




10+25
BEGIN APPROACH

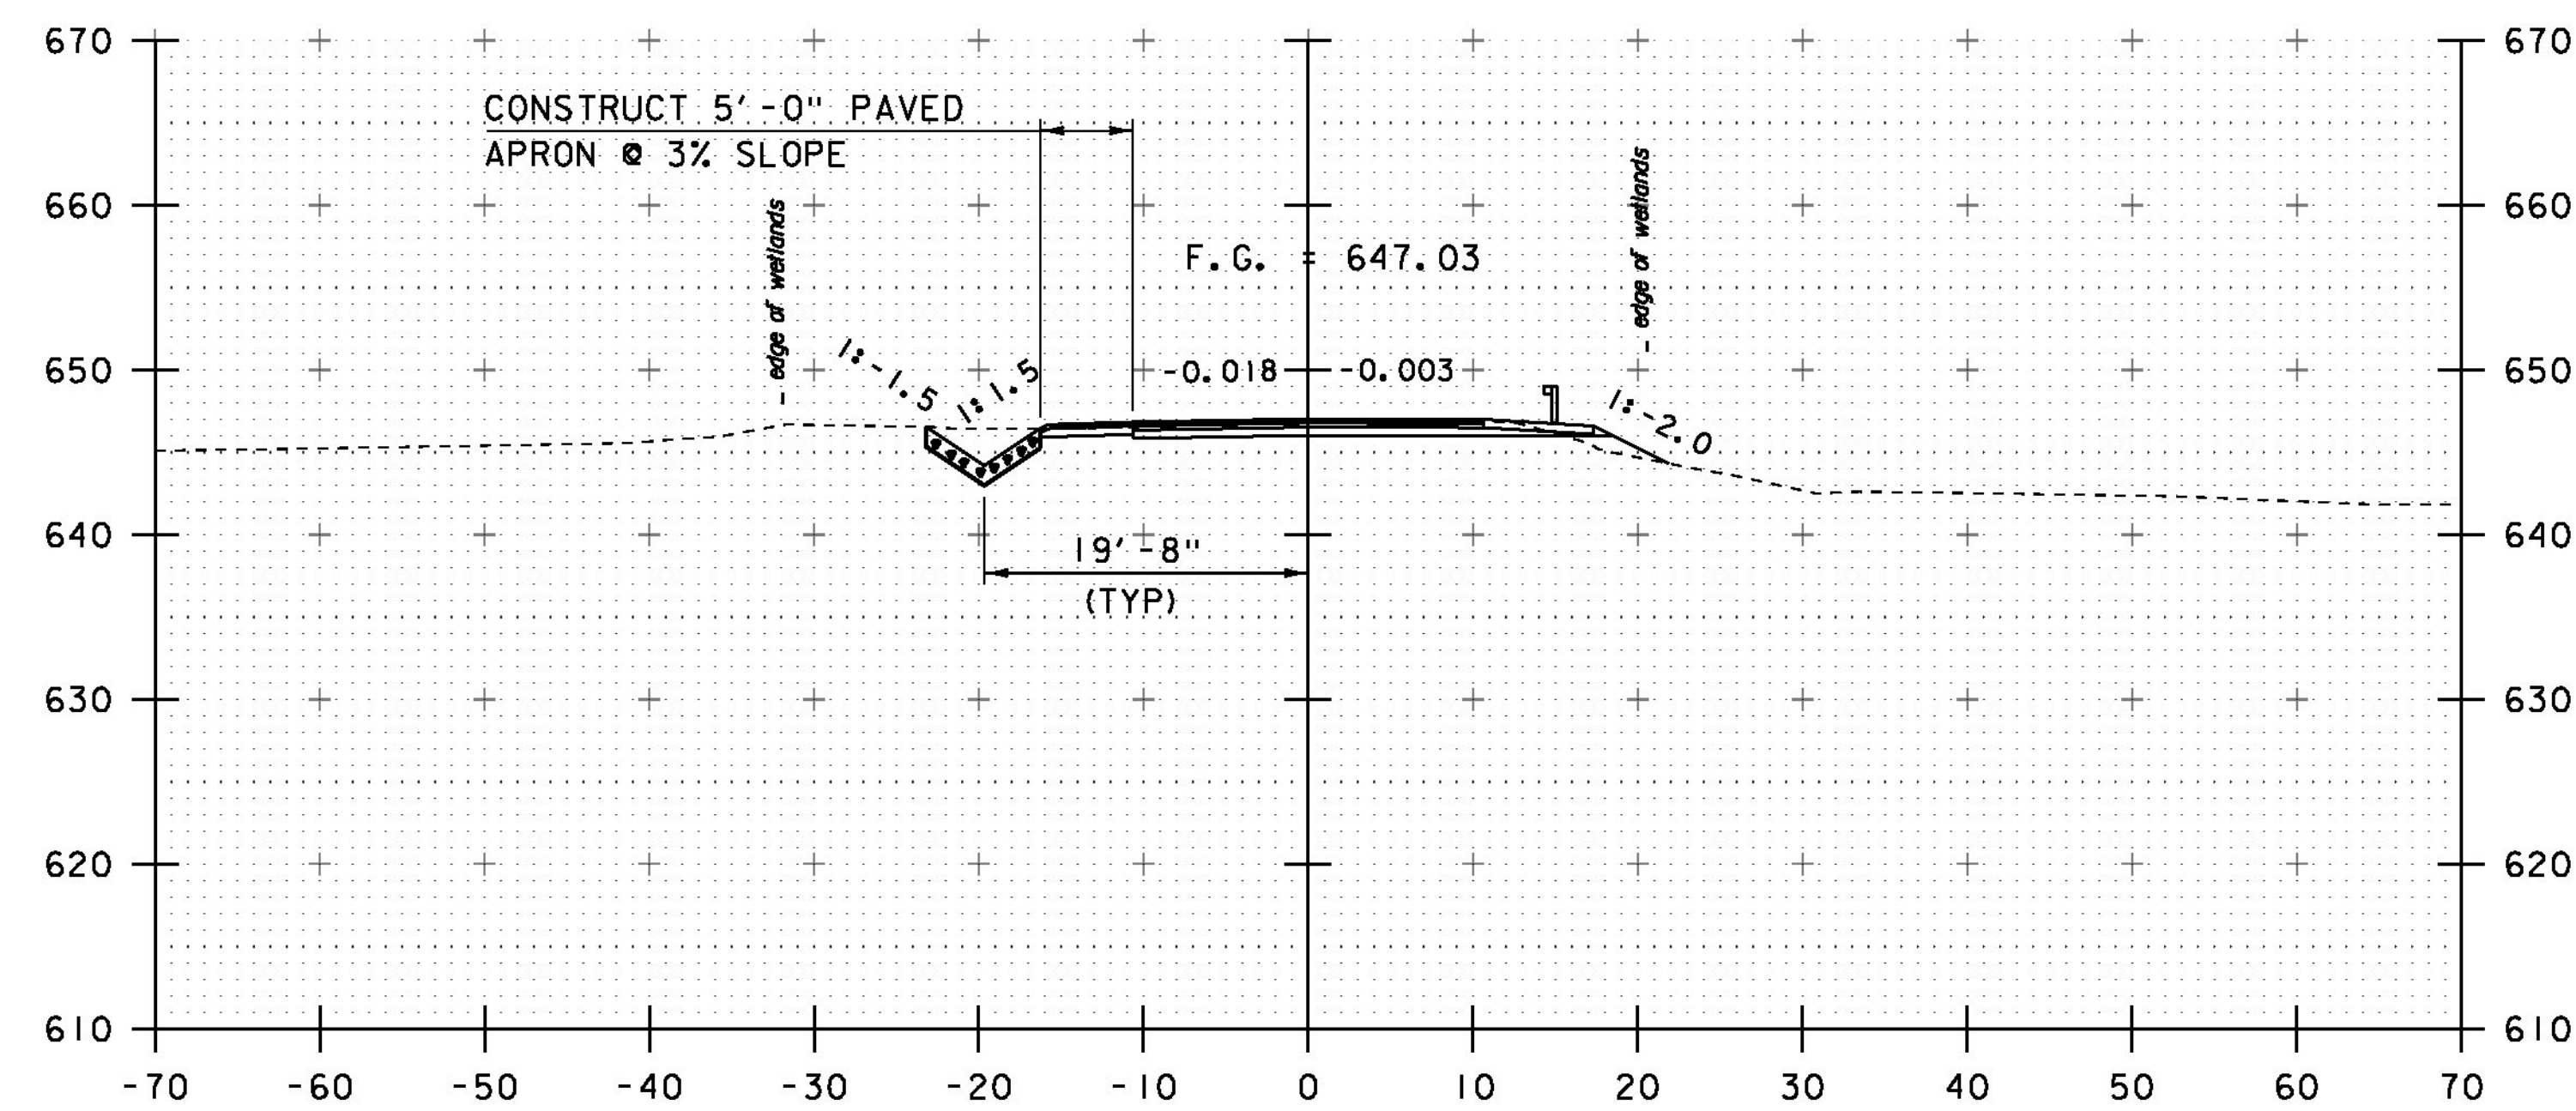

10+75

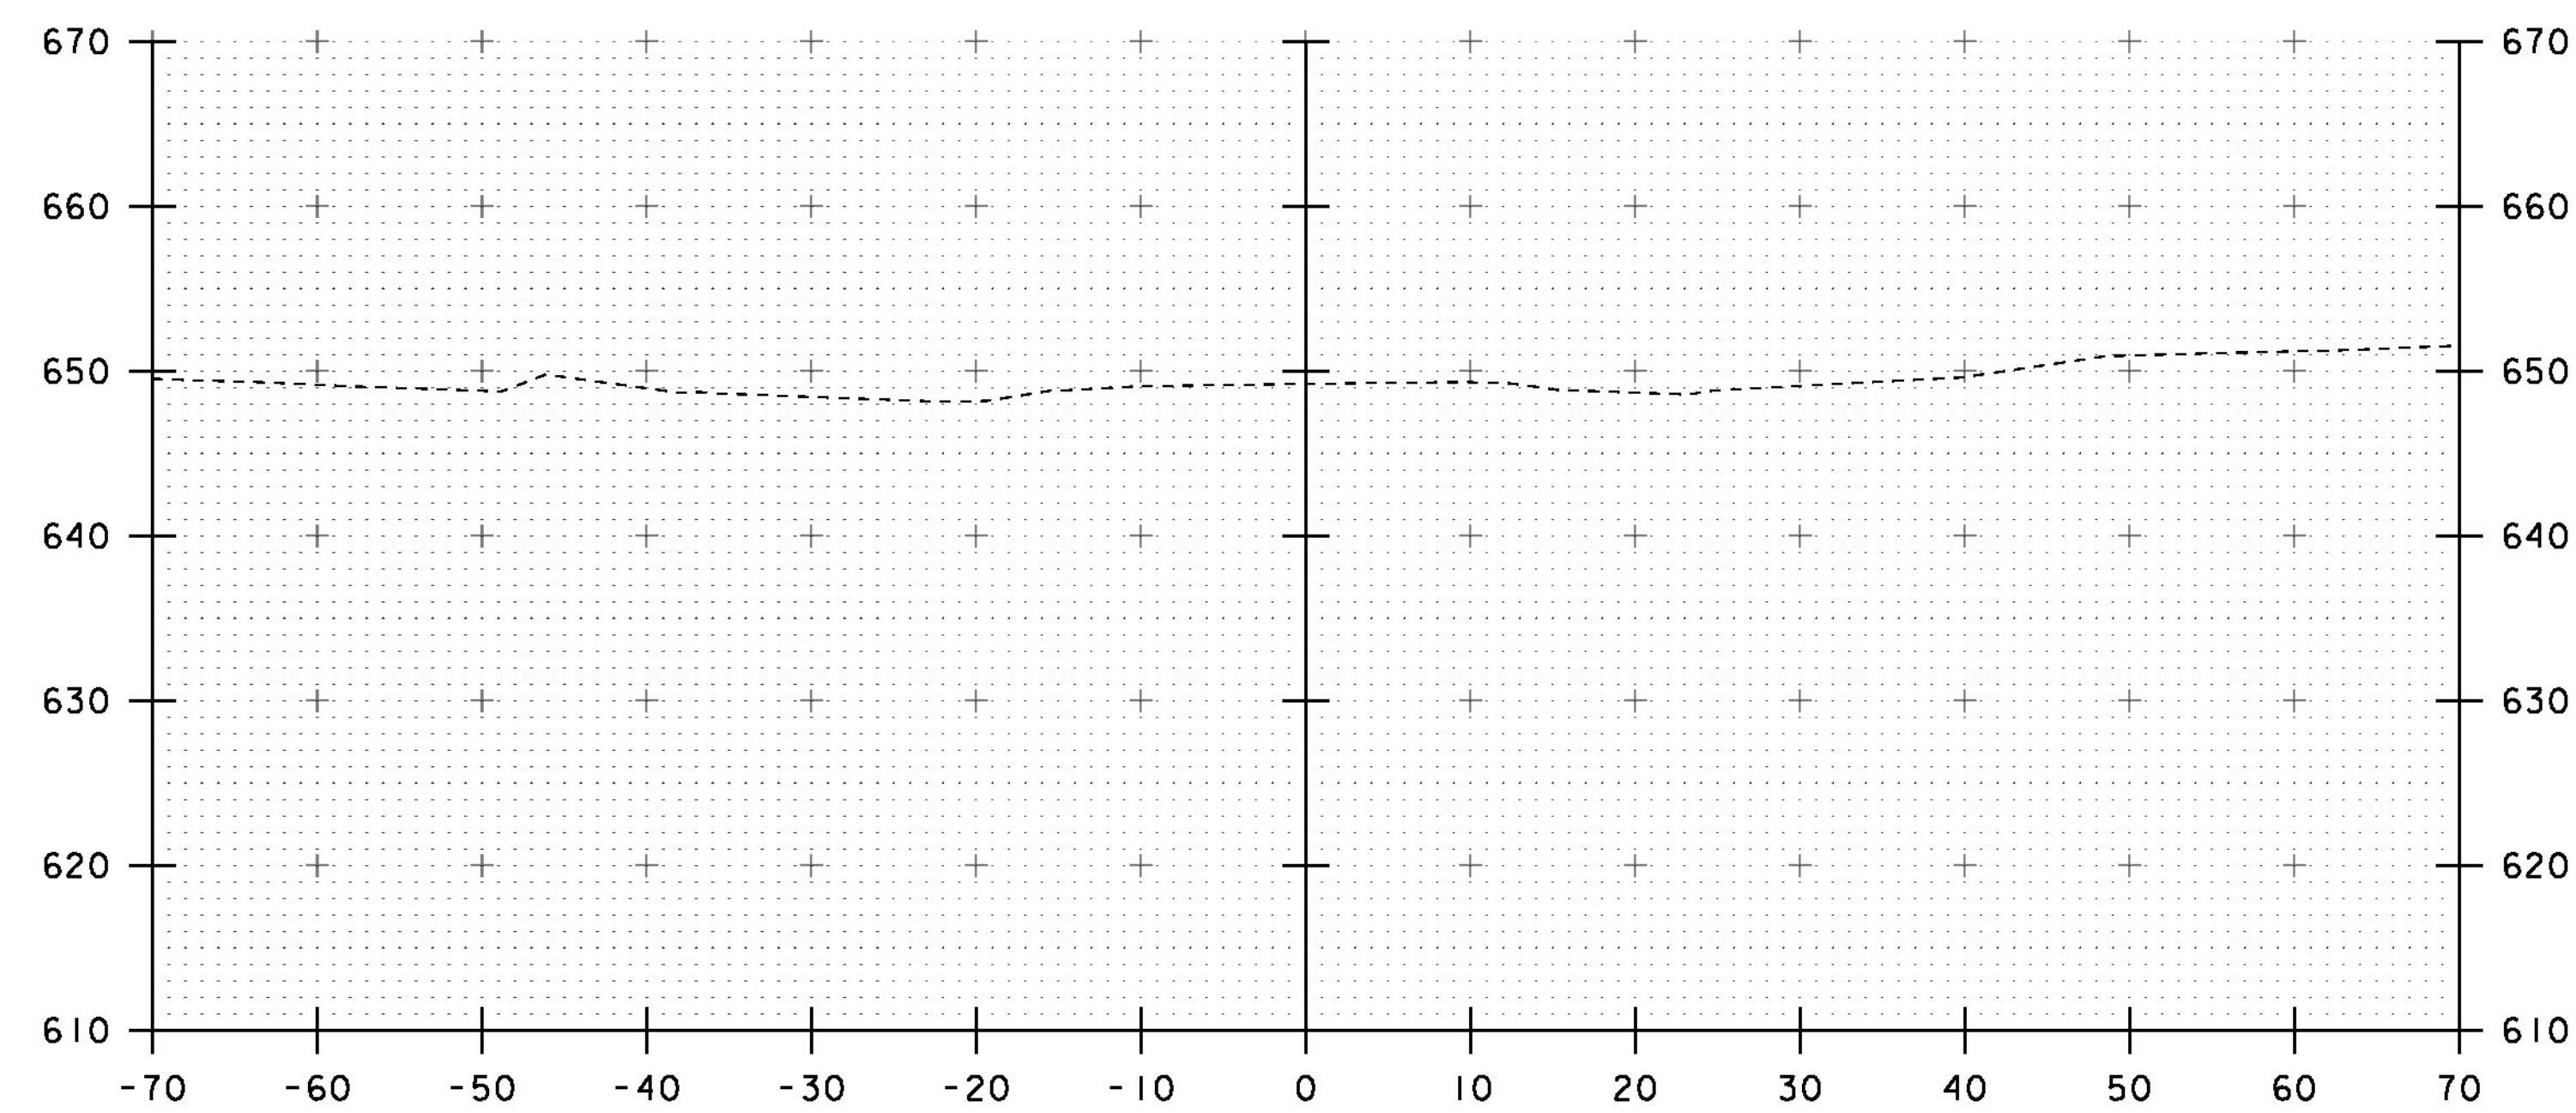

10+00

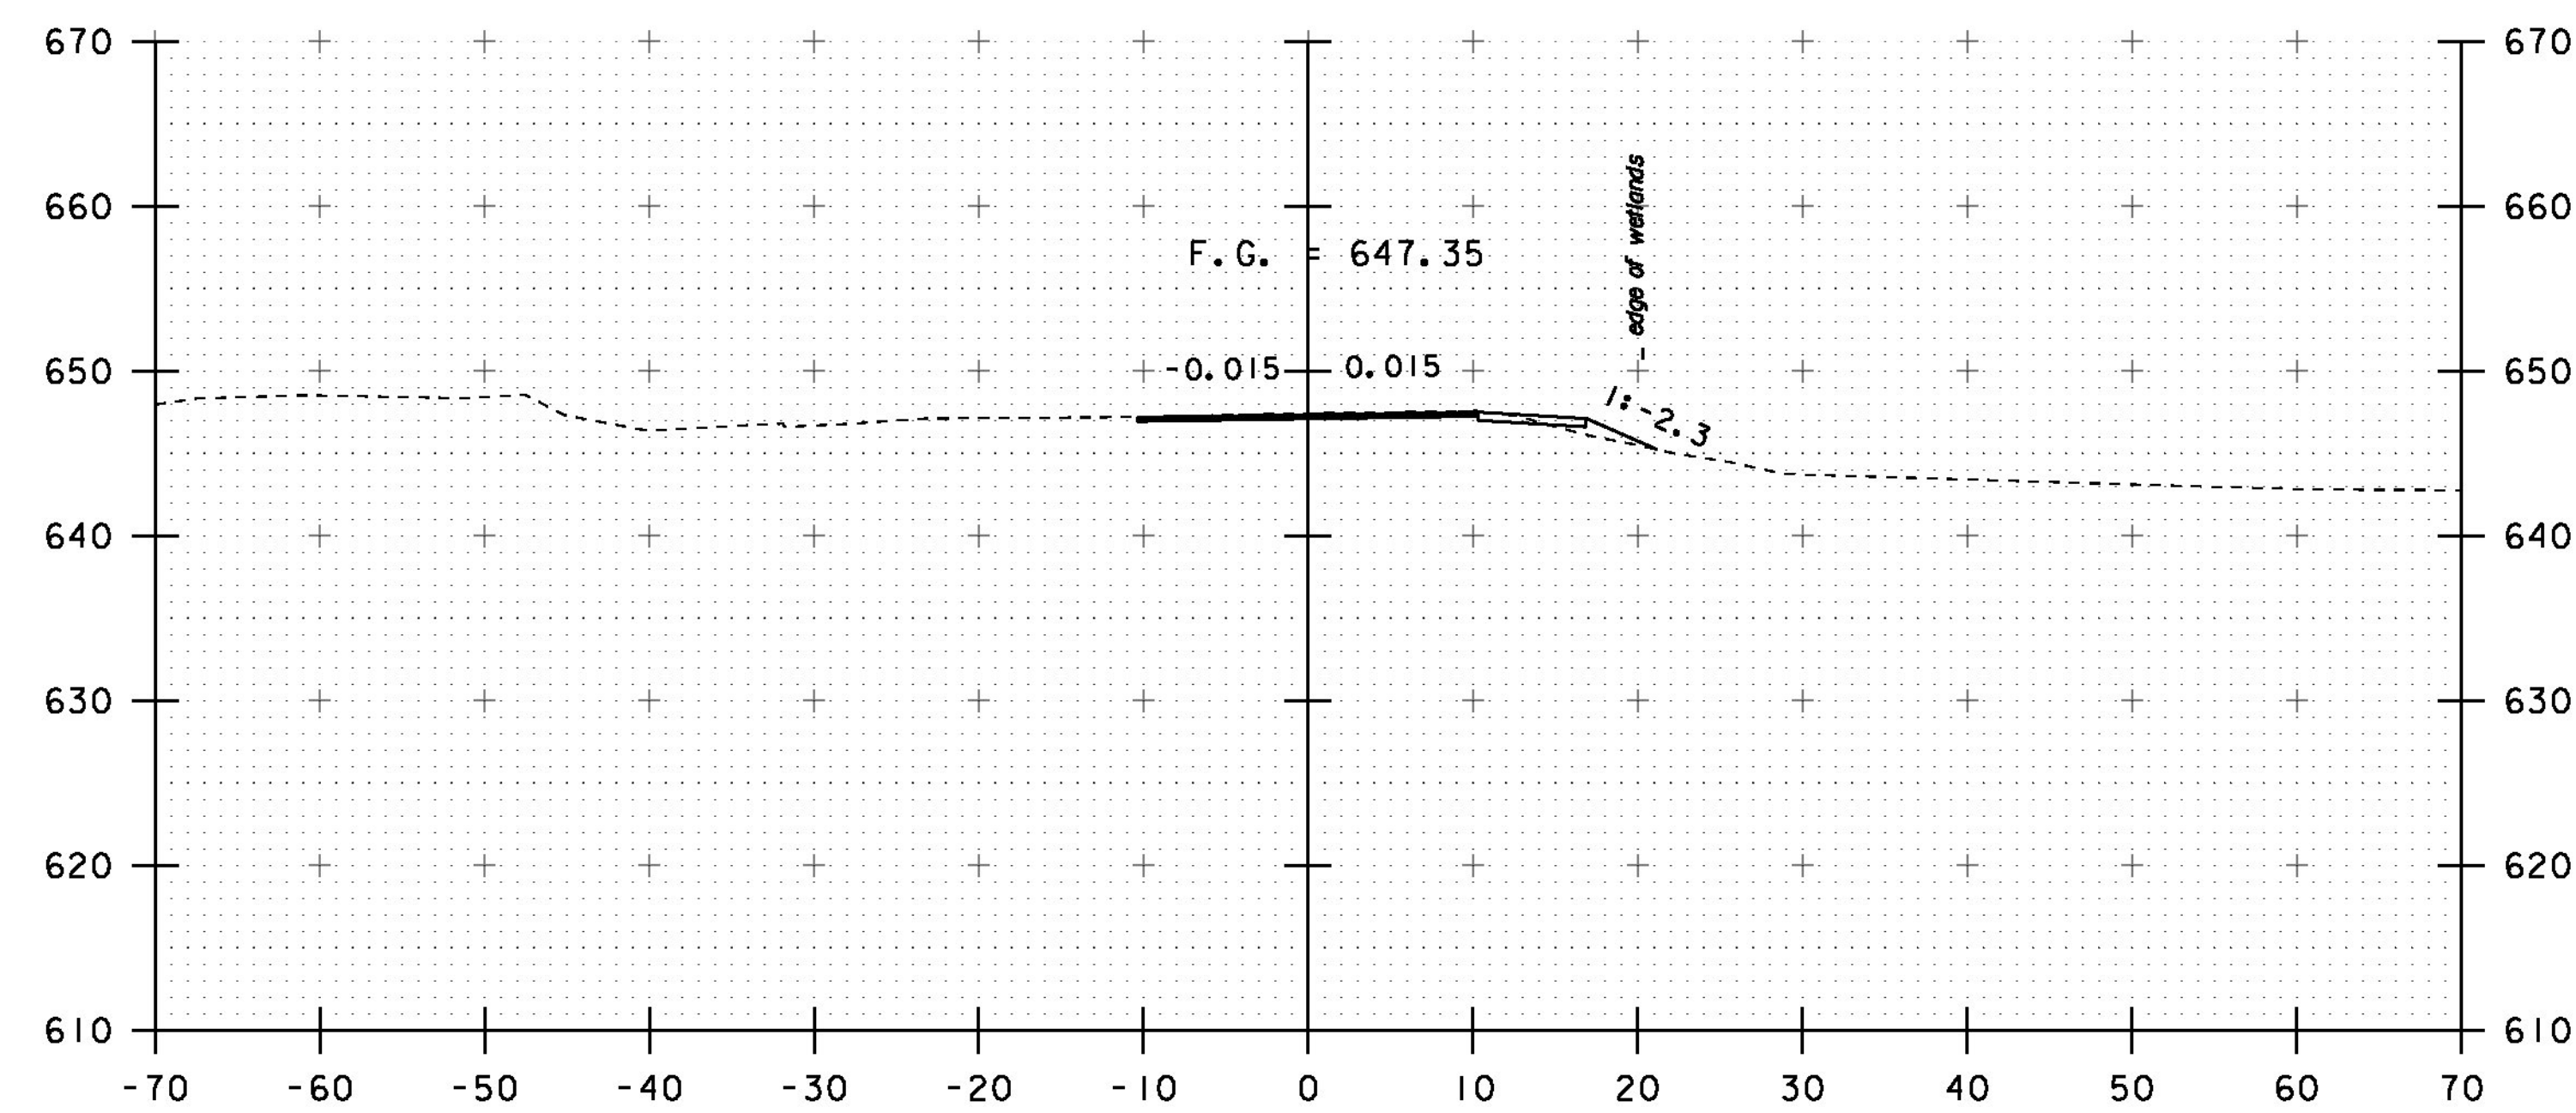

10+50

PROJECT NAME:	CLARENDON
PROJECT NUMBER:	BRO 1443(48)
FILE NAME:	st2j160xs.dgn
PROJECT LEADER:	K. HIGGINS
DESIGNED BY:	J. GRIGAS
CHECKED BY:	G. LAROCHE
PLOT DATE:	10-SEP-2015
DRAWN BY:	J. GRIGAS
SHEET	50 OF 59

STA. 10+00 TO STA. 10+75

MAINLINE CROSS SECTIONS I