




11+25

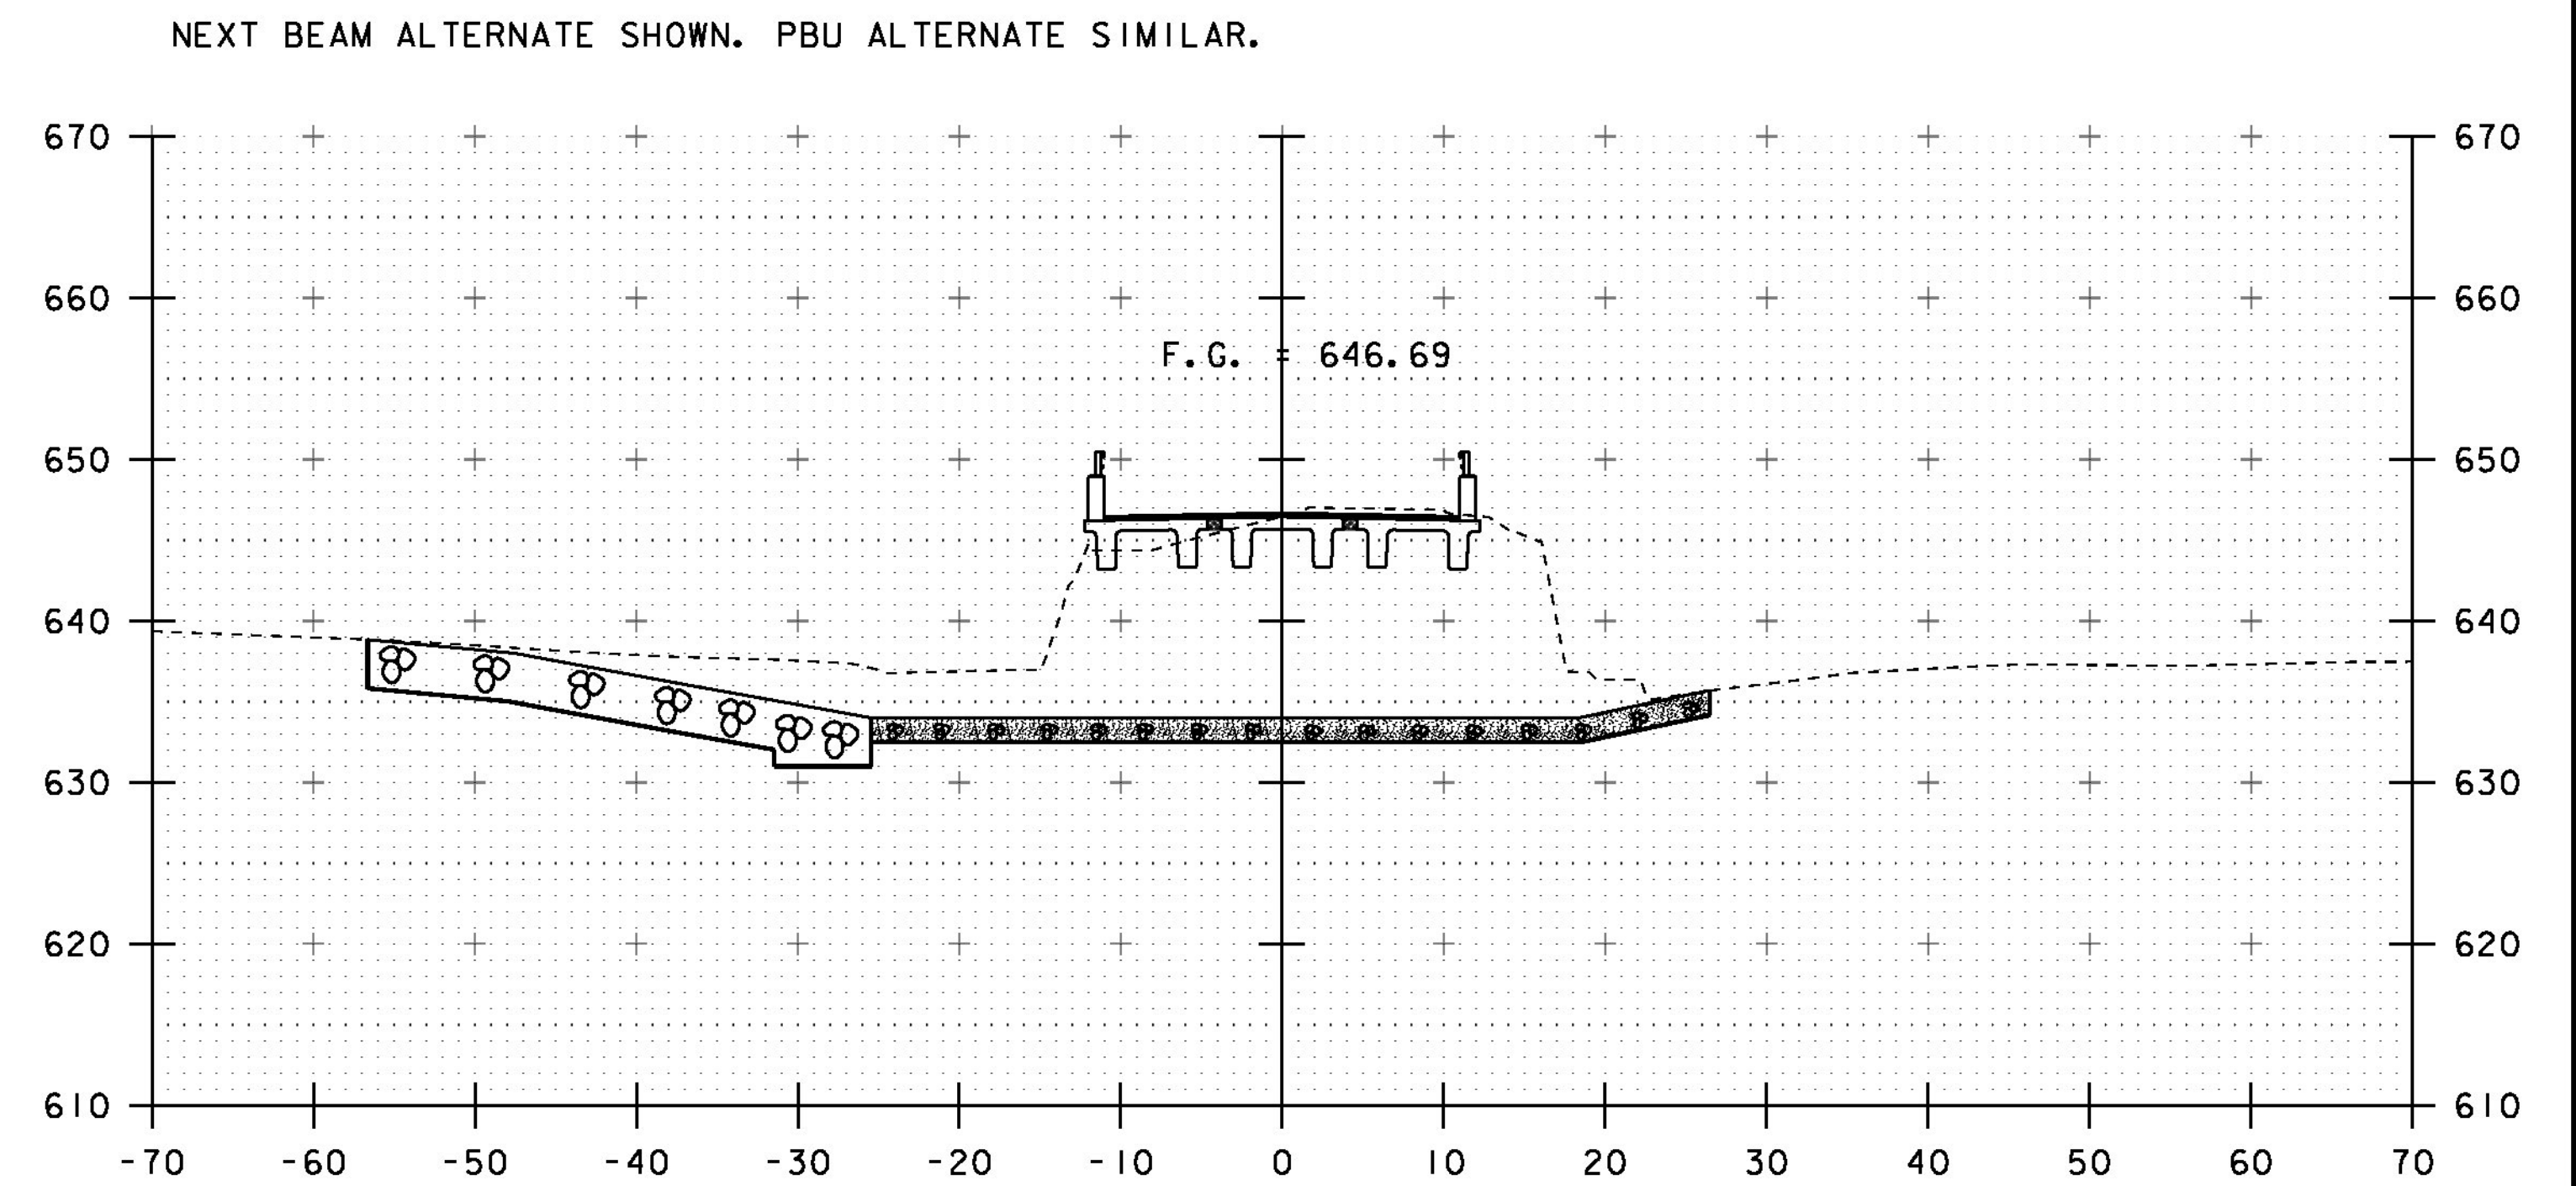

11+75

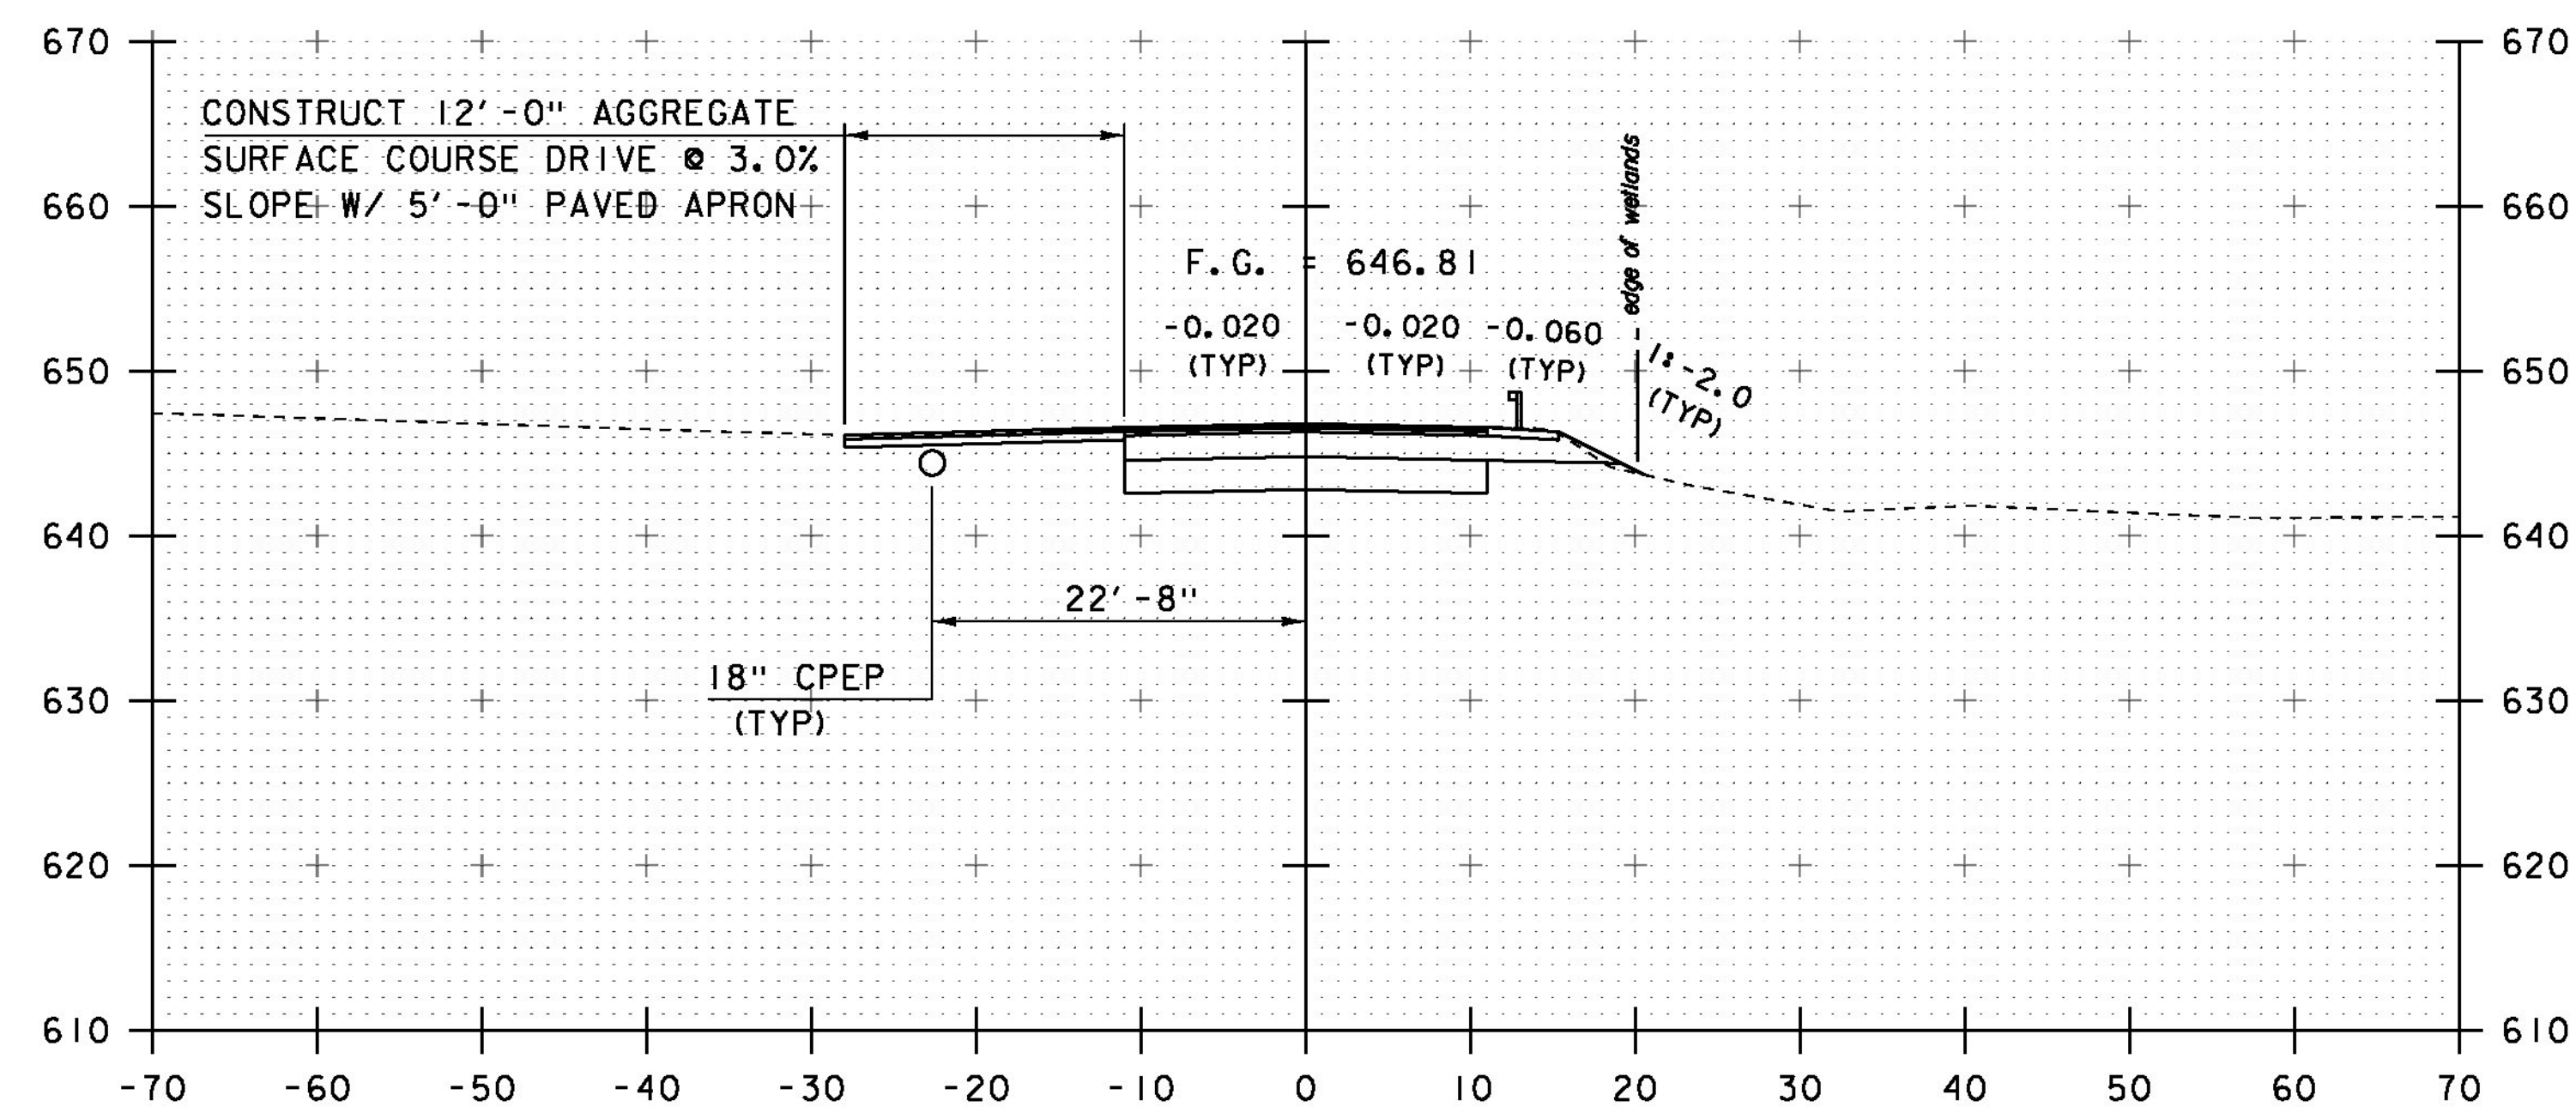

11+00
BEGIN PROJECT

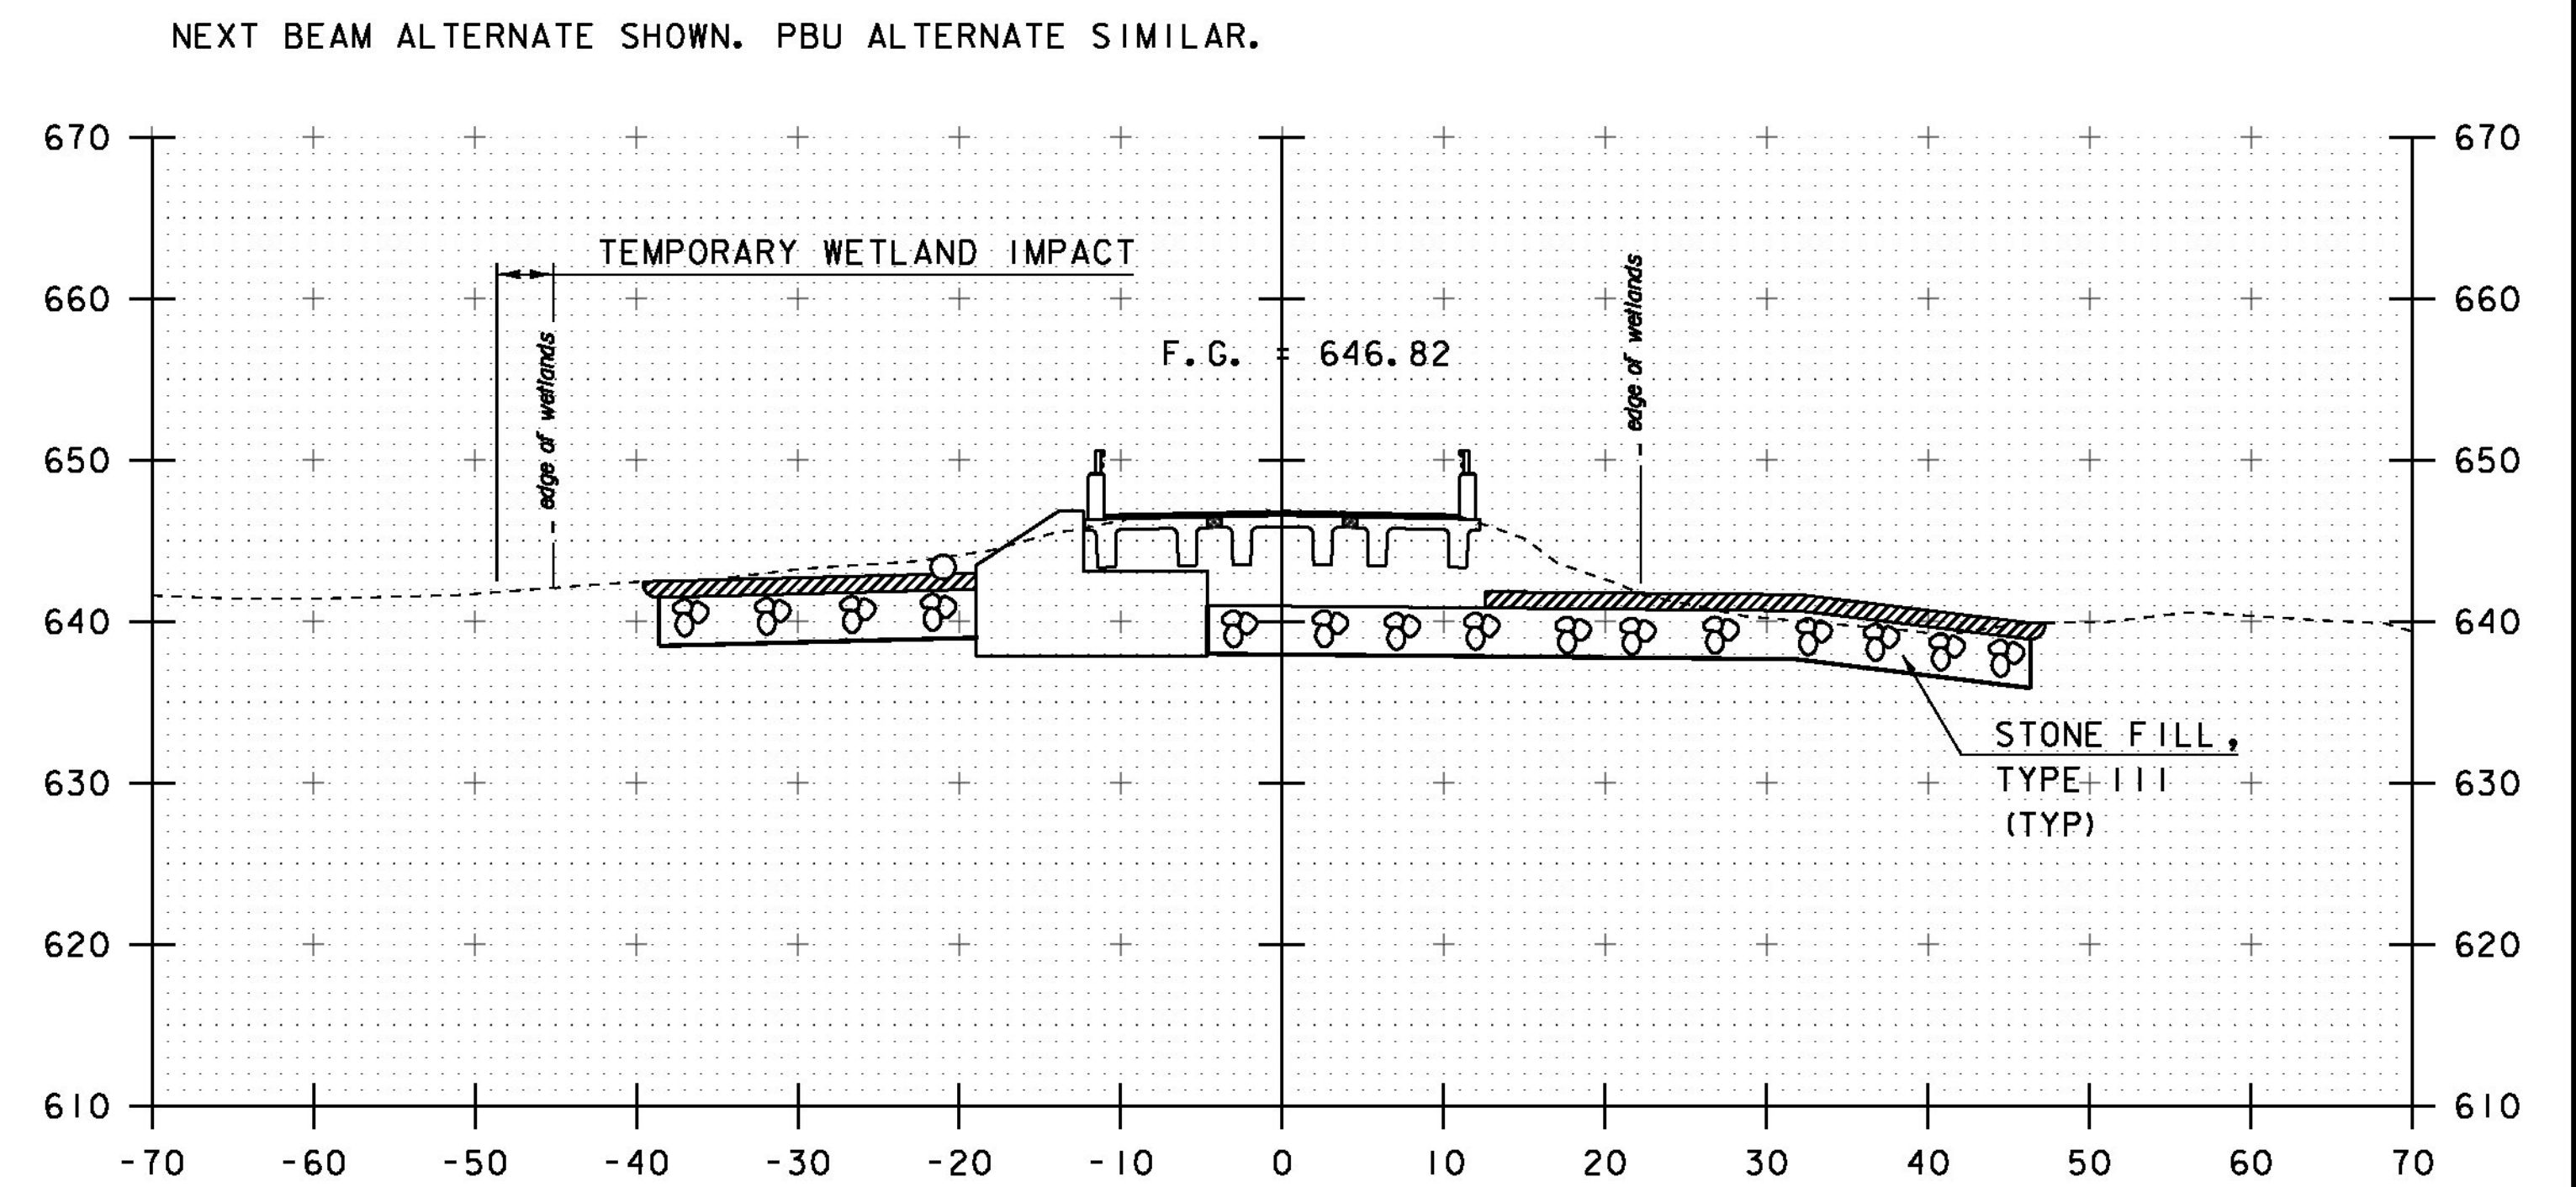

11+50
BEGIN BRIDGE 11+46.65

PROJECT NAME: CLARENDON	PLOT DATE: 08-OCT-2015
PROJECT NUMBER: BRO 1443(48)	DRAWN BY: J. GRIGAS
FILE NAME: st2j160xs.dgn	CHECKED BY: G. LAROCHE
PROJECT LEADER: K. HIGGINS	SHEET 51 OF 59
DESIGNED BY: J. GRIGAS	
MAINLINE CROSS SECTIONS 2	

STA. 11+00 TO STA. 11+75