




13+25

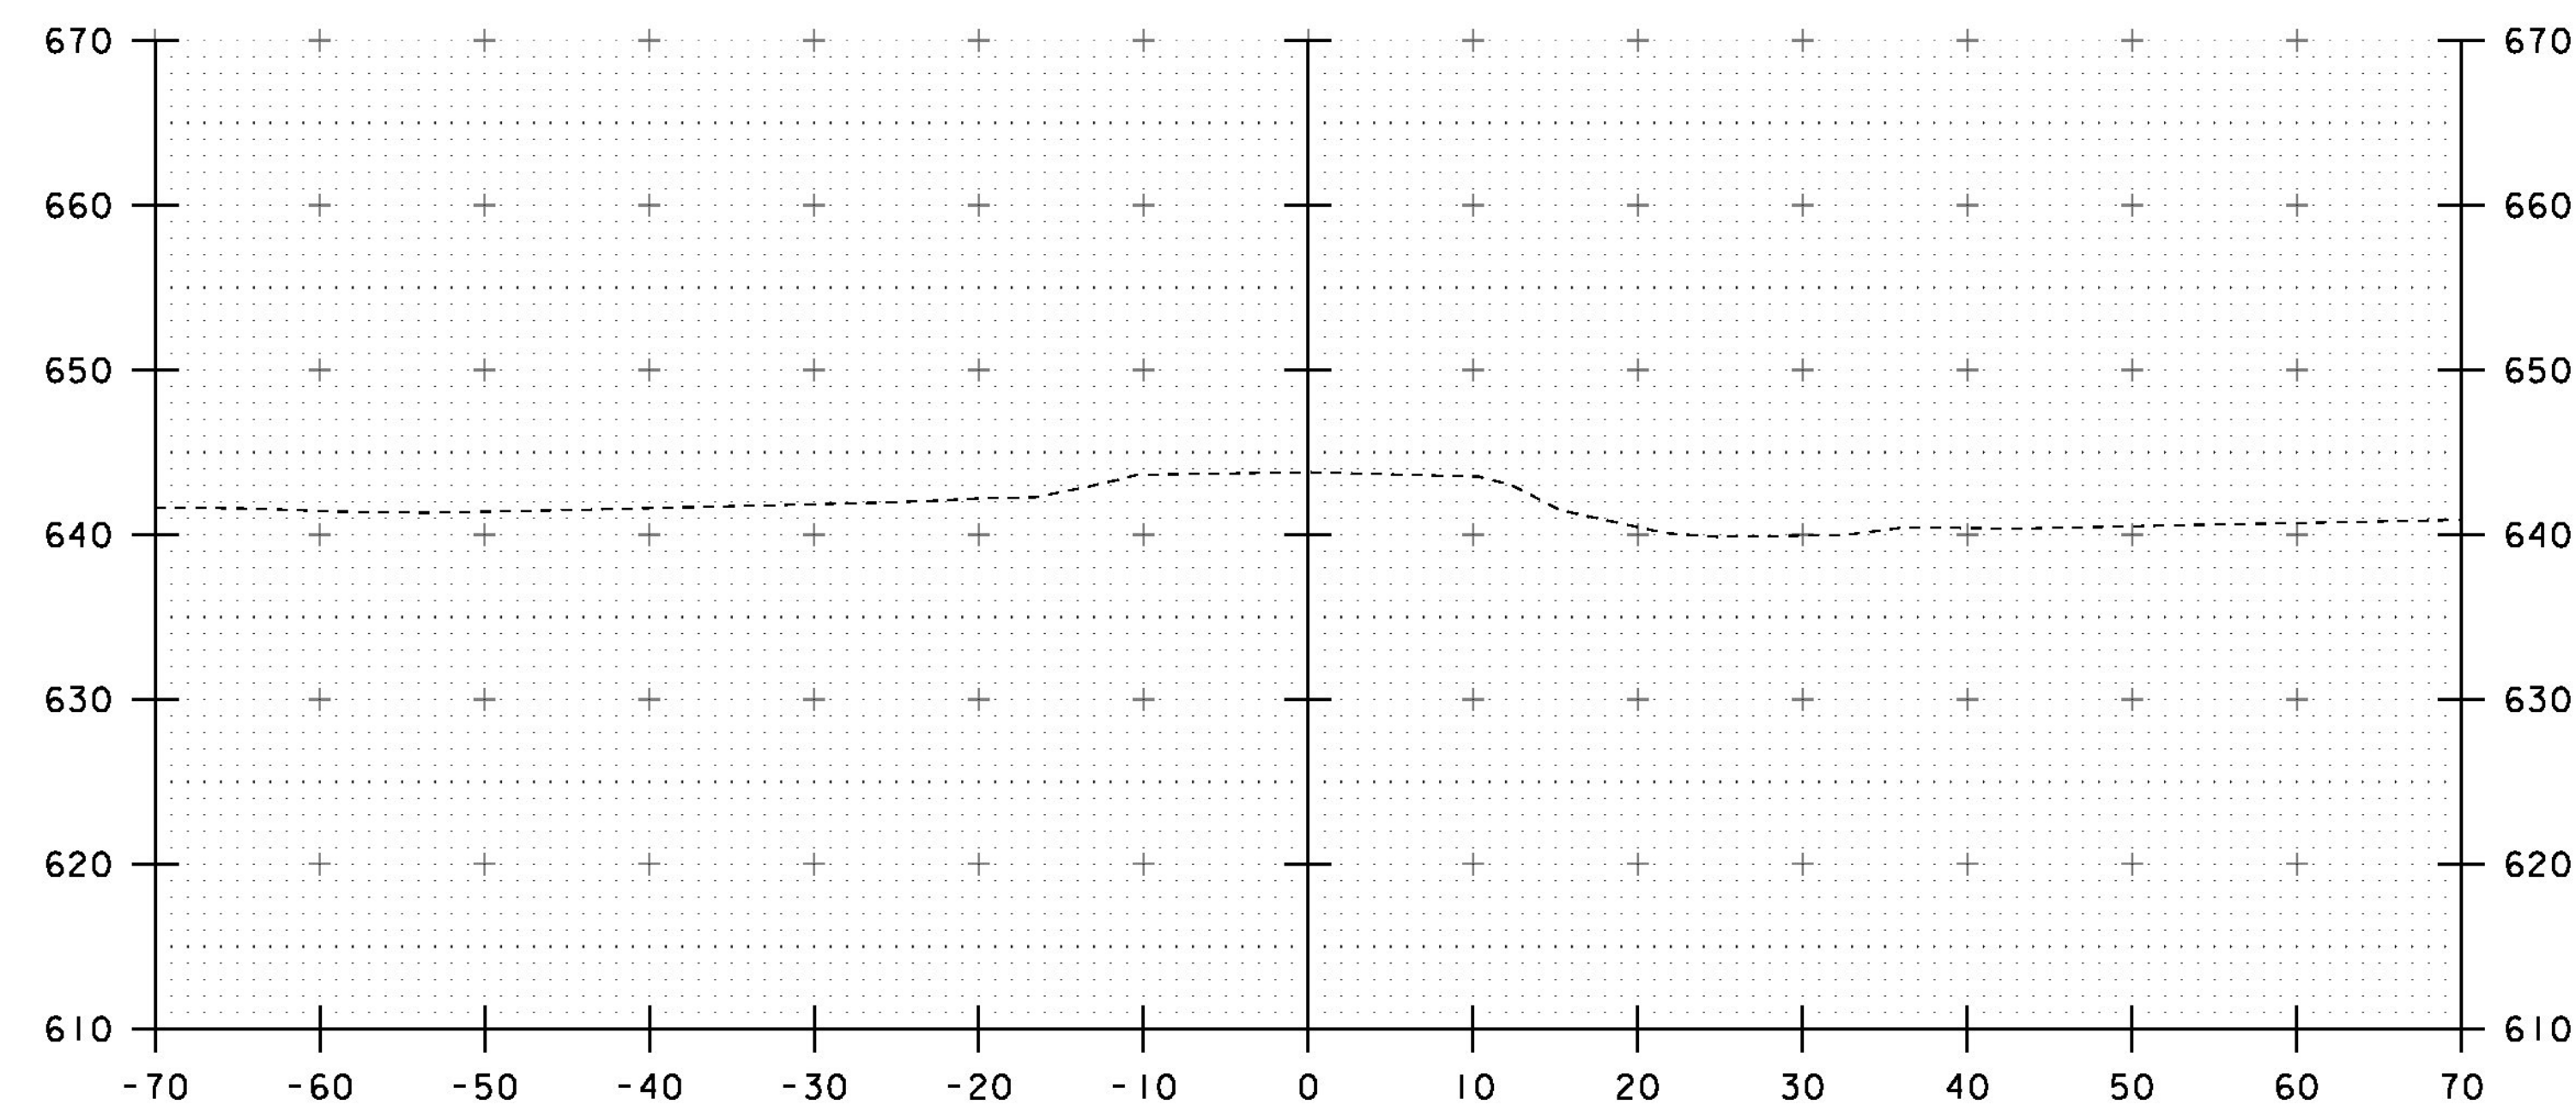

13+75

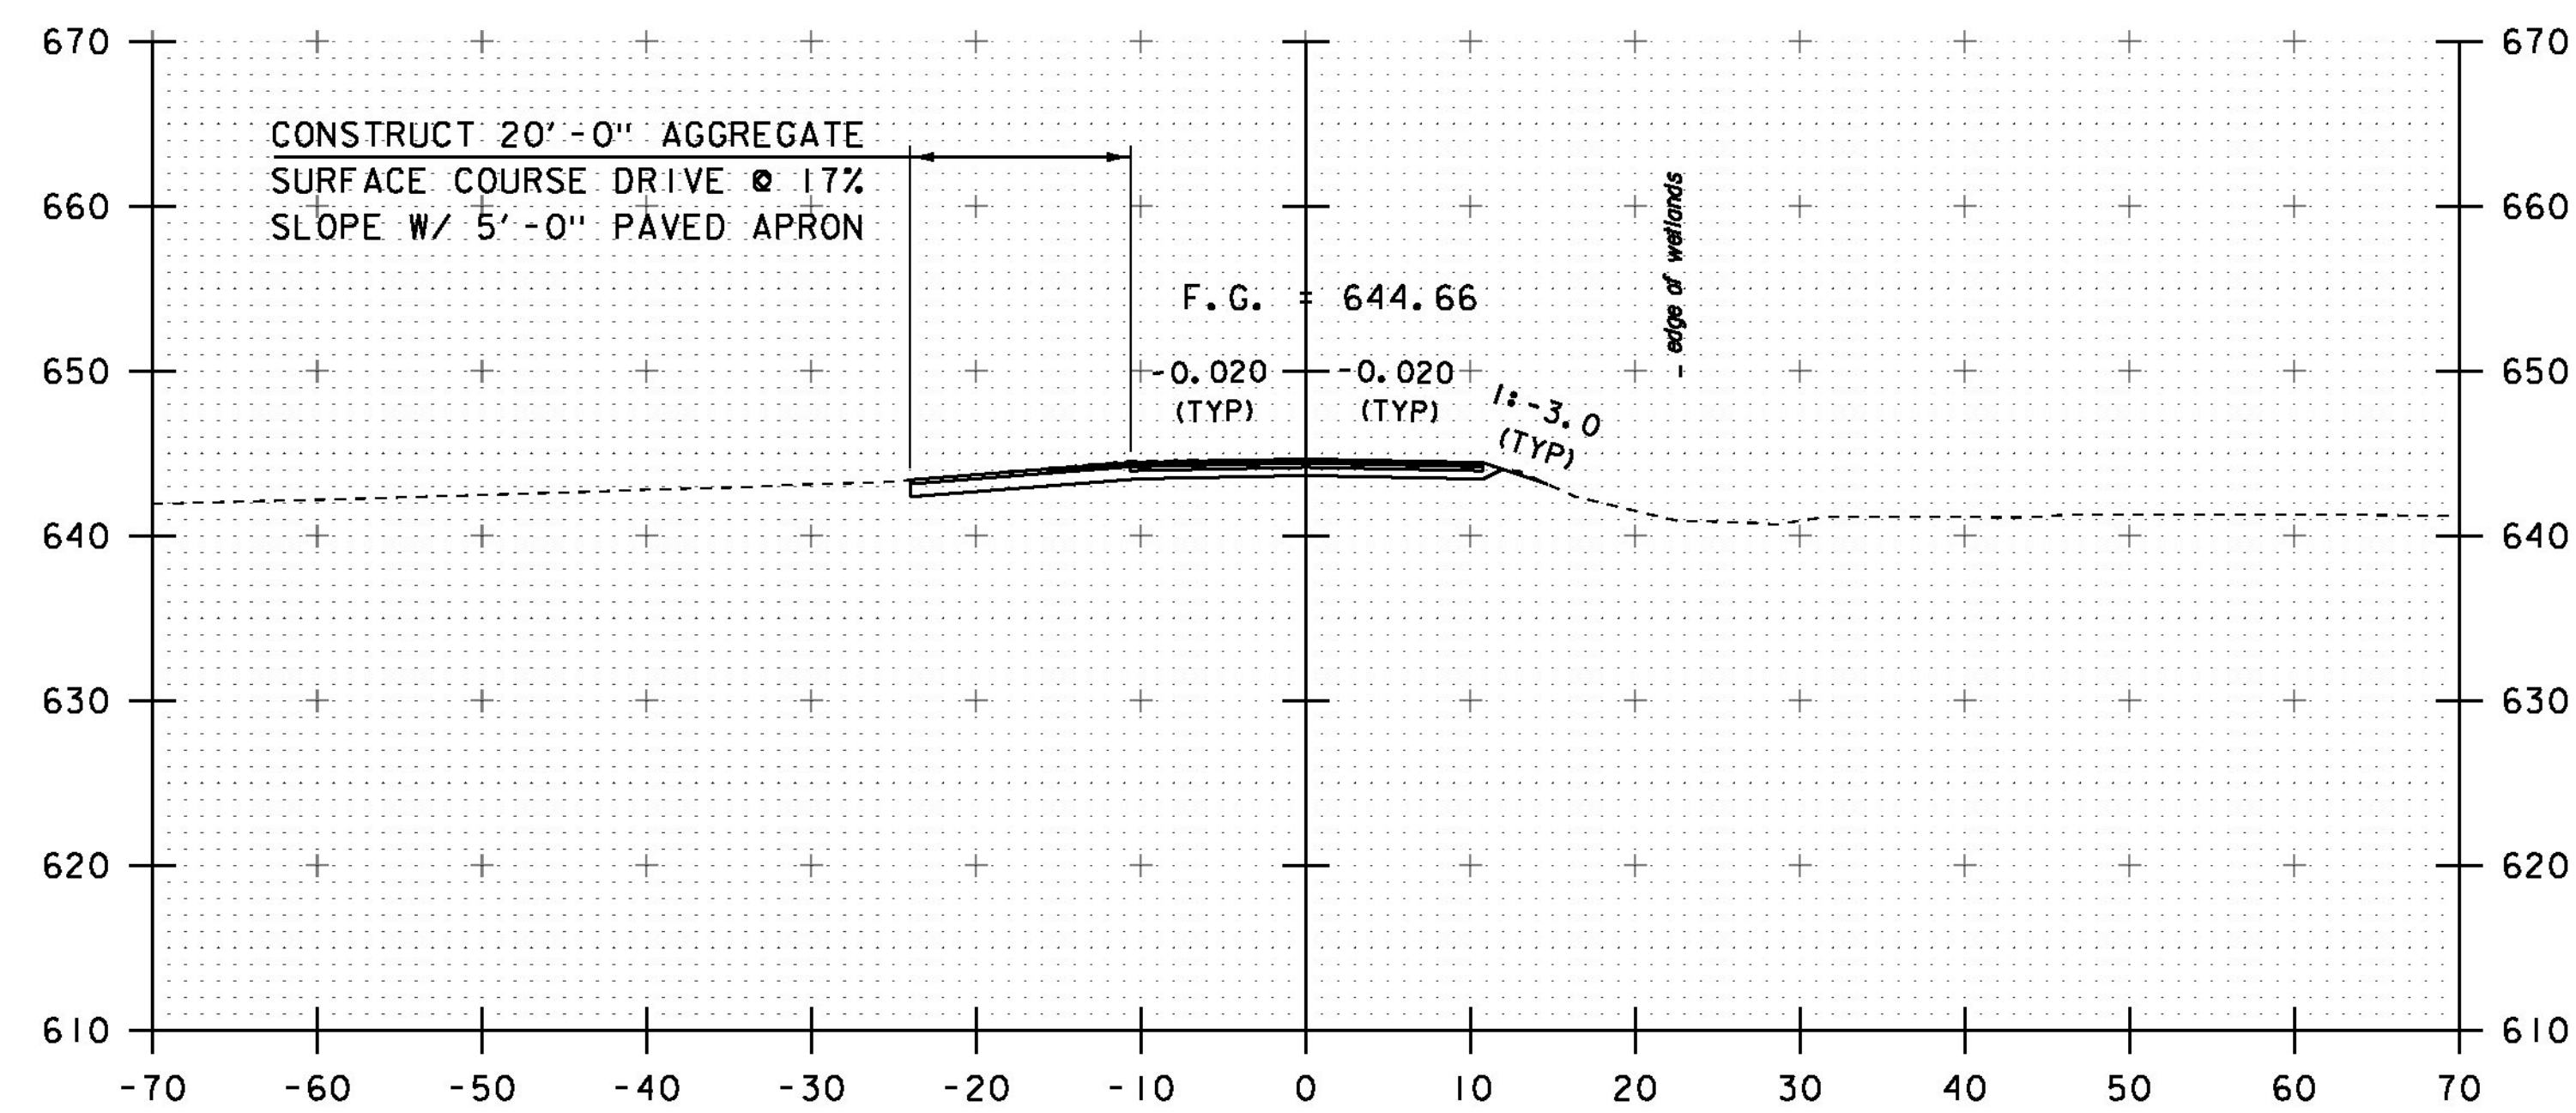

13+00

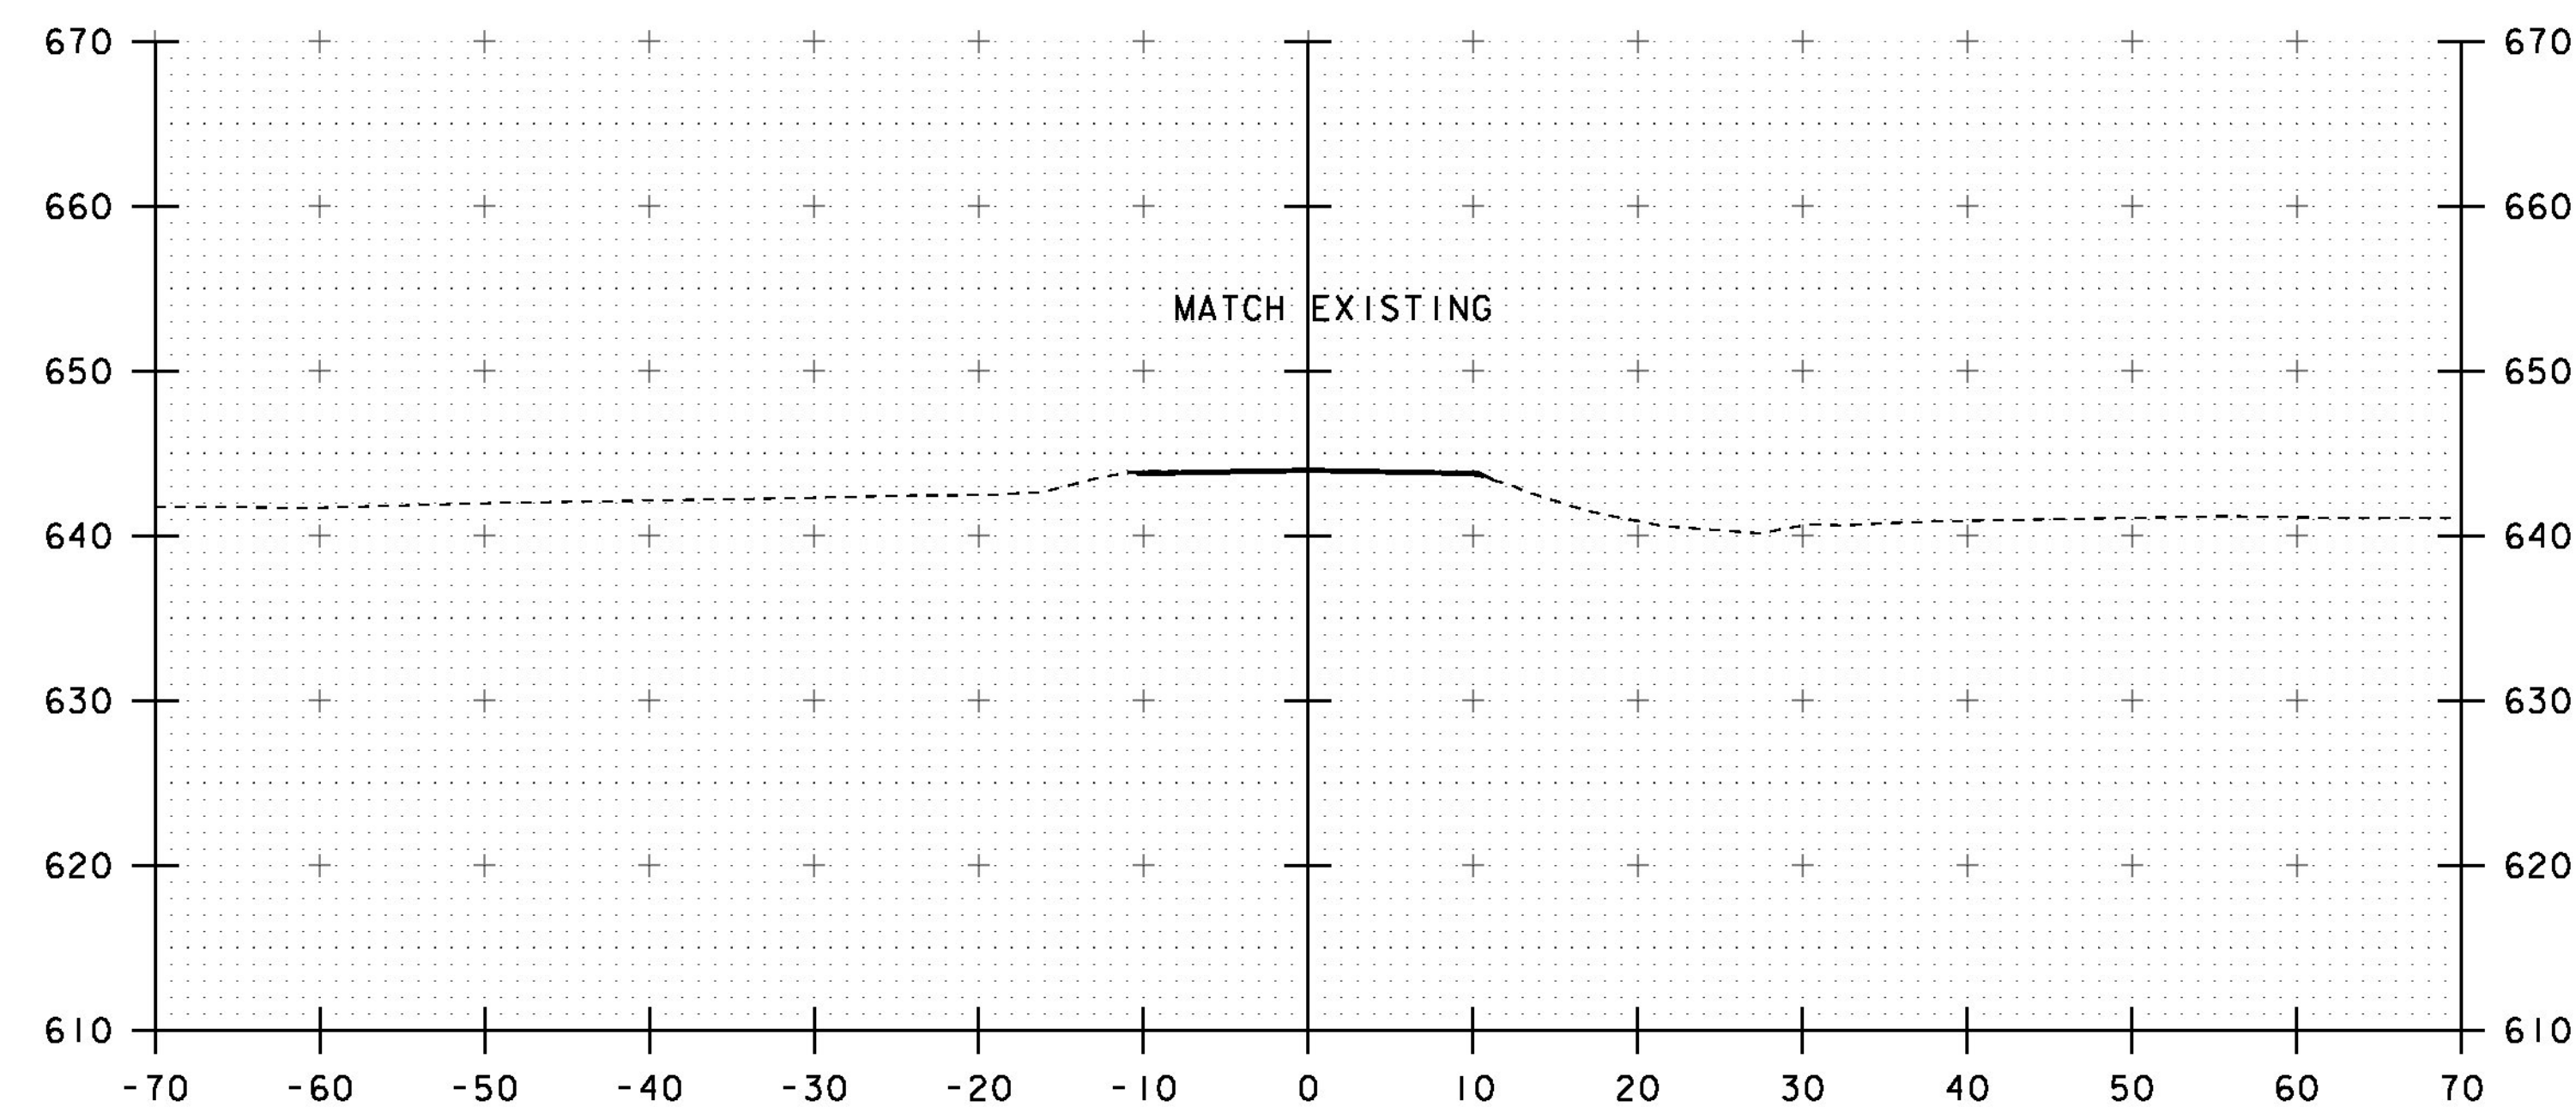

13+50
END APPROACH

PROJECT NAME: CLARENDON	PLOT DATE: 08-OCT-2015
PROJECT NUMBER: BRO 1443(48)	DRAWN BY: J. GRIGAS
FILE NAME: st2j160xs.dgn	CHECKED BY: G. LAROCHE
PROJECT LEADER: K. HIGGINS	SHEET 53 OF 59
DESIGNED BY: J. GRIGAS	
MAINLINE CROSS SECTIONS 4	

STA. 13+00 TO STA. 13+75