



STA 50+82.00 LT
END GRUBBING MATERIAL

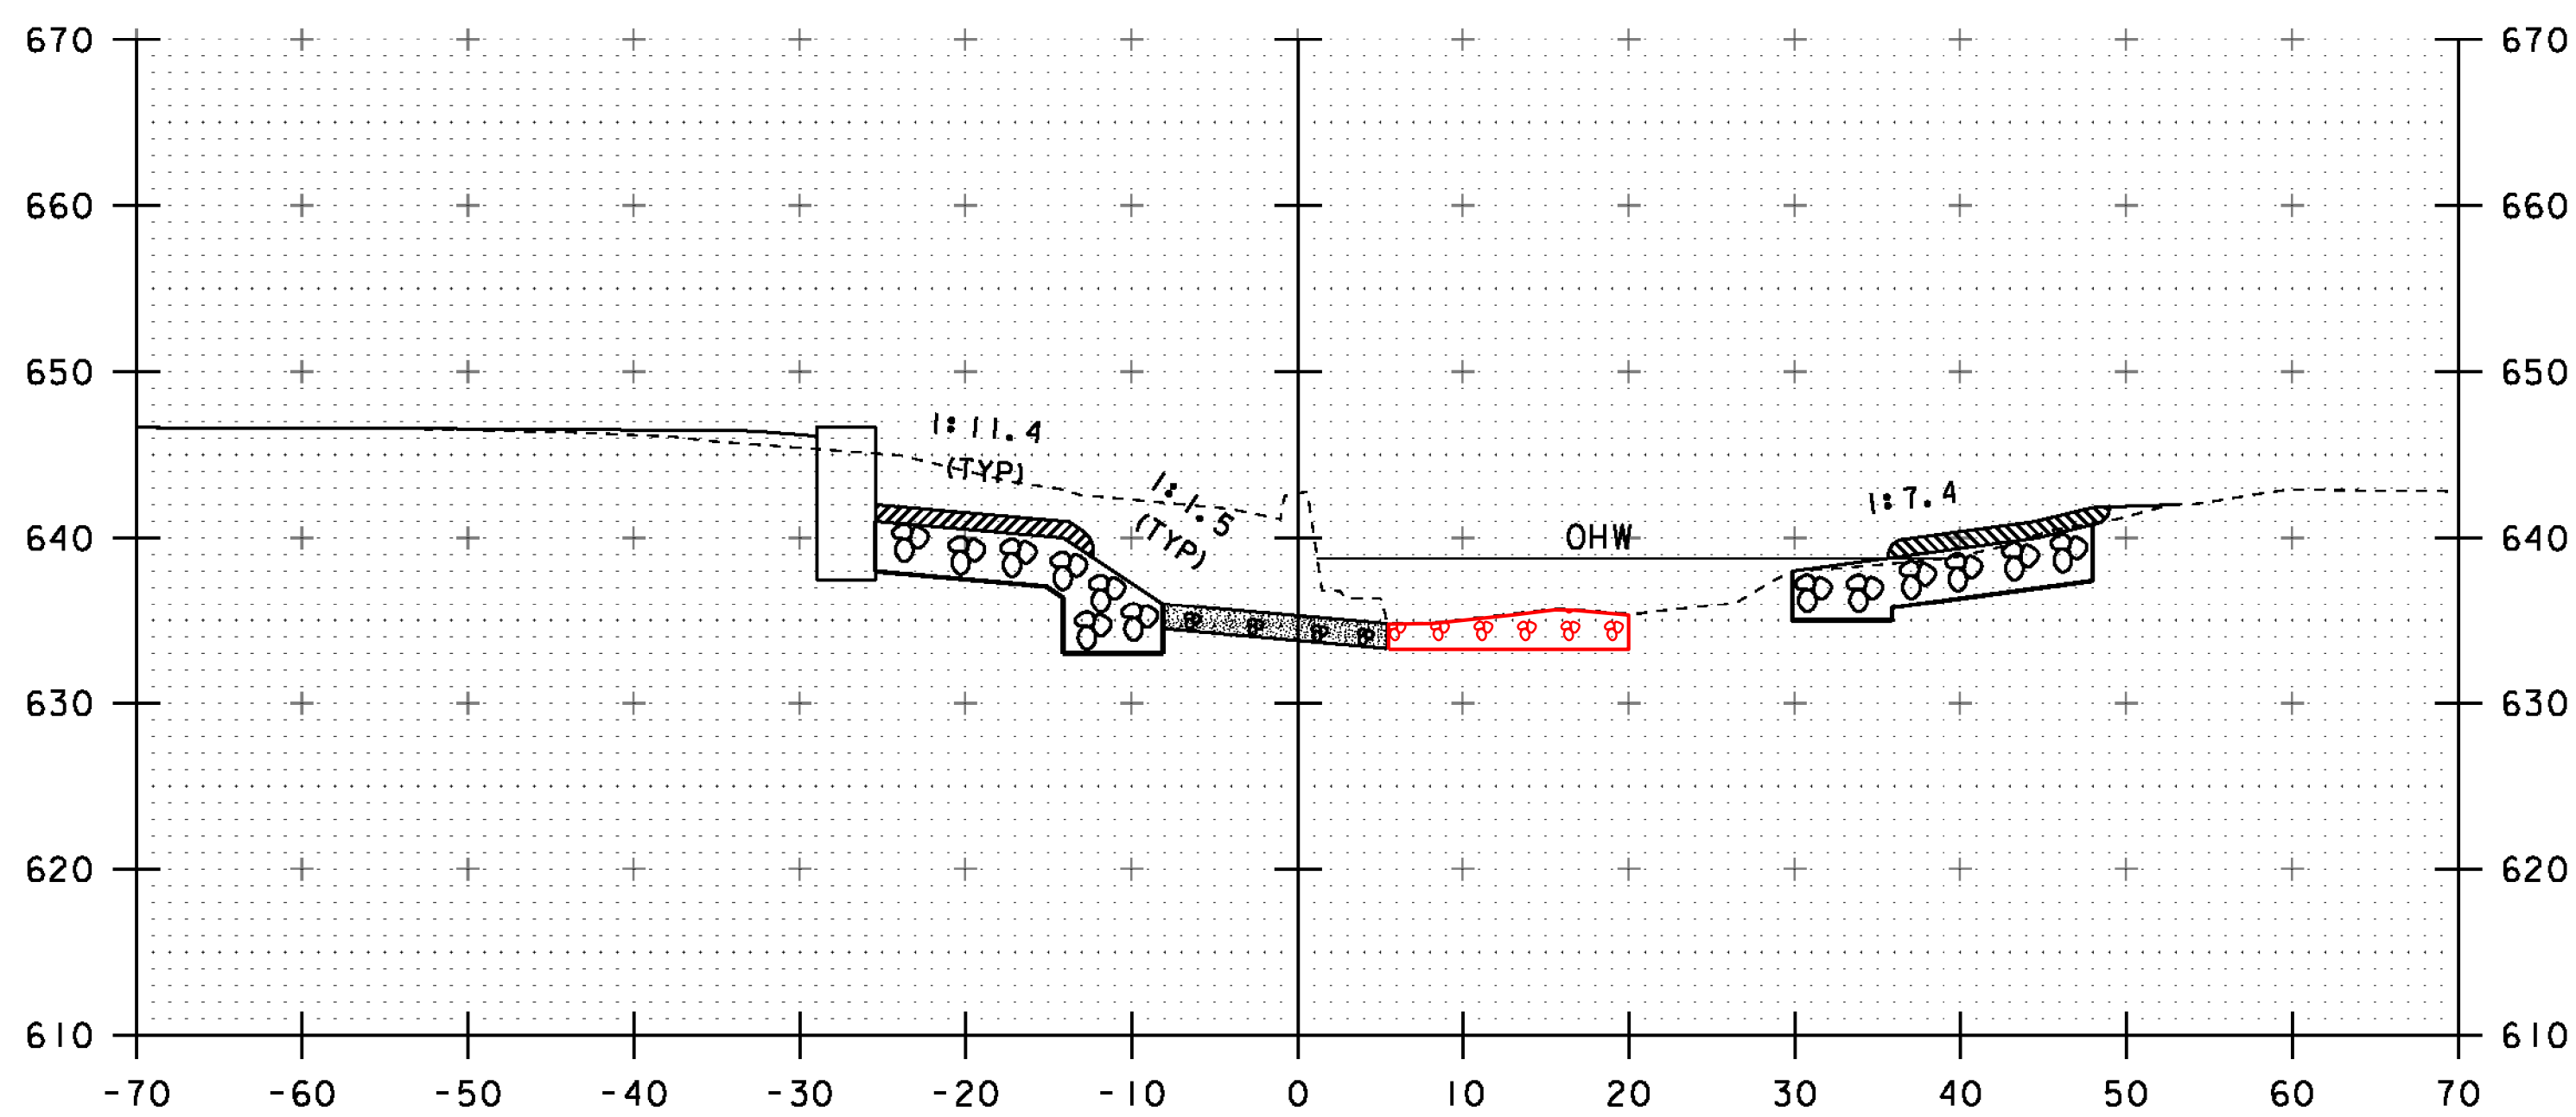



STA 51+07.70 LT
BEGIN GRUBBING MATERIAL

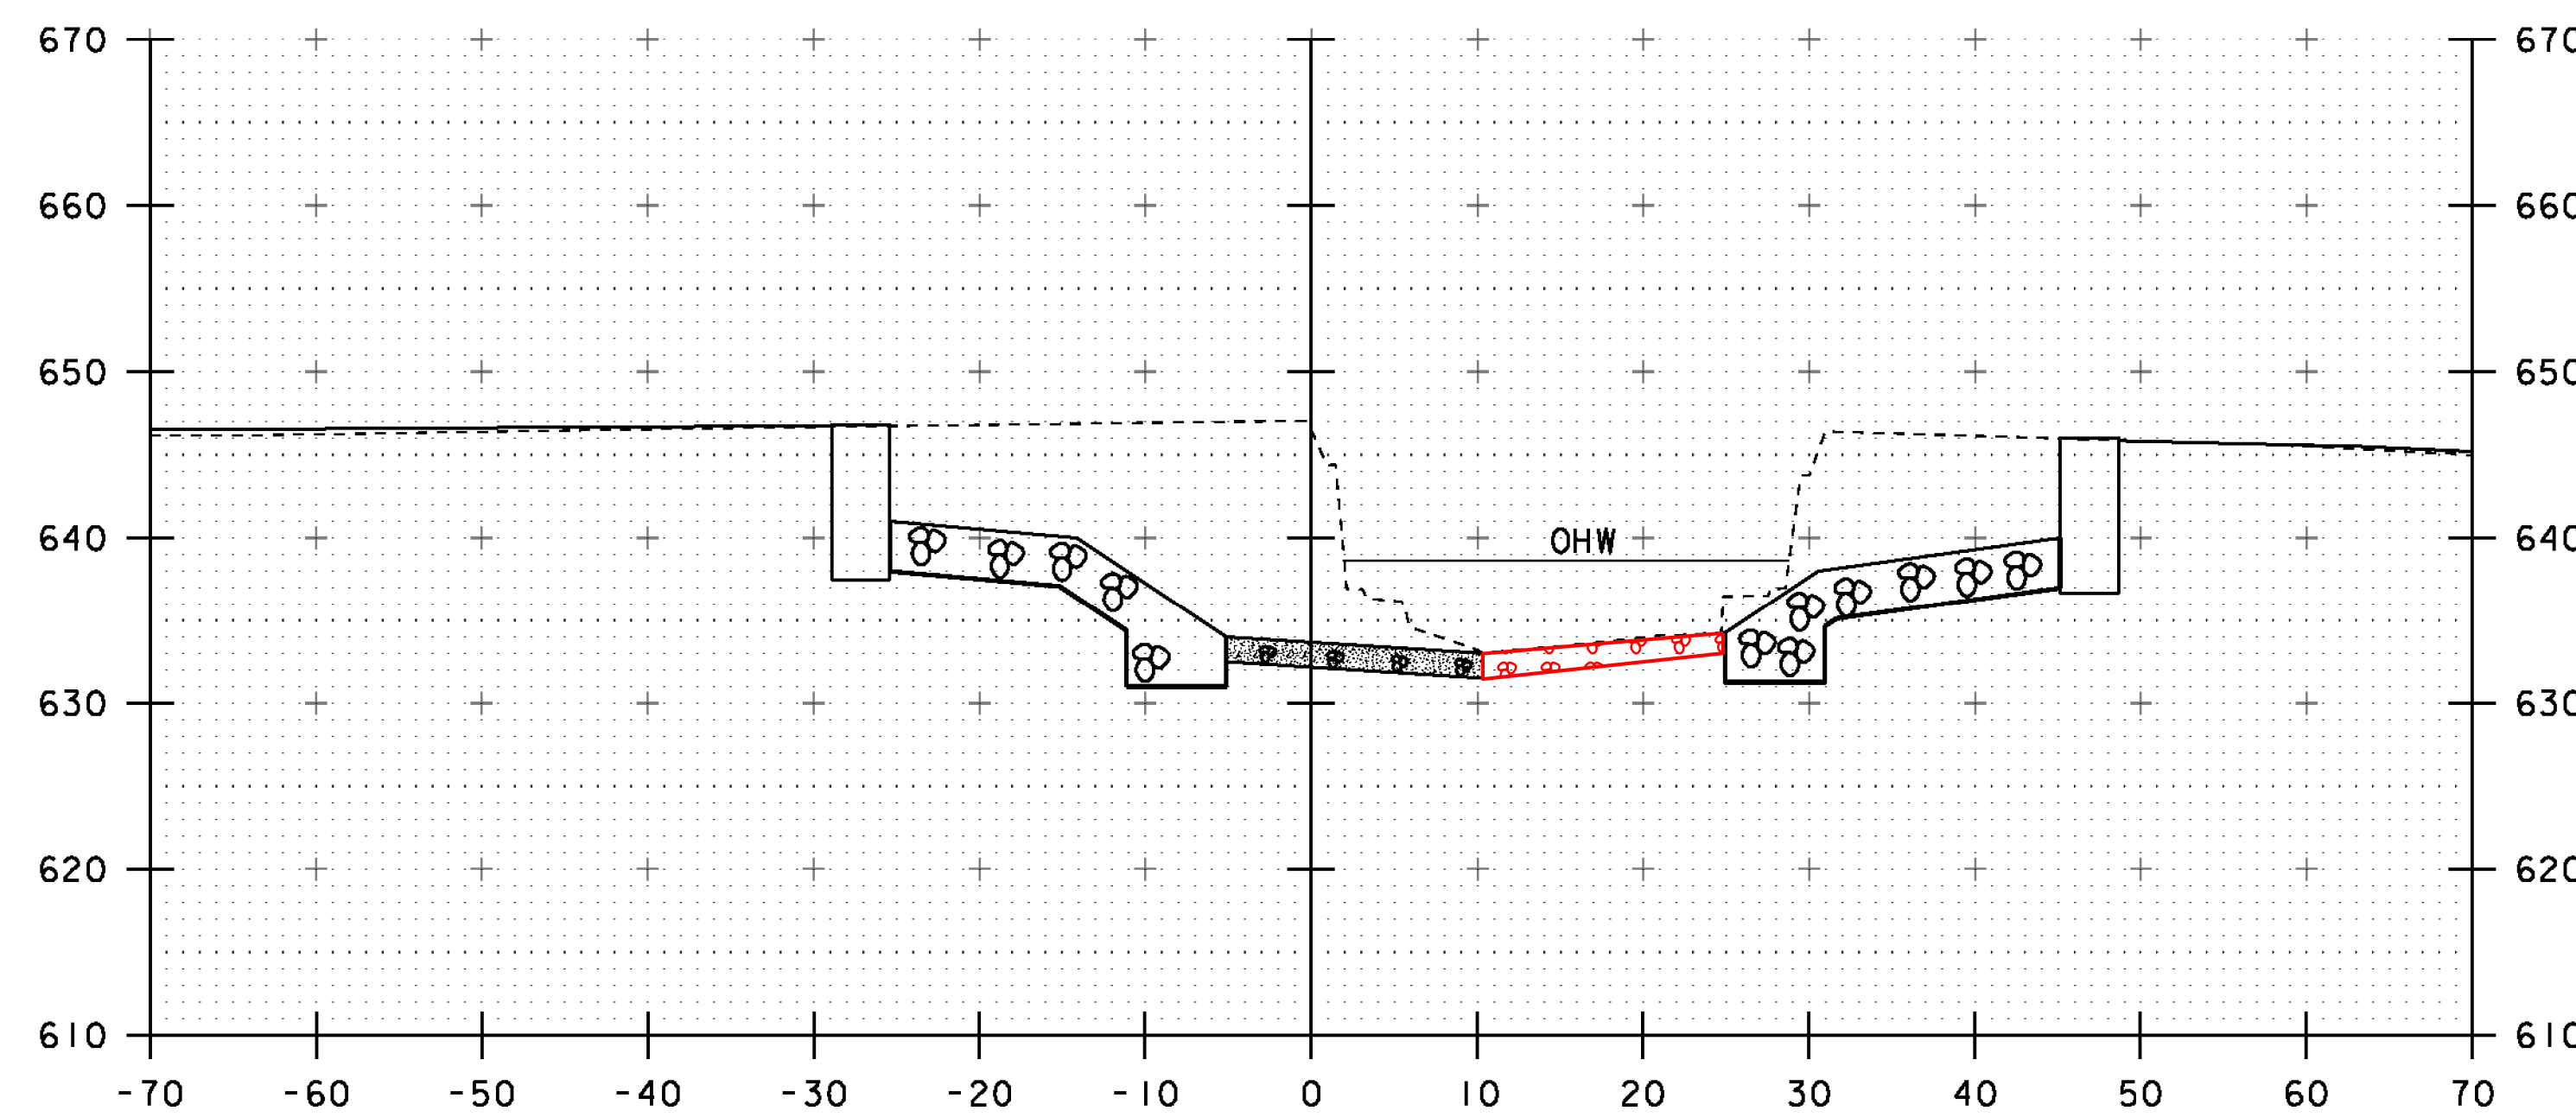

50+80 STA 50+76.77 RT
BEGIN UNCLASSIFIED CHANNEL EXCAVATION
GEOTEXTILE UNDER STONE FILL
STONE FILL, TYPE III
GRUBBING MATERIAL

51+00

STA 50+95.48 RT
END GRUBBING MATERIAL

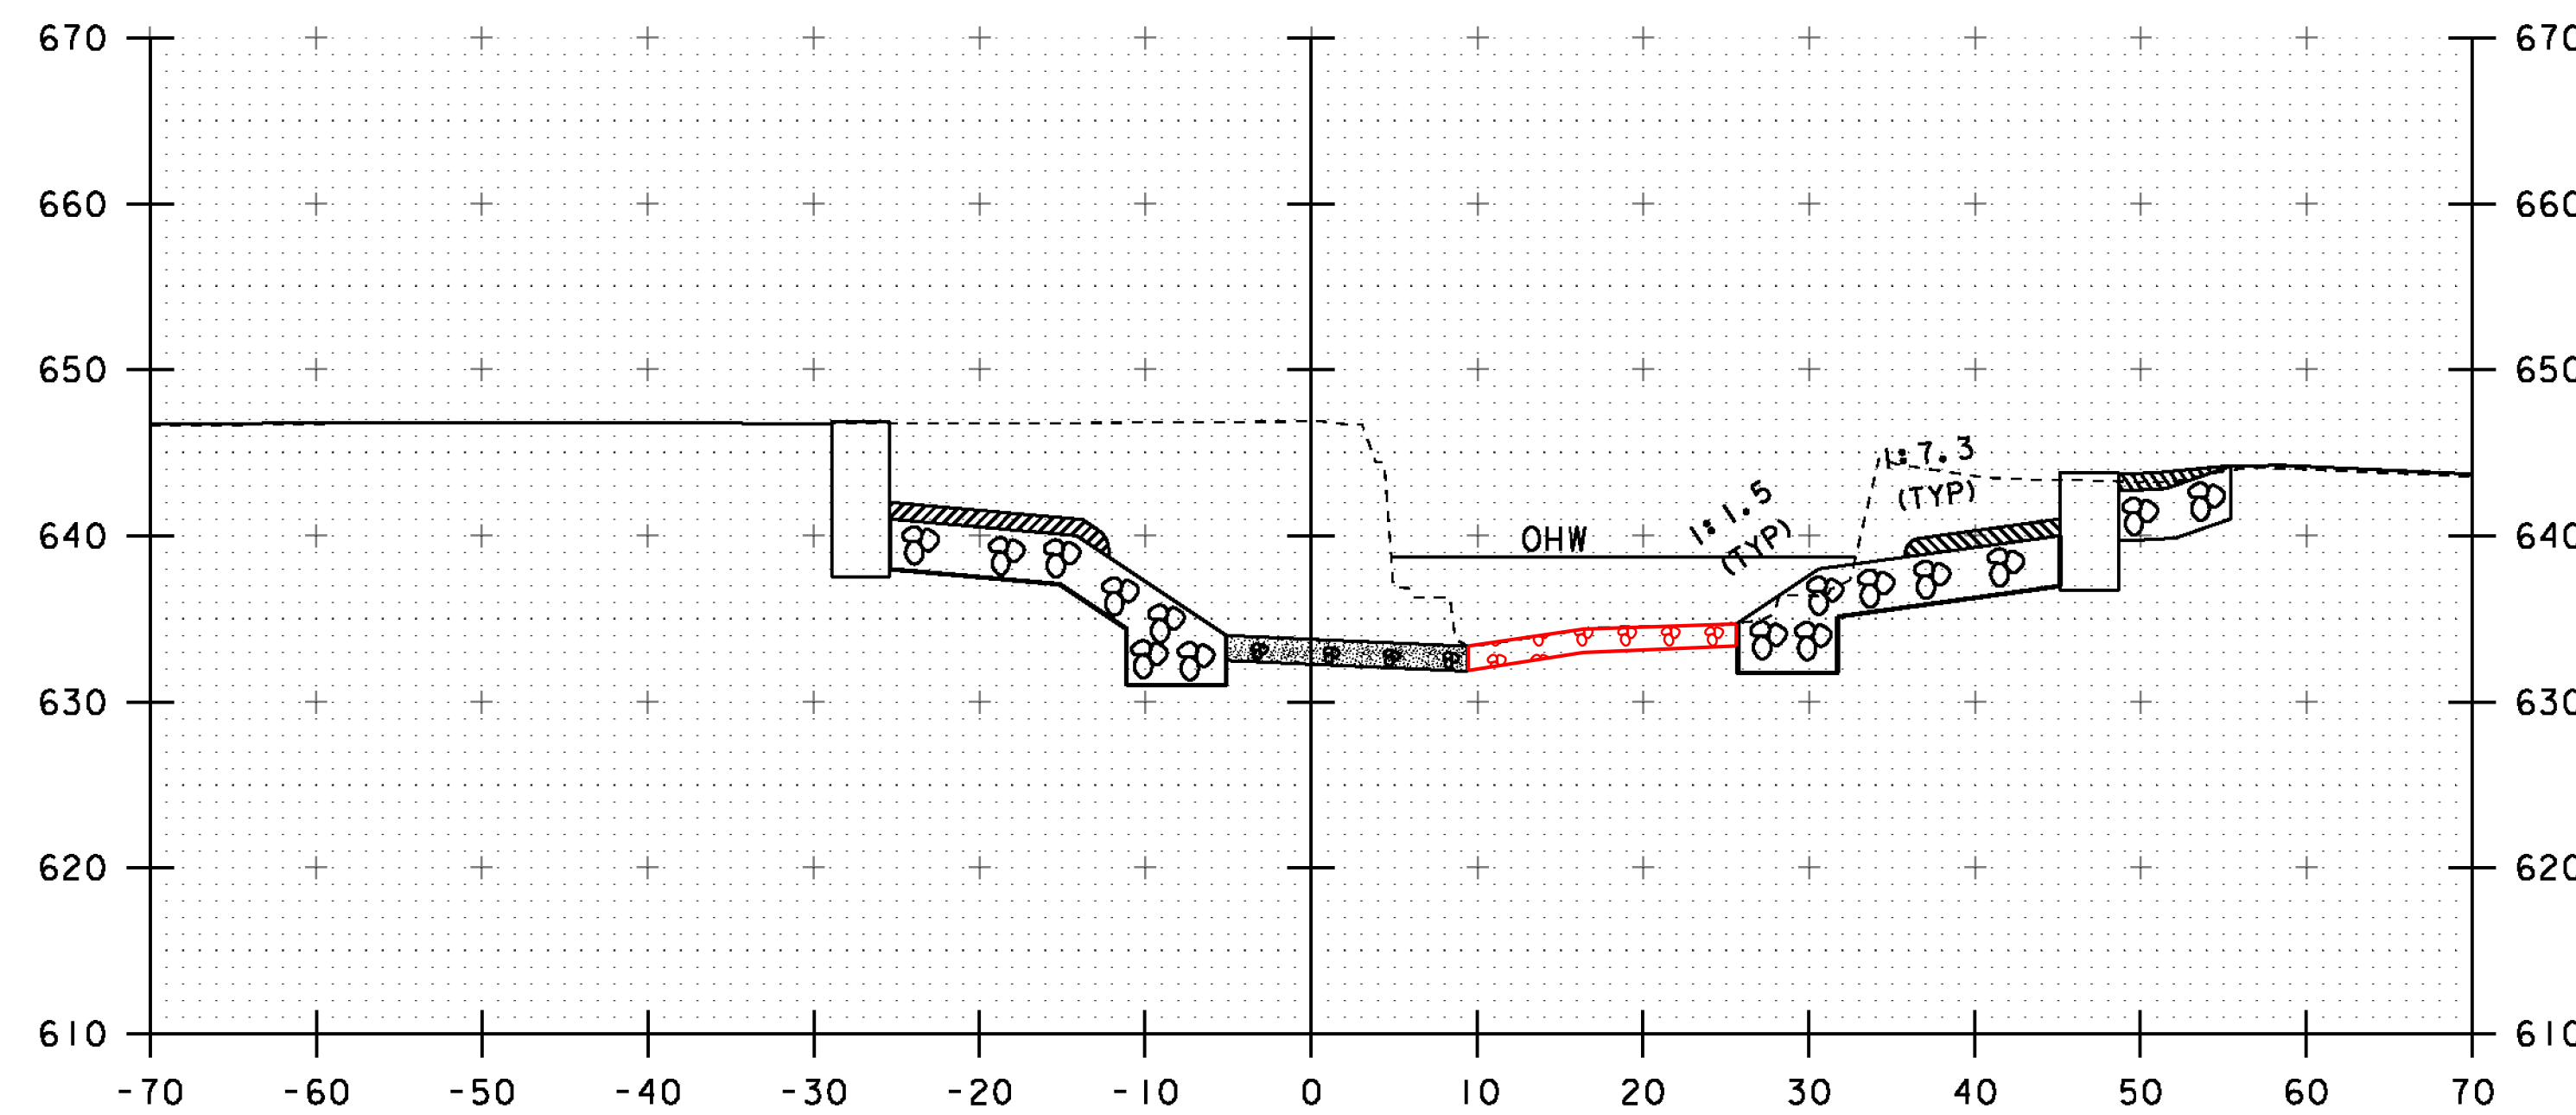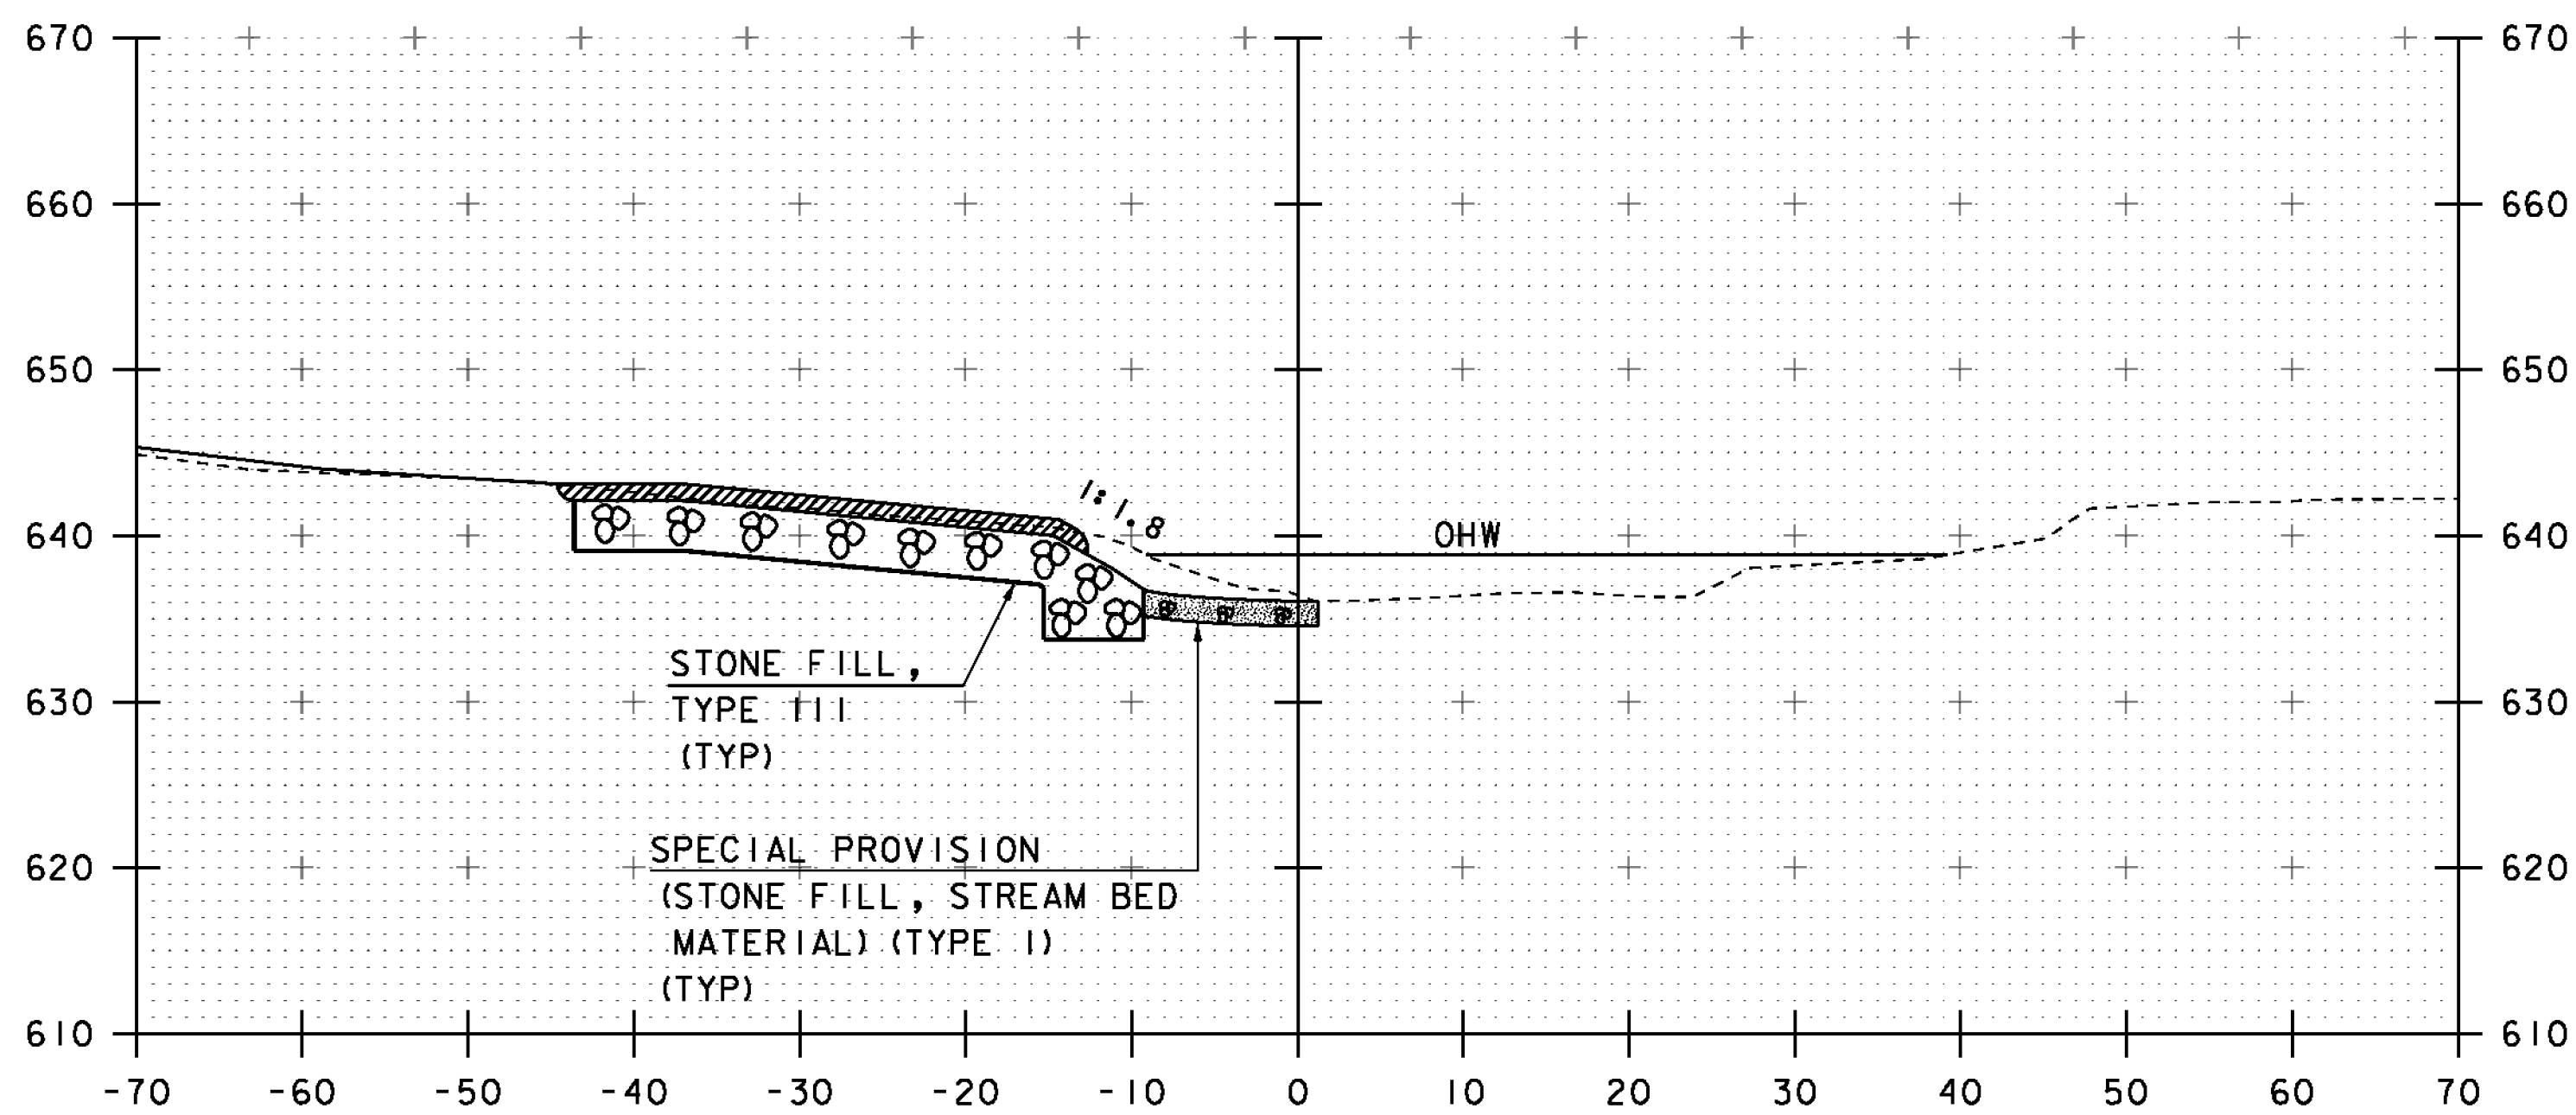

50+70

50+90

STA. 50+70 TO STA. 51+00

PROJECT NAME: CLARENDON
PROJECT NUMBER: BRO 1443(48)

FILE NAME: s12j160xs.dgn
PROJECT LEADER: K. HIGGINS
DESIGNED BY: J. GRIGAS
CHANNEL CROSS SECTIONS 2

PLOT DATE: 10-SEP-2015
DRAWN BY: J. GRIGAS
CHECKED BY: G. LAROCHE
SHEET 55 OF 59