



STA 51+50.25 RT
 END SPECIAL PROVISION (STONE FILL, STREAM BED MATERIAL) (TYPE I)

51+75

STA 51+55.75 LT
 END UNCLASSIFIED CHANNEL EXCAVATION
 GEOTEXTILE UNDER STONE FILL
 STONE FILL, TYPE III
 GRUBBING MATERIAL

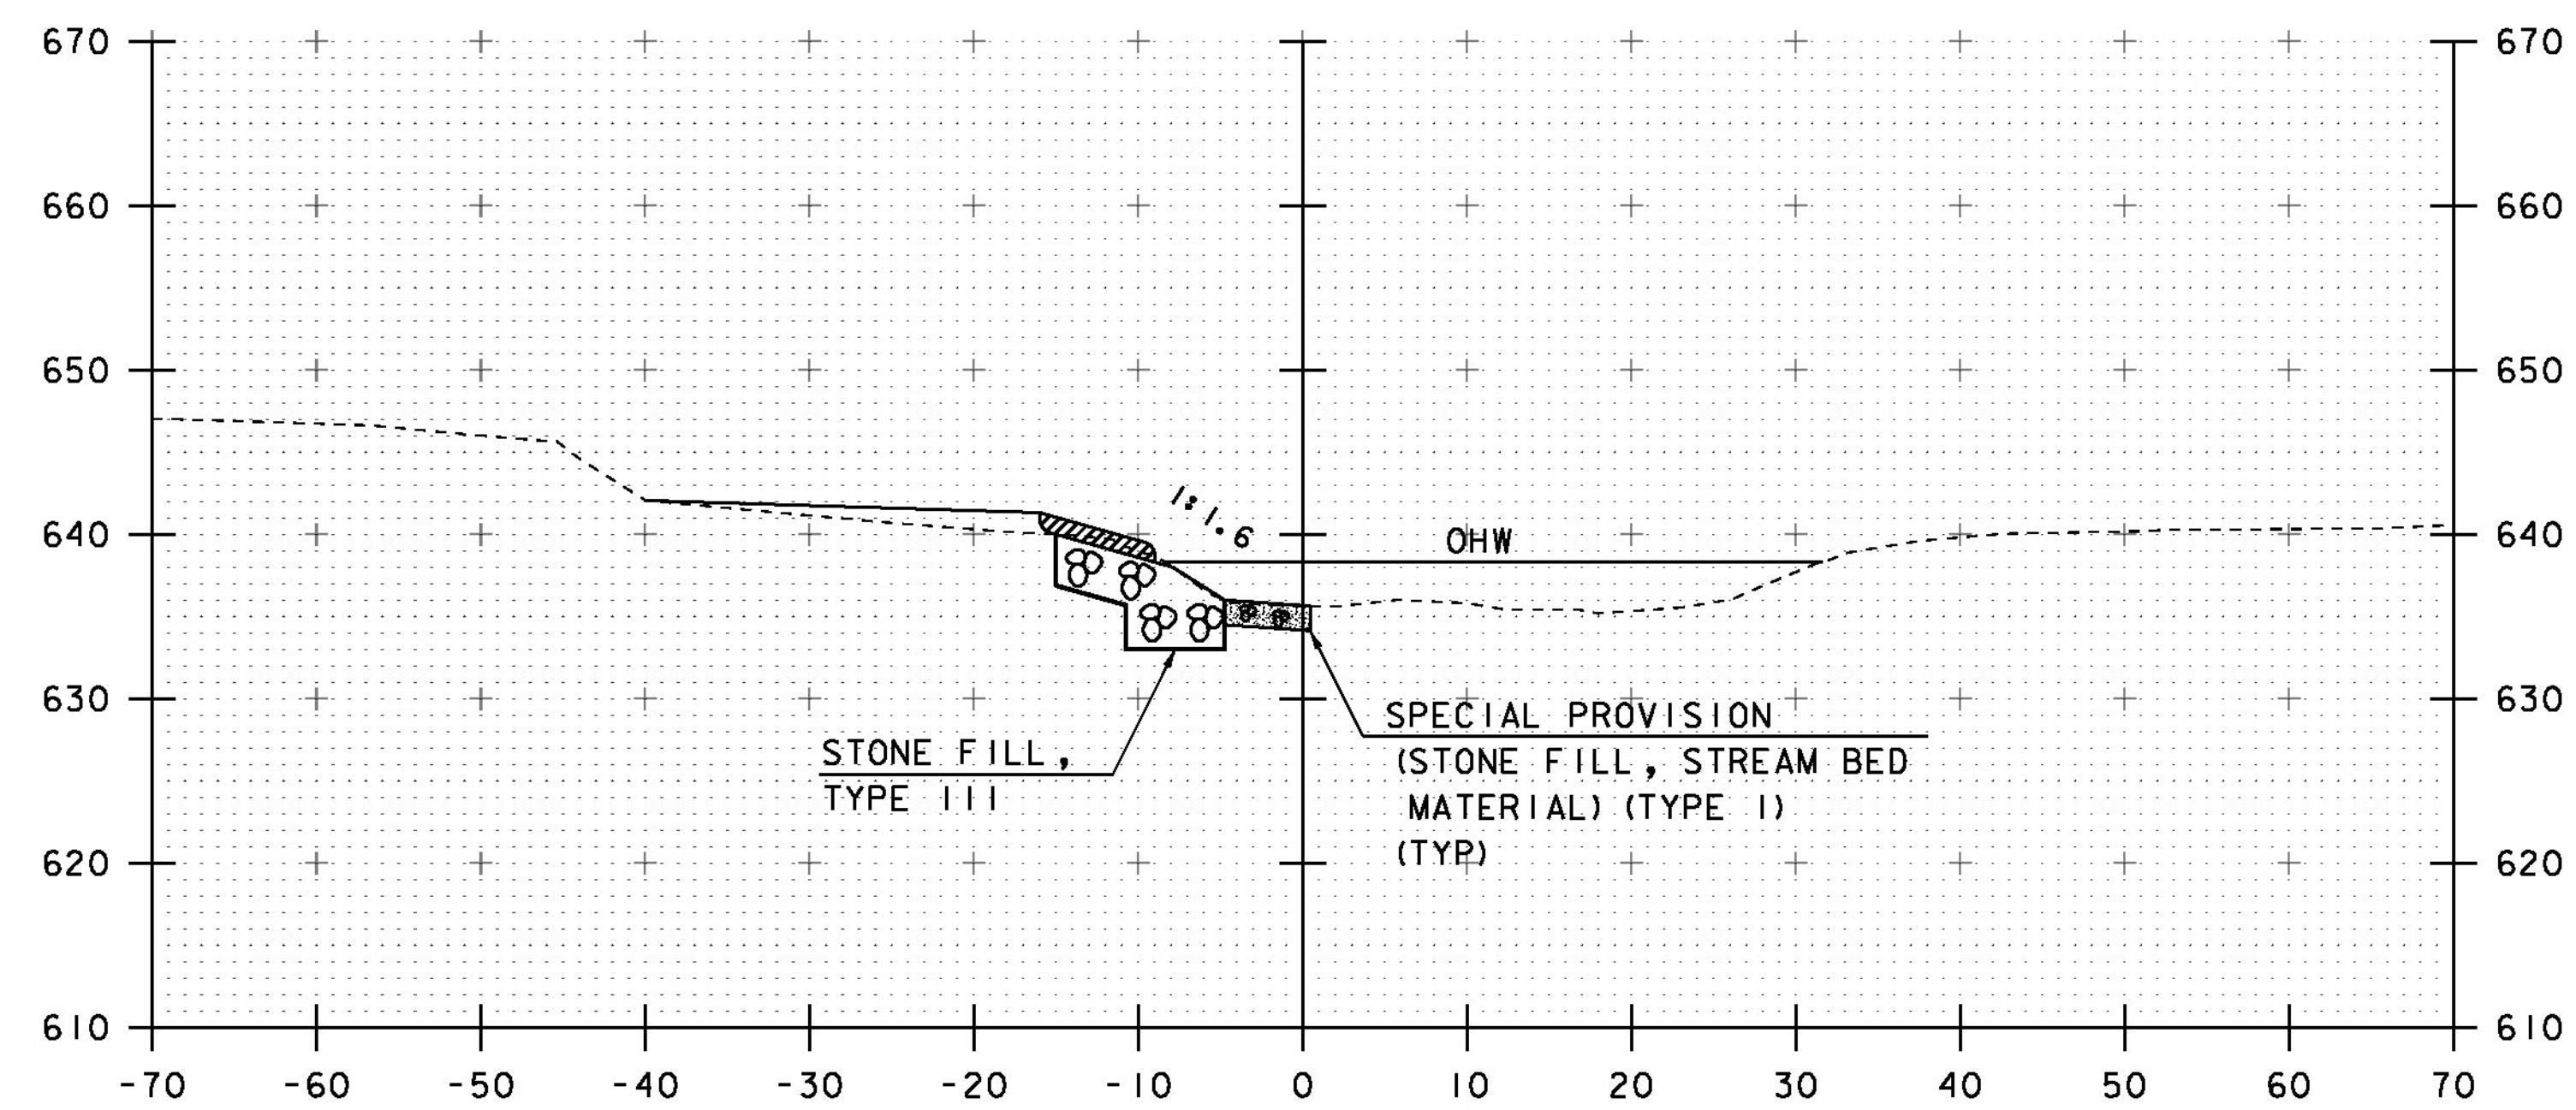

51+50

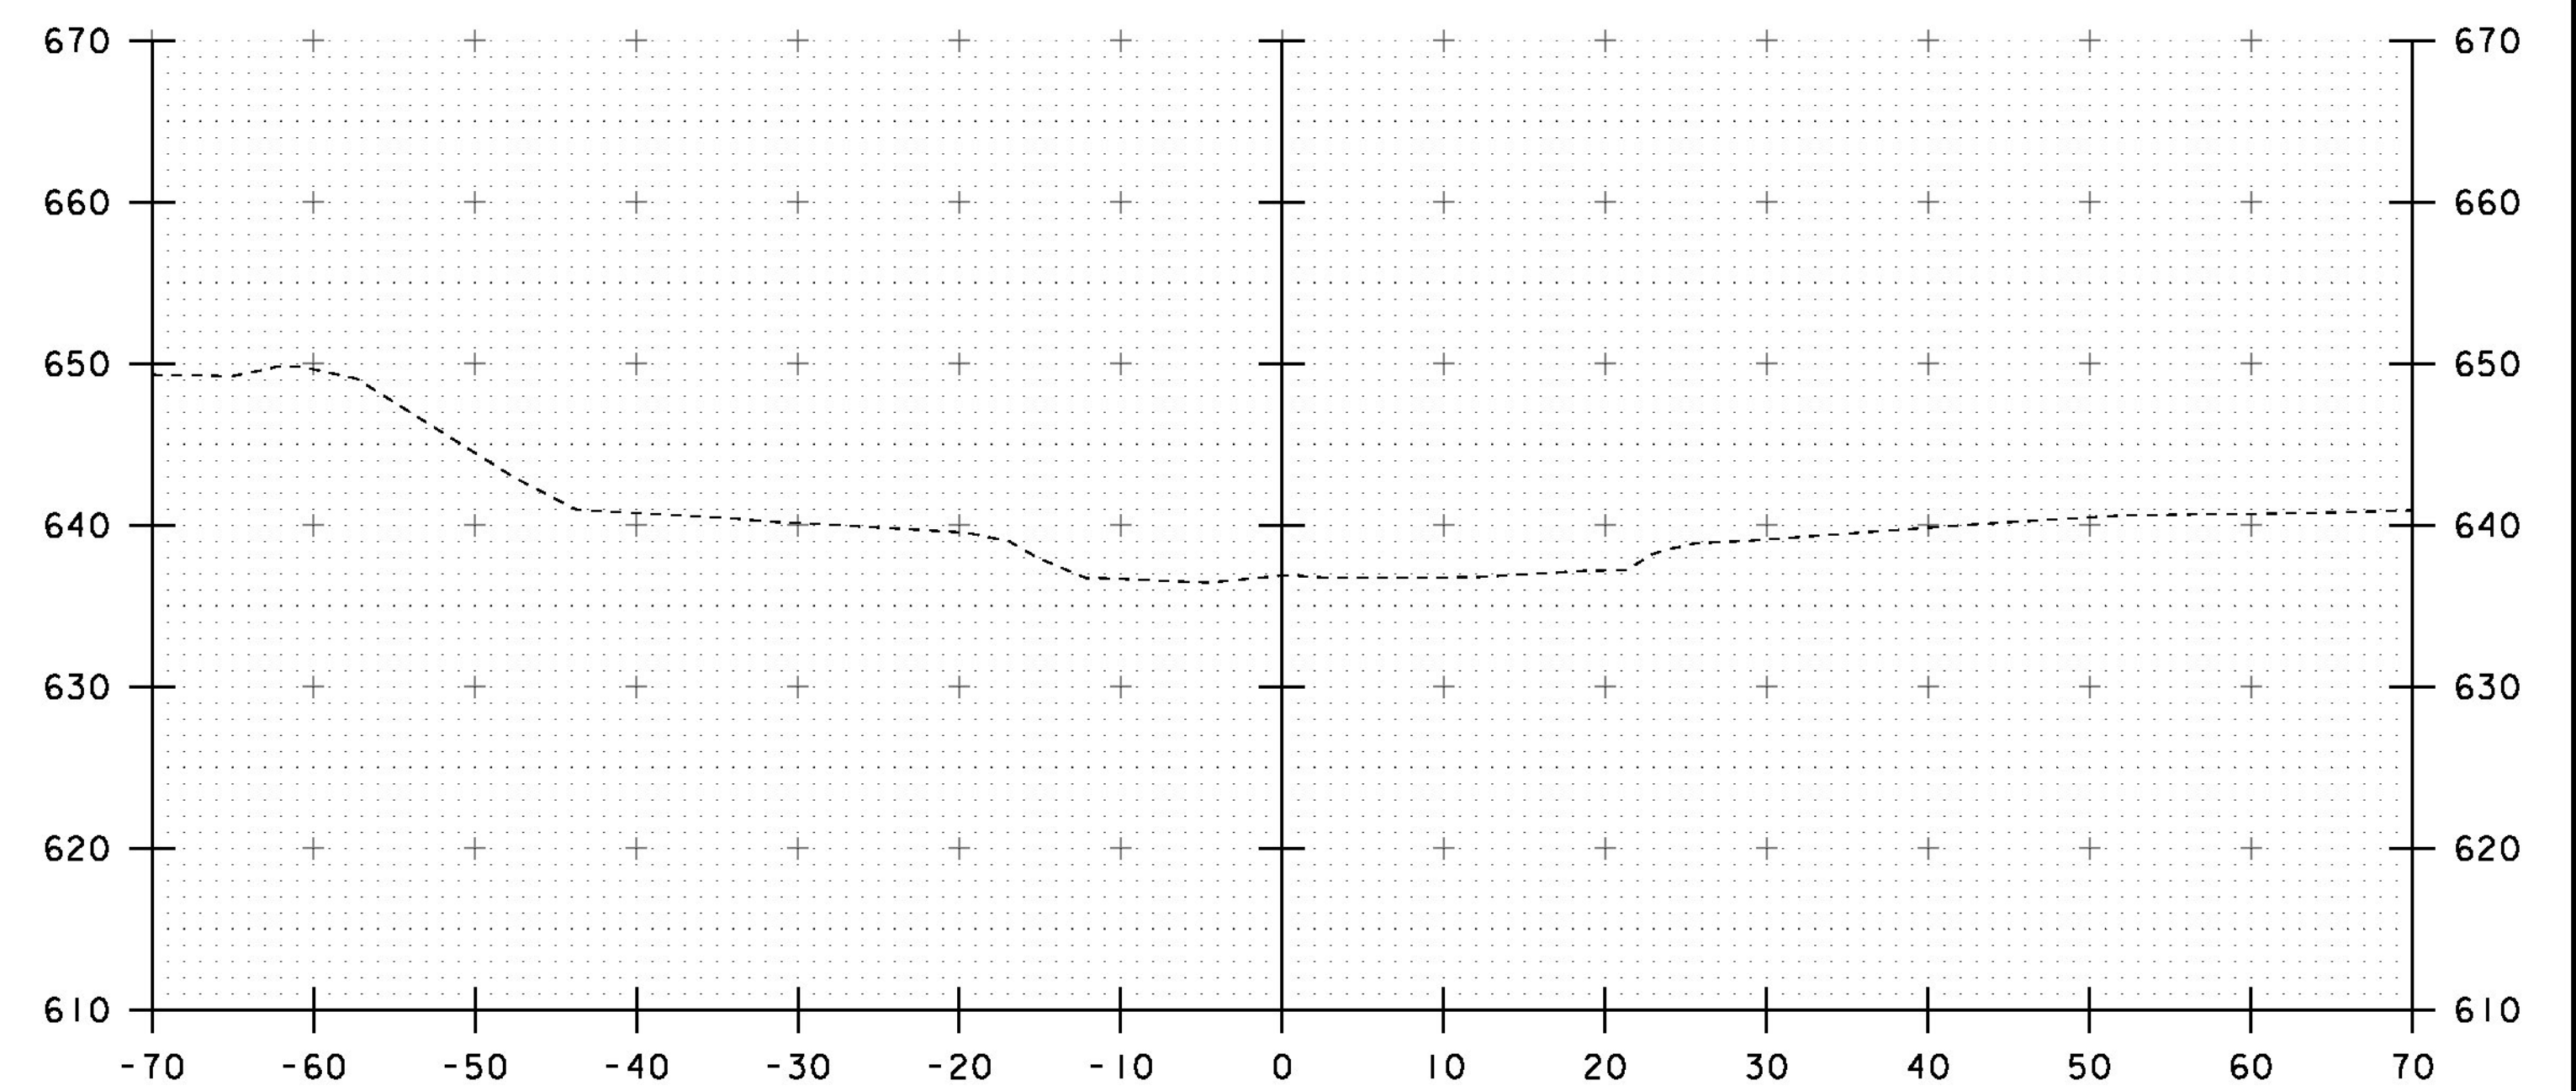

52+00

PROJECT NAME: CLARENDON
 PROJECT NUMBER: BRO 1443(48)

FILE NAME: s12j160xs.dgn
 PROJECT LEADER: K. HIGGINS
 DESIGNED BY: J. GRIGAS
 CHANNEL CROSS SECTIONS 4

PLOT DATE: 10-SEP-2015
 DRAWN BY: J. GRIGAS
 CHECKED BY: G. LAROCHE
 SHEET 57 OF 59

STA. 51+50 TO STA. 52+00