




C-401D
#4 BENT BAR
LEVEL II (DUAL COATED)
USE 2" ϕ (50 mm) PIN
(312) REQ'D.

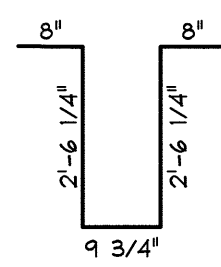


C-402D
#4 BENT BAR
LEVEL II (DUAL COATED)
USE 2" ϕ (50 mm) PIN
(318) REQ'D.

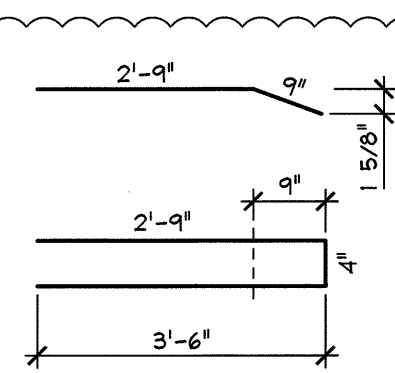


C-403D
#4 BENT BAR
LEVEL II (DUAL COATED)
USE 2" ϕ (50 mm) PIN
(164) REQ'D.

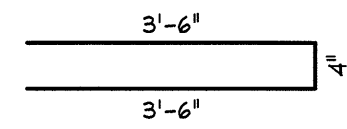


C-404D
#4 BENT BAR
LEVEL II (DUAL COATED)
USE 2" ϕ (50 mm) PIN
(417) REQ'D.

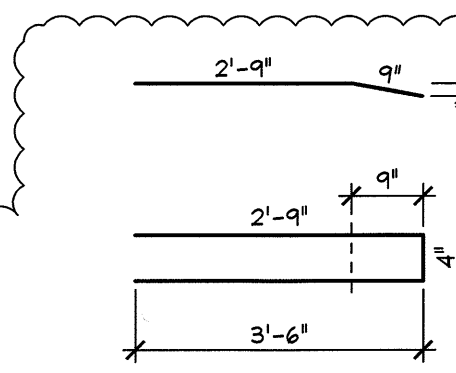

C-405D
#4 BENT BAR
LEVEL II (DUAL COATED)
USE 2" ϕ (50 mm) PIN
(6) REQ'D.

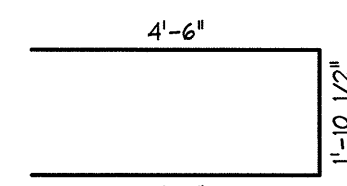


C-501D
#5 BENT BAR
LEVEL II (DUAL COATED)
USE 2 3/4" ϕ (70 mm) PIN
(48) REQ'D.

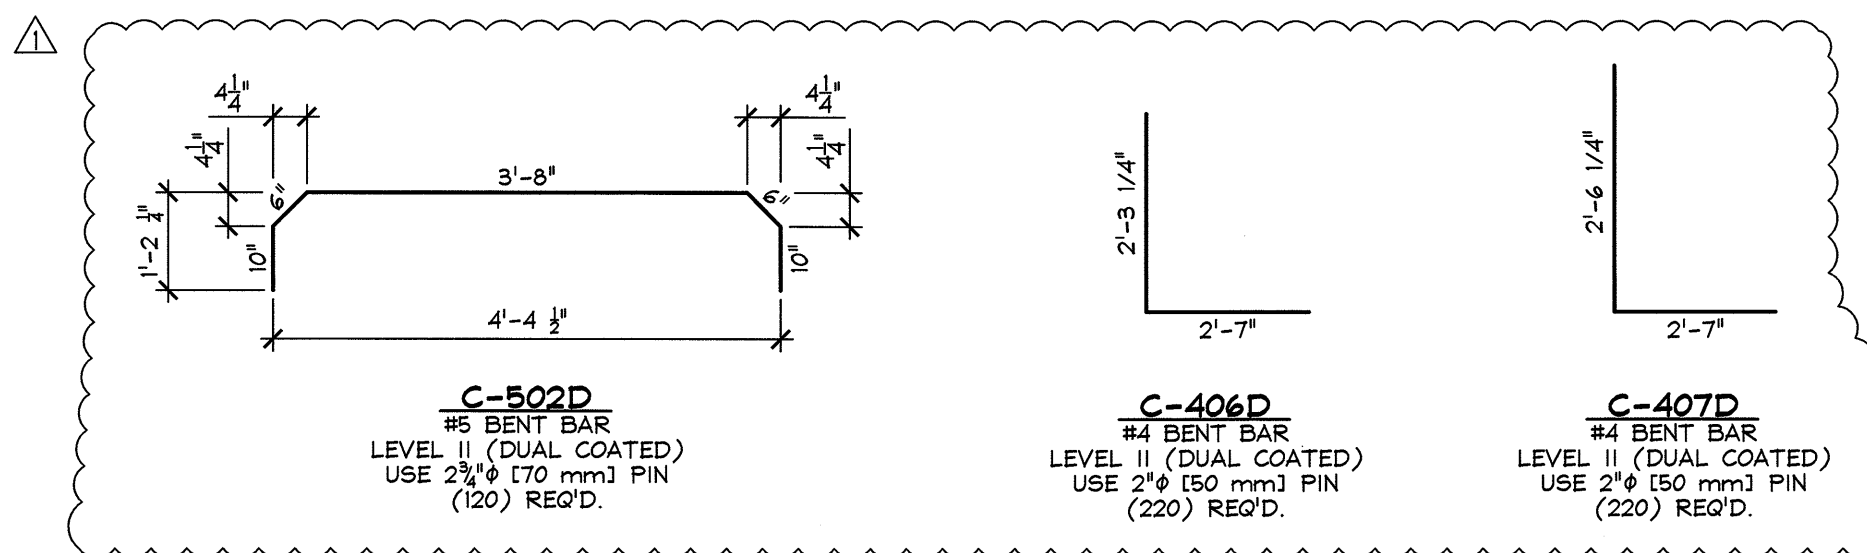


C-502D
#5 BENT BAR
LEVEL II (DUAL COATED)
USE 2 3/4" ϕ (70 mm) PIN
(220) REQ'D.

C-406D
#4 BENT BAR
LEVEL II (DUAL COATED)
USE 2" ϕ (50 mm) PIN
(220) REQ'D.

C-407D
#4 BENT BAR
LEVEL II (DUAL COATED)
USE 2" ϕ (50 mm) PIN
(220) REQ'D.

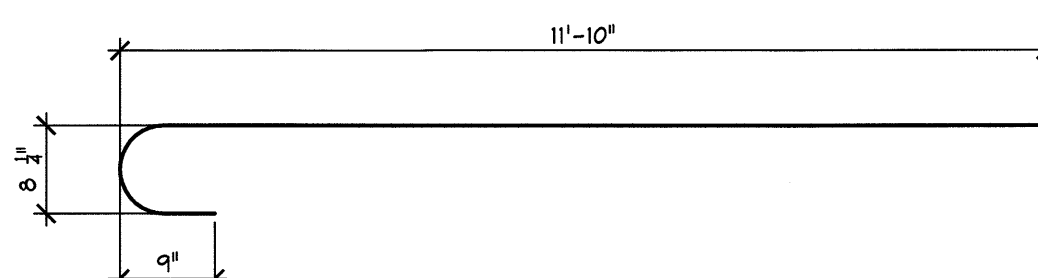


C-801D
#8 BENT BAR
LEVEL II (DUAL COATED)
USE 6" ϕ (152 mm) PIN
(84) REQ'D.

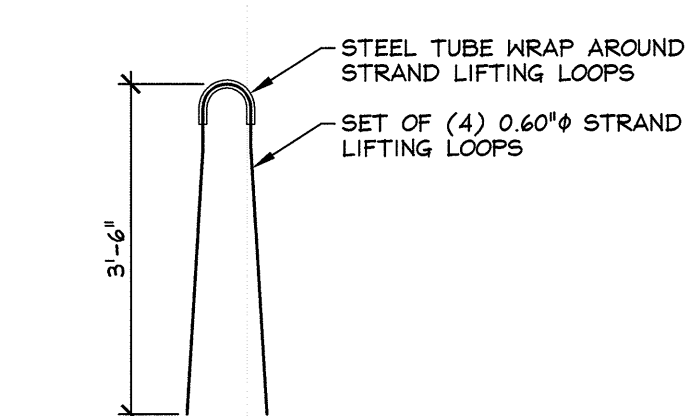


MK-CL3
N.T.S.

MISCELLANEOUS MATERIALS				
ITEM	MARK	QTY.	DESCRIPTION	REMARKS
1	MK-CL1	38	DAYTON C-24 TYPE 4-APR DECK FORM HANGER (GALV.)	DOMESTIC ORIGIN (BUY AMERICAN)
2	MK-CL2	76	1/2" ϕ x 3" B16 COIL LOOP INSERT (GALV.)	DOMESTIC ORIGIN (BUY AMERICAN)
3	MK-CL3	12	SET OF (4) 0.60" ϕ STRAND LIFTING LOOPS x 3'-6" LONG	
4	C-401D	312	#4 BENT BAR (LEVEL II, DUAL COATED)	
5	C-402D	324	#4 BENT BAR (LEVEL II, DUAL COATED)	
6	C-403D	125	#4 BENT BAR (LEVEL II, DUAL COATED)	
7	C-404D	417	#4 BENT BAR (LEVEL II, DUAL COATED)	
8	C-405D	8	#4 BENT BAR (LEVEL II, DUAL COATED)	
9	C-406D	220	#4 BENT BAR (LEVEL II, DUAL COATED)	
10	C-407D	220	#4 BENT BAR (LEVEL II, DUAL COATED)	
11				
12	C-501D	48	#5 BENT BAR (LEVEL II, DUAL COATED)	
13	C-502D	120	#5 BENT BAR (LEVEL II, DUAL COATED)	
14				
15	C-801D	84	#8 BENT BAR (LEVEL II, DUAL COATED)	
16		2	#8 x 2'-6" (LEVEL II, DUAL COATED)	SAMPLES
17		(60)	#4 x 7'-5 1/2" (LEVEL II, DUAL COATED)	
18		252	#5 x 7'-5 1/2" (LEVEL II, DUAL COATED)	
19		12	#5 x 7'-4 1/2" (LEVEL II, DUAL COATED)	
20		12	#5 x 7'-4 1/4" (LEVEL II, DUAL COATED)	
21		37	#5 x 4'-6" (LEVEL II, DUAL COATED)	
22		600	#5 x 7'-4" (LEVEL II, DUAL COATED)	
23		66	#5 x 40'-0" (LEVEL II, DUAL COATED)	
24		66	#5 x 36'-3" (LEVEL II, DUAL COATED)	
25				


PRESTRESSED NEXT BEAMS

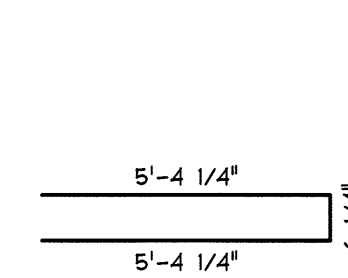


CA-501D
#5 BENT BAR
LEVEL II (DUAL COATED)
USE 2 3/4" ϕ (70 mm) PIN
(52) REQ'D.

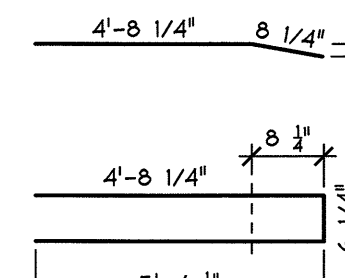


CA-502D
#5 BENT BAR
LEVEL II (DUAL COATED)
USE 2 3/4" ϕ (70 mm) PIN
(2) REQ'D.

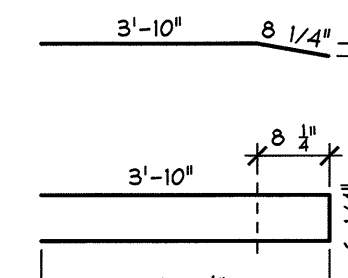


CA-503D
#5 BENT BAR
LEVEL II (DUAL COATED)
USE 2 3/4" ϕ (70 mm) PIN
(6) REQ'D.

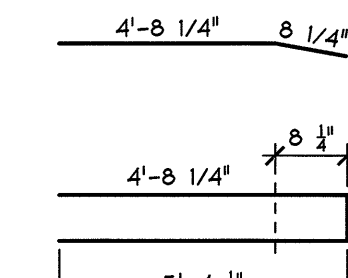

CA-504D
#5 BENT BAR
LEVEL II (DUAL COATED)
USE 2 3/4" ϕ (70 mm) PIN
(2) REQ'D.

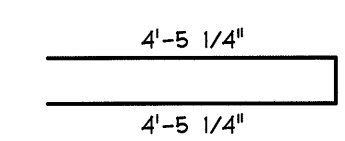

CA-505D
#5 BENT BAR
LEVEL II (DUAL COATED)
USE 2 3/4" ϕ (70 mm) PIN
(104) REQ'D.

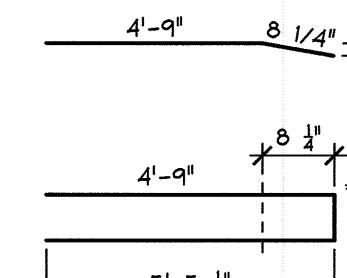

CA-506D
#5 BENT BAR
LEVEL II (DUAL COATED)
USE 2 3/4" ϕ (70 mm) PIN
(2) REQ'D.



CA-601D
#6 BENT BAR
LEVEL II (DUAL COATED)
USE 3 3/4" ϕ (95 mm) PIN
(60) REQ'D.

APPROACH SLABS

MISCELLANEOUS MATERIALS				
ITEM	MARK	QTY.	DESCRIPTION	REMARKS
1	CA-501D	52	#5 BENT BAR (LEVEL II, DUAL COATED)	
2	CA-502D	2	#5 BENT BAR (LEVEL II, DUAL COATED)	
3	CA-503D	8	#5 BENT BAR (LEVEL II, DUAL COATED)	
4	CA-504D	2	#5 BENT BAR (LEVEL II, DUAL COATED)	
5	CA-505D	104	#5 BENT BAR (LEVEL II, DUAL COATED)	
6	CA-506D	(6)	#5 BENT BAR (LEVEL II, DUAL COATED)	
7	CA-601D	60	#6 BENT BAR (LEVEL II, DUAL COATED)	
8				
9				
10		48	#6 x 14'-6" (LEVEL II, DUAL COATED)	
11		4	#5 x 4'-5" (LEVEL II, DUAL COATED)	
12		8	#5 x 4'-6" (LEVEL II, DUAL COATED)	
13		4	#5 x 3'-0" (LEVEL II, DUAL COATED)	
14				
15		2	#6 x 2'-6" (LEVEL II, DUAL COATED)	SAMPLES
16				
17				
18		32	DAYTON 2T x 6" SWIFT LIFT	DOMESTIC ORIGIN (BUY AMERICAN)
19				
20				

3/11/16 REVISED AS PER ENGINEERS COMMENT. T.D.

APPROVAL STAMP:
Vermont Agency of Transportation
RECEIVED
 CK'D BY SC, TM OK'D BY G. Laroche
 March 18, 2016
 RESUBMIT No Approved
 BY K. Higgins DATE 3/28/2016

J.P. CARRARA & SONS INC.
 Precast & Prestress Manufacturer
 2464 GASE STR., MIDDLEBURY, VERMONT 05753 Phone: (802)388-6361 Fax: (802)388-9010

J.A. McDonald, Inc.
 CONTRACTOR
 LYNDON CENTER, VERMONT

STATE OF VERMONT AGENCY OF TRANSPORTATION
 COUNTY OF RUTLAND

TOWN OF CLARENDON
 WALKER MOUNTAIN ROAD, TH #3, RURAL COLLECTOR
 BRIDGE NO.: 11 PROJECT NO.: BRO 1449(48)

MATERIALS LIST
 NEXT BEAMS & APPROACH SLABS

DATE: JAN. 8, 2016
 SCALE: NOTED
 CHKD: DFTM: T.D.
 JOB NO: 23476-015
 DWG. NO: M1