


STATE OF VERMONT AGENCY OF TRANSPORTATION

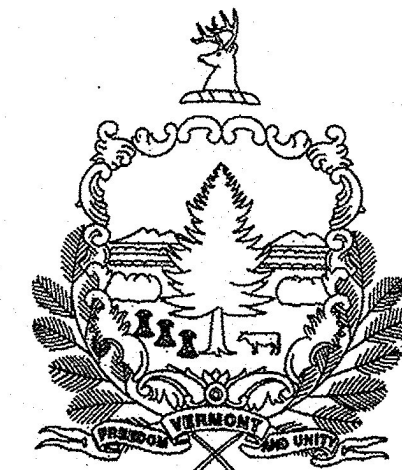

PROPOSED IMPROVEMENT BRIDGE PROJECT


TOWN OF HUNTINGTON
COUNTY OF CHITTENDEN

ROUTE NO : TOWN HIGHWAY 22, CLASS 3 (CAMELS HUMP ROAD) BRIDGE NO : 30


PROJECT LOCATION: 1.4 MILES EAST OF JUNCTION WITH TOWN HIGHWAY 4 (TAFT ROAD) (CLASS 3)

PROJECT DESCRIPTION: REPLACEMENT OF EXISTING BRIDGE WITH A NEW BRIDGE ON A NEW ALIGNMENT, WITH RELATED CHANNEL AND ROADWAY WORK.

LENGTH OF STRUCTURE: 42.00 FEET
LENGTH OF ROADWAY: 308.00 FEET
LENGTH OF PROJECT: 350.00 FEET

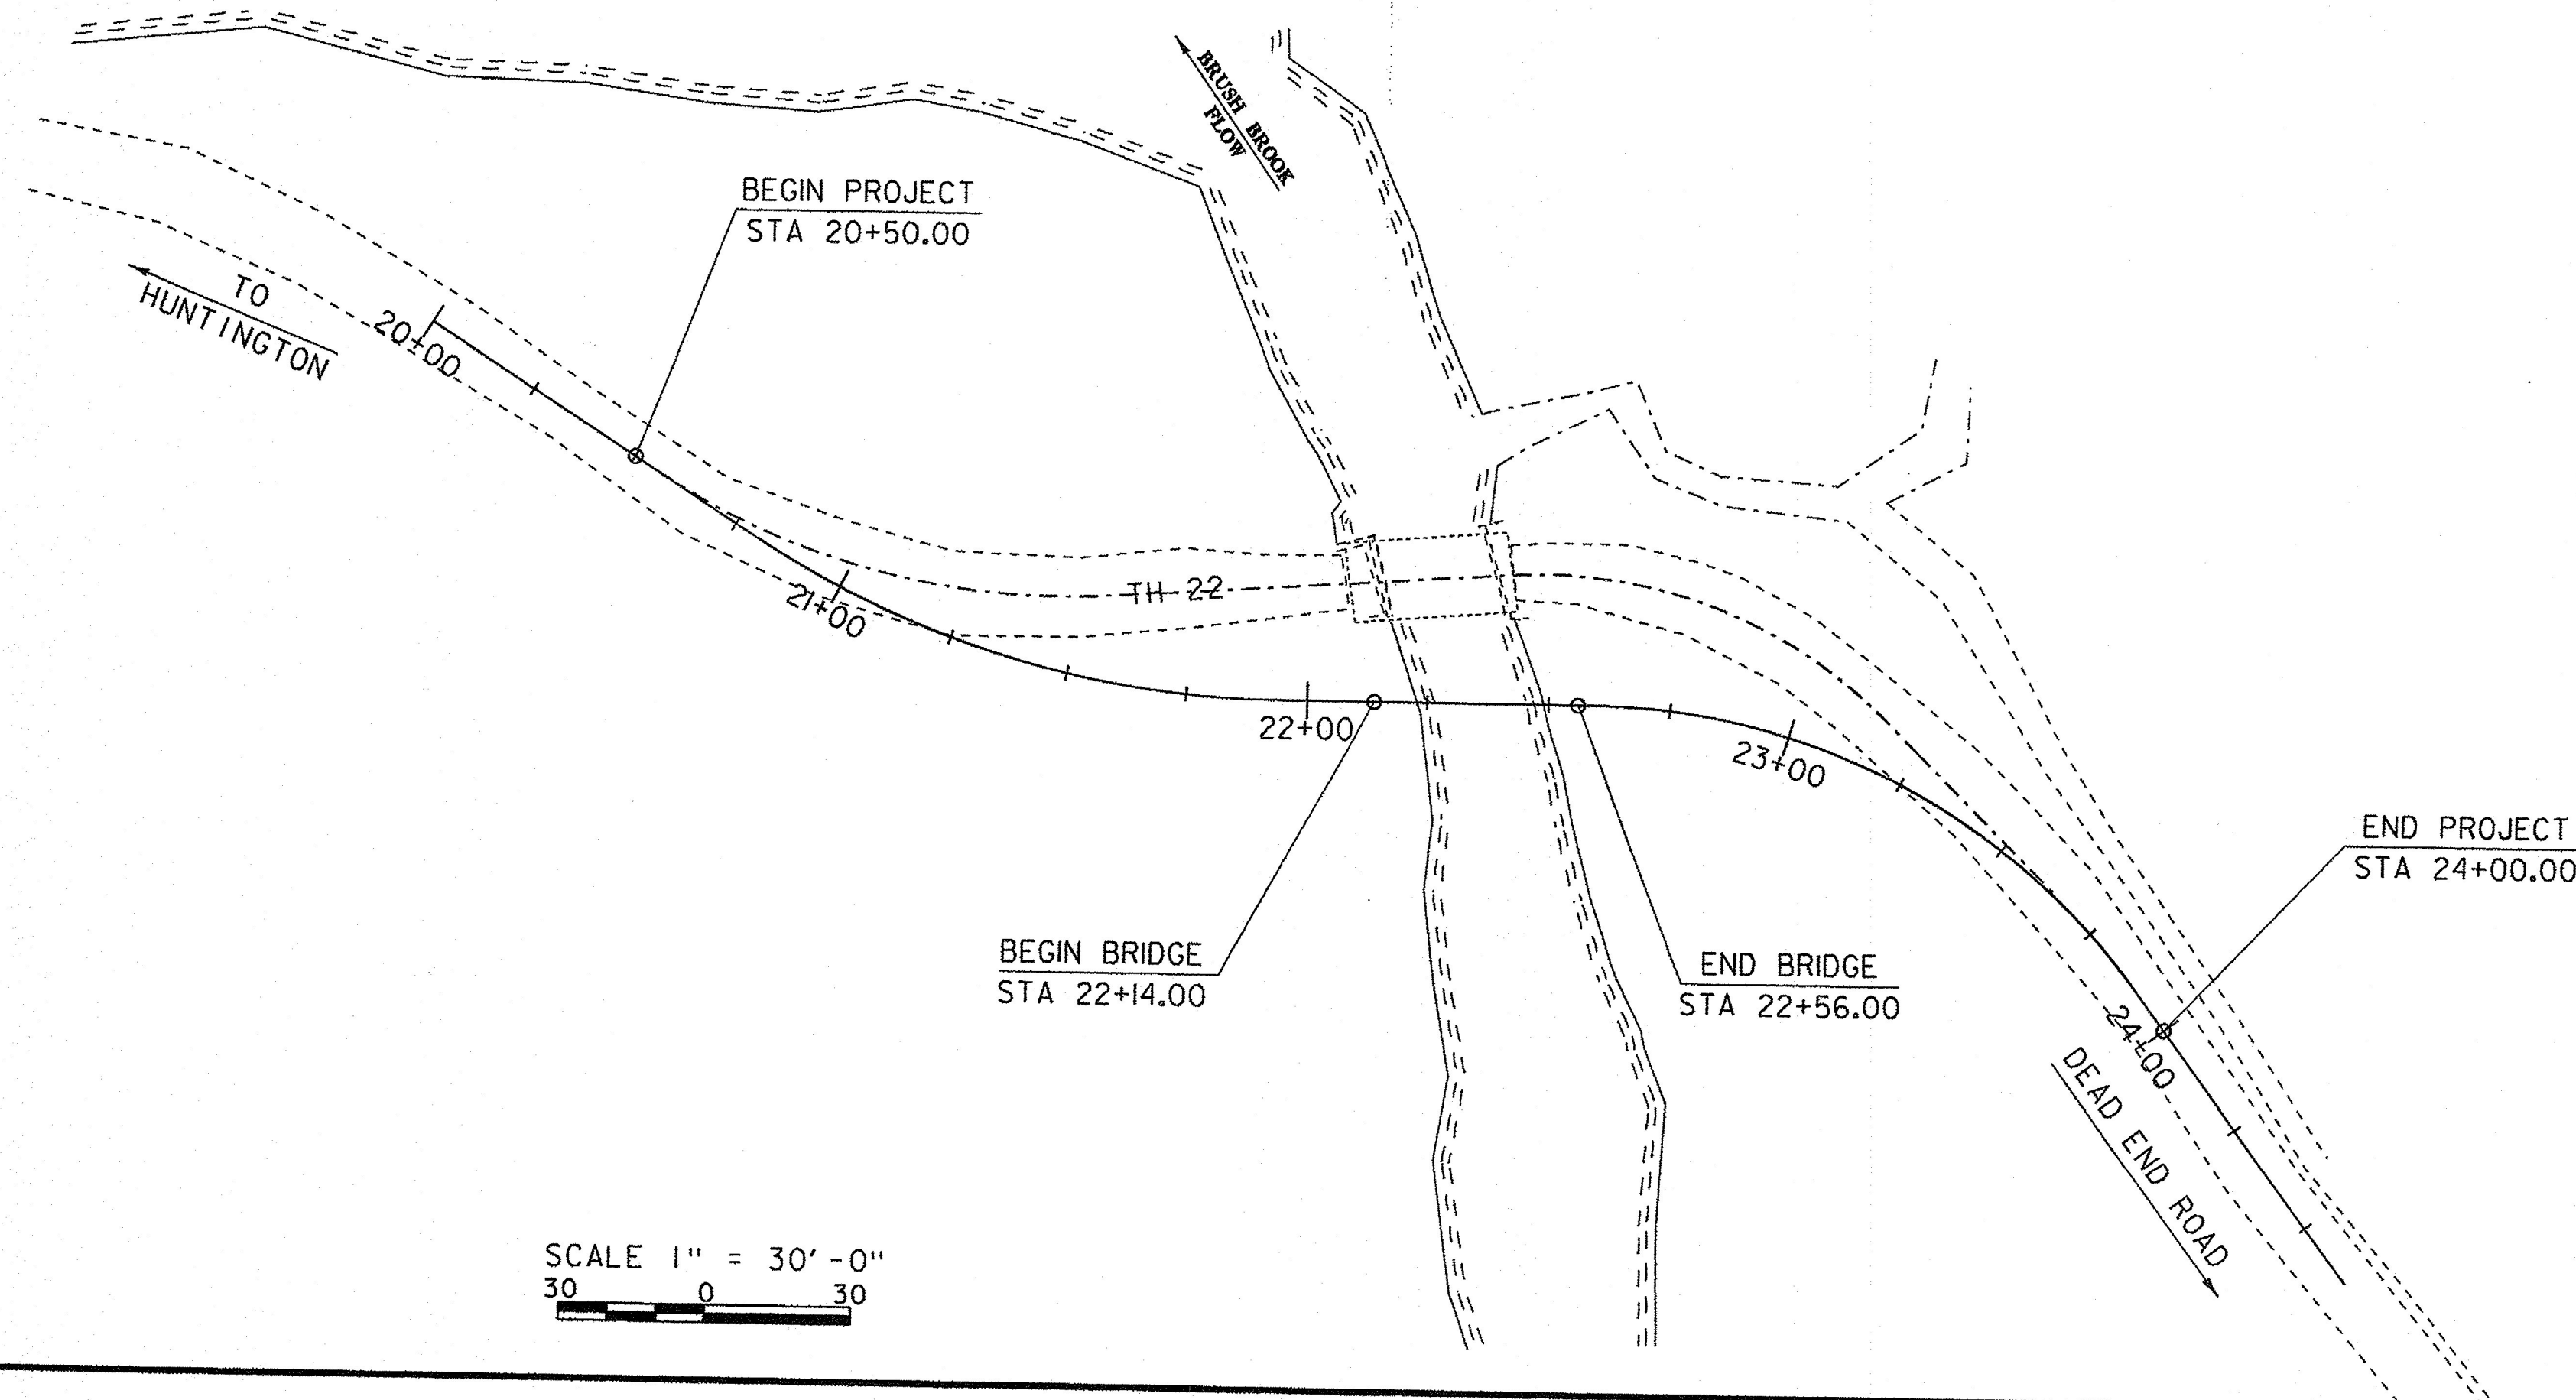

SCALE 1" = 30'-0"
30 0 30

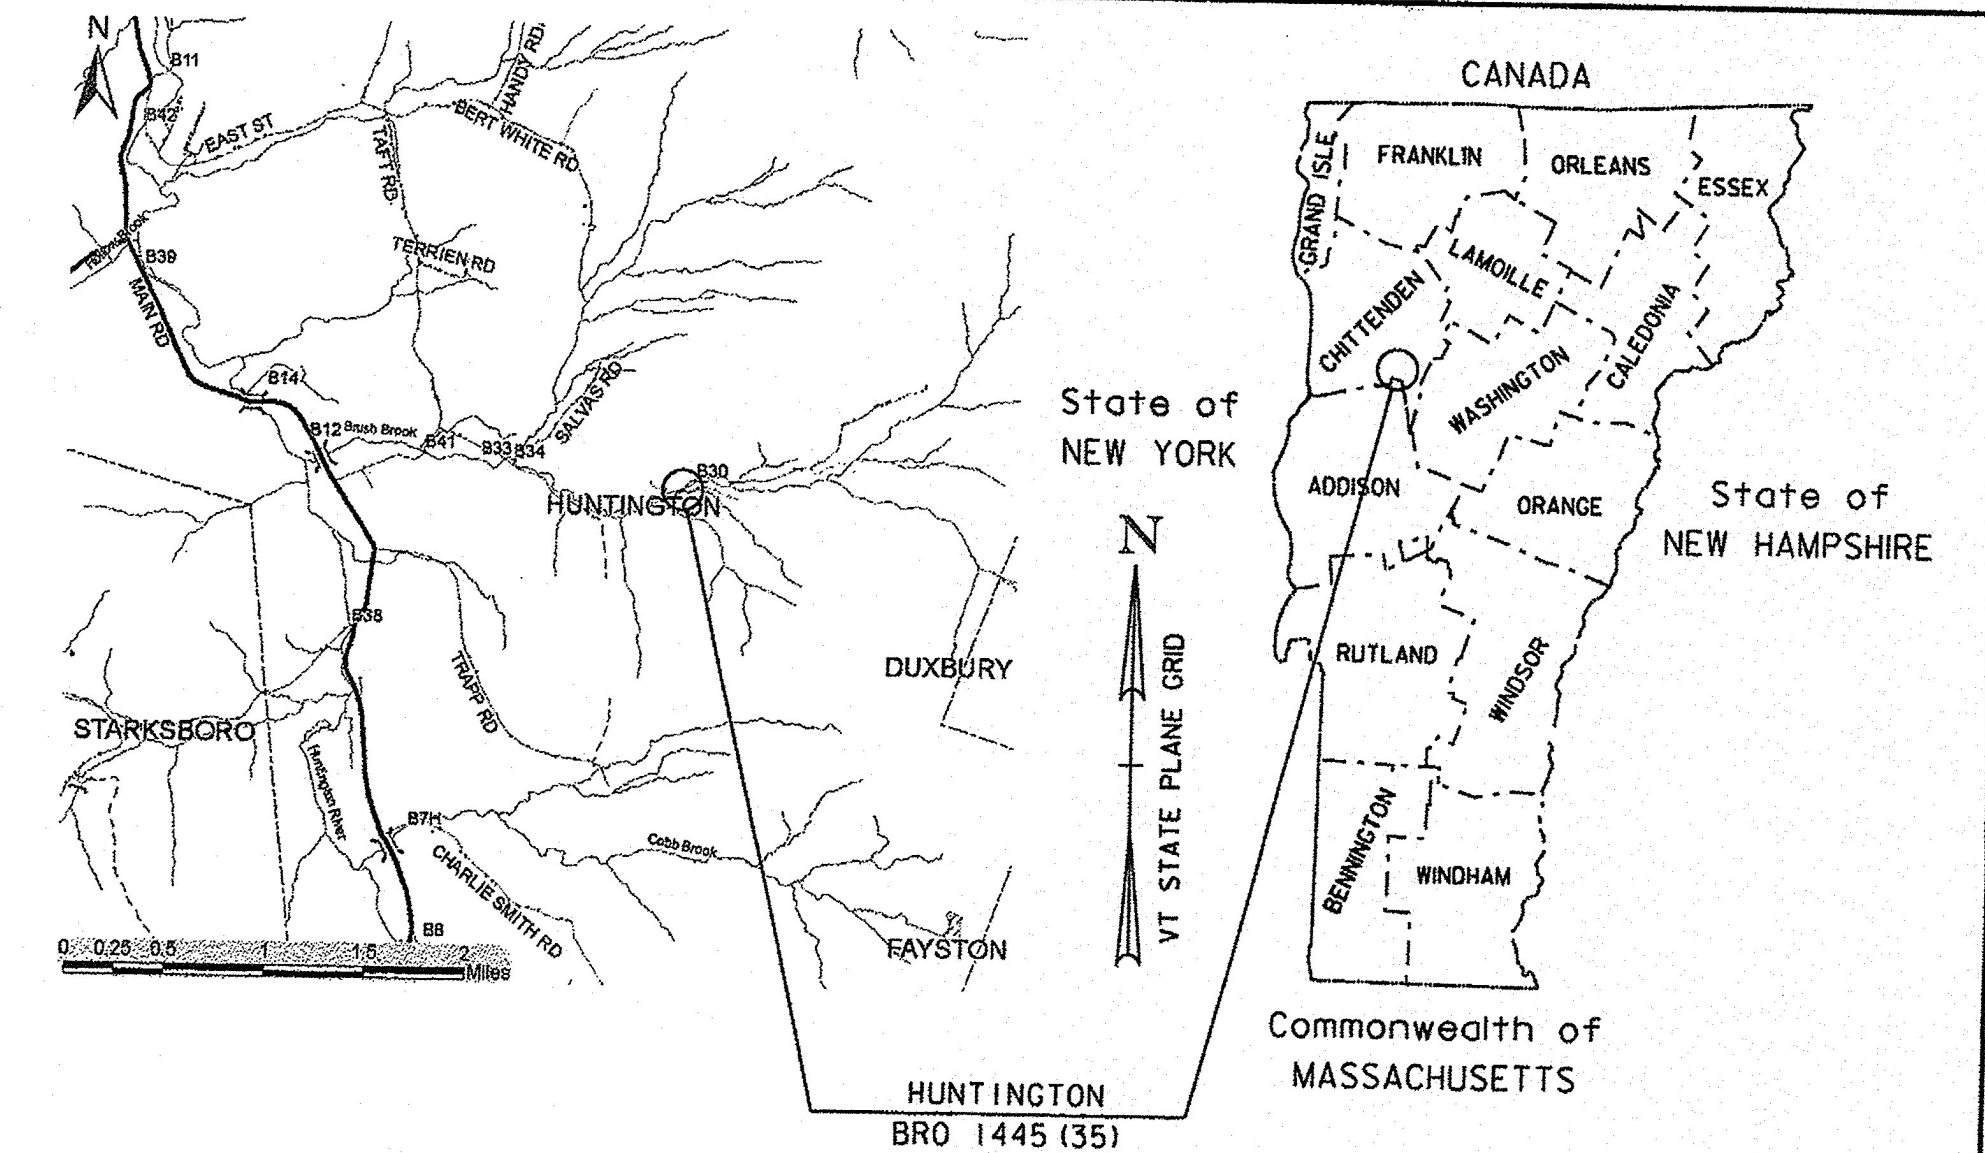

RECORD PLANS	
CONTRACTOR:	PARENT CONSTRUCTION INC. - HINESBURG, VT
RESIDENT ENGINEER:	GREG WILCOX
CONSTRUCTION BEGAN:	MAY 09, 2016
CONSTRUCTION COMPLETE:	DECEMBER 09, 2016
RECORD PLANS BY:	GREG WILCOX & AARON WEAVER
I HEREBY CERTIFY THAT ALL THE CONSTRUCTION REQUIRED BY THIS SET OF DRAWINGS HAS BEEN ACCOMPLISHED AS INDICATED HEREIN.	
BY	RESIDENT ENGINEER
DATE	6/1/18
NOTE: Any further information concerning final quantities, amounts or other details relative to this project may be found at Central Files in the electronic archives.	

CONSTRUCTION IS TO BE CARRIED ON IN ACCORDANCE WITH THESE PLANS AND THE STANDARD SPECIFICATIONS FOR CONSTRUCTION DATED 2011, AS APPROVED BY THE FEDERAL HIGHWAY ADMINISTRATION ON JULY 20, 2011 FOR USE ON THIS PROJECT, INCLUDING ALL SUBSEQUENT REVISIONS AND SUCH REVISED SPECIFICATIONS AND SPECIAL PROVISIONS AS ARE INCORPORATED IN THESE PLANS.

QUALITY ASSURANCE PROGRAM : LEVEL 2	
SURVEYED BY :	R. GILMAN
SURVEYED DATE :	03-20-2012
DATUM	
VERTICAL	NAVD88
HORIZONTAL	NAD83 (92)

DIRECTOR OF PROJECT DELIVERY	
APPROVED	DATE 10/19/2015
PROJECT MANAGER : CAROLYN CARLSON, P. E.	
PROJECT NAME :	HUNTINGTON
PROJECT NUMBER :	BRO 1445 (35)
SHEET 1 OF 44 SHEETS	