



SEE REVISED SHEET 22A

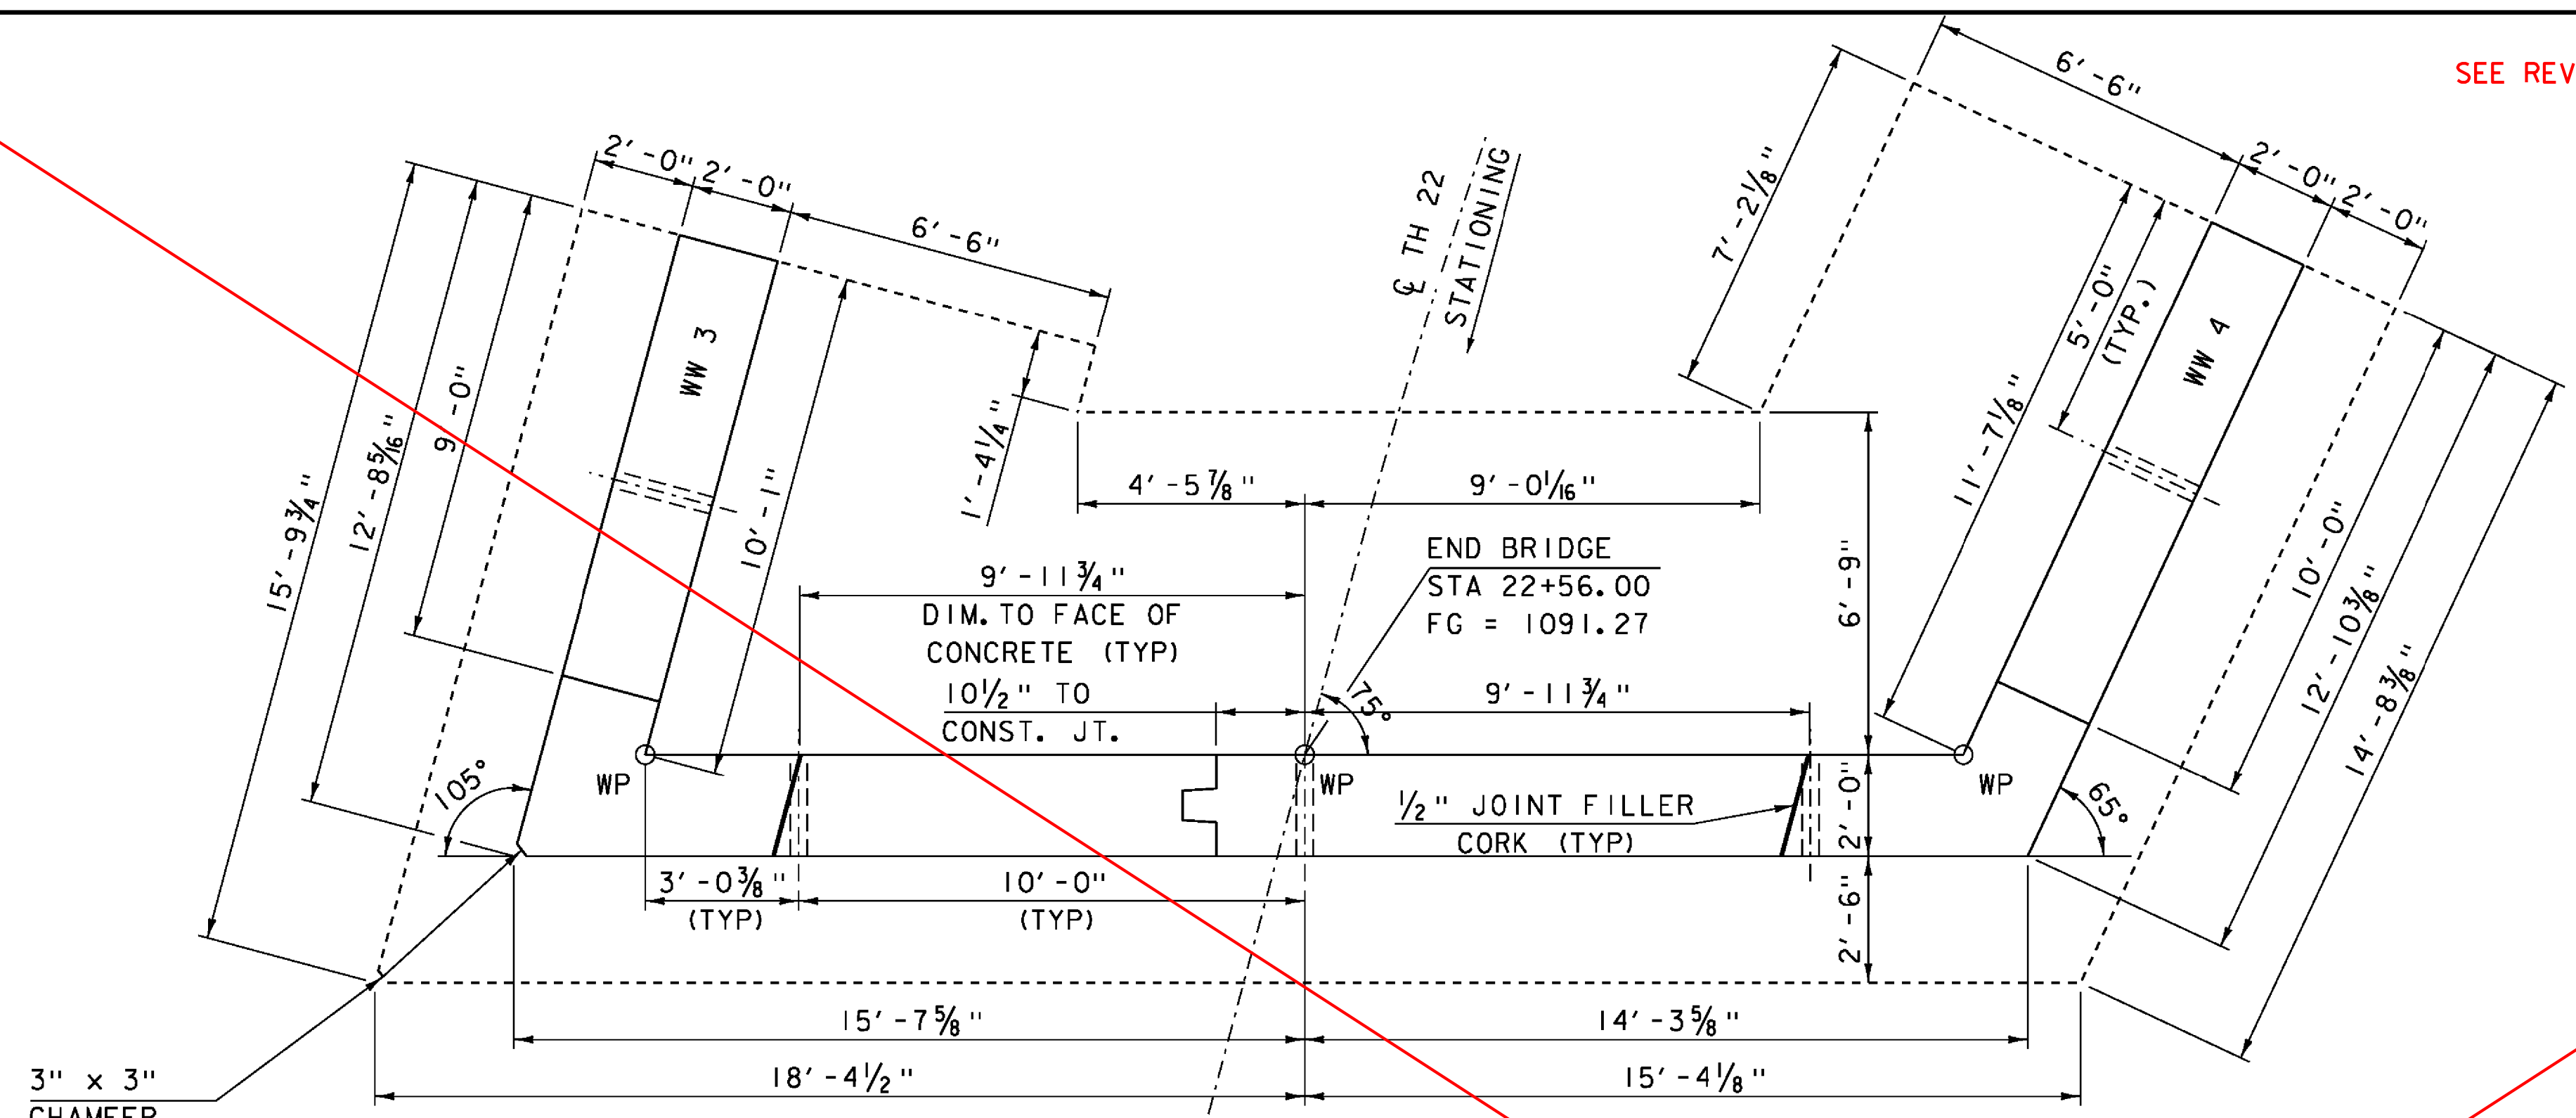


ABUTMENT 2 PLAN

SCALE 3/8" = 1'-0"

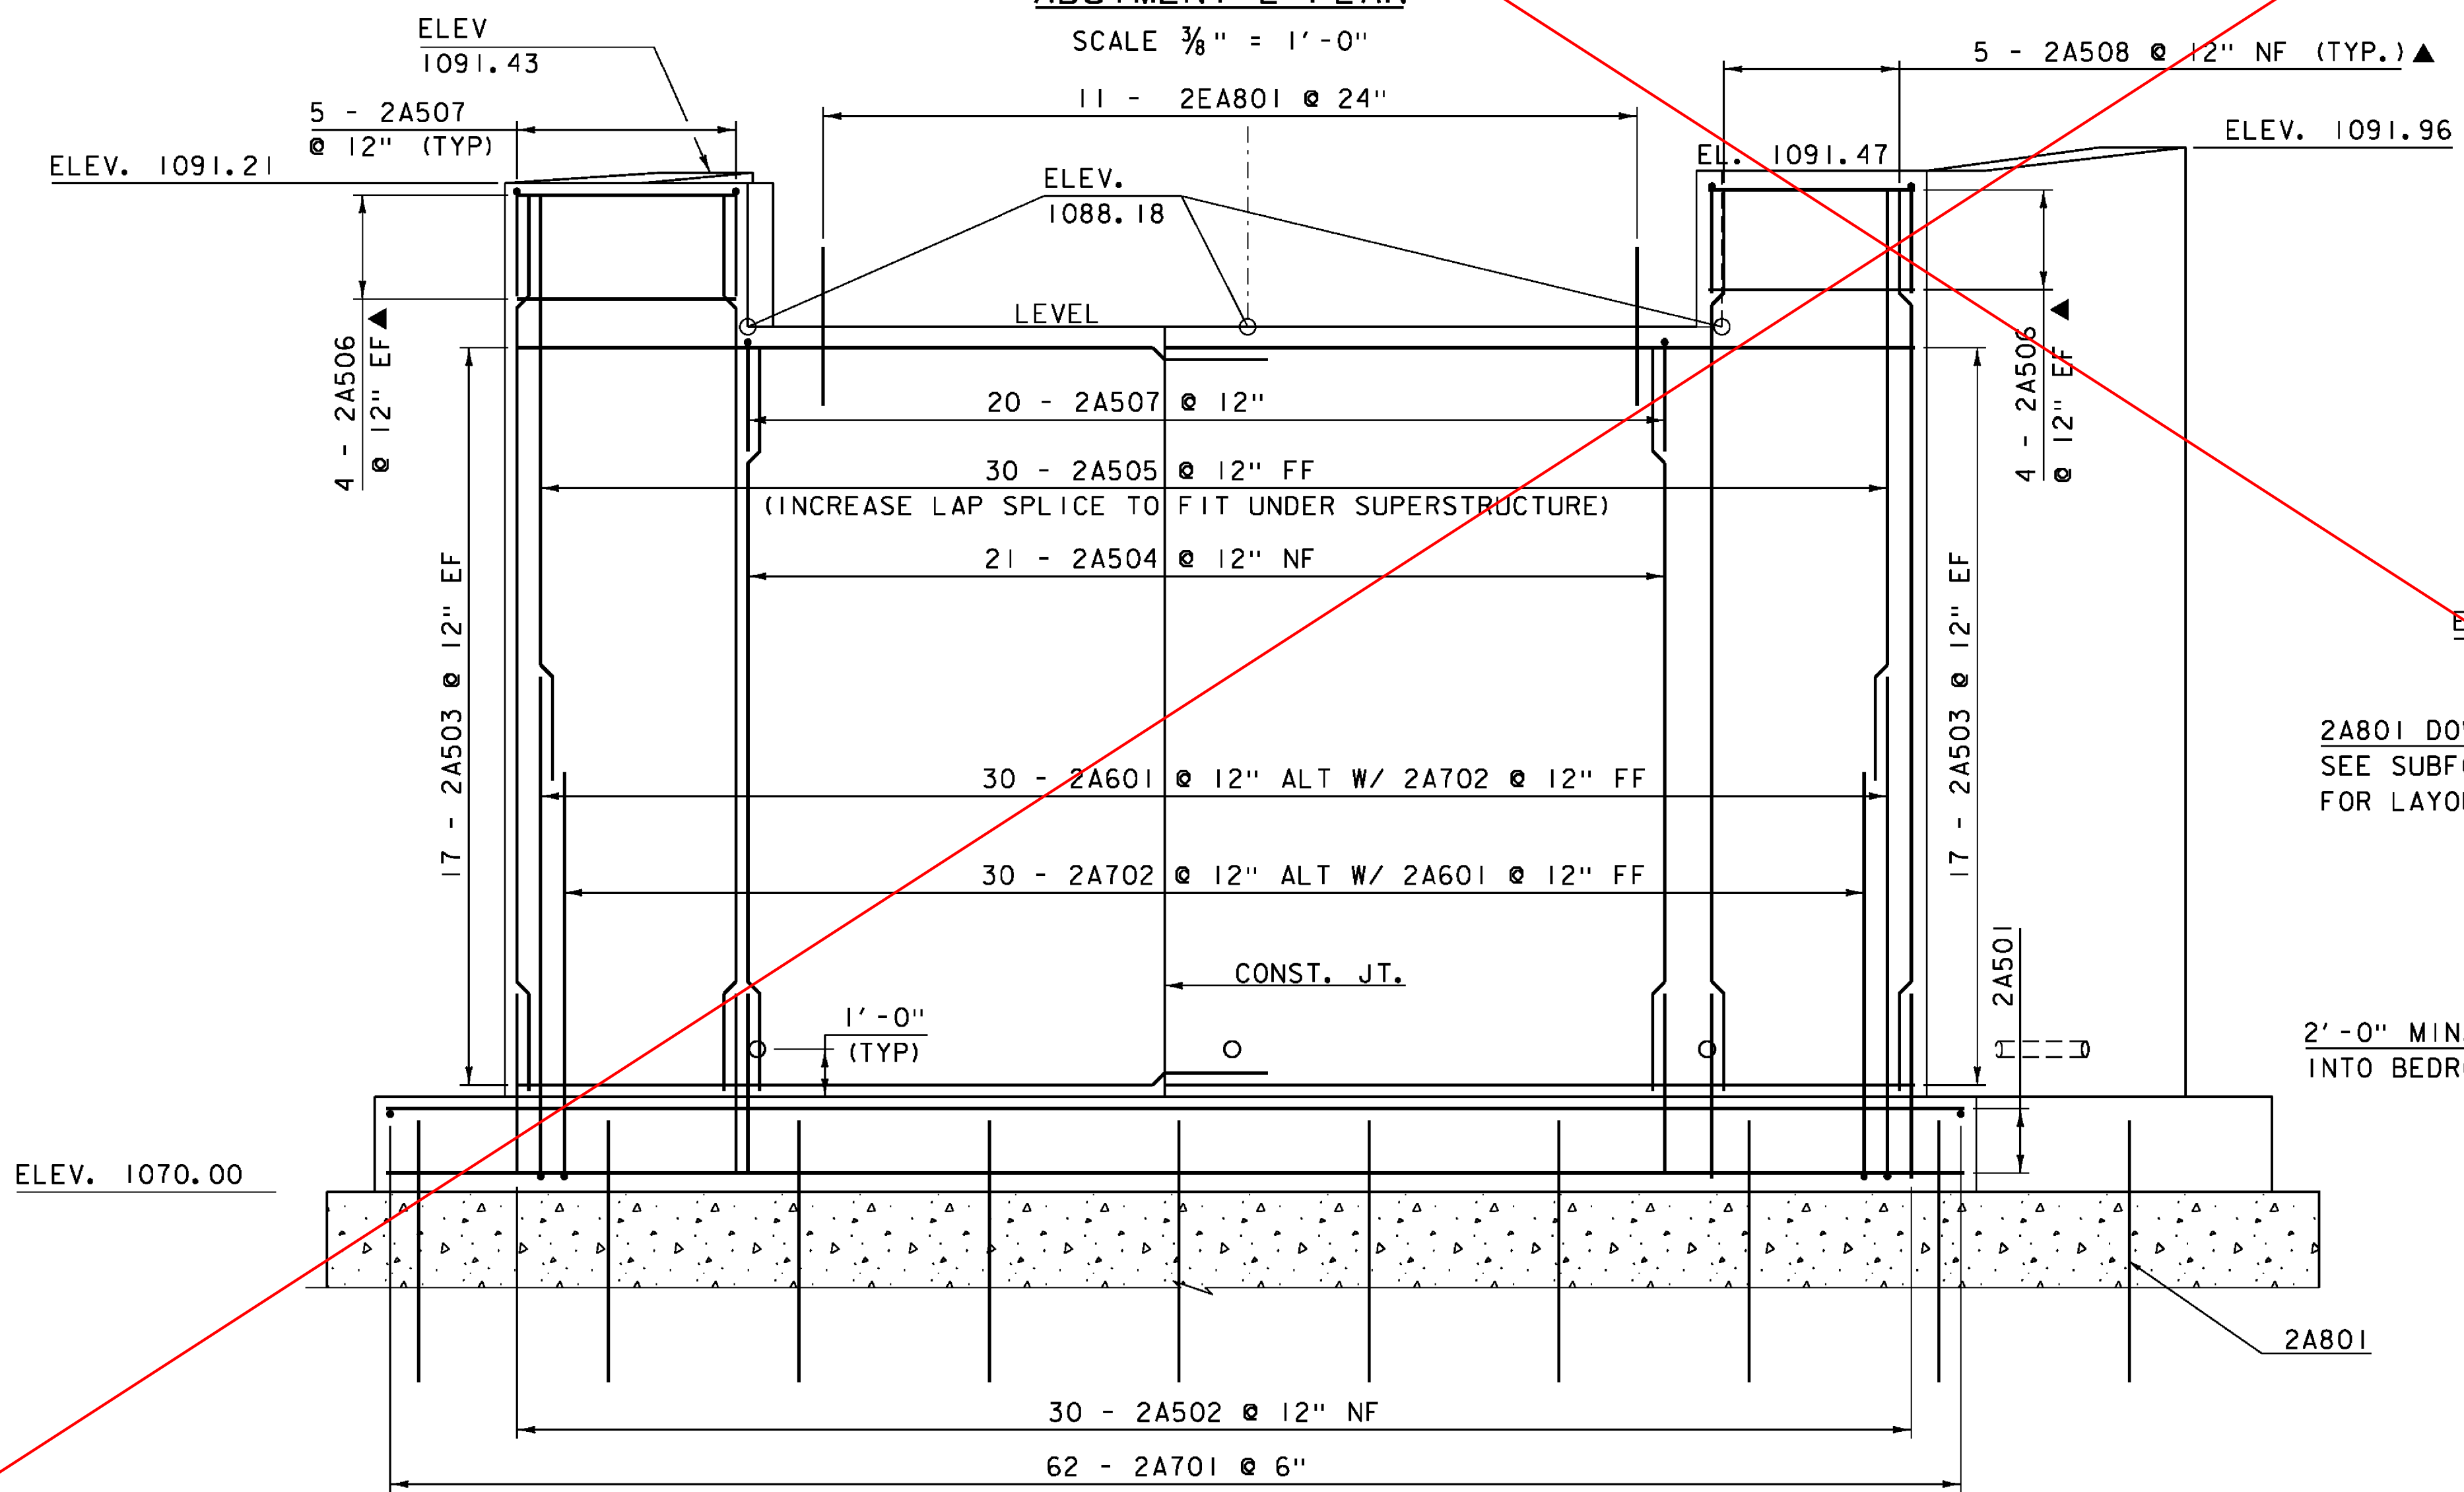

ABUTMENT 2 ELEVATION

SCALE 3/8" = 1'-0"

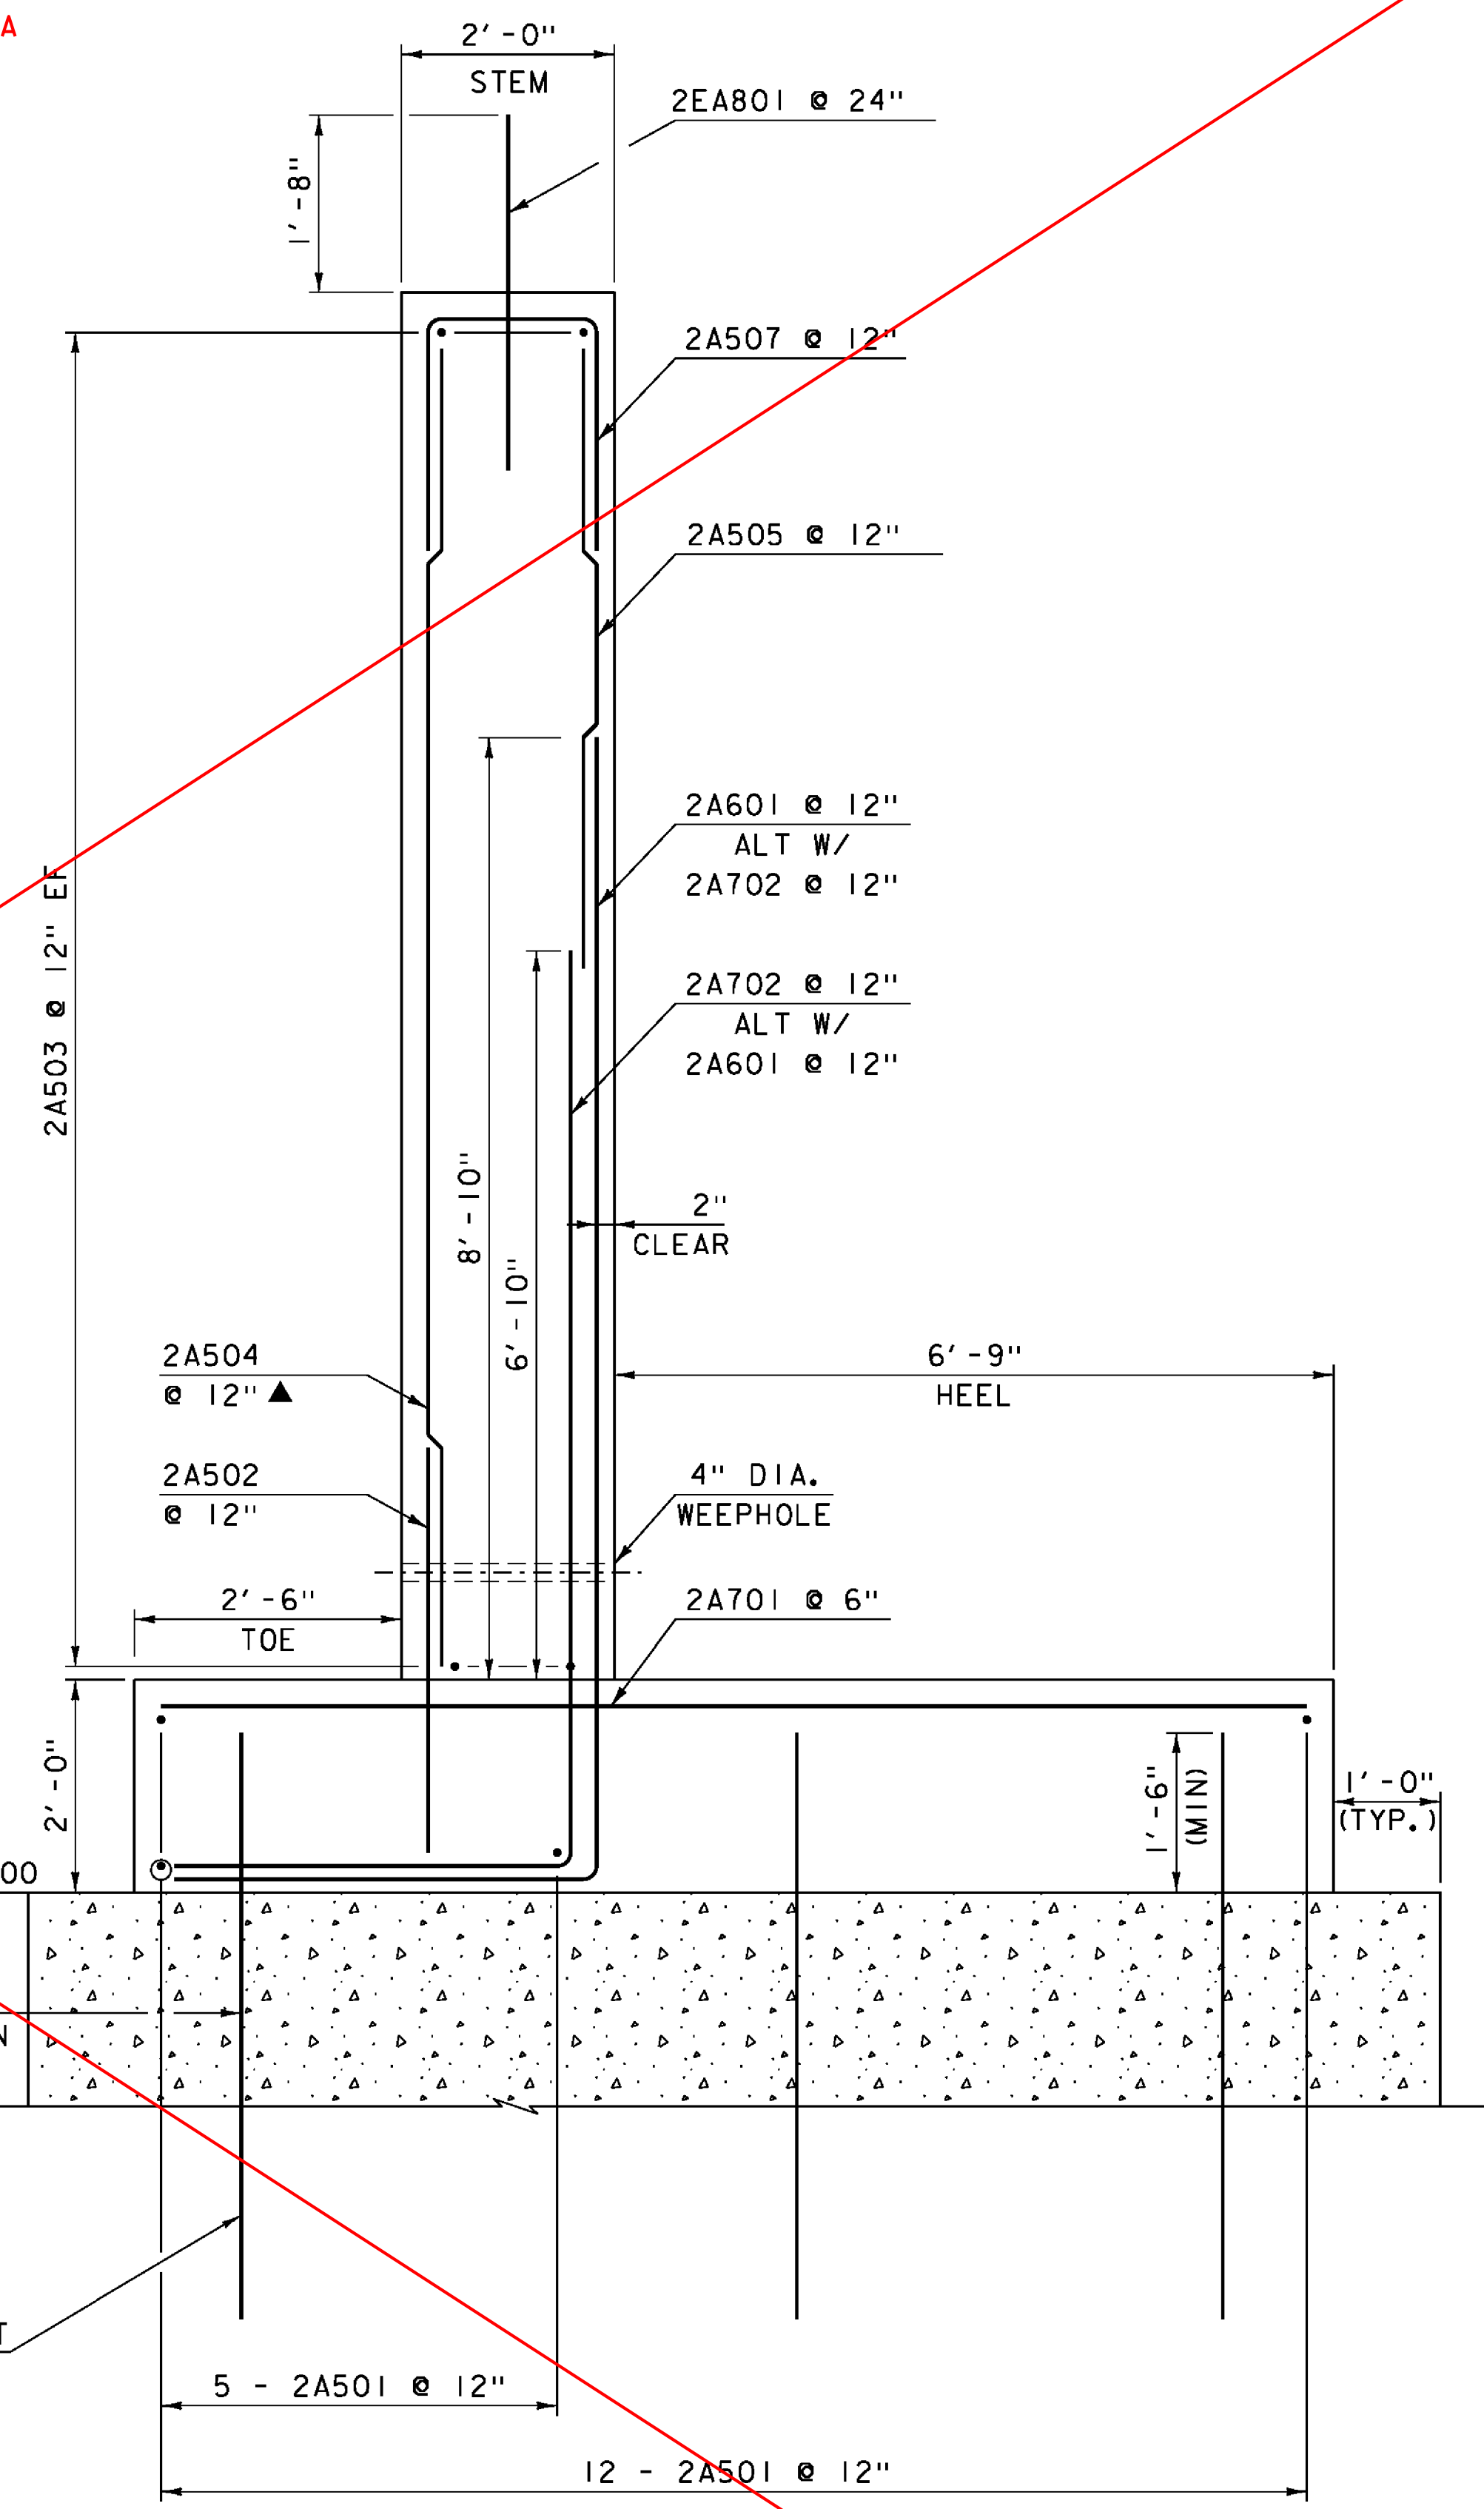

ABUTMENT 2 TYPICAL SECTION

SCALE 3/4" = 1'-0"

NOTE:
 NF = NEAR FACE
 FF = FAR FACE
 EF = EACH FACE
 ▲ = CUT TO FIT IN FIELD
 3" CLEAR, UNLESS OTHERWISE SPECIFIED ON THE PLANS.
 2'-2" BAR LAP UNLESS OTHERWISE SPECIFIED ON THE PLANS.

| | | | |
|-----------------------------|----------------|--------------|----------------|
| PROJECT NAME: | HUNTINGTON | PLOT DATE: | 15-OCT-2015 |
| PROJECT NUMBER: | BRO 1445(35) | DRAWN BY: | R. PELLETT |
| FILE NAME: | sl2j162sub.dgn | DESIGNED BY: | D. PETERSON |
| PROJECT LEADER: | C. CARLSON | CHECKED BY: | D. PETERSON |
| ABUTMENT 2 PLAN & ELEVATION | | | SHEET 22 OF 44 |