



**ABUTMENT 2 PLAN**  
SCALE 3/8" = 1'-0"

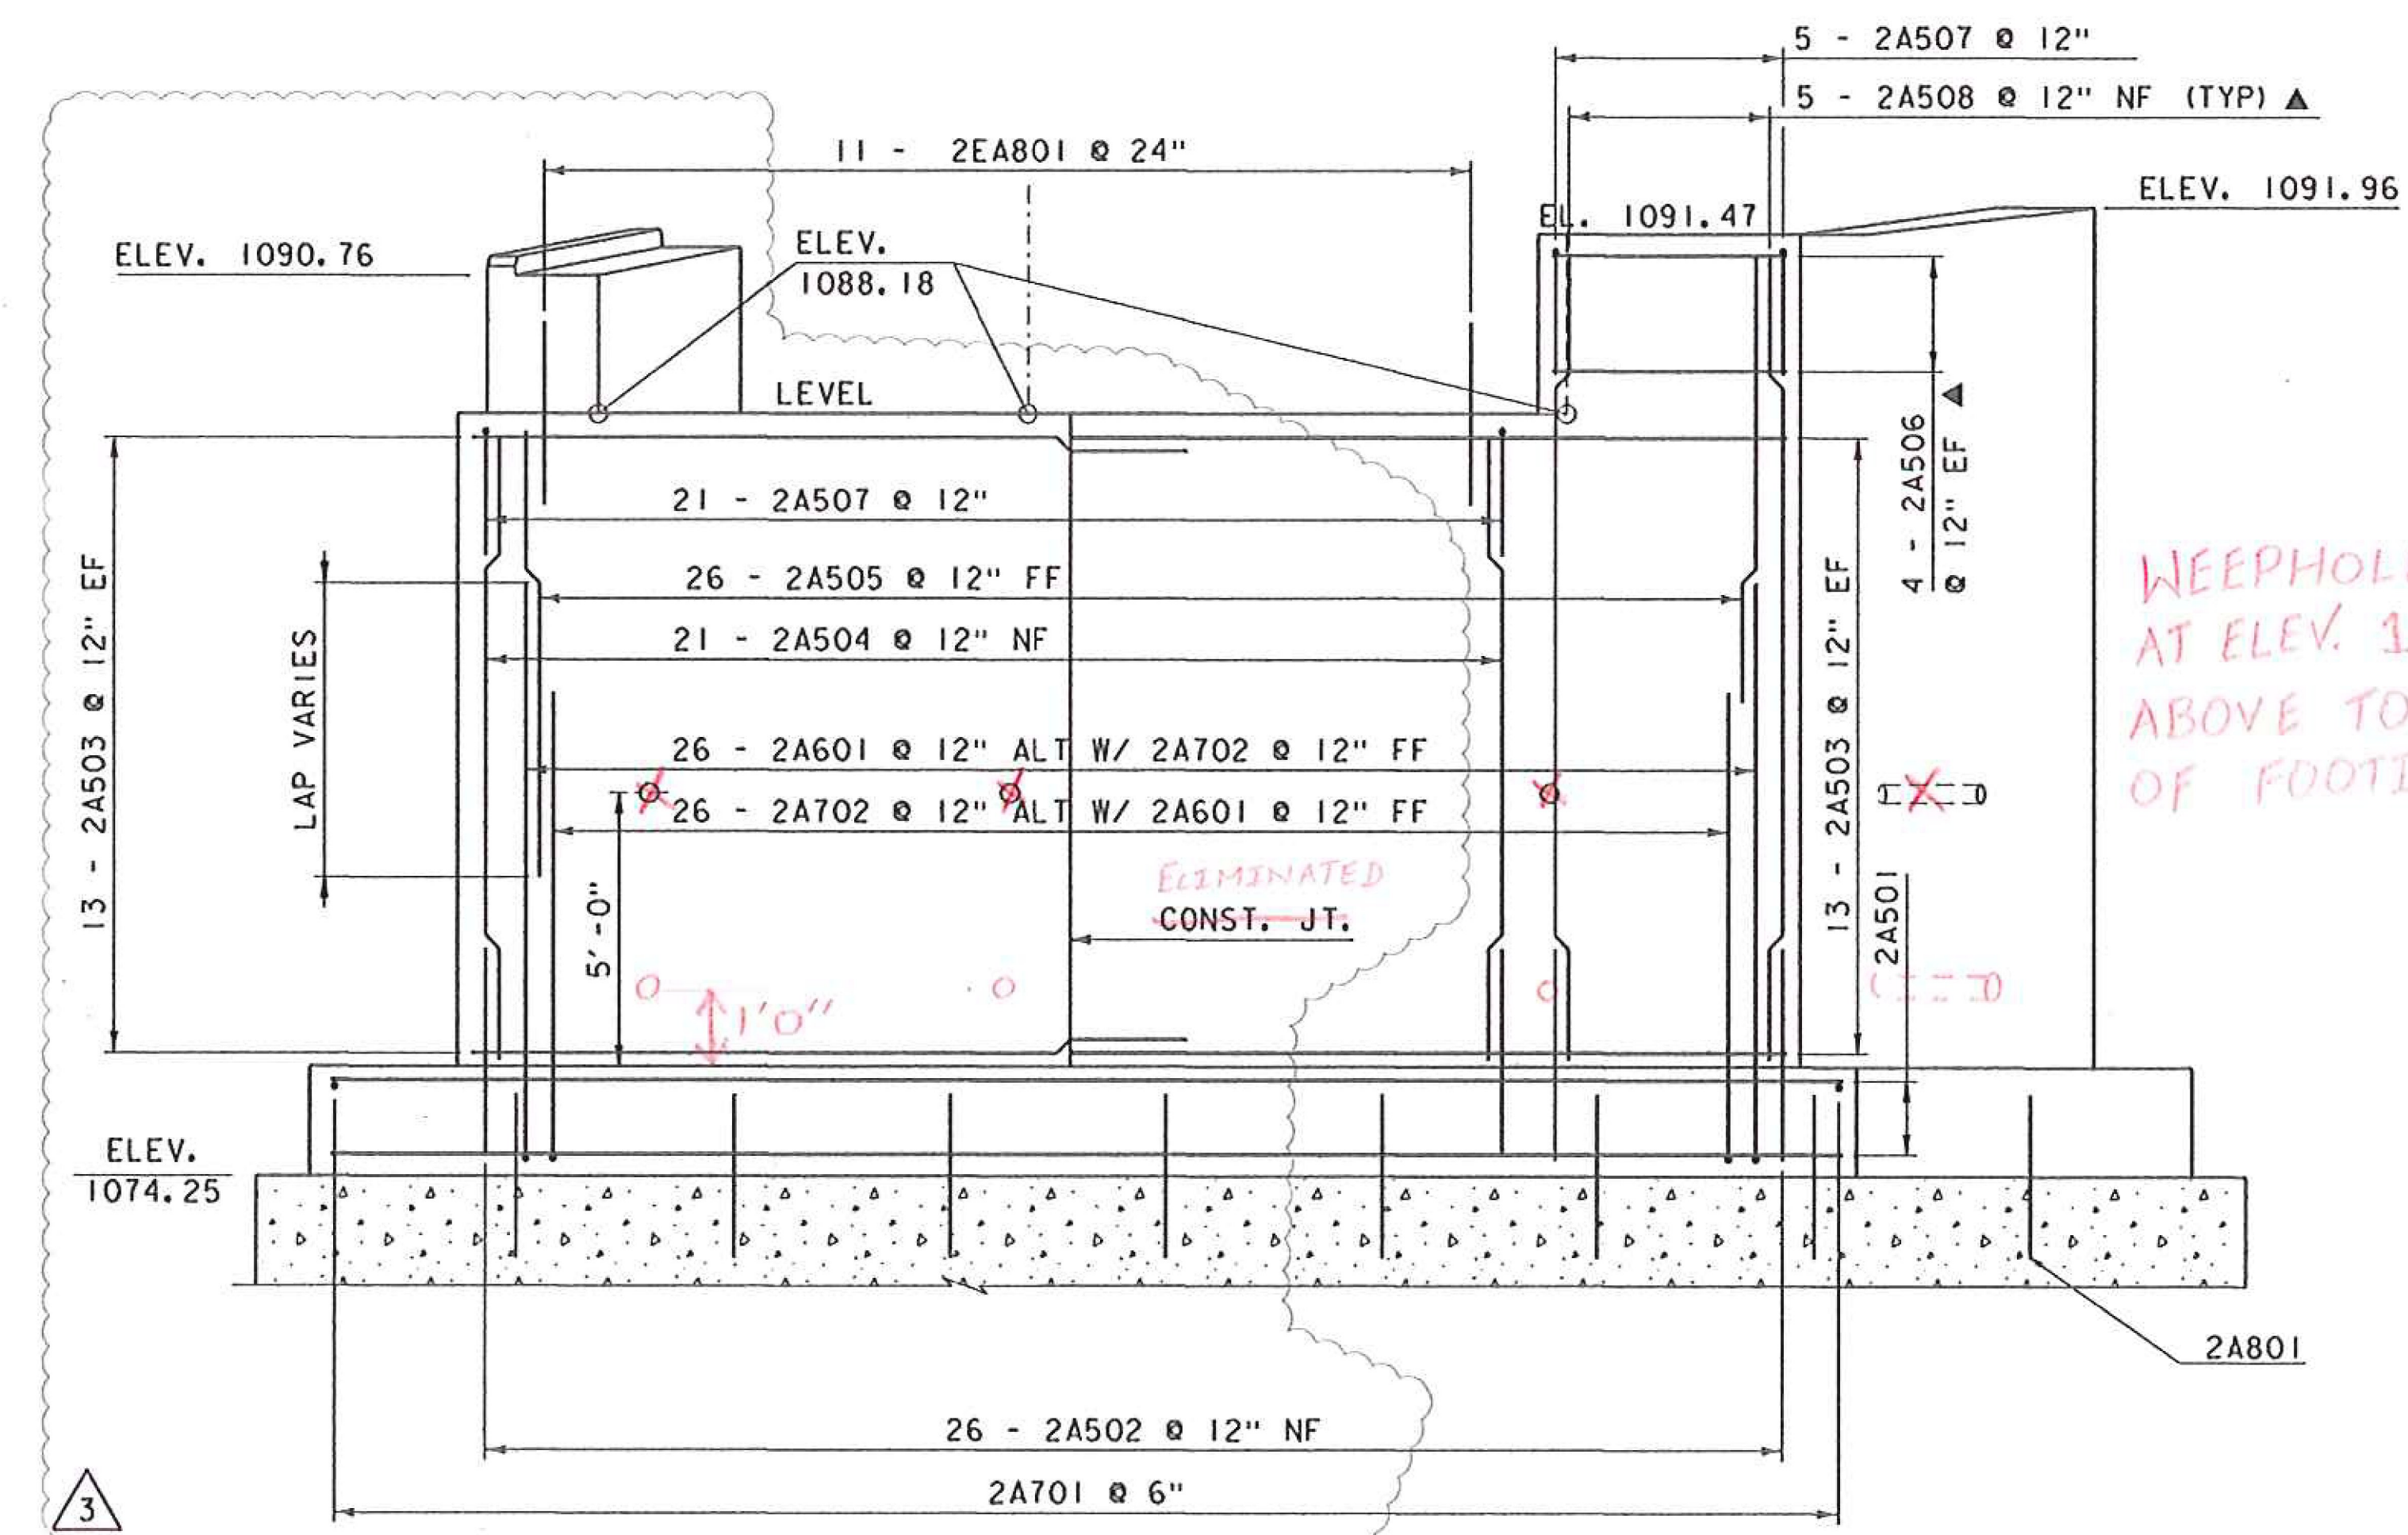

**ABUTMENT 2 ELEVATION**  
SCALE 3/8" = 1'-0"

REVISION	DATE	DESCRIPTION	BY
3	07-12-2016	ABUTMENT 2 & WINGWALL 3 DIMENSION CHANGES	MCL

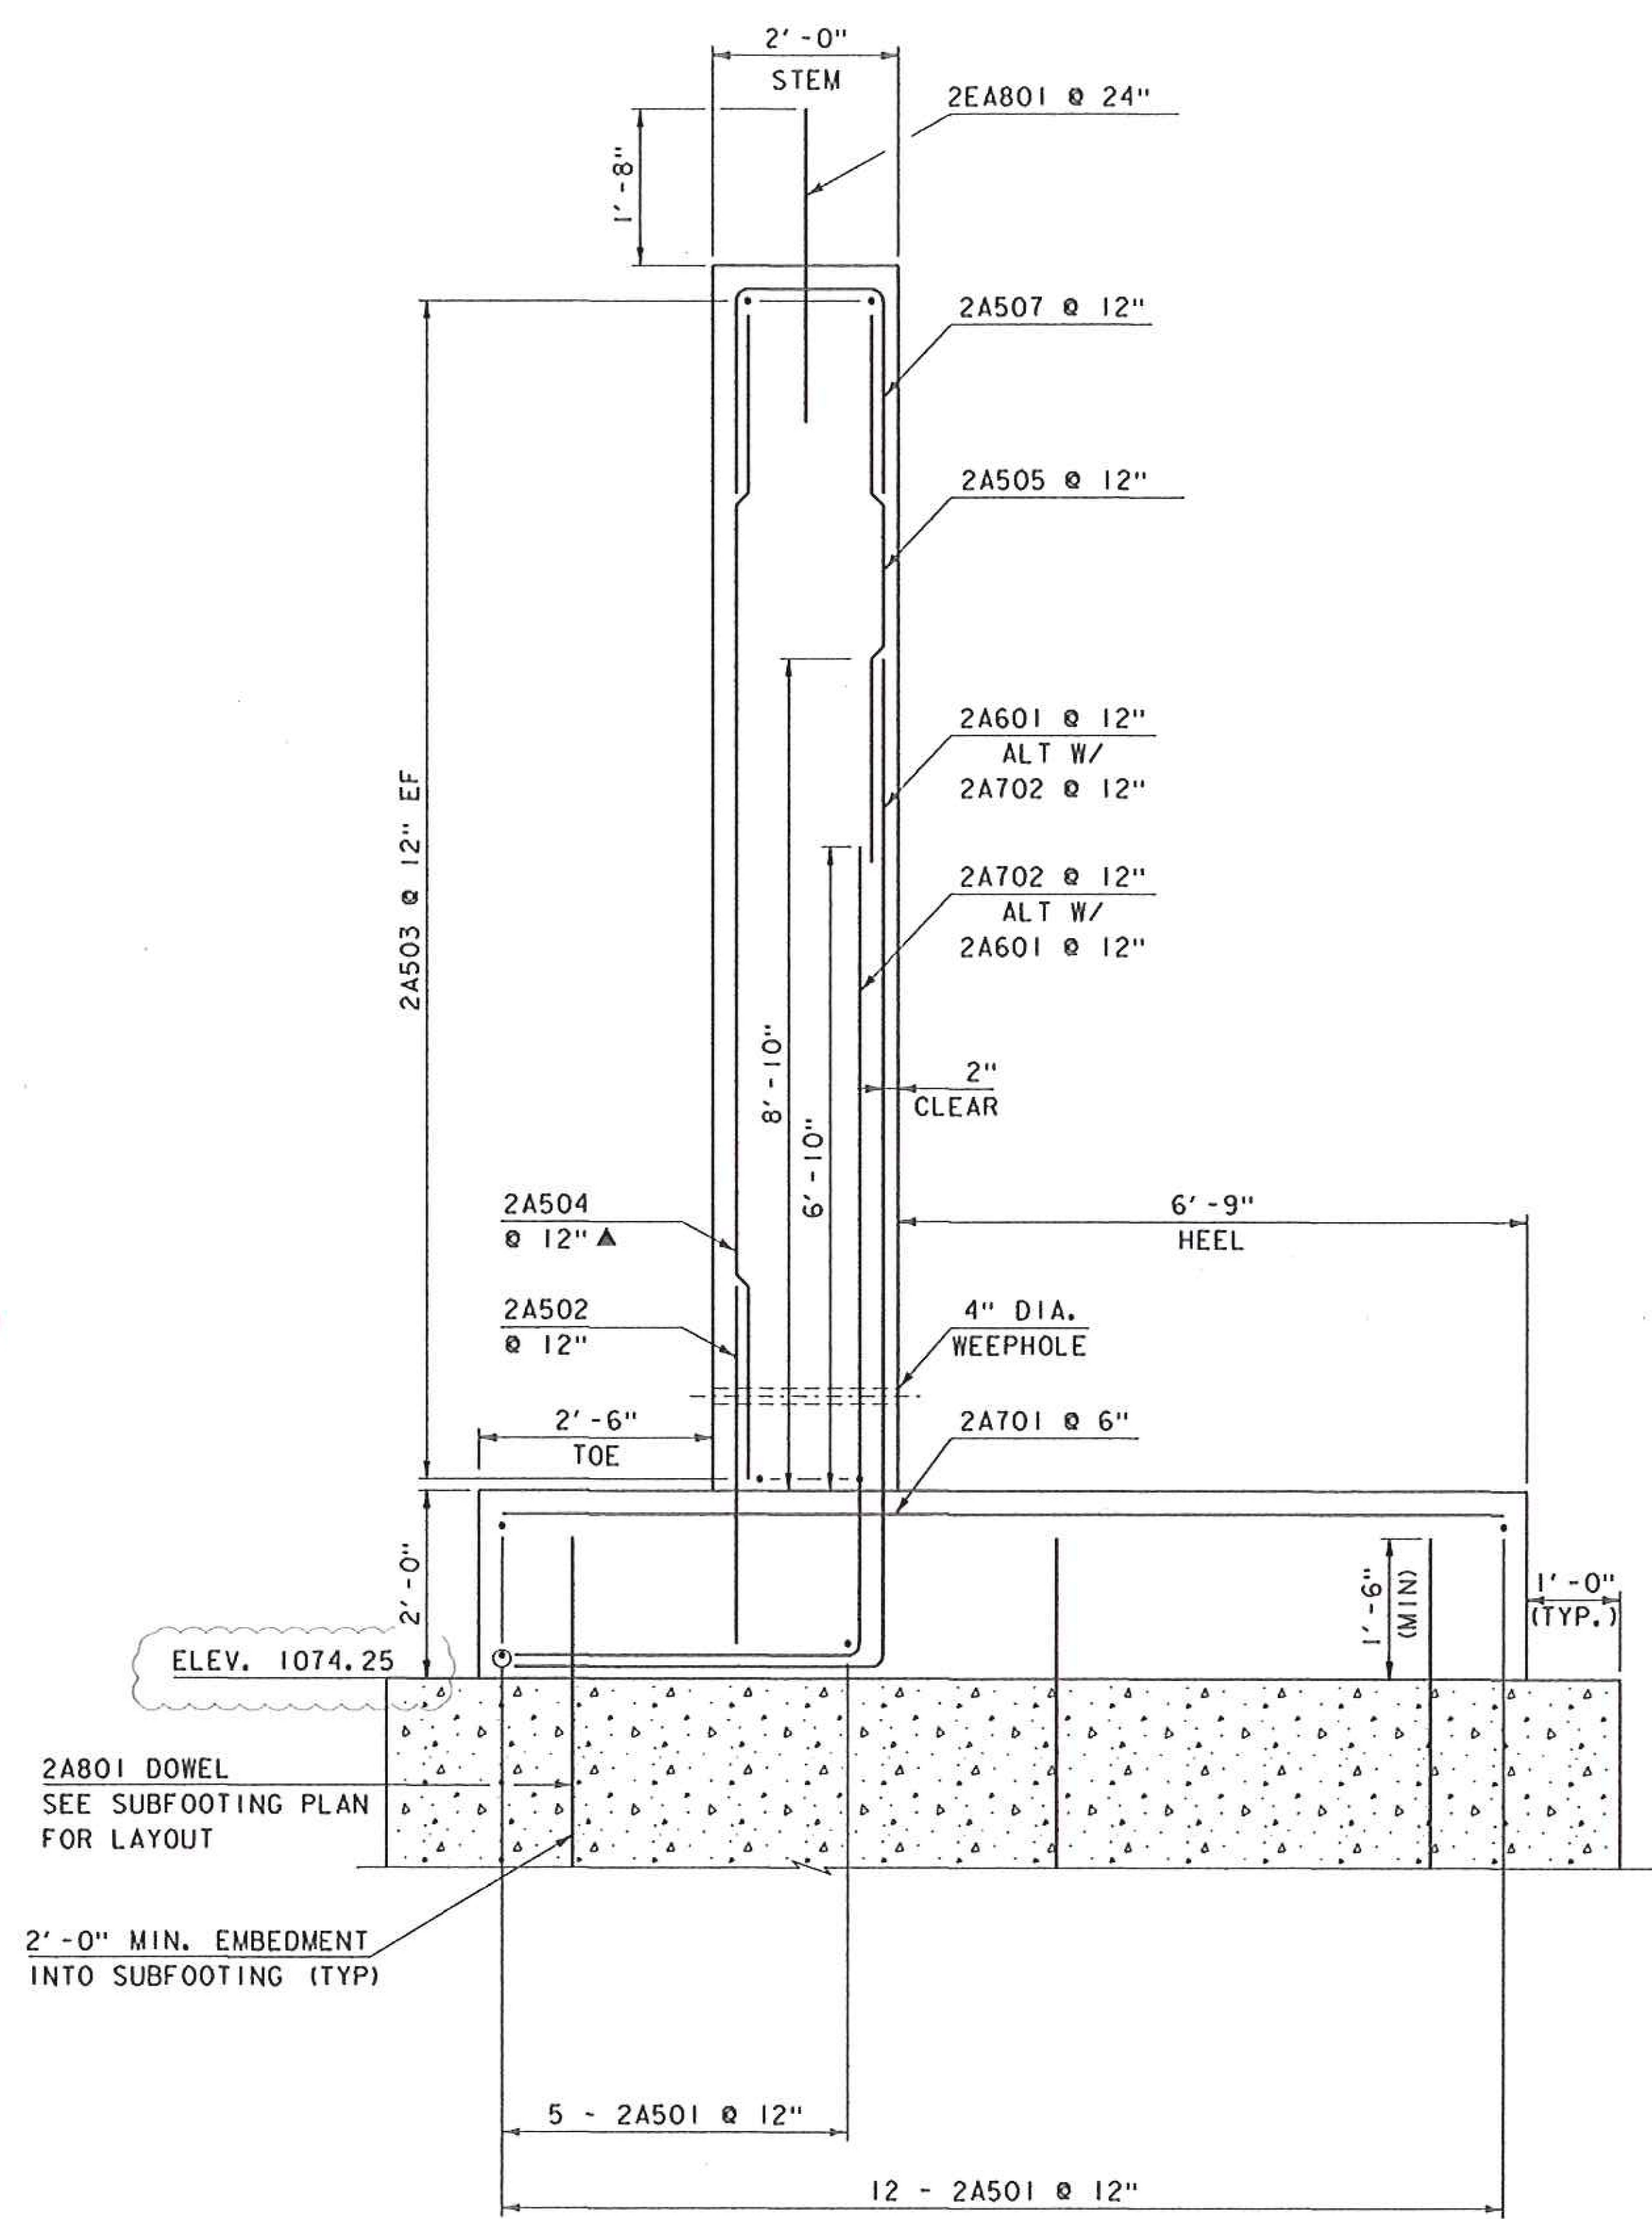

**ABUTMENT 2 TYPICAL SECTION**  
SCALE 3/4" = 1'-0"

**NOTE:**  
NF = NEAR FACE  
FF = FAR FACE  
EF = EACH FACE  
▲ = CUT TO FIT IN FIELD  
3" CLEAR, UNLESS OTHERWISE SPECIFIED ON THE PLANS.  
2'-2" BAR LAP UNLESS OTHERWISE SPECIFIED ON THE PLANS.

PROJECT NAME: HUNTINGTON	PLOT DATE: 13-JUL-2016
PROJECT NUMBER: BRO 1445(35)	DRAWN BY: R. PELLETT
FILE NAME: s12j162sub.dgn	CHECKED BY: D. PETERSON
PROJECT LEADER: C. CARLSON	SHEET 22A OF 44
DESIGNED BY: D. PETERSON	
ABUTMENT 2 PLAN & ELEVATION	