



WINGWALL 3 ELEVATION
SCALE 3/8" = 1'-0"


WEEPHOLES AT ELEV. 2 FT ABOVE TOP OF FOOTING

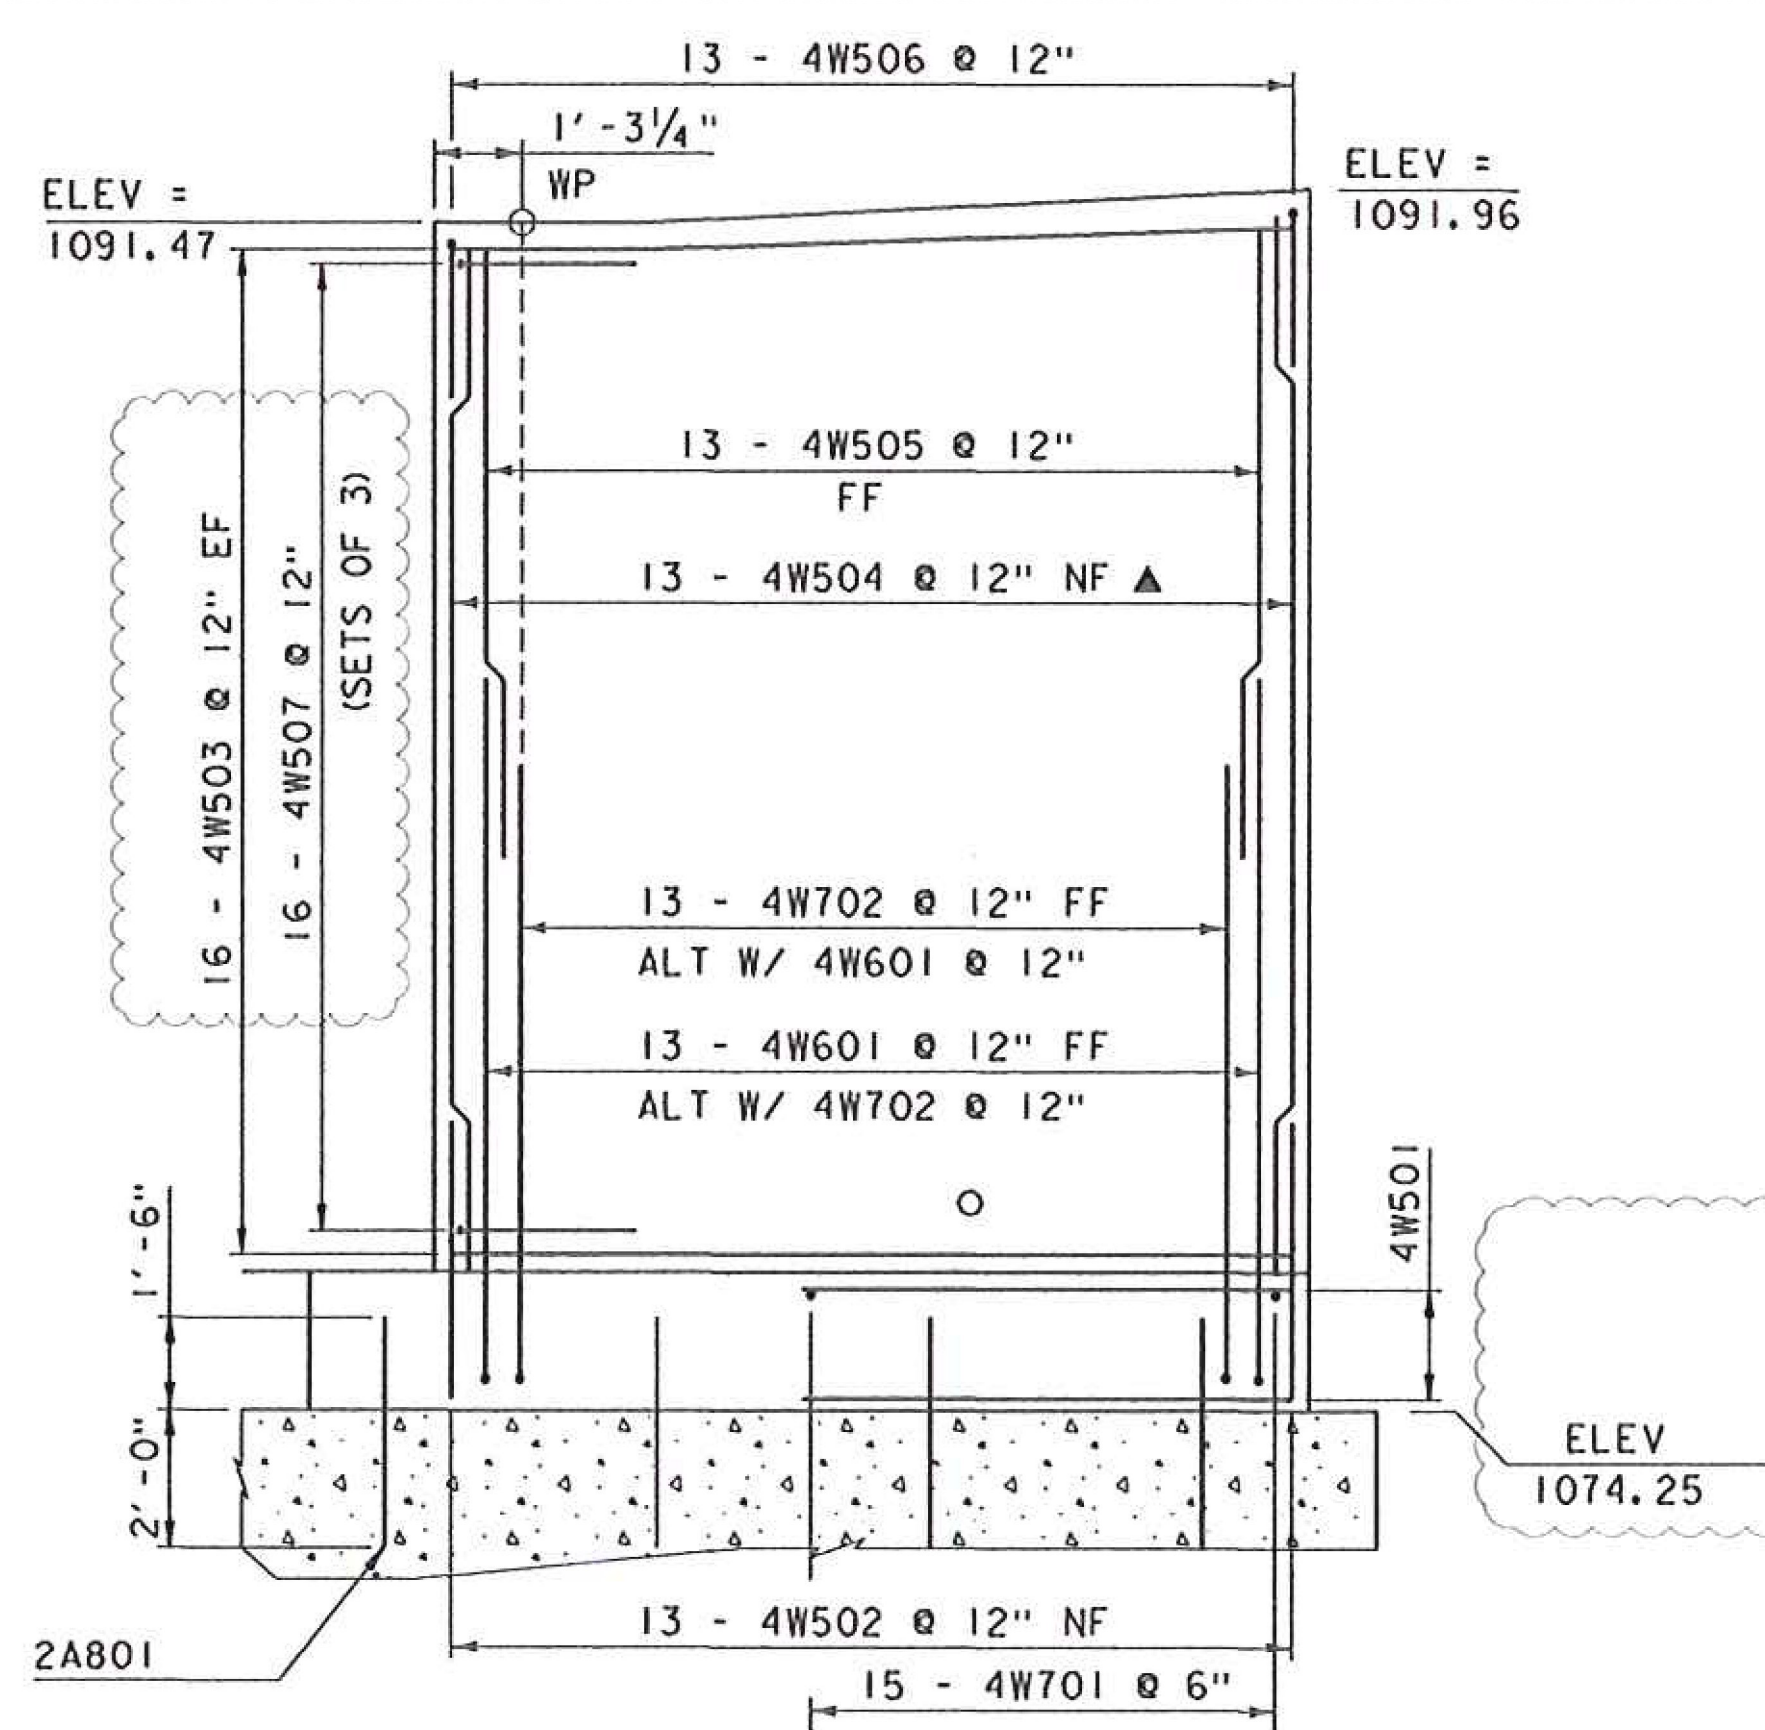

WINGWALL 4 ELEVATION
SCALE 3/8" = 1'-0"

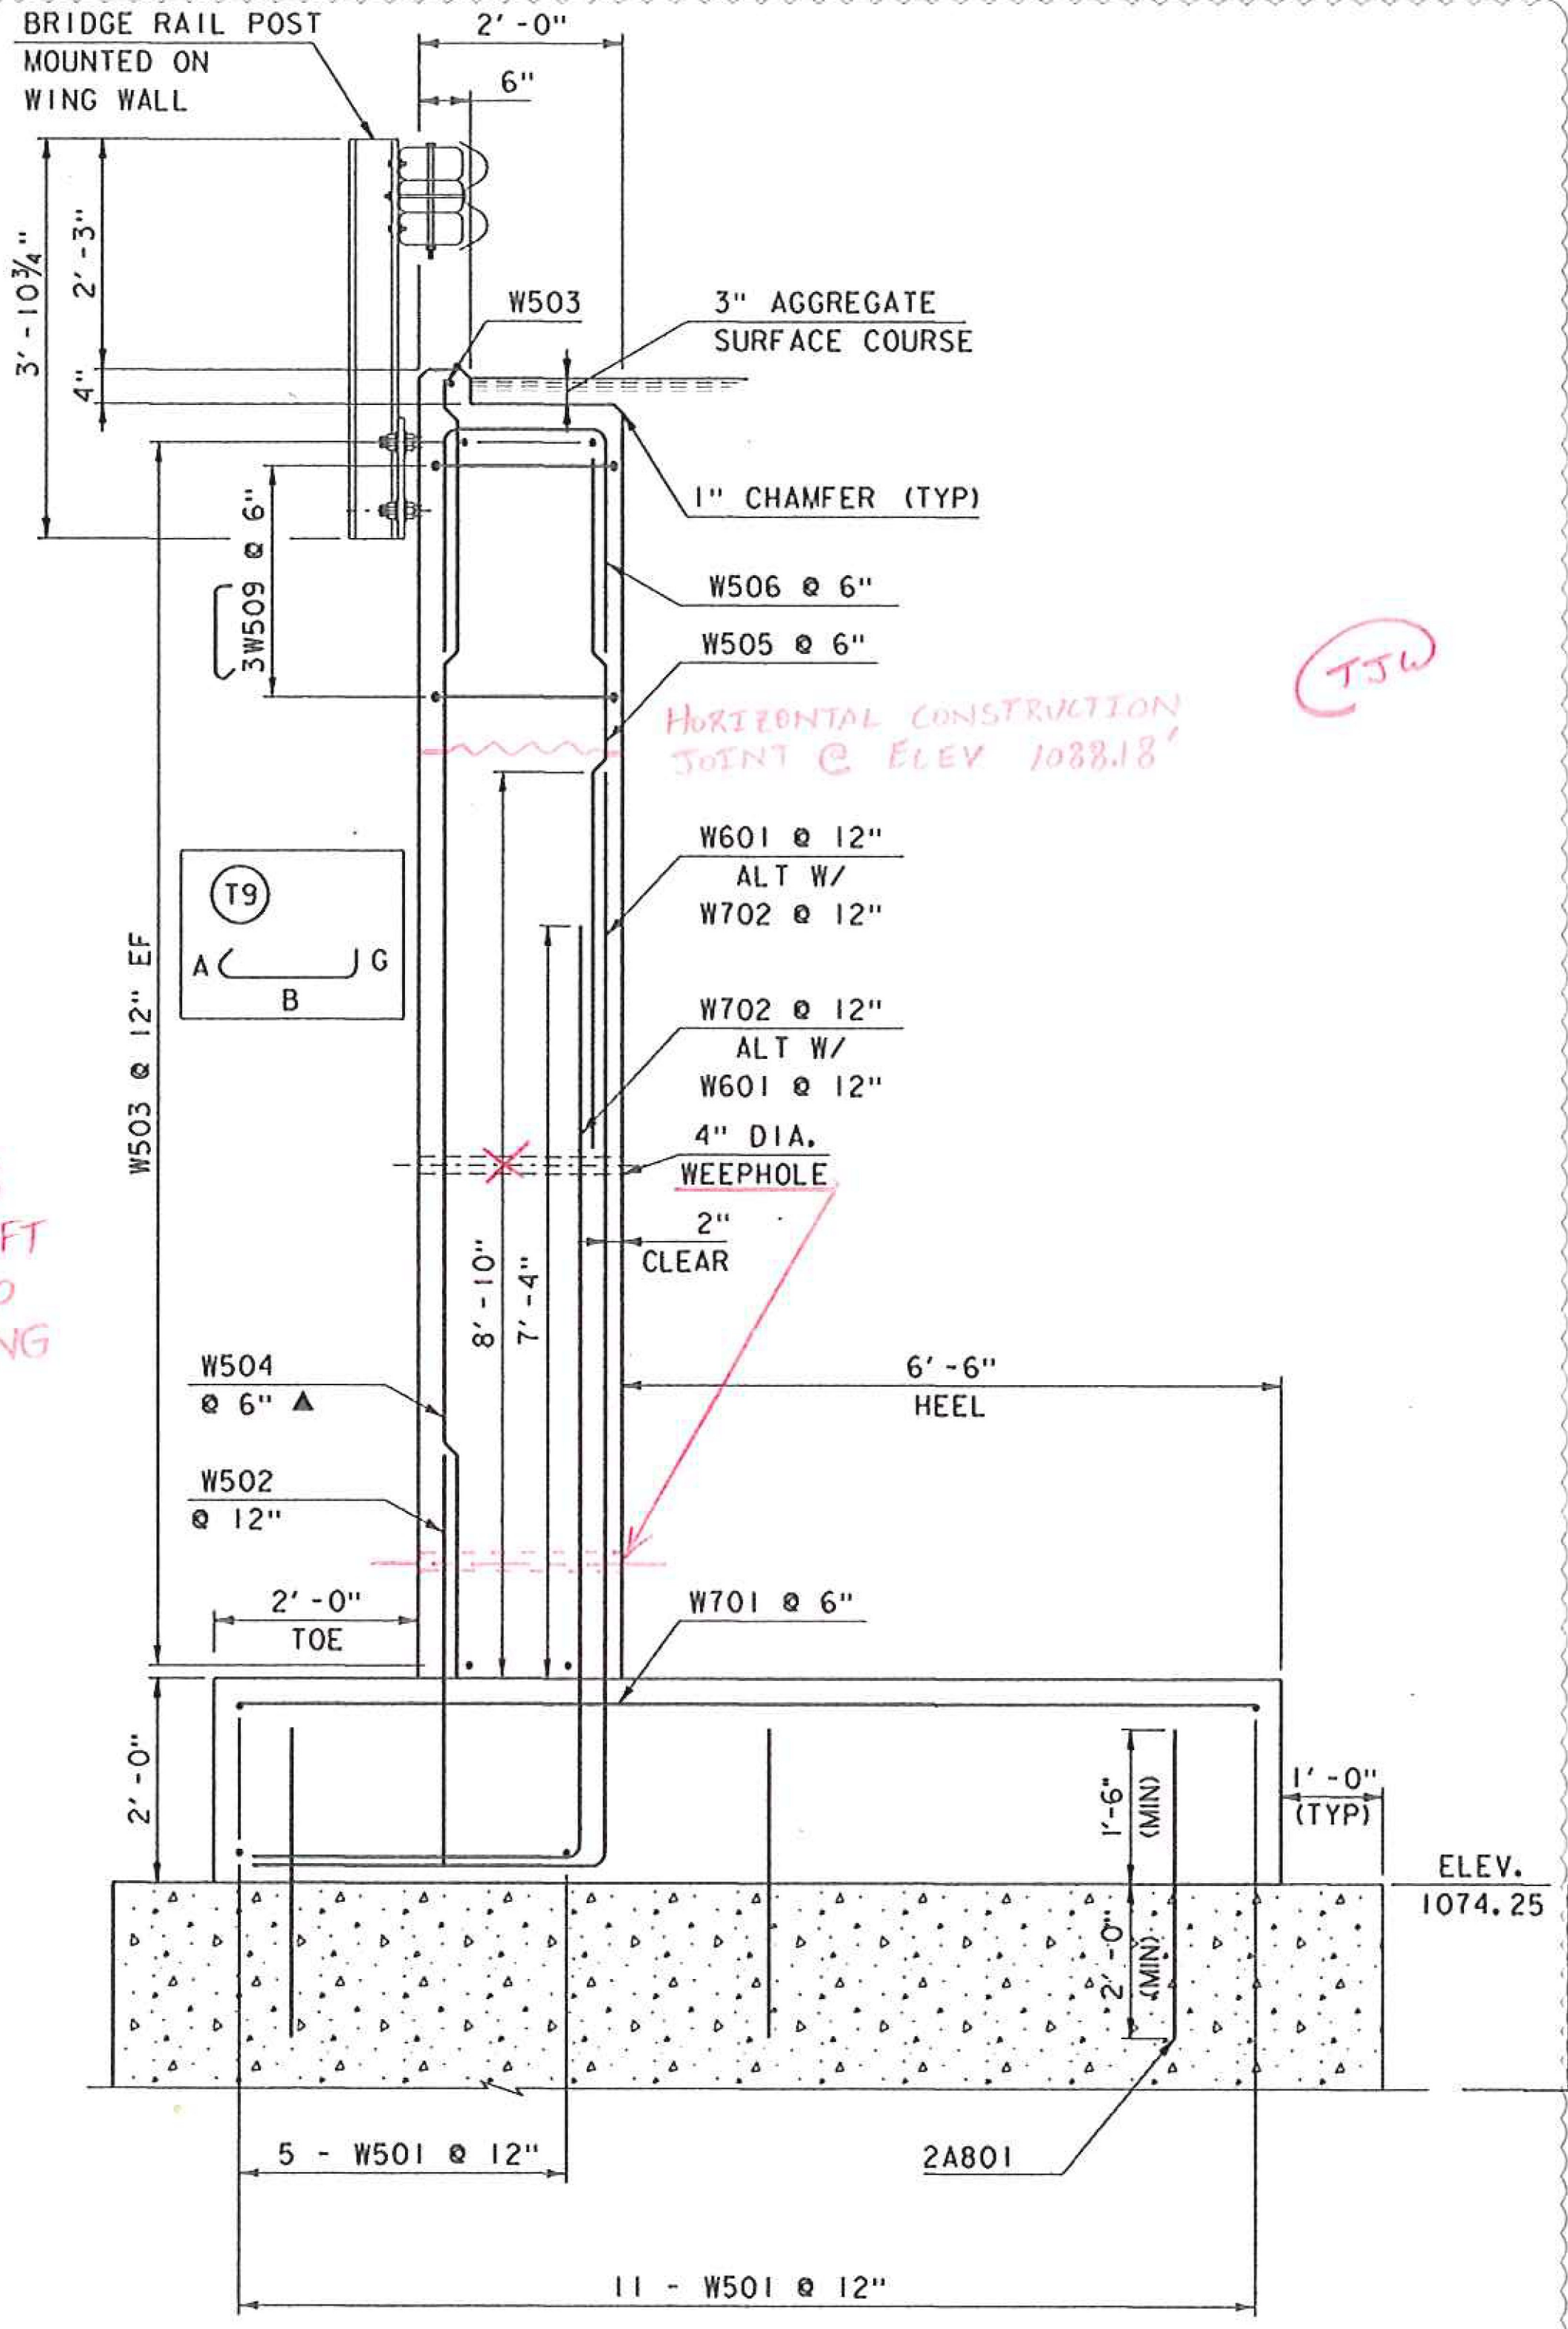

WINGWALL 3 TYPICAL SECTION
SCALE 3/4" = 1'-0"

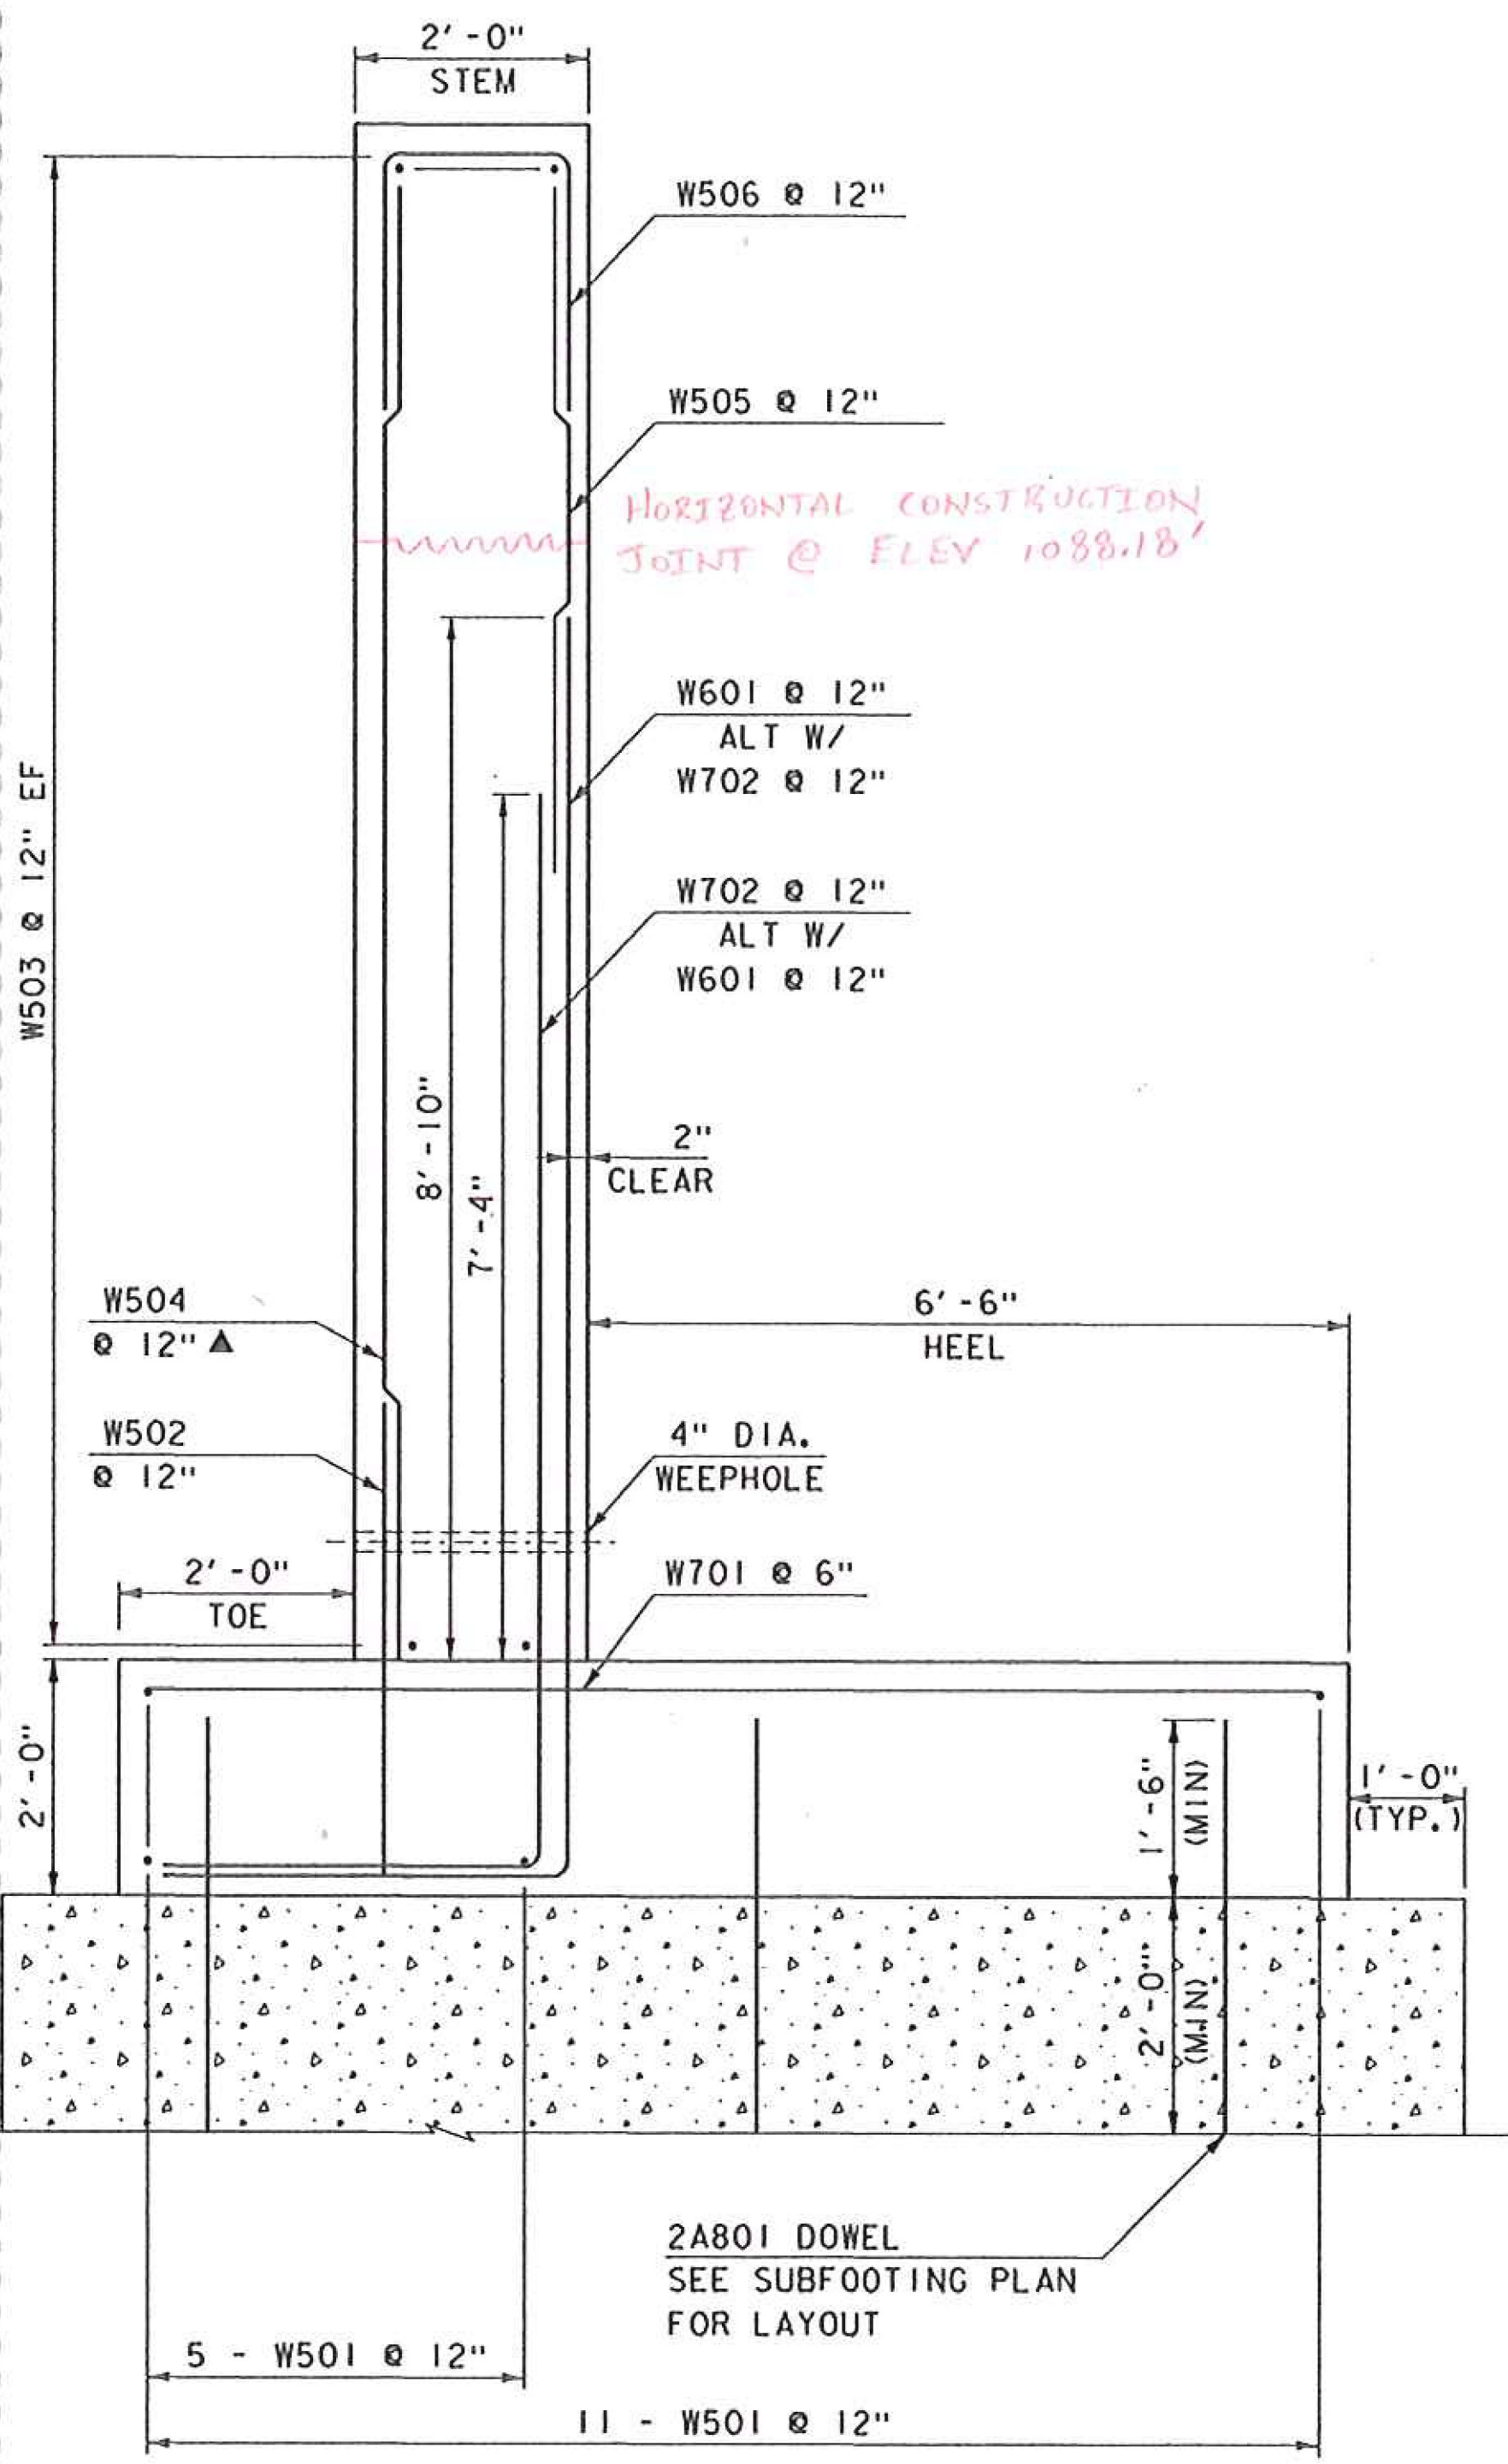

WINGWALL 4 TYPICAL SECTION
SCALE 3/4" = 1'-0"

NOTE:
NF = NEAR FACE
FF = FAR FACE
EF = EACH FACE
 \blacktriangle = CUT TO FIT IN FIELD
3" CLEAR, UNLESS OTHERWISE SPECIFIED ON THE PLANS.
2' - 2" BAR LAP UNLESS OTHERWISE SPECIFIED ON THE PLANS.

REVISION	DATE	DESCRIPTION	BY
3	07-12-2016	ABUTMENT 2 & WINGWALL 3 DIMENSION CHANGES	MCL

PROJECT NAME:	HUNTINGTON	PLOT DATE:	13-JUL-2016
PROJECT NUMBER:	BRO 1445(35)	DRAWN BY:	R. PELLETT
FILE NAME:	sl2j162sub.dgn	DESIGNED BY:	D. PETERSON
PROJECT LEADER:	C. CARLSON	CHECKED BY:	D. PETERSON
WINGWALL 3 & 4 ELEVATIONS		SHEET	24A OF 44