


STATE OF VERMONT
AGENCY OF TRANSPORTATION

REINFORCING STEEL SCHEDULE

ITEM	EACH	SIZE	LENGTH	MARK	TYPE	A	B	C	D	E	F	G	H	J	K	R	O	ITEM	EACH	SIZE	LENGTH	MARK	TYPE	A	B	C	D	E	F	G	H	J	K	R	O
DECK																		WINGWALL NO. 3																	
* 13	5	41'-6"	ES501	STR	41'-6"													16	5	4'-1"	3W501	STR	4'-1"												
86	5	12'-10"	ES502	S6	2'-2"	1'-9"	5'-0"	1'-9"				2'-2"						10	5	3'-11"	3W502	STR	3'-11"												
* 44	6	19'-6"	ES601	STR	19'-6"													▲ 30	5	10'-0"	3W503	STR	10'-0"												
* 40	11	42'-6"	ES1101	1	1'-7"	41'-0"								1'-9"				▲ 20	5	14'-11"	3W504	STR	14'-11"												
ABUTMENT NO. 1																		WINGWALL NO. 4																	
* 14	5	26'-0"	1A501	STR	26'-0"													20	5	5'-10"	3W506	S10		2'-2"	1'-6"	2'-2"									
26	5	3'-11"	1A502	STR	3'-11"													24	5	4'-9"	3W507	27		2'-7"	2'-2"	---			2'-6"	---	0'-8"				
32	5	13'-11"	1A503	STR	13'-11"													12	5	6'-5"	3W508	27		4'-3"	2'-2"	---			4'-1"	---	1'-1"				
21	5	6'-11"	1A504	STR	6'-11"													50	5	3'-1"	3W509	T9		0'-8"	1'-7"	---			0'-10"	---	---				
21	5	6'-11"	1A505	STR	6'-11"													10	6	14'-1"	3W601	17		3'-6"	10'-7"	---									
8	5	4'-1"	1A506	STR	4'-1"													9	7	10'-0"	3W701	STR	10'-0"												
53	5	6'-6"	1A508	STR	6'-6"													10	7	12'-7"	3W702	17		3'-6"	9'-1"	---									
10	5	10'-1"	1A510	STR	10'-1"													WINGWALL NO. 2																	
26	5	5'-11"	1A507	S10		2'-2"	1'-7"	2'-2"										13	5	5'-11"	4W508	S10		2'-2"	1'-7"	2'-2"									
26	5	7'-6"	1A509	17		3'-7"	3'-11"	---										48	5	5'-0"	4W507	22		2'-6"	2'-6"	---			2'-3"	---	1'-1"	---			
* ▲ 22	8	9'-0"	1A801	STR	9'-0"													13	6	14'-2"	4W601	17		3'-7"	10'-7"	---									
▲ 13	8	3'-4"	1EA801	STR	3'-4"													15	7	10'-0"	4W701	STR	10'-0"												
WINGWALL NO. 1																		WINGWALL NO. 3																	
10	5	8'-0"	1W501	STR	8'-0"													13	5	5'-11"	4W508	S10		2'-2"	1'-7"	2'-2"									
13	5	3'-11"	1W502	STR	3'-11"													48	5	5'-0"	4W507	22		2'-6"	2'-6"	---			2'-3"	---	1'-1"	---			
23	5	9'-7"	1W503	STR	9'-7"													13	6	14'-2"	4W601	17		3'-7"	10'-7"	---									
▲ 13	5	9'-11"	1W504	STR	9'-11"													15	7	10'-0"	4W701	STR	10'-0"												
▲ 13	5	9'-7"	1W505	STR	9'-7"													13	7	12'-8"	4W702	17		3'-7"	9'-1"	---									
17	5	6'-0"	1W508	STR	6'-0"													WINGWALL NO. 1																	
13	5	5'-10"	1W506	S10		2'-2"	1'-6"	2'-2"										10	5	8'-0"	1W501	STR	8'-0"												
13	5	5'-5"	1W507	17		1'-6"	3'-11"	---										13	5	3'-11"	1W502	STR	3'-11"												
16	5	4'-9"	1W509	22		2'-2"	2'-7"	---					2'-6"	---	0'-8"	---	23	5	9'-7"	1W503	STR	9'-7"													
8	5	6'-5"	1W510	22		4'-3"	2'-2"	---					4'-1"	---	1'-1"	---	▲ 13	5	9'-11"	1W504	STR	9'-11"													
50	5	3'-1"	1W511	T9		0'-8"	1'-7"	---				0'-10"						▲ 13	5	9'-7"	1W505	STR	9'-7"												
WINGWALL NO. 2																		WINGWALL NO. 4																	
13	5	5'-0"	2W501	STR	5'-0"													13	5	5'-11"	4W508	S10		2'-2"	1'-7"	2'-2"									
13	5	3'-11"	2W502	STR	3'-11"													48	5	5'-0"	4W507	22		2'-6"	2'-6"	---			2'-3"	---	1'-1"	---			
22	5	9'-2"	2W503	STR	9'-2"													13	6	14'-2"	4W601	17		3'-7"	10'-7"	---									
▲ 13	5	10'-1"	2W504	STR	10'-1"													15	7	10'-0"	4W701	STR	10'-0"												
▲ 13	5	10'-1"	2W505	STR	10'-1"													13	7	12'-8"	4W702	17		3'-7"	9'-1"	---									
11	5	7'-6"	2W508	STR	7'-6"													WINGWALL NO. 1																	
13	5	5'-5"	2W506	17		2'-2"	1'-1"	2'-2"										10	5	8'-0"	1W501	STR	8'-0"												
13	5	7'-0"	2W507	17		3'-1"	3'-11"	---										13	5	3'-11"	1W502	STR	3'-11"												
33	5	4'-4"	2W509	27		2'-2"	2'-2"	---					2'-1"		0'-7"			23	5	9'-7"	1W503	STR	9'-7"												
ABUTMENT NO. 2																		WINGWALL NO. 3																	
* 18	5	28'-0"	2A501	STR	28'-0"													13	5	5'-11"	4W508	S10		2'-2"	1'-7"	2'-2"									
26	5	3'-11"	2A502	STR	3'-11"													48	5	5'-0"	4W507	22		2'-6"	2'-6"	---			2'-3"	---	1'-1"	---			
52	5	13'-6"	2A503	STR	13'-6"													13	6	14'-2"	4W601	17		3'-7"	10'-7"	---									
21	5	11'-8"	2A504	STR	11'-8"													15	7	10'-0"	4W701	STR	10'-0"												
26	5	8'-3"	2A505	STR	8'-3"													13	7	12'-8"	4W702	17		3'-7"	9'-1"	---									
8	5	4'-3"	2A506	STR	4'-3"													WINGWALL NO. 1																	
5	5	14'-11"	2A508	STR	14'-11"													10	5	8'-0"	1W501	STR	8'-0"												
26	5	5'-11"	2A507	17		2'-2"	1'-7"	2'-2"										13	5	3'-11"	1W502	STR	3'-11"												
26	6	14'-8"	2A601	17		4'-1"	10'-7"	---										23	5	9'-7"	1W503	STR	9'-7"												
55	7	10'-9"	2A701	STR	10'-9"													▲ 13	5	9'-11"	1W504	STR	9'-11"												
26	7	12'-8"	2A702	17		4'-1"	8'-7"	---										▲ 13	5	9'-7"	1W505	STR	9'-7"												
* ▲ 26	8	3'-6"	2A801	STR	3'-6"													WINGWALL NO. 3																	
▲ 13	8	3'-4"	2EA801	STR	3'-4"													13	5	5'-11"	4W508	S10		2'-2"	1'-7"	2'-2"									

~ NOTES ~

- UNLESS OTHERWISE DESIGNATED, ALL BAR REINFORCEMENT FOR CONCRETE IN SIZES UP TO AND INCLUDING NO. 18 SHALL CONFORM TO THE REQUIREMENTS OF THE "SPECIFICATIONS FOR DEFORMED BILLET-STEEL BARS FOR CONCRETE REINFORCEMENT", AASHTO M31 (ASTM A 615-S). ALL BARS SHALL BE GRADE 60, UNLESS OTHERWISE DESIGNATED.
- FOR TYPICAL BENDING DETAILS, RECOMMENDED PIN DIAMETER "D" OF BENDS AND HOOKS, AND OTHER STANDARD PRACTICE, SEE CURRENT CONCRETE REINFORCING STEEL INSTITUTE "MANUAL OF STANDARD PRACTICE".
- BARS WHICH REQUIRE MORE ACCURATE BENDING THAN STANDARD PRACTICES SHOULD HAVE LIMITS INDICATED.
- ALL DIMENSIONS ARE OUT TO OUT OF BAR EXCEPT "A" AND "G" ON STANDARD 180 DEGREE AND 135 DEGREE HOOKS.
- "J" DIMENSION ON 180 DEGREE HOOKS TO BE SHOWN ONLY WHERE NECESSARY TO RESTRICT HOOK SIZE. OTHERWISE, STANDARD HOOKS ARE TO BE USED.
- "H" DIMENSION ON STIRRUPS TO BE SHOWN ONLY WHEN NECESSARY TO MAINTAIN CLEARANCES.
- WHERE SLOPE DIFFERS FROM 45 DEGREES, DIMENSIONS "H" AND "K" MUST BE SHOWN.
- ▲ DENOTES BARS TO BE CUT IN FIELD.
- * DENOTES ONE EXTRA BAR ADDED FOR TESTING PURPOSES.
- △ DENOTES TWO EXTRA BARS ADDED FOR TESTING PURPOSES.
- E IN BAR MARK PREFIX DENOTES EPOXY COATED REINFORCING STEEL.

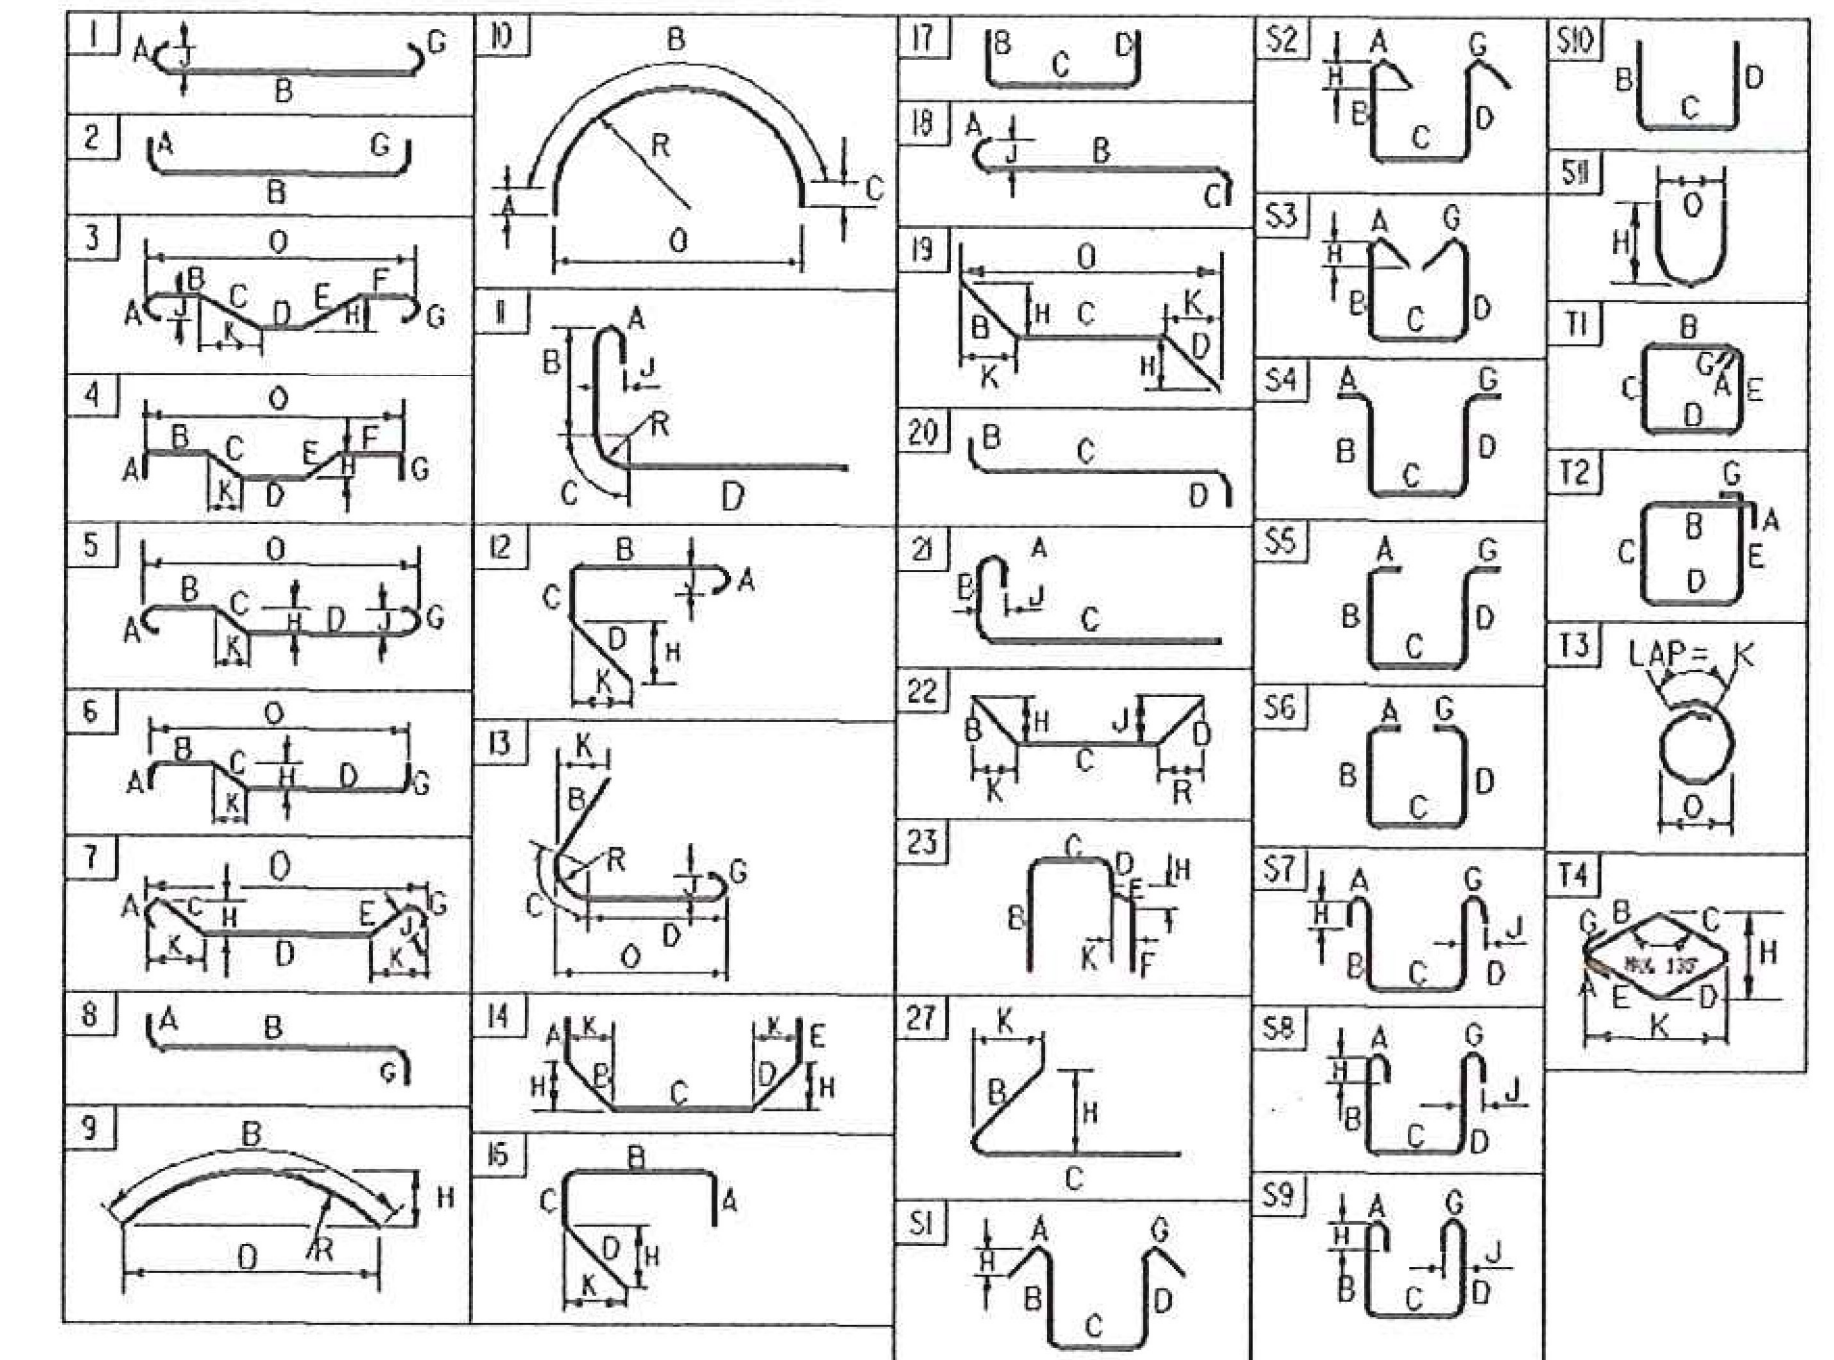

ASTM STANDARD REINFORCING BARS

Bar Size	Yield Strength (ksi)	Tensile Strength (ksi)	Elongation (%)	Weight (lb/ft)
#3	0.376	0.375	0.11	1.178
#4	0.668	0.500	0.20	1.571
#5	1.043	0.625	0.31	1.963
#6	1.502	0.750	0.44	2.356
#7	2.04	0.875	0.60	2.749
#8	2.670	1.000	0.79	3.14
#9	3.400	1.13	1.00	3.54
#10	4.3	1.270	1.27	3.990
#11	5.31	1.410	1.56	4.430
#14	7.65	1.69	2.25	5.32
#18	13.60	2.26	4.00	7.09

~ REINFORCING STEEL CORROSION RESISTANCE LEVEL ~
 THE REINFORCING STEEL MARKS IN THIS SCHEDULE INDICATE THE REQUIRED BAR CORROSION RESISTANCE LEVEL. CORROSION RESISTANCE LEVEL IS DENOTED WITH A 2 FOR LEVEL TWO SUFFIX OR 3 FOR LEVEL THREE SUFFIX. 1 FOR LEVEL ONE IS TO BE OMITTED. THE BAR MATERIAL TYPE AND BAR STEEL GRADE PROVIDED FOR EACH CORROSION LEVEL WILL BE RECORDED ON THE PLAN SET PLOT SHEET FOR AS-BUILT RECORD PLAN ARCHIVES.

REVISION	DATE	DESCRIPTION	BY
3	07-12-2016	ABUTMENT & WINGWALL REINFORCING STEEL CHANGES	MCL

PROJECT NAME: HUNTINGTON
 PROJECT NUMBER: BRO 1445(35)
 FILE NAME: sl2j162rss.dgn
 PROJECT LEADER: C. CARLSON
 DESIGNED BY: D. PETERSON
 REINFORCING STEEL SCHEDULE
 PLOT DATE: 13-JUL-2016
 DRAWN BY: R. PELLET
 CHECKED BY: D. PETERSON
 SHEET 27A OF 44