




FINAL GRADES DROWN. SEE SURVEY FOLDER FOR EXACT ELEVATIONS.

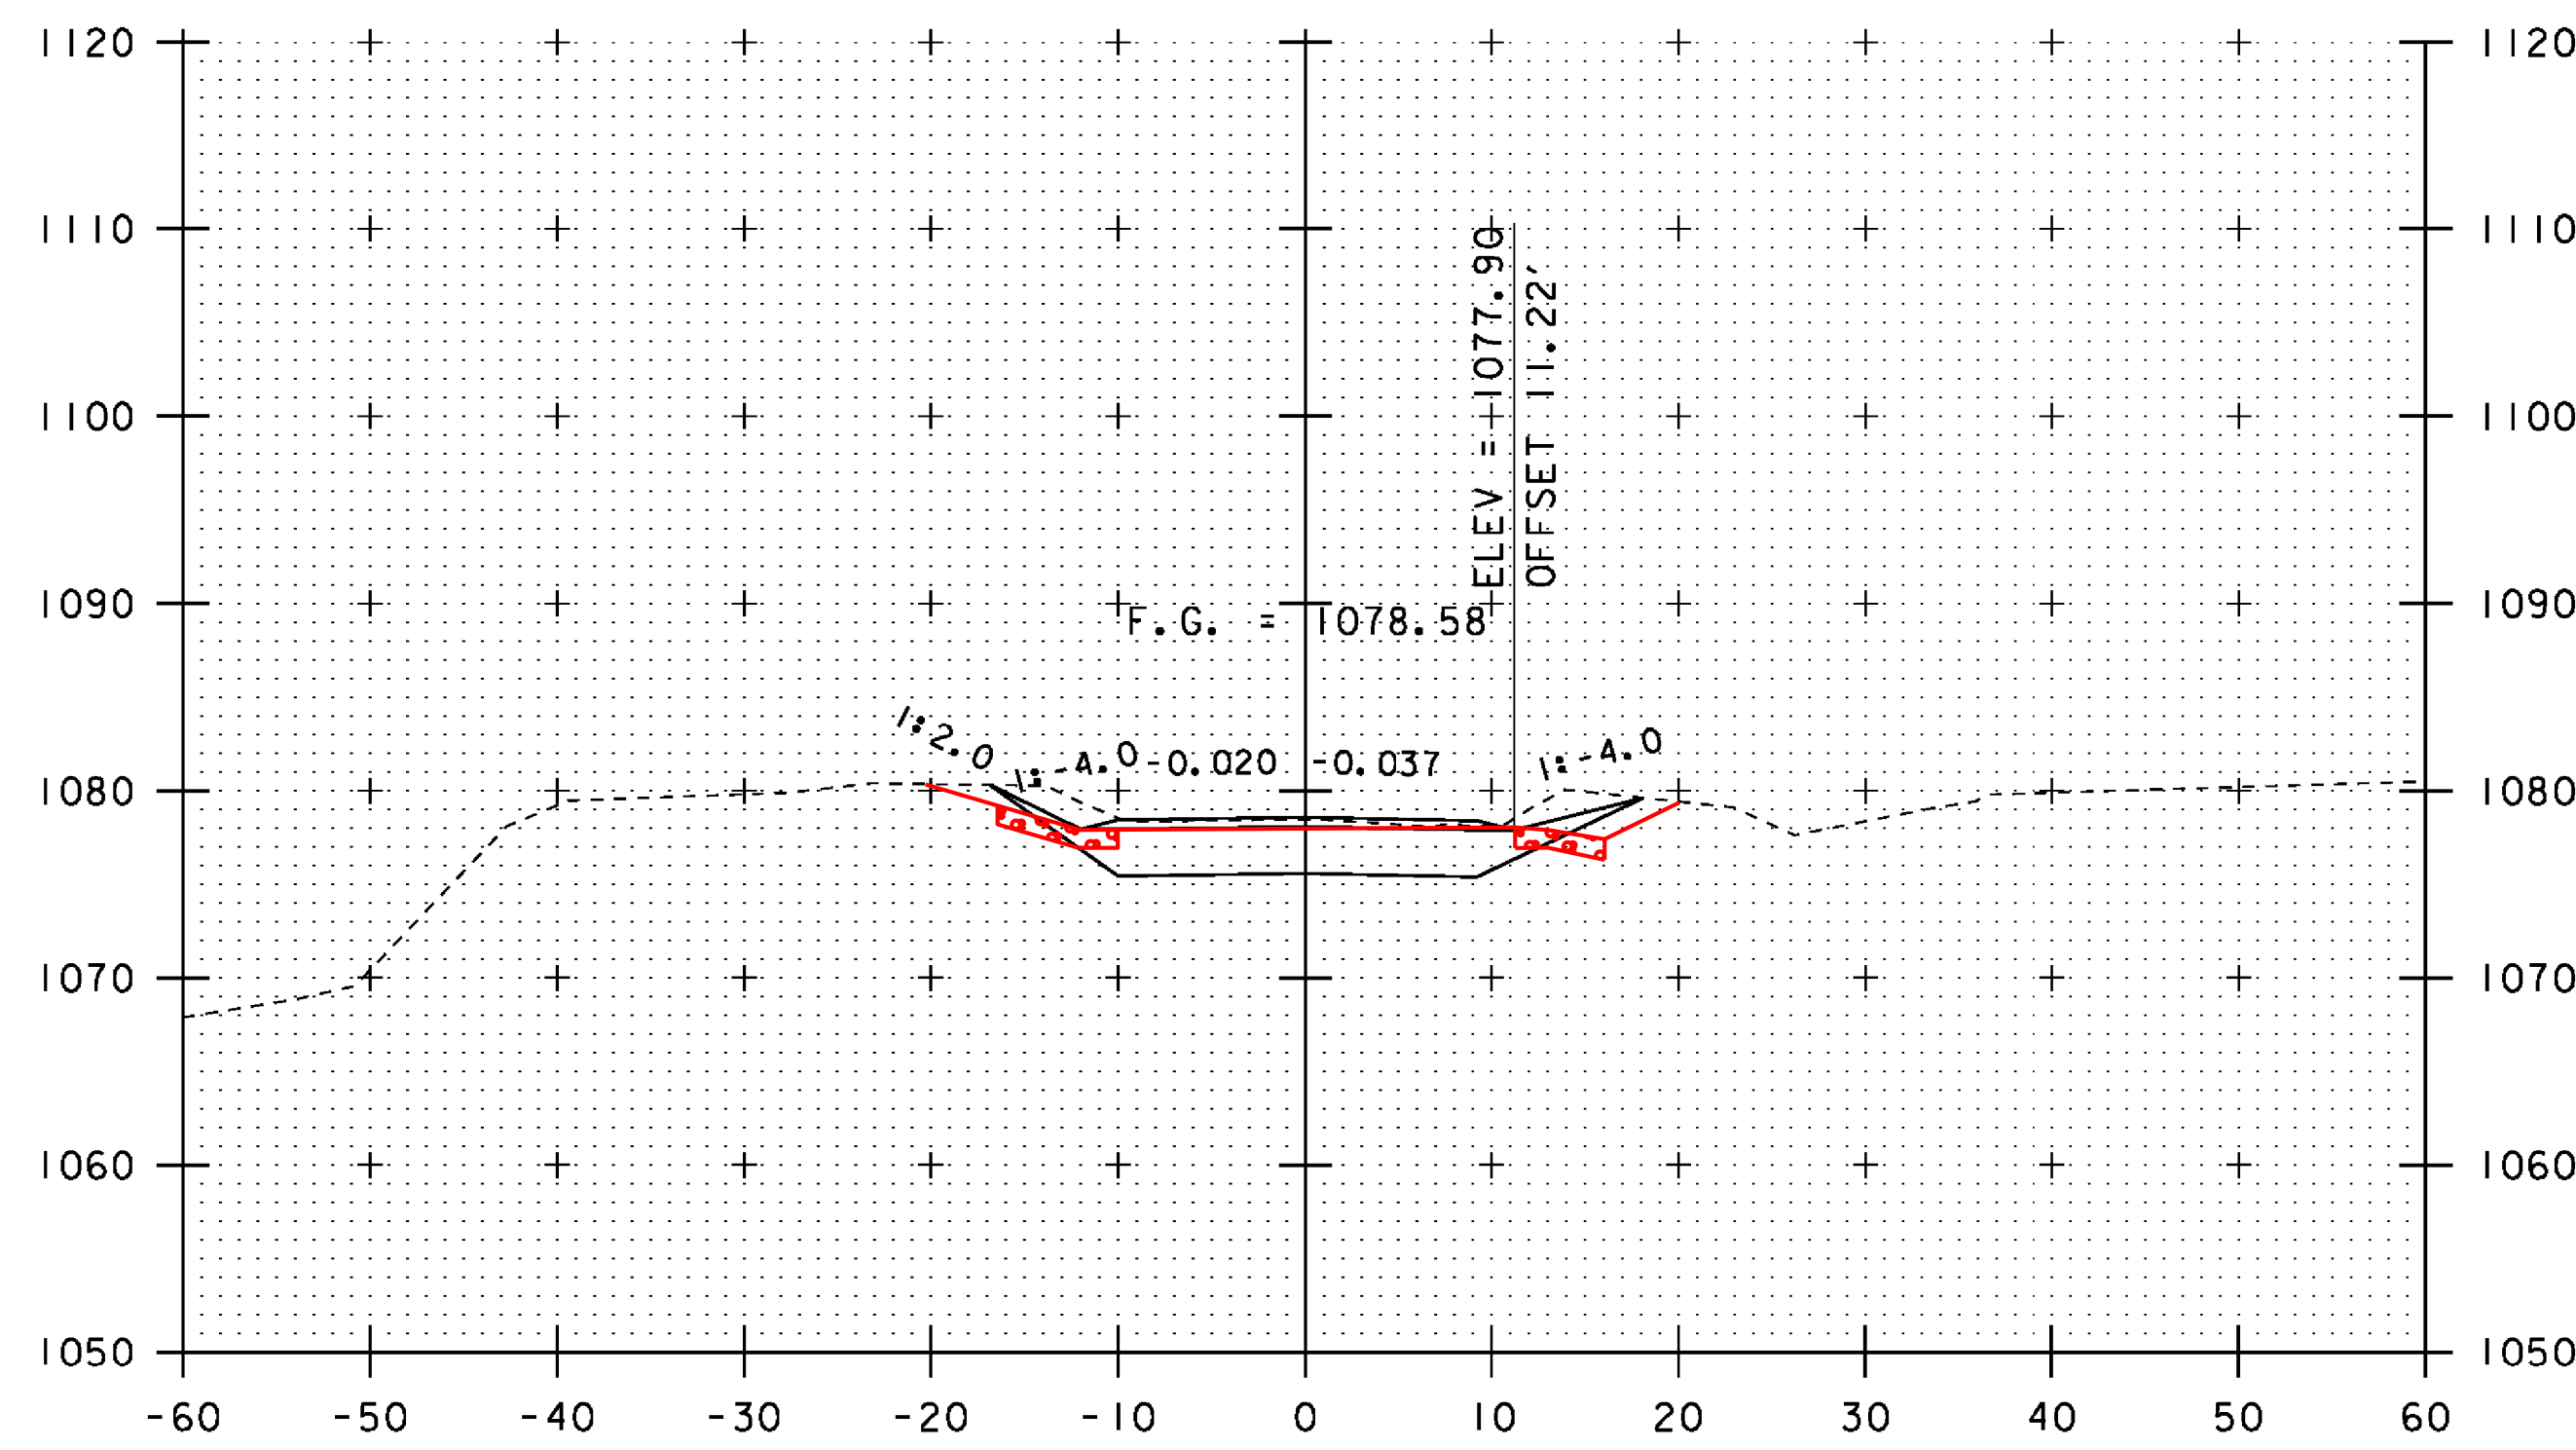


20+25

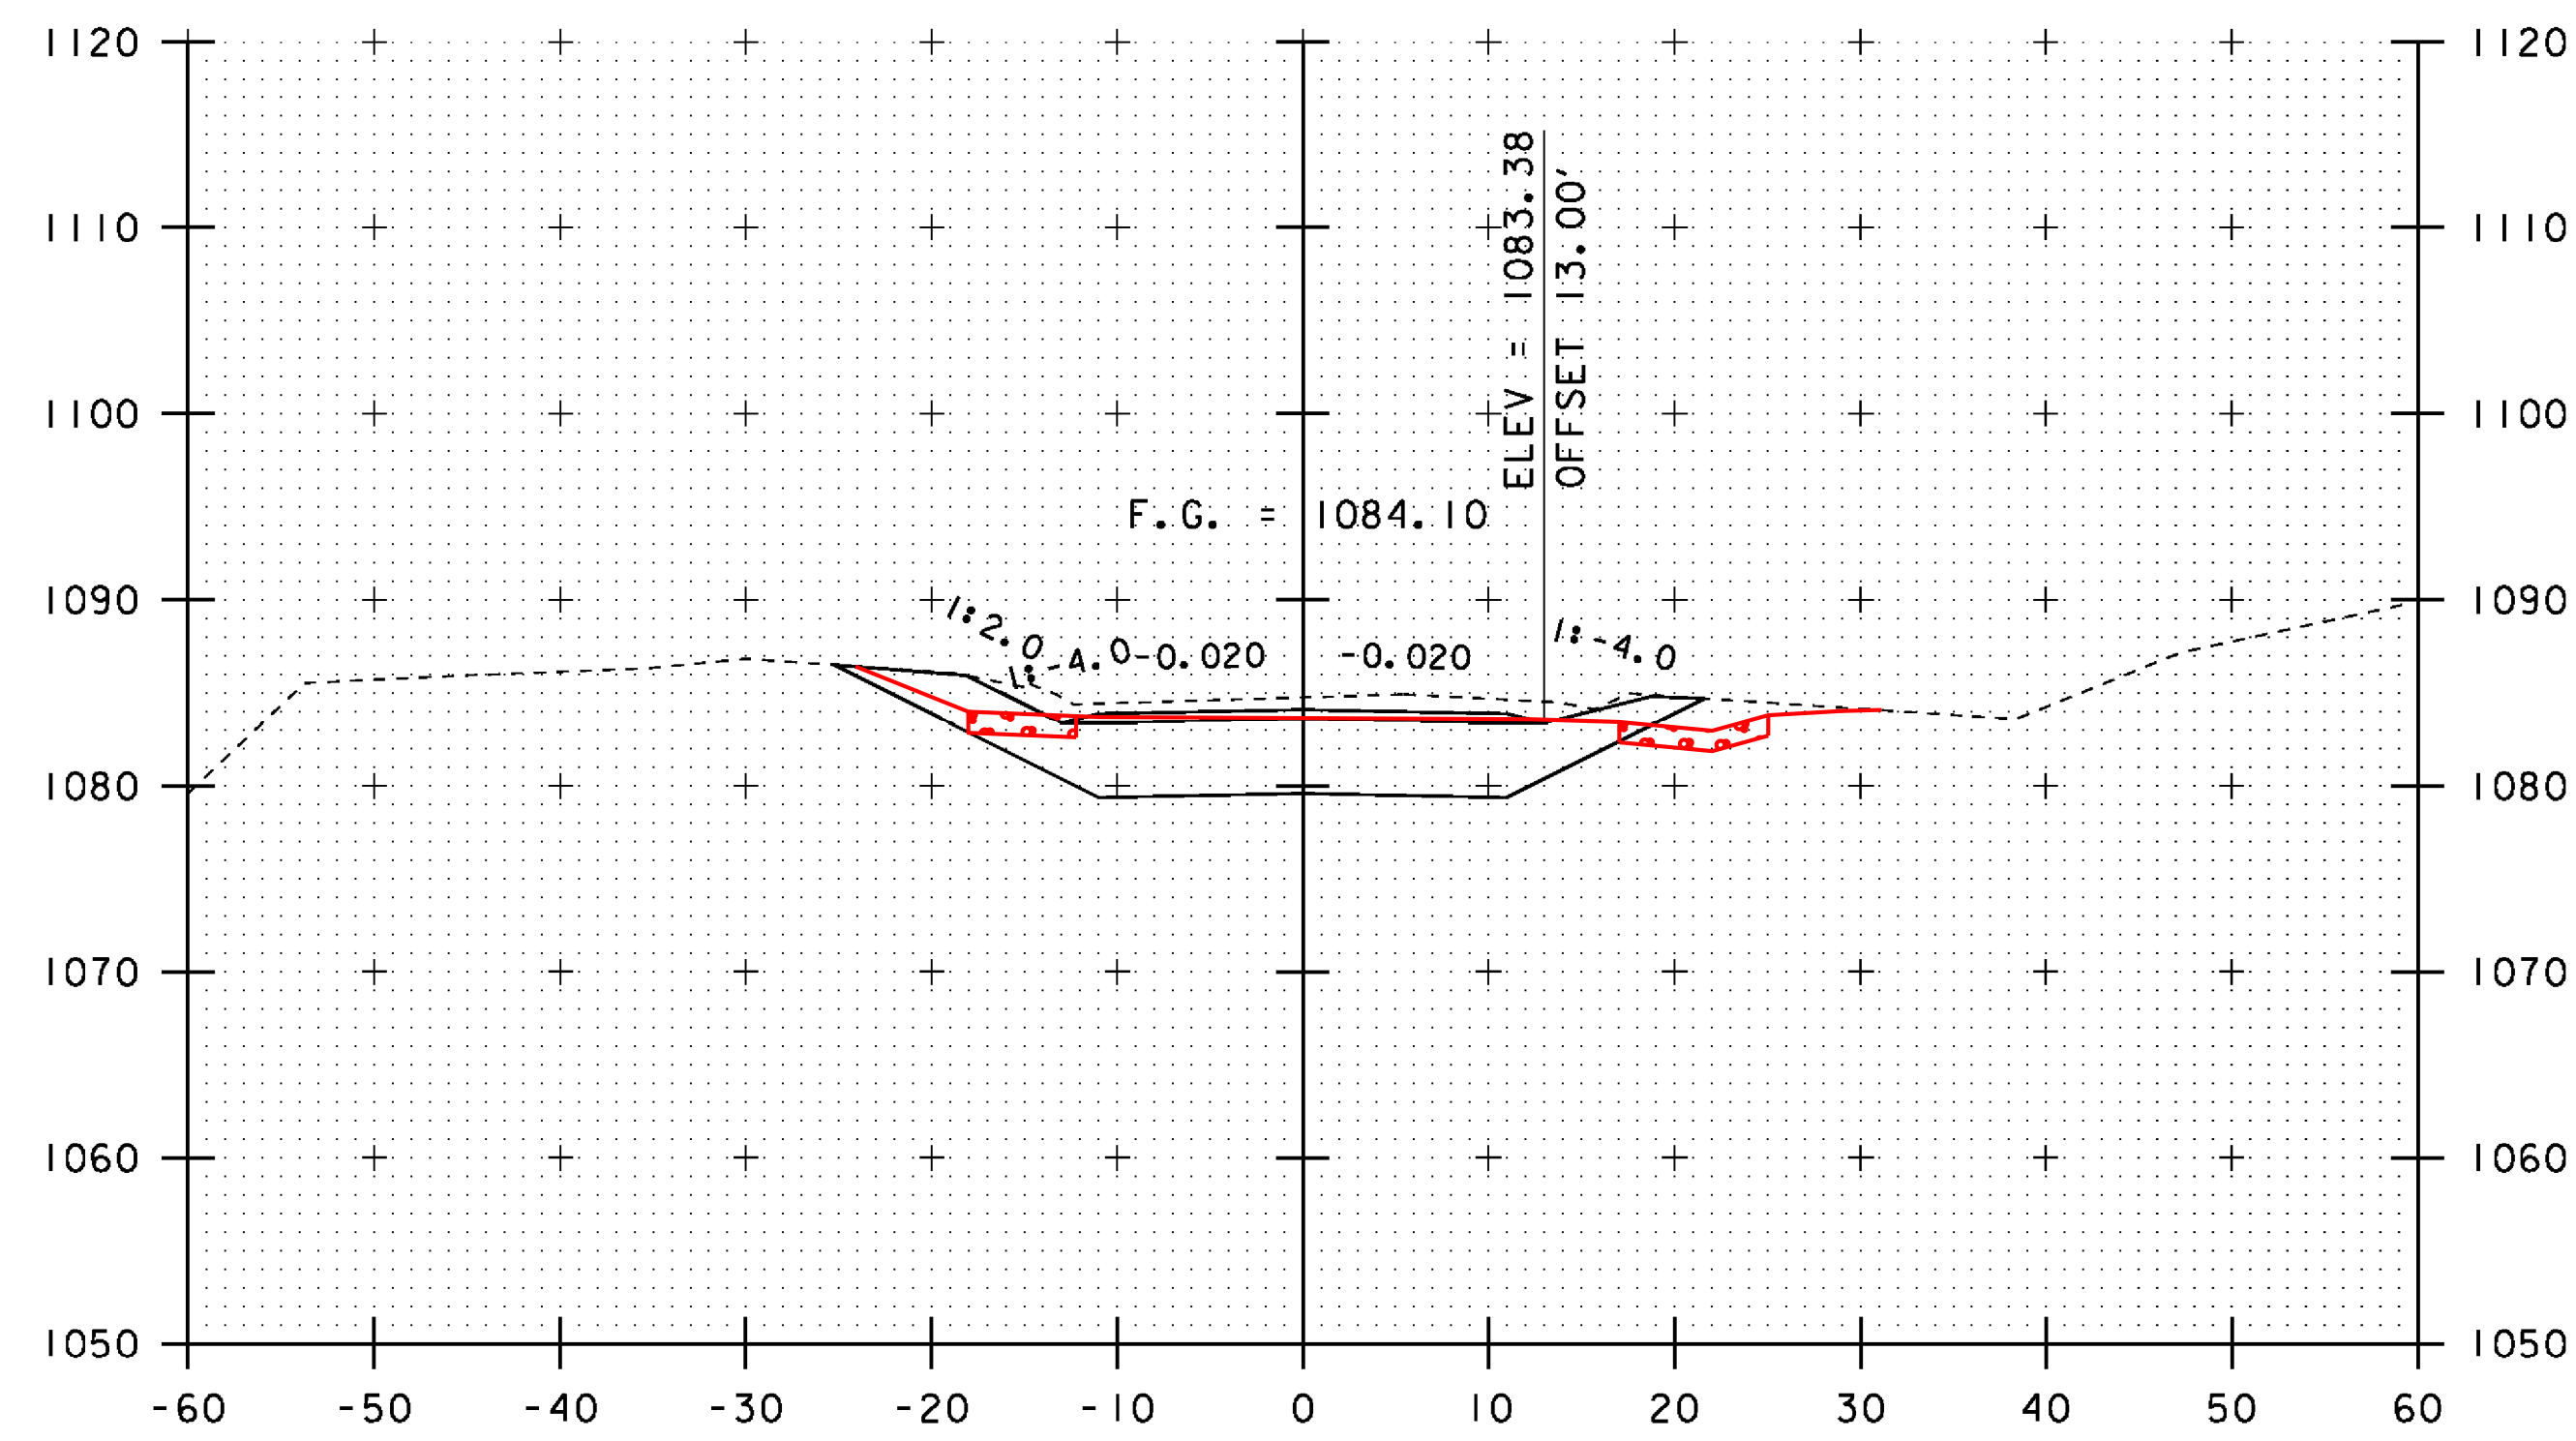

20+75

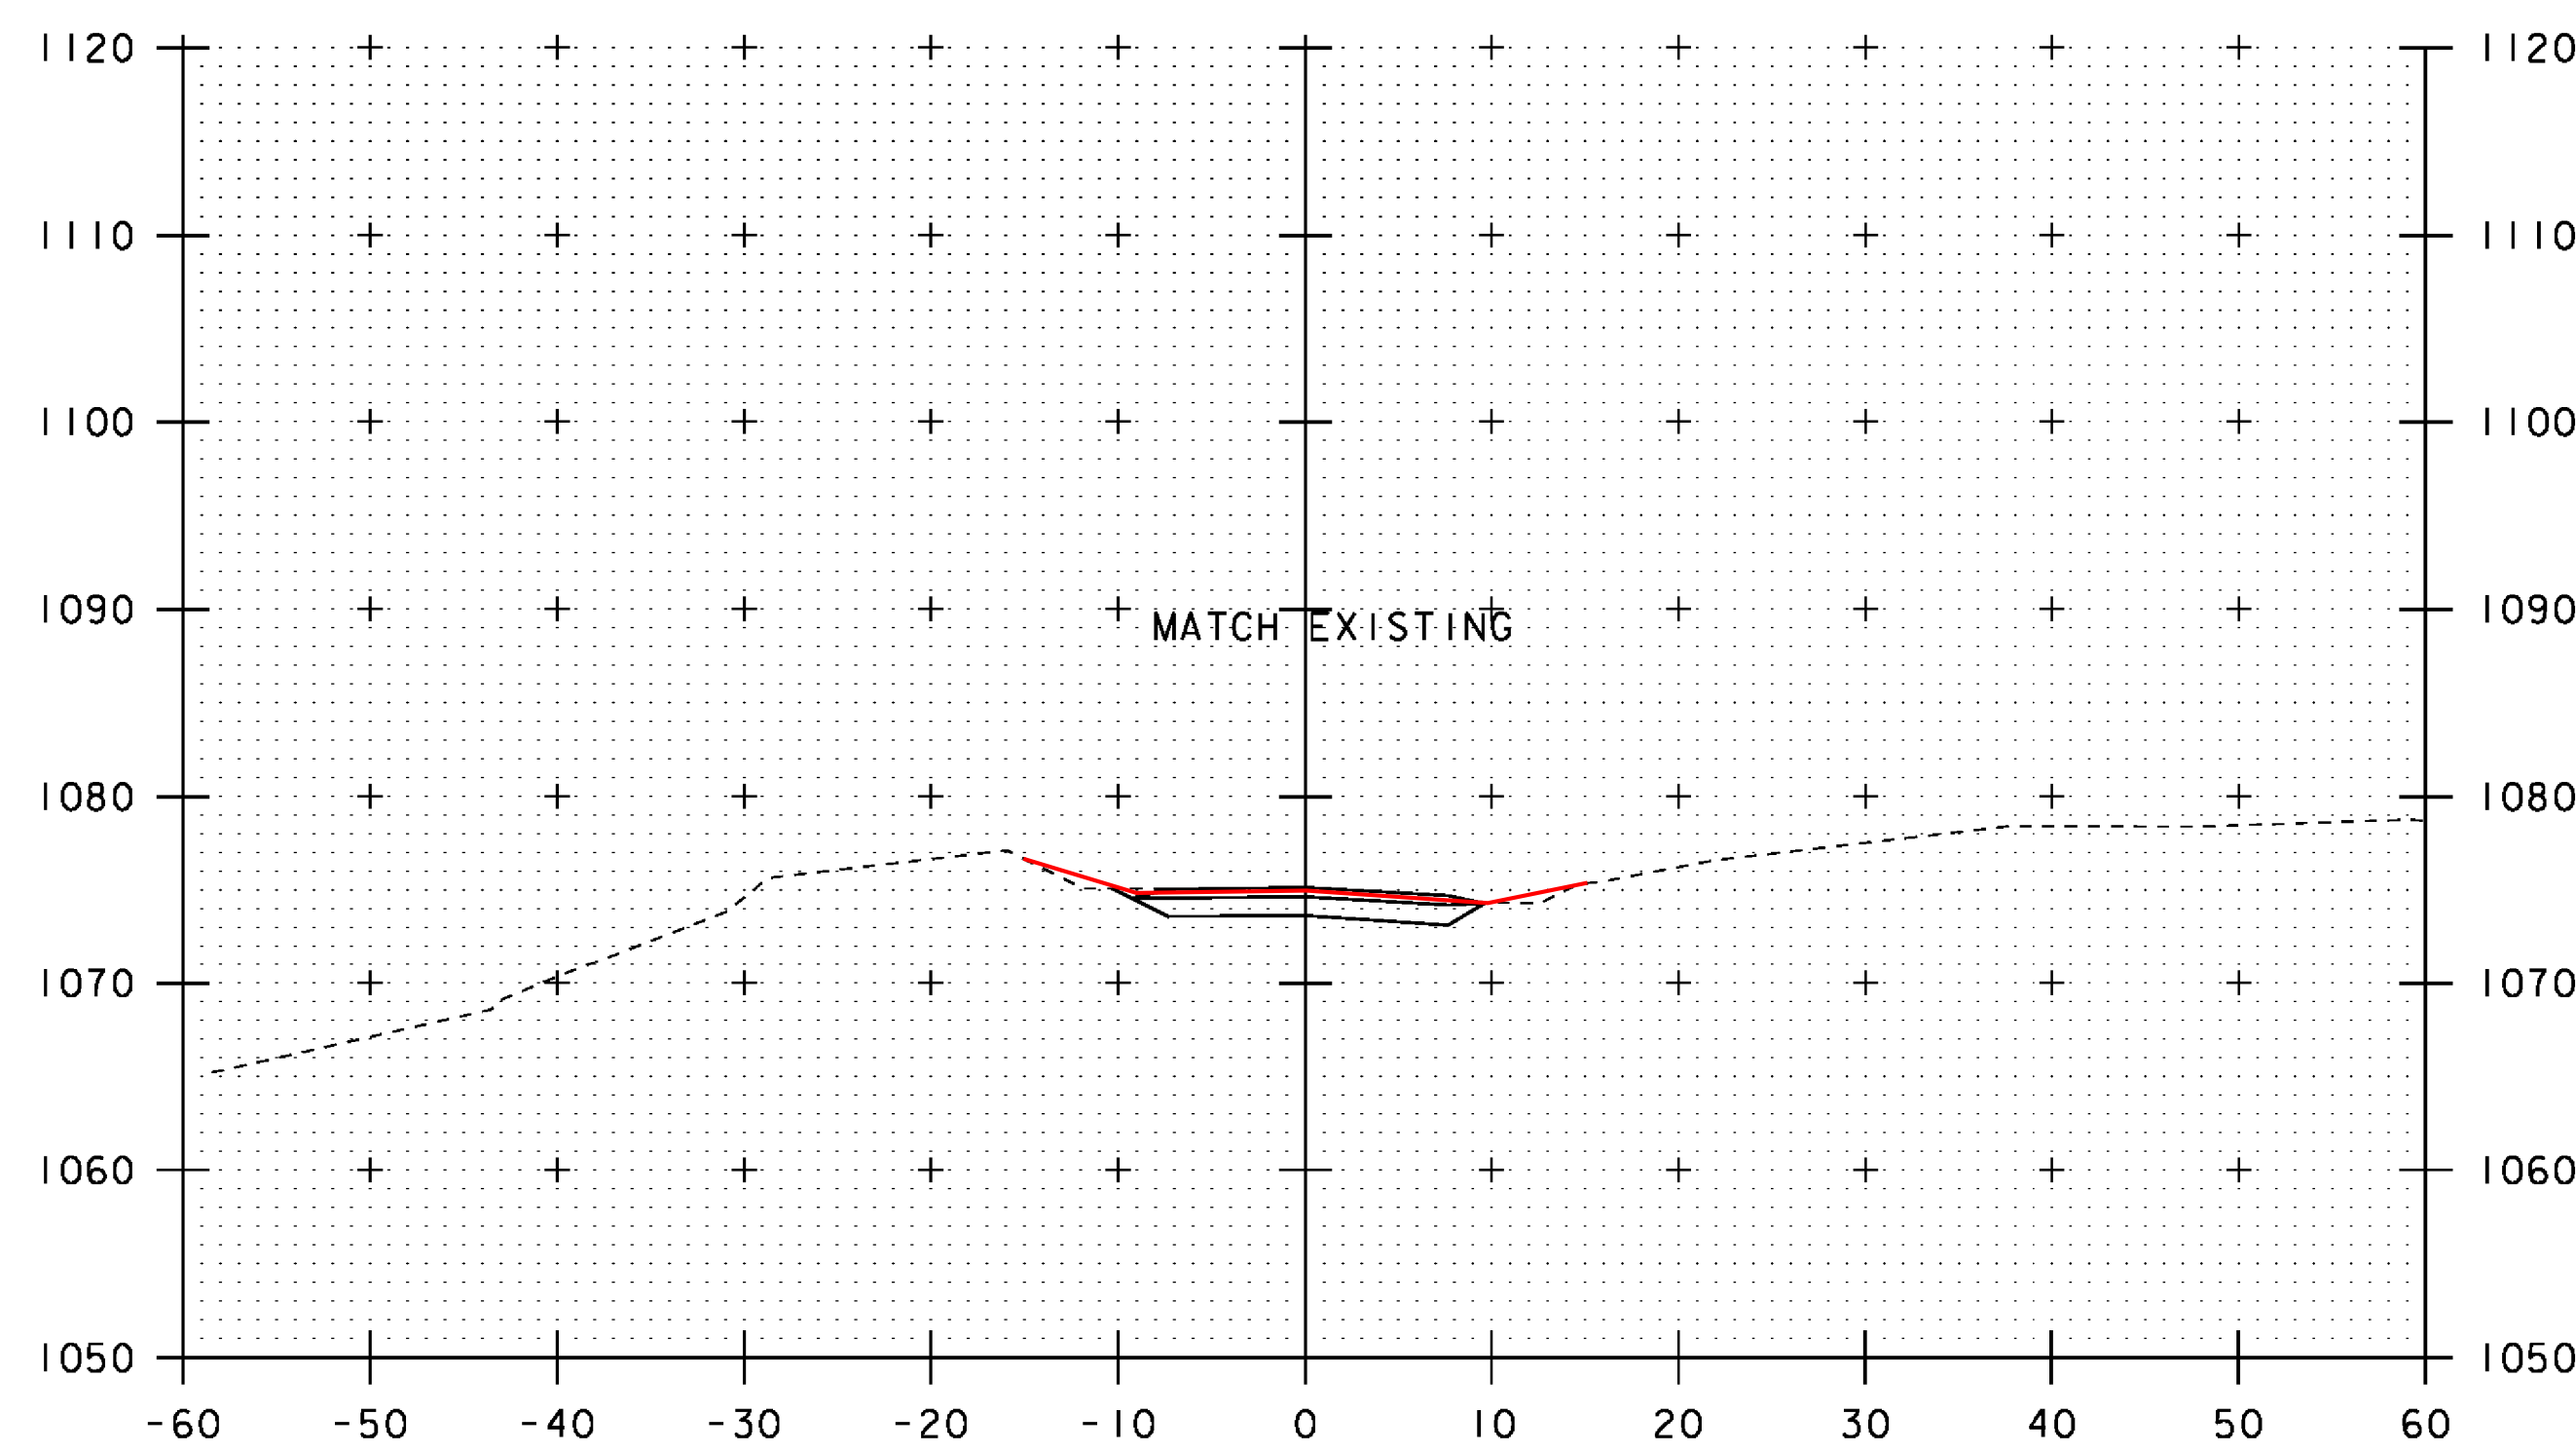

20+00
BEGIN APPROACH

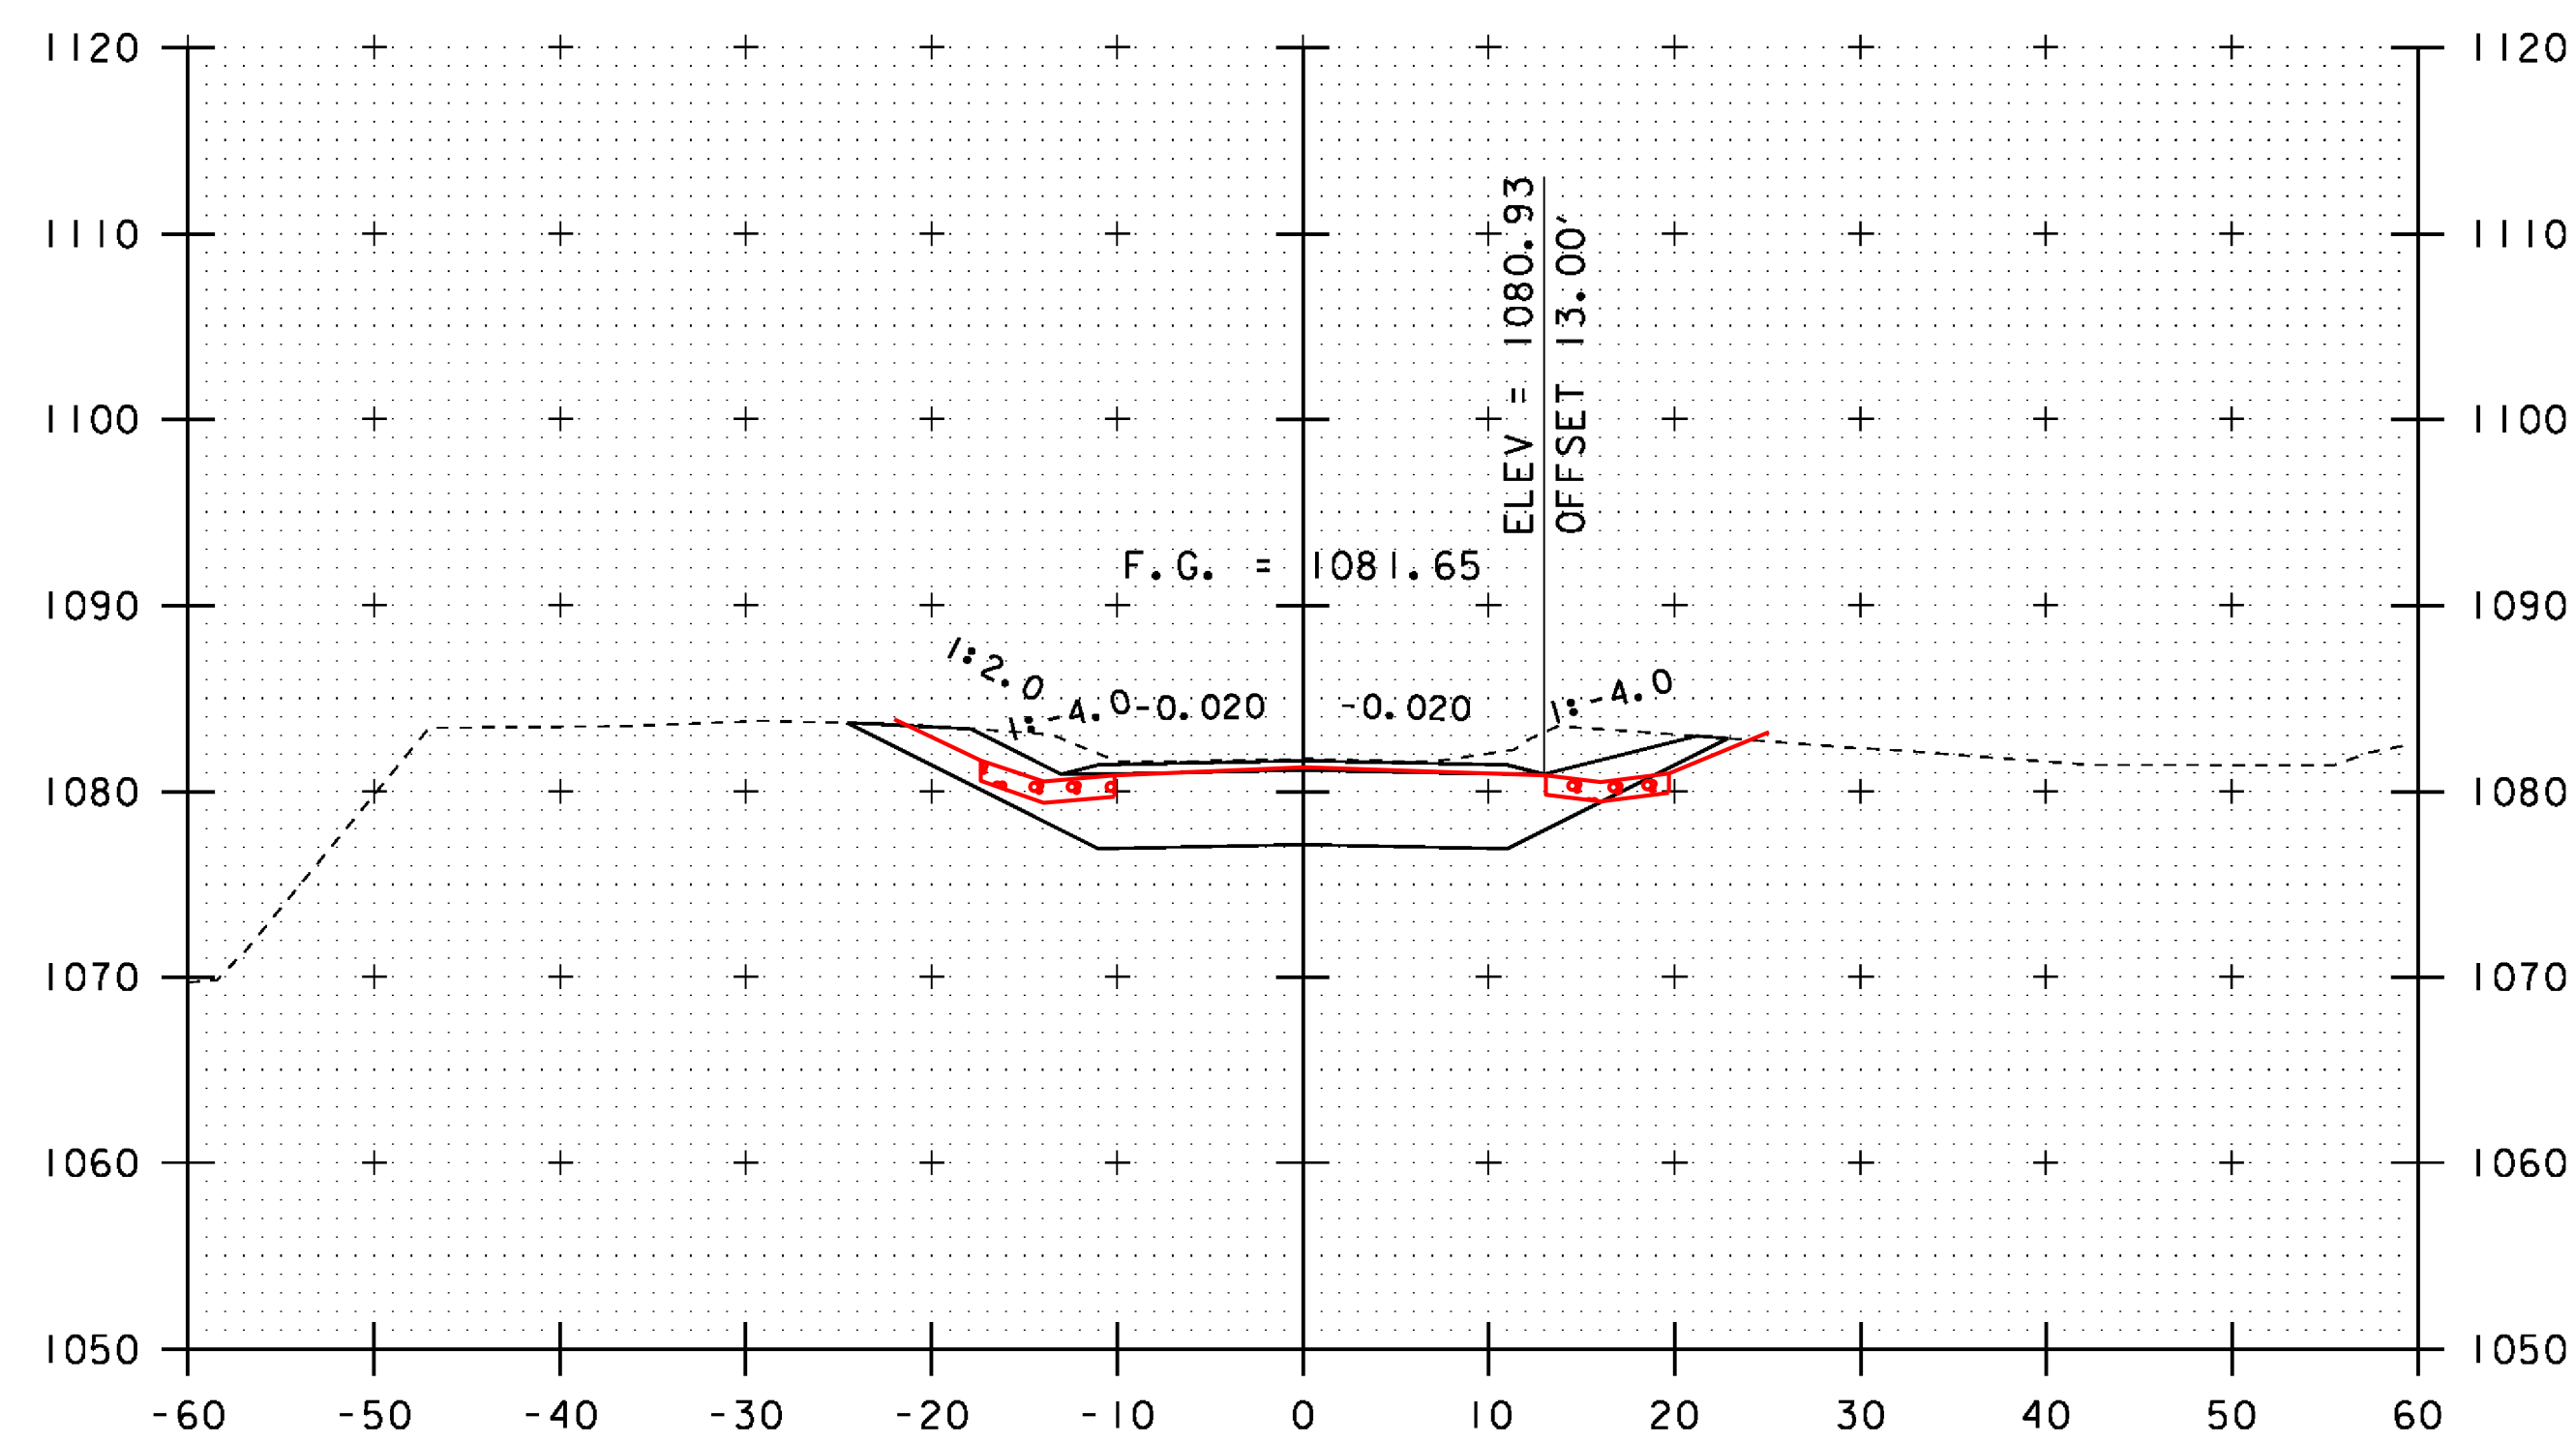

20+50
BEGIN PROJECT

SCALE 1" = 10' - 0"
10 0 10

STA. 20+00 TO STA. 20+75

PROJECT NAME: HUNTINGTON
PROJECT NUMBER: BRO 1445(35)

FILE NAME: s12j162xs.dgn
PROJECT LEADER: C. CARLSON
DESIGNED BY: D. PETERSON
MAINLINE CROSS SECTIONS I

PLOT DATE: 15-OCT-2015
DRAWN BY: R. PELLETT
CHECKED BY: D. PETERSON
SHEET 28 OF 44