




FINAL GRADES DROWN. SEE SURVEY FOLDER FOR EXACT ELEVATIONS.

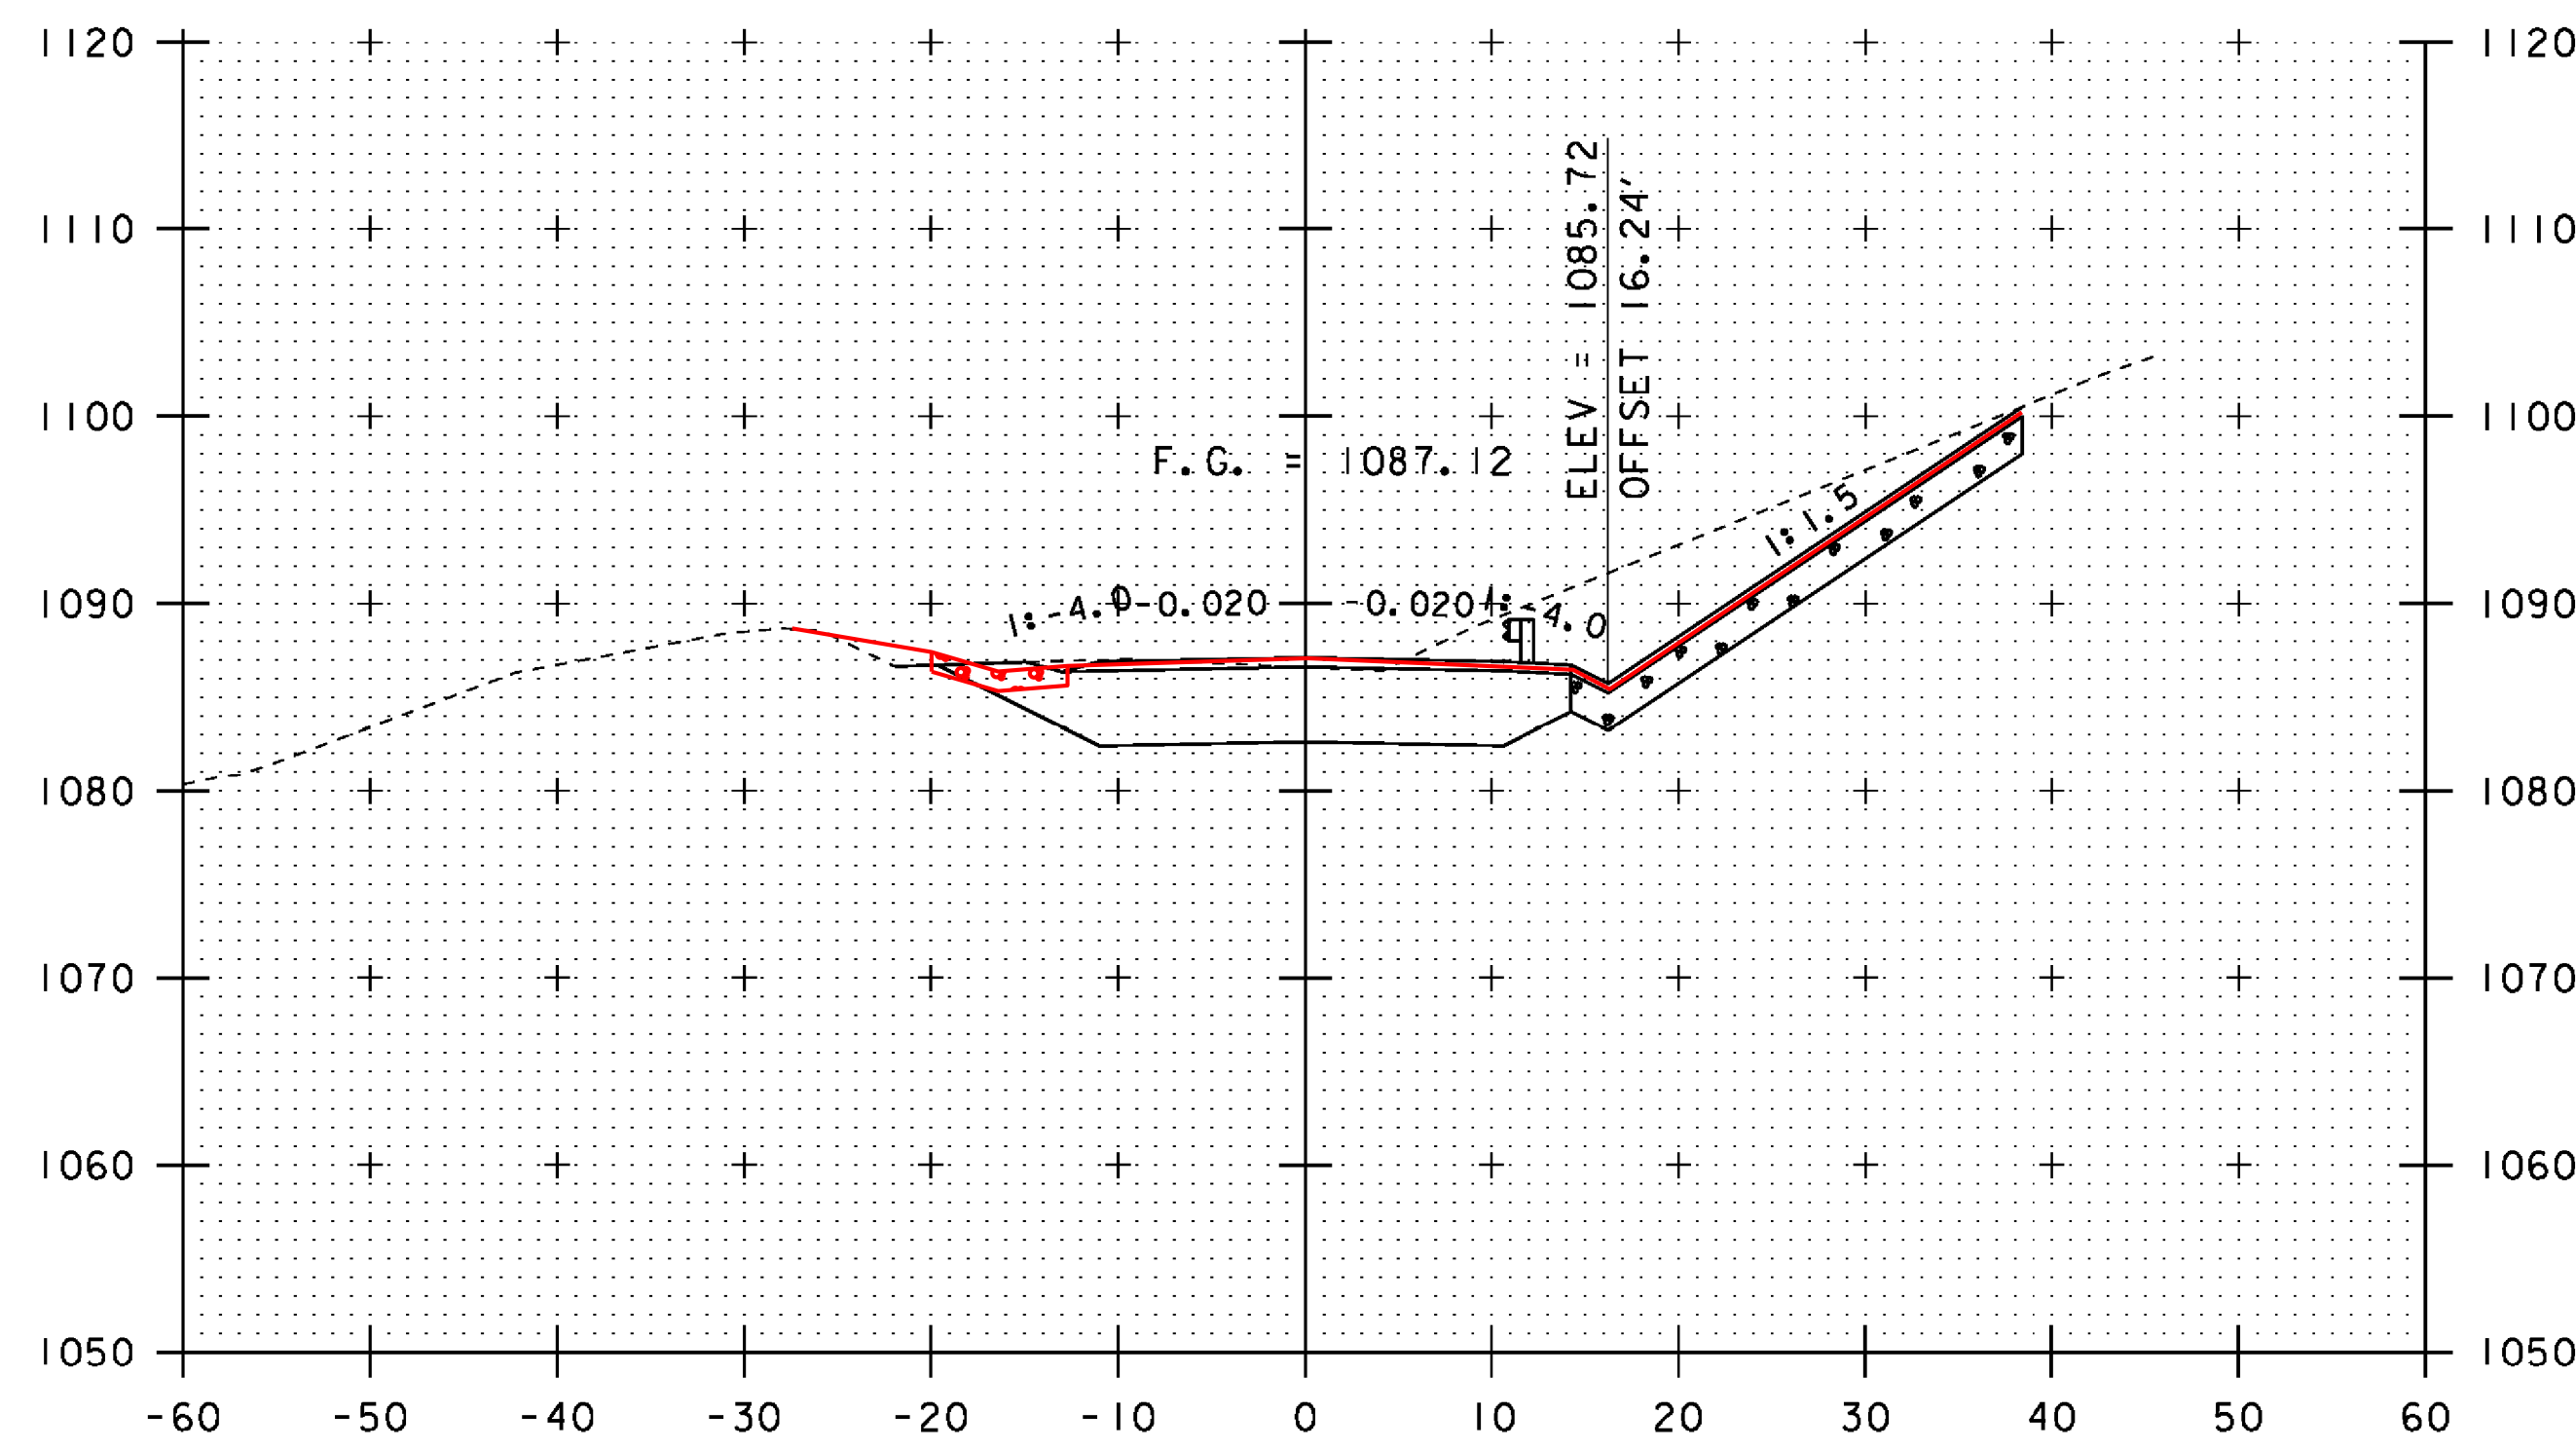


21+25

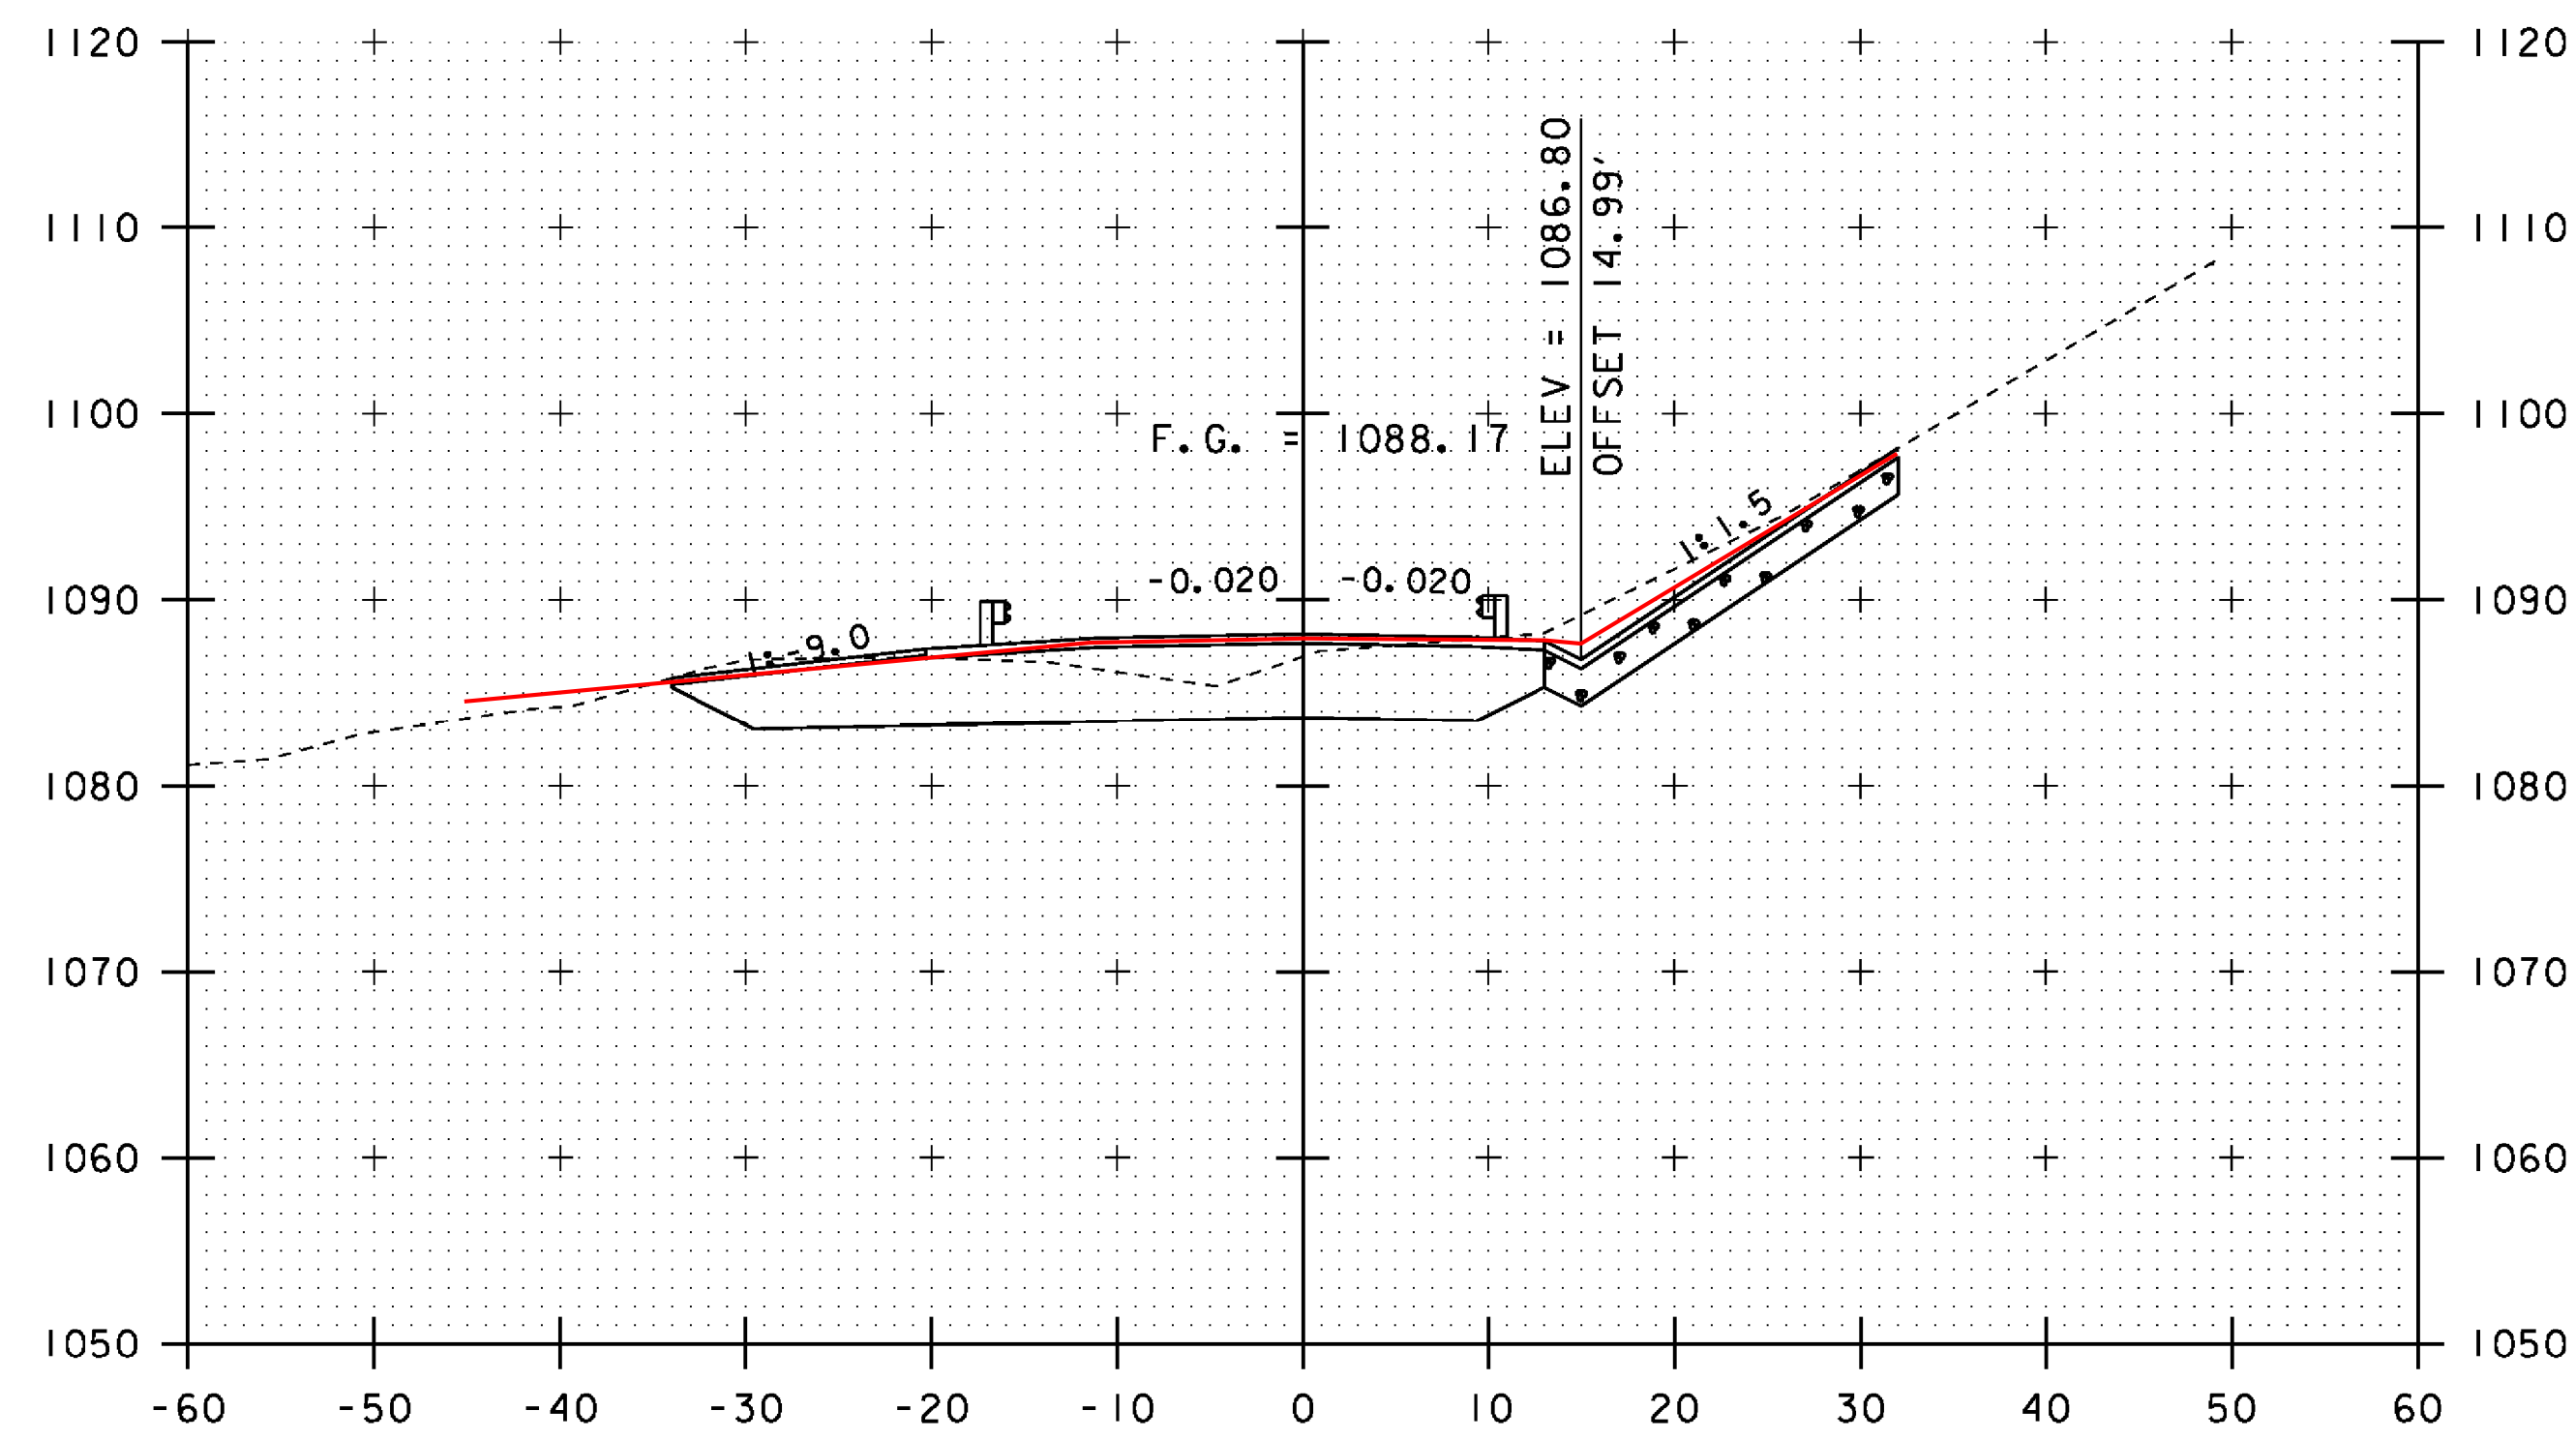

21+75

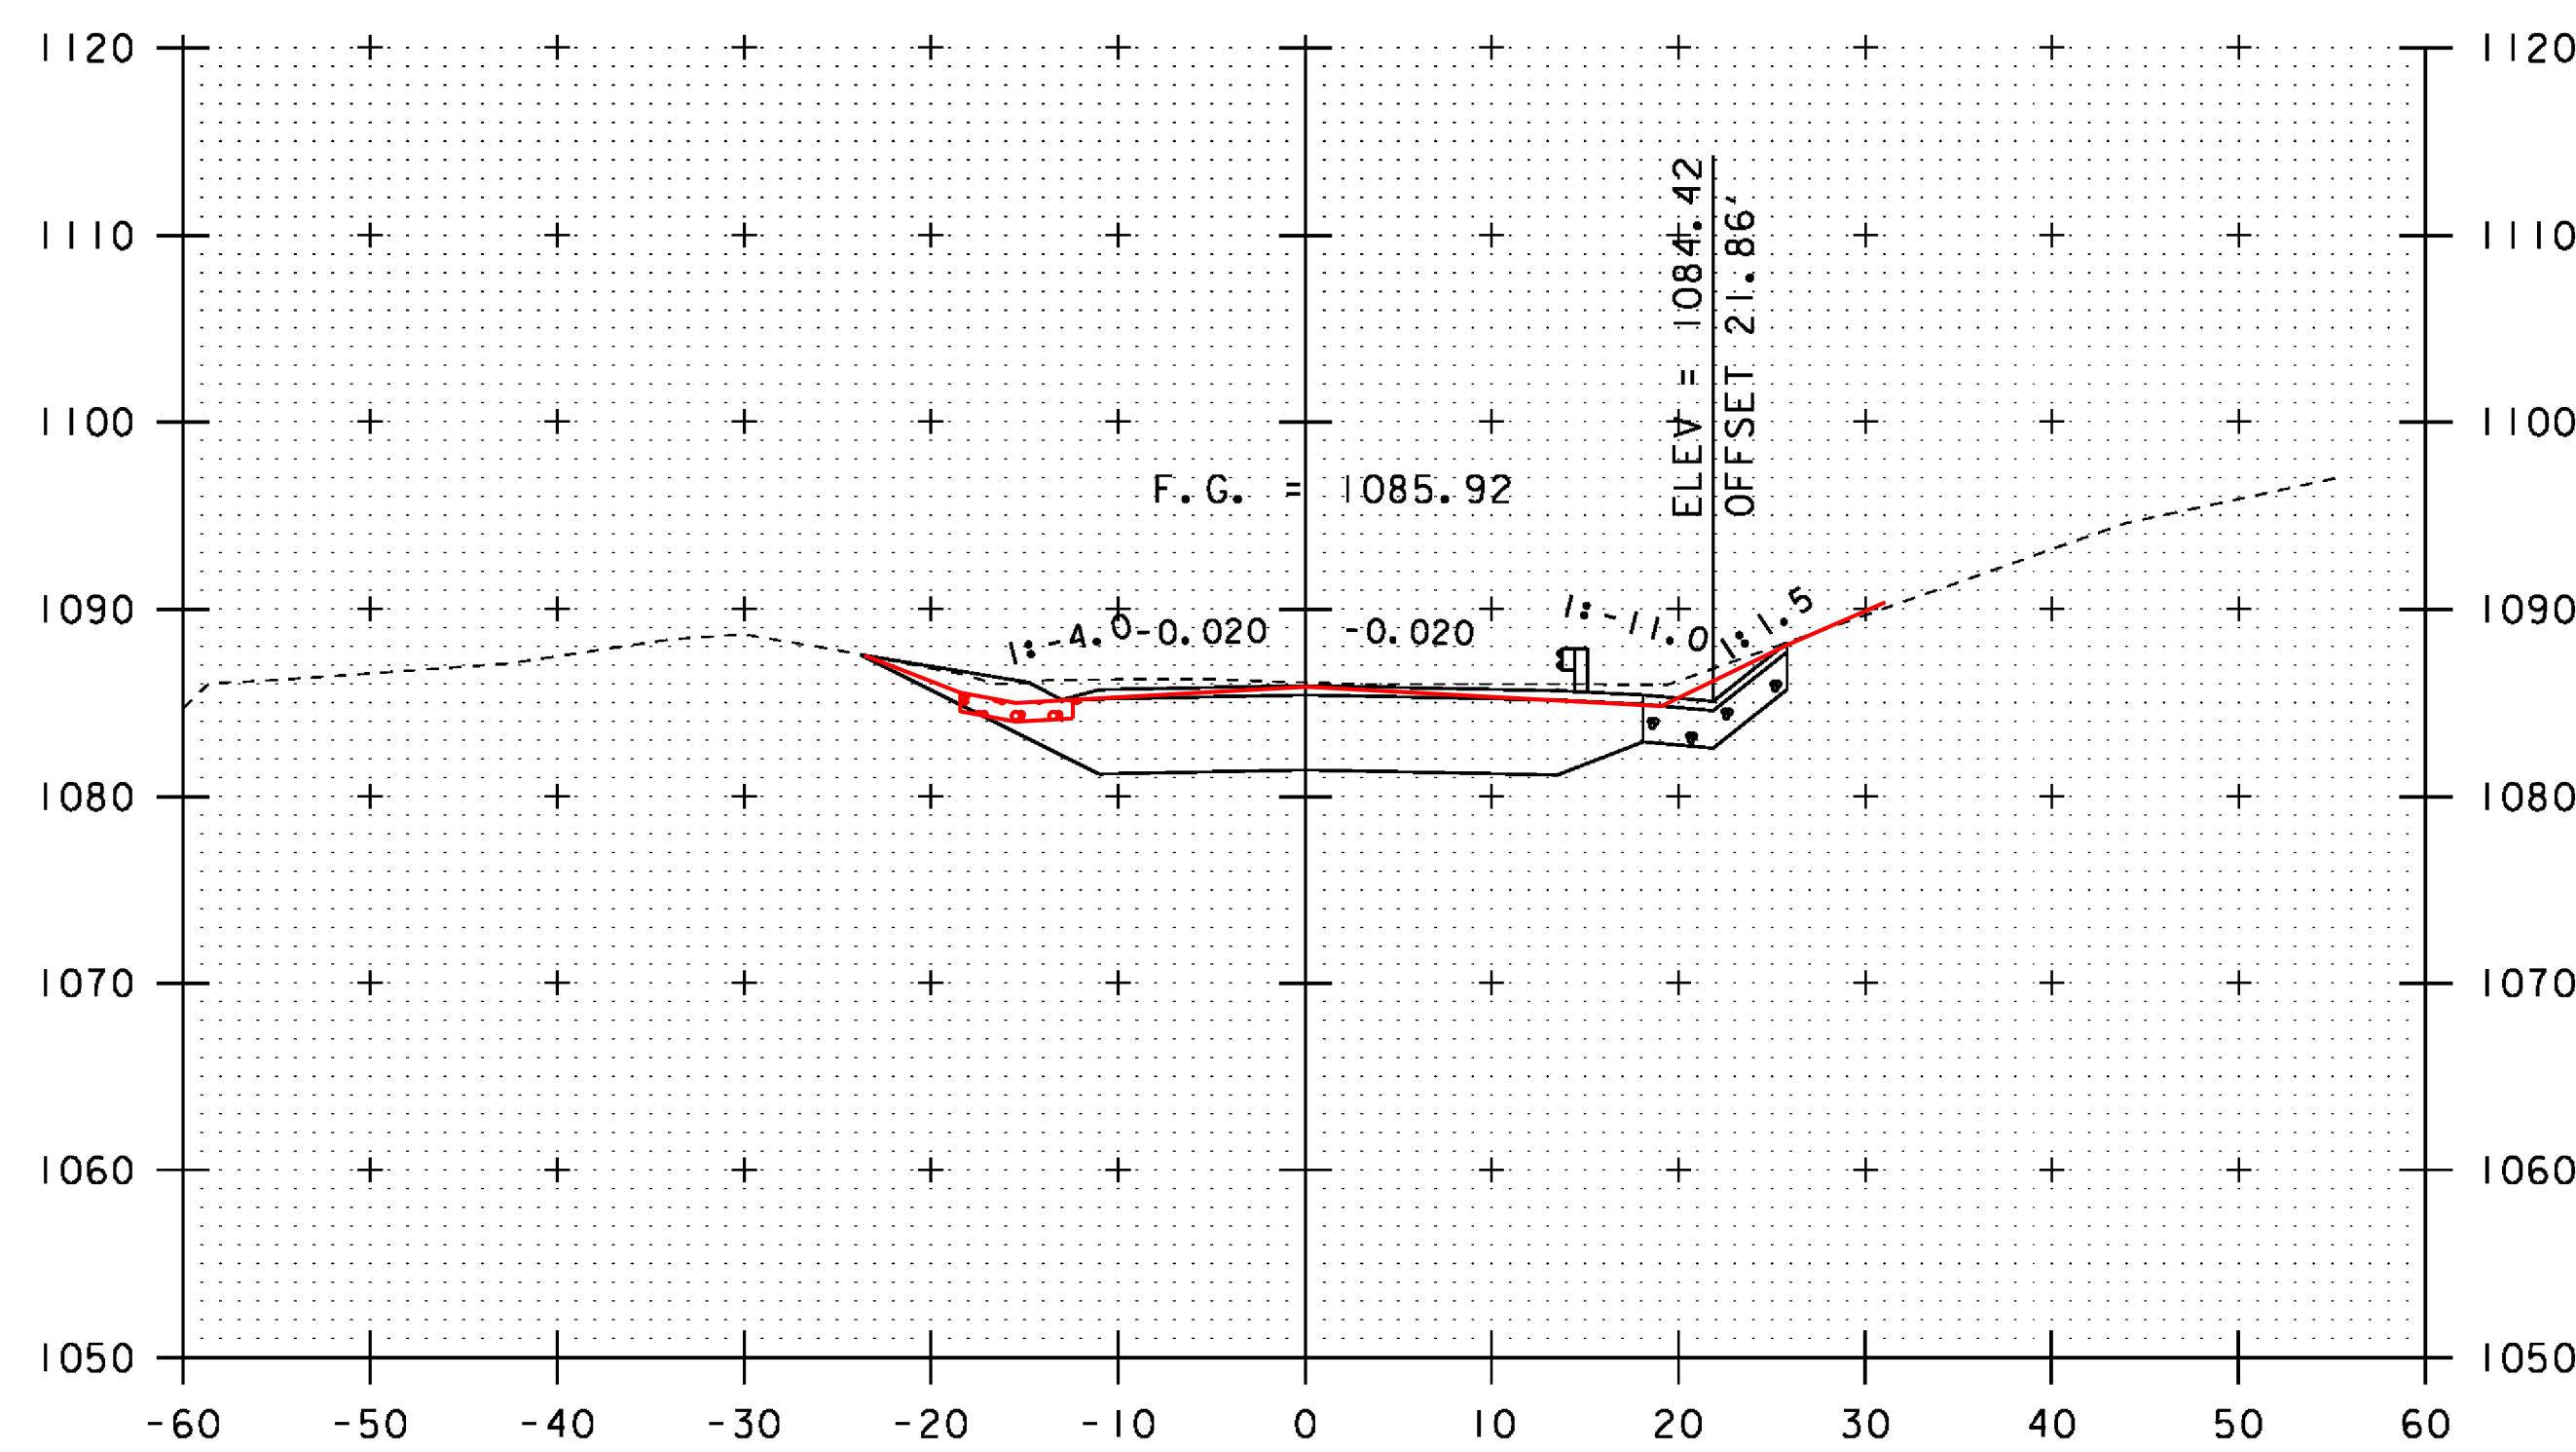

21+00

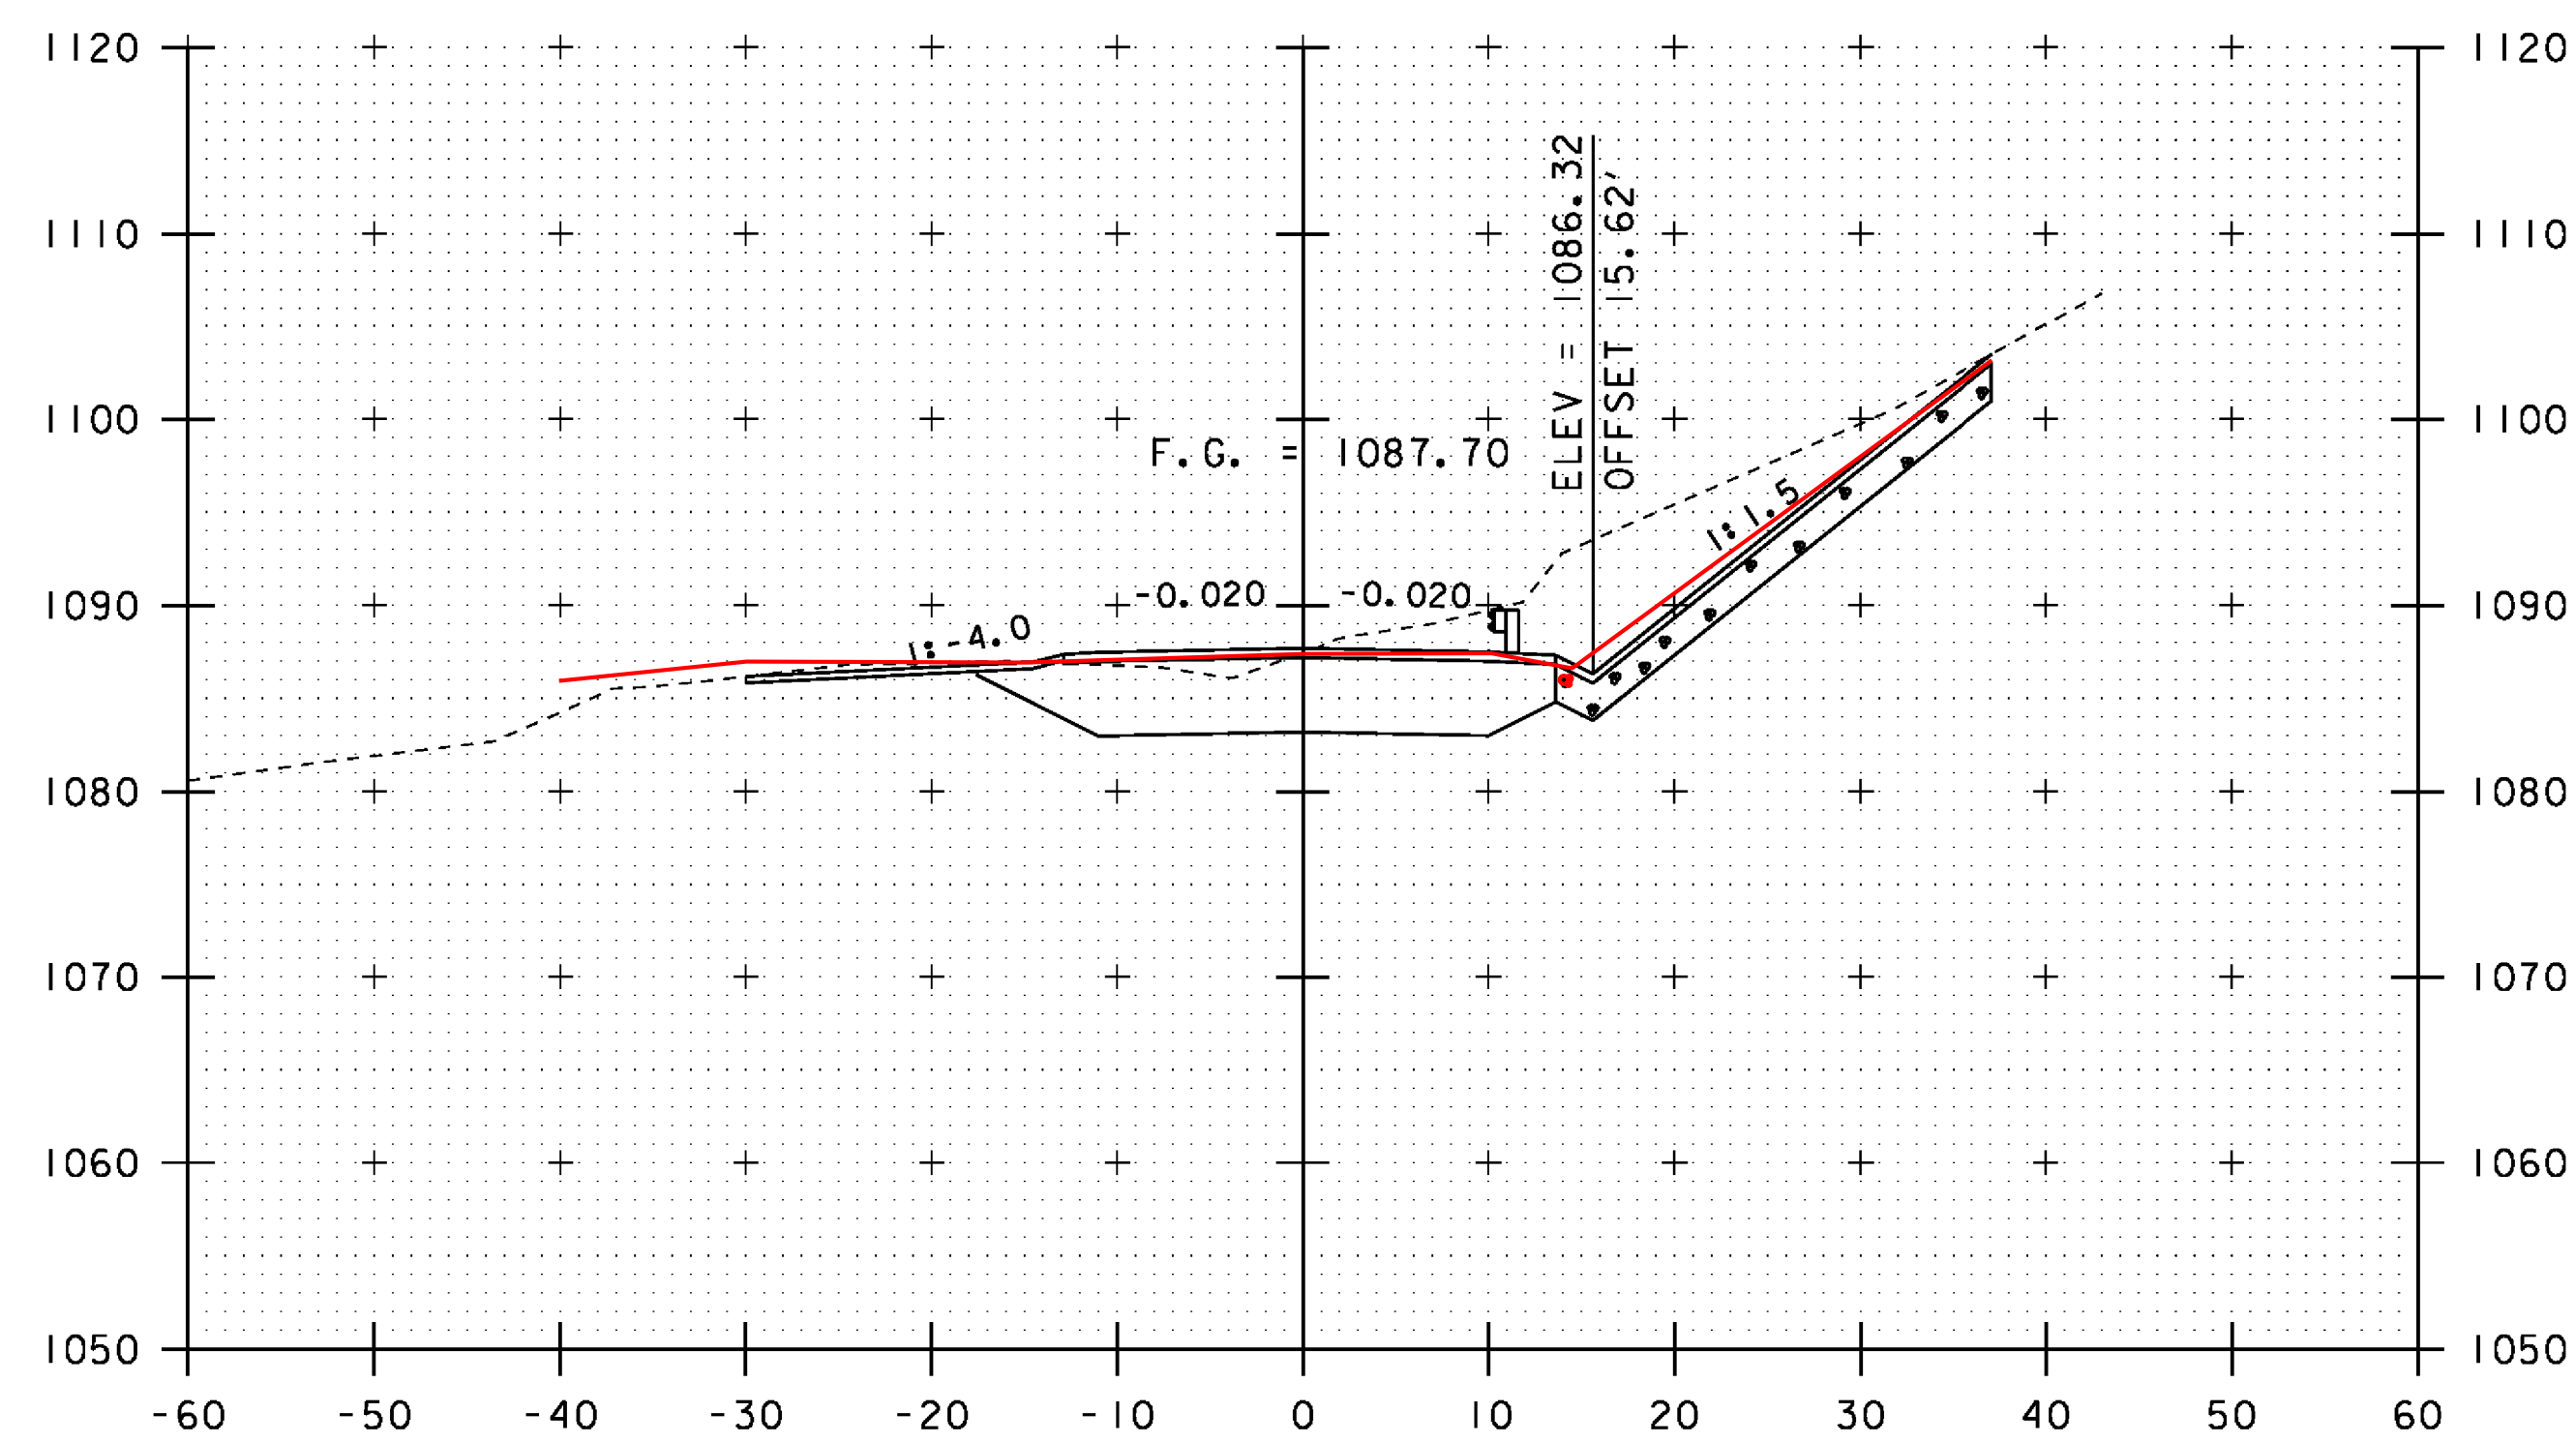

21+50

SCALE 1" = 10'-0"

STA. 21+00 TO STA. 21+75

PROJECT NAME:	HUNTINGTON	PLOT DATE:	15-OCT-2015
PROJECT NUMBER:	BRO 1445(35)	DRAWN BY:	R. PELLETT
FILE NAME:	s12j162xs.dgn	DESIGNED BY:	D. PETERSON
PROJECT LEADER:	C. CARLSON	CHECKED BY:	D. PETERSON
MAINLINE CROSS SECTIONS 2		SHEET	29 OF 44