

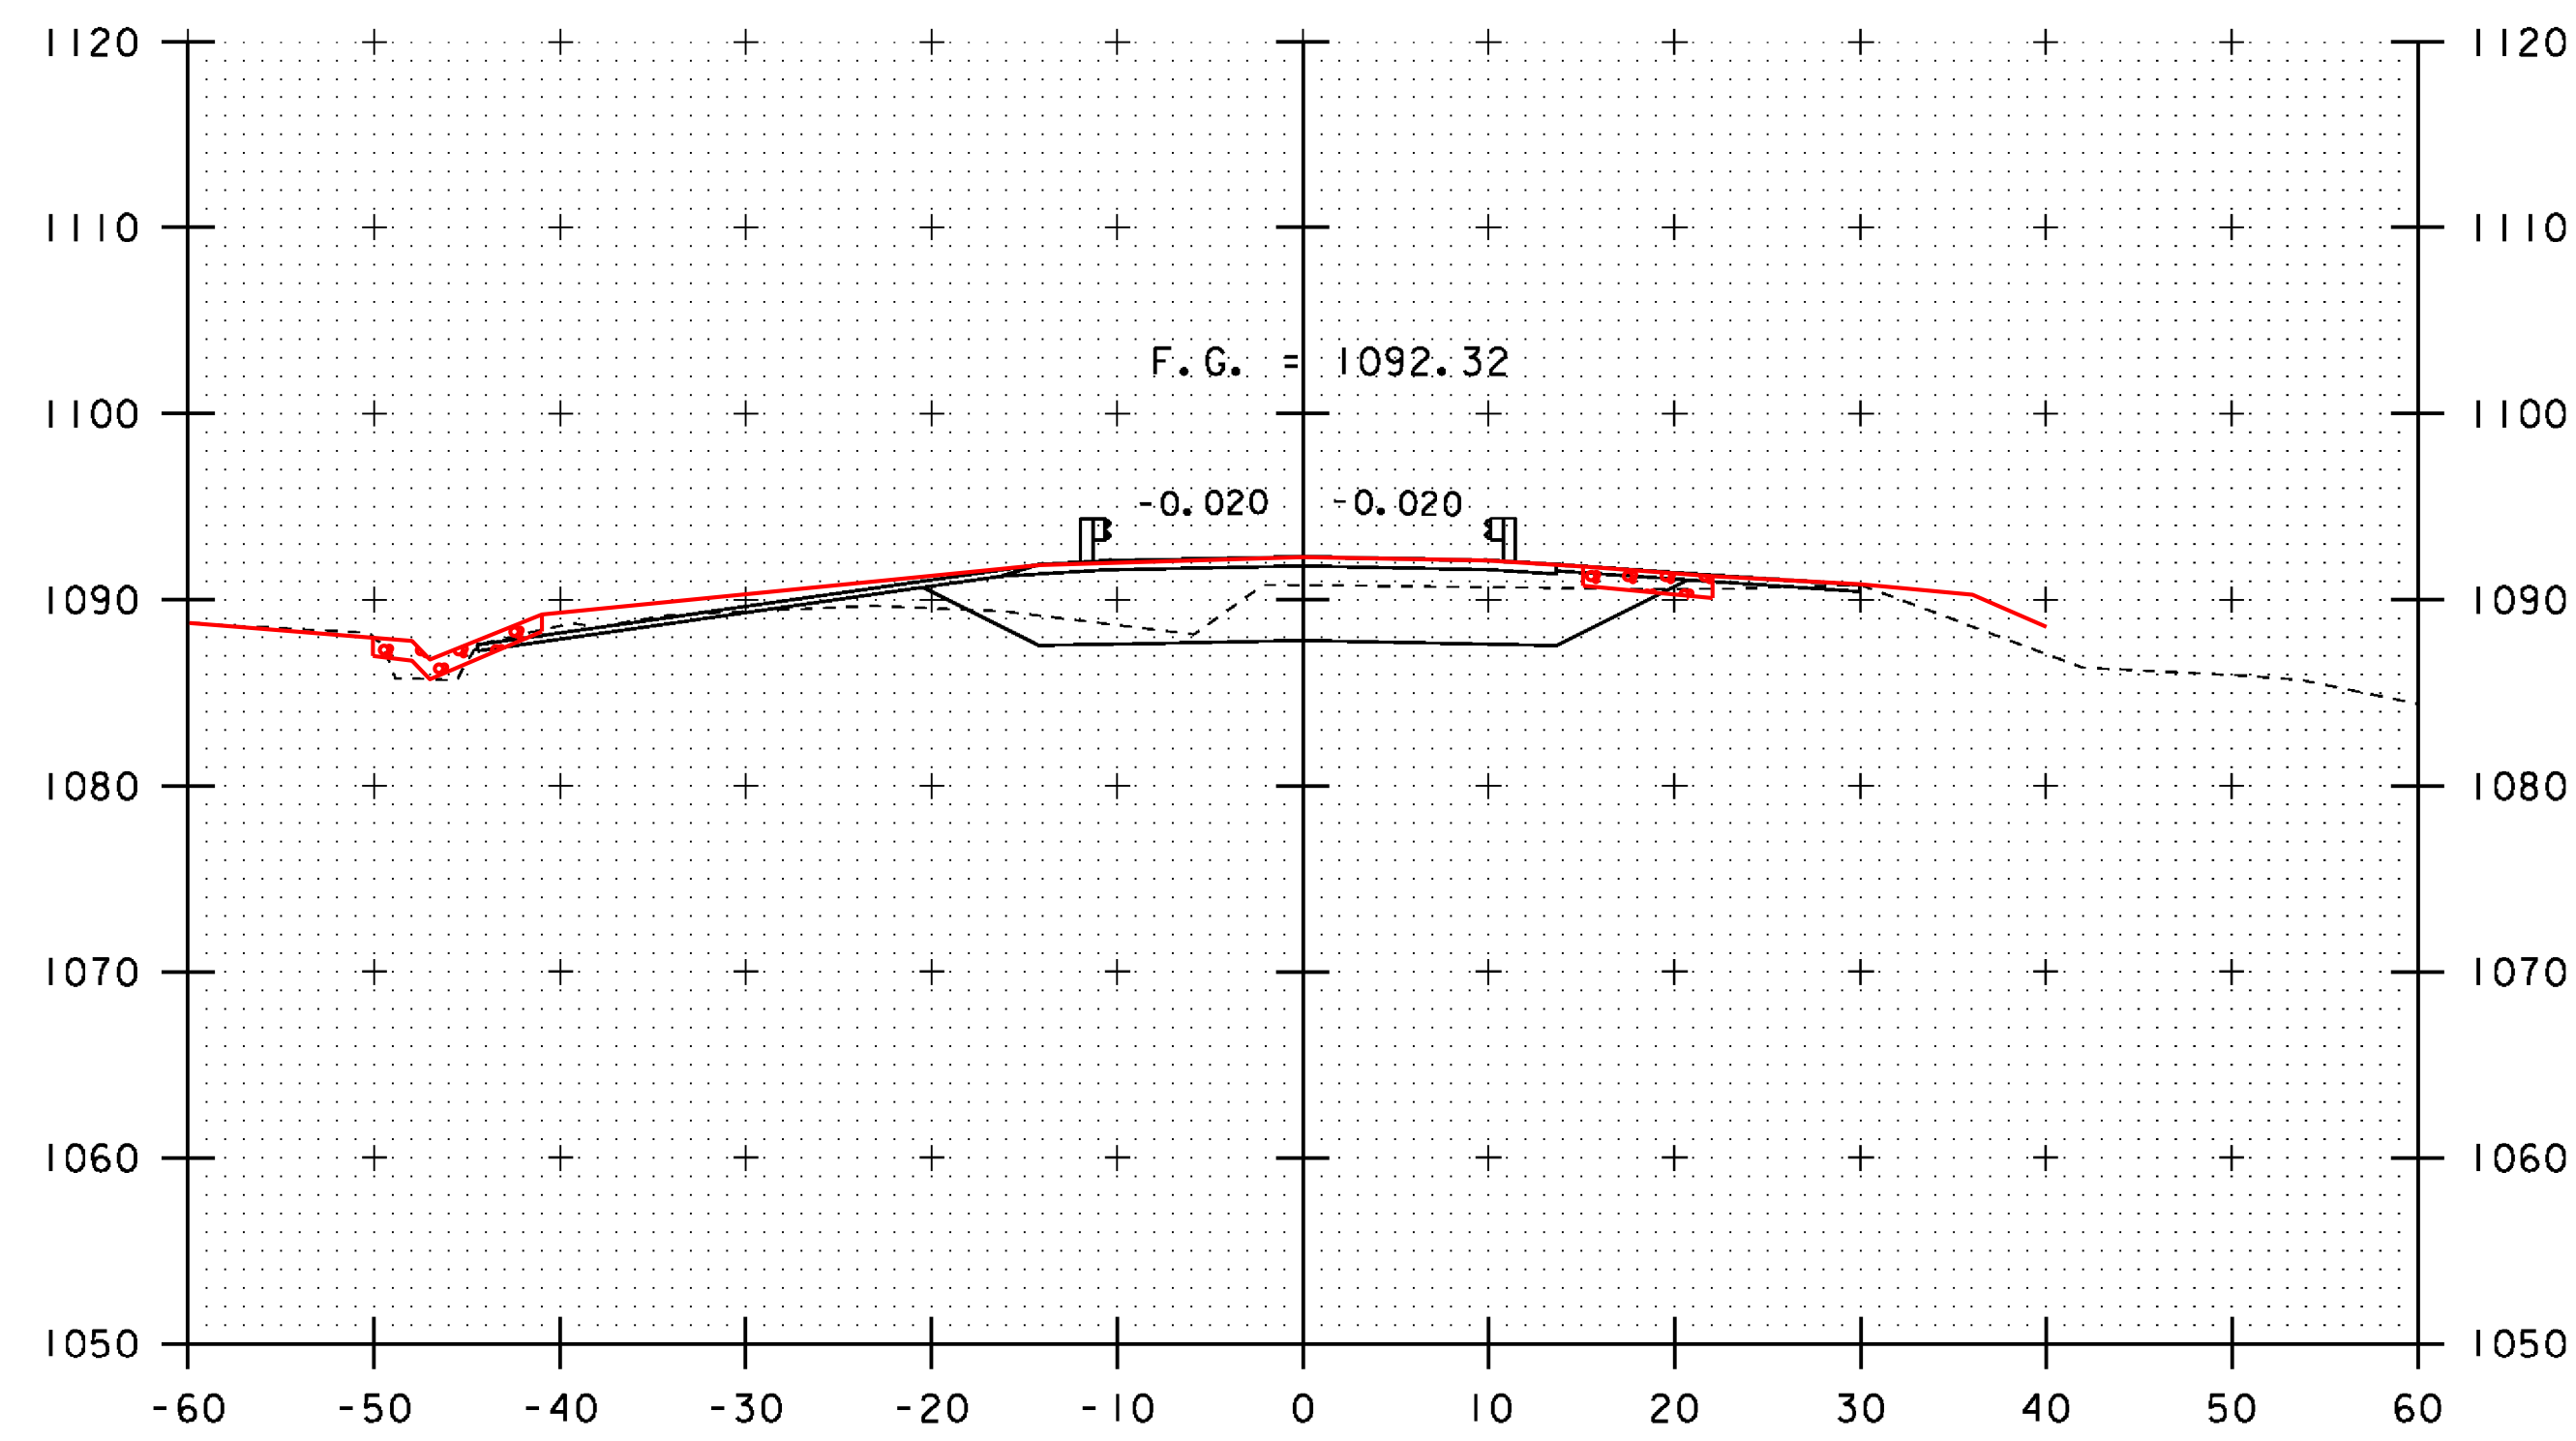


FINAL GRADES DROWN. SEE SURVEY FOLDER FOR EXACT ELEVATIONS.


SEE CHANNEL SECTIONS

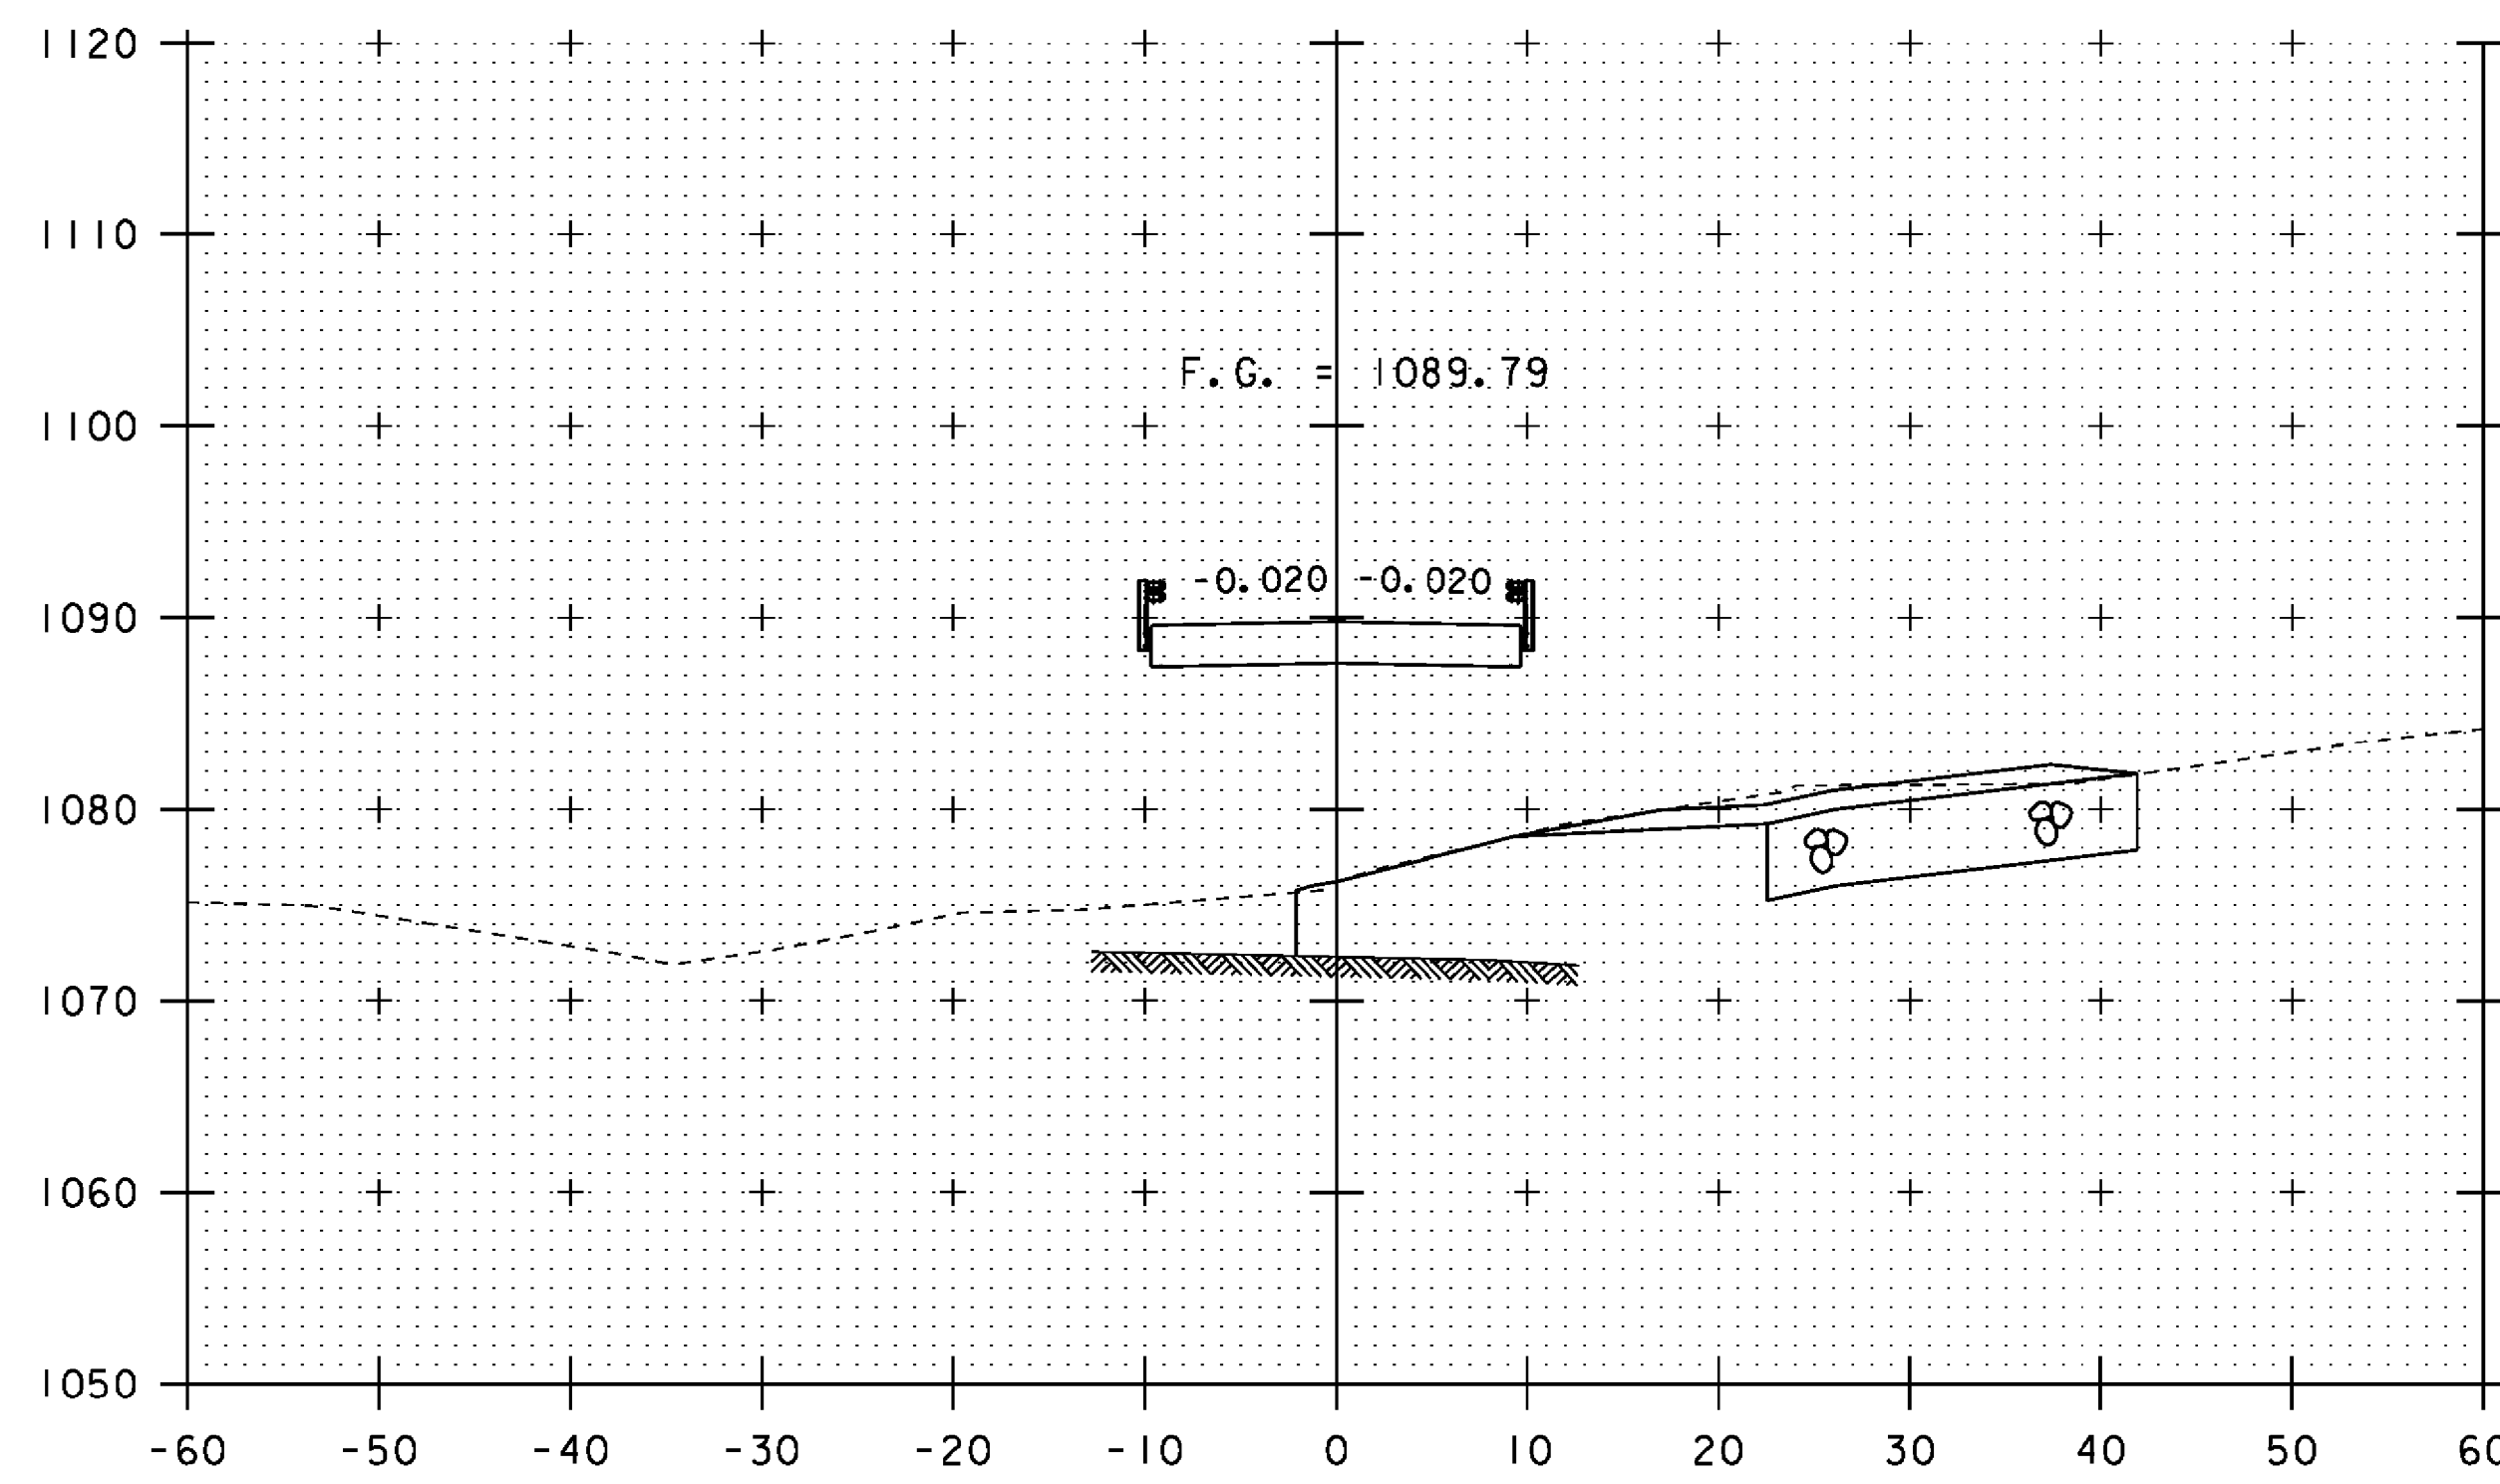

SEE CHANNEL SECTIONS  
22+25  
BEGIN BRIDGE 22+14.00

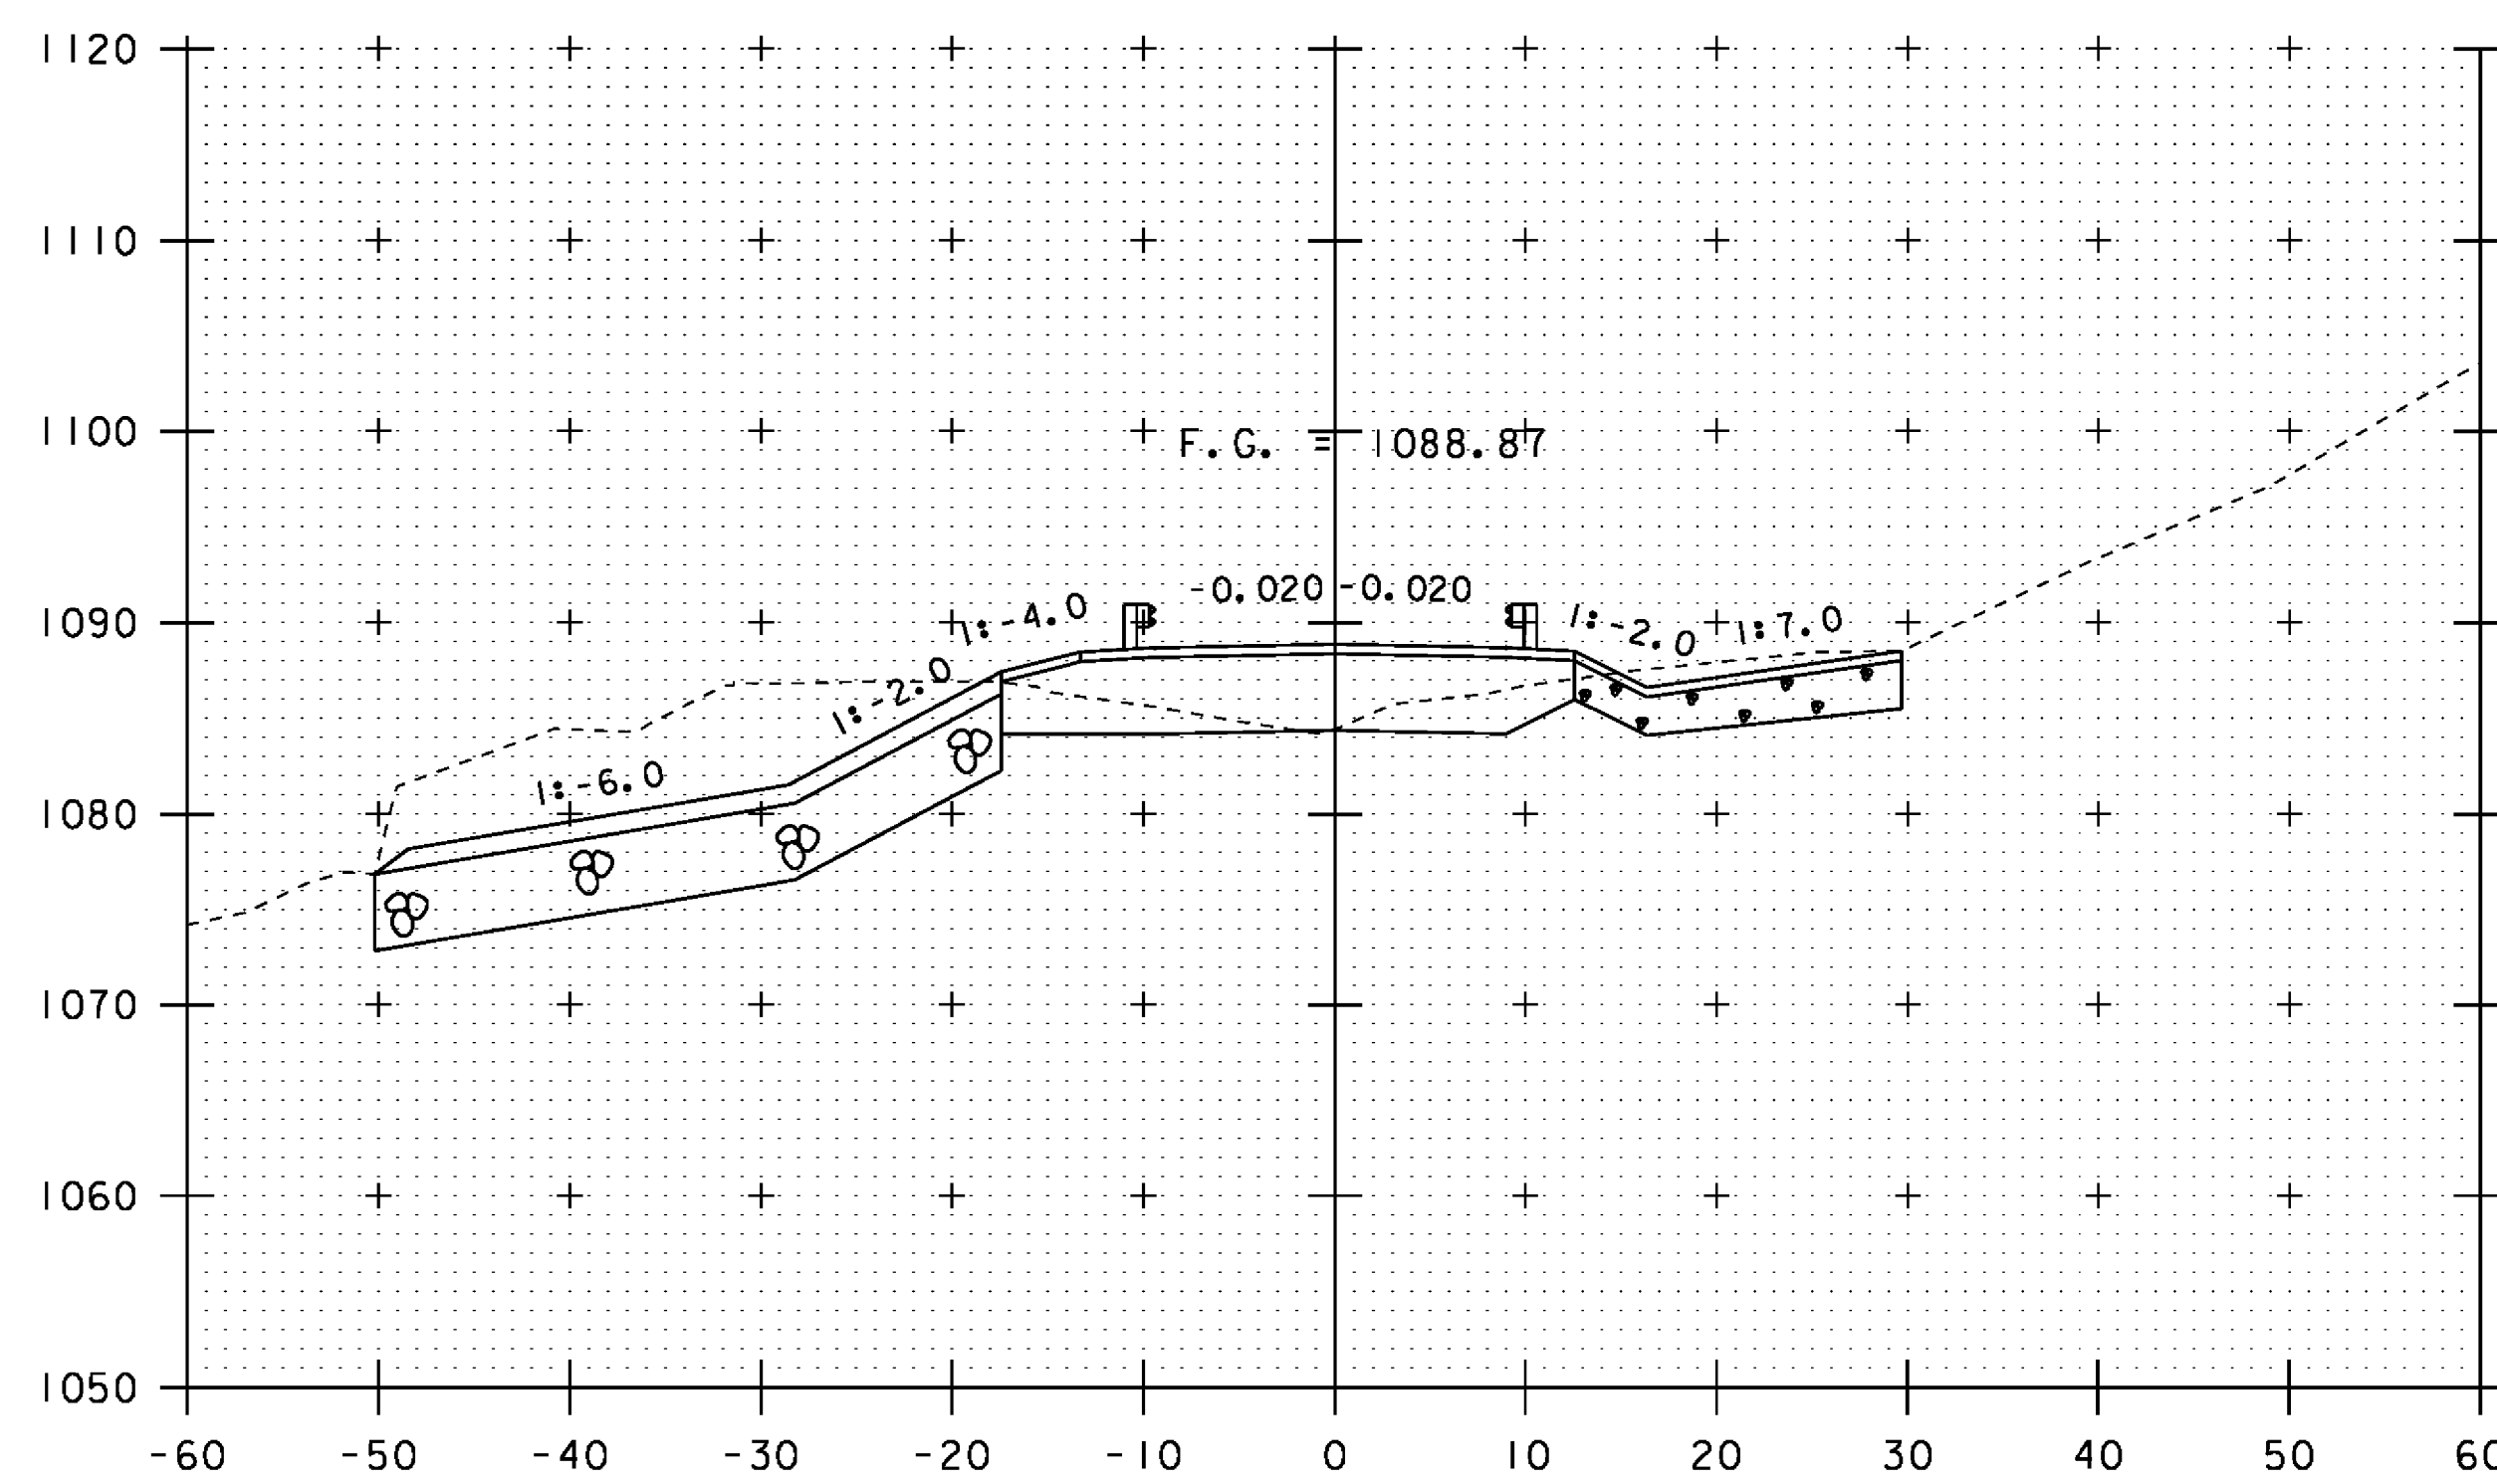

SEE CHANNEL SECTIONS  
22+75

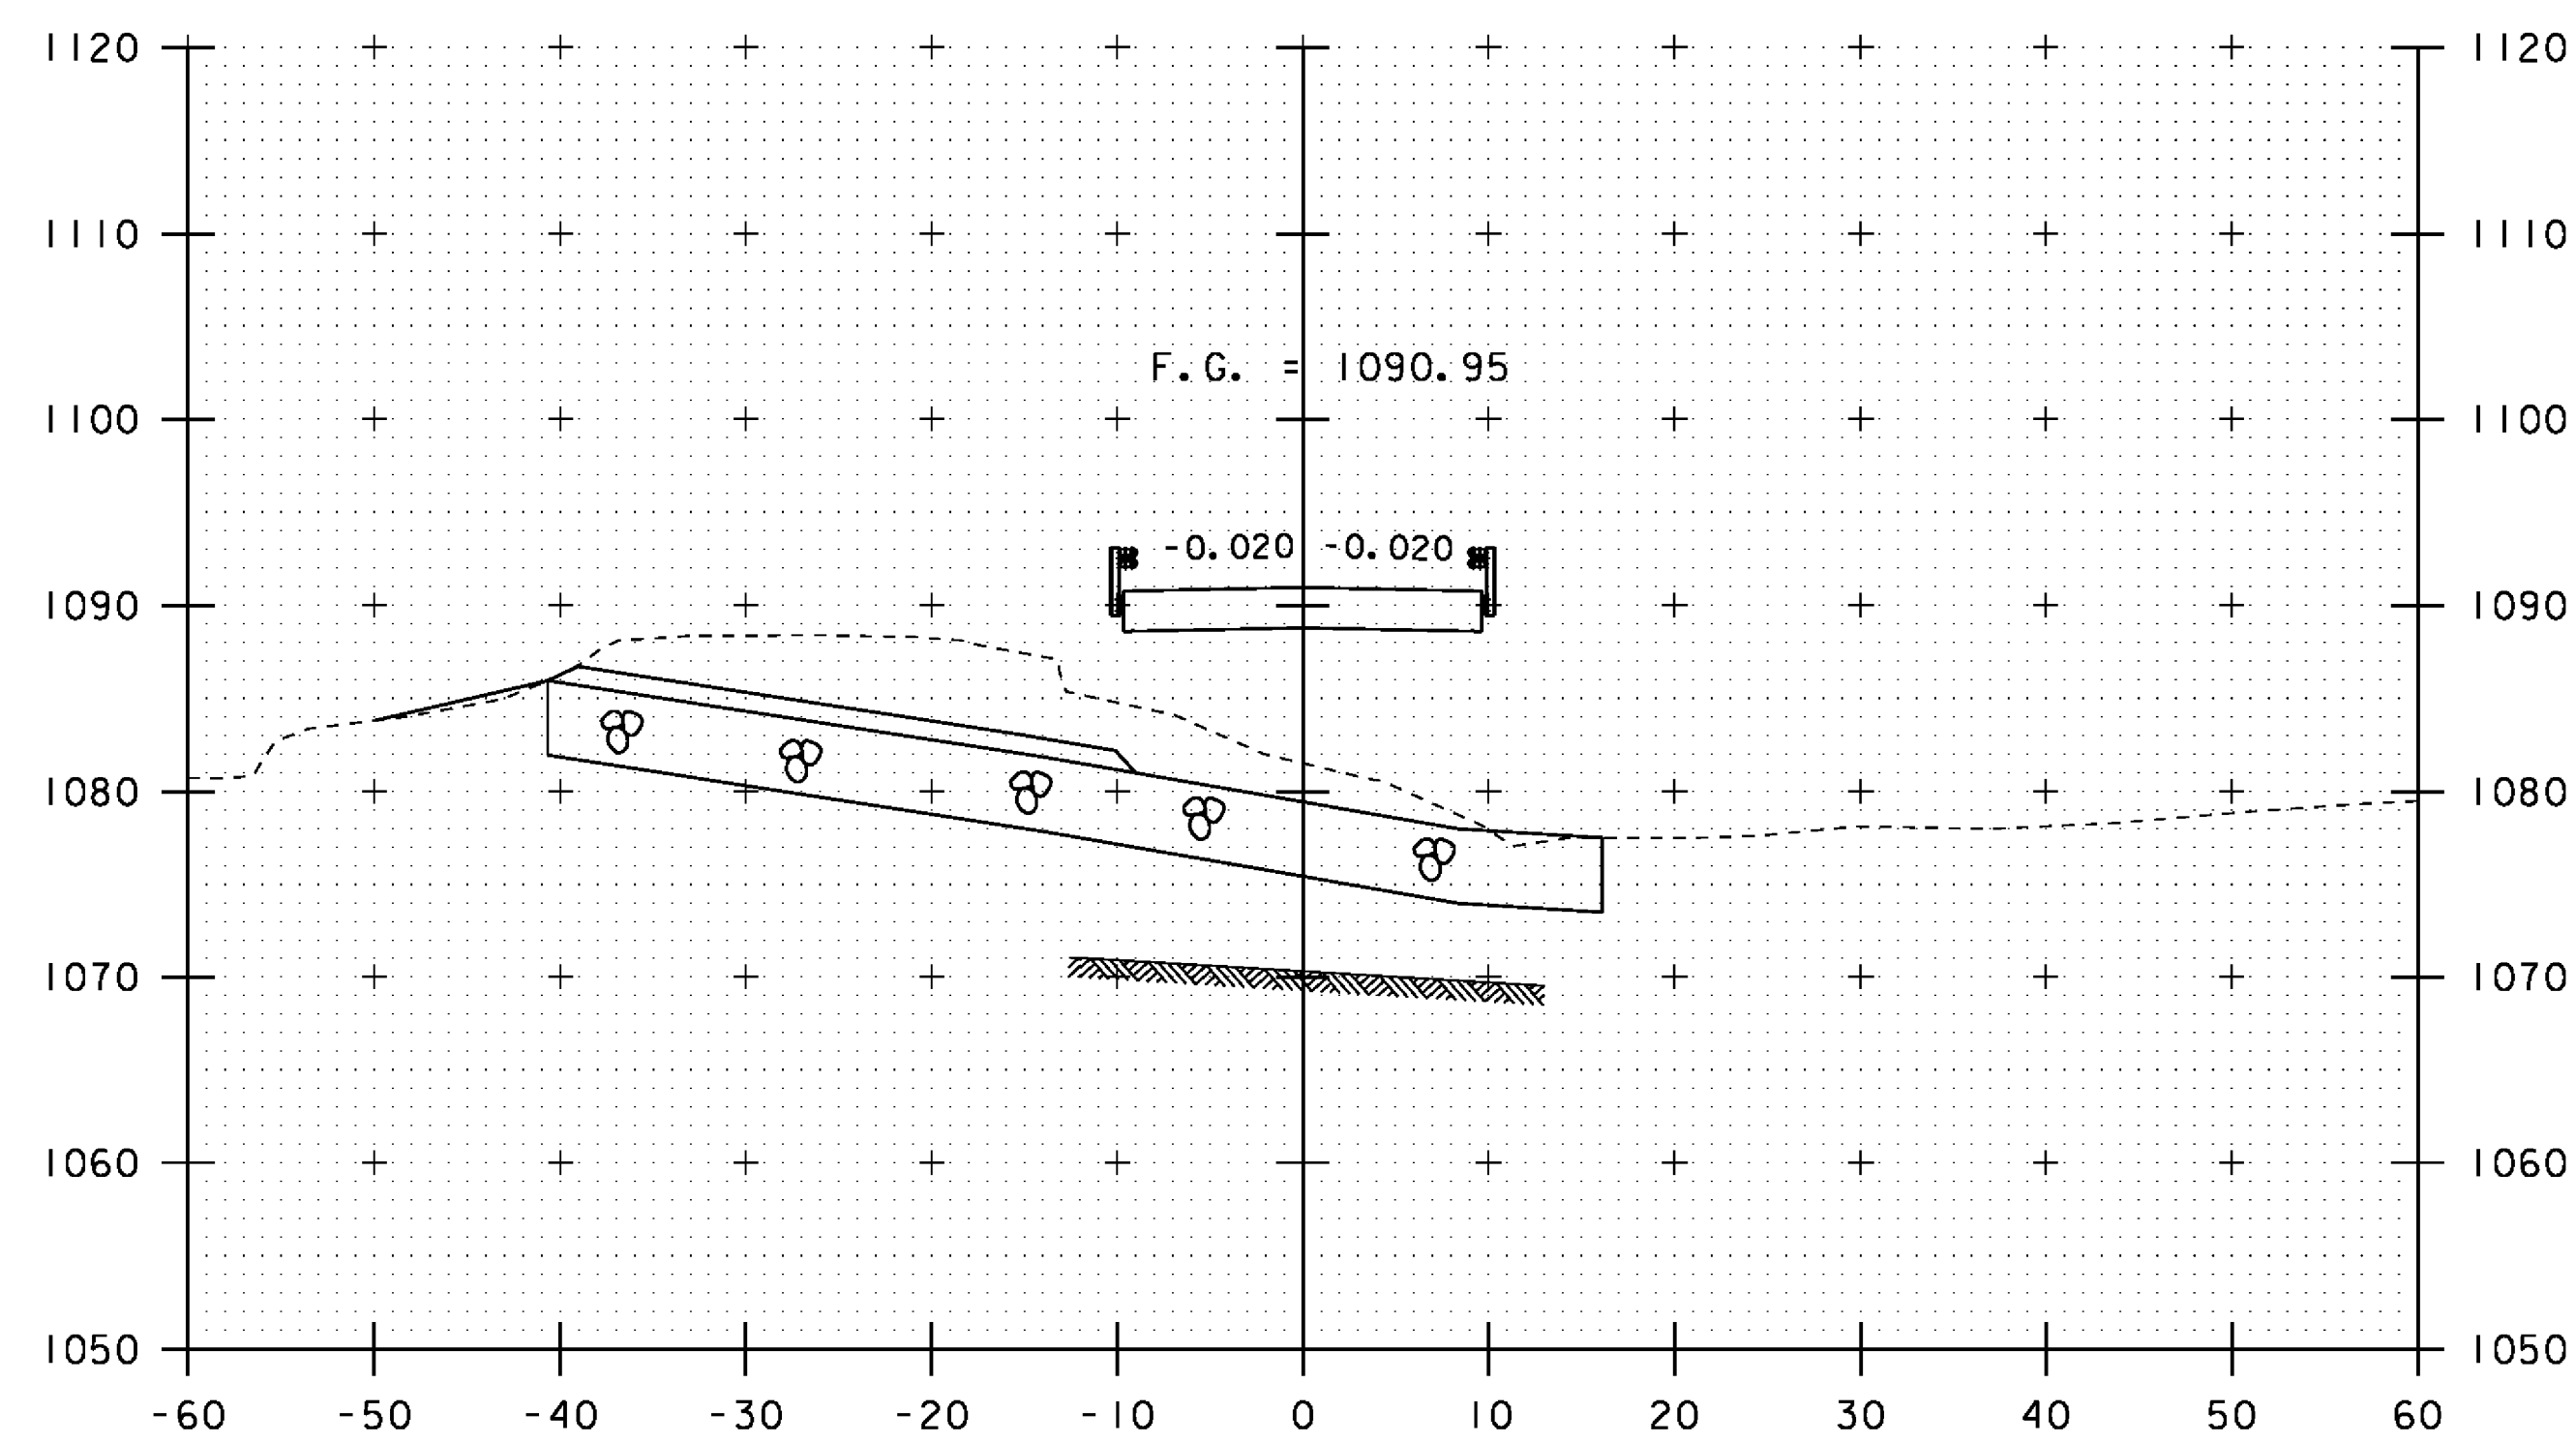

22+00

22+50  
END BRIDGE 22+56.00

SCALE 1" = 10'-0"  
10 0 10

STA. 22+00 TO STA. 22+75

PROJECT NAME: HUNTINGTON  
PROJECT NUMBER: BRO 1445(35)

FILE NAME: s12j162xs.dgn  
PROJECT LEADER: C. CARLSON  
DESIGNED BY: D. PETERSON  
MAINLINE CROSS SECTIONS 3

PLOT DATE: 15-OCT-2015  
DRAWN BY: R. PELLETT  
CHECKED BY: D. PETERSON  
SHEET 30 OF 44