




FINAL GRADES DROWN. SEE SURVEY FOLDER FOR EXACT ELEVATIONS.

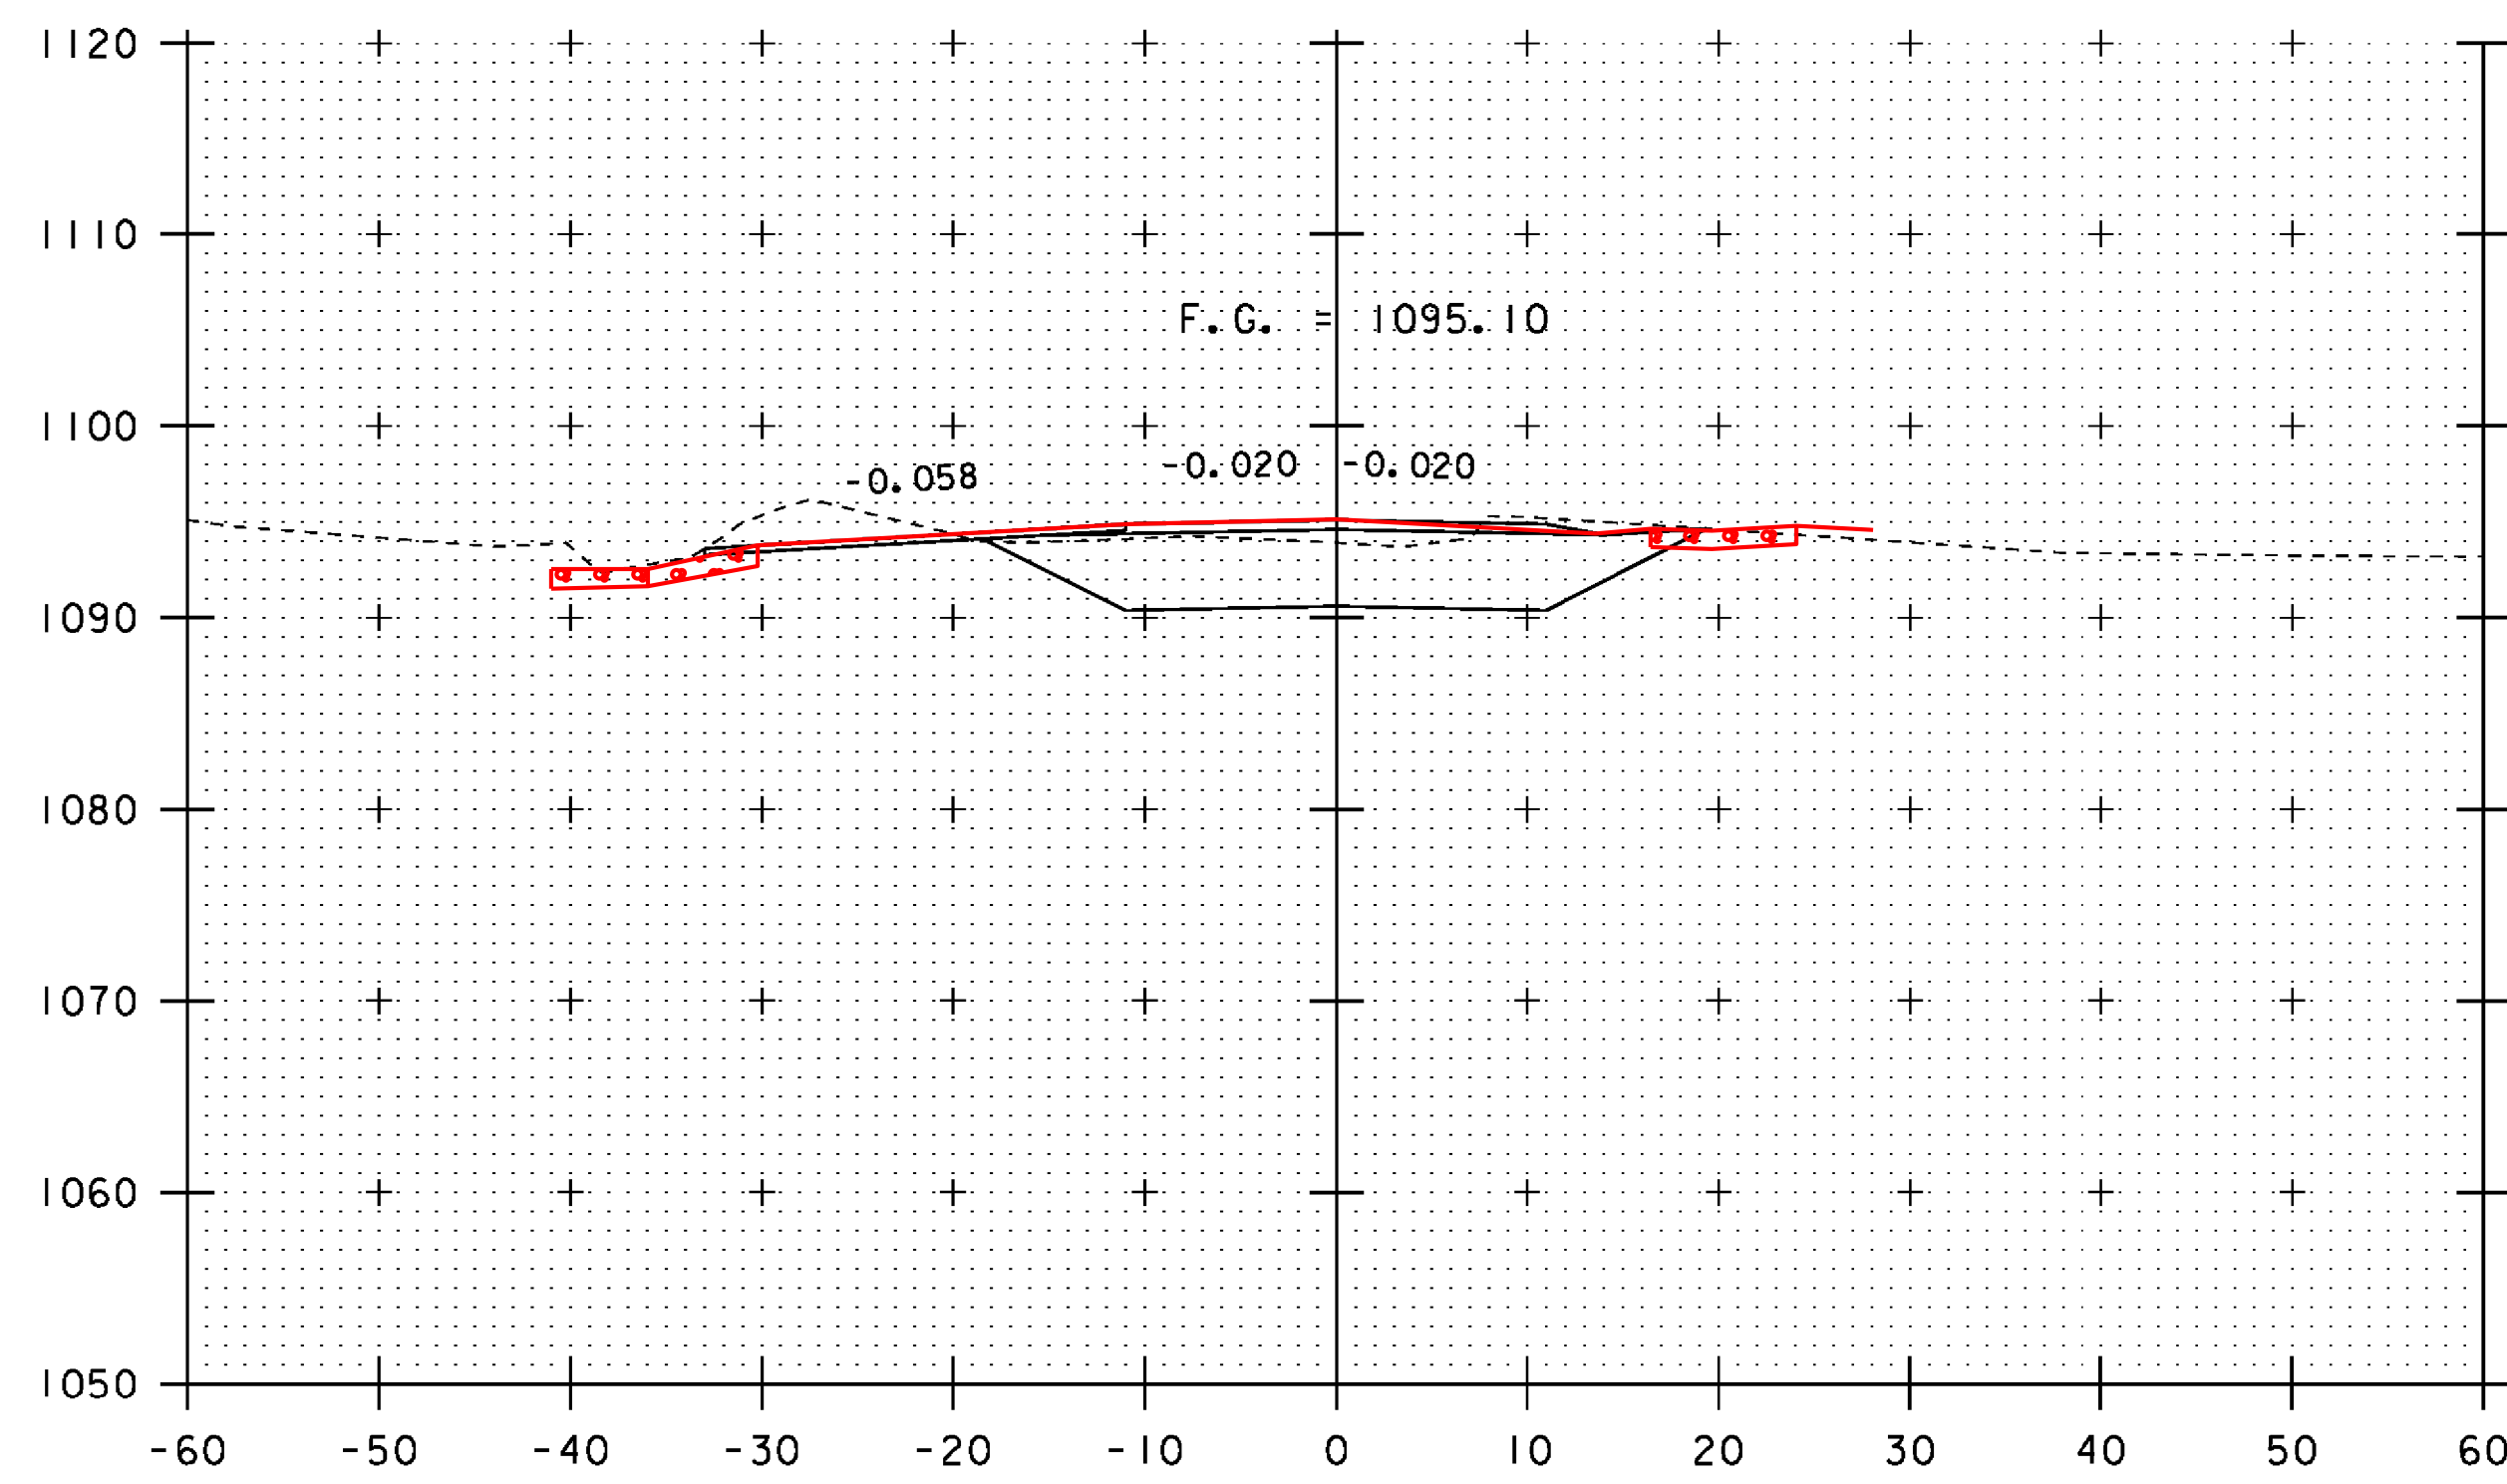


23+25

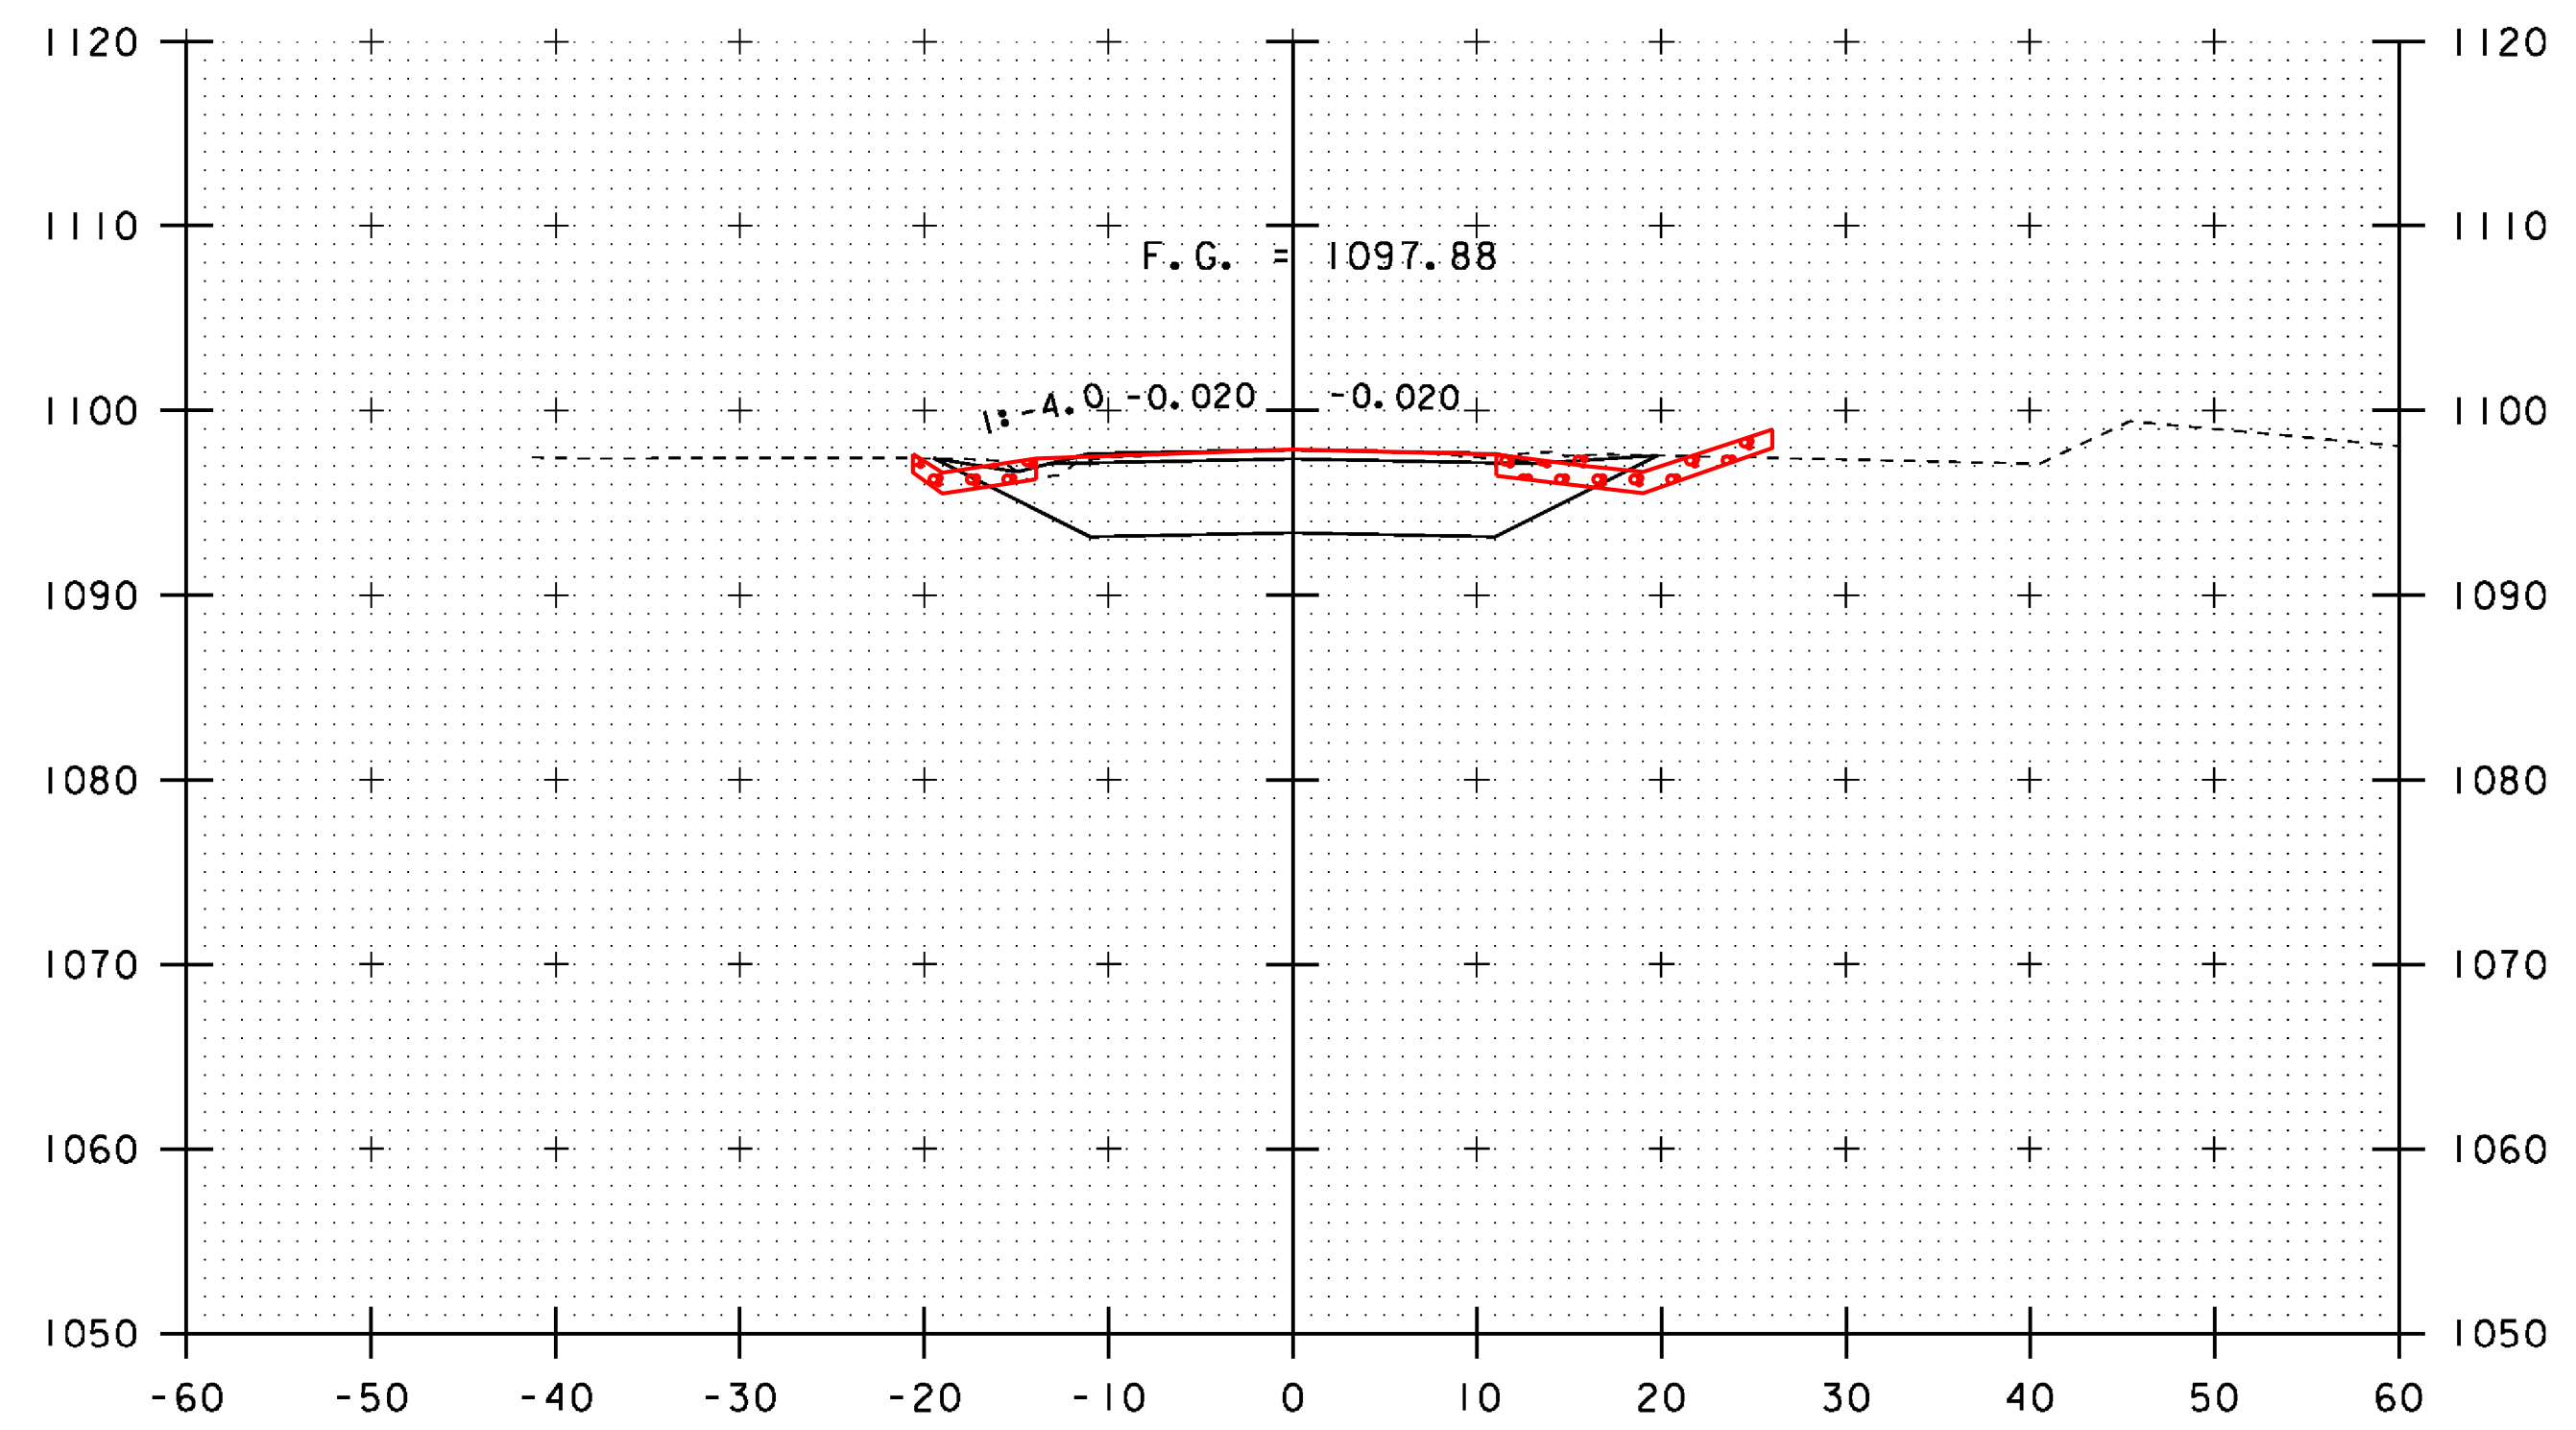

23+75

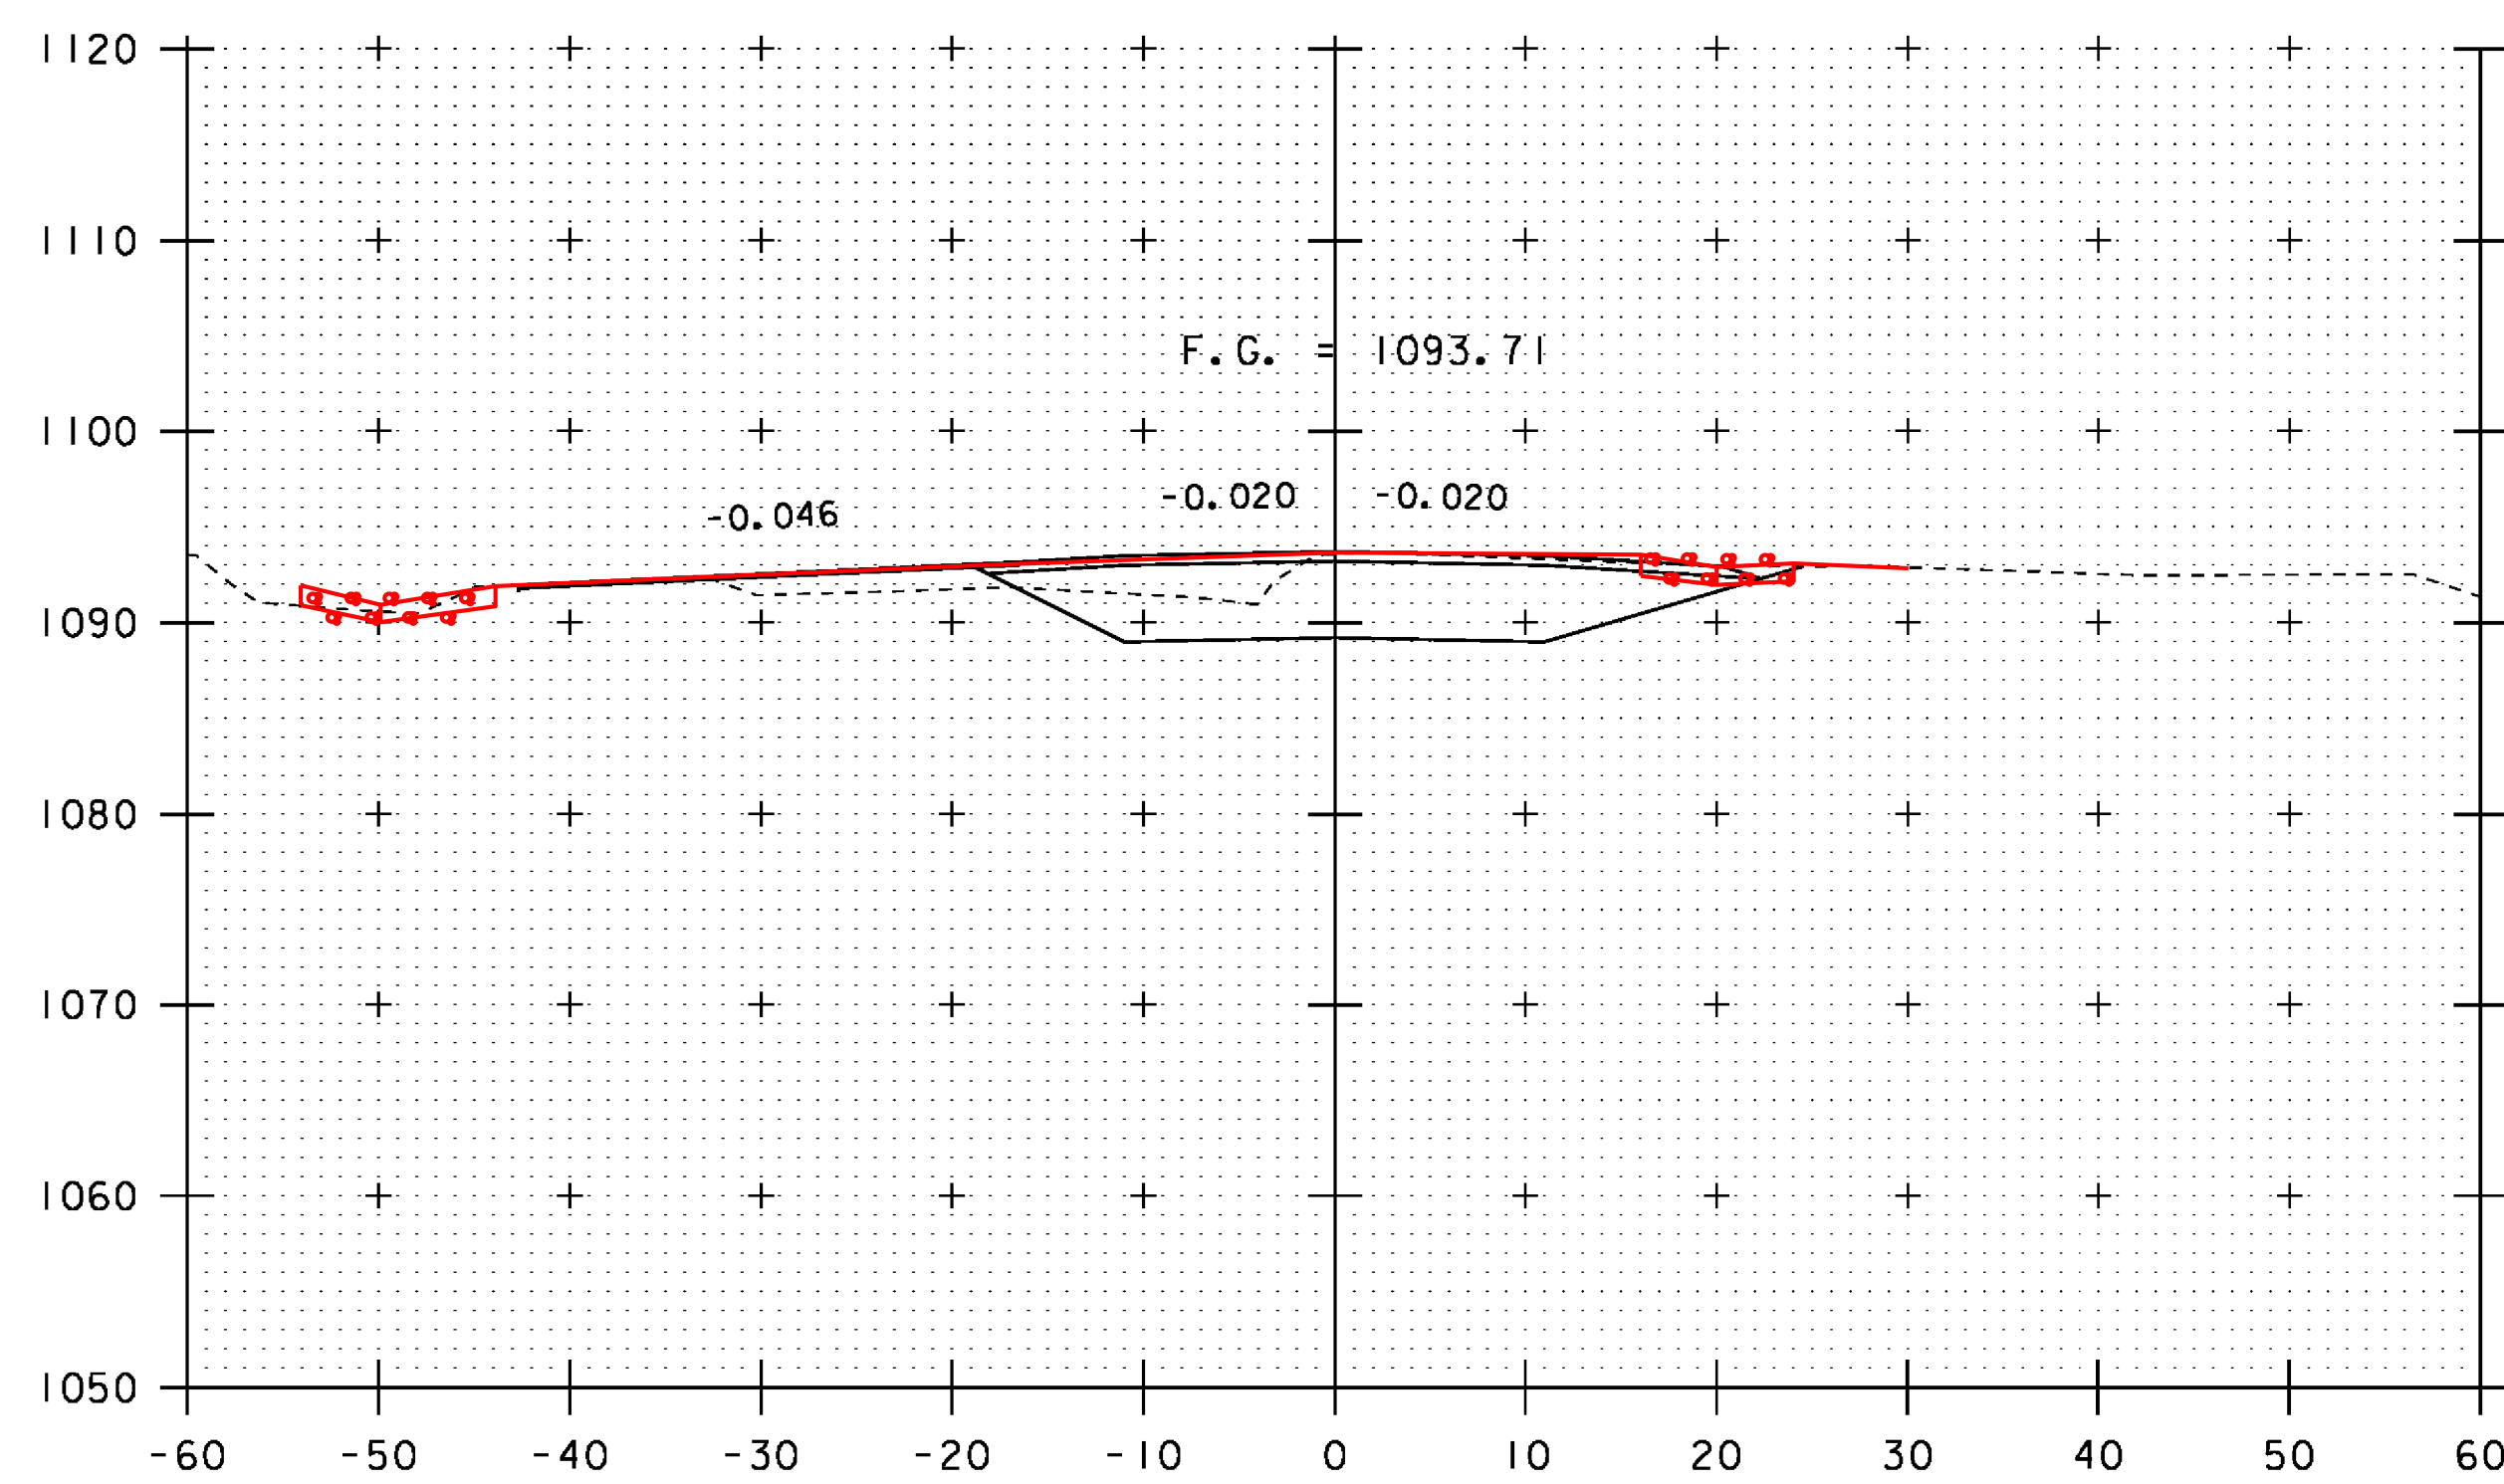

23+00

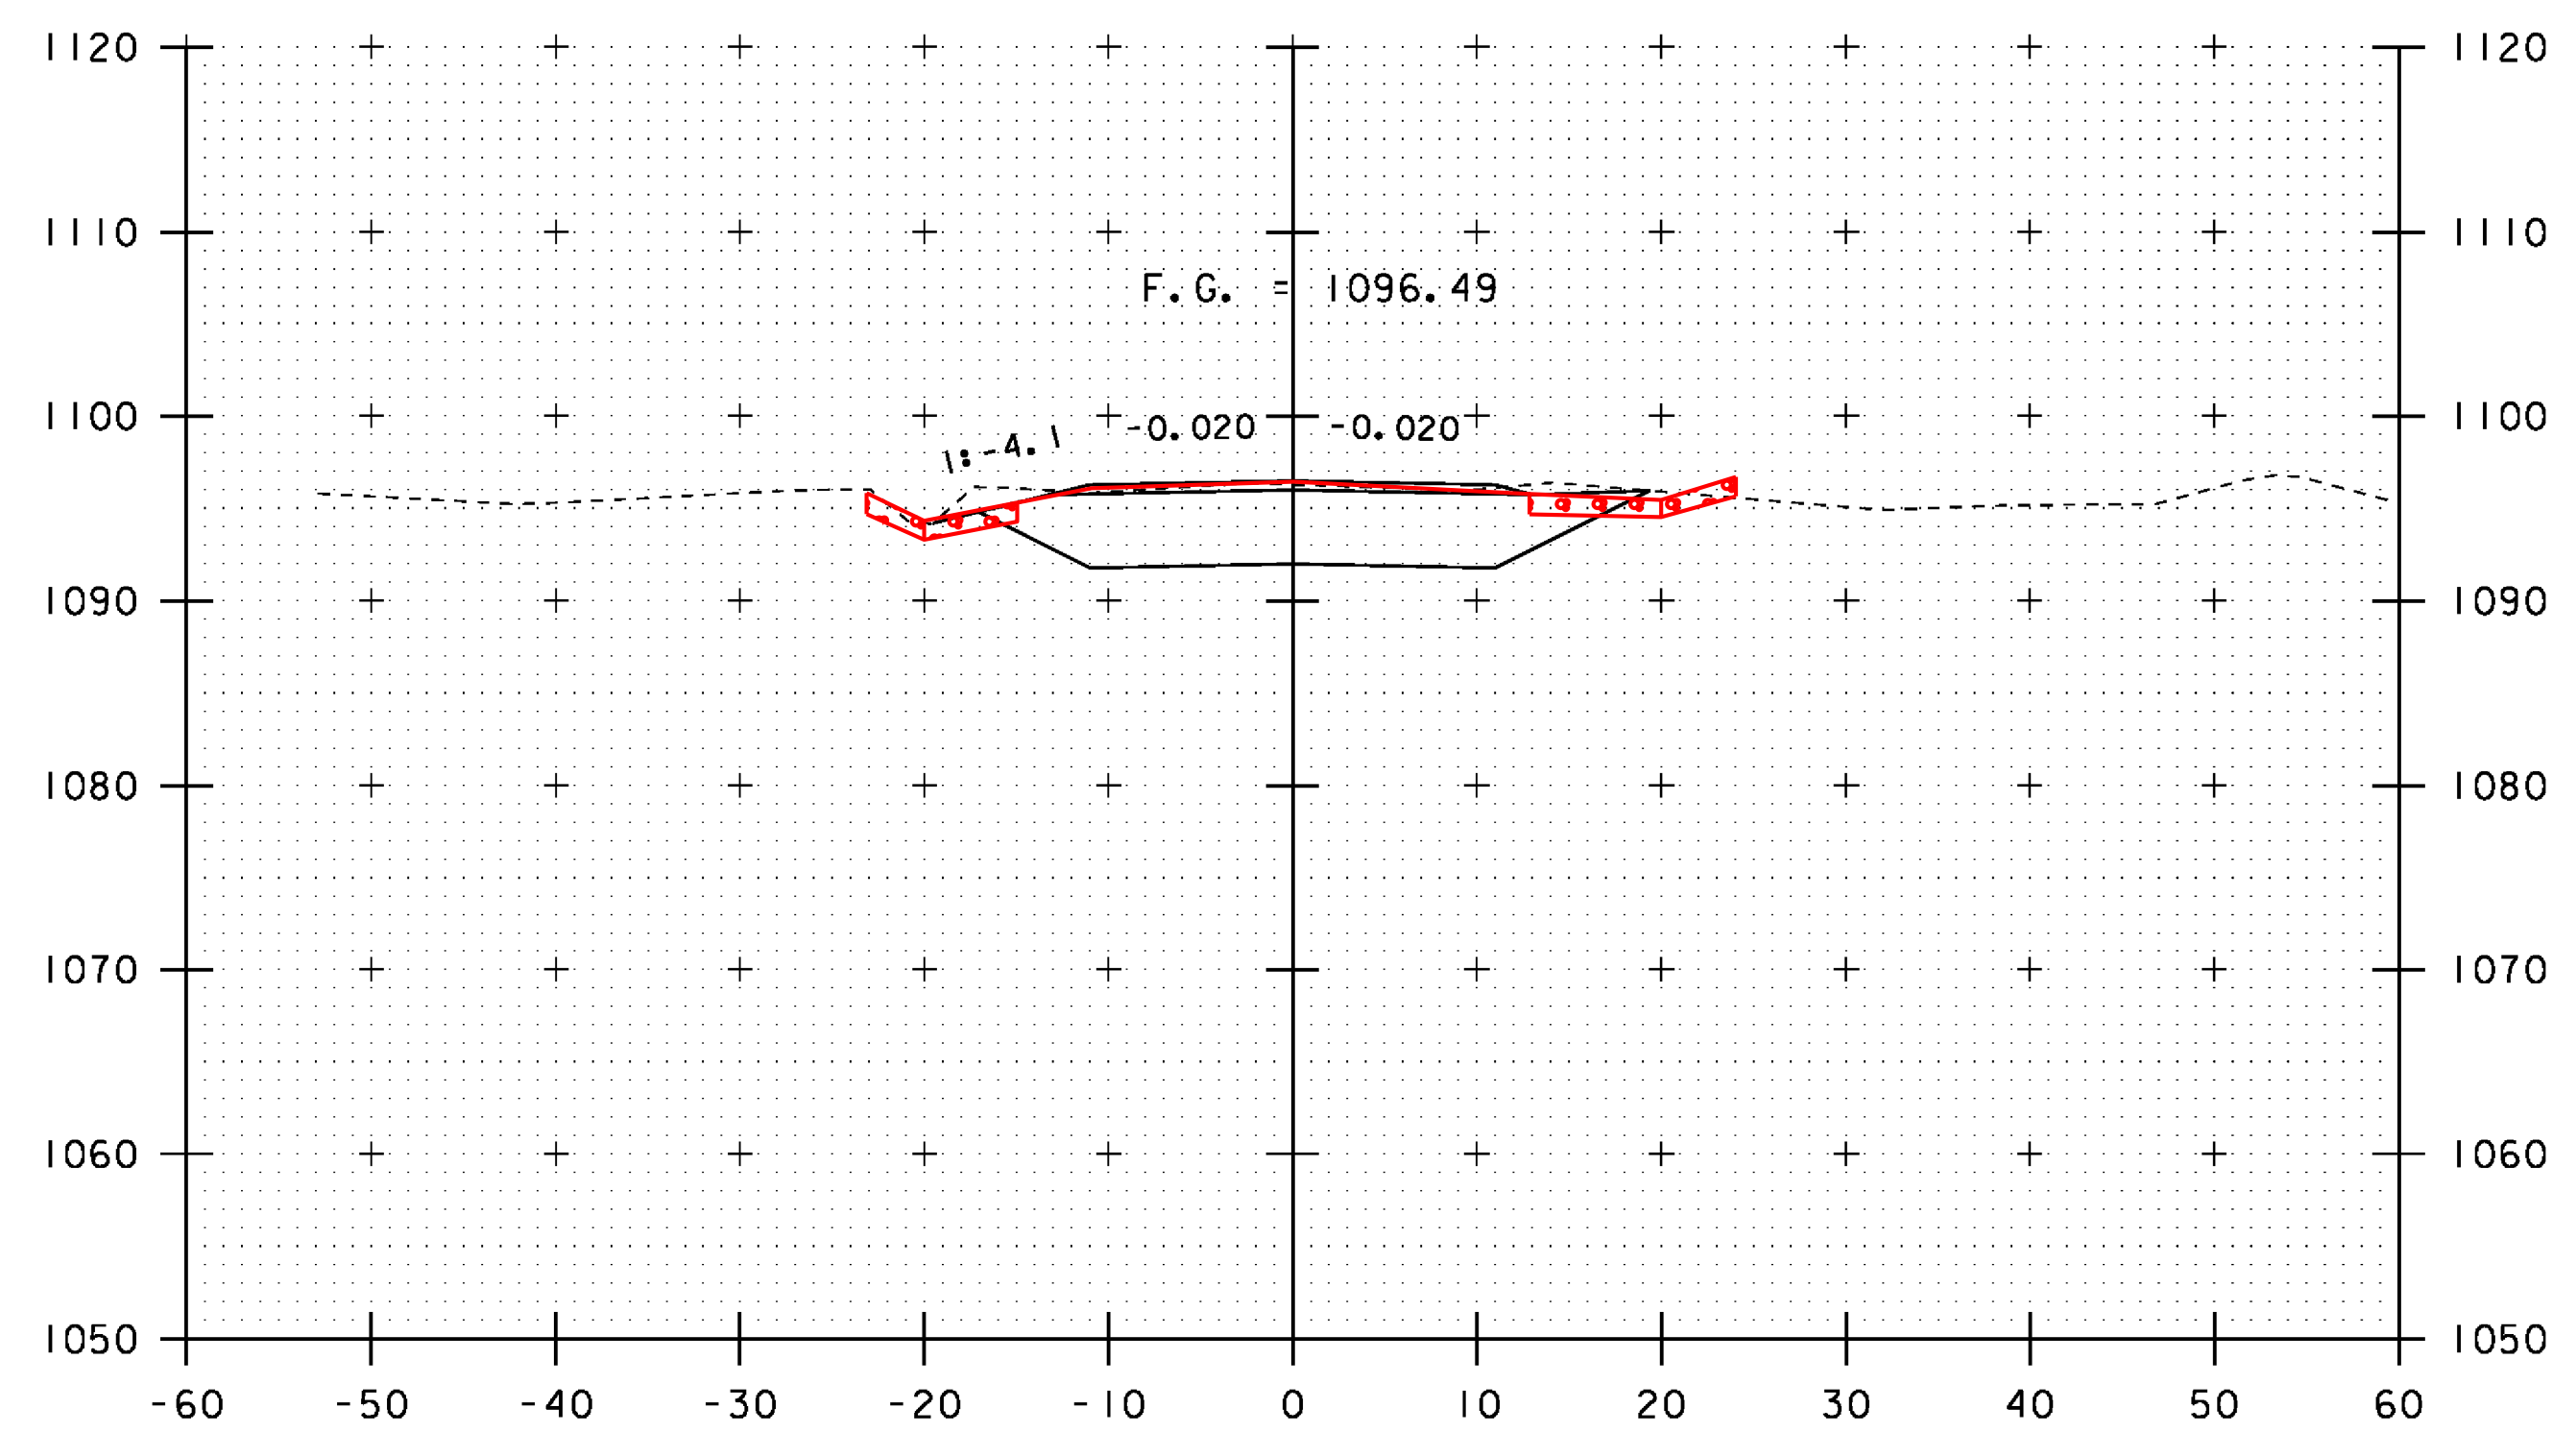

23+50

SCALE 1" = 10'-0"
10 0 10

STA. 23+00 TO STA. 23+75

PROJECT NAME: HUNTINGTON
PROJECT NUMBER: BRO 1445(35)

FILE NAME: s12j162xs.dgn
PROJECT LEADER: C. CARLSON
DESIGNED BY: D. PETERSON
MAINLINE CROSS SECTIONS 4

PLOT DATE: 15-OCT-2015
DRAWN BY: R. PELLETT
CHECKED BY: D. PETERSON
SHEET 31 OF 44