




FINAL GRADES DROWN. SEE SURVEY FOLDER FOR EXACT ELEVATIONS.

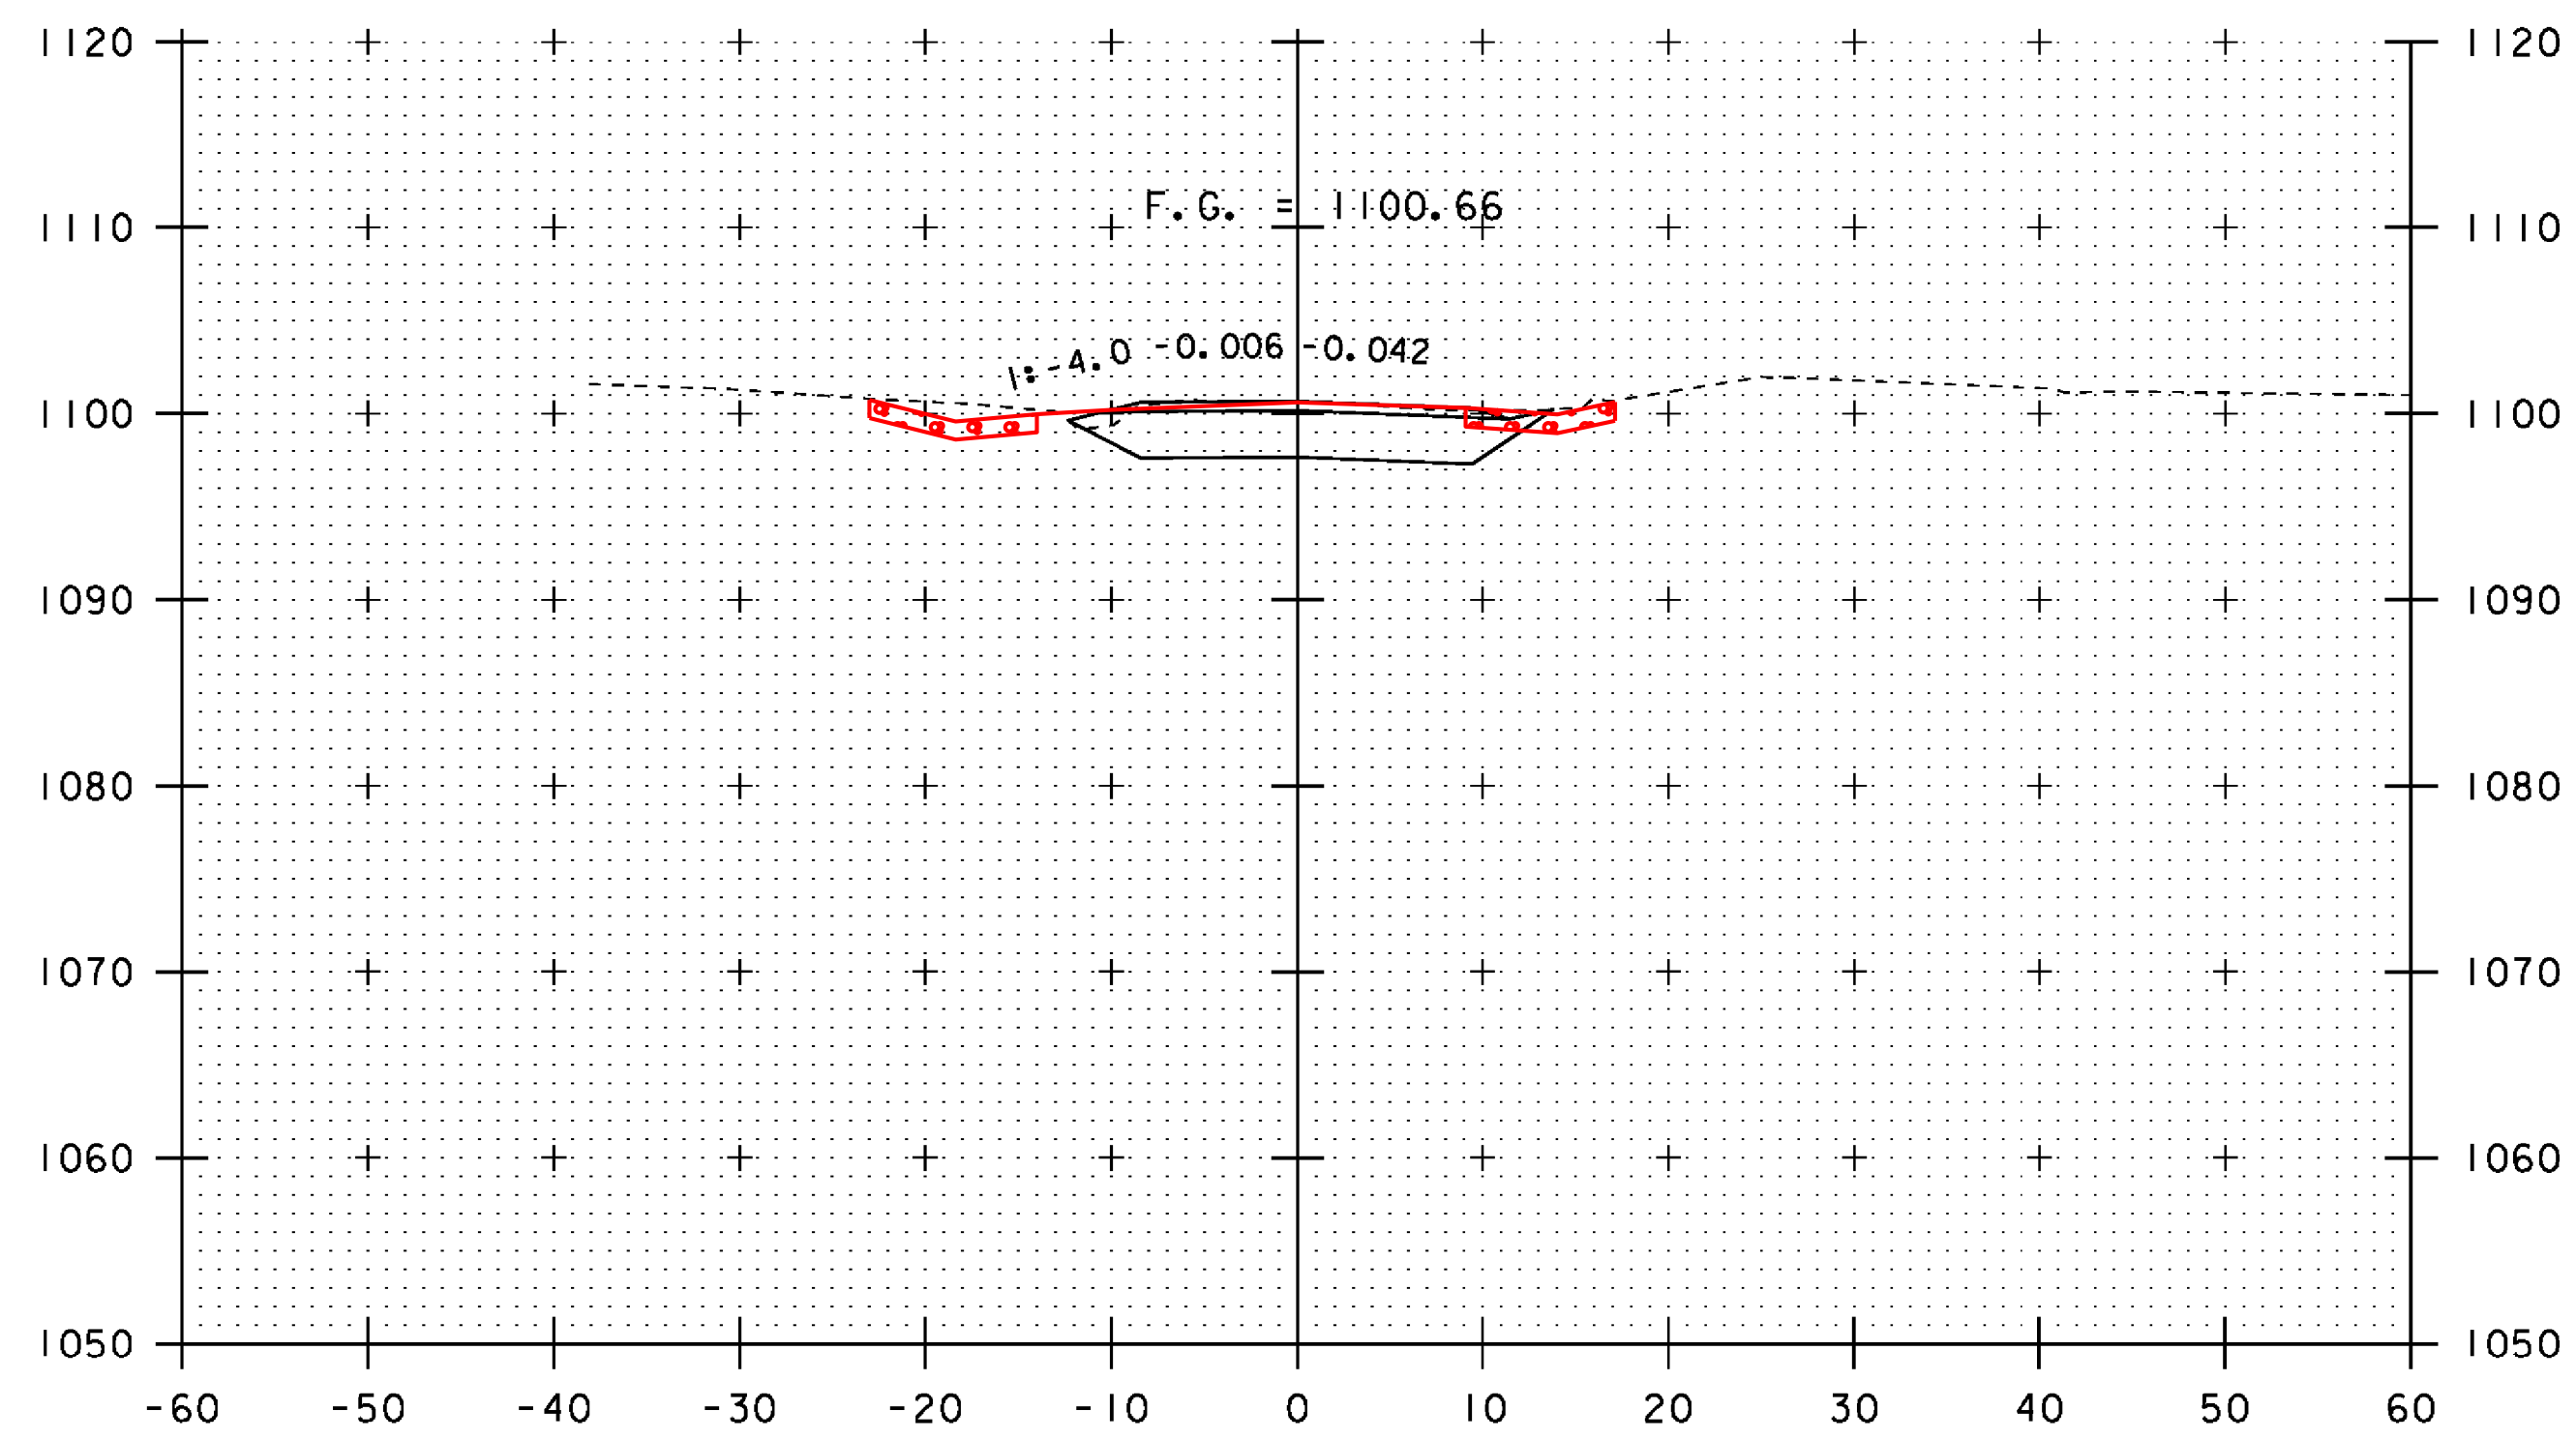

24+25

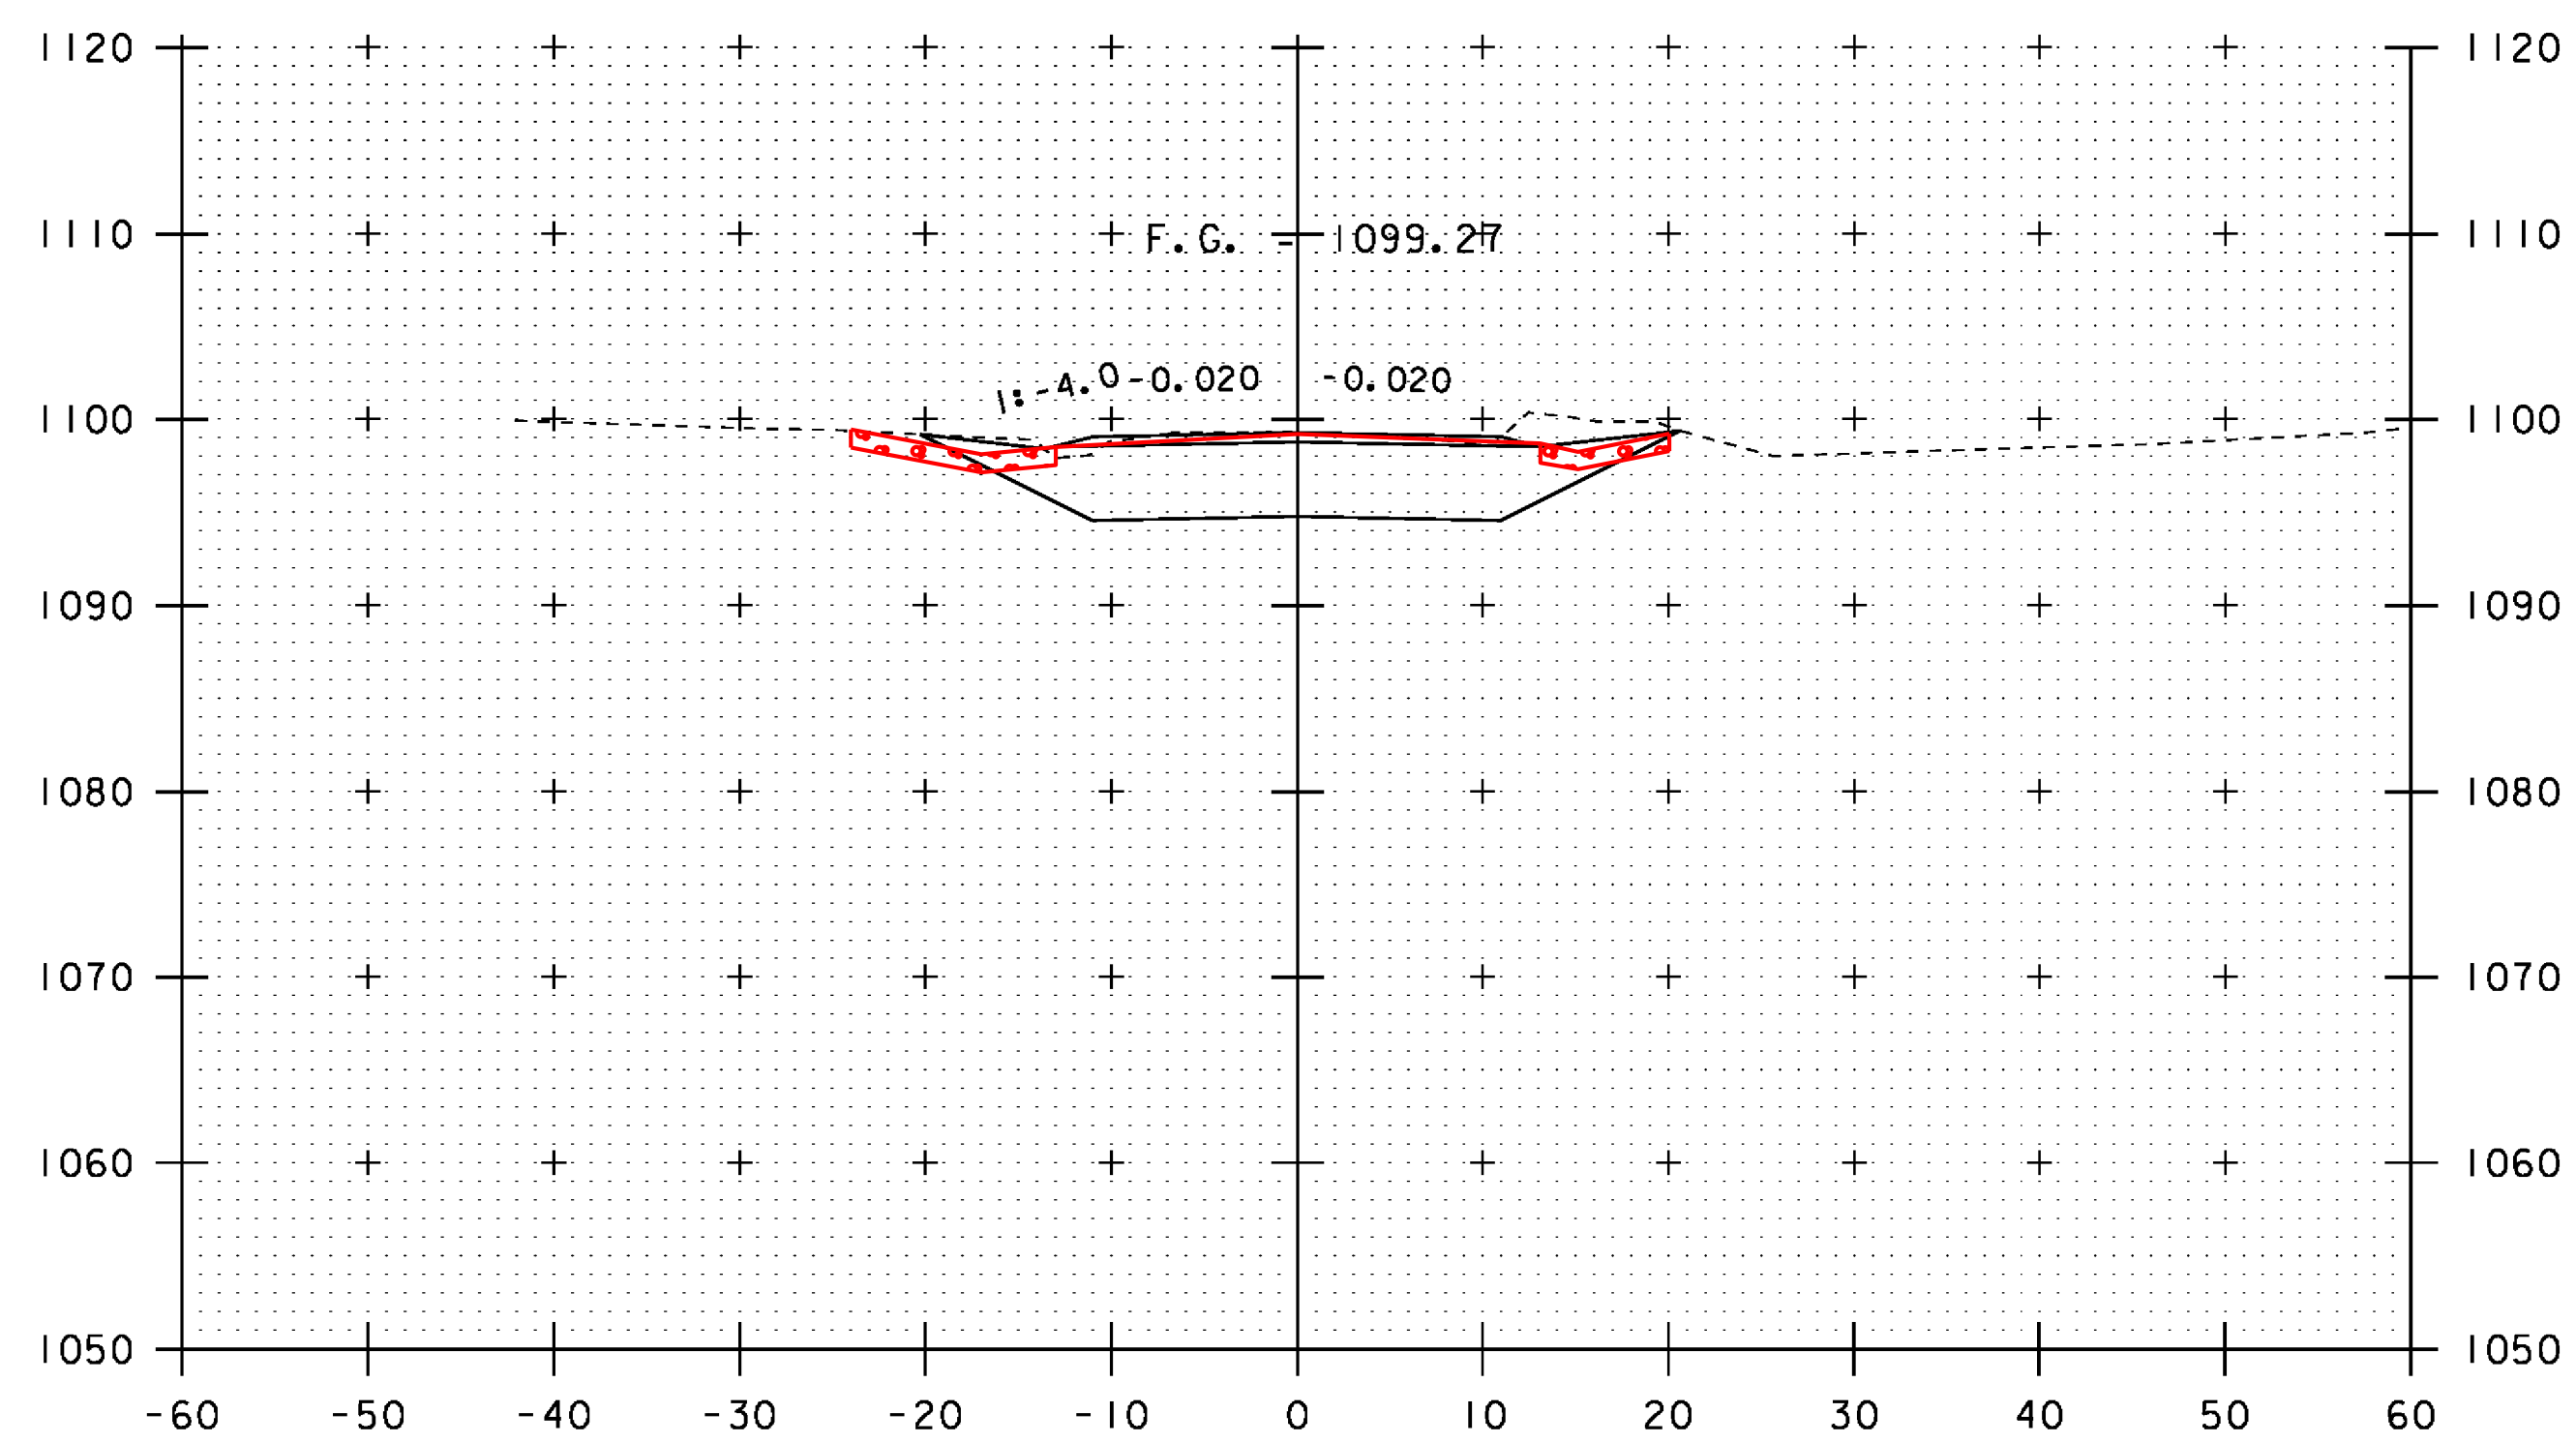

24+00
END PROJECT

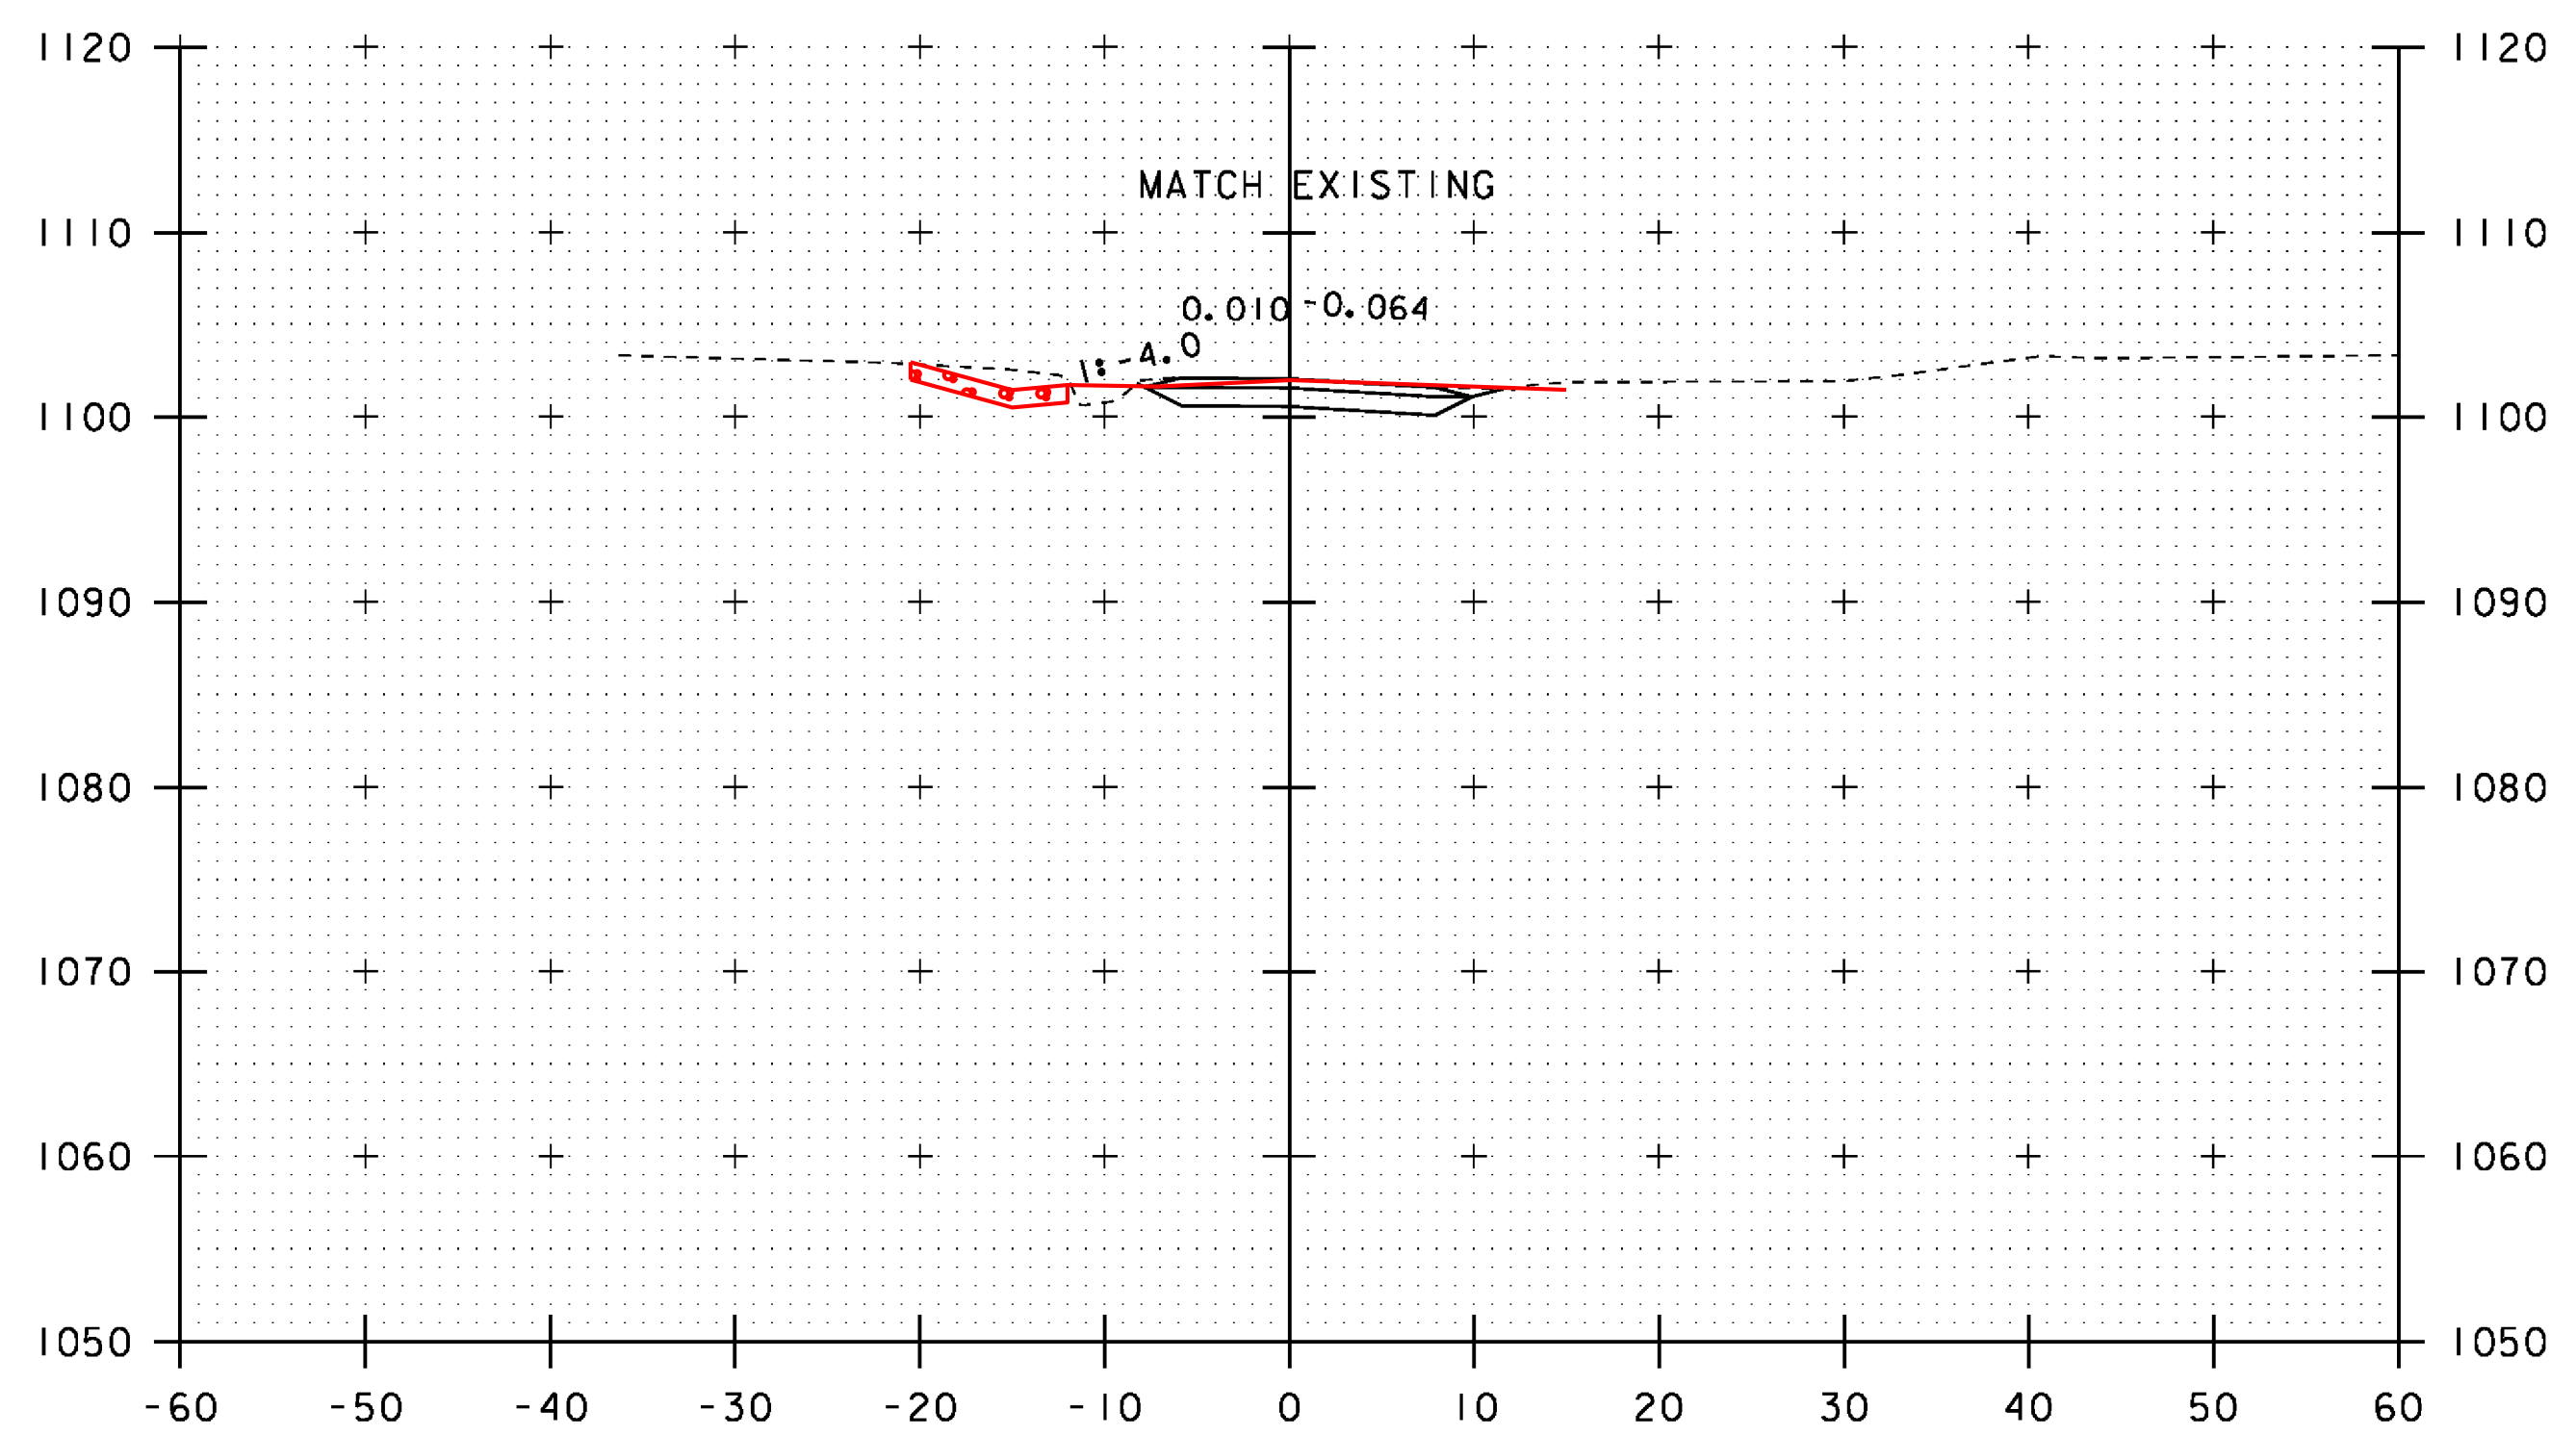

24+50
END APPROACH

SCALE 1" = 10'-0"
10 0 10

STA. 24+00 TO STA. 24+50

PROJECT NAME: HUNTINGTON
PROJECT NUMBER: BRO 1445(35)

FILE NAME: s12j162xs.dgn
PROJECT LEADER: C. CARLSON
DESIGNED BY: D. PETERSON
MAINLINE CROSS SECTIONS 5

PLOT DATE: 15-OCT-2015
DRAWN BY: R. PELLETT
CHECKED BY: D. PETERSON
SHEET 32 OF 44