




10+80

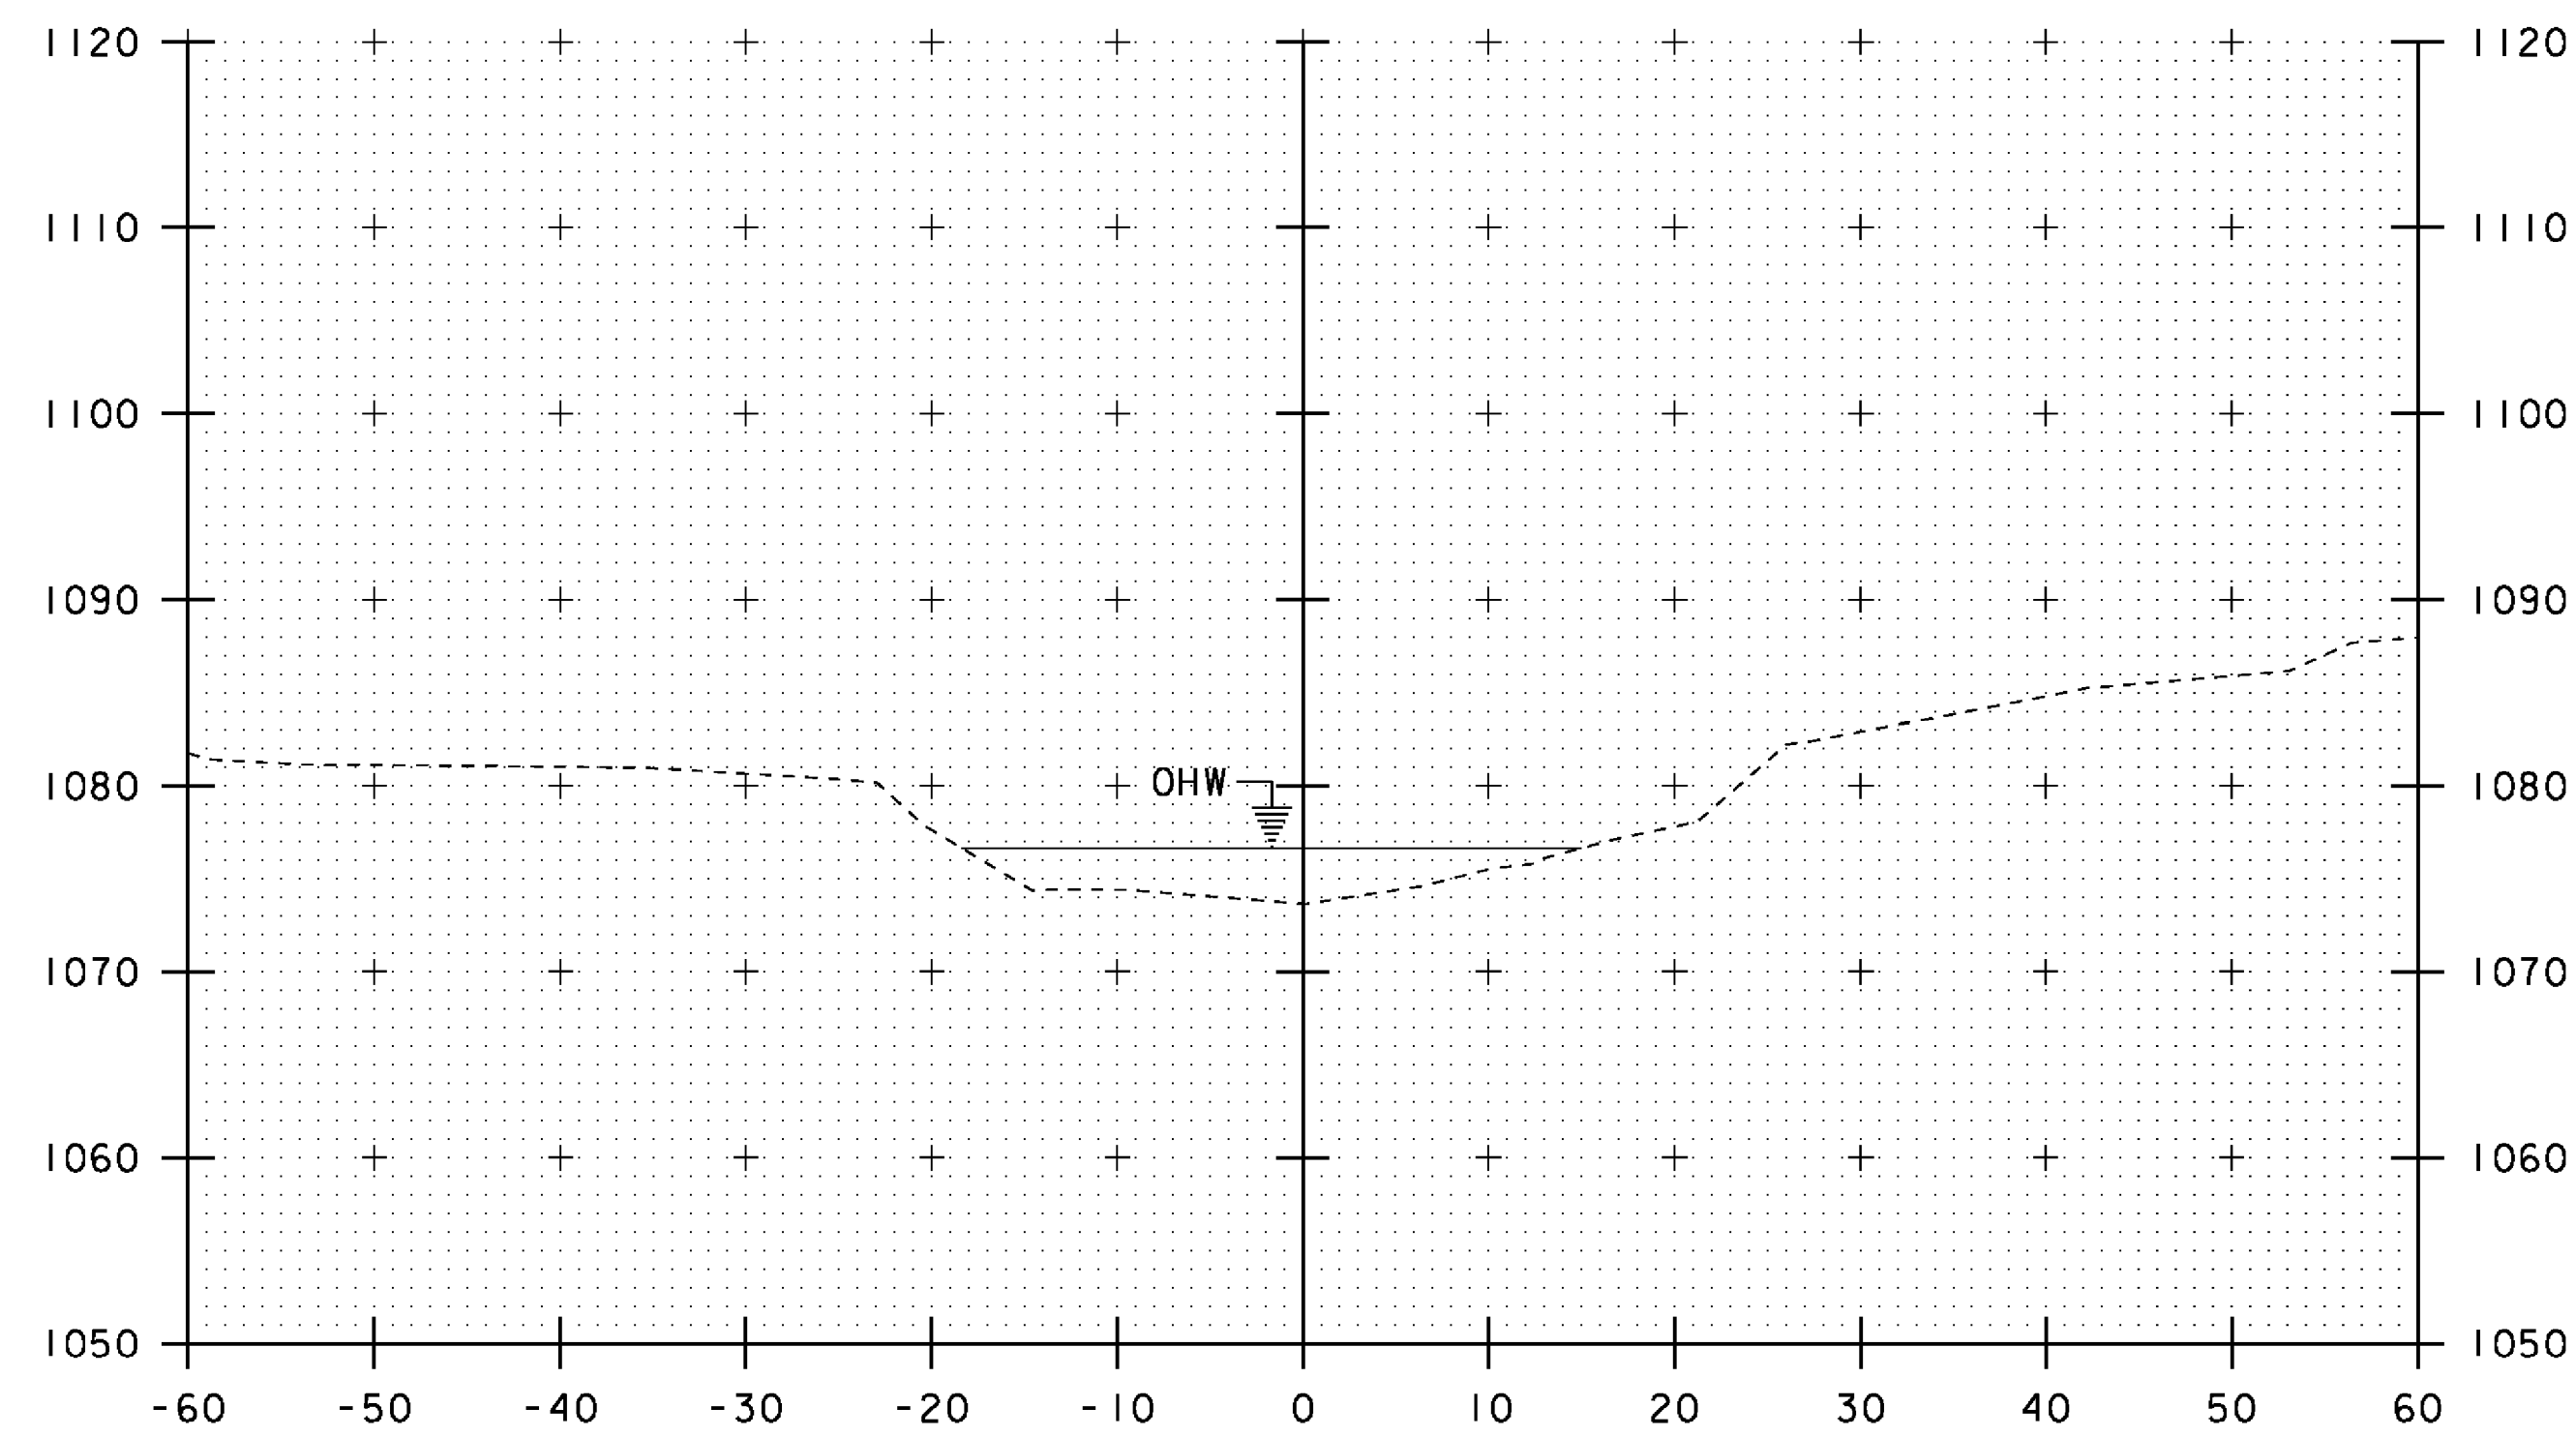


11+00

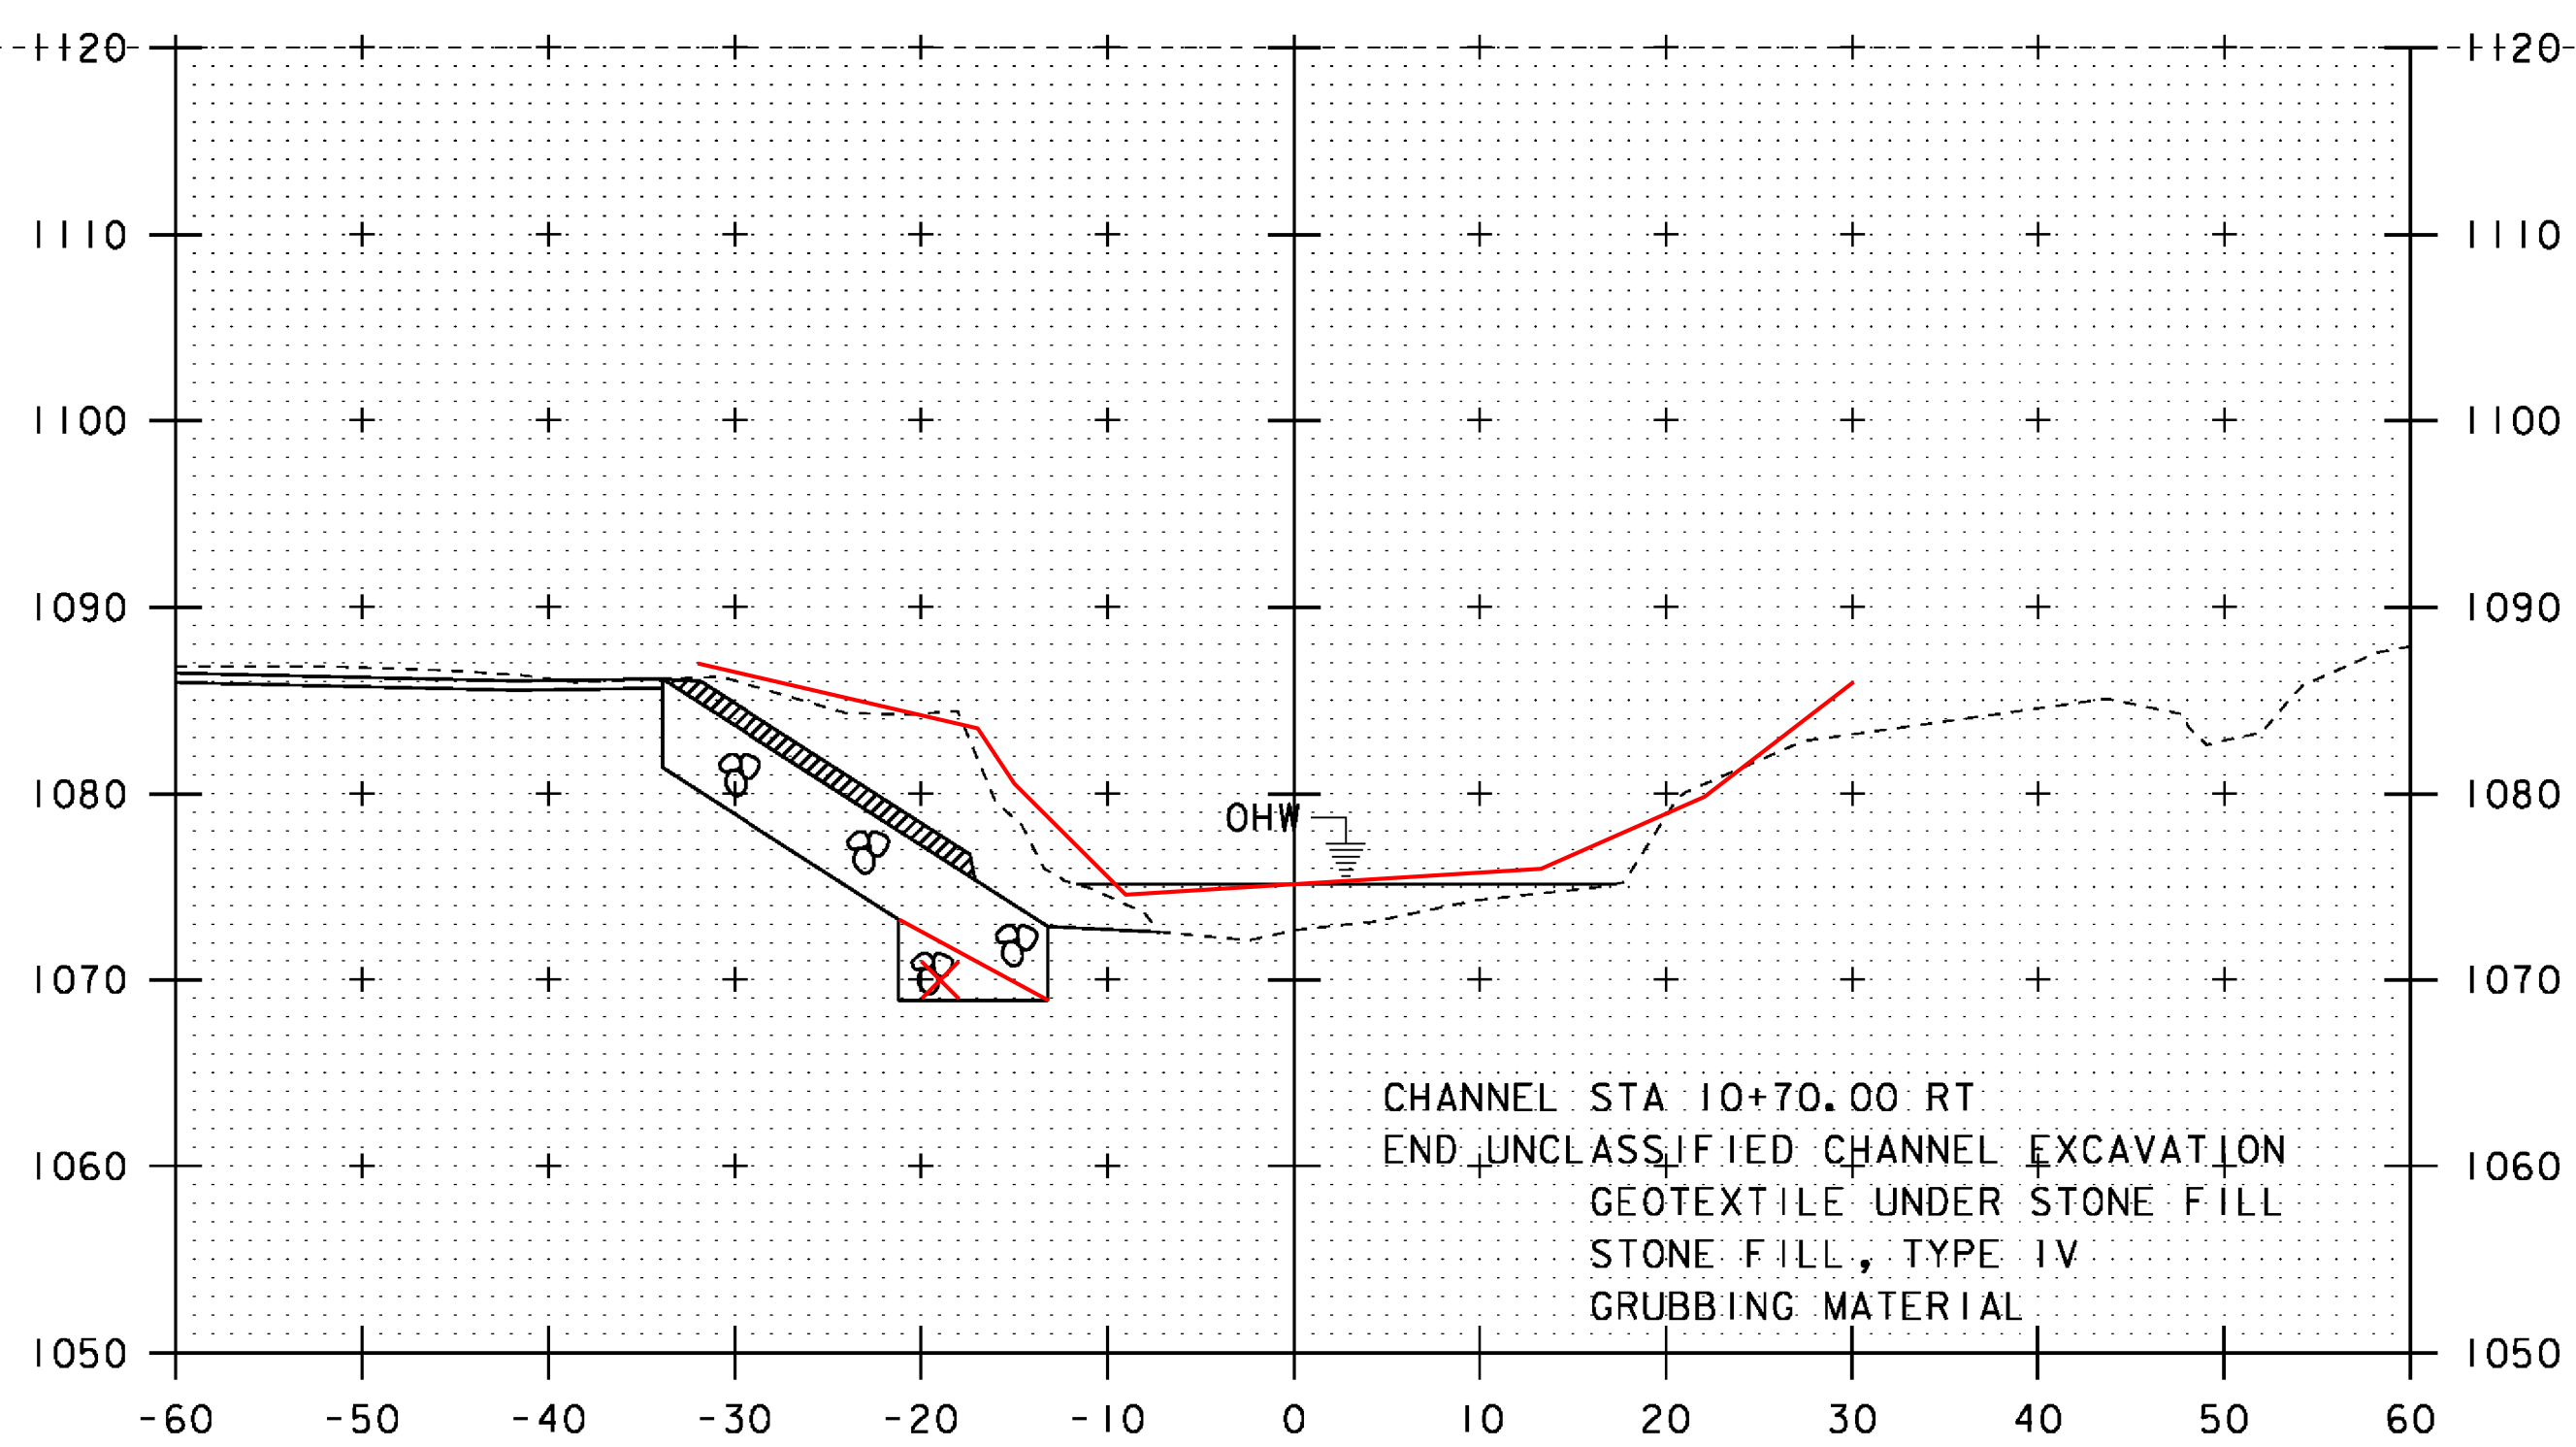

10+70

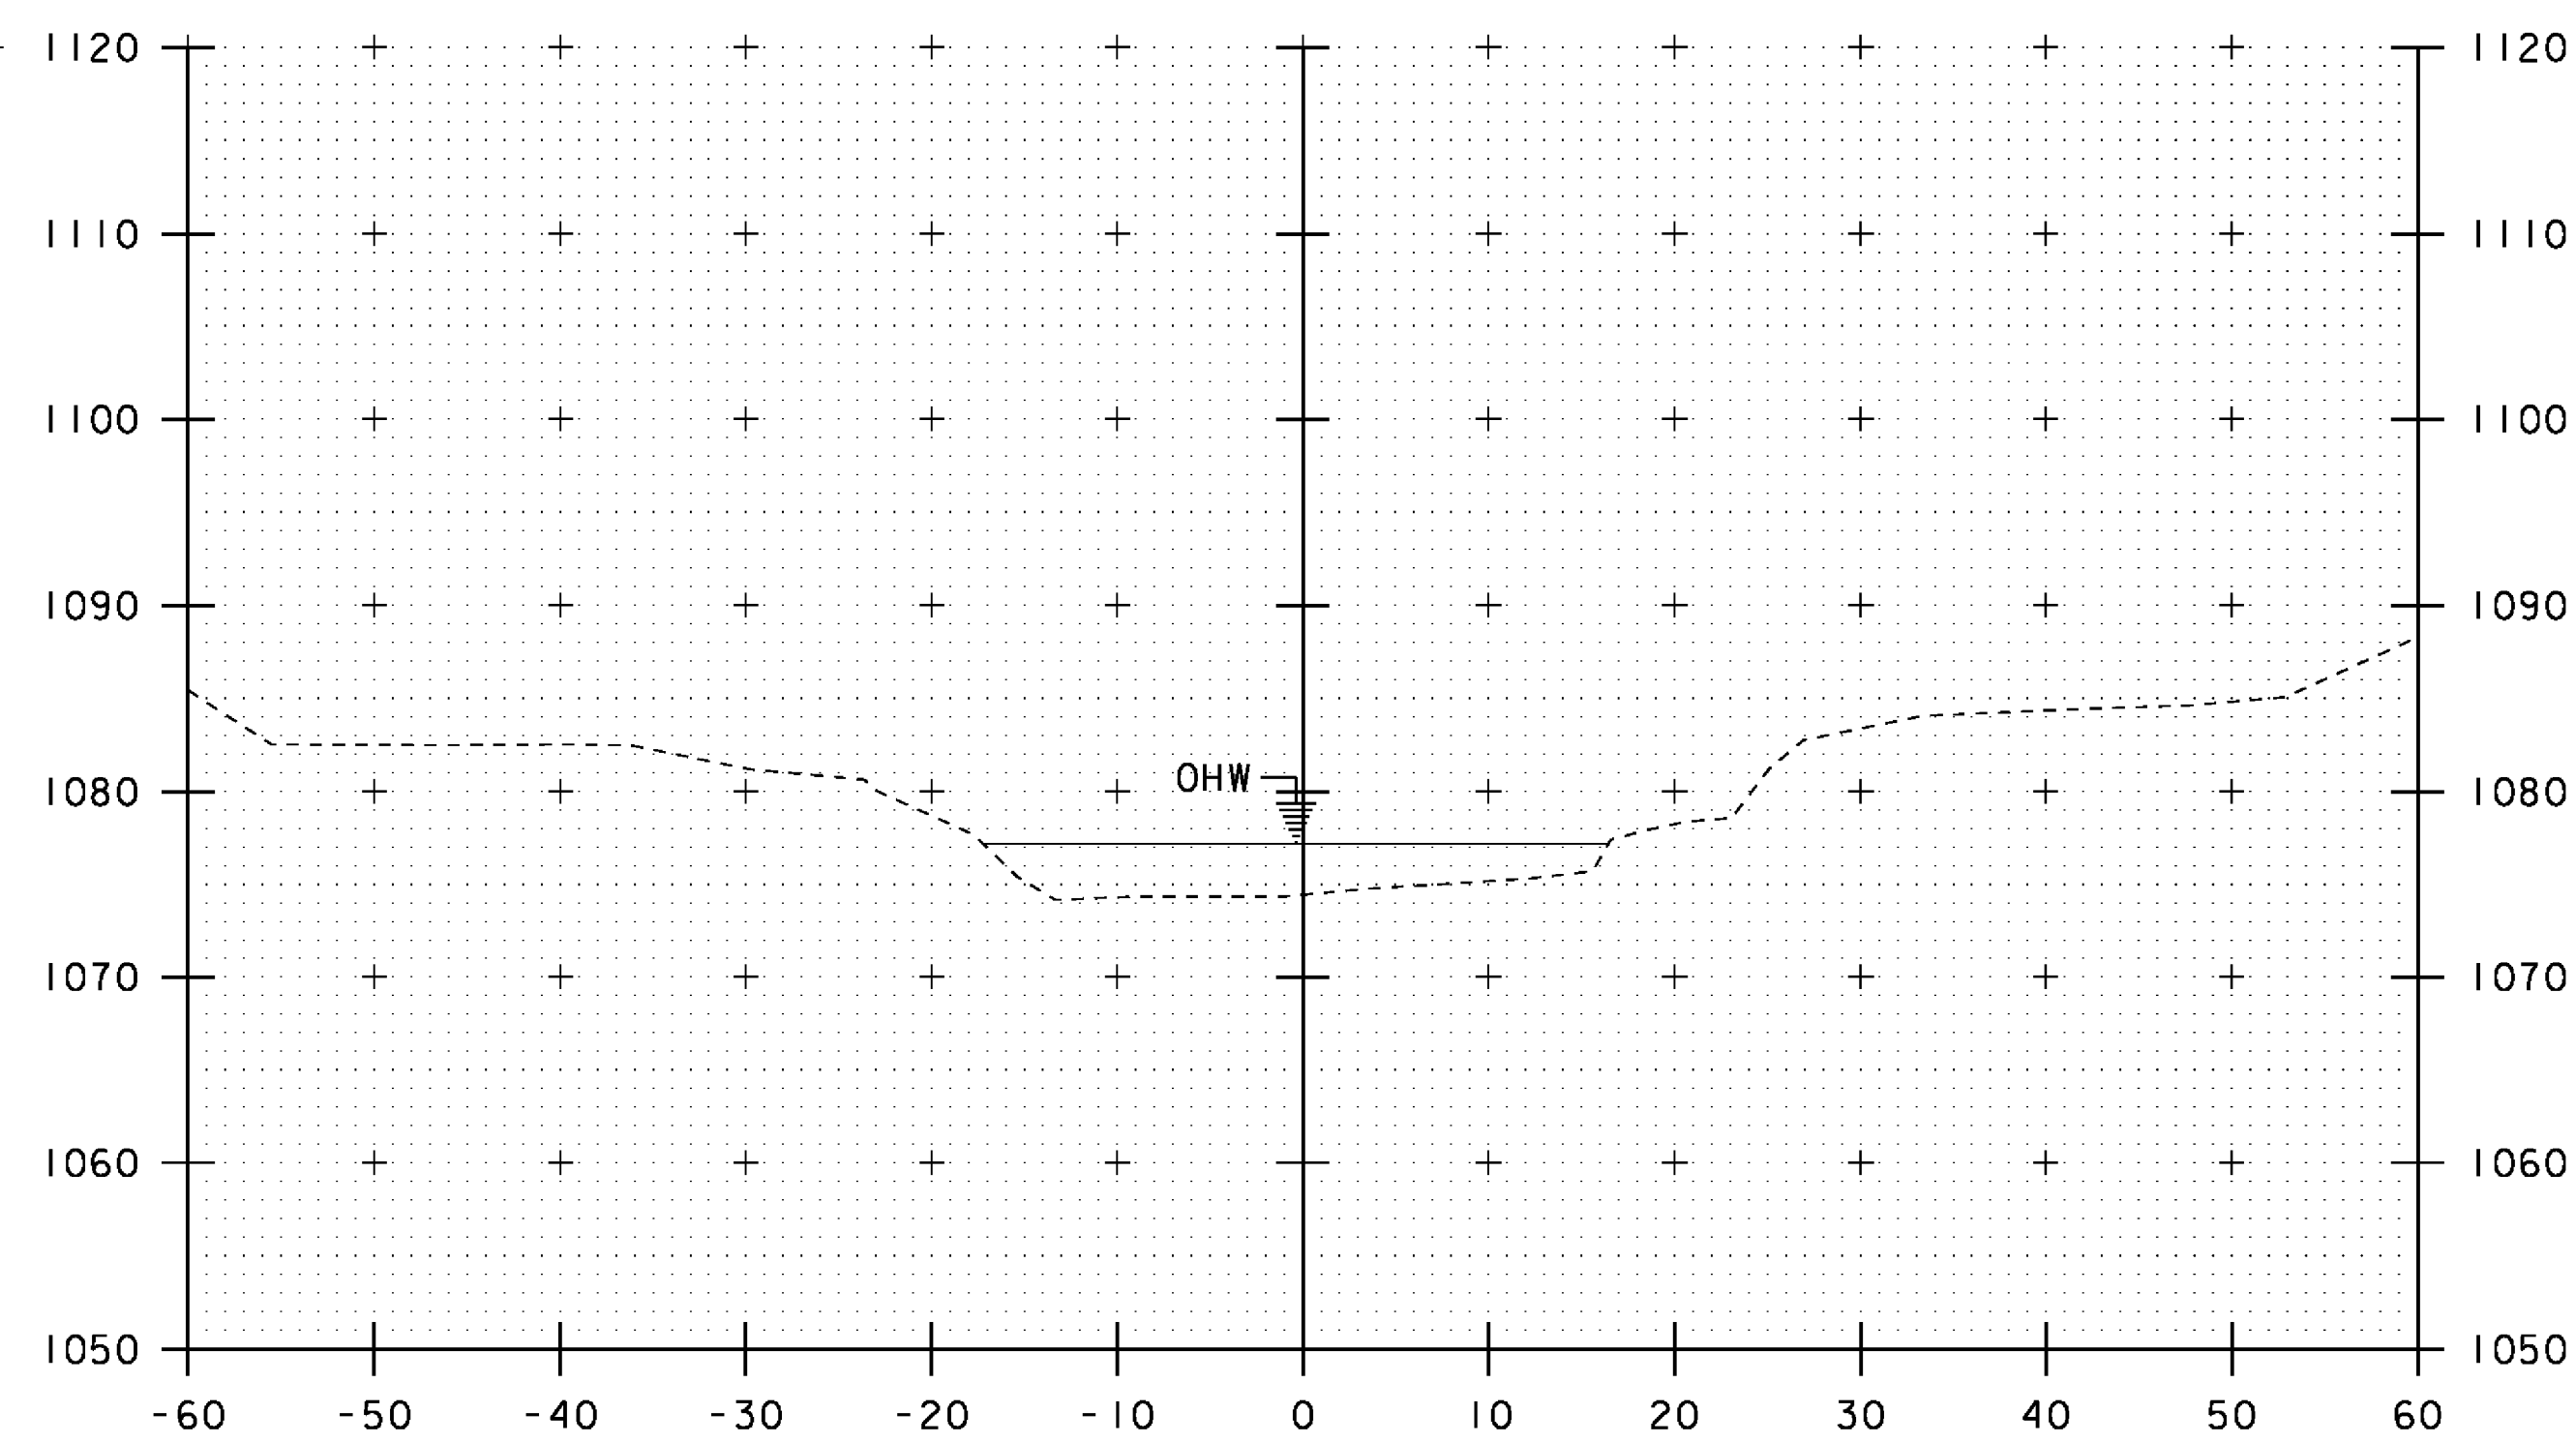

10+90

SCALE 1" = 10'-0"


STA. 10+70 TO STA. 11+00

PROJECT NAME: HUNTINGTON	PLOT DATE: 15-OCT-2015
PROJECT NUMBER: BRO 1445(35)	DRAWN BY: R. PELLETT
FILE NAME: s12j162xs.dgn	CHECKED BY: D. PETERSON
PROJECT LEADER: C. CARLSON	SHEET 36 OF 44
DESIGNED BY: D. PETERSON	
CHANNEL CROSS SECTIONS 4	