


MARLOW LOW EXTREMELY STONY LOAM
WITH 20% TO 60% SLOPES
"K FACTOR" = 0.24

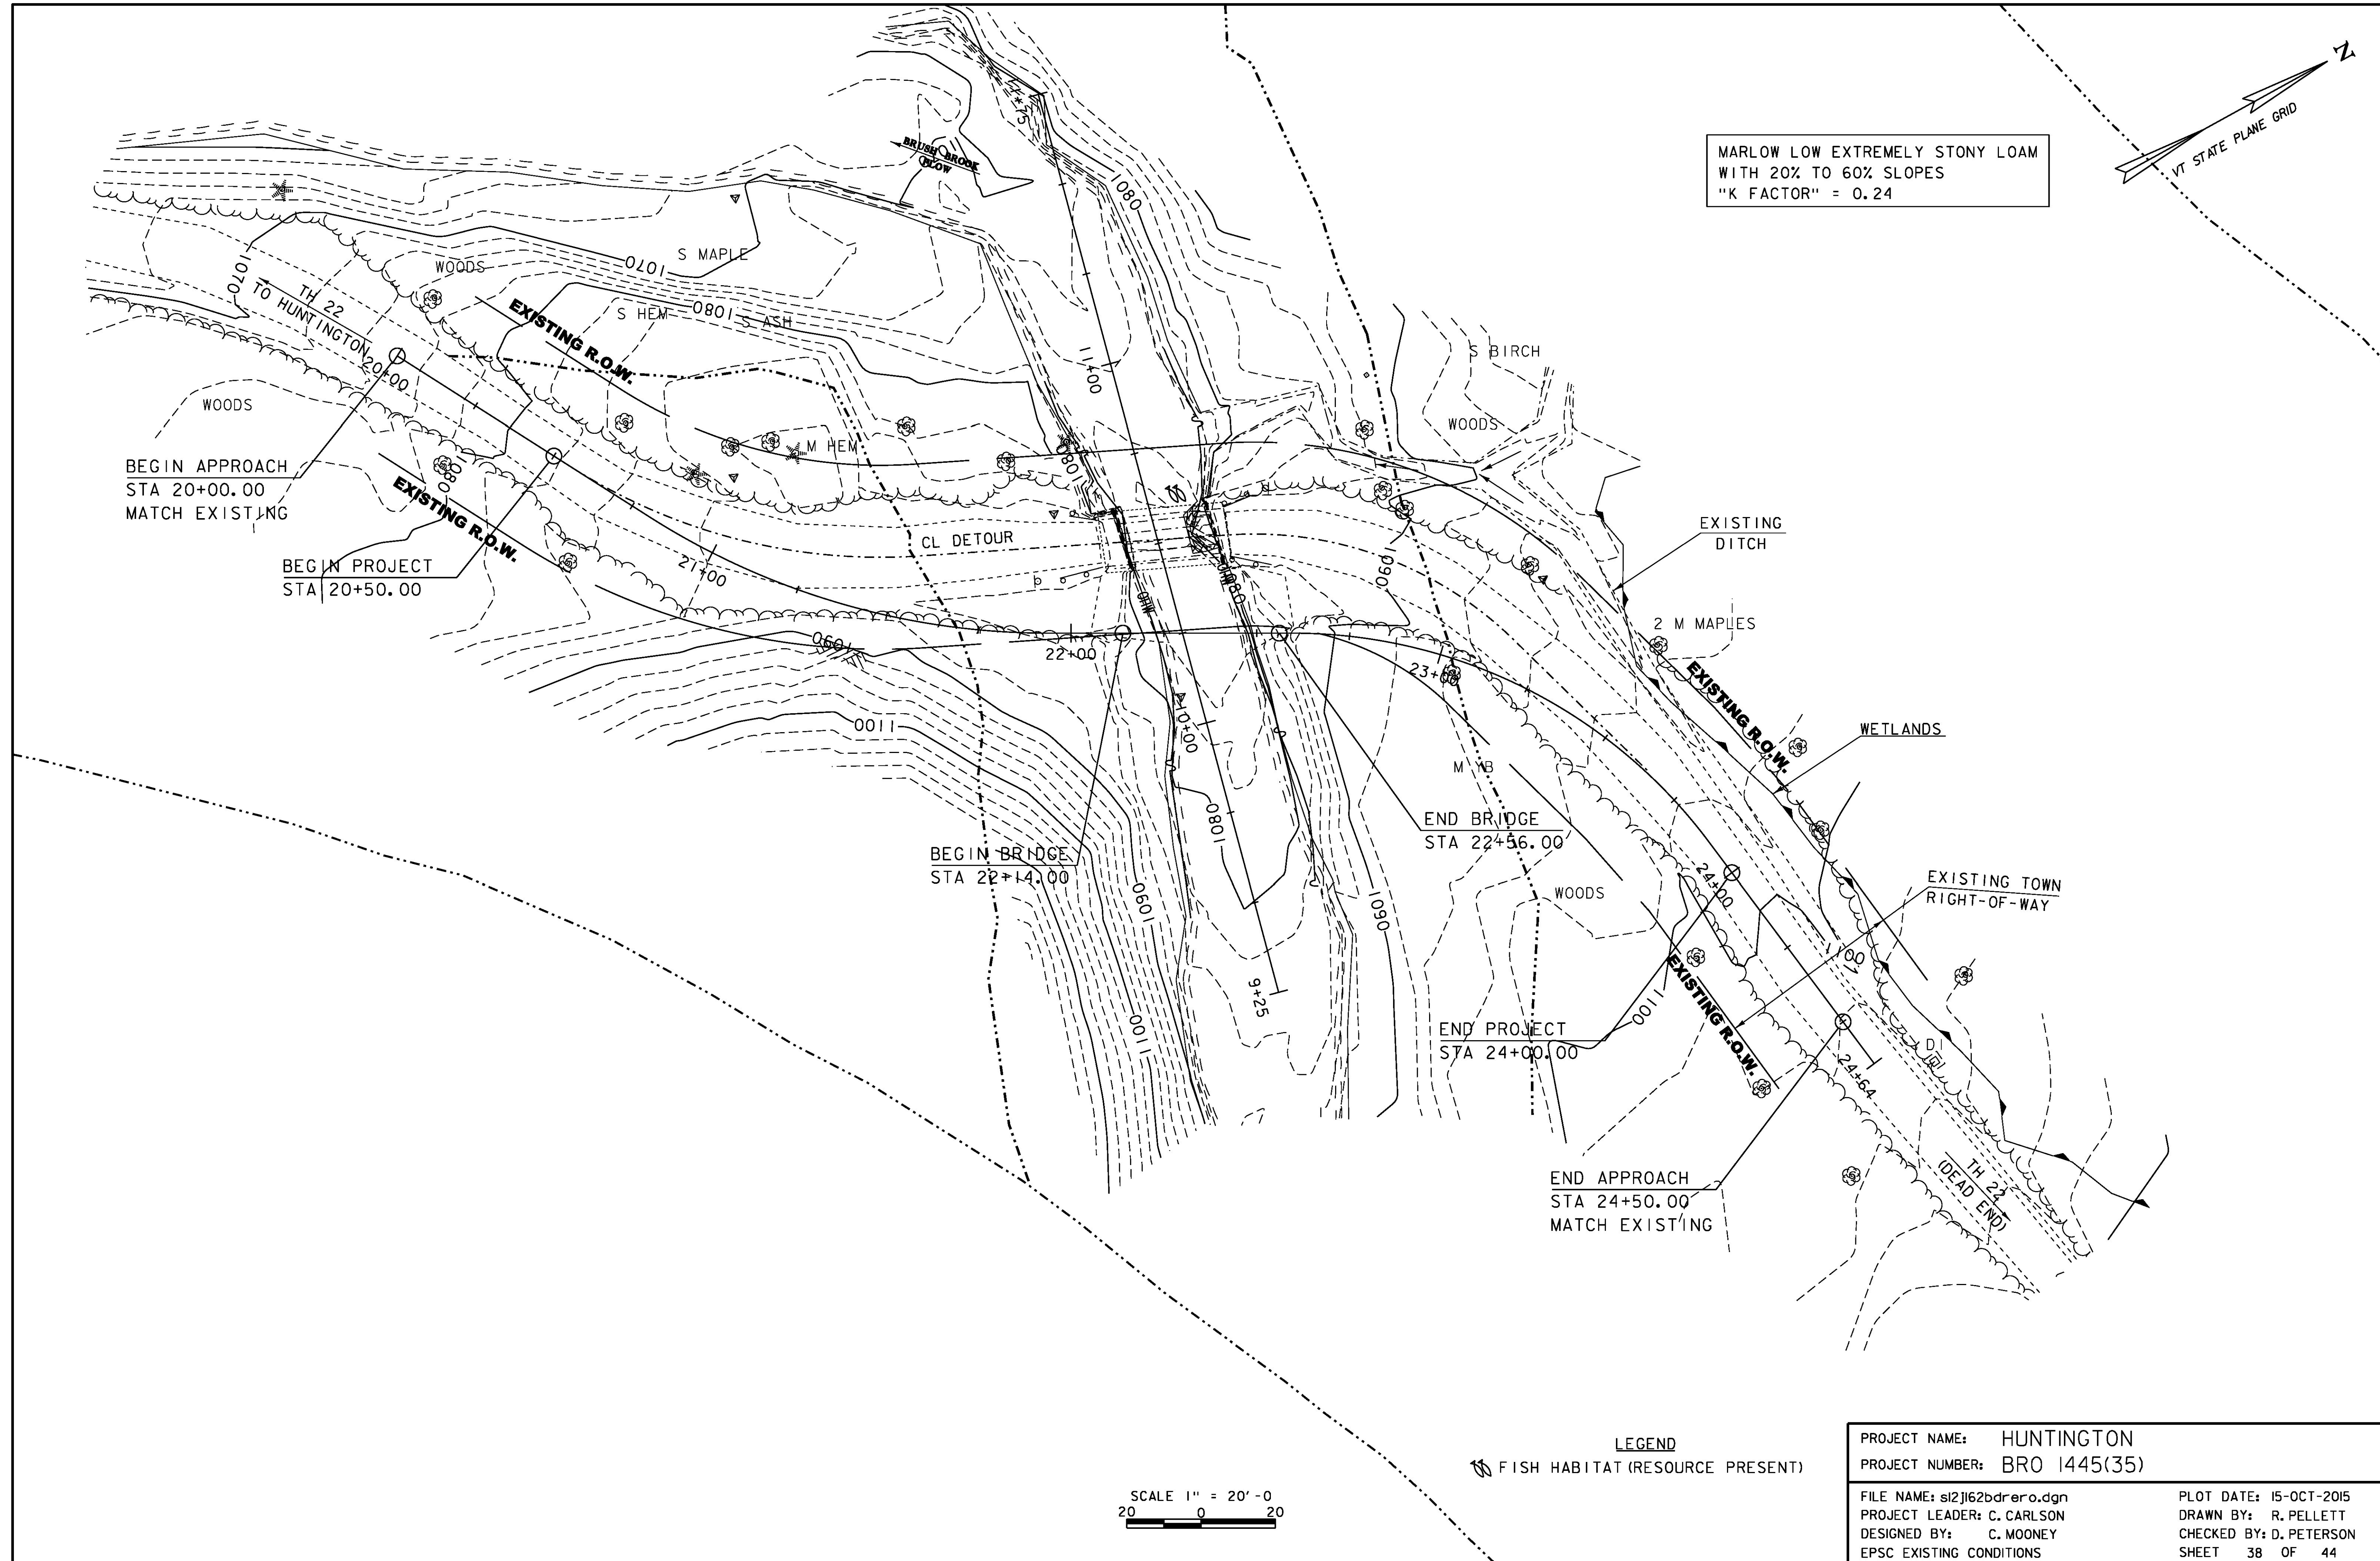

SCALE 1" = 20'-0"
20 0 20

LEGEND
FISH HABITAT (RESOURCE PRESENT)

PROJECT NAME:	HUNTINGTON	PLOT DATE:	15-OCT-2015
PROJECT NUMBER:	BRO 1445(35)	DRAWN BY:	R. PELLETT
FILE NAME:	sl2j162bdrer0.dgn	CHECKED BY:	D. PETERSON
PROJECT LEADER:	C. CARLSON	SHEET	38 OF 44
DESIGNED BY:	C. MOONEY		
EPSC EXISTING CONDITIONS			