




STATE OF VERMONT AGENCY OF TRANSPORTATION

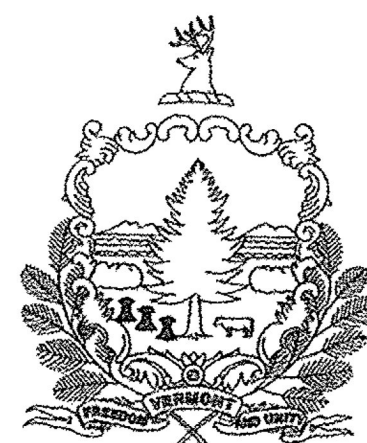

PROPOSED IMPROVEMENT BRIDGE PROJECT TOWN OF ST. JOHNSBURY COUNTY OF CALEDONIA TH 371, RURAL LOCAL ROAD, CLASS 3 TOWN HIGHWAY BRIDGE NUMBER 46

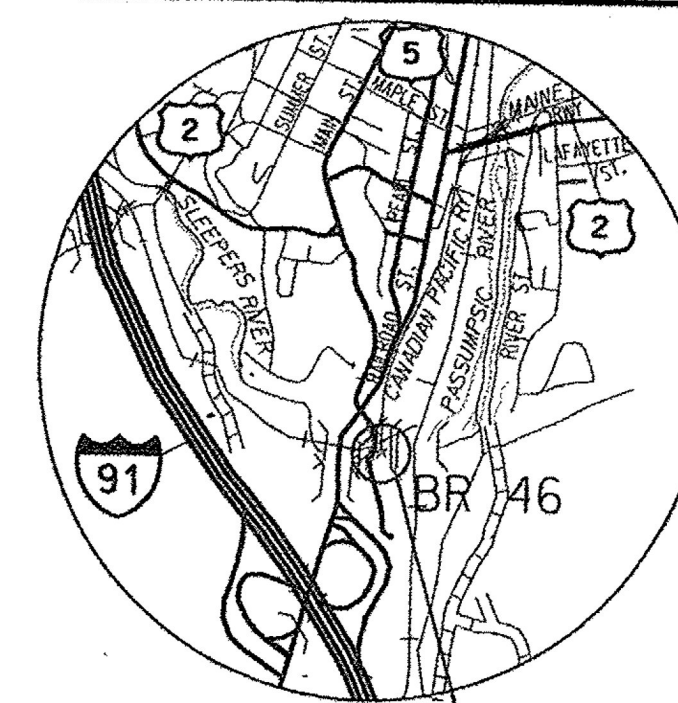

LOCATION MAP
NOT TO SCALE

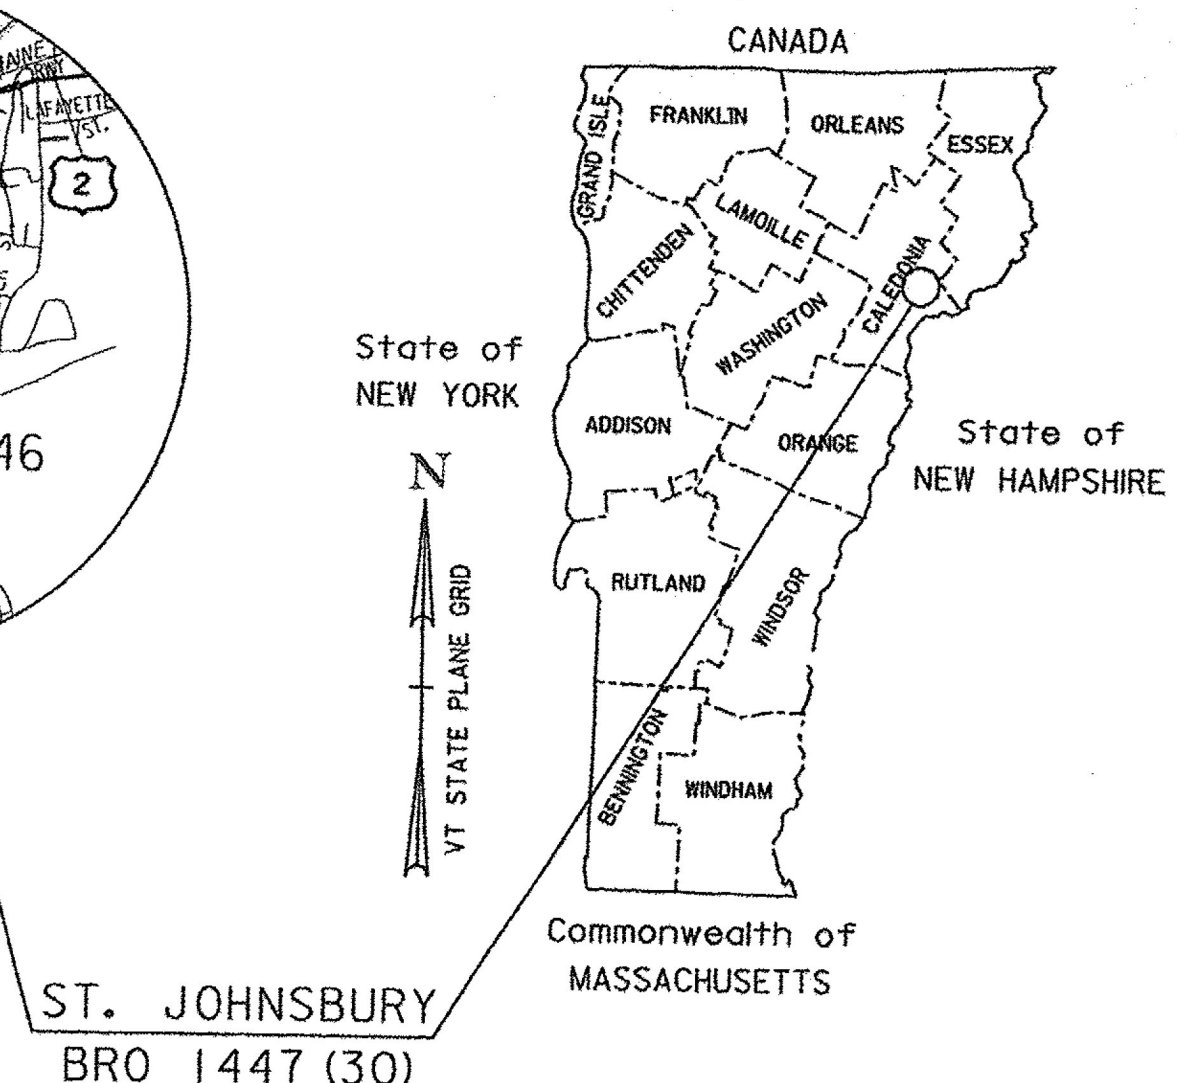


ST. JOHNSBURY
BRO 1447 (30)

RECORD PLANS	
CONTRACTOR:	WINTerset, INC. - LYNDONVILLE, VT
RESIDENT ENGINEER:	JAY STRONG
CONSTRUCTION BEGAN:	APRIL 13, 2017
CONSTRUCTION COMPLETE:	MAY 18, 2018
RECORD PLANS BY:	JAY STRONG & JESSE IVES
I HEREBY CERTIFY THAT ALL THE CONSTRUCTION REQUIRED BY THIS SET OF DRAWINGS HAS BEEN ACCOMPLISHED AS INDICATED HEREIN.	
BY:	RESIDENT ENGINEER
DATE:	10/10/2018
NOTE: Any further information concerning final quantities, amounts or other details relative to this project may be found at Central Files in the electronic archives.	

PROJECT LOCATION: THE PROJECT IS LOCATED ON TH 371 (MAIN STREET), APPROXIMATELY 0.1 MILES SOUTH OF JUNCTION WITH US ROUTE 5

PROJECT DESCRIPTION: DEMOLITION OF EXISTING BRIDGE, AND REPLACEMENT WITH A NEW SINGLE SPAN STEEL BEAM BRIDGE ON THE EXISTING ALIGNMENT, WITH ASSOCIATED ROADWAY AND CHANNEL WORK.

LENGTH OF STRUCTURE: 112.02 FEET
LENGTH OF ROADWAY: 112.98 FEET
LENGTH OF PROJECT: 225.00 FEET

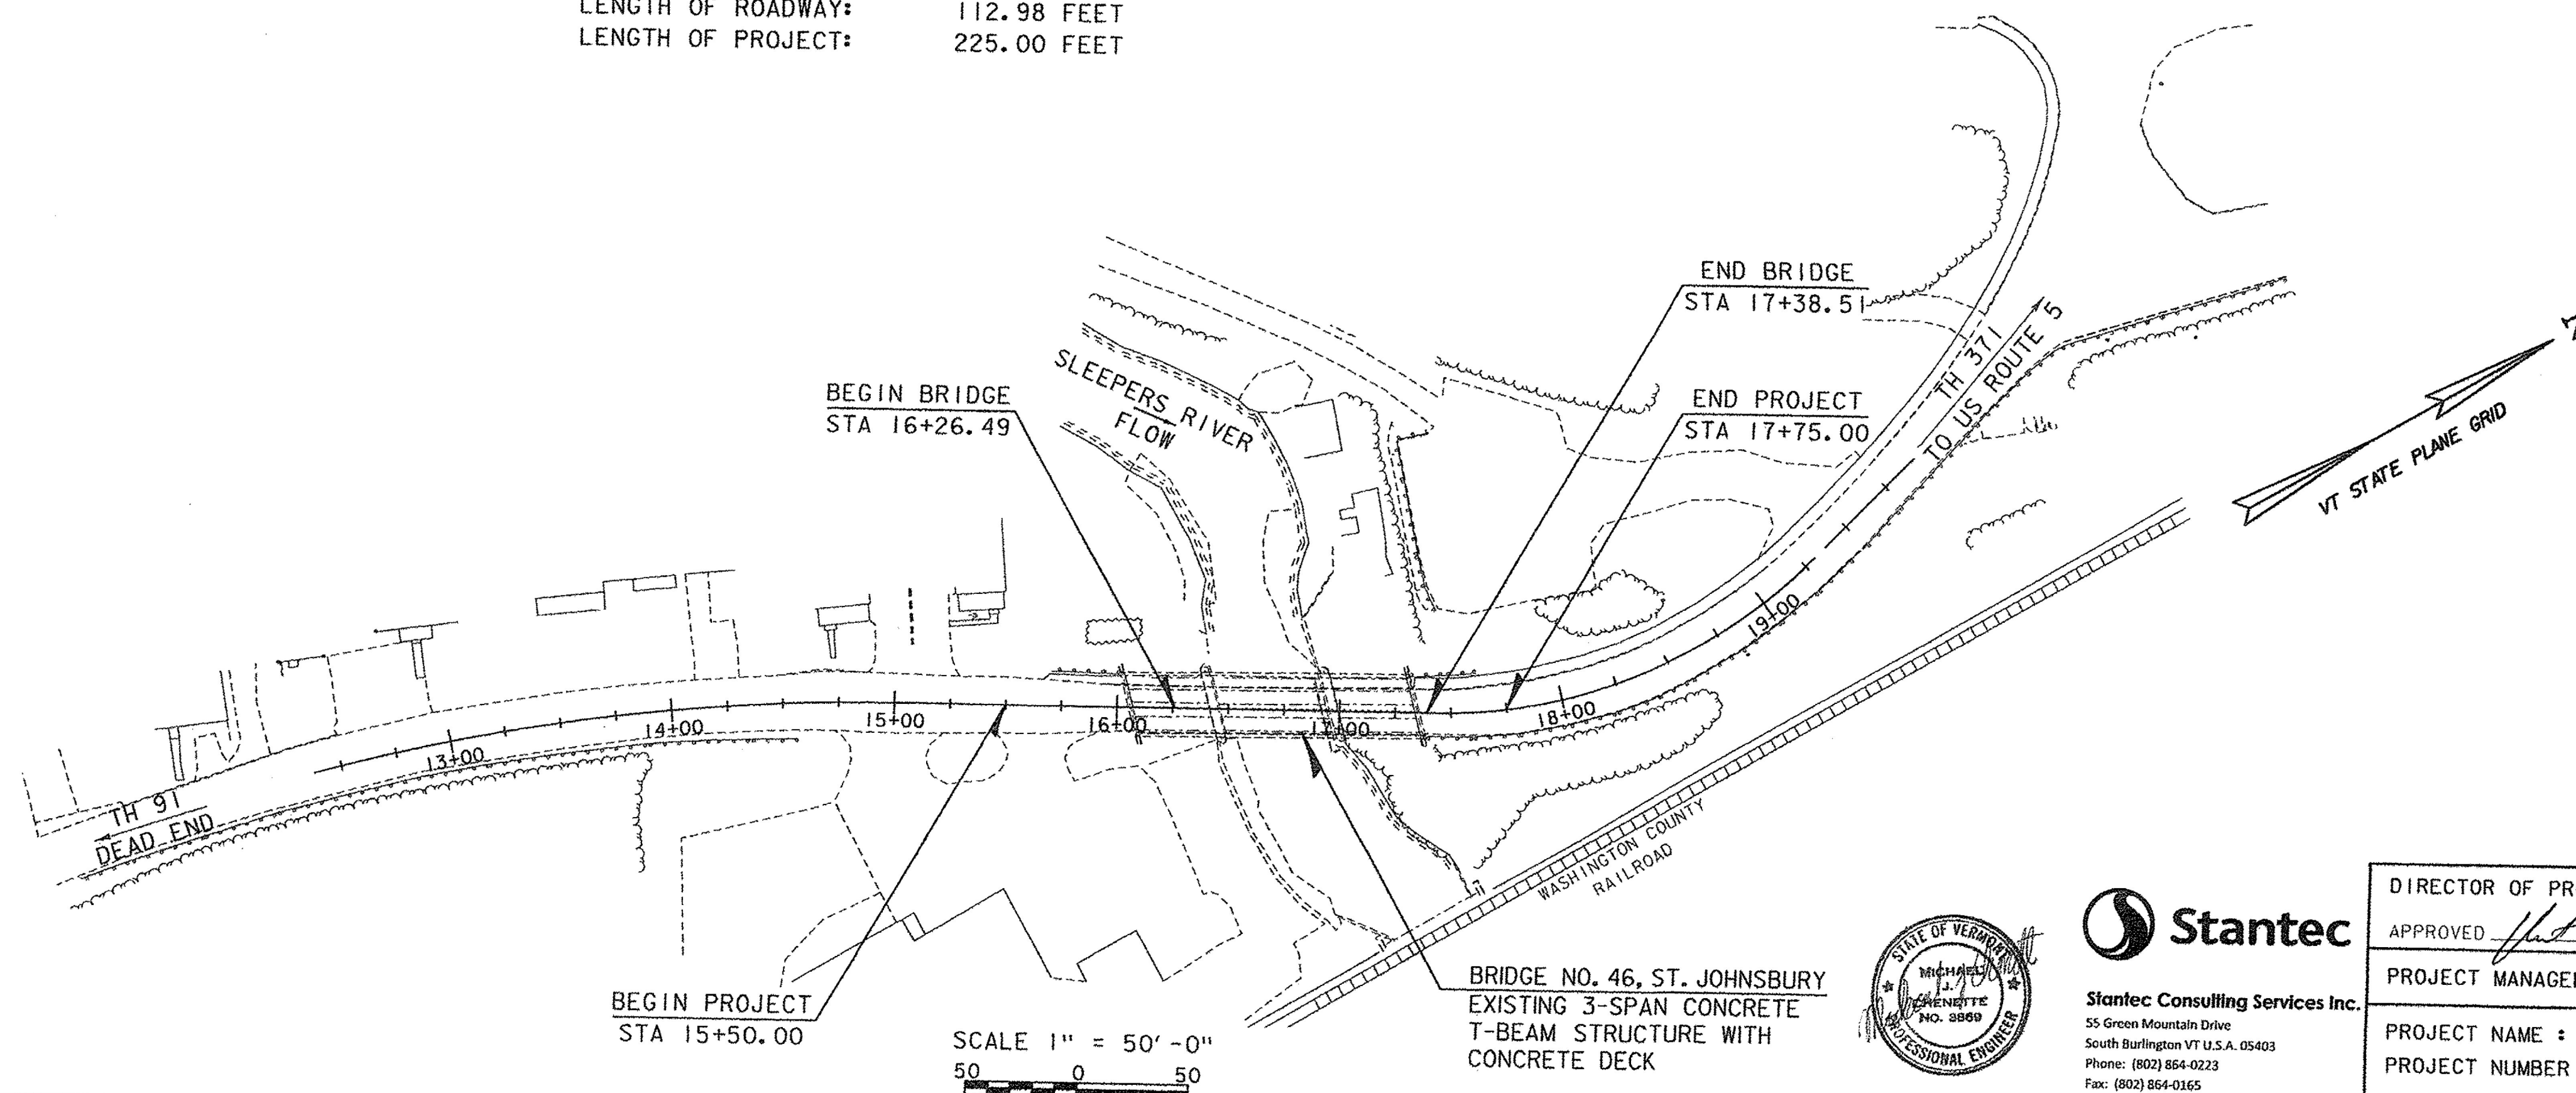


CONSTRUCTION IS TO BE CARRIED ON IN ACCORDANCE WITH THESE PLANS AND THE STANDARD SPECIFICATIONS FOR CONSTRUCTION DATED 2011, AS APPROVED BY THE FEDERAL HIGHWAY ADMINISTRATION ON JULY 20, 2011 FOR USE ON THIS PROJECT, INCLUDING ALL SUBSEQUENT REVISIONS AND SUCH REVISED SPECIFICATIONS AND SPECIAL PROVISIONS AS ARE INCORPORATED IN THESE PLANS.

QUALITY ASSURANCE PROGRAM : LEVEL 2	
SURVEYED BY :	L. ORVIS
SURVEYED DATE :	5/16/2012
DATUM	
VERTICAL	NAVD88
HORIZONTAL	NAD 83 (96)

SCALE 1" = 50' - 0"

BRIDGE NO. 46, ST. JOHNSBURY
 EXISTING 3-SPAN CONCRETE
 T-BEAM STRUCTURE WITH
 CONCRETE DECK

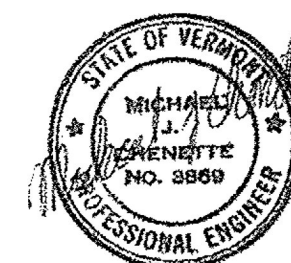

Stantec Consulting Services Inc.
 55 Green Mountain Drive
 South Burlington VT U.S.A. 05403
 Phone: (802) 864-0223
 Fax: (802) 864-0165
 www.stantec.com

DIRECTOR OF PROJECT DELIVERY	
APPROVED	DATE 8/25/2016
PROJECT MANAGER : WENDY PELLETTIER, P.E.	
PROJECT NAME :	ST. JOHNSBURY
PROJECT NUMBER :	BRO 1447 (30)
SHEET 1 OF 76 SHEETS	