


BRIDGE DECK REINFORCING PLAN

SCALE: 1/4" = 1'-0"

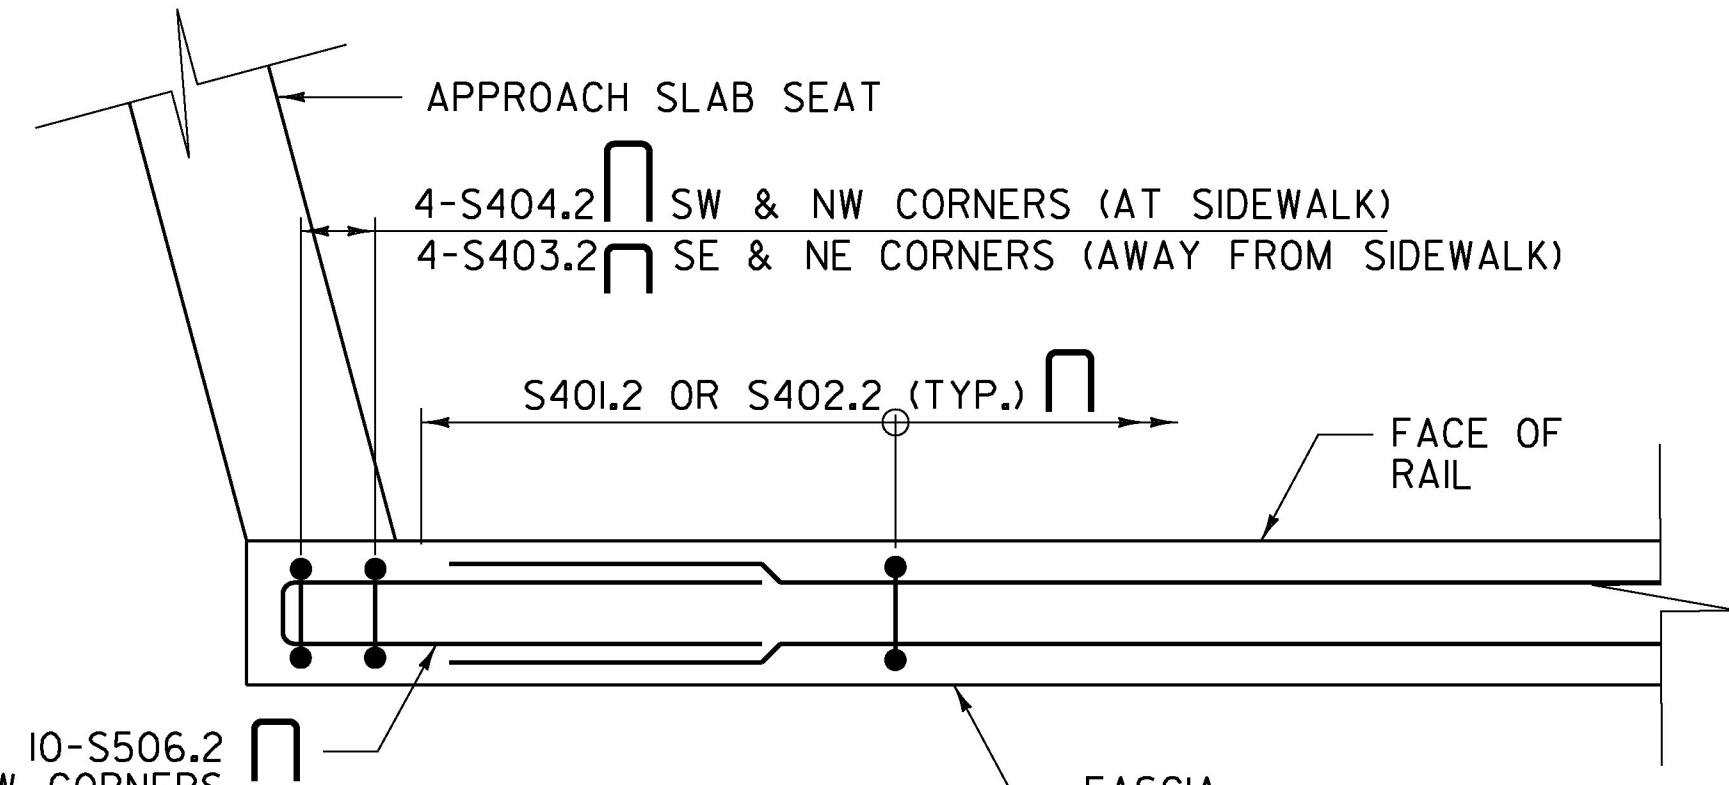

DETAIL A
SCALE 3/4" = 1'-0"

NOTES:

1. 2'-2" MINIMUM BAR LAP UNLESS OTHERWISE SPECIFIED ON PLANS.
2. * - INDICATES ABUTMENT BAR. REFER TO ABUTMENT DRAWINGS FOR DETAILS.

PROJECT NAME:	ST JOHNSBURY
PROJECT NUMBER:	BRO 1447(30)
FILE NAME:	z12j164deck.dgn
PROJECT LEADER:	M. CHENETTE
DESIGNED BY:	D. TAYLOR
DECK REINFORCING PLAN	
PLOT DATE:	9/30/2016
DRAWN BY:	J. SOTER
CHECKED BY:	TEK/DDT
SHEET	29 OF 76

