




FRAMING PLAN
SCALE: 3/16" = 1'-0"
(DIMENSIONS ARE HORIZONTAL)

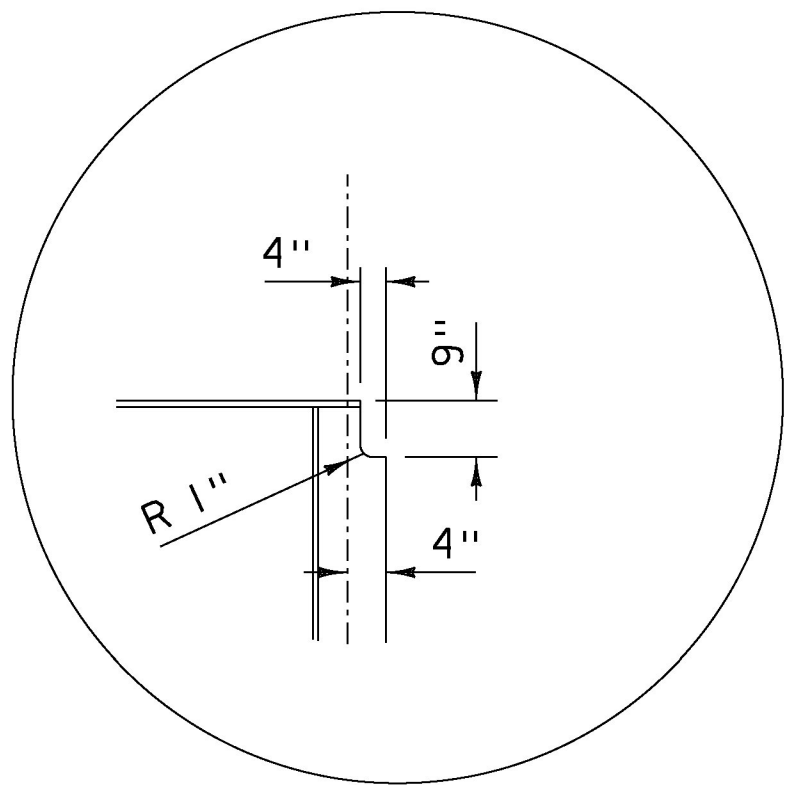

DETAIL B
NOT TO SCALE

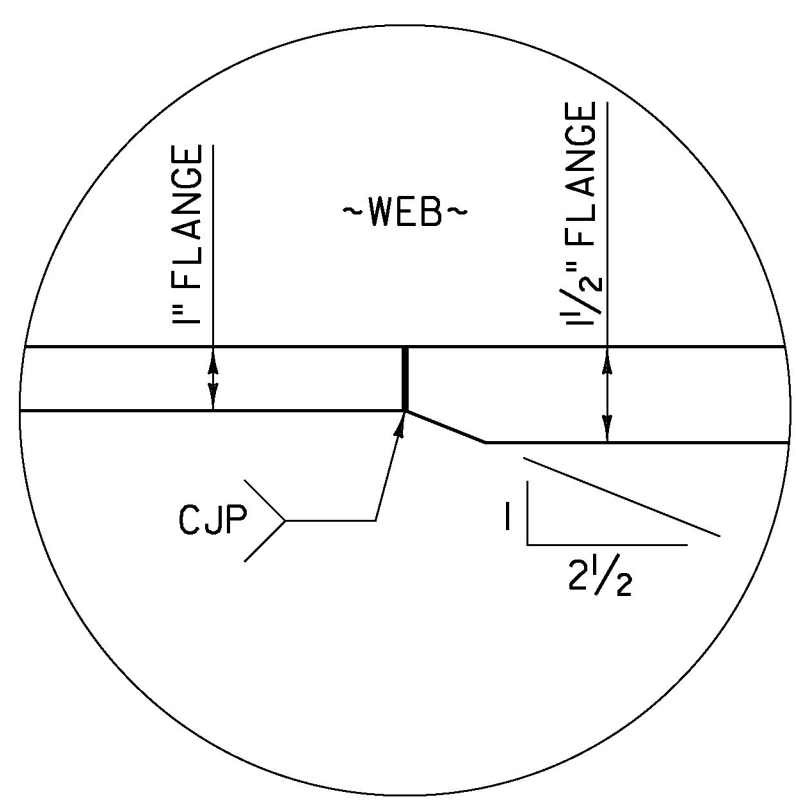

DETAIL A
NOT TO SCALE

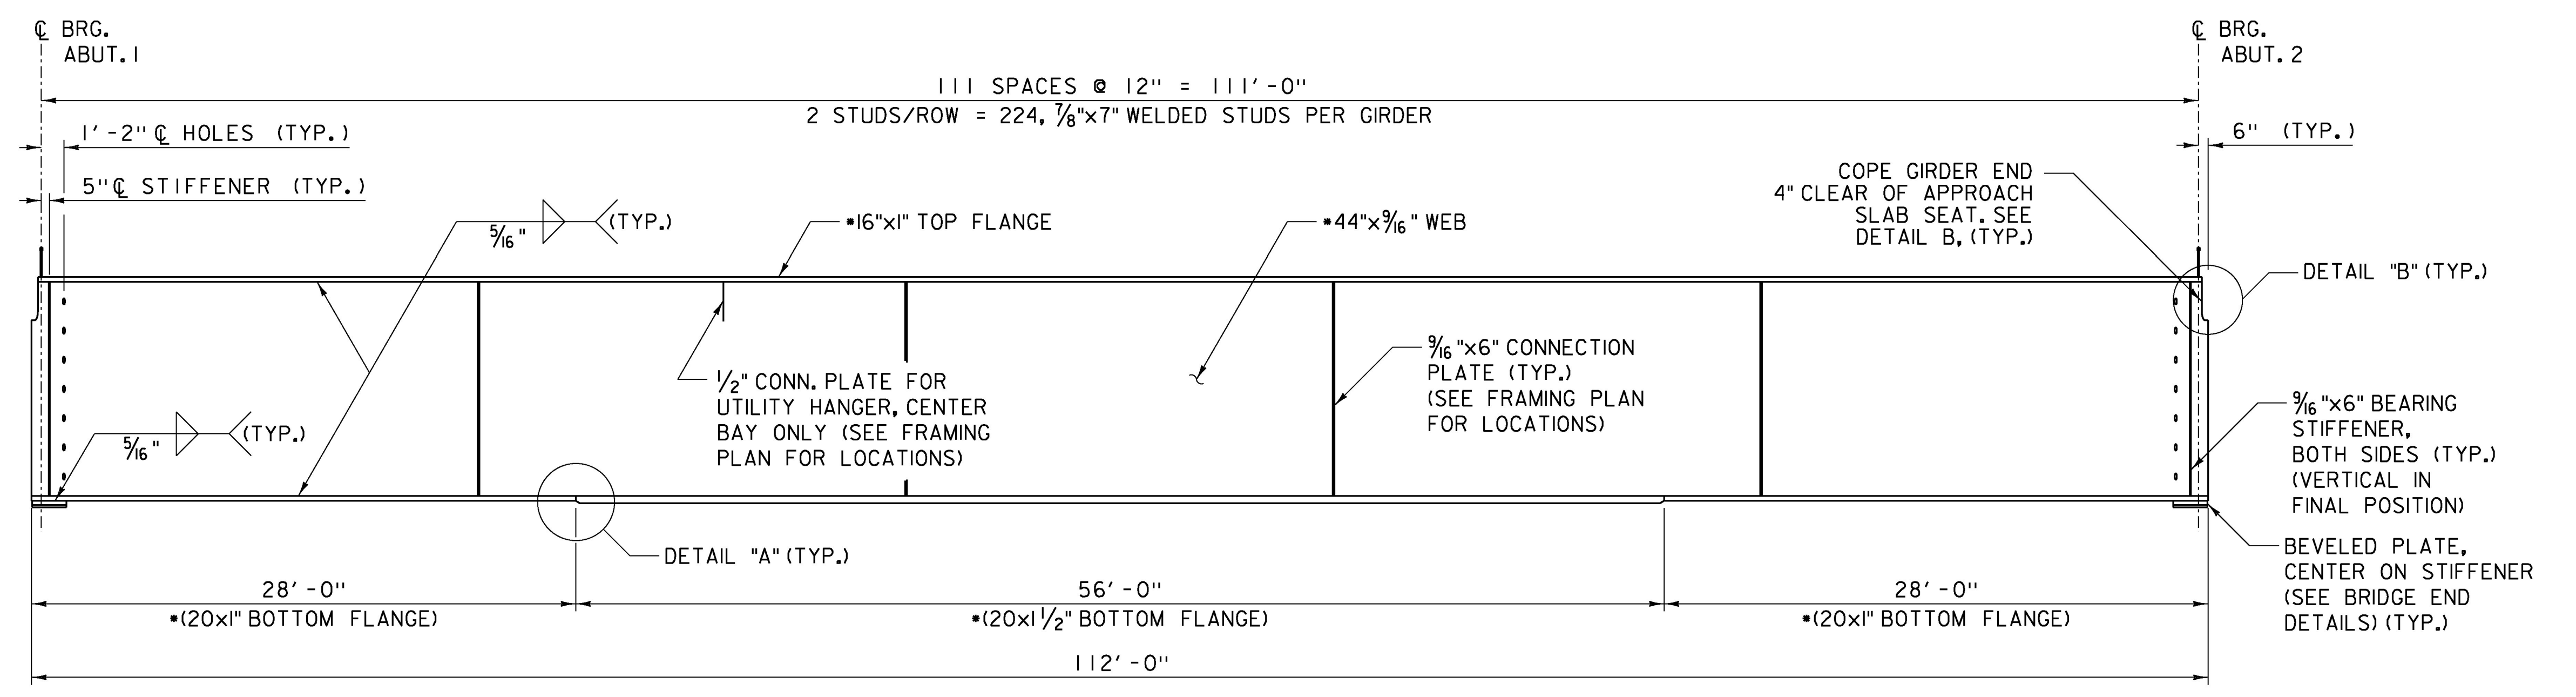

GIRDER ELEVATION
NOT TO SCALE

• DENOTES CHARPY V-NOTCH TEST REQUIRED

PROJECT NAME:	ST JOHNSBURY	FILE NAME:	z12j164fra.dgn	PLOT DATE:	9/30/2016
PROJECT NUMBER:	BRO 1447(30)	PROJECT LEADER:	M. CHENETTE	DRAWN BY:	J. SOTER
		DESIGNED BY:	D. TAYLOR	CHECKED BY:	TEK/DDT
		FRAMING PLAN			SHEET 30 OF 76

