




15+00

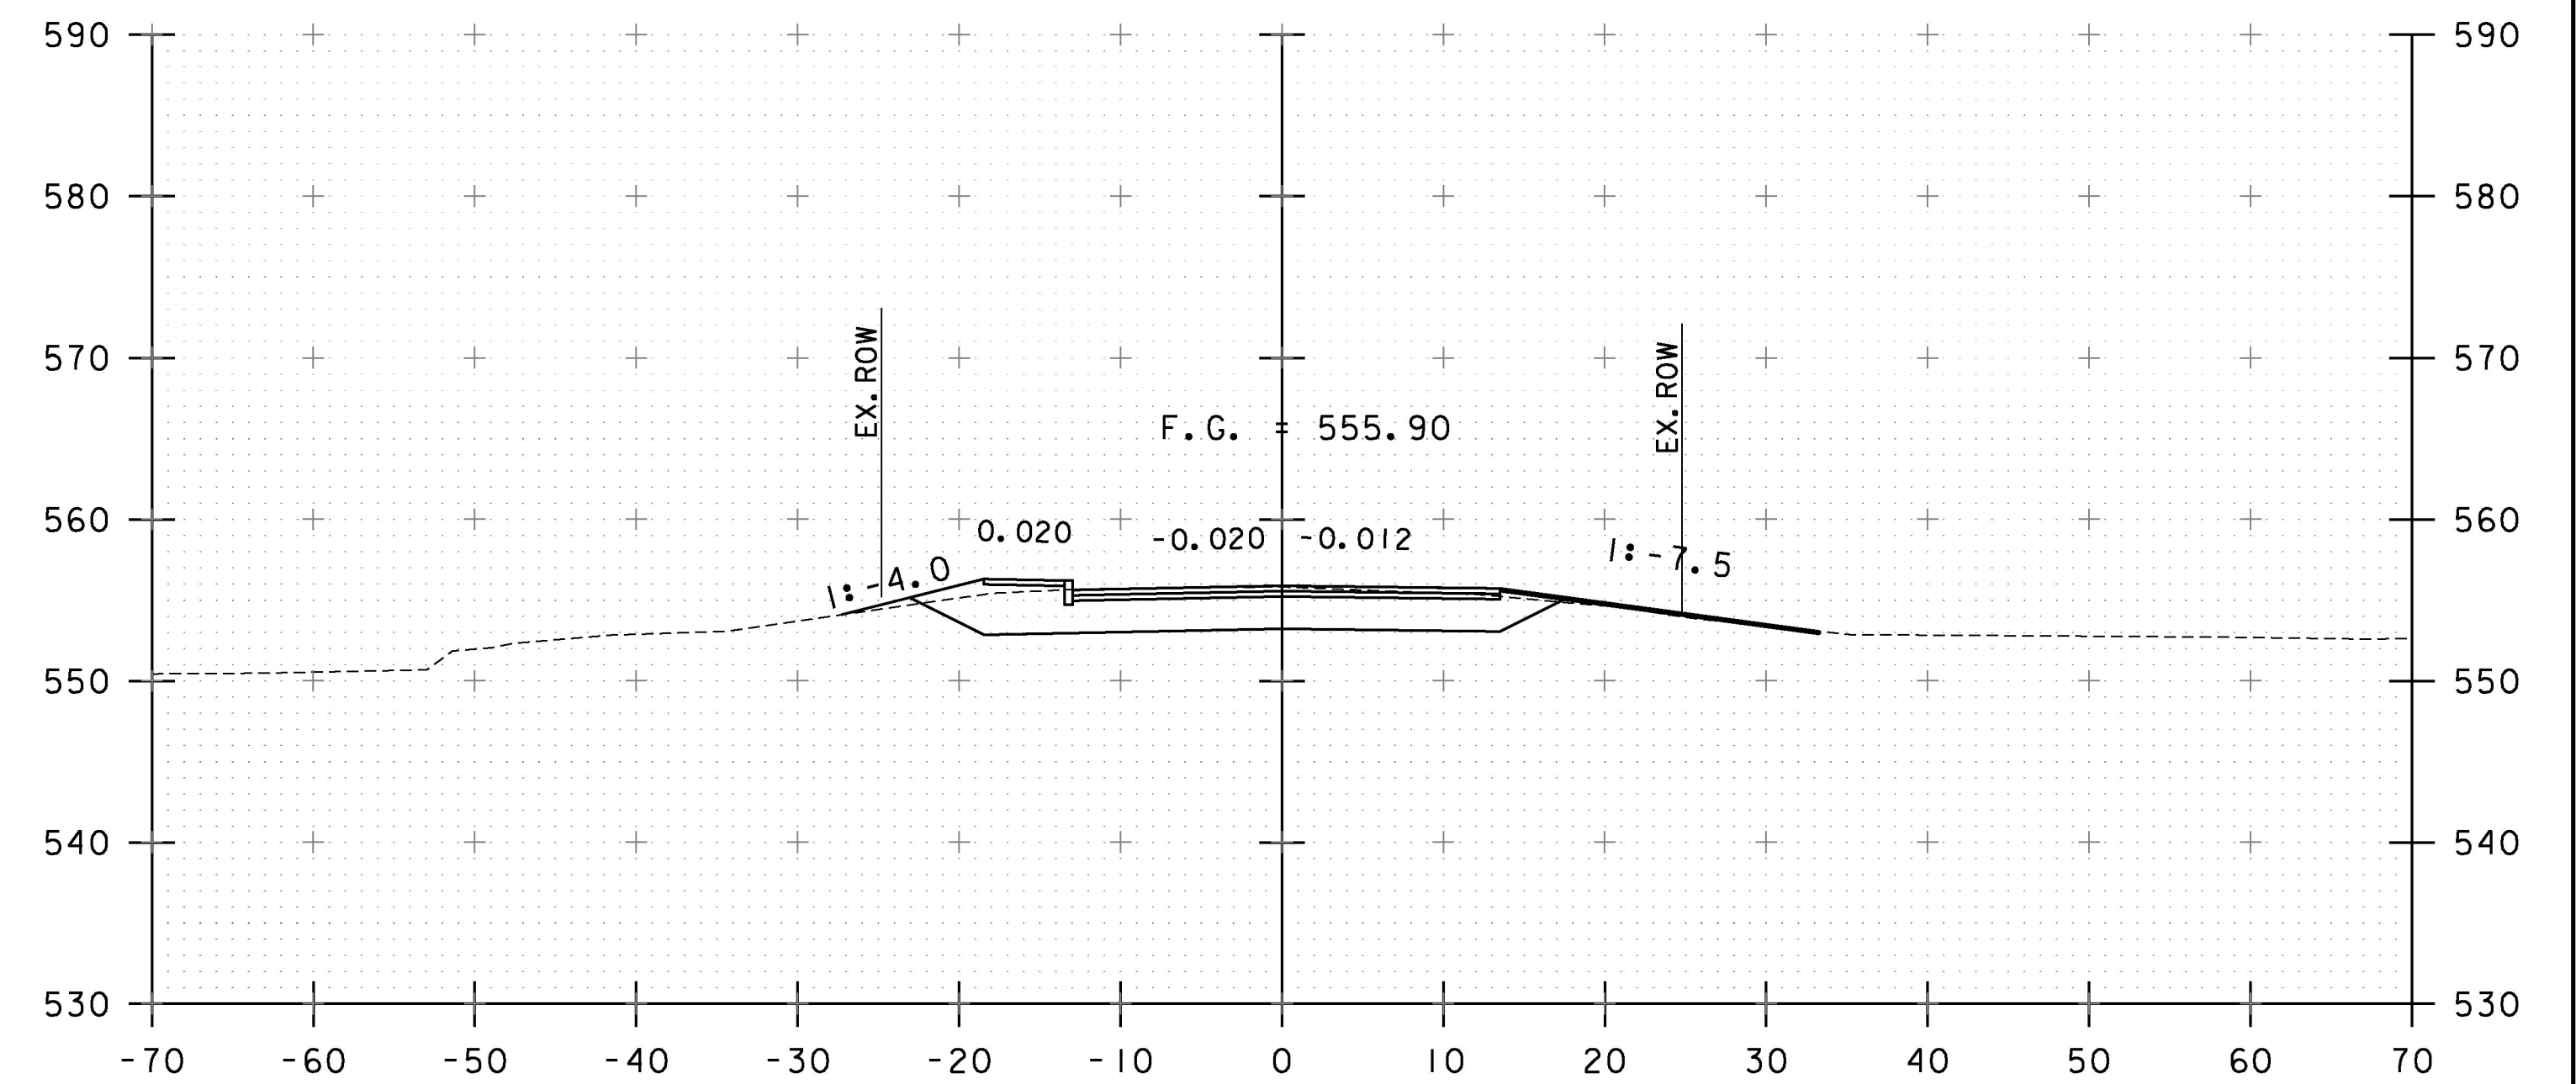

15+50
BEGIN PROJECT

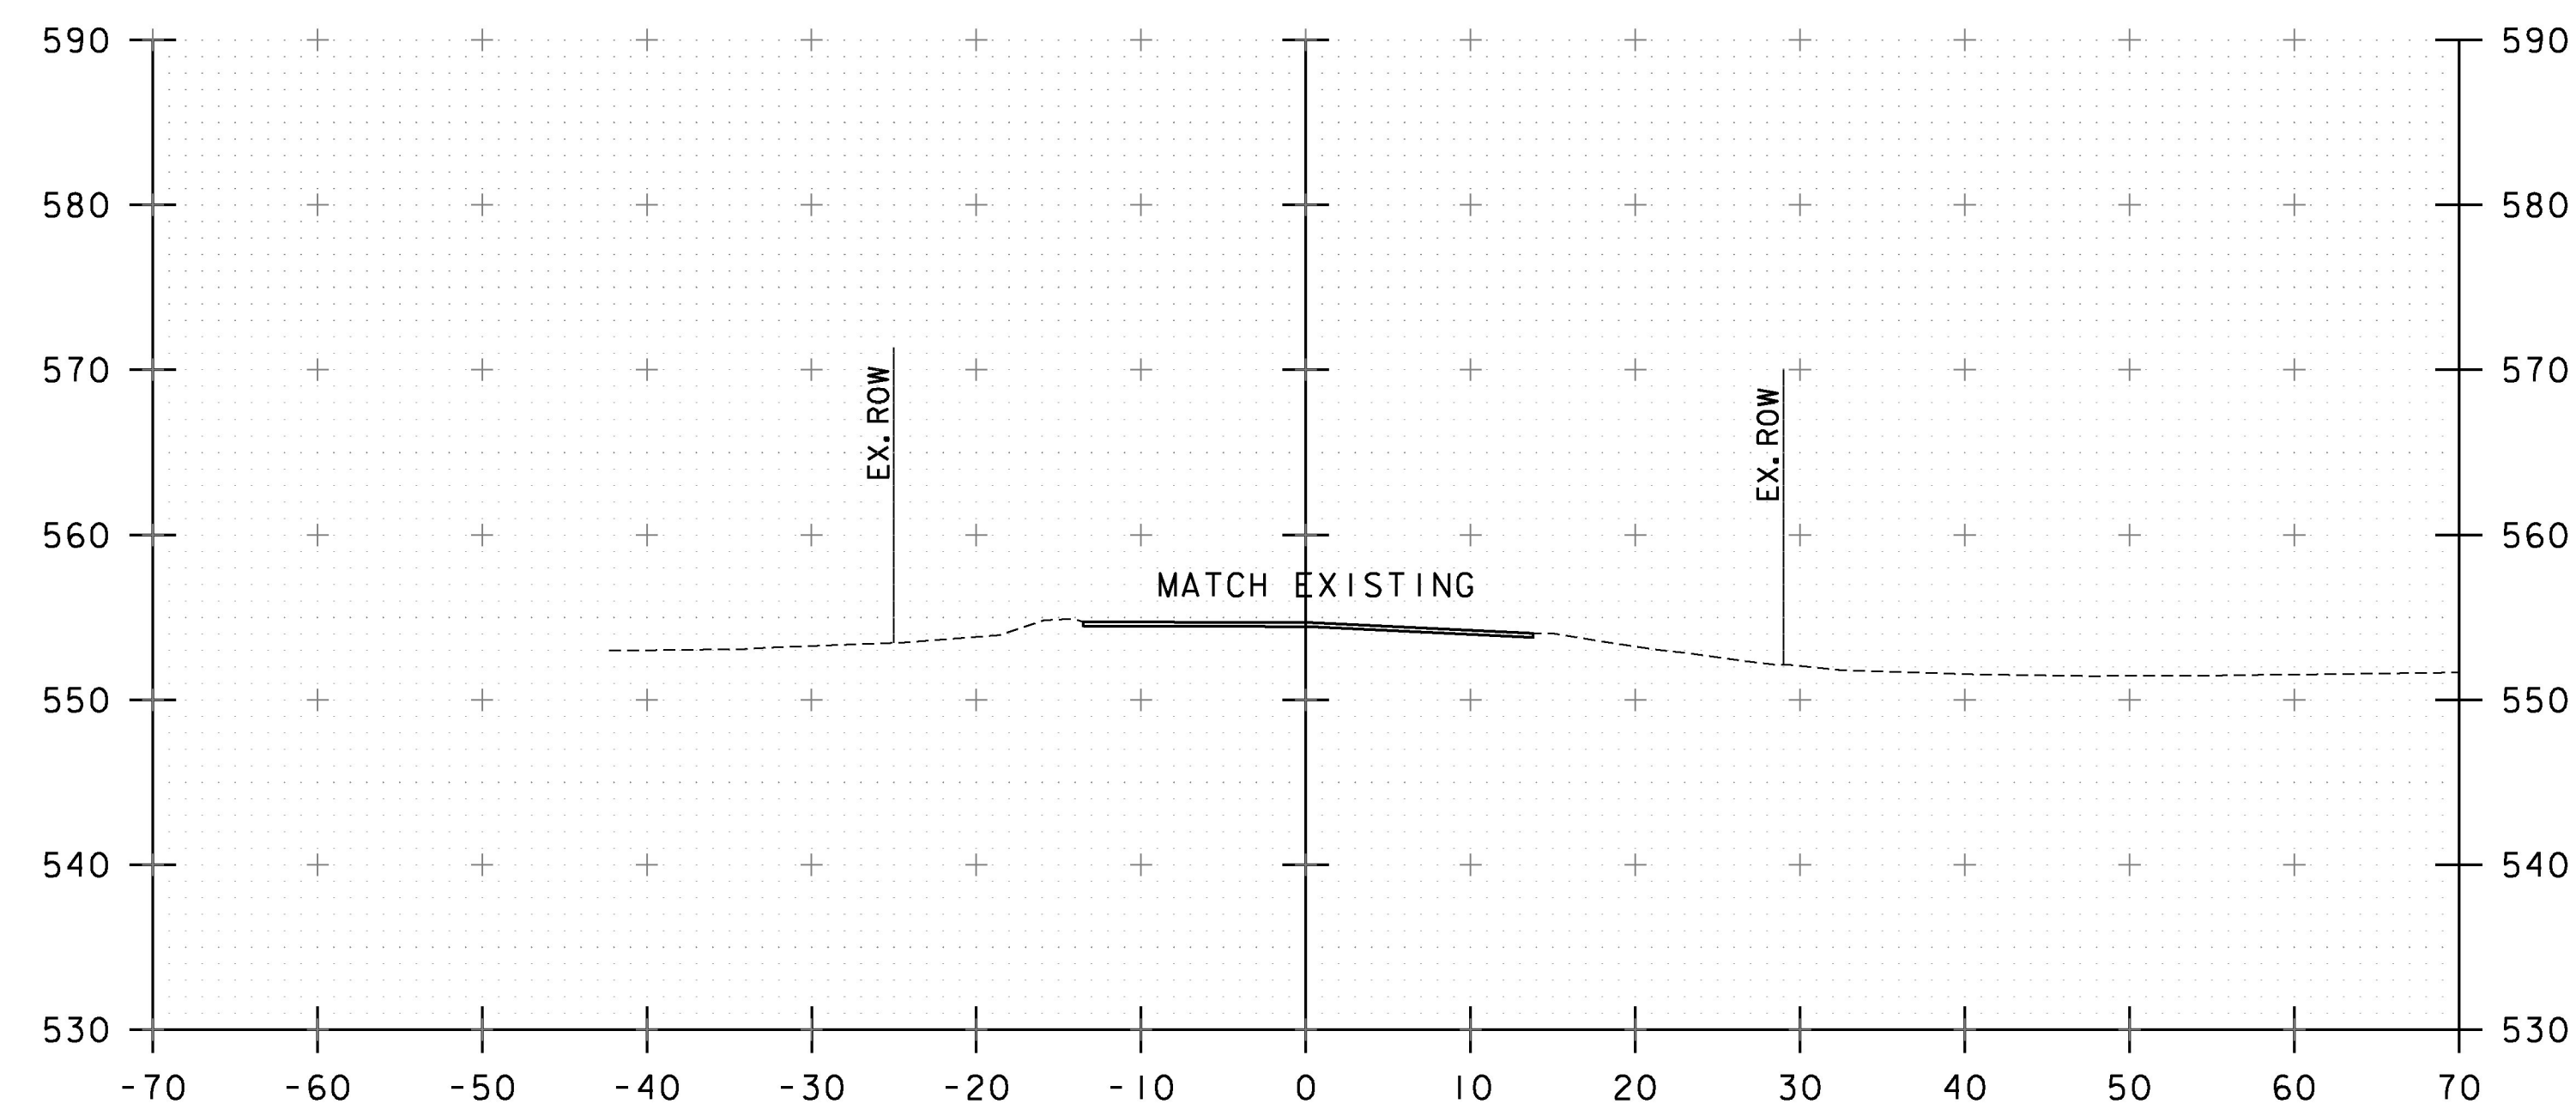

14+75
14+50
BEGIN APPROACH

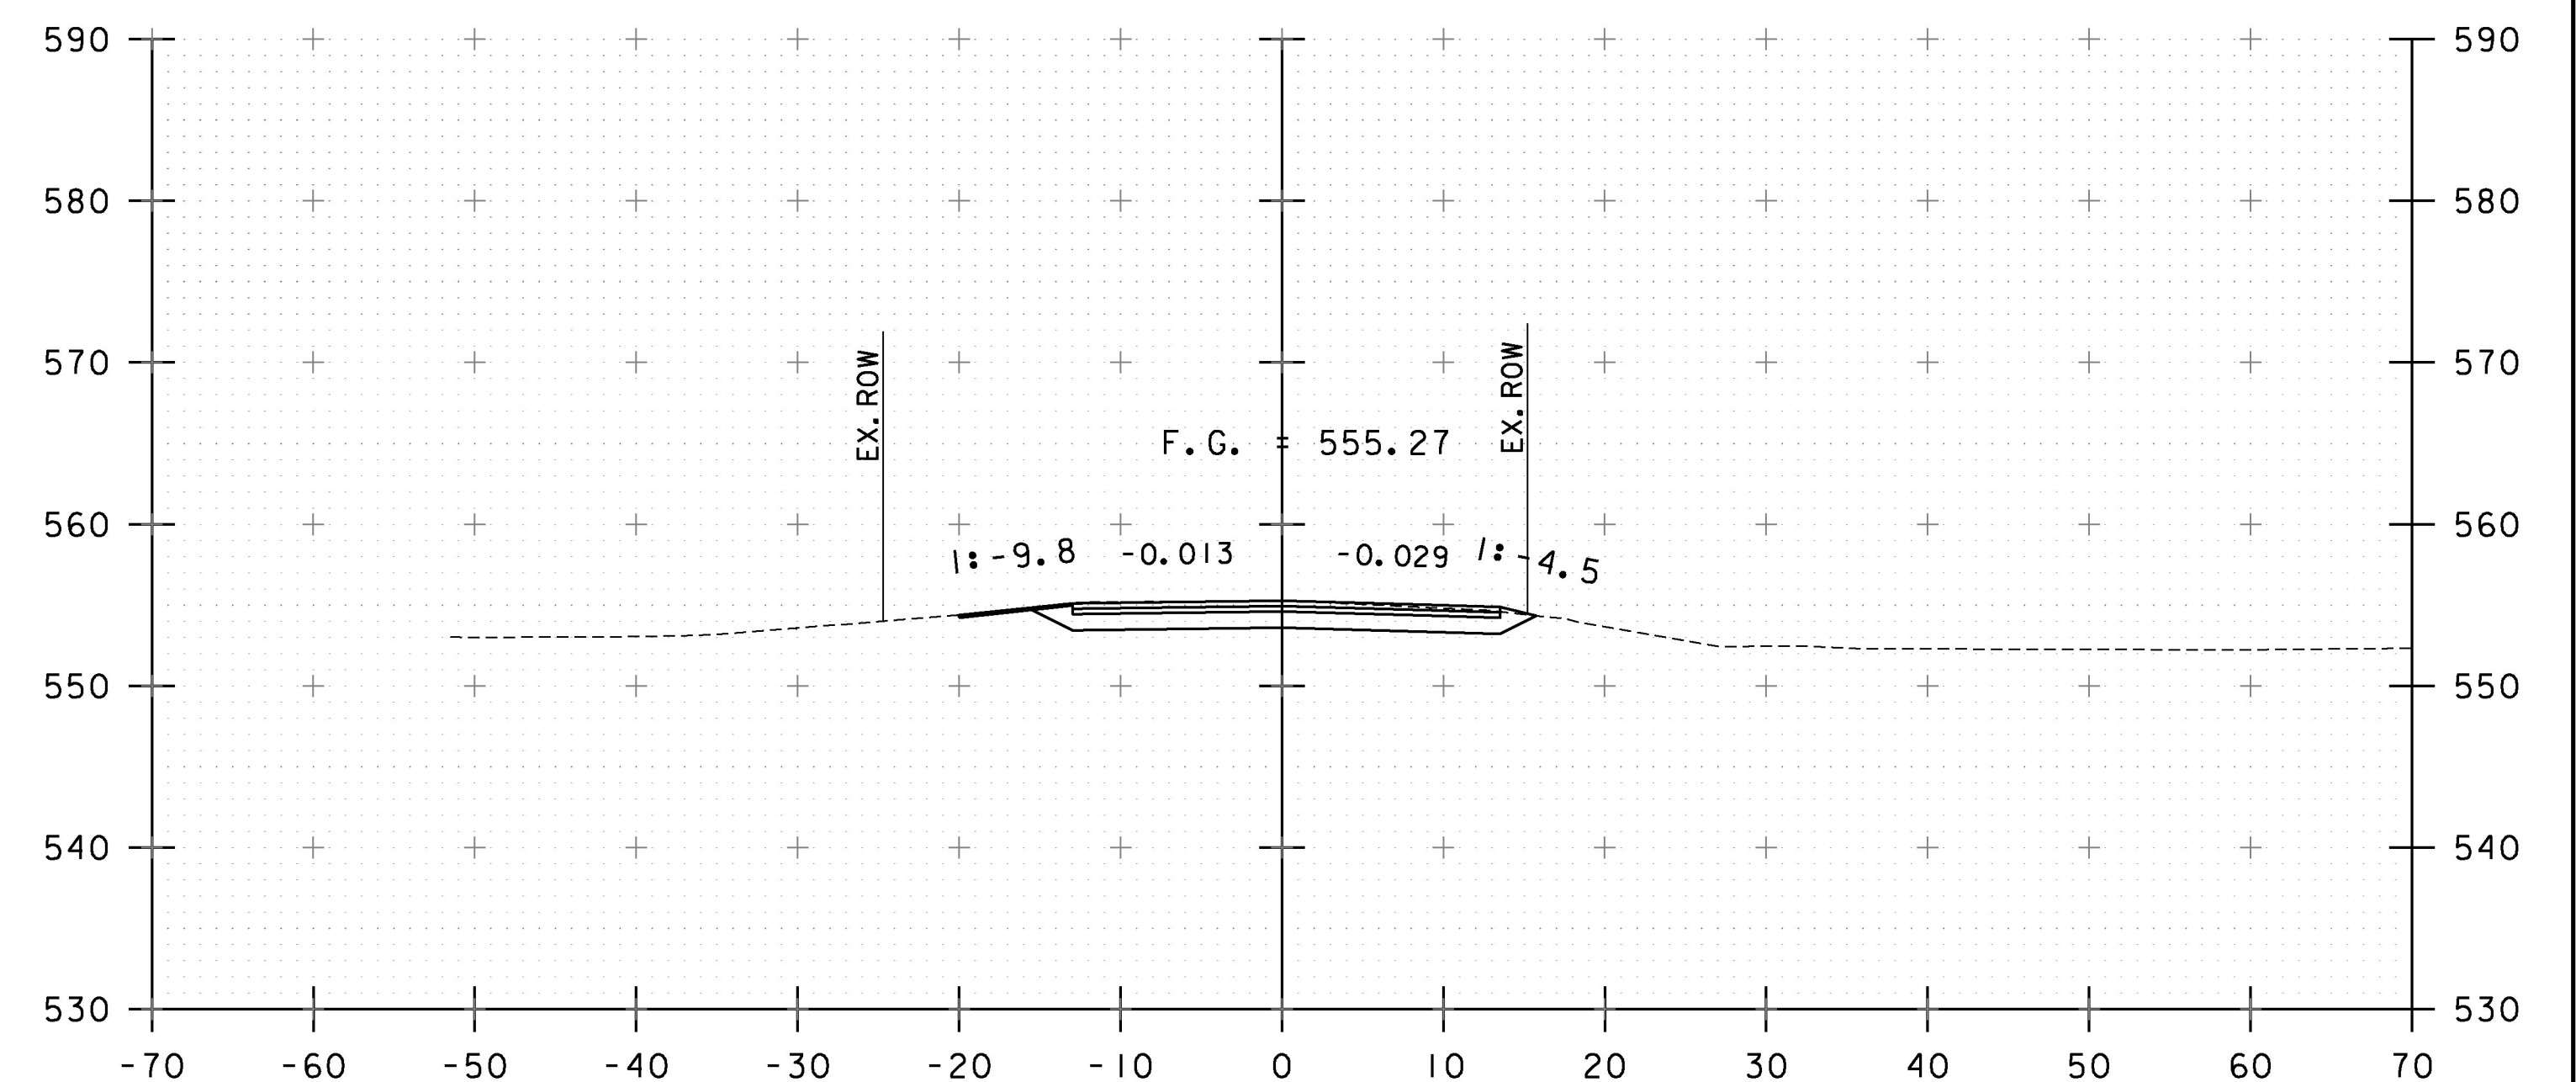

15+25

STA. 14+75 TO STA. 15+50

PROJECT NAME:	ST JOHNSBURY
PROJECT NUMBER:	BRO 1447(30)
FILE NAME:	z12j164xs.dgn
PROJECT LEADER:	M. CHENETTE
DESIGNED BY:	I. MAYNARD
ROADWAY CROSS SECTIONS - RXS 1	
PLOT DATE:	9/30/2016
DRAWN BY:	I. MAYNARD
CHECKED BY:	G. SANTY
SHEET	38 OF 76

