




17+00

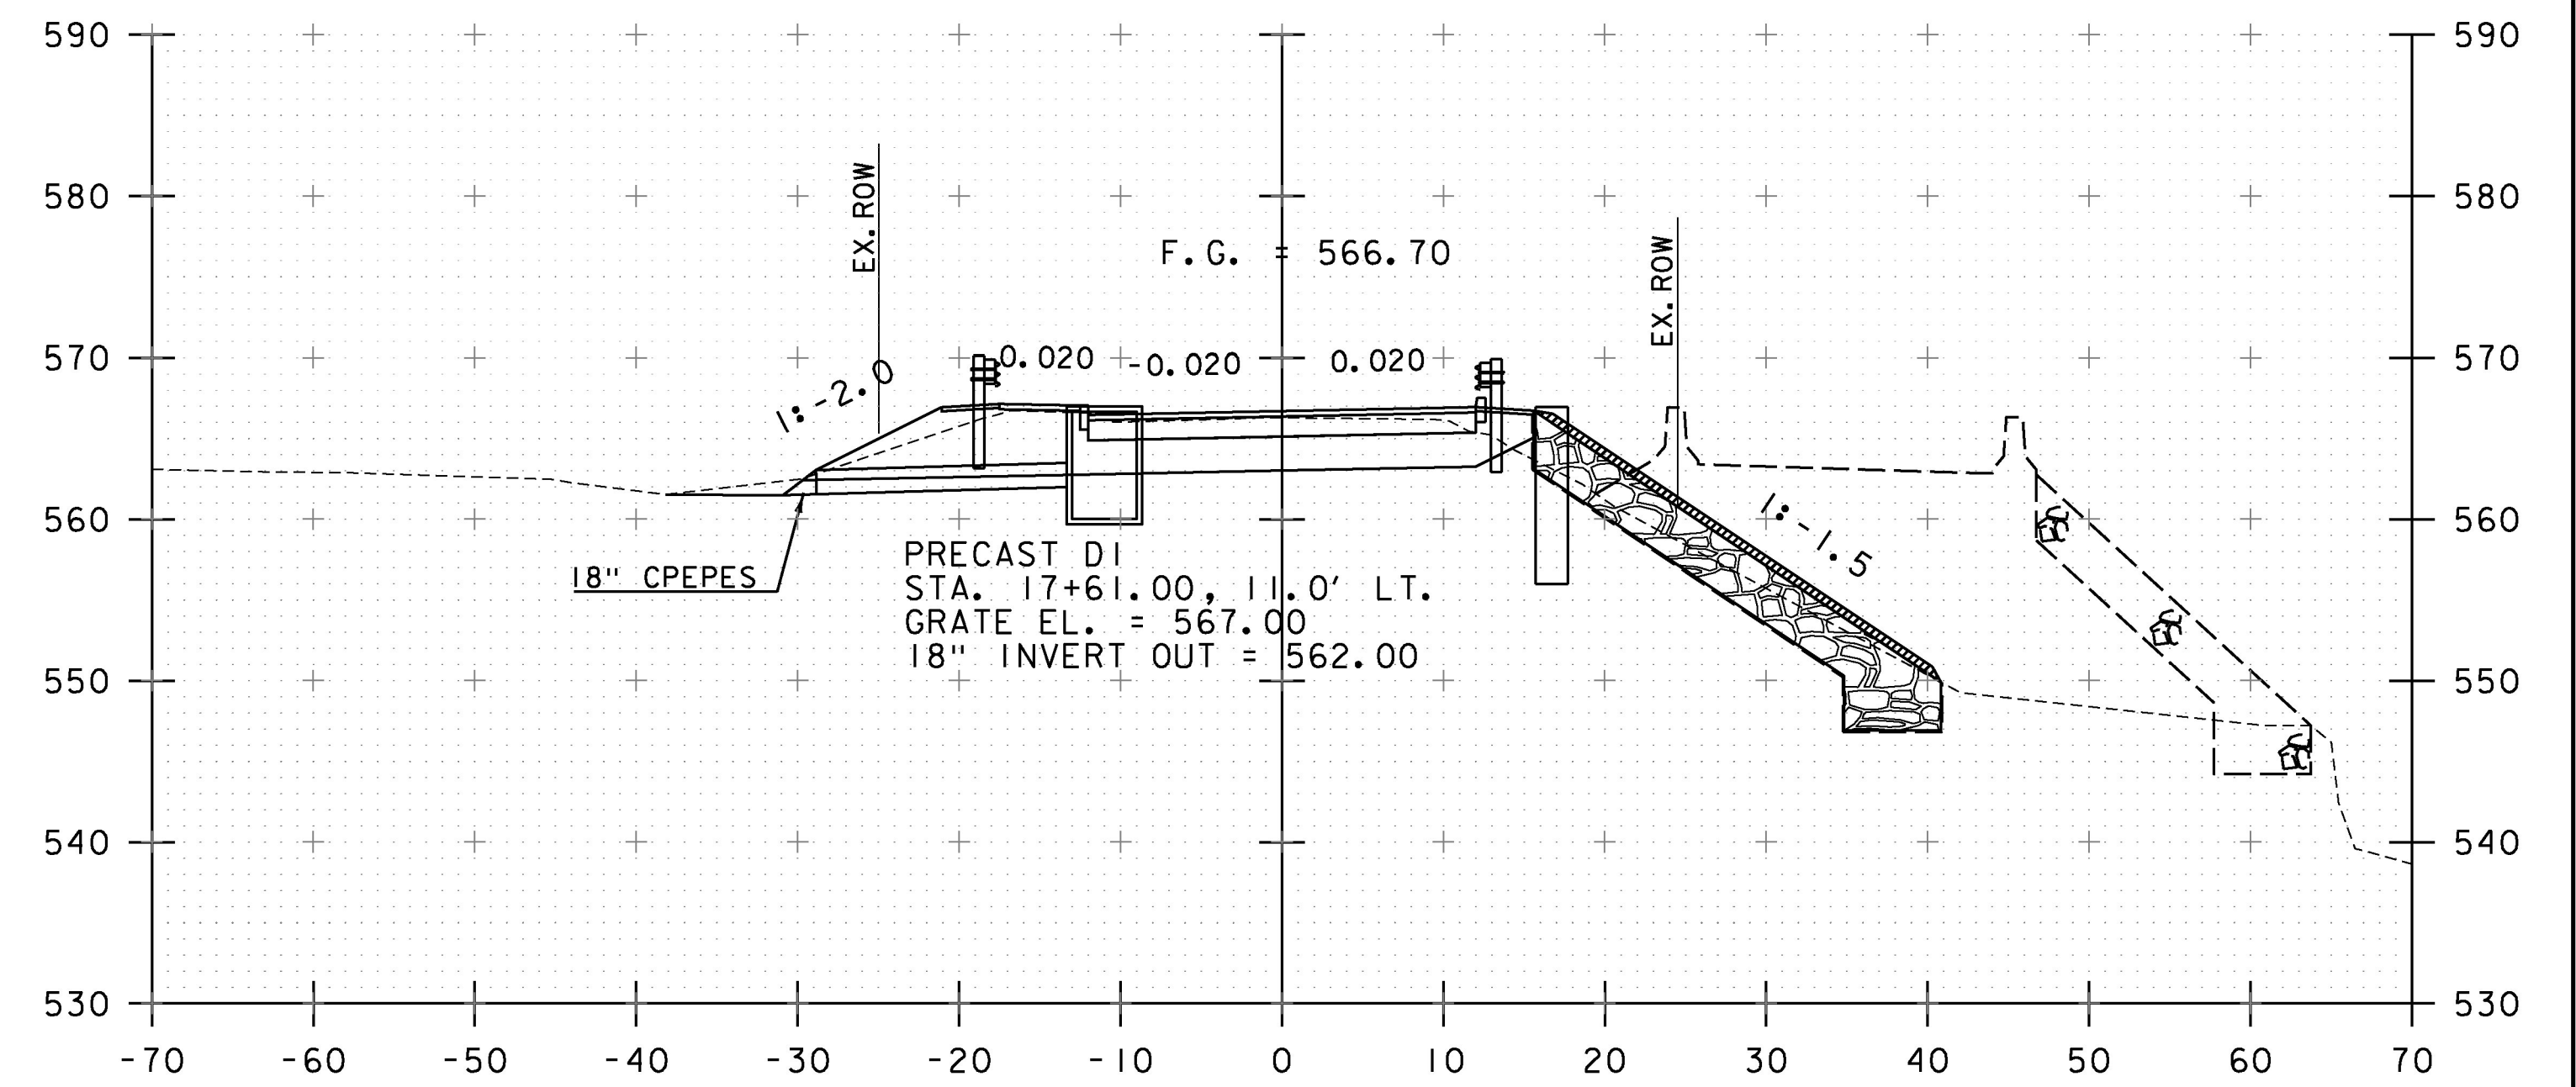

17+50

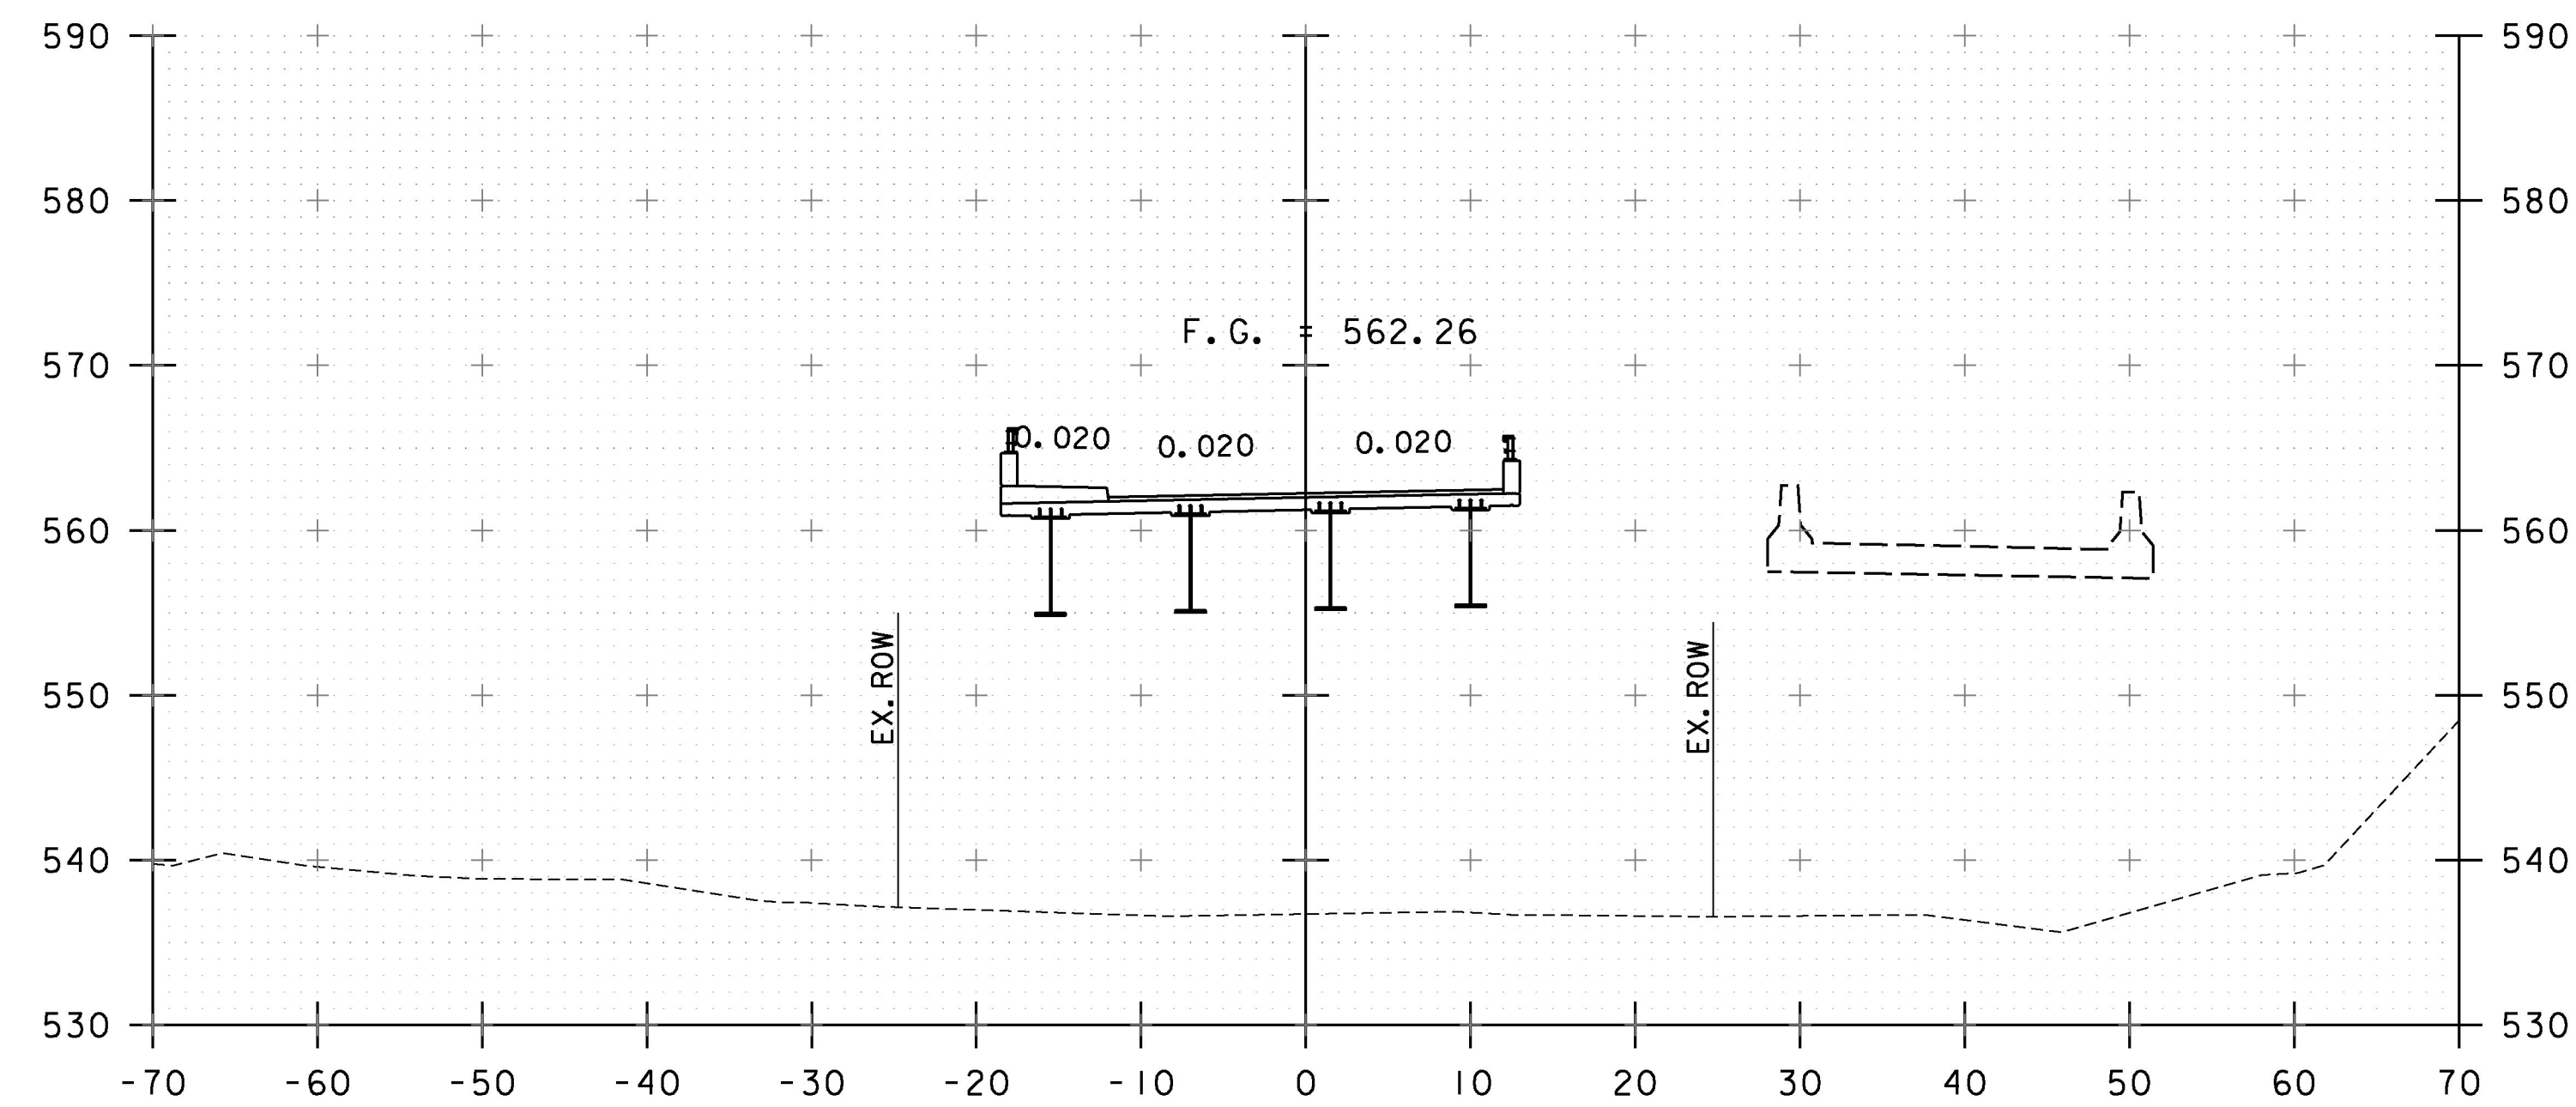


16+75

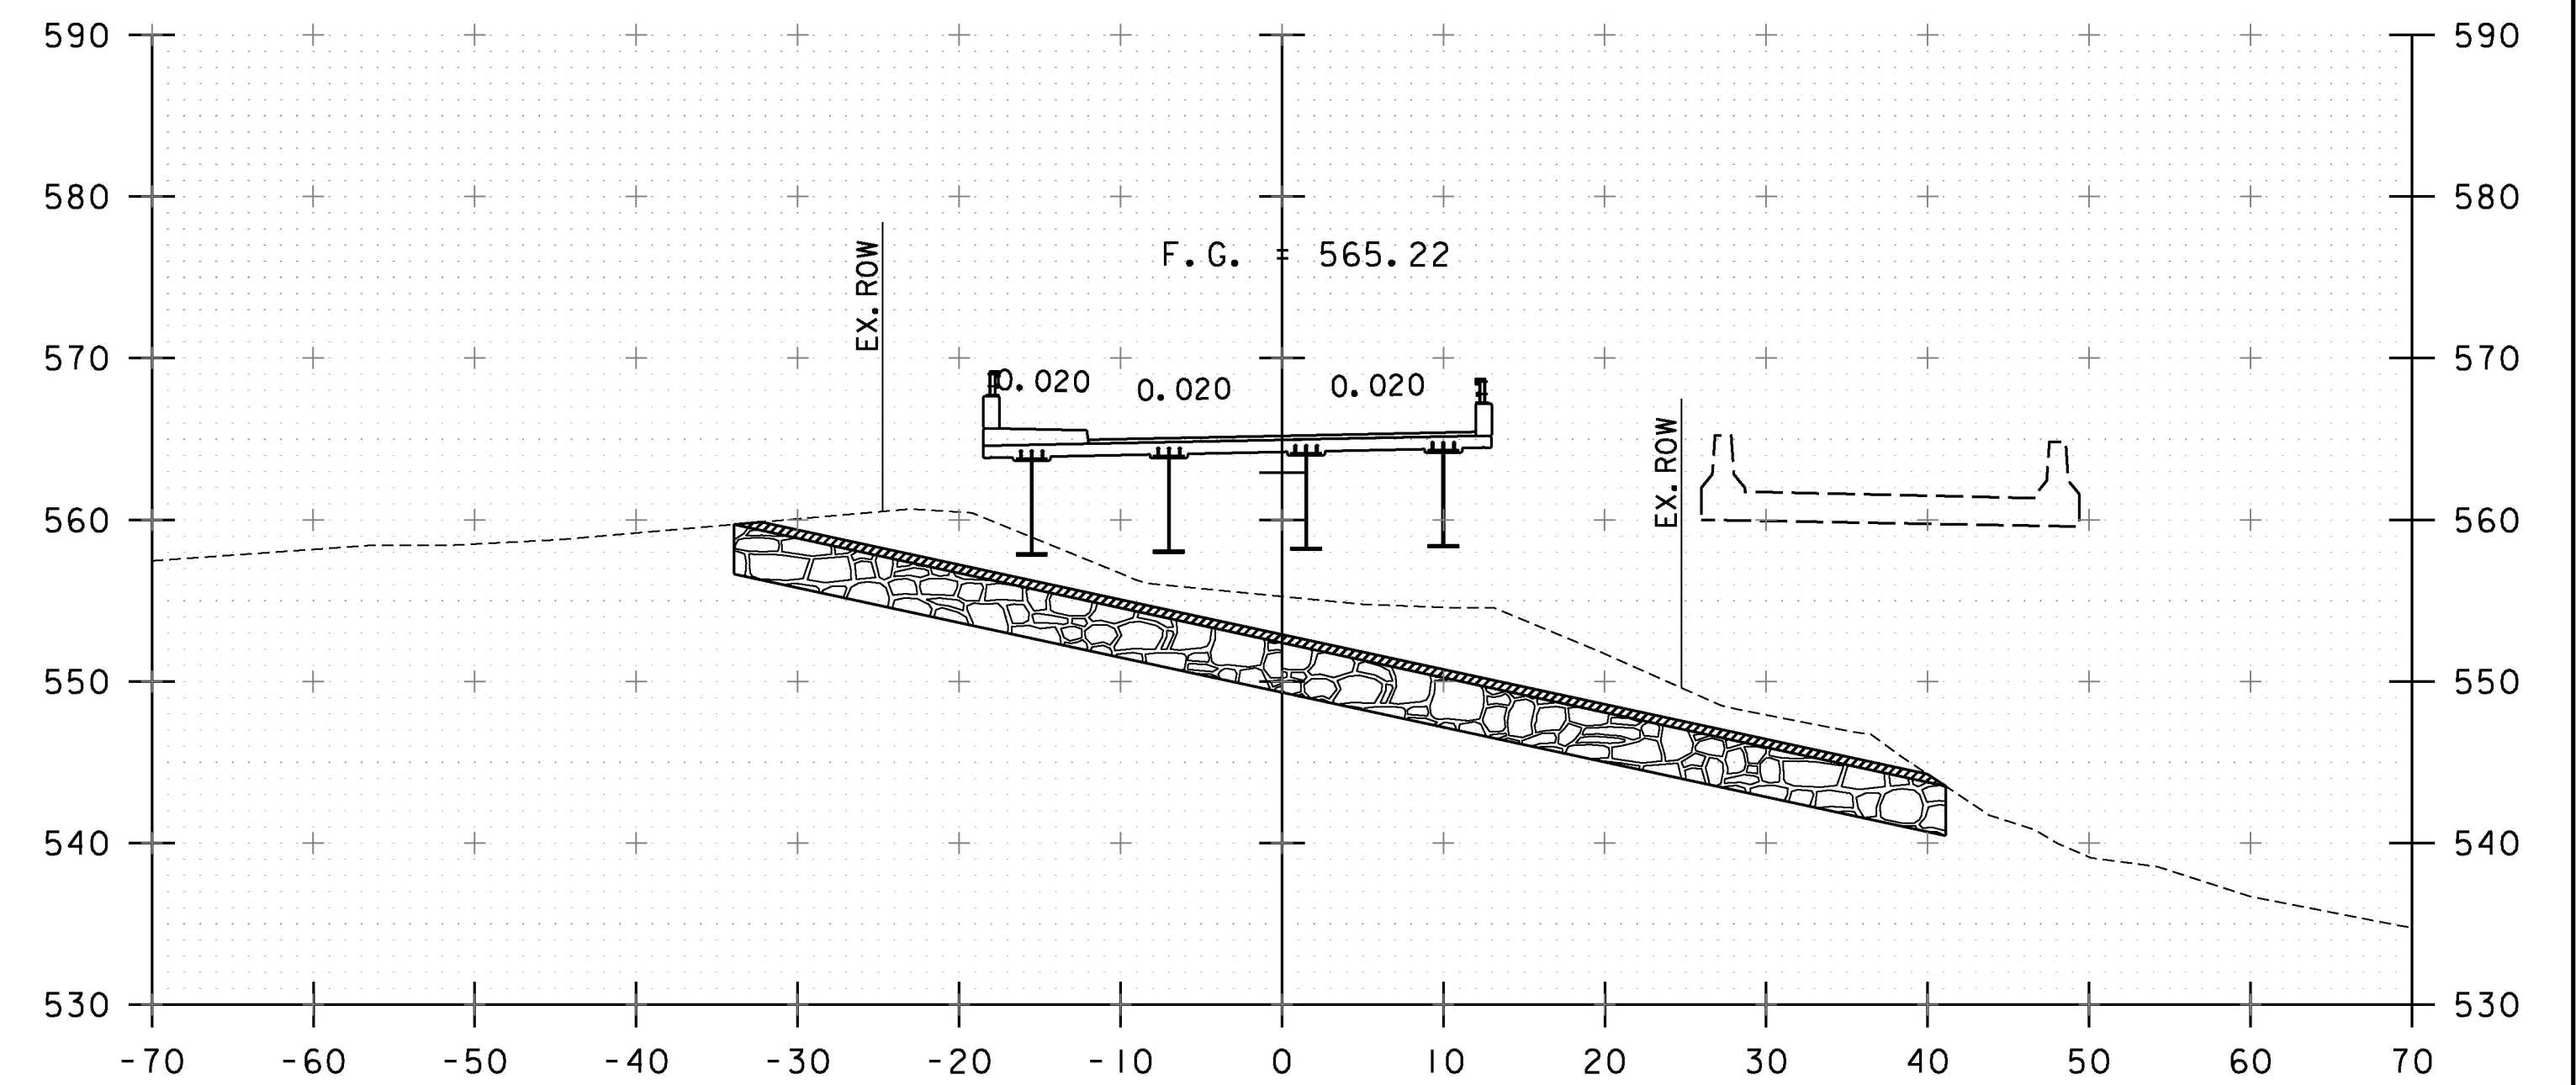

17+25
17+38.51
END BRIDGE

STA. 16+75 TO STA. 17+50

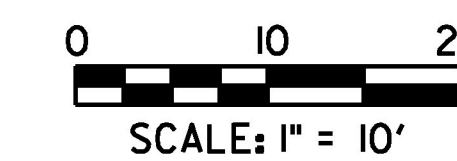

PROJECT NAME:	ST JOHNSBURY	PLOT DATE:	9/30/2016
PROJECT NUMBER:	BRO 1447(30)	DRAWN BY:	I. MAYNARD
FILE NAME:	z12j164xs.dgn	DESIGNED BY:	I. MAYNARD
PROJECT LEADER:	M. CHENETTE	CHECKED BY:	G. SANTY
ROADWAY CROSS SECTIONS - RXS 3			SHEET 40 OF 76