




18+75  
END APPROACH

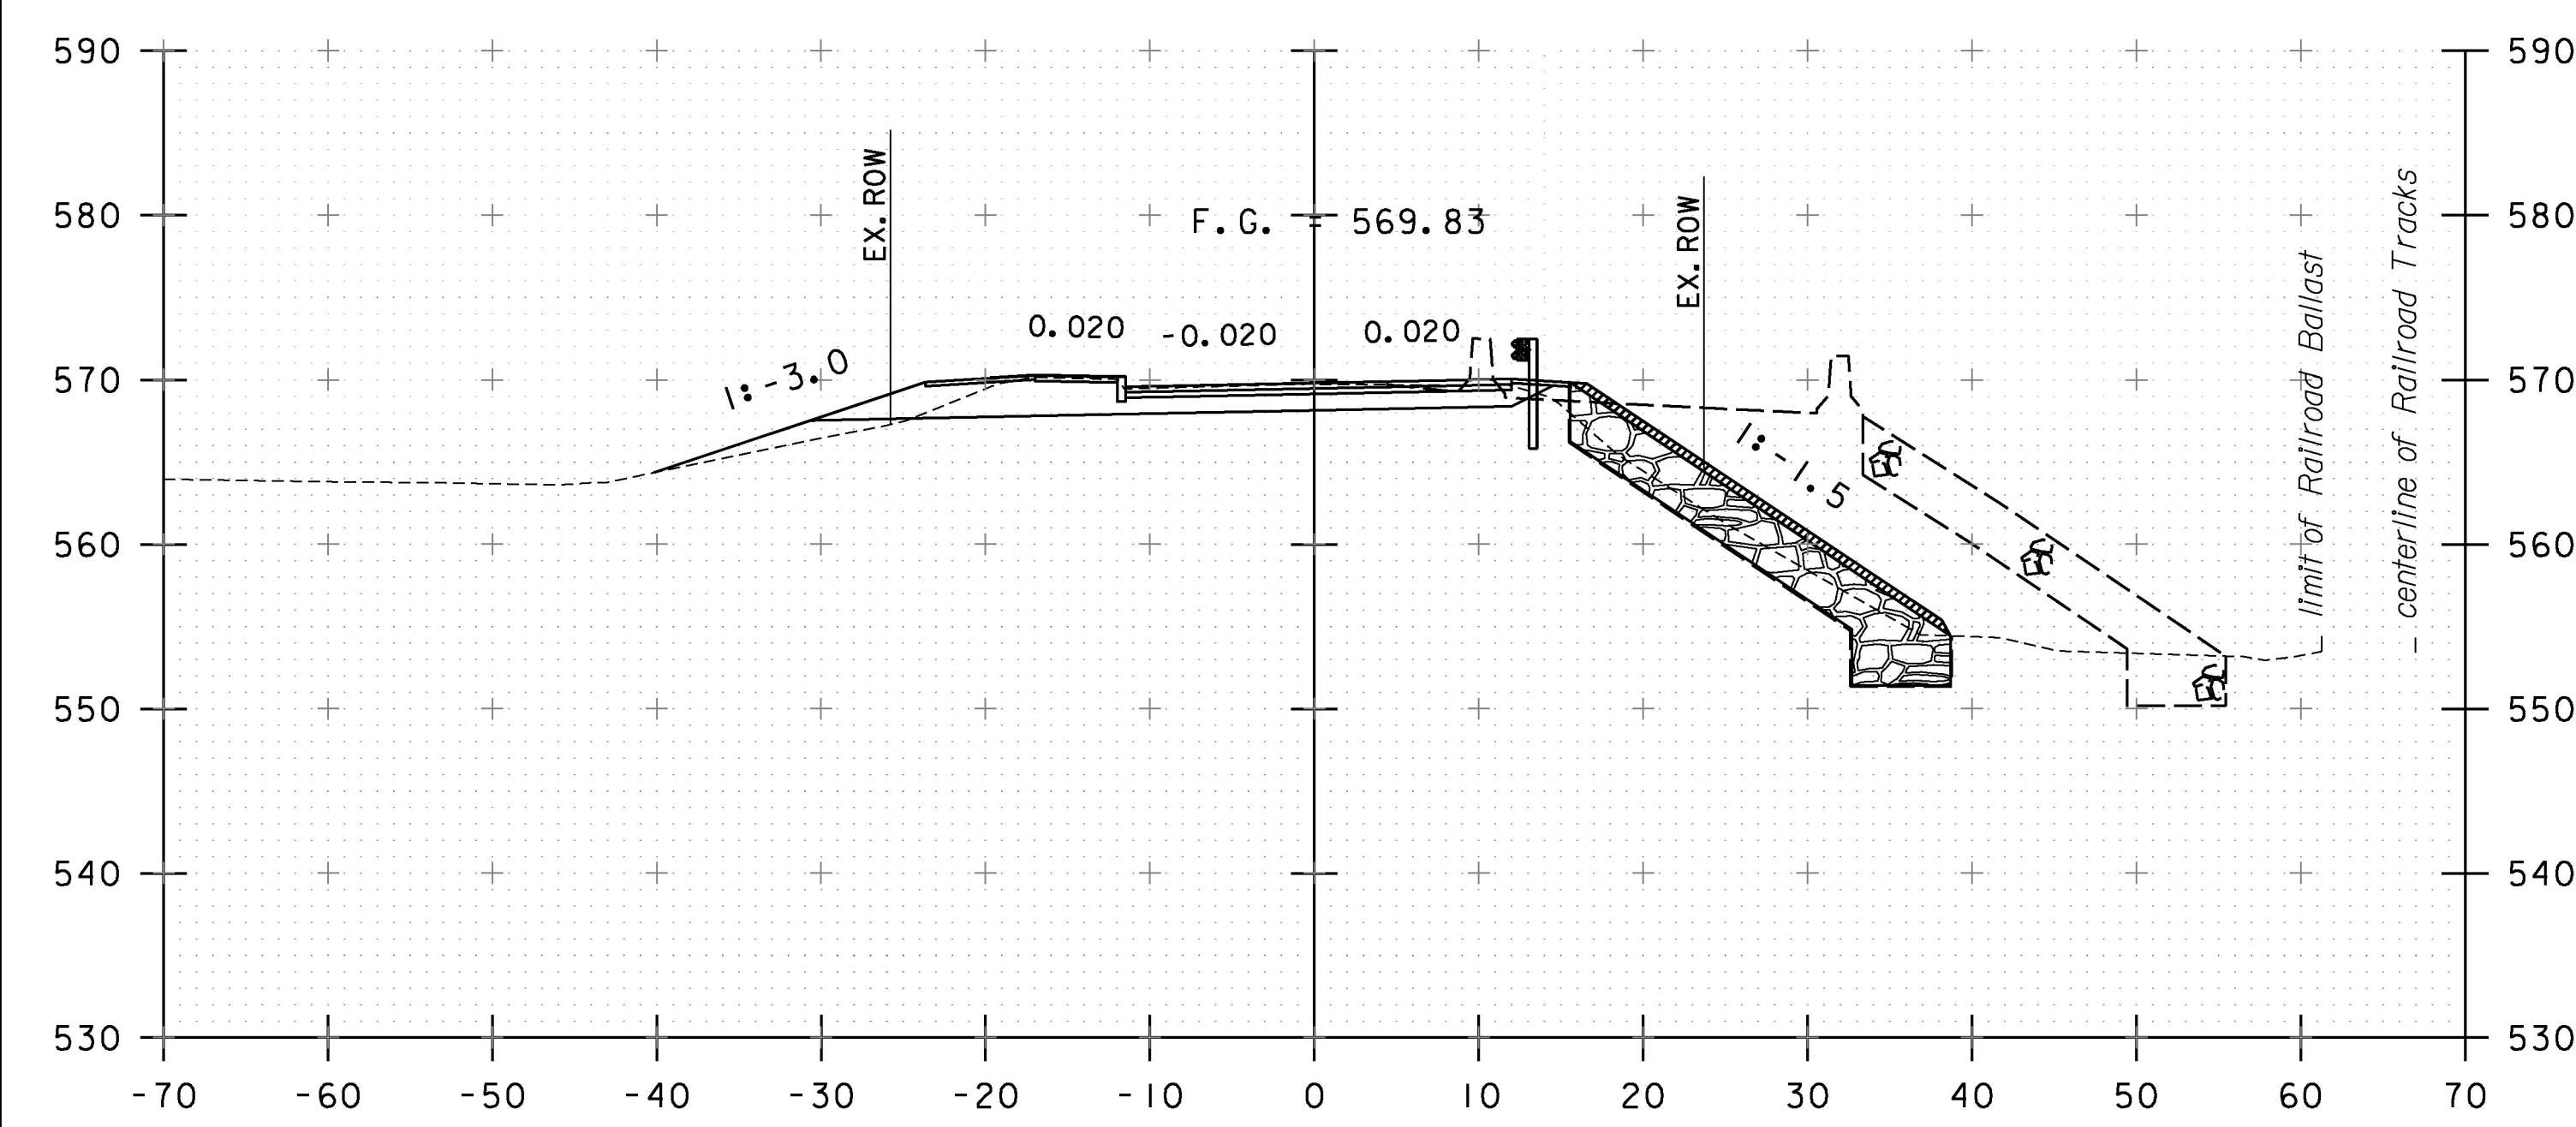


18+00

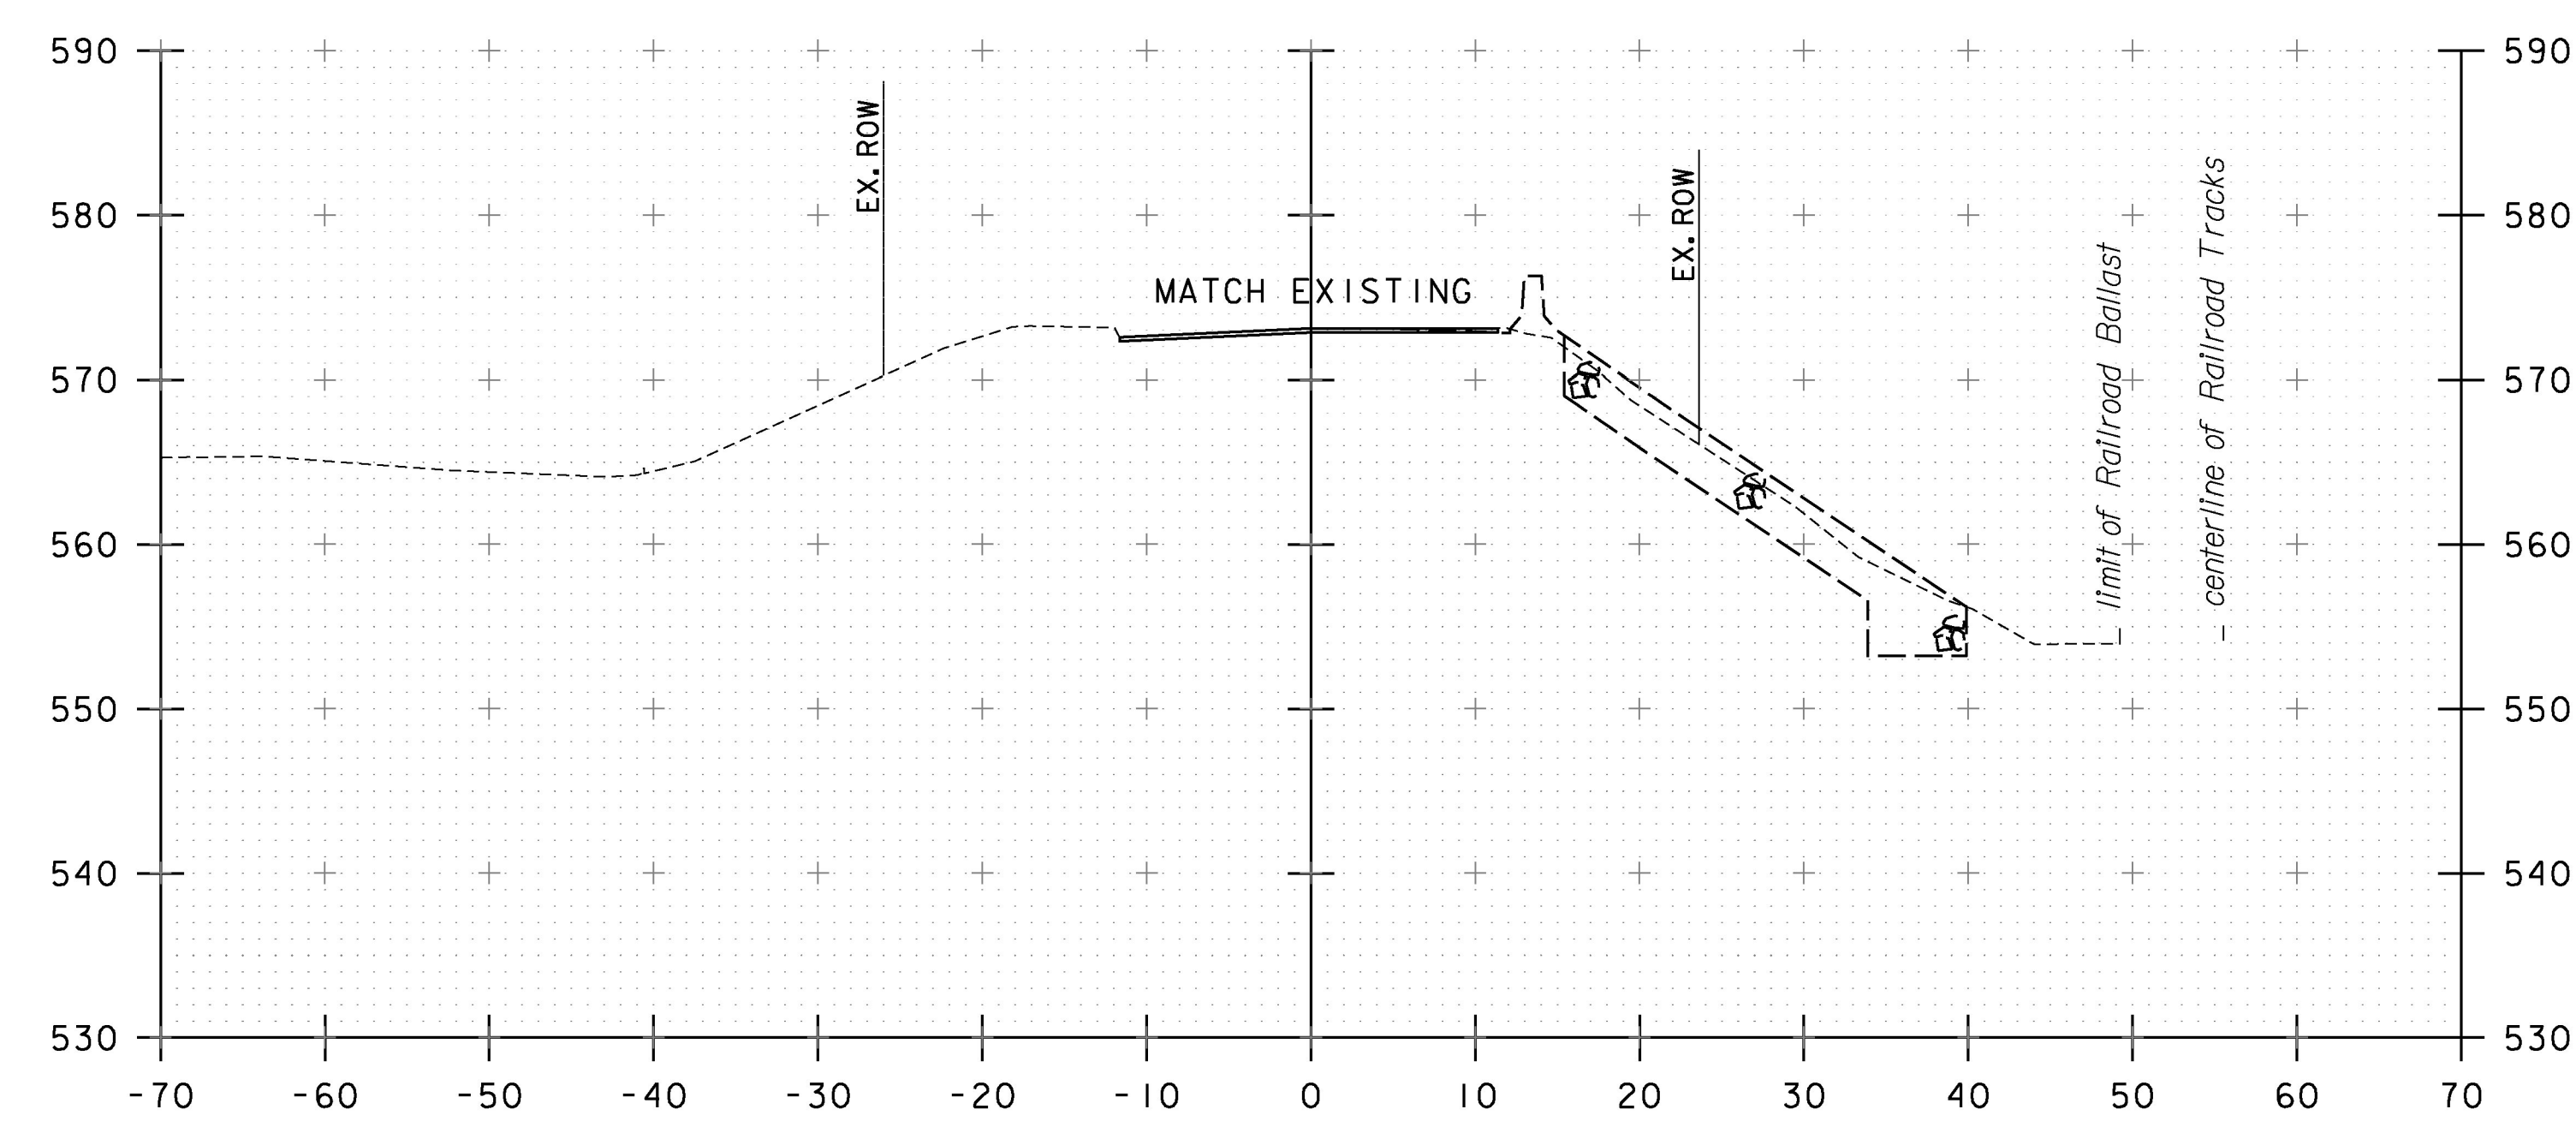

18+50

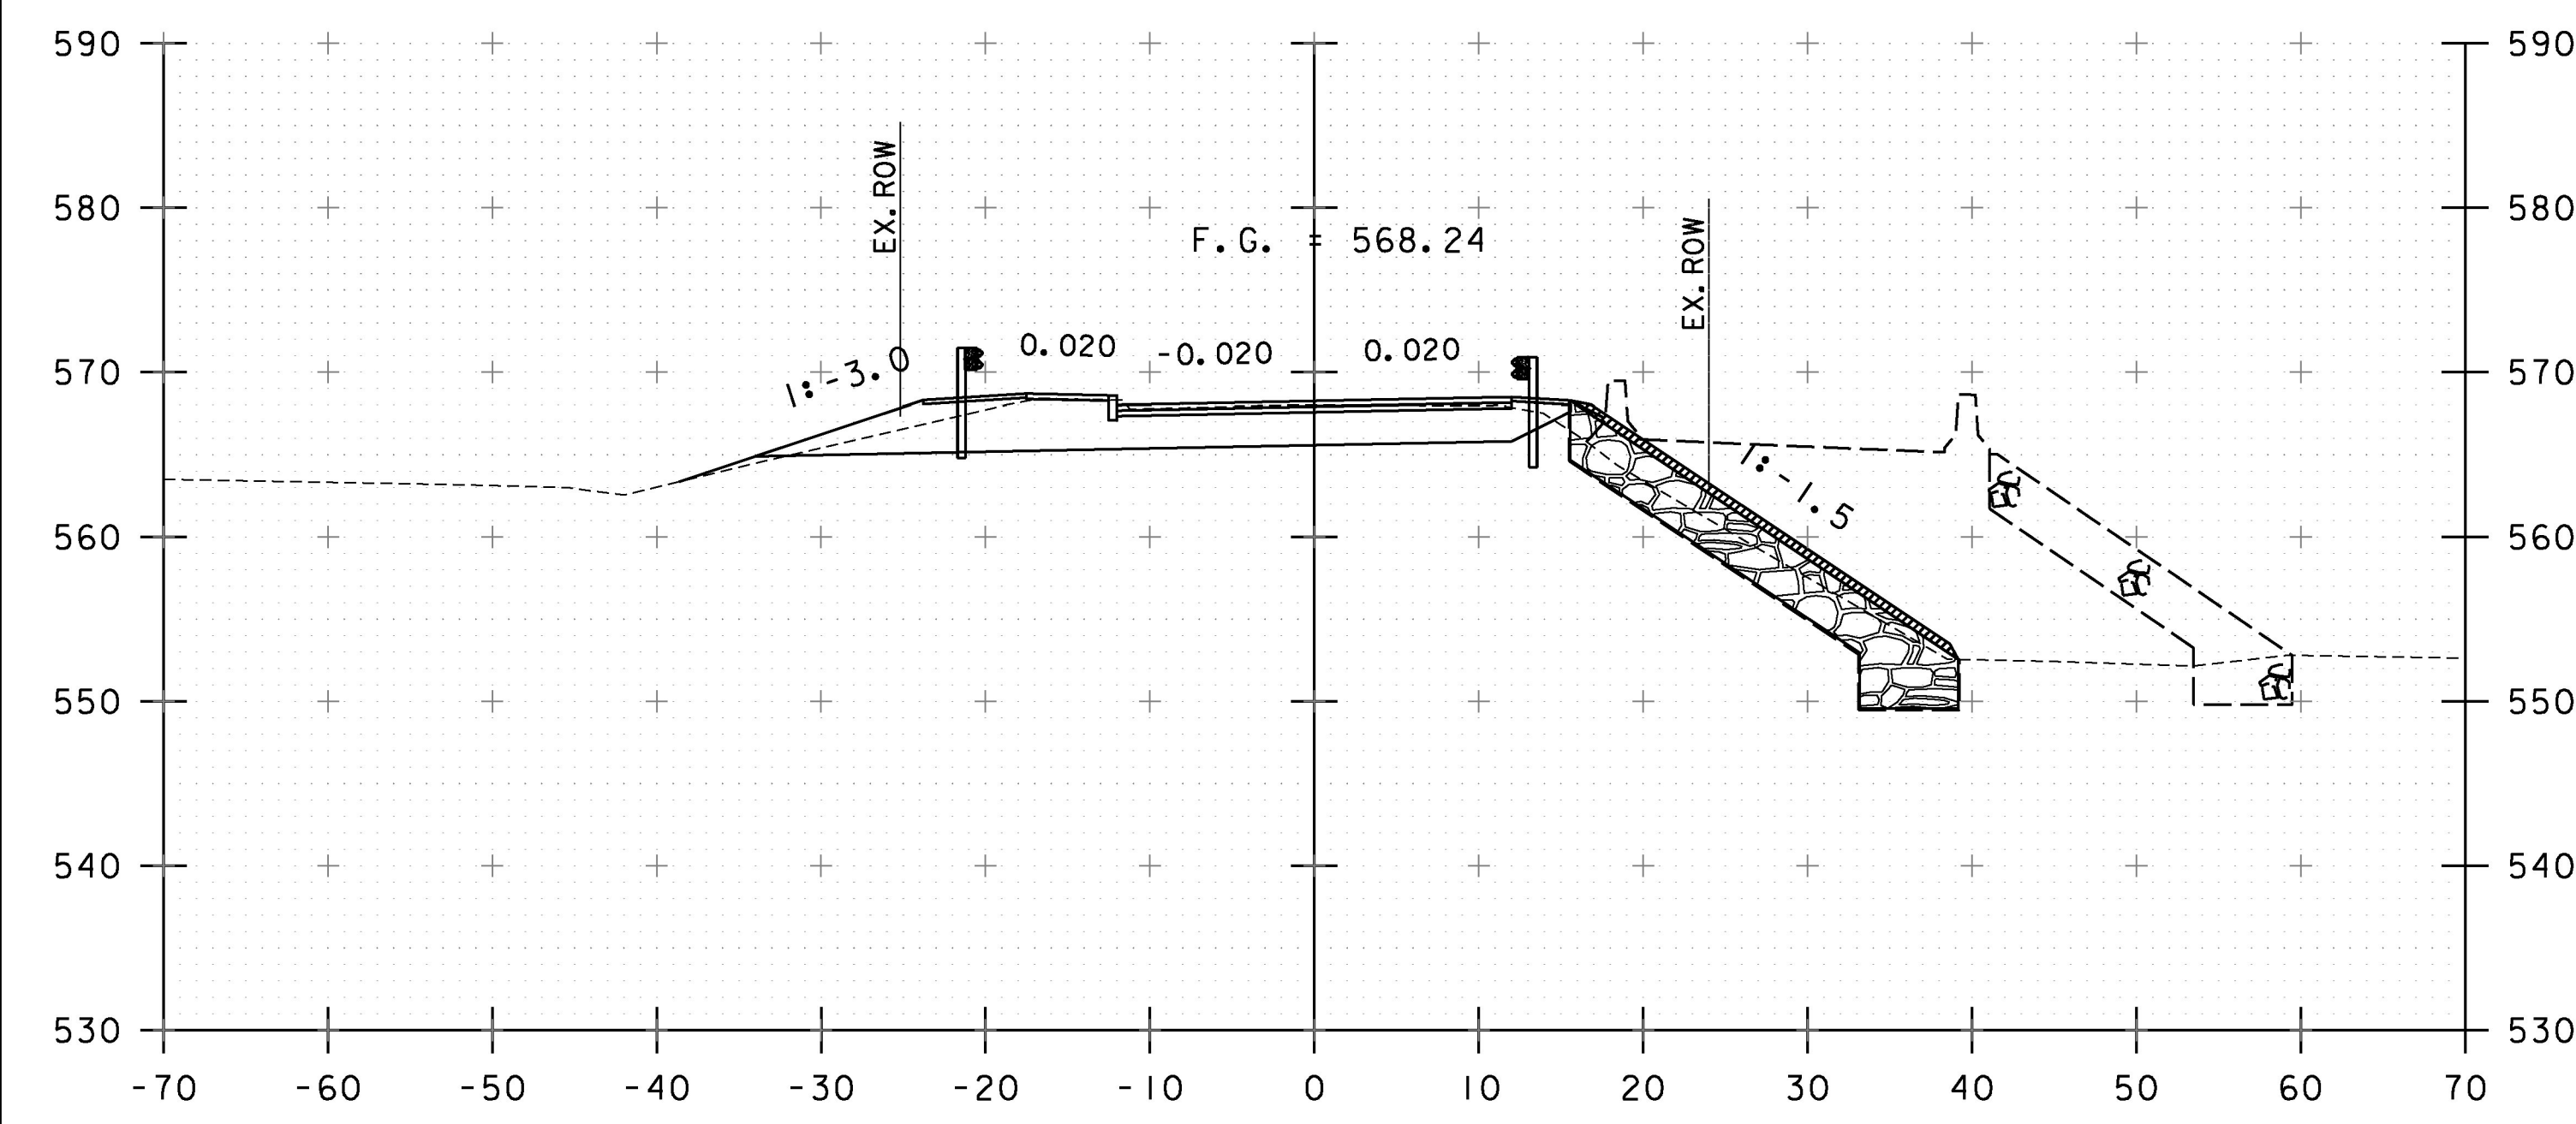

17+75  
END PROJECT

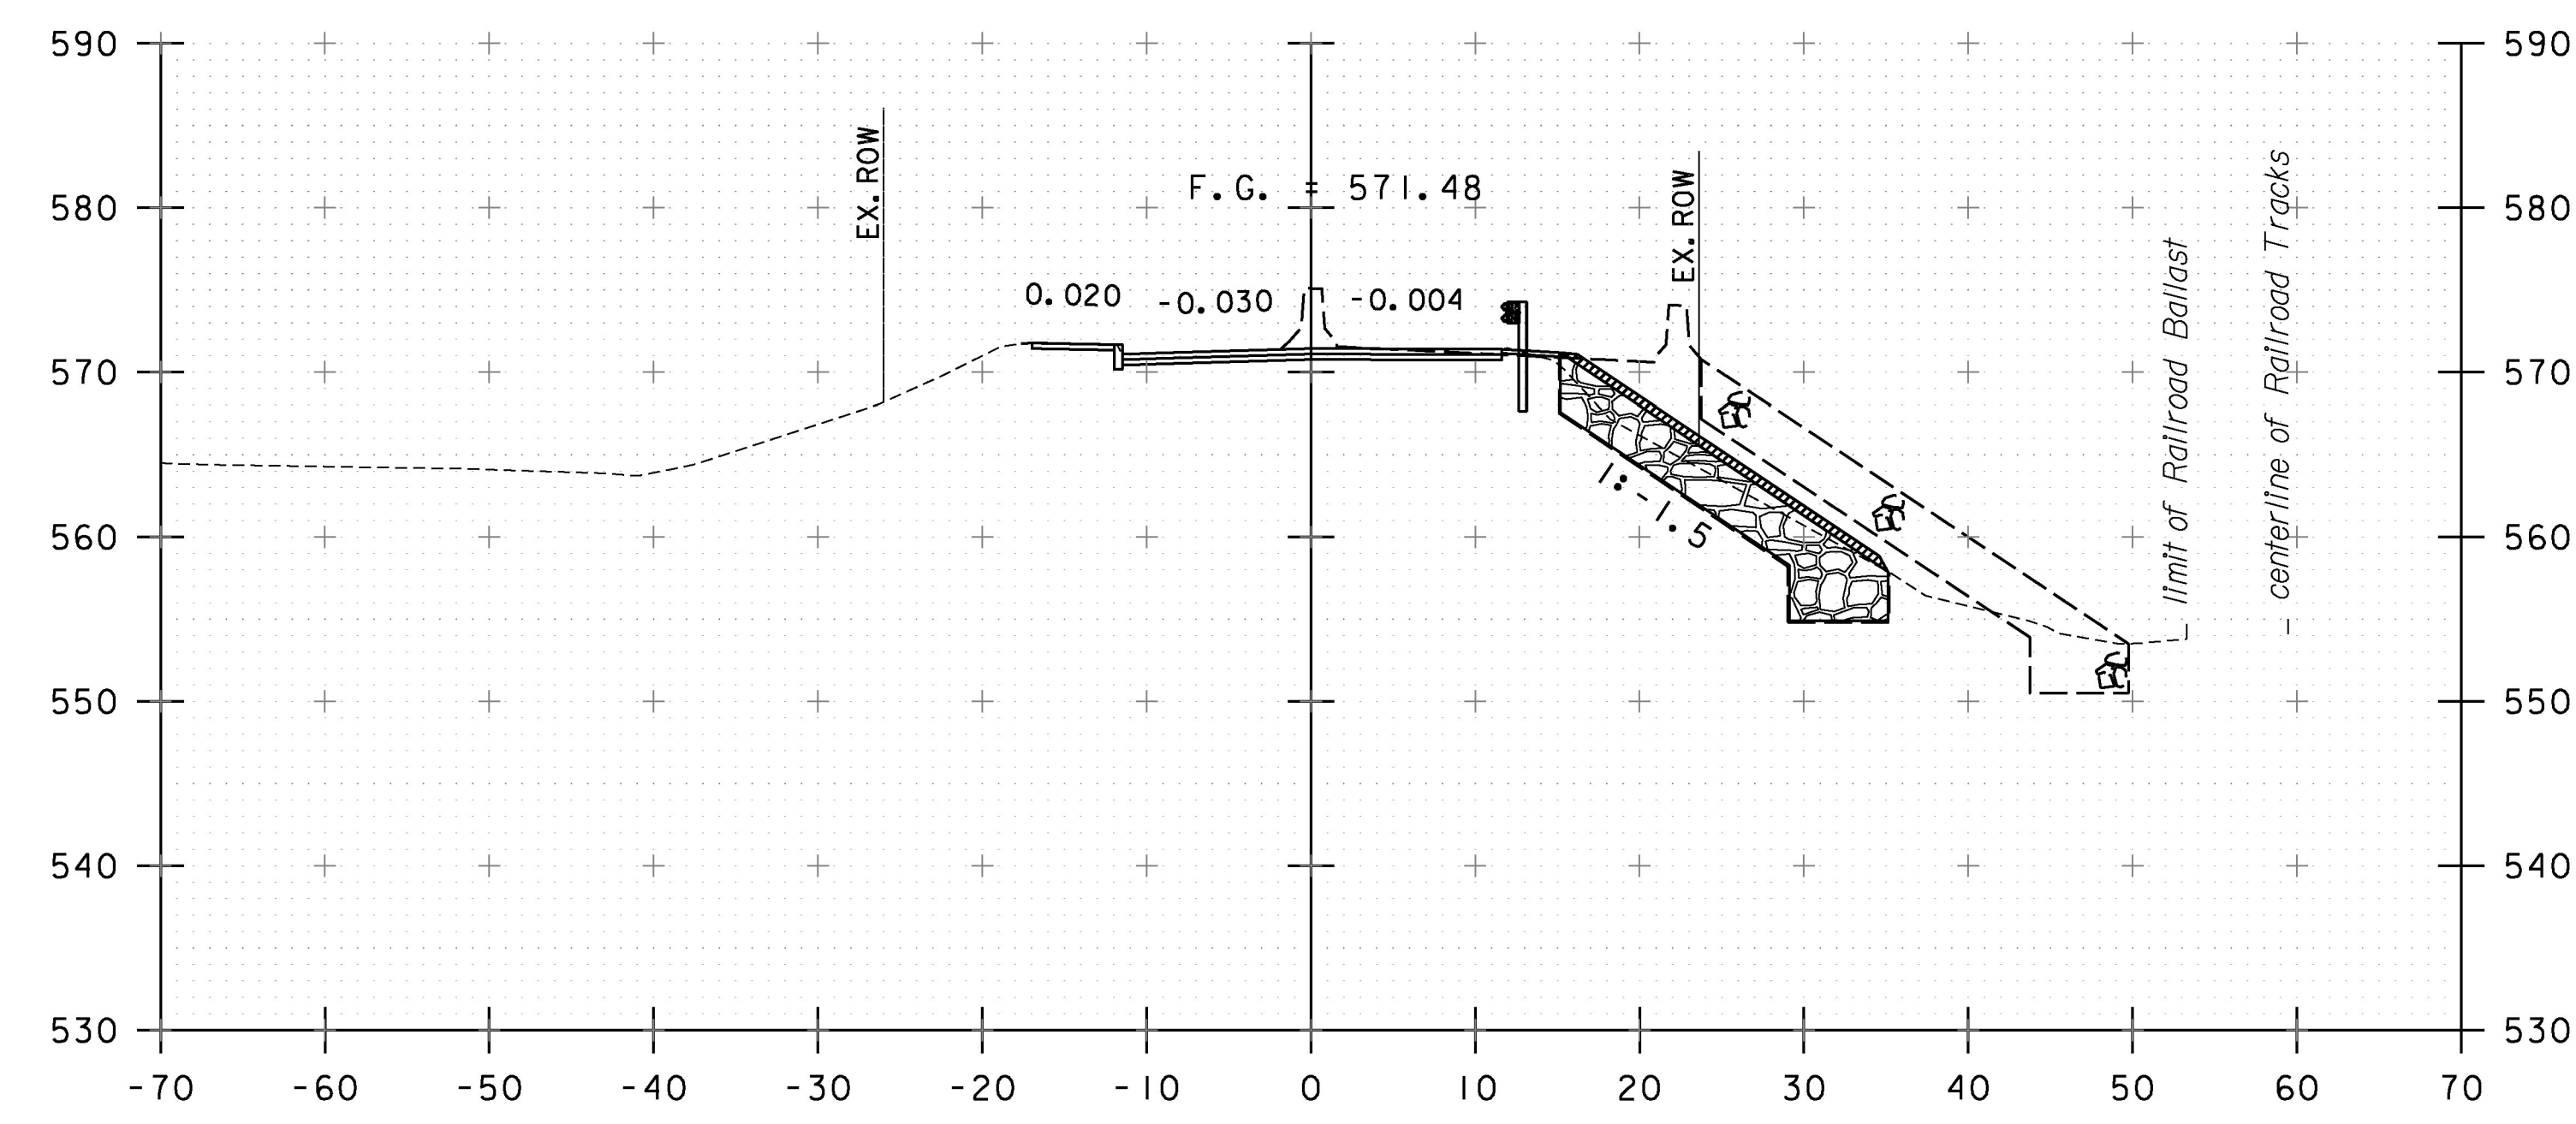

18+25

STA. 17+75 TO STA. 18+50

PROJECT NAME:	ST JOHNSBURY
PROJECT NUMBER:	BRO 1447(30)
FILE NAME:	z12j164xs.dgn
PROJECT LEADER:	M. CHENETTE
DESIGNED BY:	I. MAYNARD
ROADWAY CROSS SECTIONS - RXS 4	
PLOT DATE:	9/30/2016
DRAWN BY:	I. MAYNARD
CHECKED BY:	G. SANTY
SHEET	41 OF 76

