




50+25

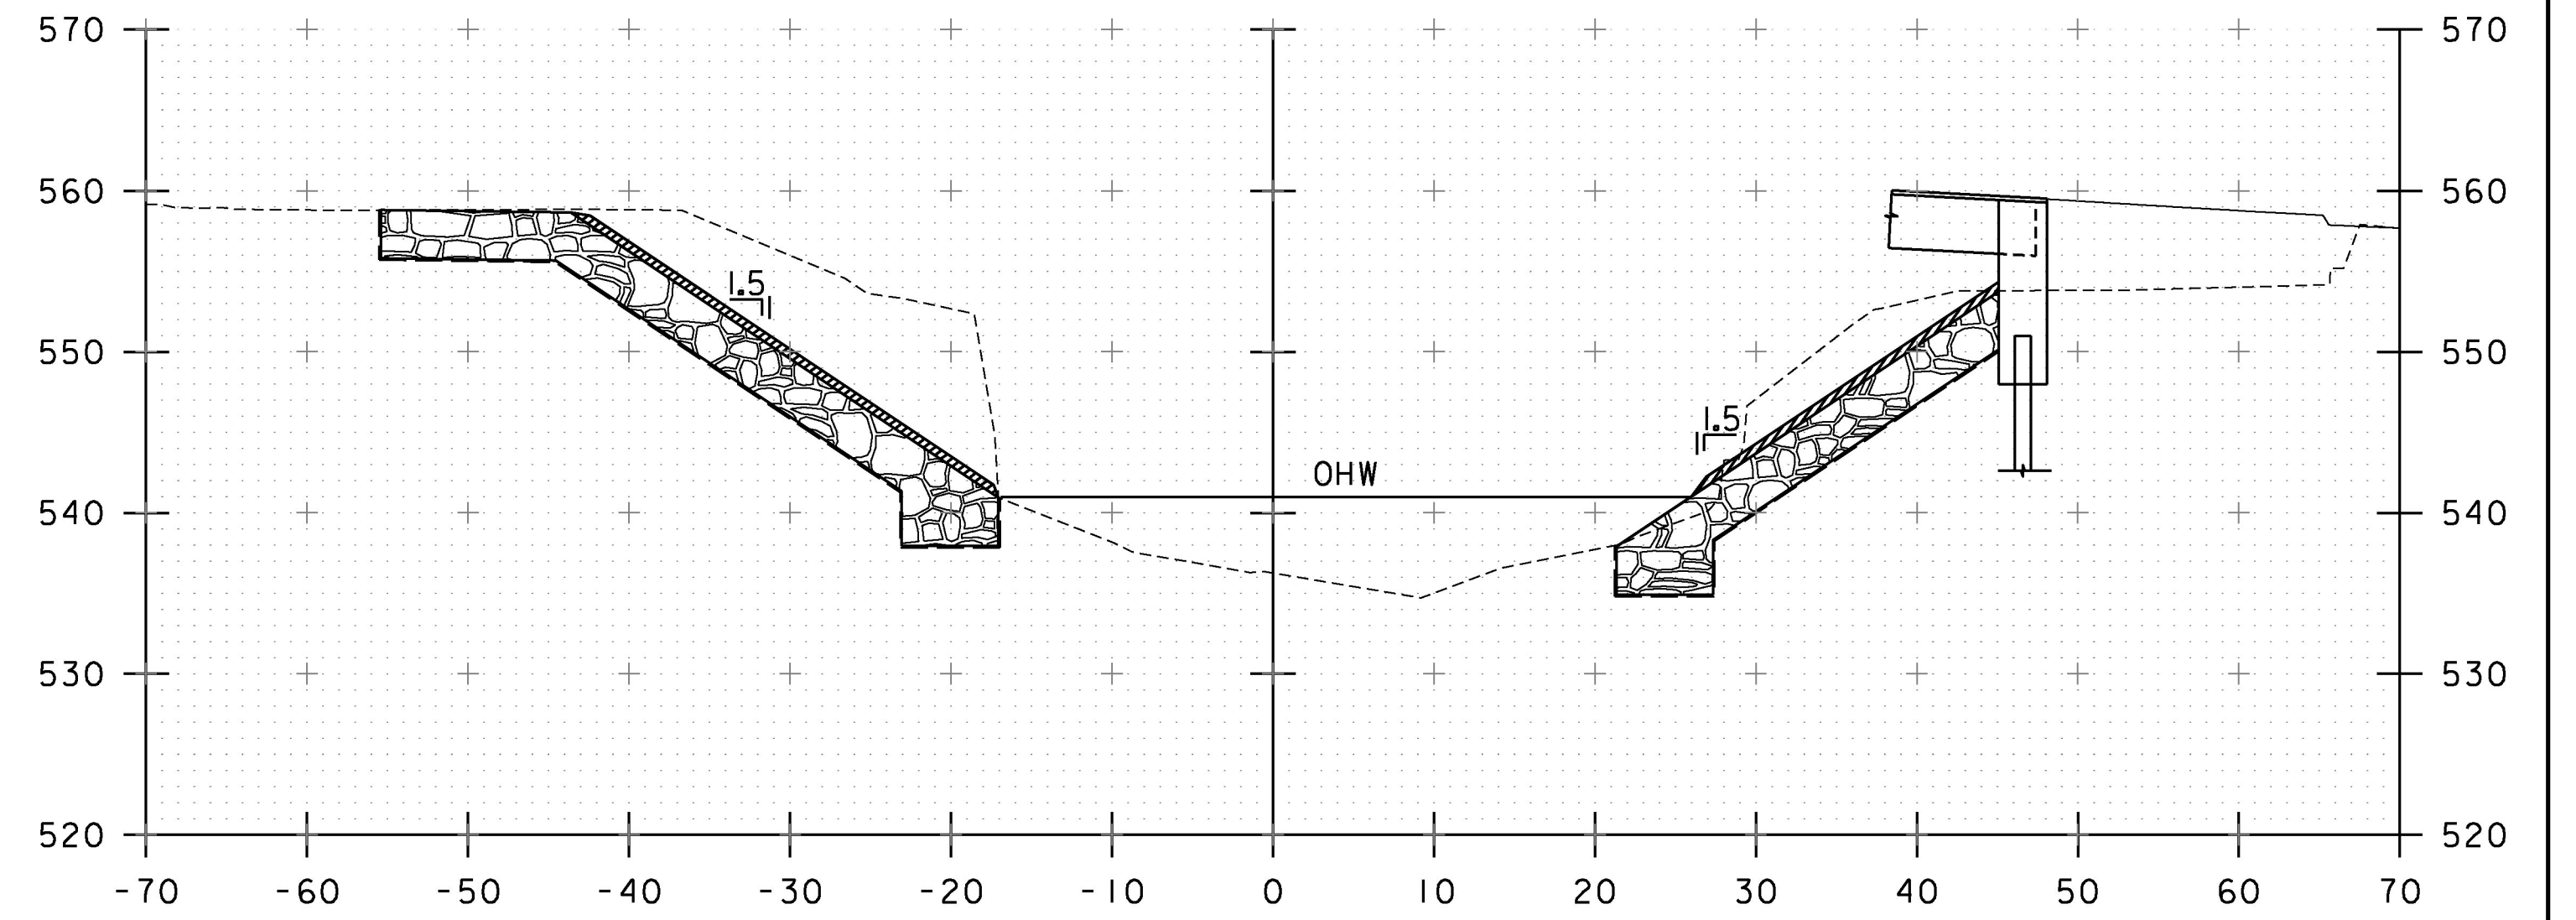

50+70

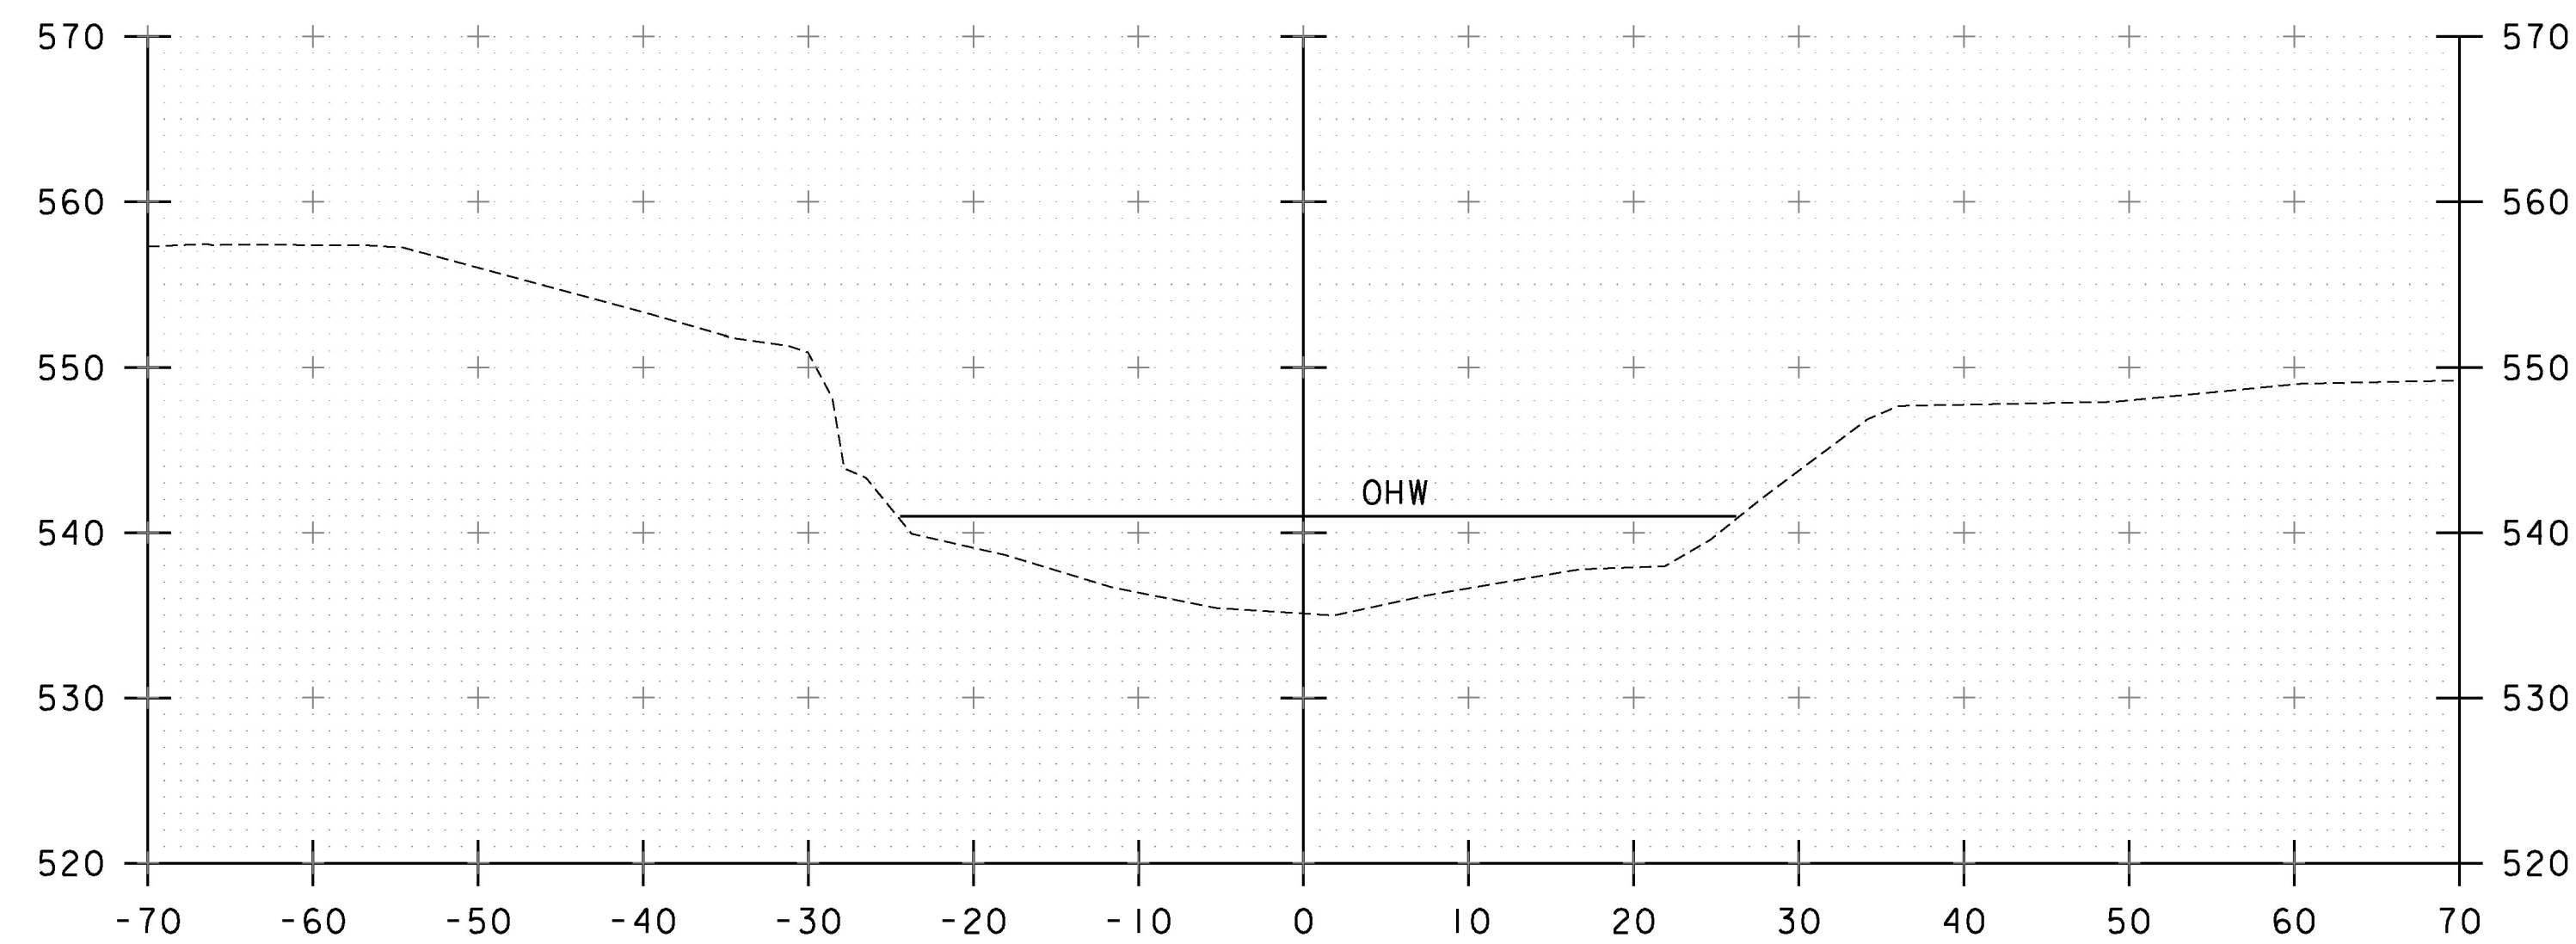

50+00

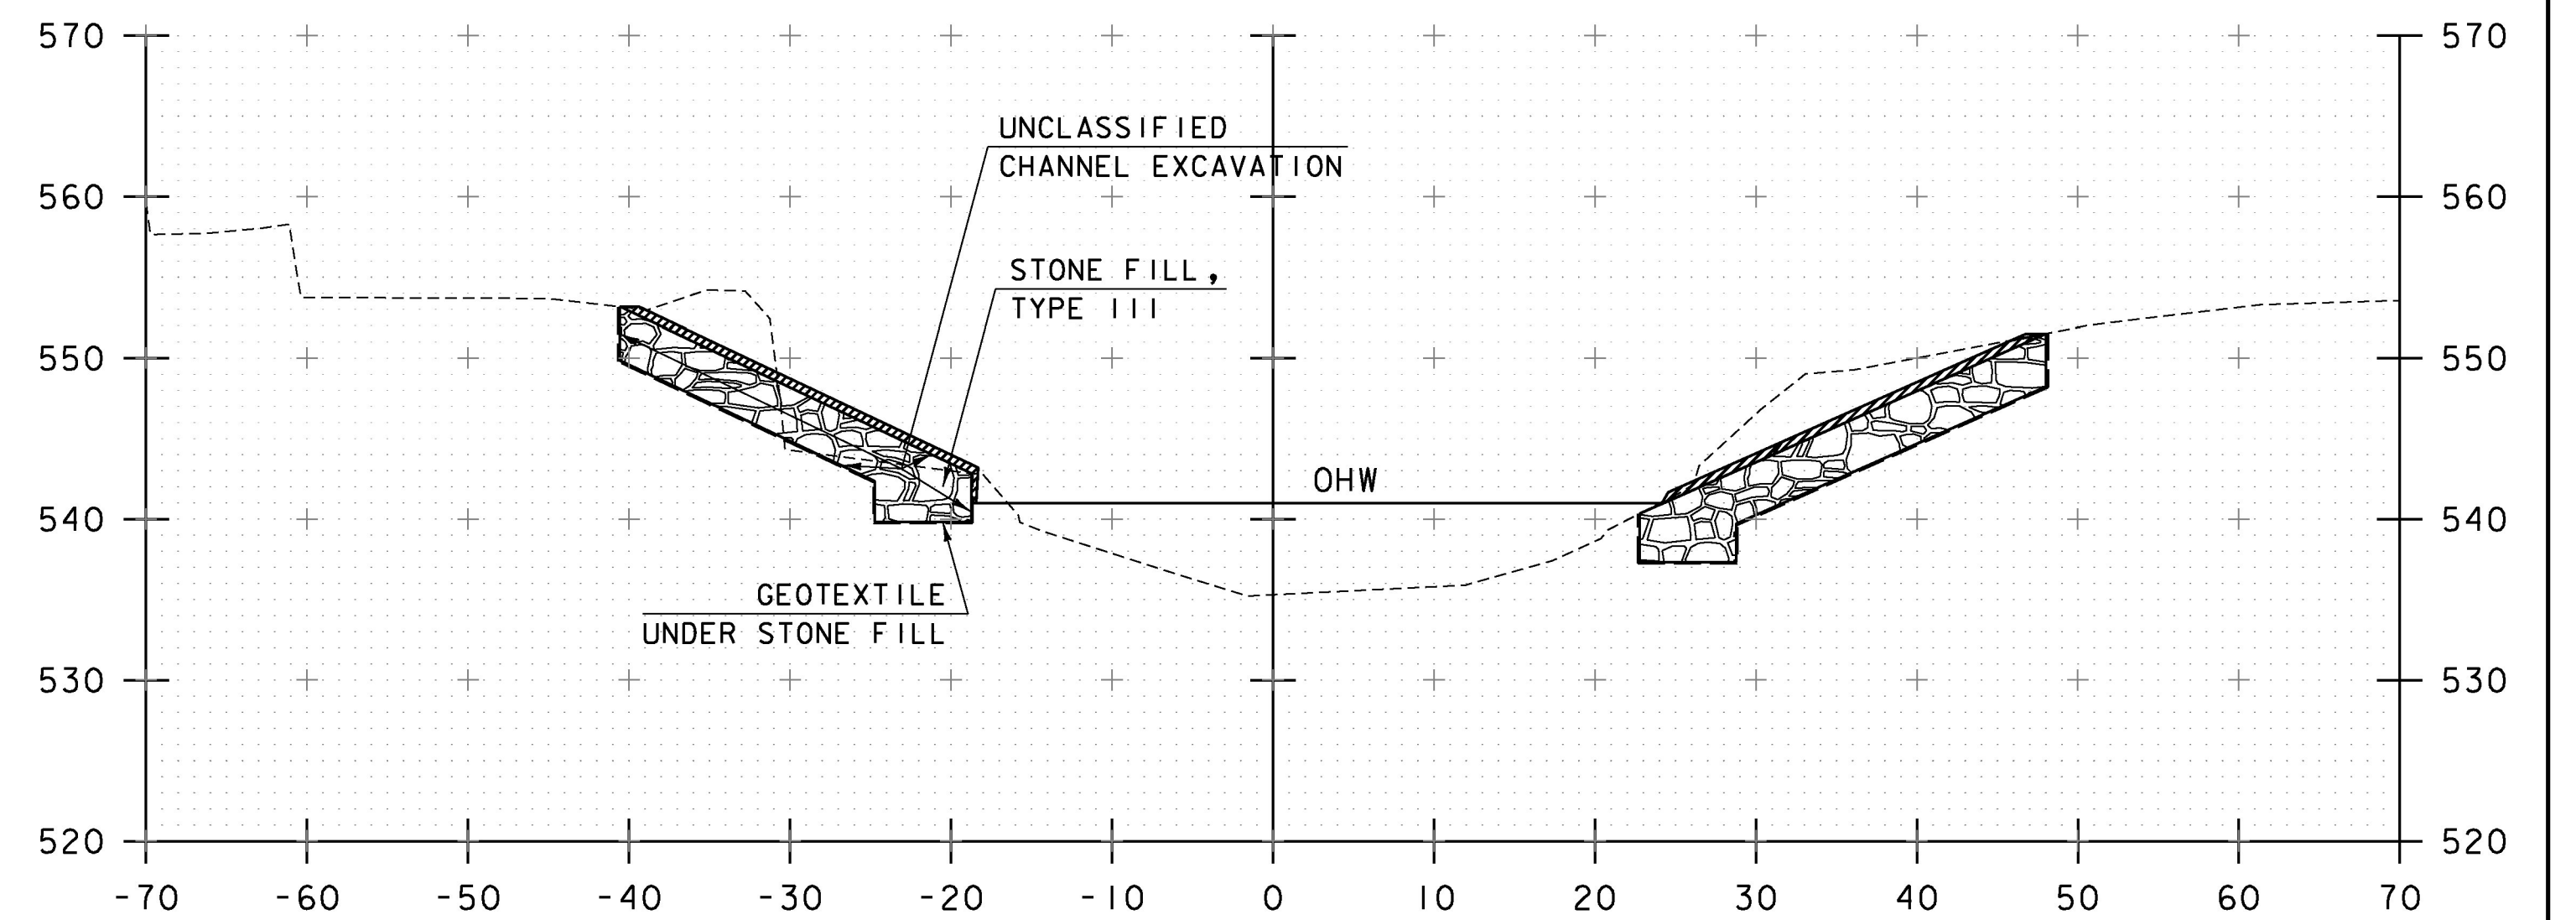


50+50

STA. 50+45 LT
 BEGIN UNCLASSIFIED CHANNEL EXCAVATION
 BEGIN STONE FILL, TYPE III
 BEGIN GEOTEXTILE UNDER STONE FILL
 BEGIN GRUBBING MATERIAL

STA. 50+39 RT
 BEGIN UNCLASSIFIED CHANNEL EXCAVATION
 BEGIN STONE FILL, TYPE III
 BEGIN GEOTEXTILE UNDER STONE FILL
 BEGIN GRUBBING MATERIAL

STA. 50+00 TO STA. 50+70

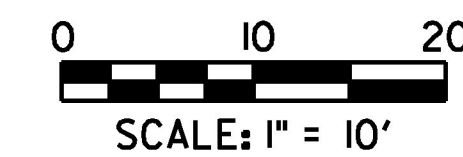

PROJECT NAME: ST JOHNSBURY	PLOT DATE: 9/30/2016
PROJECT NUMBER: BRO 1447(30)	DRAWN BY: J. HUNGERFORD
FILE NAME: z12j164xs.dgn	DESIGNED BY: I. MAYNARD
PROJECT LEADER: M. CHENETTE	CHECKED BY: M. CHENETTE
CHANNEL CROSS SECTIONS - CXS 1	SHEET 42 OF 76