




50+90

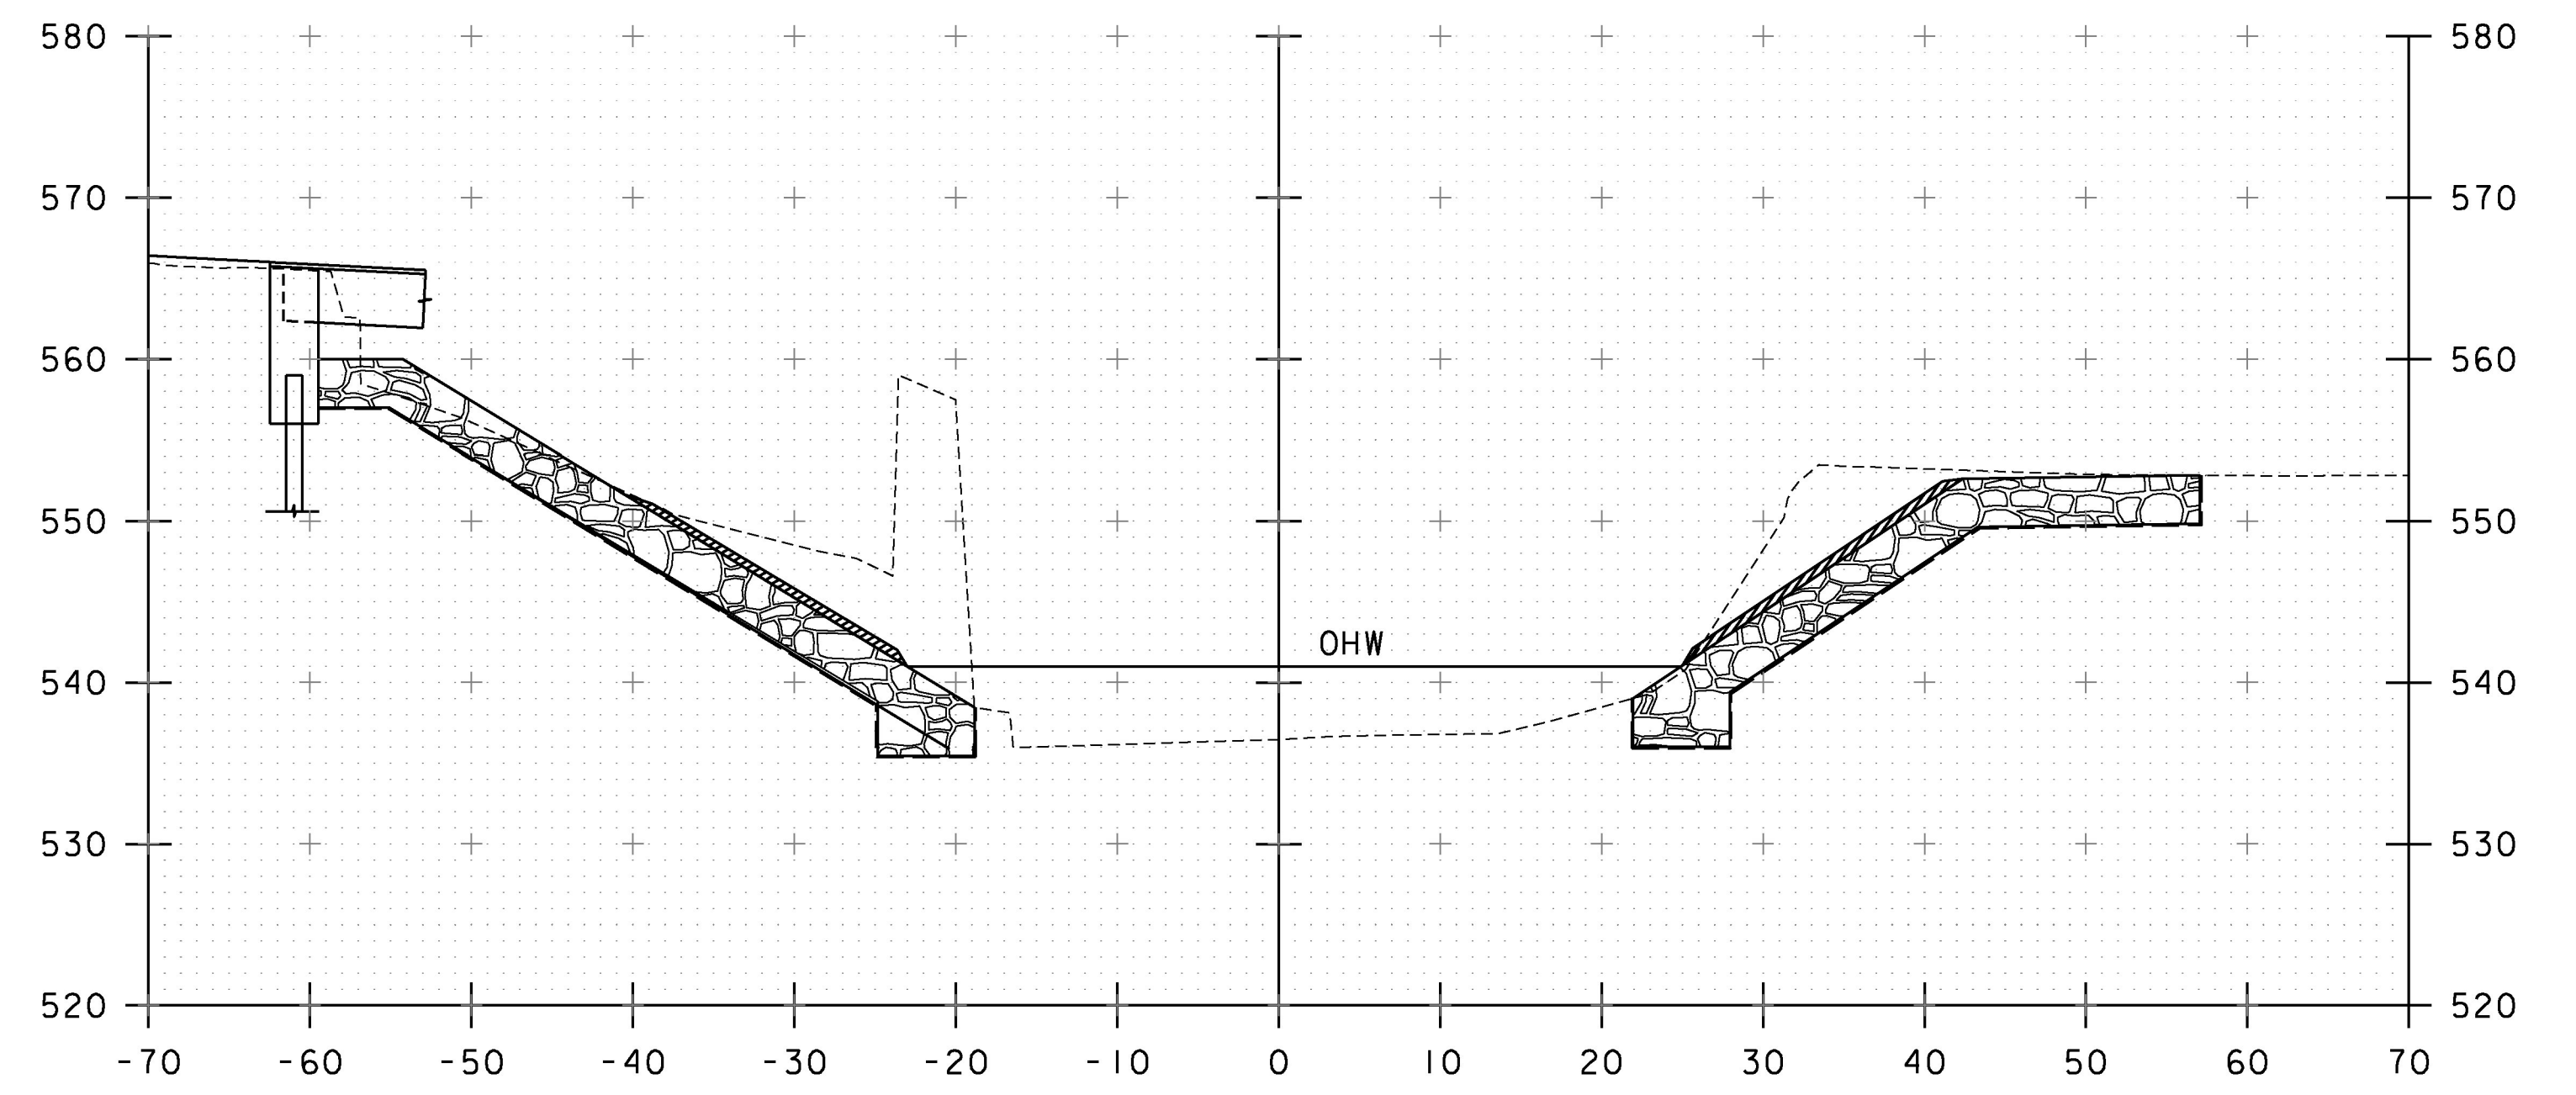

51+14

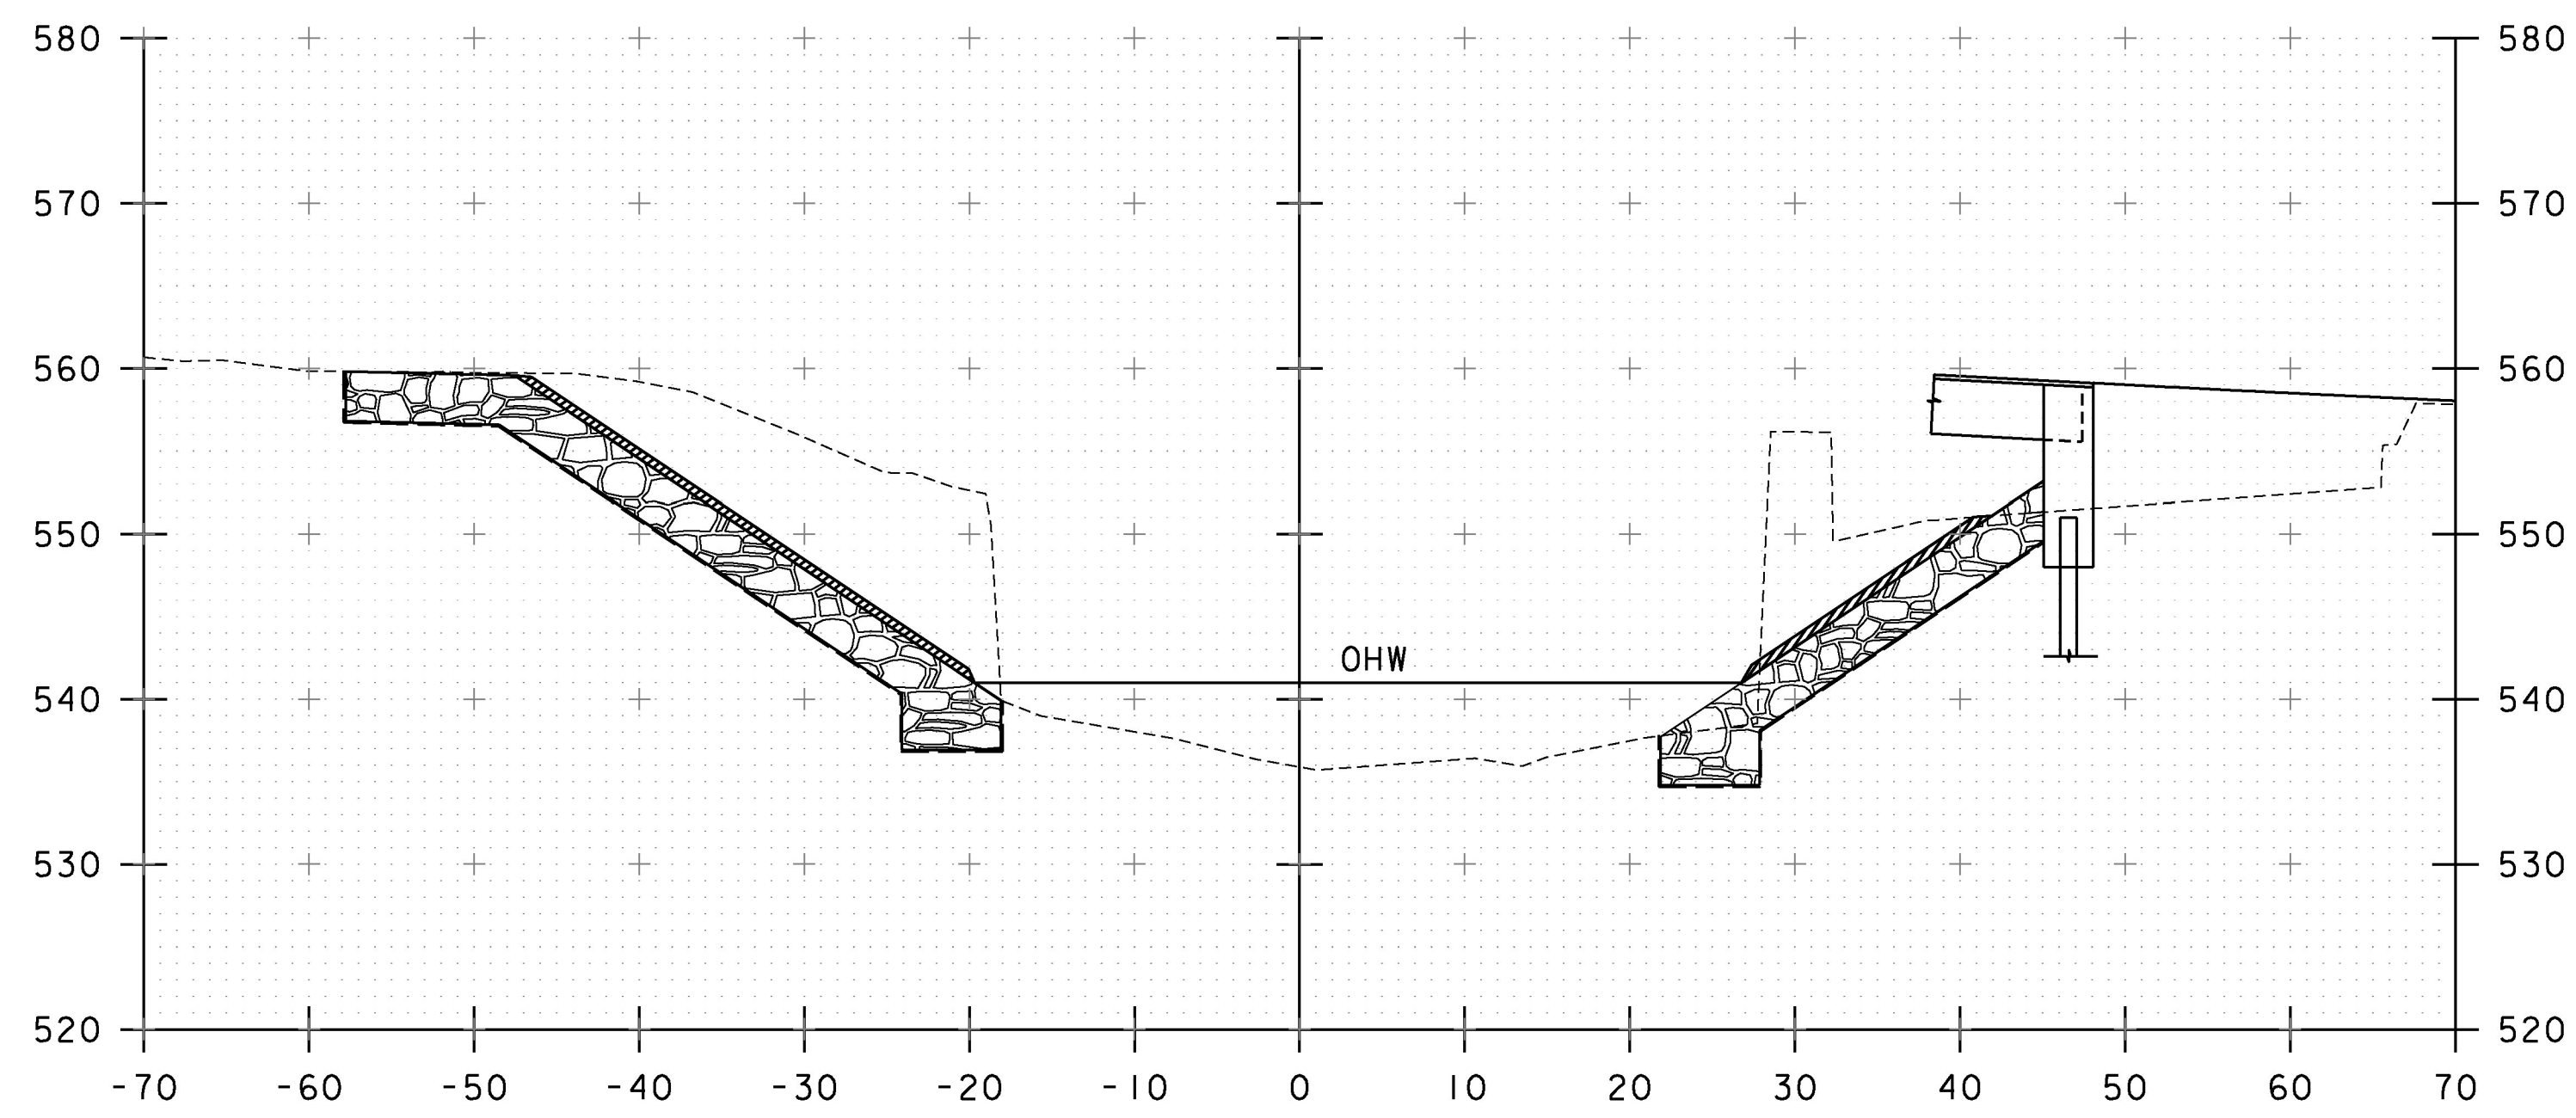

50+81

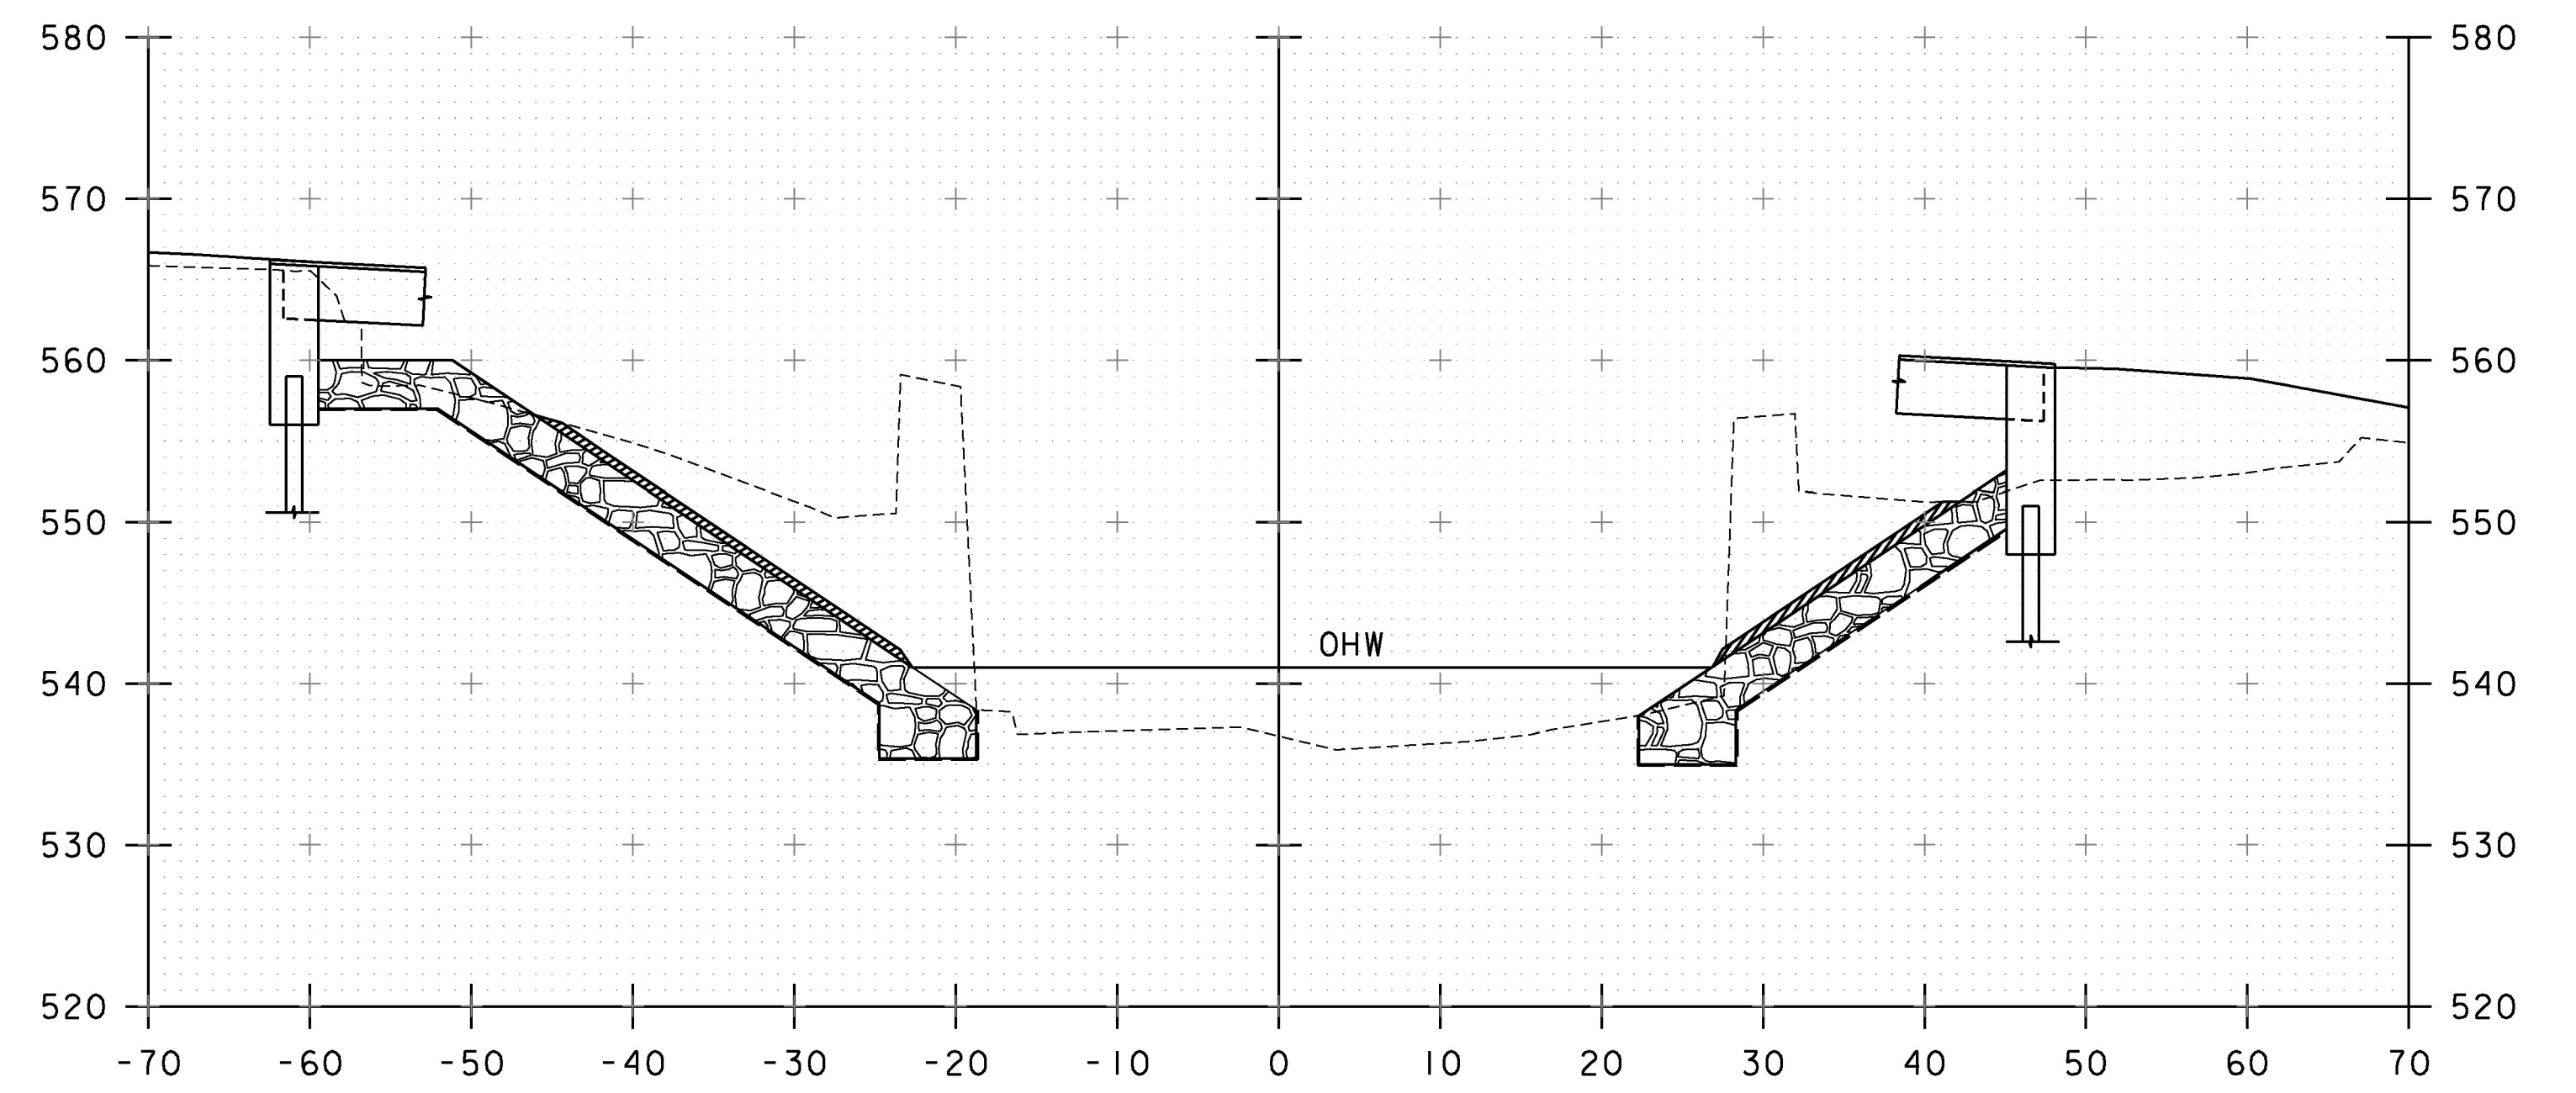

51+00

STA. 50+81 TO STA. 51+14

PROJECT NAME:	ST JOHNSBURY	PLOT DATE:	9/30/2016
PROJECT NUMBER:	BRO 1447(30)	DRAWN BY:	J. HUNGERFORD
FILE NAME:	z12j164xs.dgn	DESIGNED BY:	I. MAYNARD
PROJECT LEADER:	M. CHENETTE	CHECKED BY:	M. CHENETTE
CHANNEL CROSS SECTIONS - CXS 2		SHEET	43 OF 76

