


**MENARD, RICHARD D. & CARMEN A.**

**TOWN OF ST. JOHNSBURY**

**VINTON, DRURY L.**

**STATE OF VERMONT**

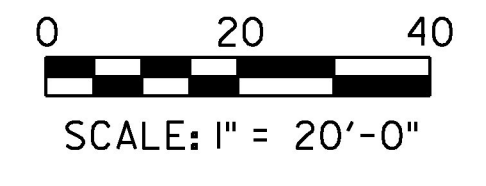

PROJECT NAME:	ST JOHNSBURY	PLOT DATE:	9/30/2016
PROJECT NUMBER:	BRO 1447(30)	DRAWN BY:	D. BARNES
FILE NAME:	z12j164bdr_ero.dgn	DESIGNED BY:	I. MAYNARD
PROJECT LEADER:	M. CHENETTE	CHECKED BY:	G. SANTY
EPSC FINAL SITE PLAN		SHEET	48 OF 76