




22+00
BEGIN APPROACH

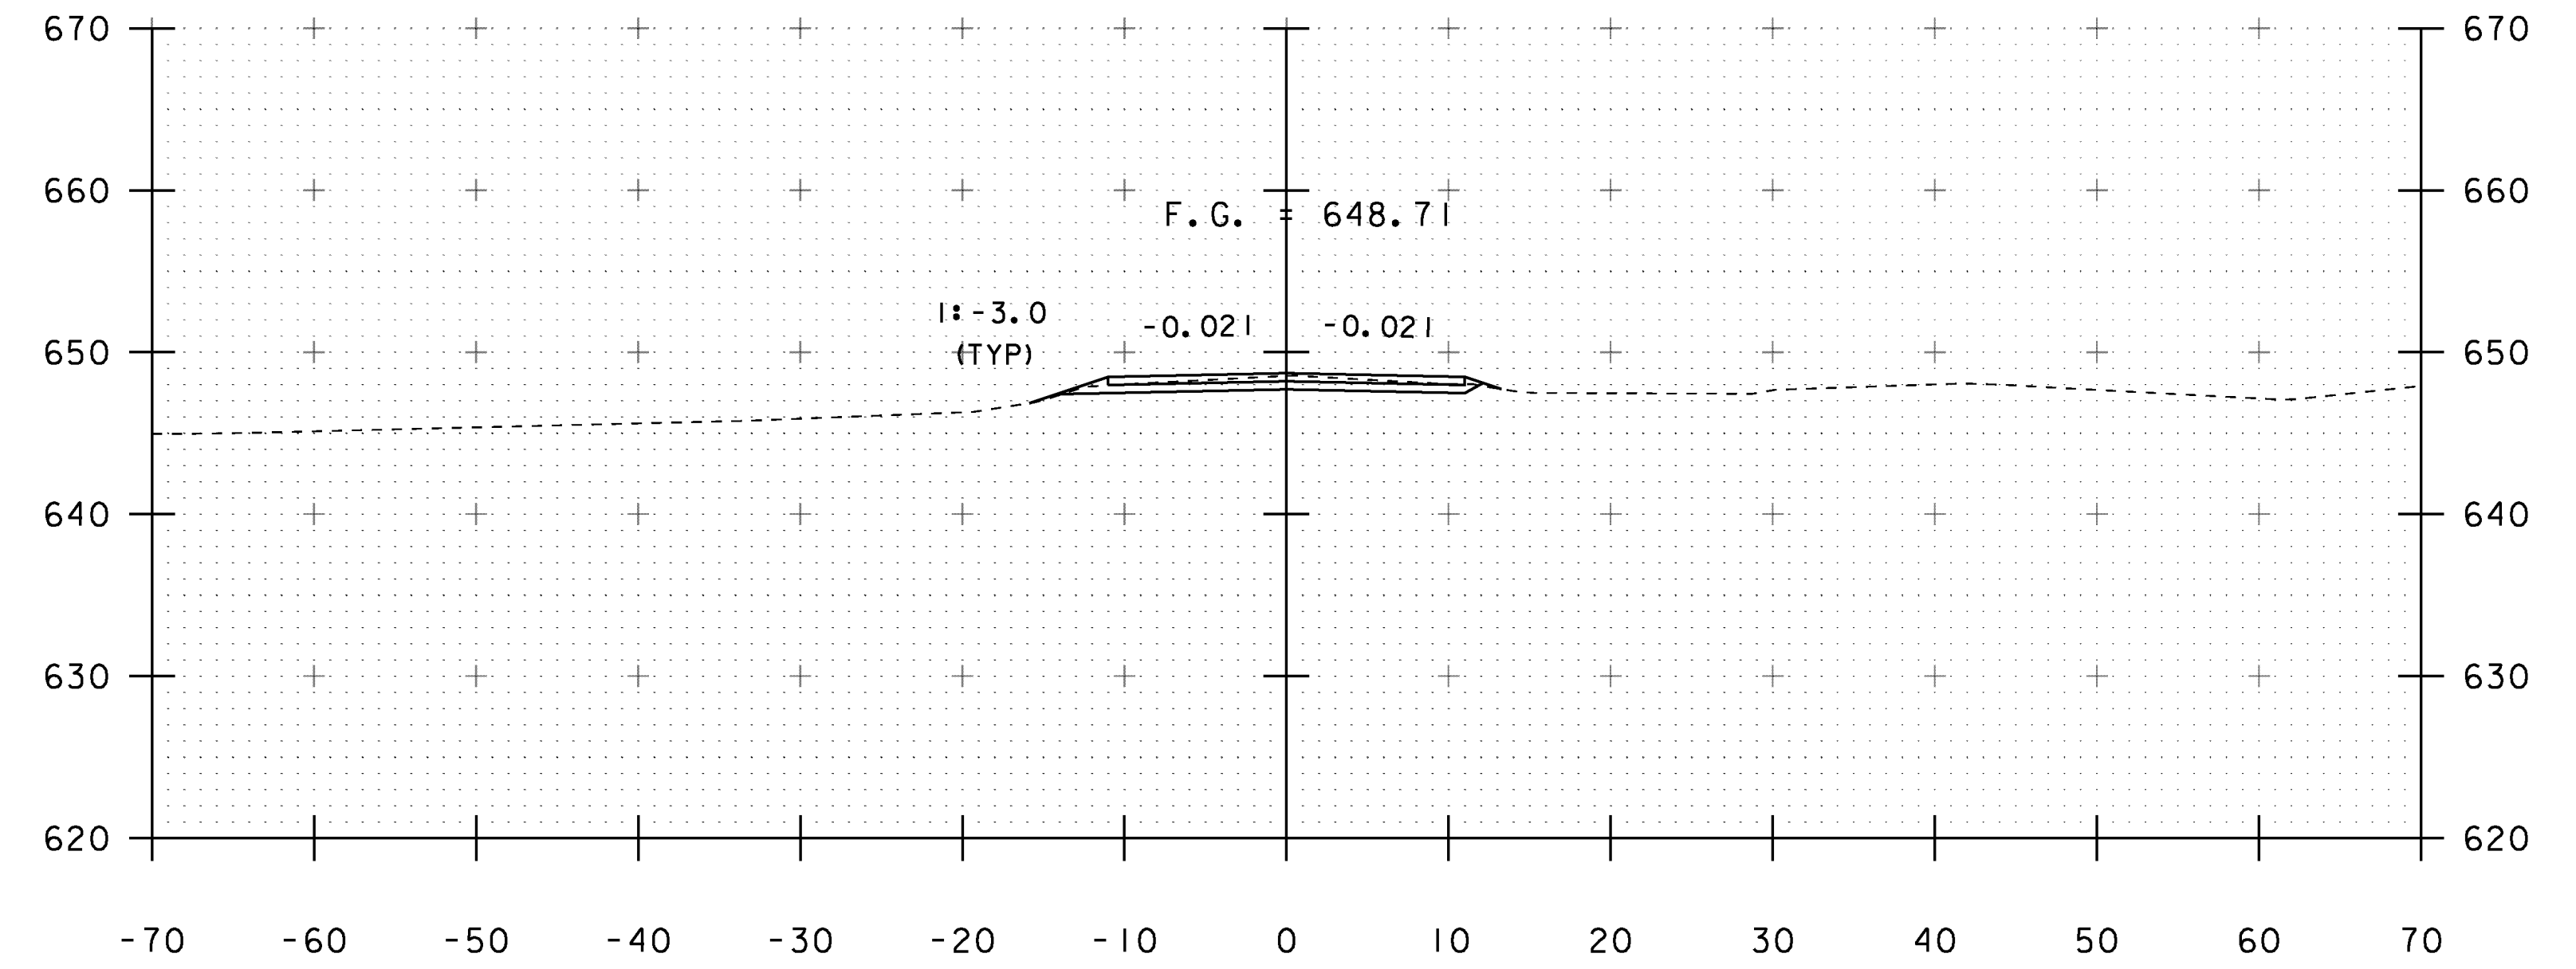

22+50

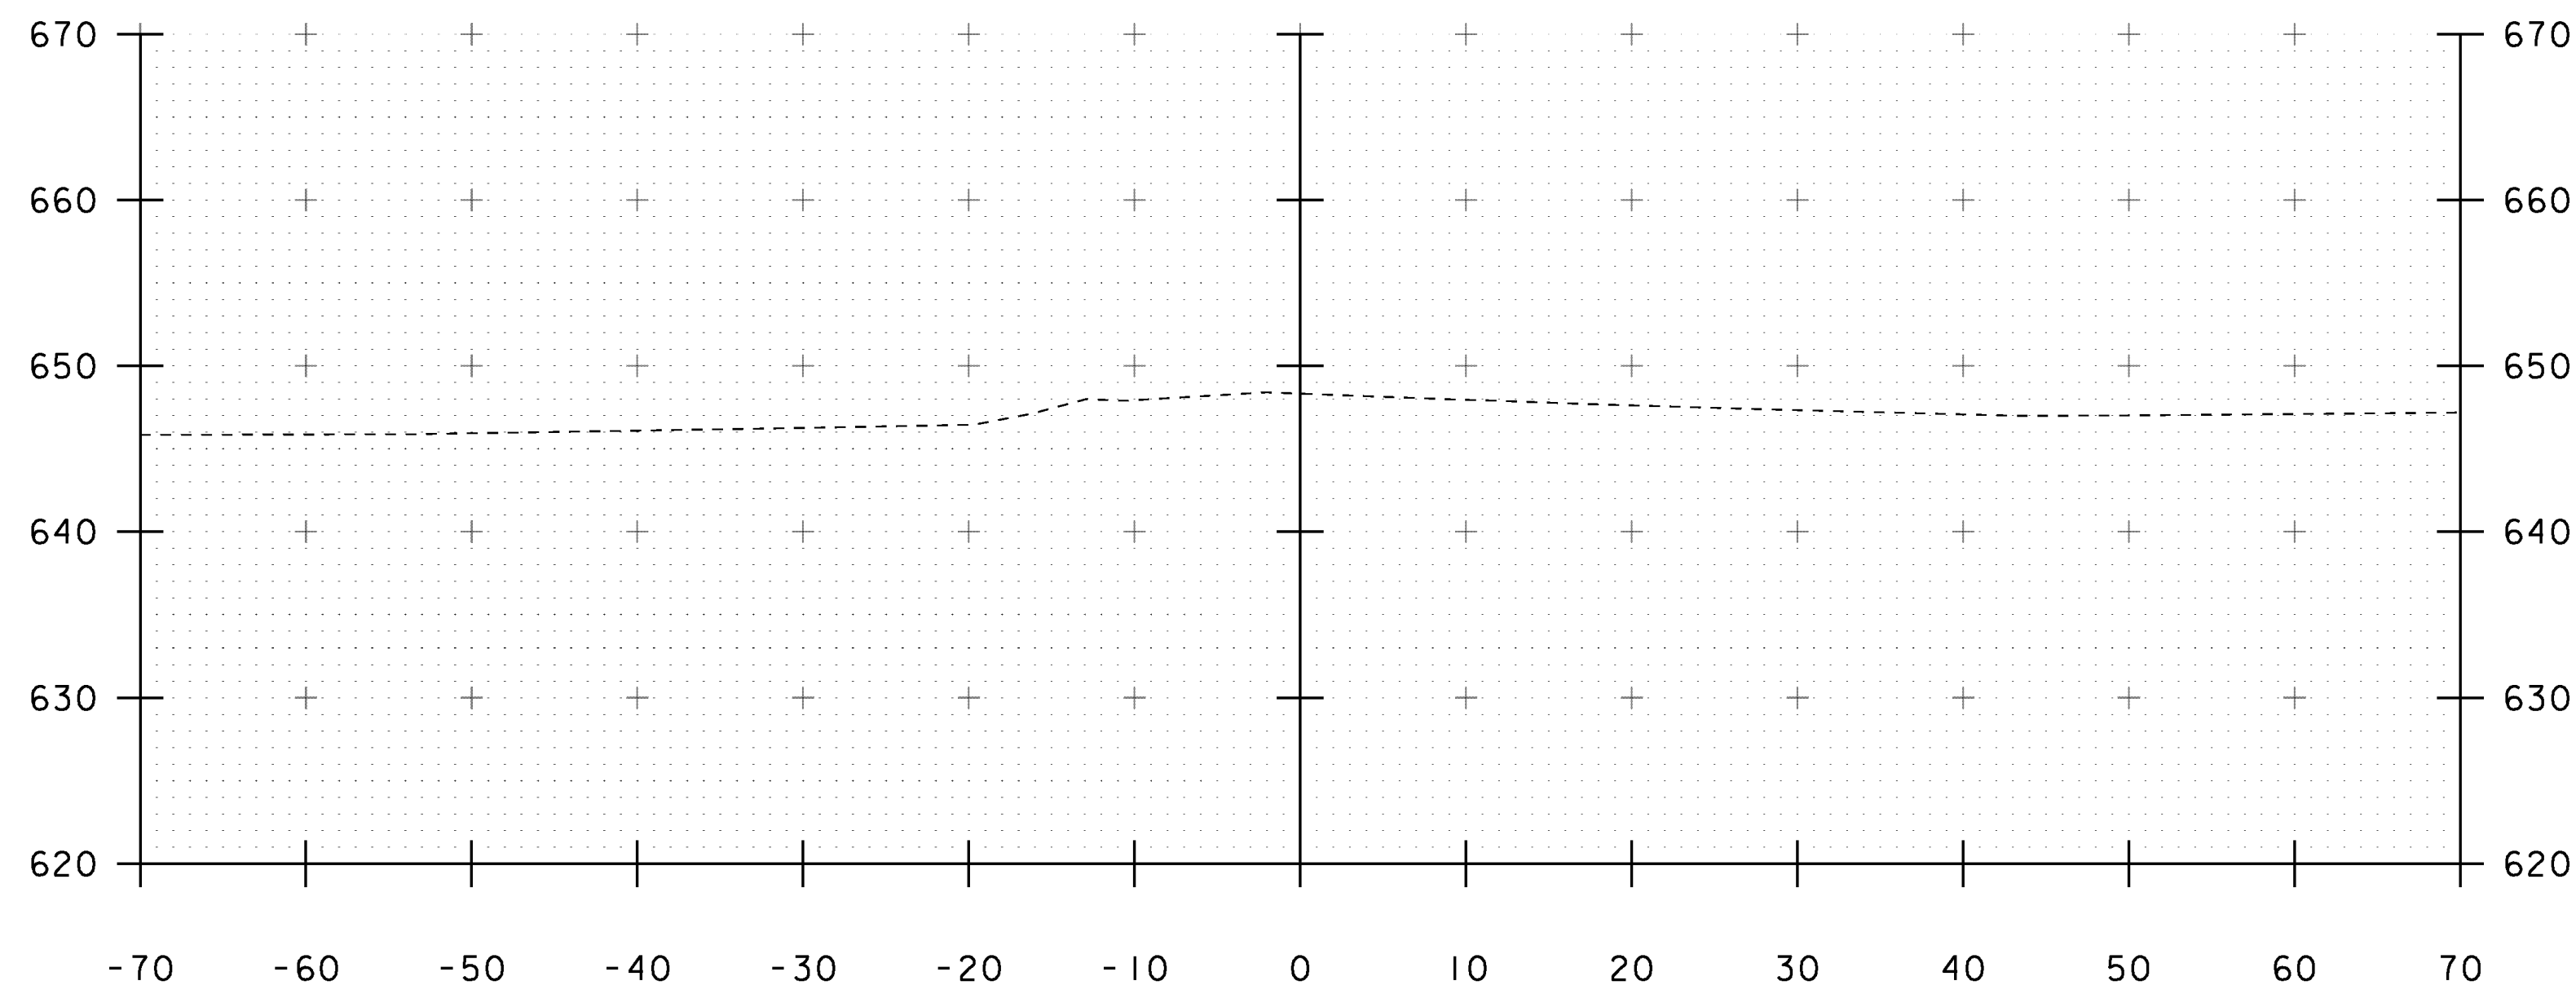

21+75

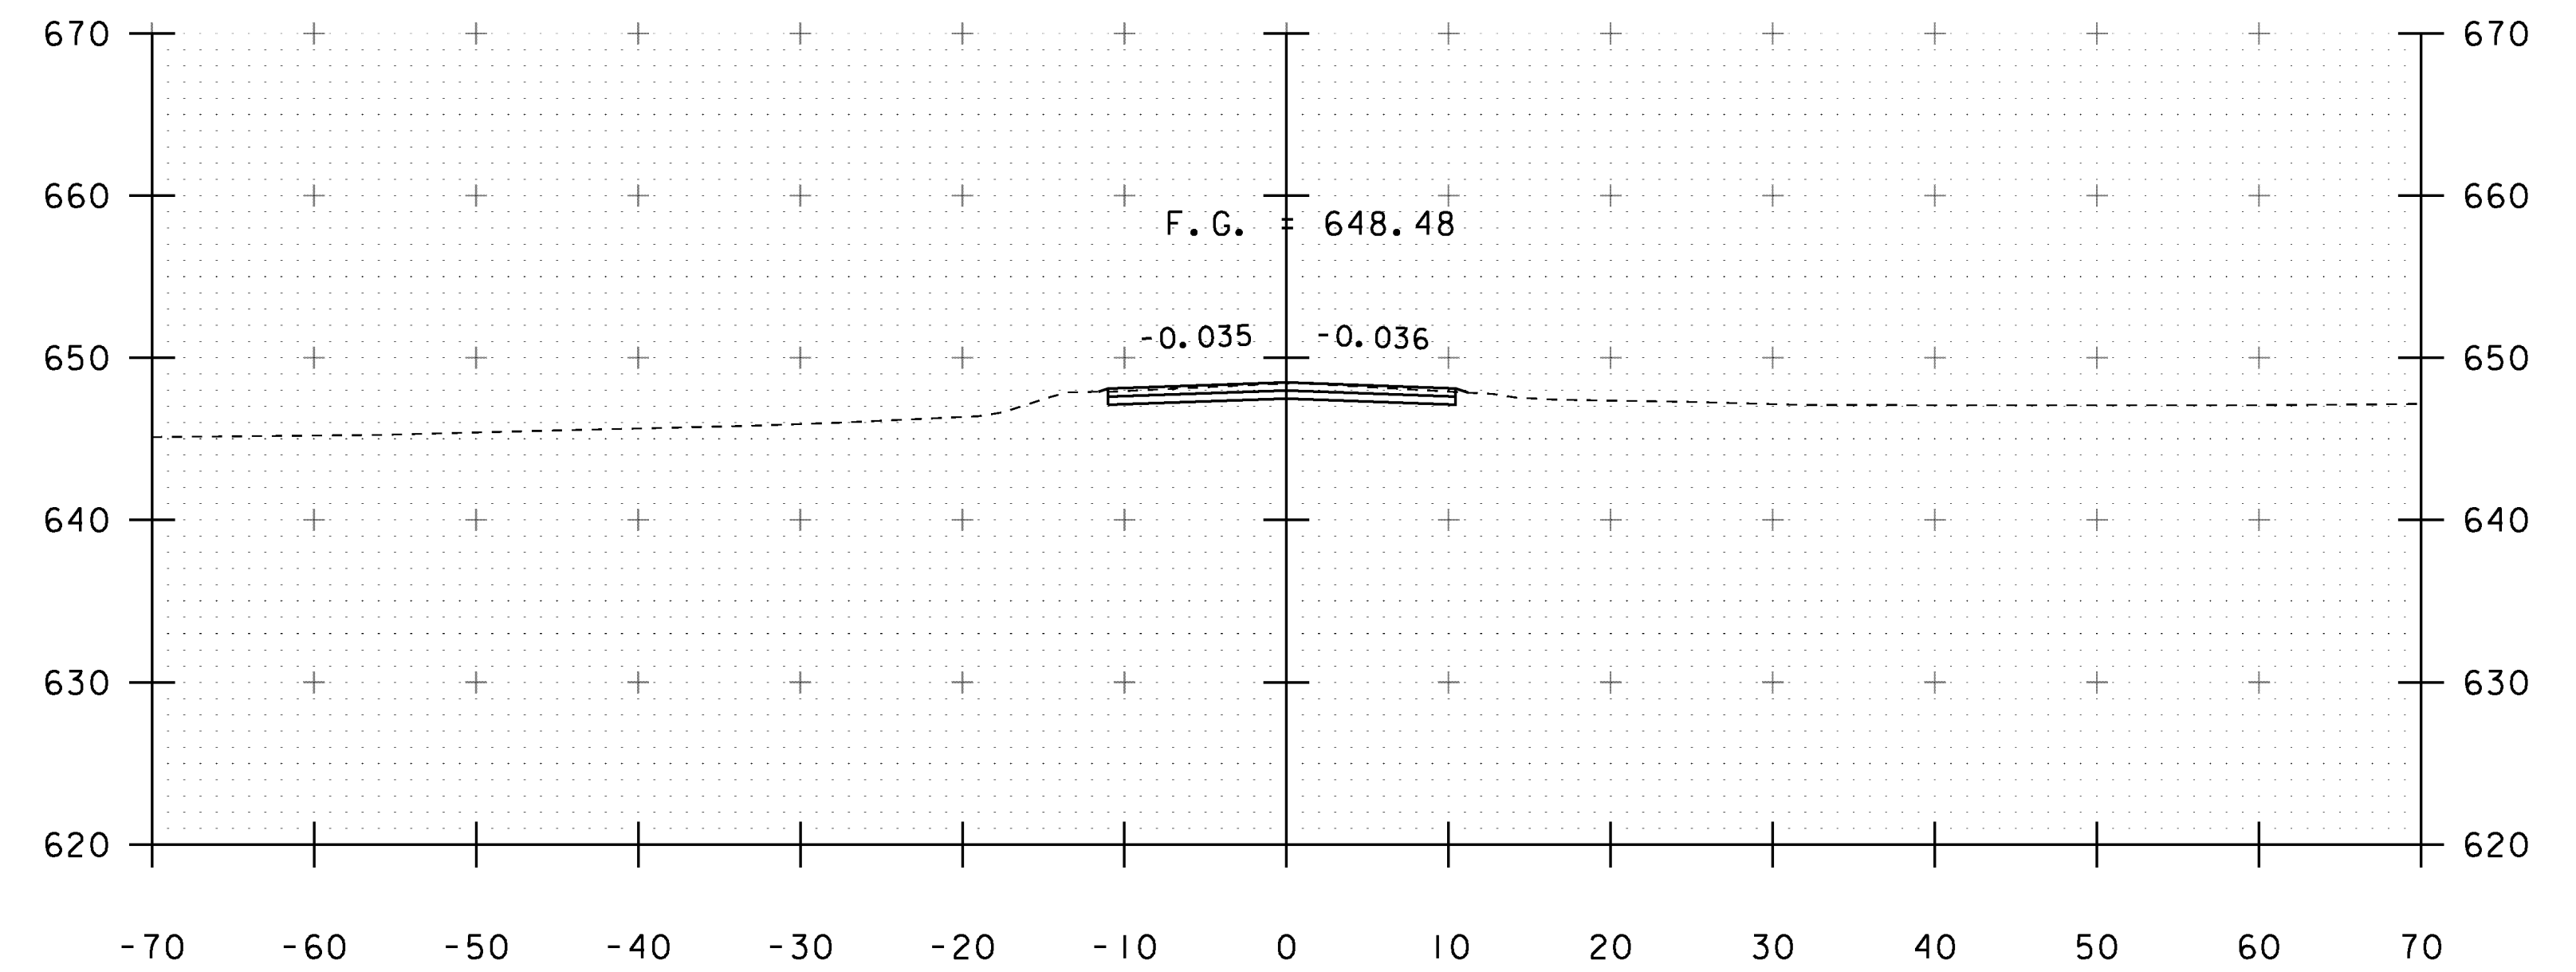

22+25

STA. 21+75 TO STA. 22+50

PROJECT NAME: CAMBRIDGE
PROJECT NUMBER: BRO 1448(39)

FILE NAME: s12j166xs.dgn
PROJECT LEADER: K. HIGGINS
DESIGNED BY: G. LAROCHE
MAINLINE SECTIONS 1

PLOT DATE: 29-AUG-2014
DRAWN BY: G. LAROCHE
CHECKED BY: J. SALVATORI
SHEET 25 OF 34