




24+00
24+08.33 END BRIDGE

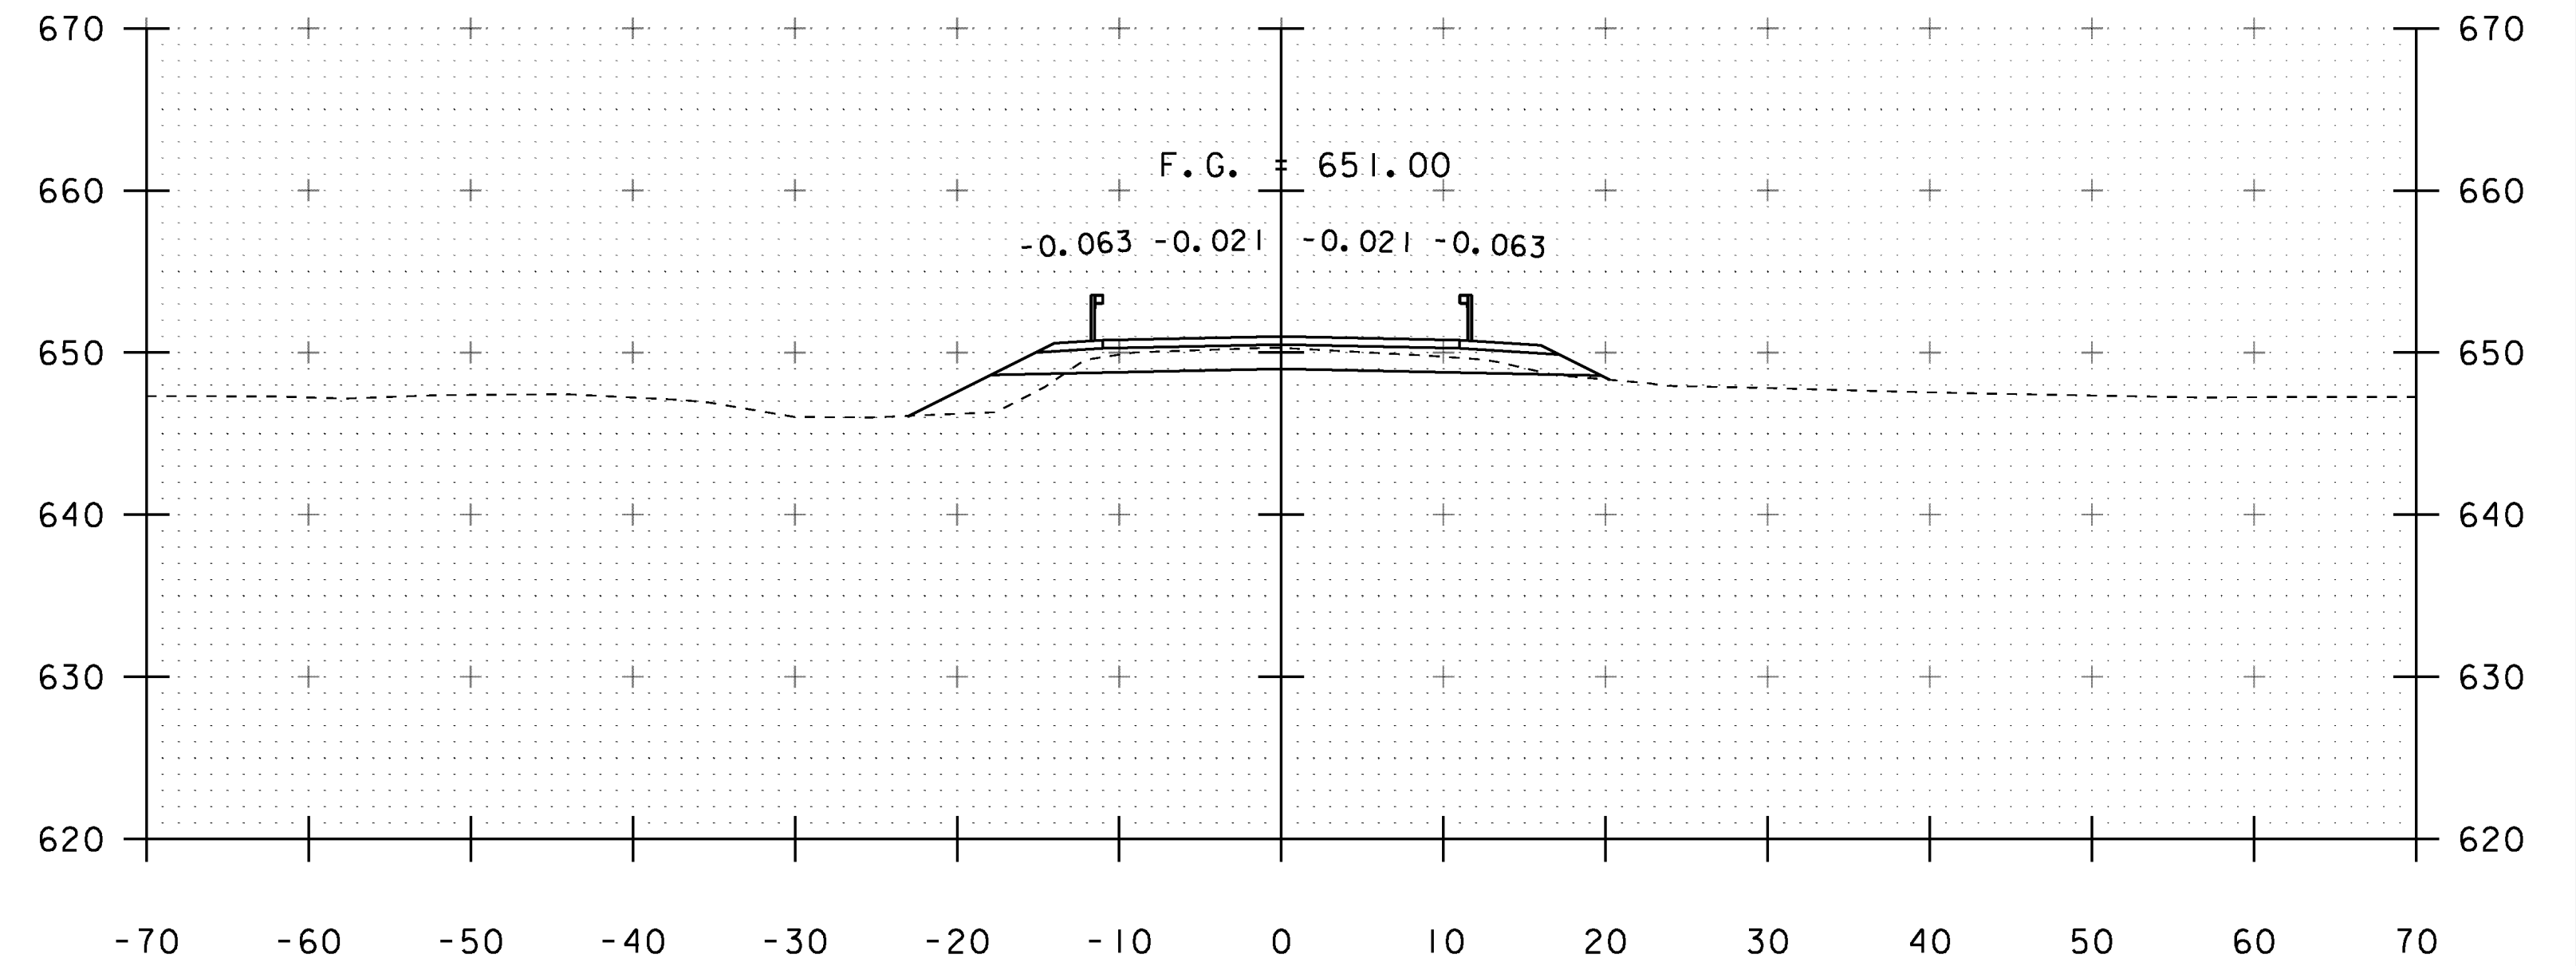

24+50
END PROJECT
END PAVEMENT

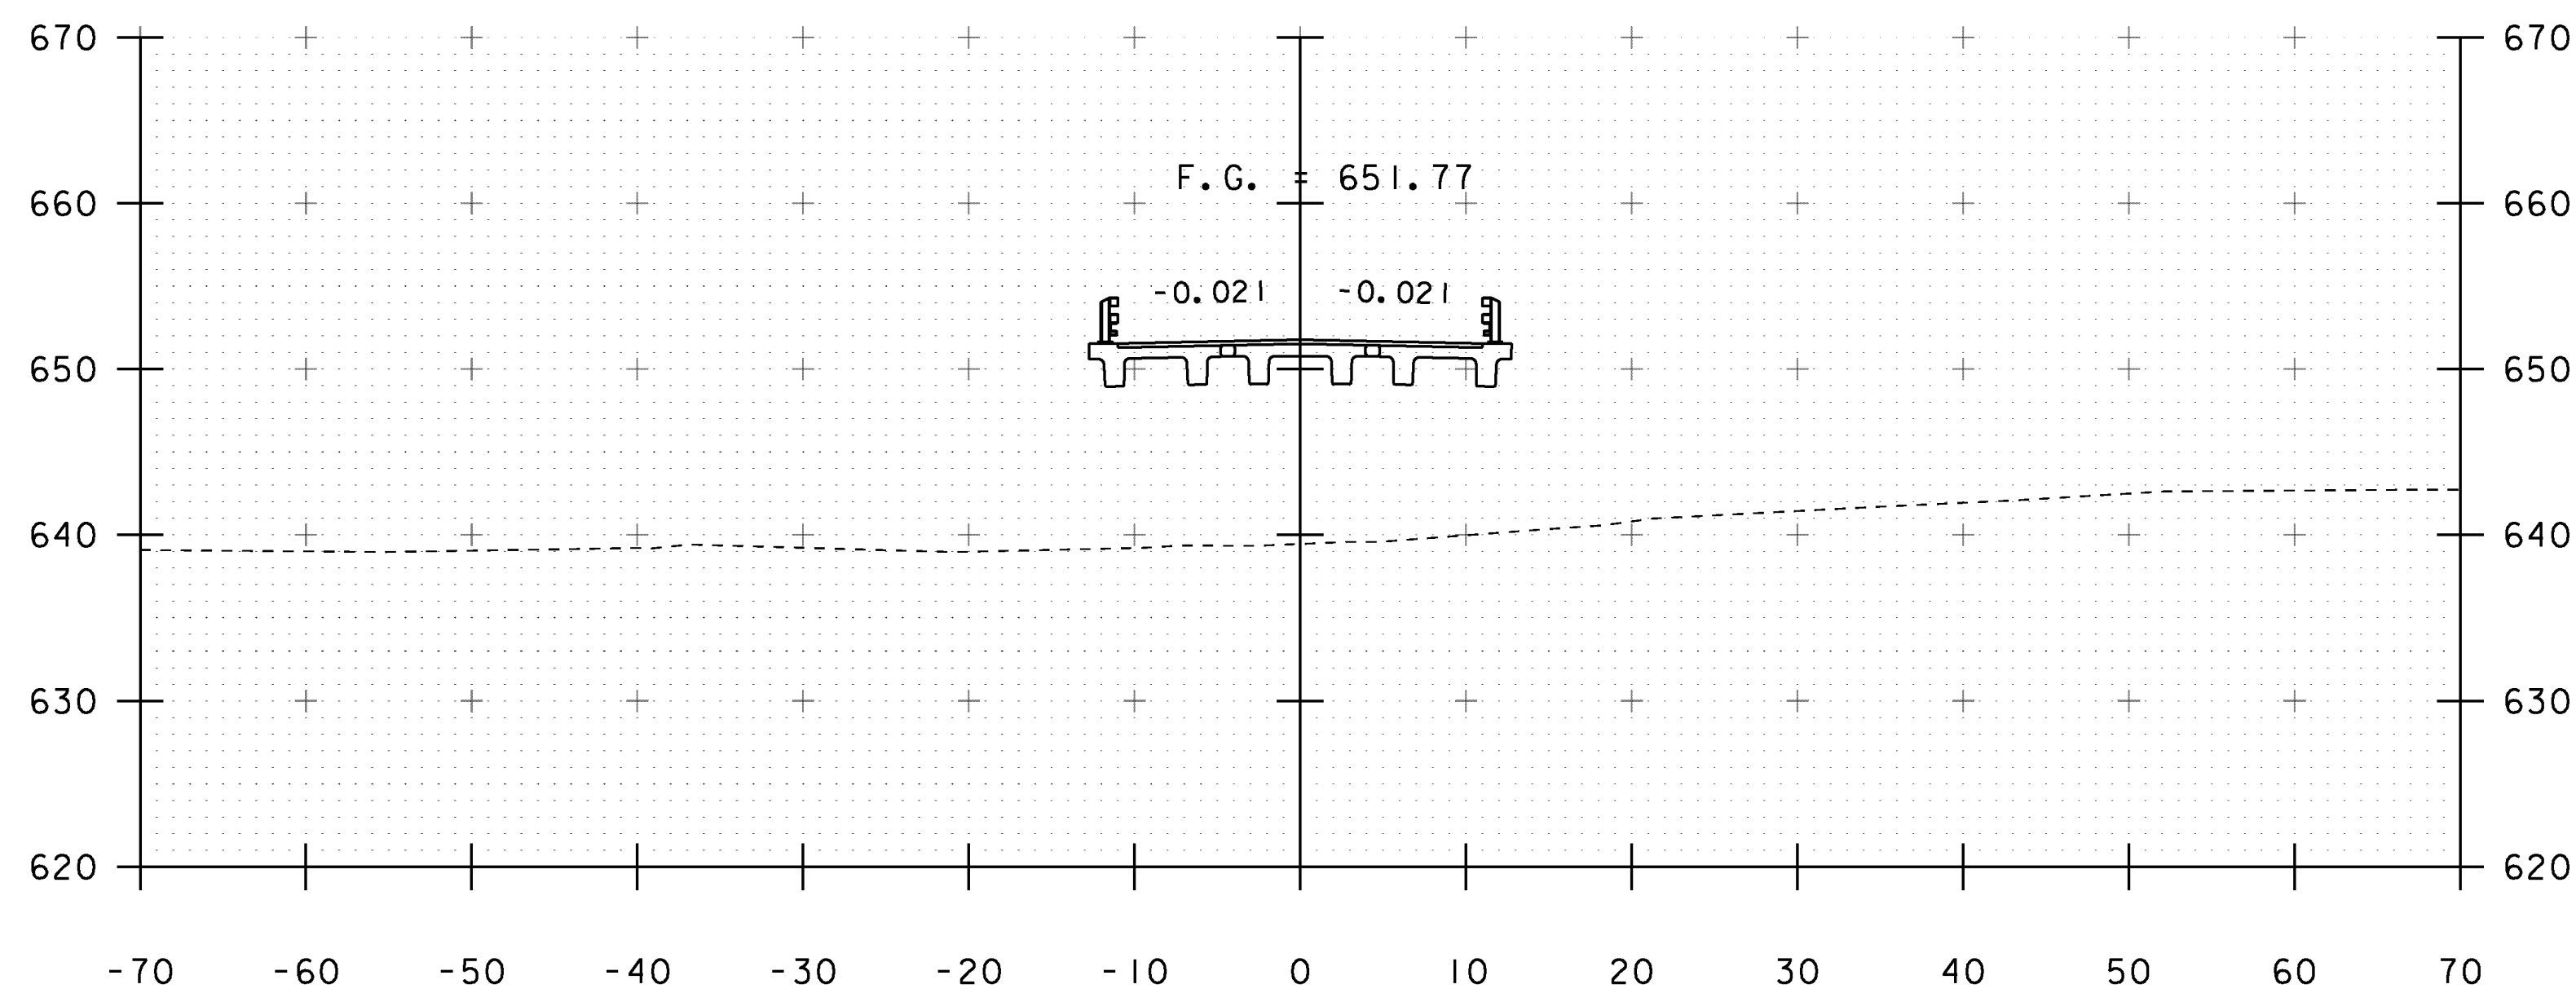

23+75

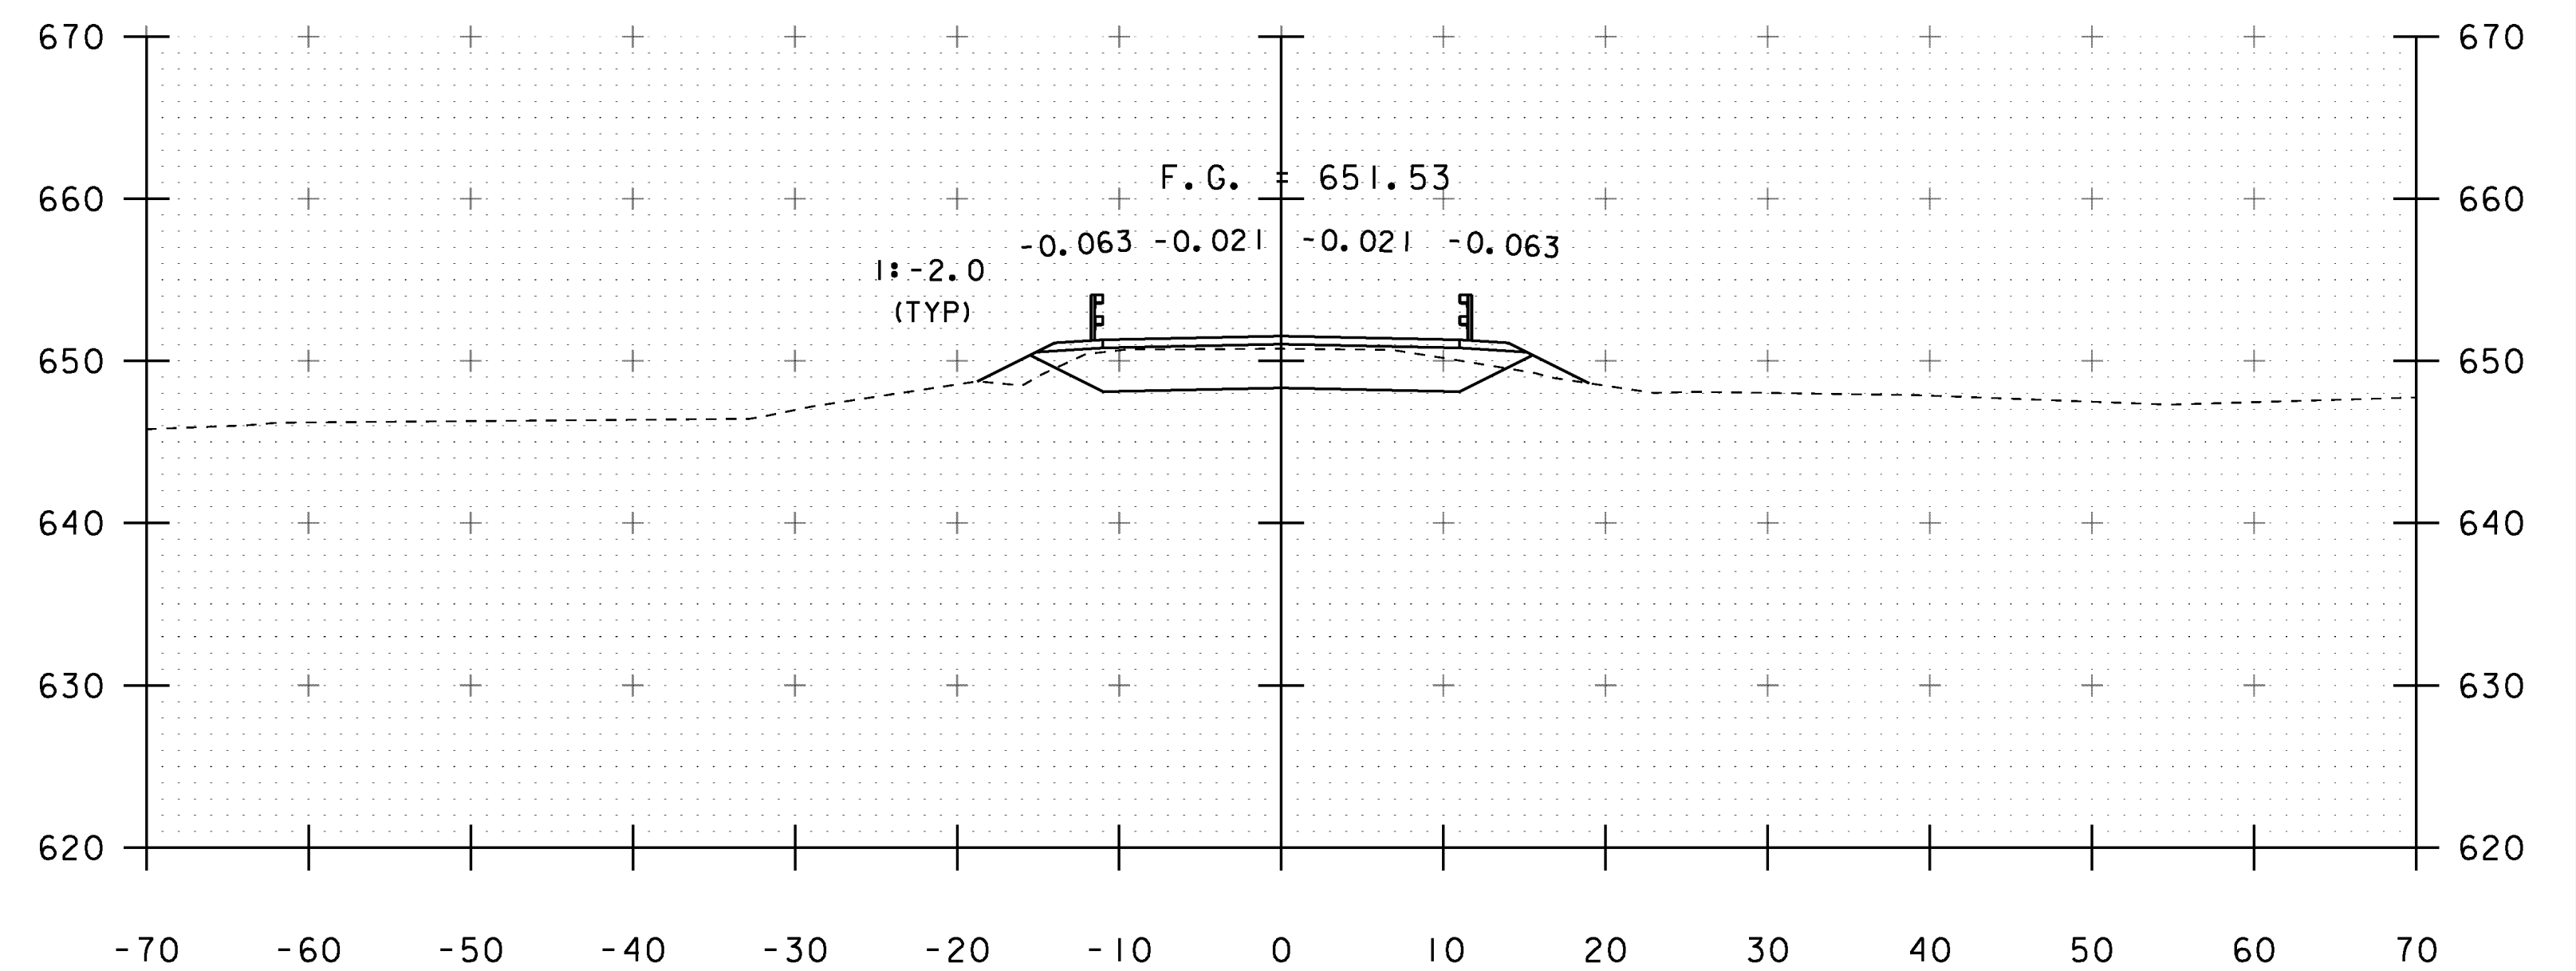

24+25

PROJECT NAME: CAMBRIDGE
PROJECT NUMBER: BRO 1448(39)

FILE NAME: s12j166xs.dgn
PROJECT LEADER: K. HIGGINS
DESIGNED BY: G. LAROCHE
MAINLINE SECTIONS 3

PLOT DATE: 29-AUG-2014
DRAWN BY: G. LAROCHE
CHECKED BY: J. SALVATORI
SHEET 27 OF 34

STA. 23+75 TO STA. 24+50