

STATE OF VERMONT AGENCY OF TRANSPORTATION



PROPOSED IMPROVEMENT BRIDGE PROJECT



TOWN OF CAMBRIDGE
COUNTY OF LAMOILLE

ROUTE NO : TOWN HIGHWAY 46 (IRISH SETTLEMENT ROAD), CLASS 3 TOWN HIGHWAY
BRIDGE NO : 28

PROJECT LOCATION: 0.1 MILES WEST OF JUNCTION WITH TOWN HIGHWAY 1 (PLEASANT VALLEY ROAD)

PROJECT DESCRIPTION: REPLACEMENT OF BRIDGE 28 WITH A NEW PRECAST CONCRETE STRUCTURE WITH RELATED APPROACH AND CHANNEL WORK.


LENGTH OF STRUCTURE: 60.66 FEET
LENGTH OF ROADWAY: 89.34 FEET
LENGTH OF PROJECT: 150.00 FEET

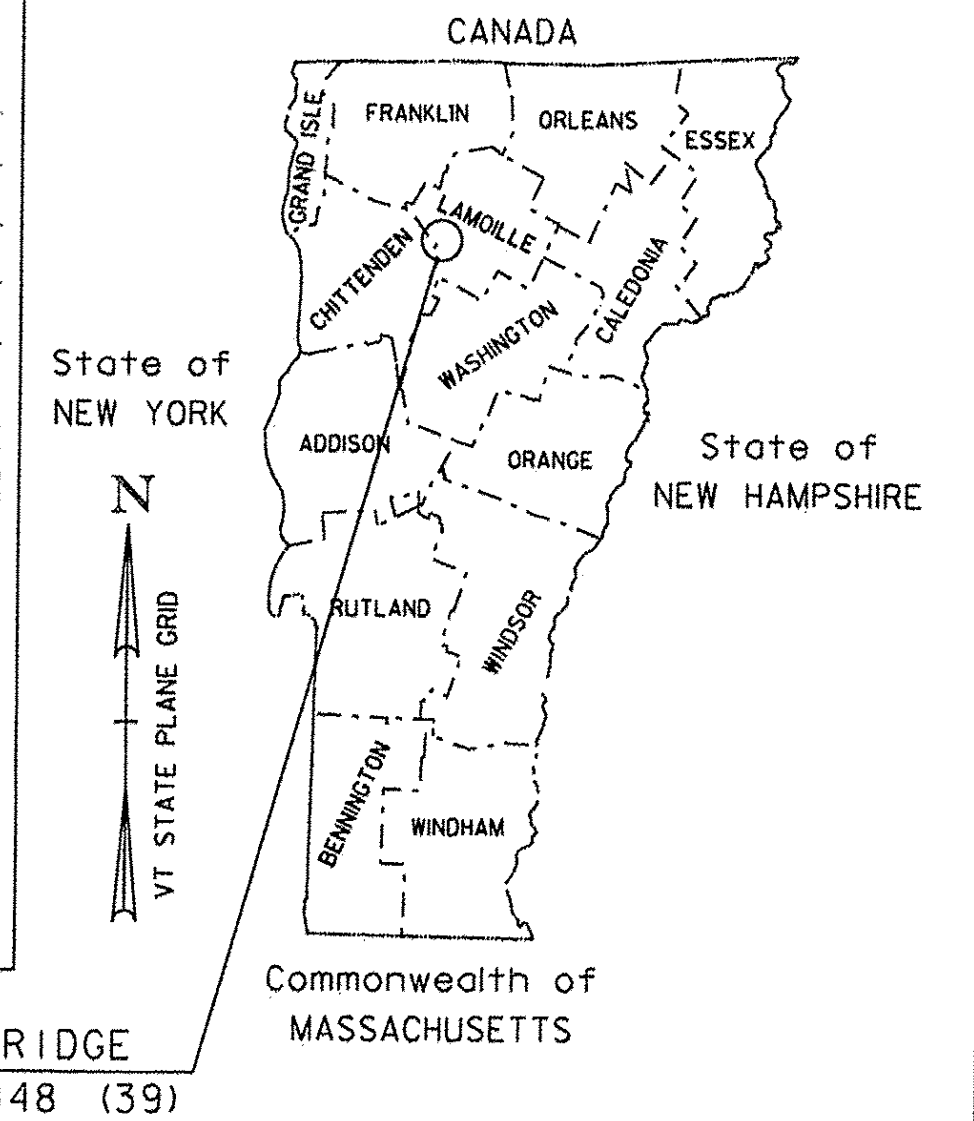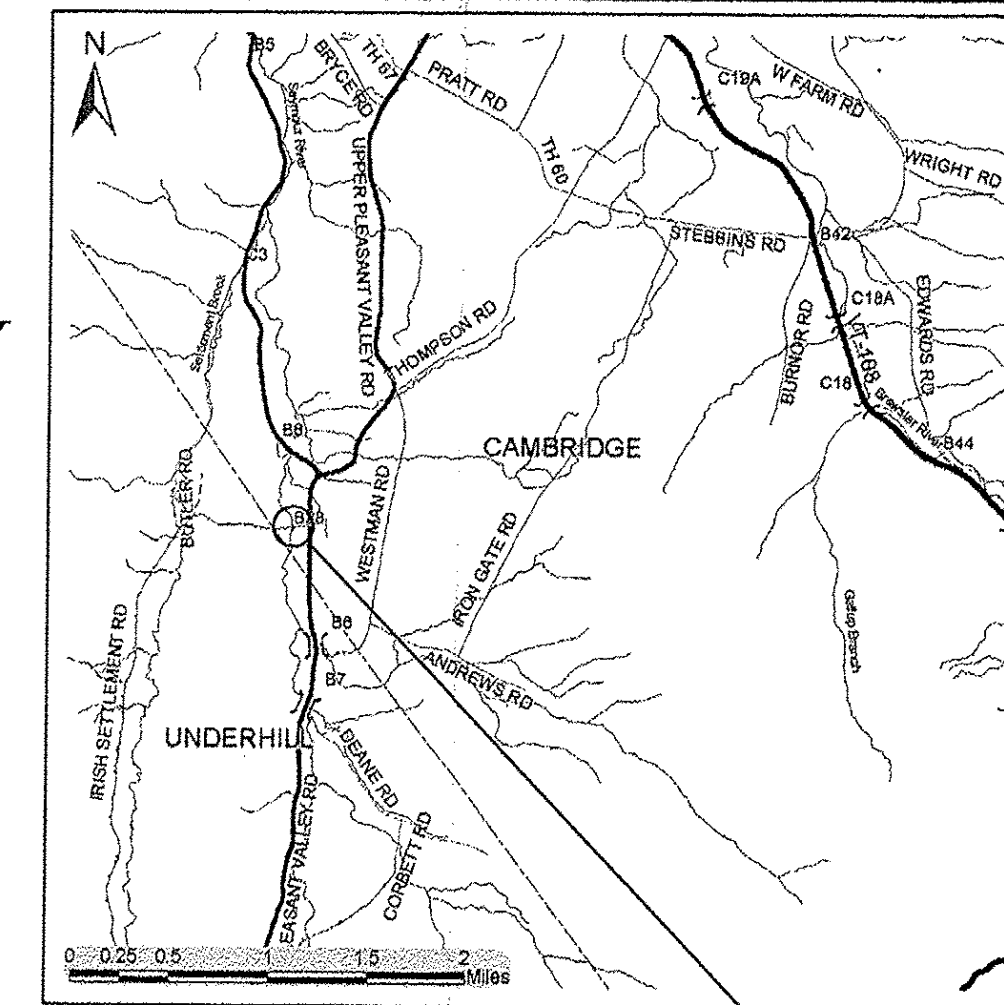

RECORD PLANS	
CONTRACTOR:	BLOW & COTE INC. - MORRISVILLE, VT
RESIDENT ENGINEER:	GREG WILCOX
CONSTRUCTION BEGAN:	MAY 18, 2015
CONSTRUCTION COMPLETE:	AUGUST 19, 2015
RECORD PLANS BY:	GREG WILCOX & KEVIN KING
I HEREBY CERTIFY THAT ALL THE CONSTRUCTION REQUIRED BY THIS SET OF DRAWINGS HAS BEEN ACCOMPLISHED AS INDICATED HEREIN.	
BY:	RESIDENT ENGINEER
DATE:	5-17-16
NOTE: Any further information concerning final quantities, amounts or other details relative to this project may be found at Central Files in the electronic archives.	

CONSTRUCTION IS TO BE CARRIED ON IN ACCORDANCE WITH THESE PLANS AND THE STANDARD SPECIFICATIONS FOR CONSTRUCTION DATED 2011, AS APPROVED BY THE FEDERAL HIGHWAY ADMINISTRATION ON JULY 20, 2011 FOR USE ON THIS PROJECT, INCLUDING ALL SUBSEQUENT REVISIONS AND SUCH REVISED SPECIFICATIONS AND SPECIAL PROVISIONS AS ARE INCORPORATED IN THESE PLANS.

QUALITY ASSURANCE PROGRAM : LEVEL 2	
SURVEYED BY :	L. ORVIS
SURVEYED DATE :	04-24-2012
DATUM	
VERTICAL	NAVD88
HORIZONTAL	NAD83 (2007)

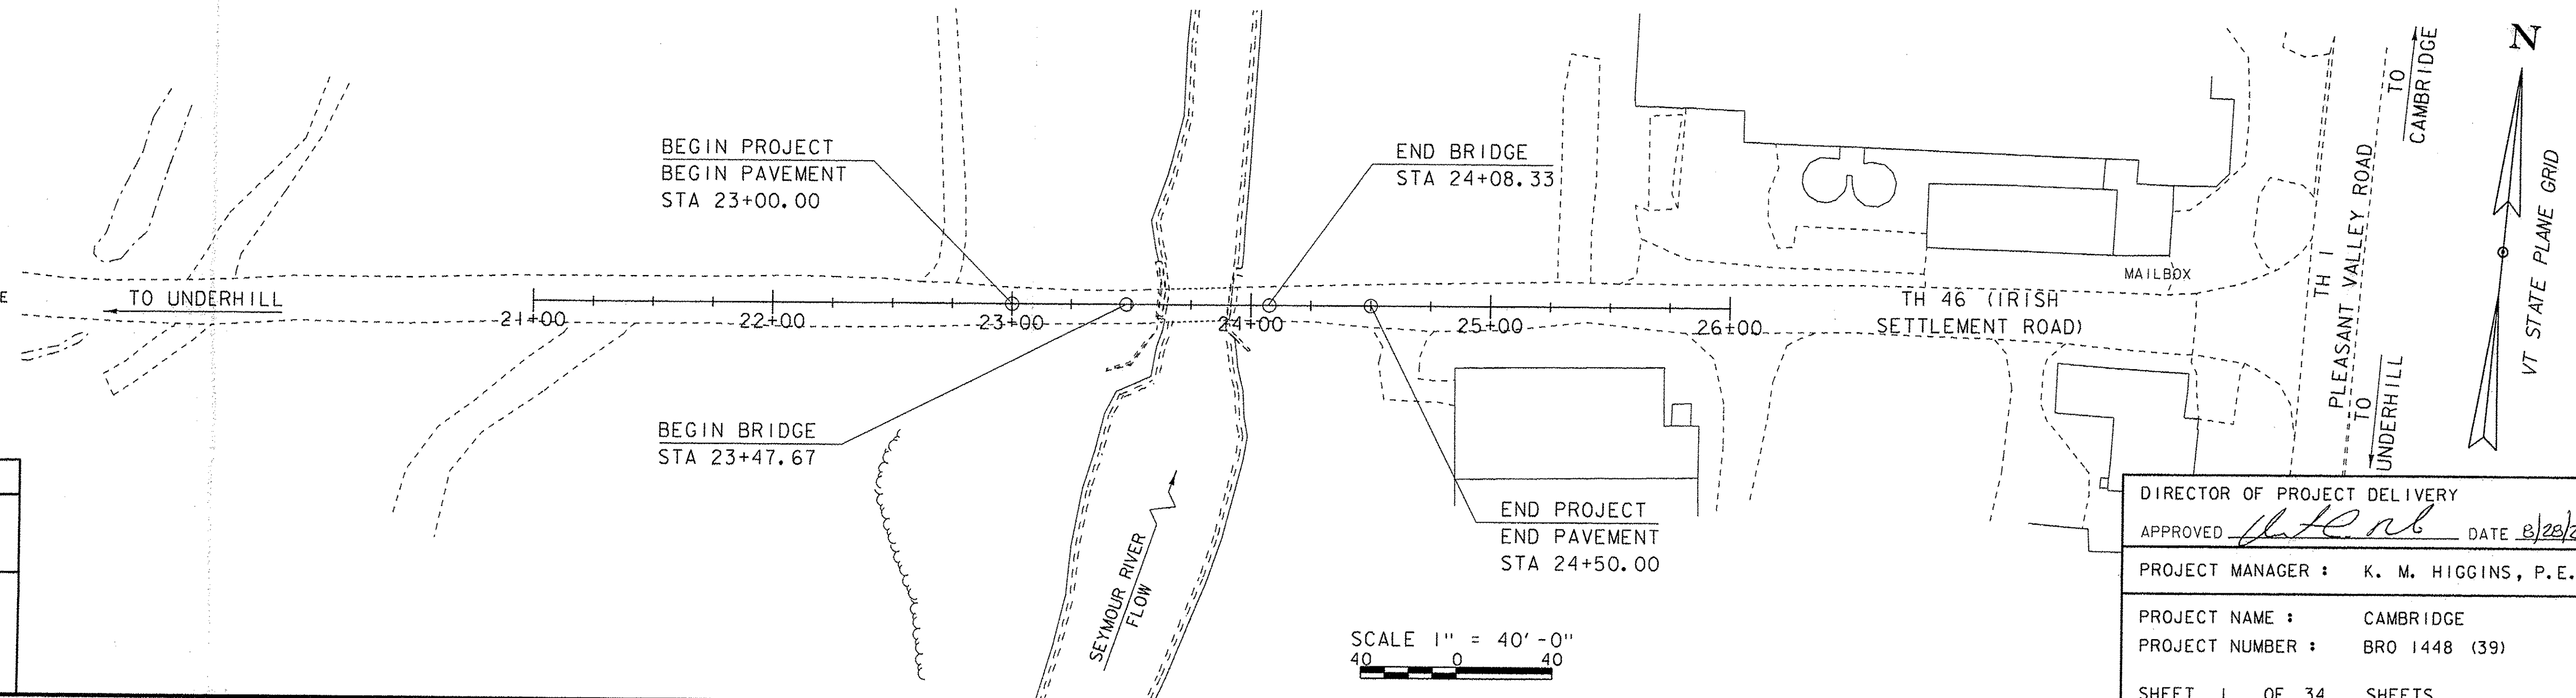

SCALE 1" = 40'-0"
40 0 40

DIRECTOR OF PROJECT DELIVERY	
APPROVED:	DATE 8/28/2014
PROJECT MANAGER : K. M. HIGGINS, P.E.	
PROJECT NAME :	CAMBRIDGE
PROJECT NUMBER :	BRO 1448 (39)
SHEET 1 OF 34 SHEETS	

PRELIMINARY INFORMATION SHEET (BRIDGE)

INDEX OF SHEETS

PLAN SHEETS

1	TITLE SHEET
2	PRELIMINARY INFORMATION
3 - 4	TYPICAL SECTIONS 1 - 2
5 - 6	GENERAL NOTES 1-2
7 - 9	QUANTITY 1 - 3
10	BRIDGE QUANTITY
11	TIE SHEET
12	ALIGNMENT
13	LAYOUT
14	MAINLINE PROFILE
15	DRAINAGE LAYOUT
16	DRAINAGE DETAIL
17	EXISTING UTILITY LAYOUT
18	PROPOSED UTILITY LAYOUT
19	BRIDGE STREET GRAVITY SEWER BRIDGE CROSSING PLAN
20	BRIDGE STREET GRAVITY SEWER BRIDGE CROSSING PROFILE
21	BRIDGE STREET GRAVITY SEWER BRIDGE CROSSING SEWER DETAILS
22	SIGN LAYOUT
23	BORING INFORMATION
24 - 28	BORING LOGS 1 - 5
29	PLAN AND ELEVATION
30	BRIDGE RAIL ELEVATIONS
31	BRIDGE RAIL CONCRETE DETAILS
32	METAL HAND RAILING DETAILS
33	BRIDGE RAIL REINFORCING
34	APPROACH RAIL DETAILS
35	DECK PLAN
36	FRAMING & CROSS FRAME DETAILS
37	GIRDER DETAILS
38 - 39	SPLICE DETAIL 1 - 2
40	BRACING DETAILS
41	FIXED BEARING DETAILS
42	EXPANSION BEARING DETAILS
43	APPROACH SLAB DETAILS
44	ABUTMENT 1
45	ABUTMENT 1 REINFORCING PLAN
46	WING WALLS 1 & 2
47	BACKWALL ABUTMENT 1
48	ABUTMENT 2
49	ABUTMENT 2 REINFORCING AND PILE LAYOUT
50	WING WALLS 3 & 4
51	ABUTMENT 2 BACKWALL DETAILS
52	RETAINING WALL
53	REINFORCING STEEL SCHEDULE SHEET #1
54 - 58	MAINLINE CROSS SECTIONS 1 - 5
59	MATERIAL TRANSITION DIAGRAM
60 - 61	CHANNEL CROSS SECTIONS 1 - 2
62	EPSC NARRATIVE
63	EPSC EXISTING CONDITIONS
64	EPSC DURING CONSTRUCTION
65	EPSC FINAL CONDITIONS
66 - 68	EPSC DETAILS 1 - 3
69	RIGHT OF WAY LAYOUT SHEET
70	RIGHT OF WAY DETAIL SHEET

STANDARDS LIST

A-78	SHARED USE PATH TYPICAL	03-31-2004
A-80	SHARED USE PATH / HIGHWAY INTERSECTION DETAILS	03-31-2004
C-3A	SIDEWALK RAMPS	03-10-2008
C-10	CURBING	02-11-2008
D-1	PRECAST REINFORCED CONCRETE DROP INLET DETAILS	06-01-1994
D-11	STEEL OR IRON GRATES & COVERS (TYPE A)	06-01-1994
D-15	PRECAST REINF CONC. MH-GRATES, CAST IRON GRATE WITH FRAME, TYPE D & E	06-01-1994
E-100	CONSTRUCTION APPROACH SIGNS	01-02-2004
E-102	CONSTRUCTION SIGN DETAILS	06-30-2003
E-102A	CONSTRUCTION SIGN DETAILS	06-01-2004
E-107	DELINEATION, BARRICADES AND DETOURS FOR CONSTRUCTION AREAS	06-30-2003
E-107A	BREAKAWAY BARRICADE DETAILS	06-08-2009
E-121	STANDARD SIGN PLACEMENT - CONVENTIONAL ROAD	08-08-1995
E-134	BRIDGE NUMBER PLAQUE	08-08-1995
E-164	SQUARE STEEL SIGN POST	06-08-2009
E-193	PAVEMENT MARKING DETAILS	08-18-1995
E-195	SHARED USE PATH PAVEMENT MARKINGS AND SIGN DETAILS	06-09-2008
F-2	CHAIN LINK FENCE, TYPE I DETAILS	06-01-1994
G-1	STEEL BEAM GUARDRAIL DETAILS (POST, DELINEATOR, TYPICALS)	01-03-2000
G-1D	STEEL BEAM GUARDRAIL DETAILS (END TERMINAL, ANCHOR, MEDIAN)	01-03-2000

FINAL HYDRAULIC REPORT

HYDROLOGIC DATA Date: vised October 2010

DRAINAGE AREA : 34.0 sq. mi.
 CHARACTER OF TERRAIN : Hilly to mountainous, mostly rural, mostly forested
 STREAM CHARACTERISTICS : Sinuous, incised, gorge at bridge site
 NATURE OF STREAMBED : Mixed upstream, ledge at bridge

PEAK FLOW DATA

Q 2.33 =	1600 cfs	Q 50 =	5950 cfs
Q 10 =	3325 cfs	Q 100 =	7225 cfs
Q 25 =	4750 cfs	Q 500 =	10,850 cfs

DATE OF FLOOD OF RECORD : 1927
 ESTIMATED DISCHARGE : unknown
 WATER SURFACE ELEV. : unknown
 NATURAL STREAM VELOCITY : @ Q25 = 25.2 fps
 ICE CONDITIONS : moderate
 DEBRIS : moderate
 DOES THE STREAM REACH MAXIMUM HIGHWATER ELEV. RAPIDLY? no
 IS ORDINARY RISE RAPID? no
 IS STAGE AFFECTED BY UPSTREAM OR DOWNSTREAM CONDITIONS? no
 IF YES, DESCRIBE :

PROPOSED STRUCTURE

STRUCTURE TYPE: Single span curved steel girder

CLEAR SPAN(NORMAL TO STREAM): 118'
 VERTICAL CLEARANCE ABOVE STREAMBED: 38'
 WATERWAY OF FULL OPENING: 2145 sq. ft.

WATER SURFACE ELEVATIONS AT:

Q2.33 =	#REF!	VELOCITY=	21.2 fps
Q10 =	#REF!	"	24.1 fps
Q25 =	#REF!	"	25.8 fps
Q50 =	#REF!	"	26.8 fps
Q100 =	#REF!	"	27.7 fps

IS THE ROADWAY OVERTOPPED BELOW Q100: No
 FREQUENCY: N/A
 RELIEF ELEVATION: 734.3'
 DISCHARGE OVER ROAD @Q100: N/A

AVERAGE LOW ELEVATION OF SUPERSTRUCTURE: 732.3'
 VERTICAL CLEARANCE: @ Q25 = 20.8'

SCOUR: Abutments to be founded on ledge

REQUIRED CHANNEL PROTECTION: Stone Fill, Type II

PERMIT INFORMATION

AVERAGE DAILY FLOW: 70 cfs DEPTH OR ELEVATION:
 ORDINARY LOW WATER: 30 cfs 1.5'
 ORDINARY HIGH WATER: 700 cfs 4.0'

TEMPORARY BRIDGE REQUIREMENTS

STRUCTURE TYPE: None required
 CLEAR SPAN (NORMAL TO STREAM):
 VERTICAL CLEARANCE ABOVE STREAMBED:
 WATERWAY AREA OF FULL OPENING:

ADDITIONAL INFORMATION

TRAFFIC MAINTENANCE NOTES

1. MAINTAIN TRAFFIC ON AN OFF SITE DETOUR.
2. TRAFFIC SIGNALS ARE NOT NECESSARY.
3. SIDEWALKS ARE NOT NECESSARY

DESIGN VALUES

1. DESIGN LIVE LOAD	HL-93
2. FUTURE PAVEMENT	d _p : 3.0 INCH
3. DESIGN SPAN	L: 120.00 FT
4. MIN. MID-SPAN POS. CAMBER @ RELEASE (PRESTRESSED UNITS)	Δ: --- INCH
5. PRESTRESSING STRAND (0.60 INCH DIAMETER - LOW RELAX)	f _y : 270 KSI
6. PRESTRESSED CONCRETE STRENGTH	f' _c : 6.0 KSI
7. PRESTRESSED CONCRETE RELEASE STRENGTH	f' _{cr} : 5.0 KSI
8. CONCRETE, HIGH PERFORMANCE CLASS AA	f' _c : ---
9. CONCRETE, HIGH PERFORMANCE CLASS A	f' _c : 4.0 KSI
10. CONCRETE, HIGH PERFORMANCE CLASS B	f' _c : 3.5 KSI
11. CONCRETE, CLASS C	f' _c : 3.0 KSI
12. REINFORCING STEEL	f _y : 60 KSI
13. STRUCTURAL STEEL AASHTO M270 (WEATHERING)	f _y : 50 KSI
14. SOIL UNIT WEIGHT	γ: 0.140 KCF
15. NOMINAL BEARING RESISTANCE OF SOIL	q _n : ---
16. SOIL BEARING RESISTANCE FACTOR (REFER TO AASHTO LRFD)	φ: ---
17. NOMINAL BEARING RESISTANCE OF ROCK	q _n : 22.2 KSF
18. ROCK BEARING RESISTANCE FACTOR (REFER TO AASHTO LRFD)	φ: 0.45
19. NOMINAL AXIAL PILE RESISTANCE	q _p : ---
20. PILE YIELD STRENGTH ASTM A572	f _y : 50 KSI
21. PILE SIZE	HP 14X117
22. EST. AVG. PILE LENGTH	L _p : 25 FT
23. PILE RESISTANCE FACTOR	φ: 0.65
24. LATERAL PILE DEFLECTION	Δ: ---
25. BASIC WIND SPEED	V _{3s} : ---
26. MINIMUM GROUND SNOW LOAD	p _g : ---
27. SEISMIC DATA	PGA: --- S _s : --- S ₁ : ---

EXISTING STRUCTURE INFORMATION

STRUCTURE TYPE: Single span steel beam bridge
 YEAR BUILT: 1949
 CLEAR SPAN(NORMAL TO STREAM): 89'
 VERTICAL CLEARANCE ABOVE STREAMBED: 36' +/-
 WATERWAY OF FULL OPENING: 1965 sq. ft.
 DISPOSITION OF STRUCTURE: Replace
 TYPE OF MATERIAL UNDER SUBSTRUCTURE: See borings

WATER SURFACE ELEVATIONS AT:

Q2.33 =	707.9'	VELOCITY =	21.2 fps
Q10 =	710.1'	"	24.1 fps
Q25 =	711.5'	"	25.8 fps
Q50 =	712.6'	"	26.8 fps
Q100 =	713.7'	"	27.7 fps

LONG TERM STREAMBED CHANGES: None noted

IS THE ROADWAY OVERTOPPED BELOW Q100: No
 FREQUENCY: N/A
 RELIEF ELEVATION: 732.6'
 DISCHARGE OVER ROAD @Q100: N/A

UPSTREAM STRUCTURE

TOWN: Barre Town DISTANCE: 2000'
 HIGHWAY #: VT 63 STRUCTURE #: BR 5
 CLEAR SPAN: 15' + 15' = 30' CLEAR HEIGHT: 12'
 YEAR BUILT: 1970 FULL WATERWAY: 360 sf
 STRUCTURE TYPE: Twin cell RC Box

DOWNSTREAM STRUCTURE

TOWN: Barre Town DISTANCE: 3200'
 HIGHWAY #: Parkside Terrace STRUCTURE #: BR 13
 CLEAR SPAN: 82' CLEAR HEIGHT: 26'
 YEAR BUILT: 1997 FULL WATERWAY: 1750 sf
 STRUCTURE TYPE: Welded plate girder

LRFR LOAD RATING FACTORS

LOADING LEVELS	TRUCK						
	H-20	HL-93	3S2	6 AXLE	3A STR.	4A STR.	5A SEMI
TONNAGE	20	36	36	66	30	34.5	38
INVENTORY	2.47	1.1					
POSTING							
OPERATING	3.2	1.42	2.11	1.46	2.2	2.11	2.15
COMMENTS:							

STRUCTURAL DETAIL SHEETS

SD-501.00	CONCRETE DETAILS AND NOTES
SD-502.00	CONCRETE DETAILS AND NOTES
SD-516.10	BRIDGE JOINT, ASPHALTIC PLUG
SD-601.00	STRUCTURAL STEEL DETAILS AND NOTES
SD-602.00	STRUCTURAL STEEL PLATE GIRDER AND NOTES

LOADING LEVELS	LRFR LOAD RATING FACTORS						
	H-20	HL-93	3S2	6 AXLE	3A STR.	4A STR.	5A SEMI
TONNAGE	20	36	36	66	30	34.5	38
INVENTORY	2.22	1.22					
POSTING							
OPERATING	2.87	1.58	2.69	1.59	2.06	1.87	2.18
COMMENTS:							

NOTE: LOAD RATINGS TABLE
 VALUES CHANGED PER
 G. LAROCHE (PROJ. ENGINEER)

TRAFFIC DATA

YEAR	ADT	DHV	% D	% T	ADTT	20 year ESAL for flexible pavement from 2013 to 2033 : 594000
2013	3400	380	53	3	180	40 year ESAL for flexible pavement from 2013 to 2053 : 1323000
2033	4100	460	53	3.6	260	Design Speed : 25 mph

PILE DRIVING AND TESTING REQUIREMENTS

1. NOMINAL PILE DRIVING CAPACITY R_{nd} : 627.00 KIP
2. PILE TEST RESISTANCE FACTOR ϕ : 0.65
3. MAXIMUM PILE TIP ELEVATION VARIES
4. THREE DYNAMIC PILES TESTS REQUIRED

PROJECT NAME: BARRE TOWN

PROJECT NUMBER: BRF 6100(7)

FILE NAME: s06j002pi.xls PLOT DATE: 9/19/2012
 PROJECT LEADER: J. LACROIX DRAWN BY: R. PELLETT
 DESIGNED BY: T. FILLBACH CHECKED BY: T. FILLBACH
PRELIMINARY INFORMATION SHEET 1 SHEET 2 OF 70

GENERAL INFORMATION

SYMBOLY LEGEND NOTE

THE SYMBOLY ON THIS SHEET IS INTENDED TO COVER STANDARD CONVENTIONAL SYMBOLY. THE SYMBOLY IS USED FOR EXISTING & PROPOSED FEATURES WITH HEAVIER LINEWEIGHT, IN COMBINATION WITH PROJECT ANNOTATION, AS NOTED ON PROJECT PLAN SHEETS. THIS LEGEND SHEET COVERS THE BASICS. SYMBOLY ON PLANS MAY VARY, PLAN ANNOTATIONS AND NOTES SHOULD BE USED TO CLARIFY AS NEEDED.

R.O.W. ABBREVIATIONS (CODES) & SYMBOLS

POINT CODE	DESCRIPTION
CH	CHANNEL EASEMENT
CONST	CONSTRUCTION EASEMENT
CUL	CULVERT EASEMENT
D&C	DISCONNECT & CONNECT
DIT	DITCH EASEMENT
DR	DRAINAGE EASEMENT
DRIVE	DRIVEWAY EASEMENT
EC	EROSION CONTROL
HWY	HIGHWAY EASEMENT
I&M	INSTALL & MAINTAIN EASEMENT
LAND	LANDSCAPE EASEMENT
R&RES	REMOVE & RESET
R&REP	REMOVE & REPLACE
SR	SLOPE RIGHT
UE	UTILITY EASEMENT
(P)	PERMANENT EASEMENT
(T)	TEMPORARY EASEMENT
■	BNDNS BOUND SET
▣	BNDNS BOUND TO BE SET
●	IPNS IRON PIN SET
◎	IPNS IRON PIN TO BE SET
⊠	CALC EXISTING ROW POINT
○	PROW PROPOSED ROW POINT
[LENGTH]	LENGTH CARRIED ON NEXT SHEET

COMMON TOPOGRAPHIC POINT SYMBOLS

POINT CODE	DESCRIPTION
※	APL BOUND APPARENT LOCATION
□	BM BENCHMARK
□	BND BOUND
▣	CB CATCH BASIN
⊕	COMB COMBINATION POLE
▣	DITHR DROP INLET THROATED DNC
⊕	EL ELECTRIC POWER POLE
○	FPOLE FLAGPOLE
○	GASFIL GAS FILLER
○	GP GUIDE POST
×	GSO GAS SHUT OFF
○	GUY GUY POLE
○	GUYW GUY WIRE
×	GV GATE VALUE
⊗	H TREE HARDWOOD
△	HCTRL CONTROL HORIZONTAL
△	HVCTRL CONTROL HORIZ. & VERTICAL
◇	HYD HYDRANT
●	IP IRON PIN
●	IPIPE IRON PIPE
⊕	LI LIGHT - STREET OR YARD
□	MB MAILBOX
○	MH MANHOLE (MH)
□	MM MILE MARKER
●	PM PARKING METER
□	PMK PROJECT MARKER
○	POST POST STONE/WOOD
⊗	RRSIG RAILROAD SIGNAL
⊕	RRSL RAILROAD SWITCH LEVER
⊕	S TREE SOFTWOOD
⊕	SAT SATELLITE DISH
⊗	SHRUB SHRUB
⊕	SIGN SIGN
⊕	STUMP STUMP
⊕	TEL TELEPHONE POLE
○	TIE TIE
⊕	TSIGN SIGN W/DOUBLE POST
⊕	VCTRL CONTROL VERTICAL
○	WELL WELL
×	WSO WATER SHUT OFF

THESE ARE COMMON VAOT SURVEY POINT SYMBOLS FOR EXISTING FEATURES, ALSO USED FOR PROPOSED FEATURES WITH HEAVIER LINEWEIGHT, IN COMBINATION WITH PROPOSED ANNOTATION.

PROPOSED GEOMETRY CODES

CODE	DESCRIPTION
PC	POINT OF CURVATURE
PI	POINT OF INTERSECTION
CC	CENTER OF CURVE
PT	POINT OF TANGENCY
PCC	POINT OF COMPOUND CURVE
PRC	POINT OF REVERSE CURVE
POB	POINT OF BEGINNING
POE	POINT OF ENDING
STA	STATION PREFIX
AH	AHEAD STATION SUFFIX
BK	BACK STATION SUFFIX
D	CURVE DEGREE OF (100FT)
R	CURVE RADUIS OF
T	CURVE TANGENT LENGTH
L	CURVE LENGTH OF
E	CURVE EXTERNAL DISTANCE

UTILITY SYMBOLY

UNDERGROUND UTILITIES

— UGU —	UTILITY (GENERIC-UNKNOWN)
— UT —	TELEPHONE
— UE —	ELECTRIC
— UC —	CABLE (TV)
— UEC —	ELECTRIC+CABLE
— UET —	ELECTRIC+TELEPHONE
— UCT —	CABLE+TELEPHONE
— UECT —	ELECTRIC+CABLE+TELEP.
— G —	GAS LINE
— W —	WATER LINE
— S —	SANITARY SEWER (SEPTIC)

ABOVE GROUND UTILITIES (AERIAL)

— AGU —	UTILITY (GENERIC-UNKNOWN)
— T —	TELEPHONE
— E —	ELECTRIC
— C —	CABLE (TV)
— EC —	ELECTRIC+CABLE
— ET —	ELECTRIC+TELEPHONE
— AER E&T —	ELECTRIC+TELEPHONE
— CT —	CABLE+TELEPHONE
— ECT —	ELECTRIC+CABLE+TELEP.
— — —	UTILITY POLE GUY WIRE

PROJECT CONSTRUCTION SYMBOLY

PROJECT DESIGN & LAYOUT SYMBOLY

— — — CZ — — —	CLEAR ZONE
— — — — —	PLAN LAYOUT MATCHLINE

PROJECT CONSTRUCTION FEATURES

△ — △ — △ — △	TOP OF CUT SLOPE
○ — ○ — ○ — ○	TOE OF FILL SLOPE
⊗ ⊗ ⊗ ⊗ ⊗ ⊗	STONE FILL
— — — — —	BOTTOM OF DITCH
— — — — —	CULVERT PROPOSED
— — — — —	STRUCTURE SUBSURFACE
PDF — PDF —	PROJECT DEMARCATION FENCE
BF — — — — BF — — — —	BARRIER FENCE
XXXXXXXXXXXXXXXXXXXX	TREE PROTECTION ZONE (TPZ)
//// //// //// ////	STRIPING LINE REMOVAL
~~~~ ~~~~ ~~~~ ~~~~	SHEET PILES

**CONVENTIONAL BOUNDARY SYMBOLY**

**BOUNDARY LINES**

— TOWN LINE —	TOWN BOUNDARY LINE
— COUNTY LINE —	COUNTY BOUNDARY LINE
— STATE LINE —	STATE BOUNDARY LINE
— — — — —	PROPOSED STATE R.O.W. (LIMITED ACCESS)
— — — — —	PROPOSED STATE R.O.W.
— — — — —	STATE ROW (LIMITED ACCESS)
— — — — —	STATE ROW
— — — — —	TOWN ROW
— — — — —	PERMANENT EASEMENT LINE (P)
— — — — —	TEMPORARY EASEMENT LINE (T)
— — — — —	SURVEY LINE
— P — — — — — P — — — — —	PROPERTY LINE (P/L)
— SR — — — — — SR — — — — — SR — — — — —	SLOPE RIGHTS
6f — — — — — 6f — — — — —	6F PROPERTY BOUNDARY
4f — — — — — 4f — — — — —	4F PROPERTY BOUNDARY
HAZ — — — — — HAZ — — — — —	HAZARDOUS WASTE

**EPSC LAYOUT PLAN SYMBOLY**

**EPSC MEASURES**

ONNOONNOONNO	FILTER CURTAIN
— — — — —	SILT FENCE
— — — — —	SILT FENCE WOVEN WIRE
— — — — —	CHECK DAM
▣	DISTURBED AREAS REQUIRING RE-VEGETATION
⊗	EROSION MATTING

**ENVIRONMENTAL RESOURCES**

— — — — —	WETLAND BOUNDARY
— — — — —	RIPARIAN BUFFER ZONE
— — — — —	WETLAND BUFFER ZONE
— — — — —	SOIL TYPE BOUNDARY
— T&E — — — — —	THREATENED & ENDANGERED SPECIES
— HAZ — — — — — HAZ — — — — —	HAZARDOUS WASTE AREA
— AG — — — — —	AGRICULTURAL LAND
— HABITAT — — — — —	FISH & WILDLIFE HABITAT
— FLOOD PLAIN — — — — —	FLOOD PLAIN
— OHW — — — — —	ORDINARY HIGH WATER (OHW)
— — — — —	STORM WATER
— — — — —	USDA FOREST SERVICE LANDS
— — — — —	WILDLIFE HABITAT SUIT/CONN

**ARCHEOLOGICAL & HISTORIC**

— ARCH — — — — —	ARCHEOLOGICAL BOUNDARY
— HISTORIC DIST — — — — —	HISTORIC DISTRICT BOUNDARY
— HISTORIC — — — — —	HISTORIC AREA
Ⓜ	HISTORIC STRUCTURE

**CONVENTIONAL TOPOGRAPHIC SYMBOLY**

**EXISTING FEATURES**

— — — — —	ROAD EDGE PAVEMENT
— — — — —	ROAD EDGE GRAVEL
— — — — —	DRIVEWAY EDGE
— — — — —	DITCH
— — — — —	FOUNDATION
— — — — —	FENCE (EXISTING)
— — — — —	FENCE WOOD POST
— — — — —	FENCE STEEL POST
— — — — —	GARDEN
— — — — —	ROAD GUARDRAIL
— — — — —	RAILROAD TRACKS
— — — — —	CULVERT (EXISTING)
— — — — —	STONE WALL
— — — — —	WALL
— — — — —	WOOD LINE
— — — — —	BRUSH LINE
— — — — —	HEDGE
— — — — —	BODY OF WATER EDGE
— — — — —	LEDGE EXPOSED

PROJECT NAME: CAMBRIDGE  
 PROJECT NUMBER: BRO 1448 (39)  
 FILE NAME: I2J166Legend.dgn  
 PROJECT LEADER: K. HIGGINS  
 DESIGNED BY: G. LAROCHE  
 LEGEND SHEET  
 PLOT DATE: 29-AUG-2014  
 DRAWN BY: K. FRIEDLAND  
 CHECKED BY: J. SALVATORI  
 SHEET 3 OF 34

**GENERAL**

1. ALL MATERIALS AND CONSTRUCTION SHALL CONFORM TO THE VERMONT AGENCY OF TRANSPORTATION 2011 STANDARD SPECIFICATIONS FOR CONSTRUCTION, THE 2012 AASHTO LRFD BRIDGE DESIGN SPECIFICATIONS, AND THEIR LATEST REVISIONS.
2. ALL DIMENSIONS ARE HORIZONTAL OR VERTICAL, AND ARE GIVEN AT 68 DEGREES FAHRENHEIT, UNLESS NOTED OTHERWISE.
3. THERE IS A WATER AND ELECTRIC LINE ON THE EXISTING BRIDGE THAT WILL BE REMOVED PRIOR TO CONSTRUCTION. WORK TO BE PERFORMED BY OTHERS.

**TRAFFIC CONTROL**

4. THE CONTRACTOR SHALL BE RESPONSIBLE FOR THE DESIGN AND IMPLEMENTATION OF A SITE SPECIFIC TRAFFIC CONTROL PLAN FOR ALL STAGES OF CONSTRUCTION. THE PLAN SHALL CLEARLY DETAIL HOW TRAFFIC WILL BE MAINTAINED. THE PLAN SHALL SPECIFY ALL CONSTRUCTION ACTIVITIES REQUIRING ALTERNATING ONE WAY TRAFFIC, RELATE THOSE ACTIVITIES TO THE CONSTRUCTION SCHEDULE AND SHOW APPROPRIATE TEMPORARY TRAFFIC CONTROL. THE CONTRACTOR SHALL SUBMIT DETAILED TRAFFIC CONTROL PLANS TO THE ENGINEER FOR APPROVAL PER SUBSECTION 105.03. ALL COSTS SHALL BE INCLUDED IN ITEM 900.645 "SPECIAL PROVISION (TRAFFIC CONTROL, ALL-INCLUSIVE)".
5. ALL ITEMS REQUIRED TO IMPLEMENT THE CONTRACTOR'S TRAFFIC CONTROL PLAN WILL NOT BE PAID FOR DIRECTLY BUT WILL BE CONSIDERED INCLUDED IN THE BID PRICE FOR ITEM 900.645, "SPECIAL PROVISION (TRAFFIC CONTROL, ALL-INCLUSIVE)".
6. INSTALLATION OF TEMPORARY TRAFFIC CONTROL SIGNS SHALL NOT BLOCK ANY EXISTING TRAFFIC CONTROL SIGN ASSEMBLIES. THE CONTRACTOR SHALL TRY TO MAINTAIN AT LEAST 200 FEET BETWEEN SIGN ASSEMBLIES.
7. THE TOWN OF CAMBRIDGE SHALL BE RESPONSIBLE FOR CHOOSING AND SIGNING THE DETOUR ROUTE. THE CONTRACTOR SHALL NOTIFY THE TOWN A MINIMUM OF TWO WEEKS IN ADVANCE OF THE BRIDGE CLOSURE PERIOD.

**EARTHWORK**

8. THE "STONE FILL, TYPE III" UNDER THE BRIDGE AS SHOWN IN THE PLANS SHALL BE PLACED BEFORE THE NEW BEAMS ARE SET.
9. REMOVAL OF THE EXISTING STRUCTURE SHALL BE PAID FOR UNDER ITEM 529.15, "REMOVAL OF STRUCTURE". THIS WORK SHALL INCLUDE REMOVAL OF ANY PORTIONS OF THE EXISTING ABUTMENTS THAT FALL OUTSIDE THE LIMITS OF STRUCTURE EXCAVATION OR UNCLASSIFIED CHANNEL EXCAVATION.

**CONCRETE**

10. WATER REPELLENT, SILANE SHALL BE FURNISHED IN ACCORDANCE WITH SECTION 514. SILANE SHALL BE SHOP APPLIED TO ALL EXPOSED CONCRETE ON THE BRIDGE SUPERSTRUCTURE AND SUBSTRUCTURE, WITH THE EXCEPTION OF THE BOTTOM OF THE PRECAST NEXT BEAMS BETWEEN THE DRIP NOTCHES. PAYMENT FOR SILANE WILL BE INCLUDED IN THE UNIT PRICE BID FOR THE APPROPRIATE PRECAST ITEM.
11. ALL PRECAST CONCRETE ELEMENTS TO BE FABRICATED TO THE SPECIFIED DIMENSIONS WITHIN THE TOLERANCES DICTATED IN THE PRECAST/PRESTRESSED CONCRETE INSTITUTE TOLERANCE MANUAL FOR PRECAST AND PRESTRESSED CONCRETE CONSTRUCTION, MNL 135-00, AND ITS LATEST REVISIONS.

**REINFORCING STEEL**

12. ALL REINFORCING STEEL SHALL BE DETAILED AND FABRICATED USING PROCEDURES AND TOLERANCES IN ACCORDANCE WITH APPLICABLE PUBLICATIONS OF THE "CONCRETE REINFORCING STEEL INSTITUTE".
13. TEST BARS SHALL BE PROVIDED IN ACCORDANCE WITH THE "VERMONT AGENCY OF TRANSPORTATION MATERIAL SAMPLING MANUAL" AVAILABLE ON THE AGENCY WEBSITE. A MINIMUM OF TWO TEST SECTIONS ARE REQUIRED FOR EACH SIZE, BRAND, AND GRADE OR TYPE OF REINFORCING. SEE THE MANUAL FOR ACCEPTABLE DIMENSIONS OF TEST SECTIONS. ALL COSTS ASSOCIATED WITH PROVIDING BARS FOR TESTING SHALL BE INCLUDED IN THE UNIT PRICE BID FOR THE APPROPRIATE PRECAST ITEM.
14. ALL REINFORCING STEEL SHALL MEET THE REQUIREMENTS OF SECTION 507 FOR "REINFORCING STEEL, LEVEL II".
15. ALL REINFORCING STEEL INSIDE THE CLOSURE POURS SHALL BE PAID FOR UNDER ITEM 507.12 REINFORCING STEEL, LEVEL II (FPQ).
16. MINIMUM CLEAR COVER FOR REINFORCING STEEL SHALL BE AS FOLLOWS:

ALONG TOP SURFACE OF DECK SLAB:	2.5 INCH
ALONG BOTTOM SURFACE OF DECK SLAB:	1 1/4 INCH
ELSEWHERE UNLESS OTHERWISE INDICATED:	3 INCH

**PRECAST ABUTMENTS AND POST-TENSIONING**

17. IF A VERTICAL CONSTRUCTION JOINT IS REQUIRED BY THE CONTRACTOR FOR SHIPMENT OF THE ABUTMENTS, THE SECTIONS SHALL BE KEYED AND MATCH CAST. A JOINT DETAIL SHALL BE SHOWN ON THE FABRICATION DRAWINGS. NO LESS THAN TWO PILES SHALL SUPPORT EACH PRECAST ABUTMENT SECTION.
18. EPOXY BOUNDING COMPOUND SHALL BE APPLIED TO ALL VERTICAL MATCH CAST CONSTRUCTION JOINTS. SEE AGENCY WEBSITE FOR LIST OF APPROVED EPOXY BOUNDING COMPOUNDS. PAYMENT FOR EPOXY WILL BE INCLUDED IN THE UNIT PRICE BID FOR THE APPROPRIATE PRECAST ITEM.
19. POST-TENSIONING AND ASSOCIATED ITEMS ARE ONLY REQUIRED IF THE PILE CAP IS CONSTRUCTED OF MORE THAN ONE UNIT. ANY POST-TENSIONING STRANDS AND CONDUIT SHALL ADHERE TO THE REQUIREMENTS OF SECTION 510 – PRESTRESSED CONCRETE. GALVANIZED ANCHOR ASSEMBLIES, CONDUIT, AND POST-TENSIONING STRANDS SHALL BE INCLUDED IN THE UNIT PRICE BID FOR THE APPROPRIATE PRECAST ITEM. POST-TENSIONING STRANDS SHALL BE COVERED WITH SEAMLESS POLYPROPYLENE SHEATH (WITH CORROSION INHIBITOR GREASE BETWEEN SHEATH AND STRAND) FOR THE LENGTH OF THE STRAND, EXCEPT AT ANCHORAGE LOCATIONS.
20. GALVANIZE ANCHOR ASSEMBLIES AFTER FABRICATION ACCORDING TO AASHTO M232/M 232.
21. DESIGN VALUES
  - a. CONCRETE COMPRESSIVE STRENGTH:  $f_c = 5,000$  PSI.
  - b. POST-TENSIONING STRANDS: 0.5 INCH DIAMETER, 270 KSI, LOW RELAXATION 7-WIRE STRANDS.
  - c. ASSUMED MODULUS OF ELASTICITY IS 28,500 KSI.
  - d. THERE SHALL BE 2 STRANDS PER CONDUIT.
  - e. THE JACKING FORCE PER STRAND = 32 KIPS
22. THE CORRUGATED STEEL PIPE SHALL MEET THE REQUIREMENTS OF SUBSECTION 711.01. ALL COSTS ASSOCIATED WITH PLACING THE CORRUGATED STEEL PIPE, SHALL BE INCLUDED IN THE UNIT PRICE BID FOR THE APPROPRIATE PRECAST ITEM..
23. THE CONCRETE FOR THE ABUTMENT PILE CAVITIES SHALL BE PAID FOR UNDER ITEM 900.608 SPECIAL PROVISION (HIGH PERFORMANCE CONCRETE, RAPID SET) (FPQ). SEE SPECIAL PROVISIONS FOR REQUIREMENTS.

**NEXT D BEAMS**

24. NEXT D BEAMS ARE A NON-PROPRIETARY SHAPE DEVELOPED BY PCI NORTHEAST (PCINE). STANDARDIZED SECTION PROPERTIES AND DETAILS MAY BE FOUND AT <http://www.pcine.org>.
25. DESIGN VALUES
  - a. CONCRETE COMPRESSIVE STRENGTH:  $f_c = 8,000$  PSI.
  - b. CONCRETE COMPRESSIVE STRENGTH AT RELEASE:  $f_{ci} = 6,000$  PSI
  - c. PRESTRESSING STRANDS: 0.6 INCH DIAMETER, 270 KSI, LOW-RELAXATION 7-WIRE STRANDS
  - d. ASSUMED MODULUS OF ELASTICITY = 28,500 KSI.
  - e. PRESTRESSING STRANDS SHALL EACH BE PULLED TO HAVE A NET TENSION OF 44.0 KIPS AFTER ACCOUNTING FOR CHUCK SLIPPAGE.
  - f. SERVICE LOADS
 

MEMBER MOMENT	549 K-FT
SUPERIMPOSED DEAD LOAD MOMENT	108 K-FT
LIVE LOAD AND IMPACT MOMENT	938 K-FT
DEAD LOAD REACTION	54 KIPS
LIVE LOAD AND IMPACT REACTION	82 KIPS
TOTAL REACTION	136 KIPS
CAMBER AT RELEASE	1 1/8 INCHES
FINAL CAMBER	1 13/16 INCHES

26. FORMING FOR ENDS OF FLANGES ALONG LONGITUDINAL CLOSURE POURS SHALL BE TREATED WITH CONCRETE SURFACE RETARDER, OR SIMILAR, TO PROVIDE A ROUGHENED / EXPOSED AGGREGATE SURFACE; AND SHALL BE POWER WASHED WITH WATER PRIOR TO ERECTION OF THE BEAMS.
27. THE CONCRETE FOR FLANGE CLOSURE POURS SHALL BE PAID FOR UNDER ITEM 900.608 SPECIAL PROVISION (HIGH PERFORMANCE CONCRETE, RAPID SET) (FPQ). SEE SPECIAL PROVISIONS FOR REQUIREMENTS.
28. METHOD OF FORMING FLANGE CONNECTION SHALL BE DETERMINED BY THE CONTRACTOR. THE FORMS SHALL BE REMOVABLE AND ABLE TO ACCOMMODATE DIFFERENTIAL CAMBER. FORM SUPPORTS SHALL NOT BE ATTACHED TO ANY PREFABRICATED SUPERSTRUCTURE ELEMENT BY DRILLING OR SIMILAR MEANS.
29. THE FABRICATOR MAY ALTER THE DESIGN AS DETAILED IN THESE PLANS TO ACCOMMODATE THEIR SPECIFIC OPERATION. THIS ALTERATION SHALL BE DESIGNED BY A PROFESSIONAL ENGINEER LICENSED IN STATE OF VERMONT TO MEET SPECIFIED CRITERIA AND SHALL BE APPROVED BY THE PROJECT MANAGER.

**H-PILES**

30. THE PILES SHALL BE HP 12X63
31. TO PREVENT DAMAGE TO THE PILES, PILE SHOES ARE REQUIRED FOR DRIVEN PILES AND SHALL CONFORM TO SUBSECTION 505.04 (f).
32. THE PILES SHALL BE DRIVEN TO A NOMINAL PILE DRIVING RESISTANCE ( $R_{NDR}$ ) OF 280 KIPS, PROVIDED A MINIMUM PENETRATION OF 25 FEET BELOW THE BOTTOM OF PILE CAP HAS BEEN ACHIEVED.
33. A MINIMUM OF ONE DYNAMIC PILE TESTS SHALL BE CONDUCTED AT EACH ABUTMENT. PAYMENT WILL BE MADE UNDER ITEM 505.45, "DYNAMIC PILE LOADING TEST".
34. THE TOPS OF THE PILES AFTER DRIVING SHALL NOT VARY FROM THE POSITION SHOWN ON THE PLANS BY MORE THAN 3 INCHES. THE PILE ORIENTATION SHALL NOT VARY BY MORE THAN 5 DEGREES. THE CONTRACTOR SHALL DEMONSTRATE HOW THE TOLERANCES WILL BE MET TO THE SATISFACTION OF THE ENGINEER. THESE MEASURES SHALL BE DEMONSTRATED IN A SUBMITTAL TO BE ACCEPTED BEFORE PILE DRIVING COMMENCES.
35. FOR ESTIMATING PURPOSES, THE PILE TIP ELEVATIONS WERE ASSUMED AS SHOWN ON THE BORING LOGS. THE ACTUAL IN PLACE LENGTHS MAY VARY.

**ABUTMENT CLOSURE/END DIAPHRAGM**

36. THE CONCRETE FOR THE ABUTMENT CLOSURE POUR SHALL BE MADE WITH HPC RAPID SET CONCRETE IN ACCORDANCE WITH ITEM 900.608, "SPECIAL PROVISION (HIGH PERFORMANCE CONCRETE, RAPID SET) (FPQ)". SEE SPECIAL PROVISIONS FOR REQUIREMENTS.
37. AFTER THE CONCRETE HAS BEEN PLACED AND THE FINISHING OPERATIONS CONCLUDED, IT SHALL NOT BE WALKED ON OR DISTURBED IN ANY MANNER, INCLUDING THE REMOVAL OF FORMS FOR 12 HOURS.
38. THE CONCRETE SHALL OBTAIN A STRENGTH OF 4000 PSI PRIOR TO ANY VEHICULAR LOADING.

**MISCELLANEOUS**

39. SHEET MEMBRANE WATERPROOFING, PREFORMED SHEET SHALL MEET THE REQUIREMENTS OF SUBSECTION 540.02 OF THE GENERAL SPECIAL PROVISIONS, DATED MAY 6, 2014; AND SHALL BE APPLIED TO THE ENTIRE FAR FACE OF THE ABUTMENT ABOVE THE BRIDGE SEAT AND EXTENDING A MINIMUM OF ONE (1) FOOT BELOW THE BRIDGE SEAT. PAYMENT FOR MEMBRANE WILL BE INCLUDED IN THE UNIT PRICE BID FOR CONTRACT ITEM 540.10.
40. EXISTING CONDITIONS SHEET HAS BEEN INCLUDED FOR THE CONTRACTOR TO USE FOR SUBMITTALS.
41. ITEM 404.65 "EMULSIFIED ASPHALT" IS TO BE APPLIED AT A RATE OF 0.025 GAL/SY BETWEEN SUCCESSIVE COURSES OF PAVEMENT OR AS DIRECTED BY THE ENGINEER.

PROJECT NAME: CAMBRIDGE  
PROJECT NUMBER: BRO 1448(39)

FILE NAME: ...Structures\sl2j166gen2.dgn	PLOT DATE: 16-SEP-2014
PROJECT LEADER: K. HIGGINS	DRAWN BY: G. LAROCHE
DESIGNED BY: G. LAROCHE	CHECKED BY: J. SALVATORI
GENERAL NOTES	SHEET 4 OF 34

# QUANTITY SHEET 1

SUMMARY OF ESTIMATED QUANTITIES										TOTALS		DESCRIPTIONS				DETAILED SUMMARY OF QUANTITIES			
							ROADWAY	EROSION CONTROL	BRIDGE	FULL CE ITEMS	GRAND TOTAL	FINAL	UNIT	ITEMS	ITEM NUMBER	ROUND	QUANTITIES	UNIT	ITEMS
							1				1		LS	CLEARING AND GRUBBING, INCLUDING INDIVIDUAL TREES AND STUMPS	201.10				
							340				340		CY	COMMON EXCAVATION	203.15				
									540		540		CY	UNCLASSIFIED CHANNEL EXCAVATION	203.27				
							1				1		CY	TRENCH EXCAVATION OF EARTH, EXPLORATORY (N.A.B.I.)	204.22				
									90		90		CY	STRUCTURE EXCAVATION	204.25				
									20		20		CY	GRANULAR BACKFILL FOR STRUCTURES	204.30				
							360				360		CY	SUBBASE OF DENSE GRADED CRUSHED STONE	301.35				
							90				90		CY	AGGREGATE SURFACE COURSE	401.10				
							15				15		CY	AGGREGATE SHOULDERS, IN PLACE	402.10				
							4				4		CWT	EMULSIFIED ASPHALT	404.65				
							1				1		LU	PRICE ADJUSTMENT, ASPHALT CEMENT (N.A.B.I.)	406.50				
									1		1		LS	FURNISHING EQUIPMENT FOR DRIVING PILING	504.10				
									800		800		LF	STEEL PILING, HP 12 X 63	505.155				
									2		2		EACH	DYNAMIC PILE LOADING TEST	505.45				
									1900		1900		LB	REINFORCING STEEL, LEVEL II (FPQ)	507.12				
									44		44		LF	BRIDGE EXPANSION JOINT, ASPHALTIC PLUG	516.10				
									150		150		SY	SHEET MEMBRANE WATERPROOFING, TORCH APPLIED	519.20				
									124		124		LF	BRIDGE RAILING, GALVANIZED 3 RAIL BOX BEAM	525.335				
									1		1		EACH	REMOVAL OF STRUCTURE (450 SF - EST.)	529.15				
									12		12		EACH	BEARING DEVICE ASSEMBLY, STEEL REINFORCED ELASTOMERIC PAD	531.17				
														BEGIN OPTION AA					
									<del>1</del>		<del>1</del>		LS	<del>PRECAST CONCRETE STRUCTURE (ABUTMENT #1)</del>	<del>540.10</del>				
									1		1		LS	SPECIAL PROVISION (CONTRACTOR-FABRICATED PRECAST CONCRETE STRUCTURE)(ABUTMENT #1)	900.645				
														END OPTION AA					
														BEGIN OPTION BB					
									<del>1</del>		<del>1</del>		LS	<del>PRECAST CONCRETE STRUCTURE (ABUTMENT #2)</del>	<del>540.10</del>				
									1		1		LS	SPECIAL PROVISION (CONTRACTOR-FABRICATED PRECAST CONCRETE STRUCTURE)(ABUTMENT #2)	900.645				
														END OPTION BB					
									20		20		LF	CLEANING CULV. PIPE, IN-PLACE [0 TO 24 IN., INCL.]	601.995				
								1			1		MGAL	DUST CONTROL WITH WATER	609.10				
									320		320		CY	STONE FILL, TYPE III	613.12				
							<del>190</del>				<del>190</del>		LF	<del>REMOVING AND RESETTING FENCE</del>	<del>620.50</del>				
							39				39		LF	BOX BEAM GUARDRAIL	621.30				
							2				2		EACH	MANUFACTURED TERMINAL SECTION, TANGENT	621.51				
							4				4		EACH	GUARDRAIL APPROACH SECTION, GALVANIZED 3 RAIL BOX BEAM	621.725				
							112.5				112.5		LF	REMOVAL AND DISPOSAL OF GUARDRAIL	621.80				
							200				200		HR	FLAGGERS	630.15				
										1	1		LS	FIELD OFFICE, ENGINEERS	631.10				
										1	1		LS	TESTING EQUIPMENT, CONCRETE	631.16				

PROJECT NAME: CAMBRIDGE  
PROJECT NUMBER: BRO 1448(39)


FILE NAME: sl2j166qs.dgn  
PROJECT LEADER: K. HIGGINS  
DESIGNED BY: G. LAROCHE  
QUANTITY SHEET 1

PLOT DATE: 16-SEP-2014  
DRAWN BY: J. SALVATORI  
CHECKED BY: G. LAROCHE  
SHEET 5 OF 34

# QUANTITY SHEET 2


SUMMARY OF ESTIMATED QUANTITIES										TOTALS		DESCRIPTIONS				DETAILED SUMMARY OF QUANTITIES			
							ROADWAY	EROSION CONTROL	BRIDGE	FULL CE ITEMS	GRAND TOTAL	FINAL	UNIT	ITEMS	ITEM NUMBER	ROUND	QUANTITIES	UNIT	ITEMS
										1	1		LS	TESTING EQUIPMENT, BITUMINOUS	631.17				
										3000	3000		DL	FIELD OFFICE TELEPHONE (N.A.B.I.)	631.26				
							1				1		LS	MOBILIZATION/DEMobilIZATION	635.11				
									400		400		SY	GEOTEXTILE UNDER STONE FILL	649.31				
								250			250		SY	GEOTEXTILE FOR SILT FENCE	649.51				
								100			100		SY	GEOTEXTILE FOR FILTER CURTAIN	649.61				
								5			5		LB	SEED	651.15				
								5			5		LB	SEED, WINTER RYE	651.17				
								40			40		LB	FERTILIZER	651.18				
								1			1		TON	AGRICULTURAL LIMESTONE	651.20				
								1			1		TON	HAY MULCH	651.25				
								40			40		CY	TOPSOIL	651.35				
									240		240		SY	GRUBBING MATERIAL	651.40				
								1			1		LS	EPSC PLAN	652.10				
								<del>40</del>			<del>40</del>		HR	<del>MONITORING EPSC PLAN</del>	<del>652.20</del>				
								1			1		LU	MAINTENANCE OF EPSC PLAN (N.A.B.I.)	652.30				
								300			300		SY	TEMPORARY EROSION MATTING	653.20				
								60			60		CY	VEHICLE TRACKING PAD	653.35				
								180			180		LF	BARRIER FENCE	653.50				
								510			510		LF	PROJECT DEMARCATION FENCE	653.55				
							0.66				0.66		SF	TRAFFIC SIGNS, TYPE A	675.20				
							16				16		LF	SQUARE TUBE SIGN POST AND ANCHOR	675.341				
							4				4		EACH	DELINEATOR WITH STEEL POST	676.10				
									16		16		CY	SPECIAL PROVISION (HIGH PERFORMANCE CONCRETE, RAPID SET)(FPQ)	900.608				
									171		171		LF	SPECIAL PROVISION (PRESTRESSED CONCRETE NEXT D BEAM)(NEXT 28D)	900.640				
								1			1		LS	SPECIAL PROVISION (CPM SCHEDULE)	900.645				
								1			1		LS	SPECIAL PROVISION (TRAFFIC CONTROL, ALL-INCLUSIVE)	900.645				
								1			1		LU	SPECIAL PROVISION (INCENTIVE/DISINCENTIVE)(N.A.B.I.)	900.650				
								1			1		LU	SPECIAL PROVISION (MAT DENSITY PAY ADJUSTMENT, SMALL QUANTITY)(N.A.B.I.)	900.650				
								1			1		LU	SPECIAL PROVISION (MXTURE PAY ADJUSTMENT)(N.A.B.I.)	900.650				
								100			100		TON	SPECIAL PROVISION (BITUMINOUS CONCRETE PAVEMENT, SMALL QUANTITY)	900.680				

PROJECT NAME:	CAMBRIDGE	PLOT DATE:	29-AUG-2014
PROJECT NUMBER:	BRO 1448(39)	DRAWN BY:	J. SALVATORI
FILE NAME:	sl2j166qs.dgn	CHECKED BY:	G. LAROCHE
PROJECT LEADER:	K. HIGGINS	DESIGNED BY:	G. LAROCHE
QUANTITY SHEET 2		SHEET	6 OF 34

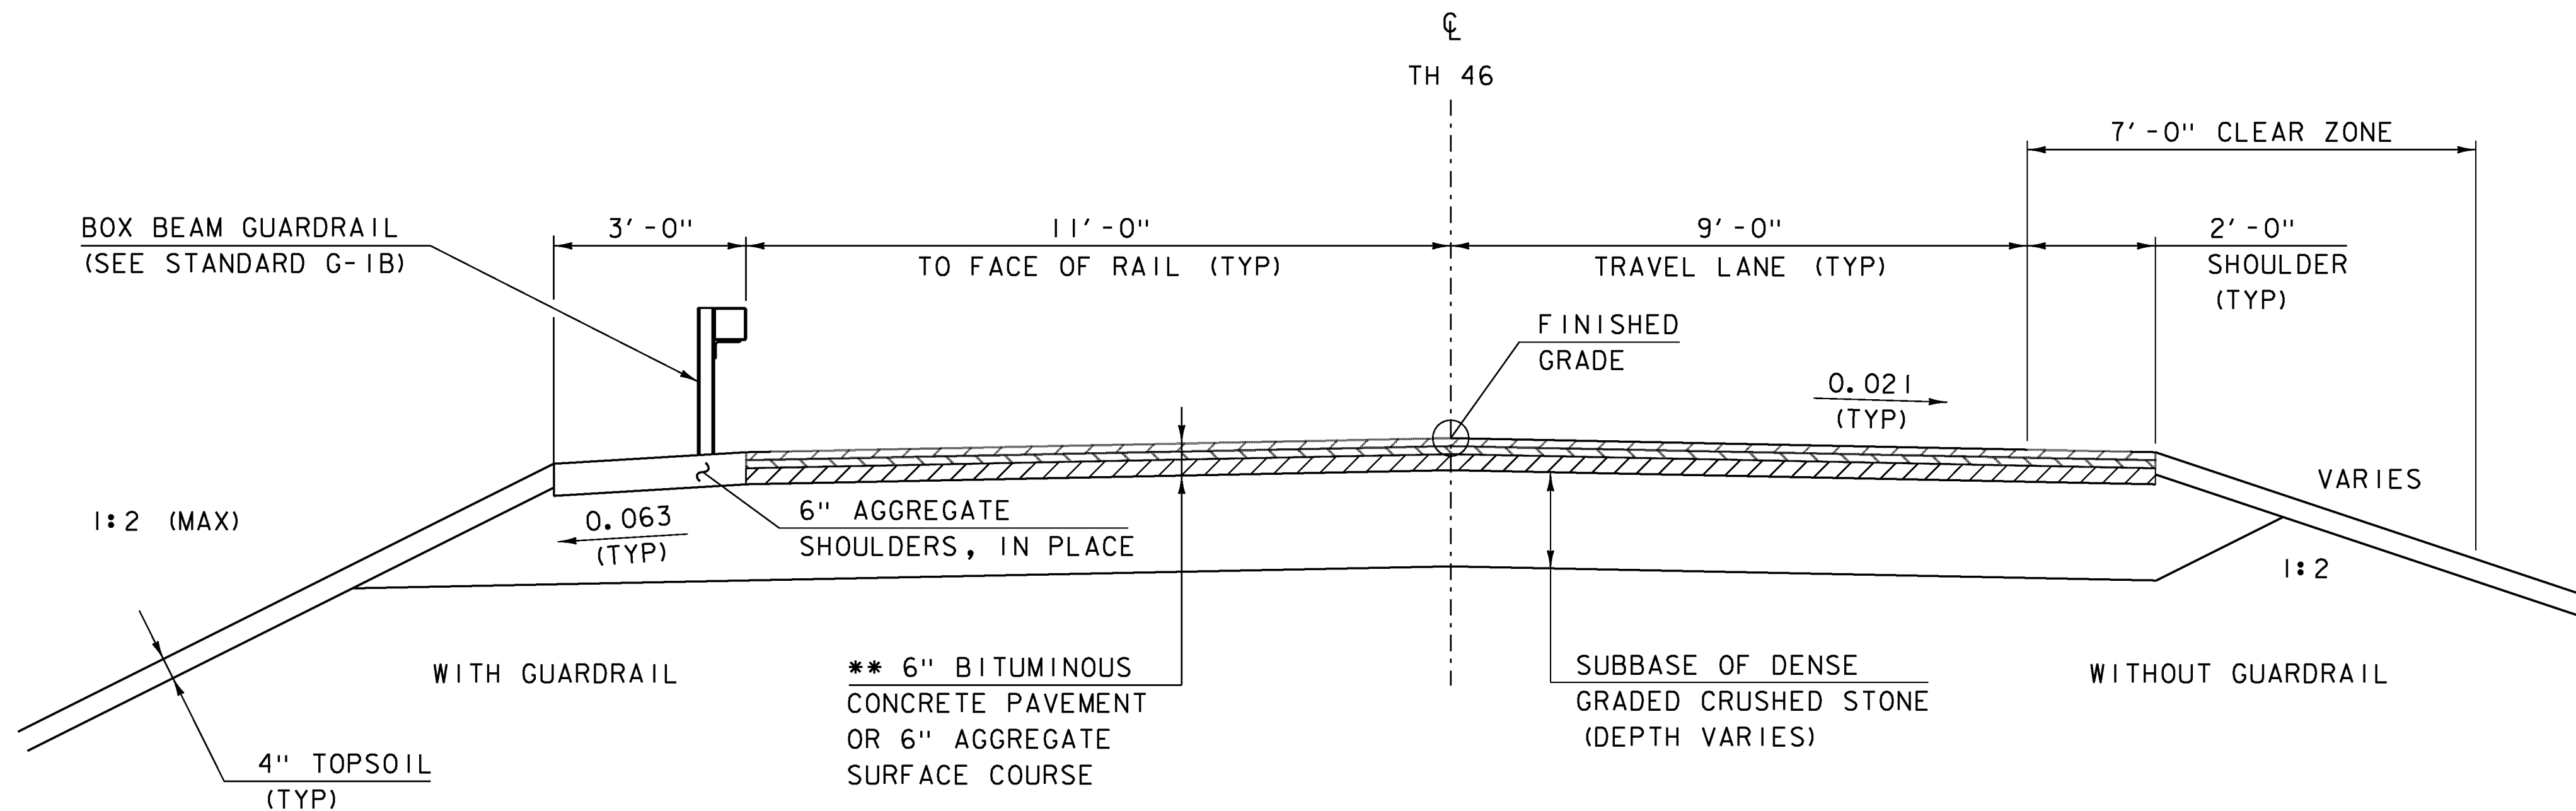

**ROADWAY TYPICAL SECTION**

SCALE 1/2" = 1'-0"

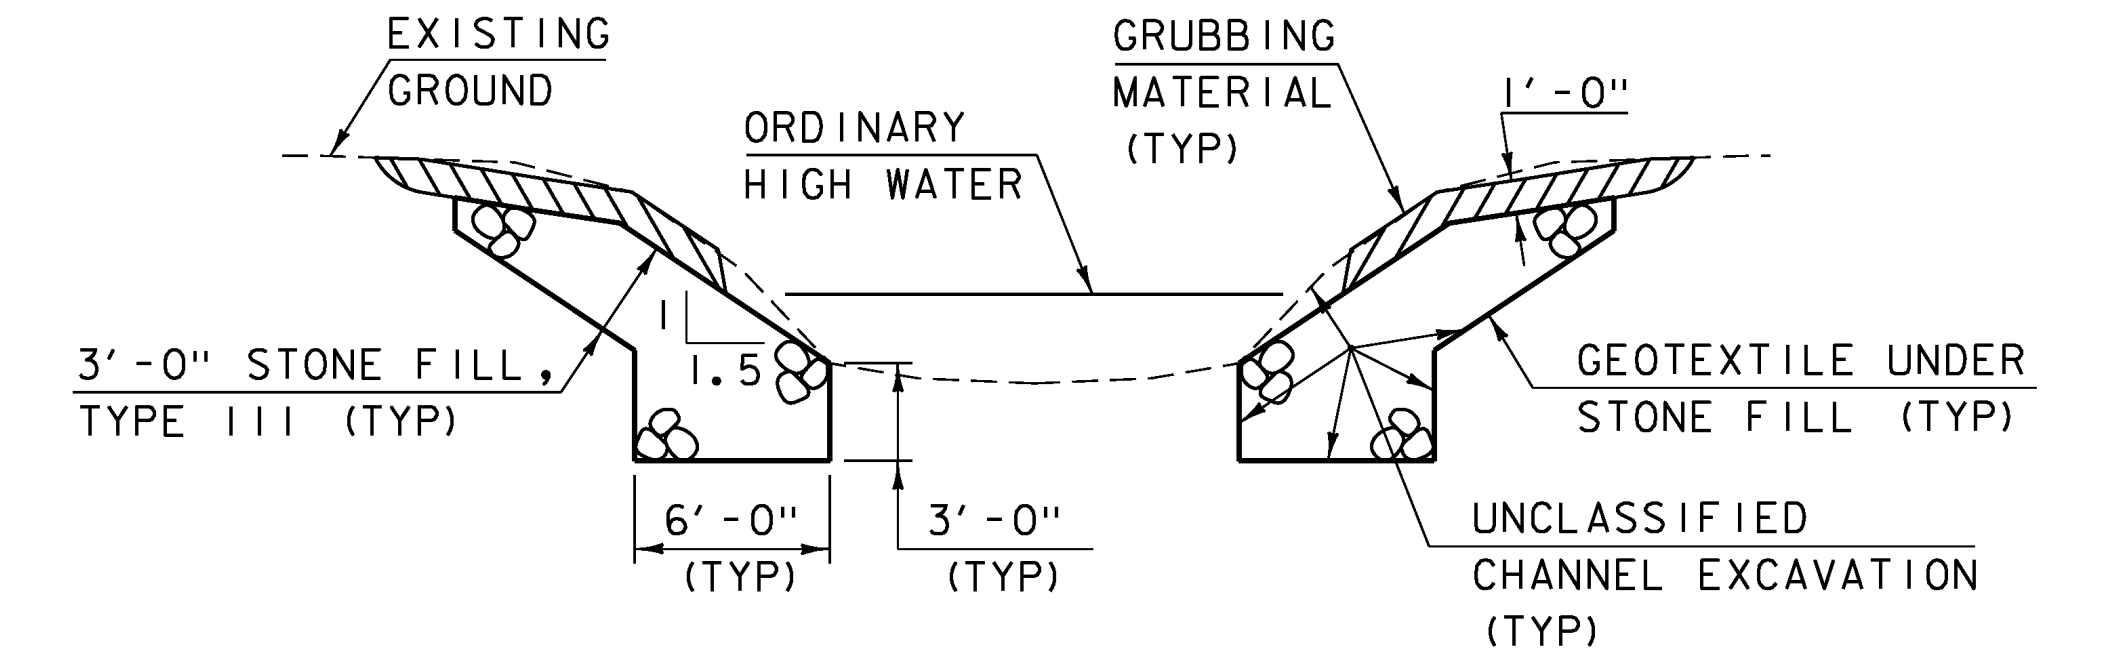

**TYPICAL CHANNEL SECTION**


(NOT TO SCALE)

**NOTES:**

1. WHENEVER CHANNEL SLOPE INTERSECTS ROADWAY SUBBASE, GRUBBING MATERIAL SHALL BEGIN AT BOTTOM OF SUBBASE.
2. NO GRUBBING MATERIAL SHALL BE PLACED UNDER DOWNSPOUTS.


MATERIAL TOLERANCES (IF USED ON PROJECT)	
SURFACE	
- PAVEMENT (TOTAL THICKNESS)	+/- 1/4"
- AGGREGATE SURFACE COURSE	+/- 1/2"
SUBBASE	
	+/- 1"
SAND BORROW	
	+/- 1"

- ** 1 1/2" SUPERPAVE BITUMINOUS CONCRETE PAVEMENT, TYPE IVS
- 1 1/2" SUPERPAVE BITUMINOUS CONCRETE PAVEMENT, TYPE IVS
- 3" SUPERPAVE BITUMINOUS CONCRETE PAVEMENT, TYPE IIIS
  
- * 1 1/2" SUPERPAVE BITUMINOUS CONCRETE PAVEMENT, TYPE IVS
- 1 1/2" SUPERPAVE BITUMINOUS CONCRETE PAVEMENT, TYPE IVS

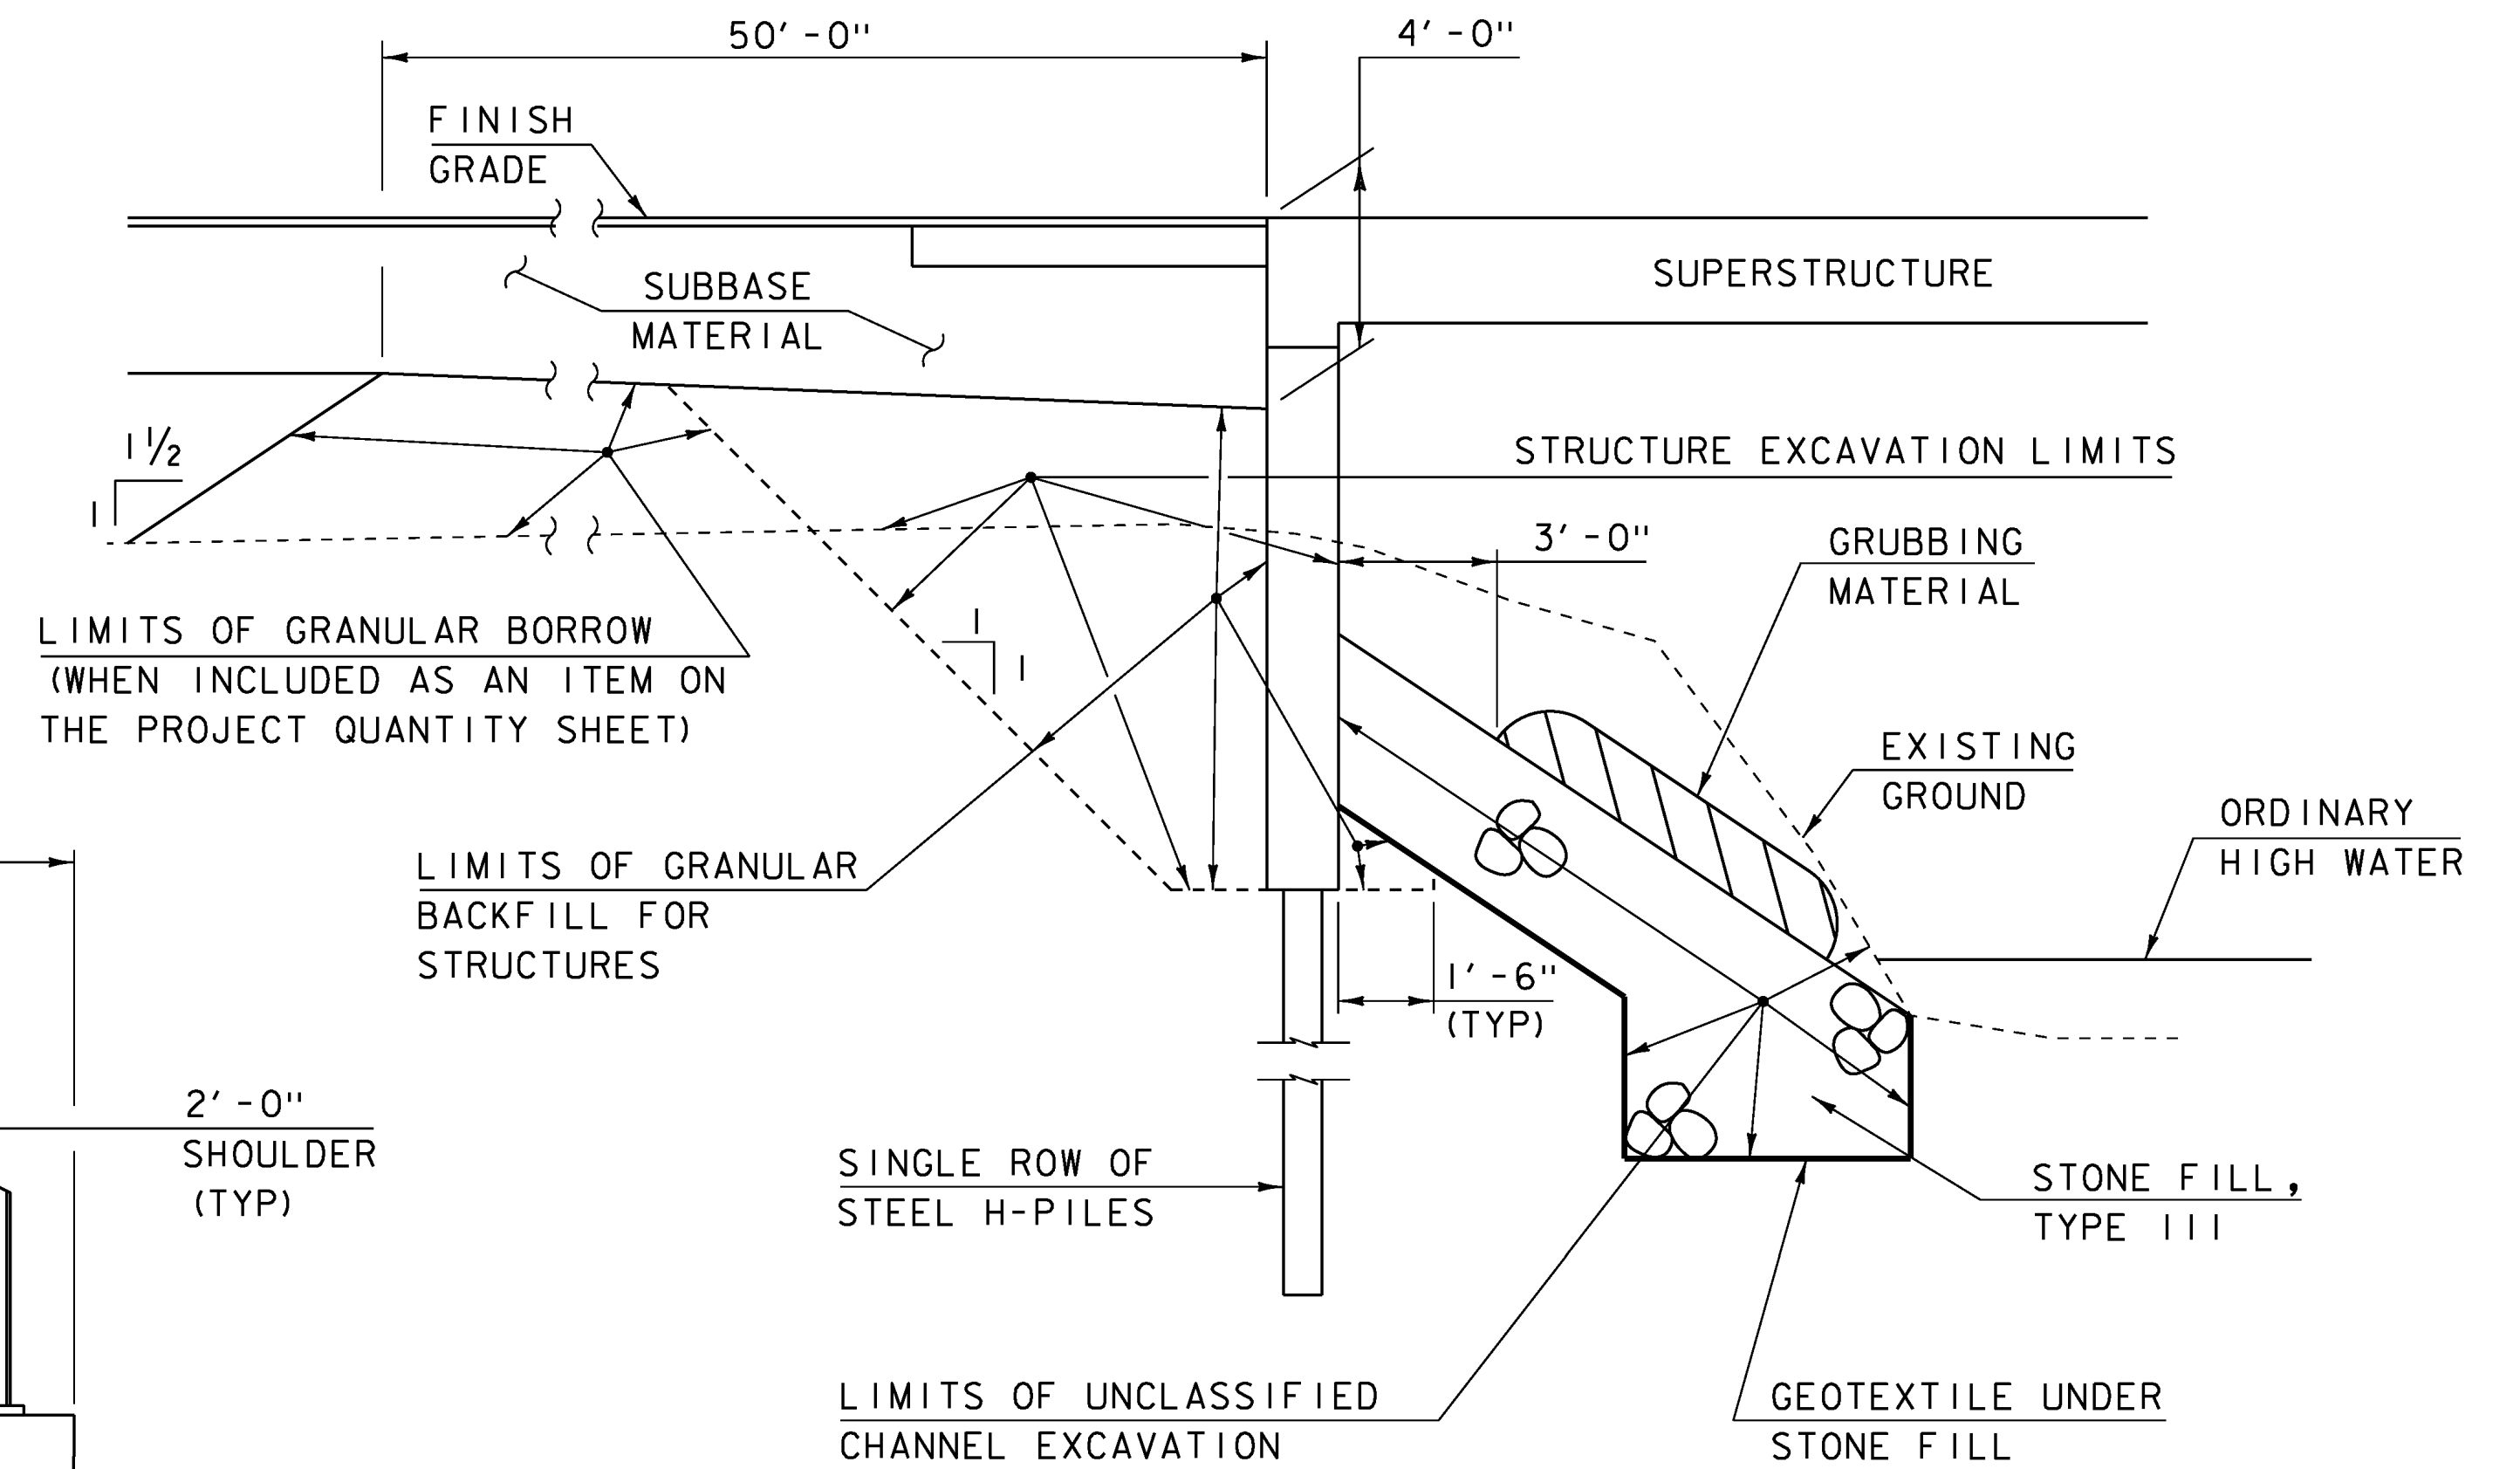

**TYPICAL INTEGRAL ABUTMENT SECTION**

NOT TO SCALE

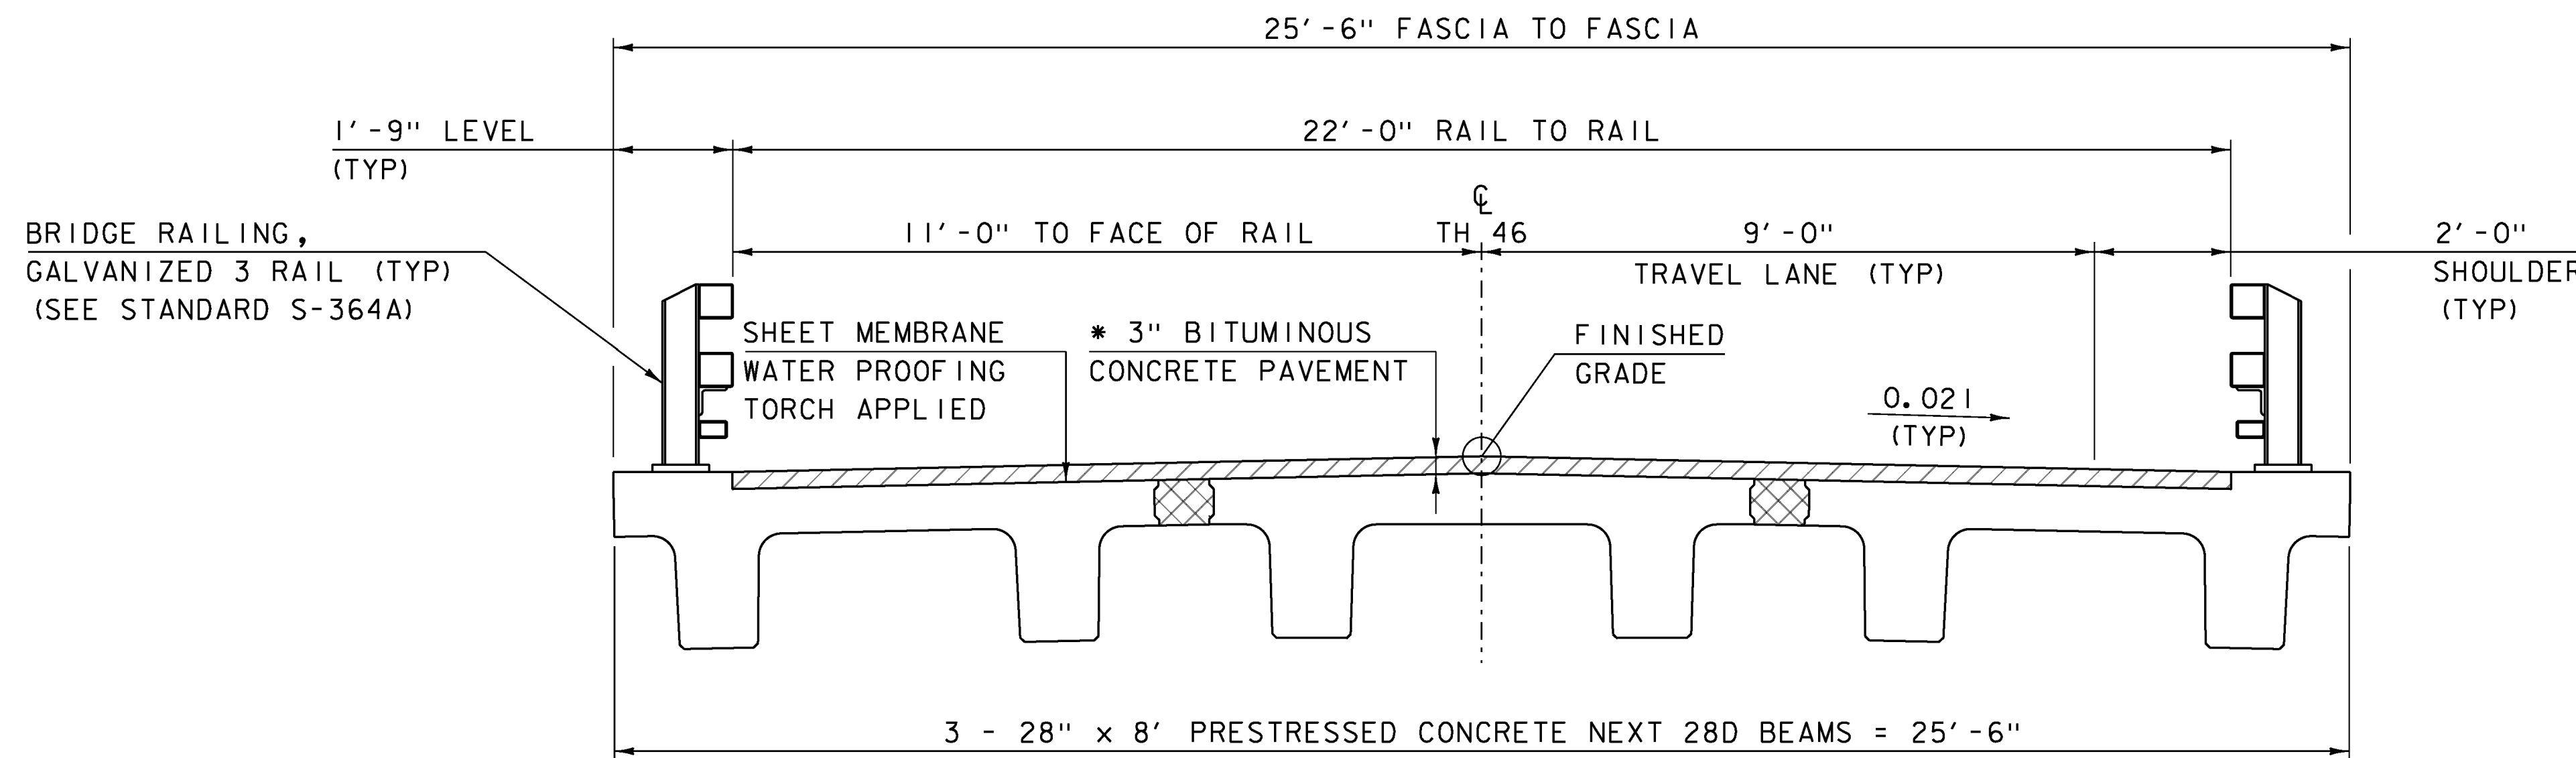

**BRIDGE TYPICAL SECTION**

SCALE 1/2" = 1'-0"

PROJECT NAME: CAMBRIDGE  
PROJECT NUMBER: BRO 1448(39)

FILE NAME: sl2j166typ.dgn  
PROJECT LEADER: K.HIGGINS  
DESIGNED BY: G.LAROCHE  
TYPICAL SECTIONS

PLOT DATE: 29-AUG-2014  
DRAWN BY: G.LAROCHE  
CHECKED BY: J.SALVATORI  
SHEET 7 OF 34

GPS CONTROL POINTS

12J166 AZ MK

12J166

 




GENERAL LOCATION CAMBRIDGE VT  
 TO REACH FROM THE INTERSECTION OF VT ROUTE 15 WEST AND VT ROUTE 108 SOUTH IN CAMBRIDGE GO WEST ON VT ROUTE 15 FOR 2.3 MILES TO THE INTERSECTION OF LOWER PLEASANT VALLEY ROAD LEFT TURN LEFT ON LOWER PLEASANT VALLEY ROAD CONTINUE ON LOWER PLEASANT VALLEY ROAD FOR 4.0 MILE TO THE INTERSECTION OF PLEASANT VALLEY ROAD TURN RIGHT ON PLEASANT VALLEY ROAD GO 0.7 MILES TO THE SIGHT OF THE MARK ON THE RIGHT. ON THE EDGE OF A FIELD. ABOUT 0.1 MILES SOUTH OF THE CAMBRIDGE UNDERHILL TOWN LINE.  
 THE MARK IS A REBAR DRIVEN FLUSH INTO THE GROUND W/ A RED PLASTIC CAP (VT AOT TRAV PT)

THE MARK IS 5.5 METER EAST OF CENTERLINE OF THE ROAD AND ABOUT 1.0 METER LOWER THEN THE ROAD 20.0 METERS NORTH WEST AND ACROSS THE ROAD FROM OF POLE # 11B/120A/6/150 20.10 SOUTH WEST OF A GRAVEL DRIVE 72.80 METER NORTH EAST OF POLE # 1/B/120/A1 0.6 METERS EAST OF MILE MARKER 0233/0415/0820. SEE HVCTRL #1 BELOW FOR COORDINATES






GENERAL LOCATION CAMBRIDGE VT  
 TO REACH FROM THE INTERSECTION OF VT ROUTE 15 WEST AND VT ROUTE 108 SOUTH IN CAMBRIDGE GO WEST ON VT ROUTE 15 FOR 2.3 MILES TO THE INTERSECTION OF LOWER PLEASANT VALLEY ROAD LEFT TURN LEFT ON LOWER PLEASANT VALLEY ROAD CONTINUE ON LOWER PLEASANT VALLEY ROAD FOR 4.0 MILE TO THE INTERSECTION OF PLEASANT VALLEY ROAD TURN RIGHT ON PLEASANT VALLEY ROAD GO 0.2 MILES TO THE SIGHT OF THE MARK ON THE LEFT ON THE EDGE OF A FIELD ACROSS FROM IRISH SETTLEMENT ROAD AND THE VALLEY DREAM FARM AND APPROXIMATELY 0.2 MILE NORTH OF THE UNDERHILL CAMBRIDGE TOWN LINE  
 THE MARK IS A REBAR DRIVEN FLUSH INTO THE GROUND W/ A RED PLASTIC CAP (VT AOT TRAV PT)  
 THE MARK IS 5.4 METERS EAST OF THE CENTERLINE OF THE ROAD AND 0.3 METER LOWER THEN CENTERLINE 3.1 METER SOUTH SOUTHEAST OF POLE # 67/6/139 13.8 METER NORTH OF FIRE HYDRANT 25.0 METER EAST AND ACROSS THE ROAD FROM THE NORTH EAST CORNER OF A BARN/GARAGE ATTACHED TO A HOUSE 16.0 METER SOUTHEAST AND ACROSS THE ROAD OF THE EAST SIDE OF A SIGN FOR VALLEY DREAM FARM AND ABOUT 20 METER NORTH OF A FIELD DRIVE. SEE HVCTRL #2 BELOW FOR COORDINATES.

LOST IN CONSTRUCTION

TRAVERSE TIES

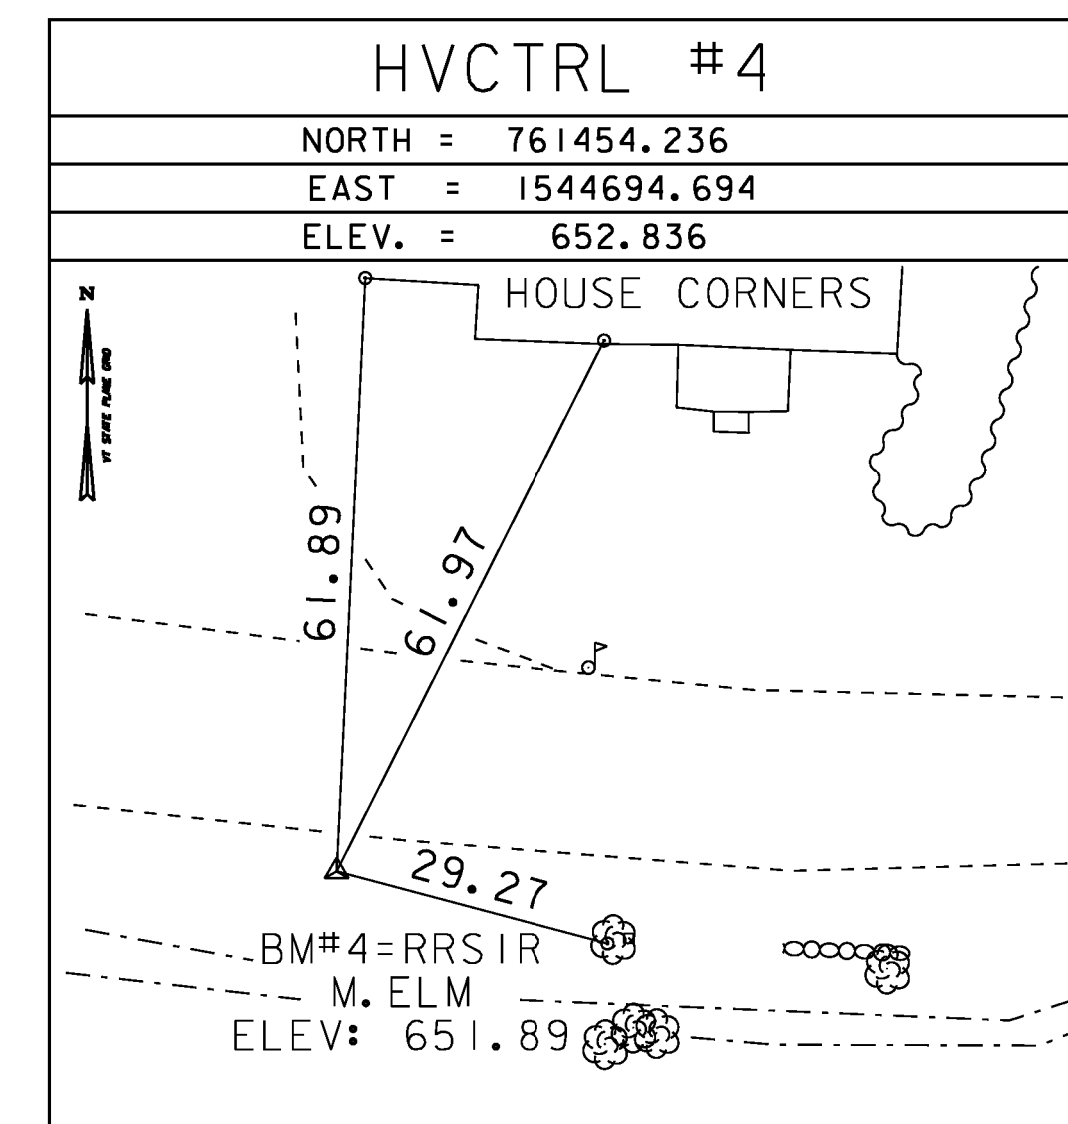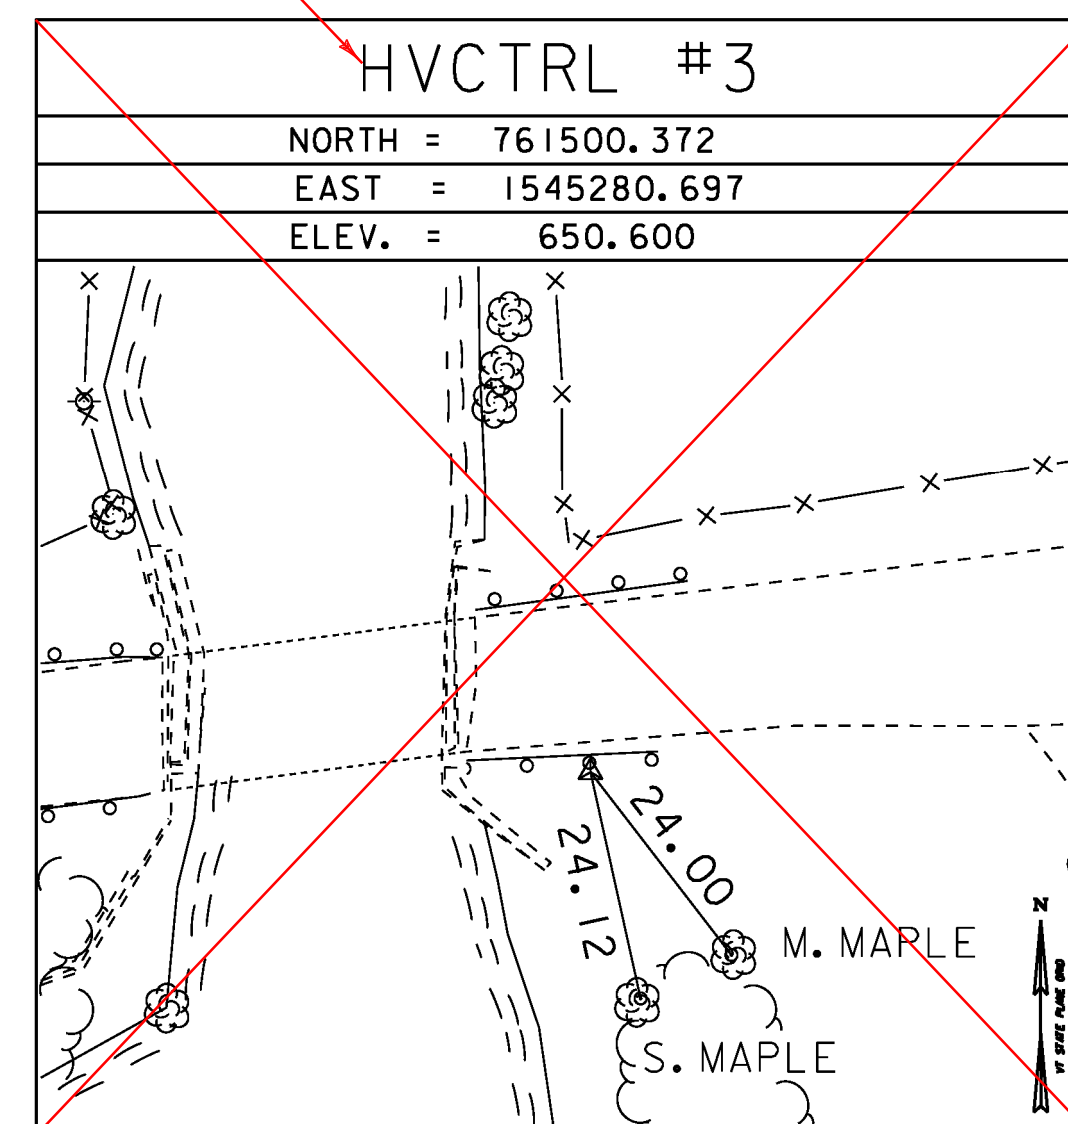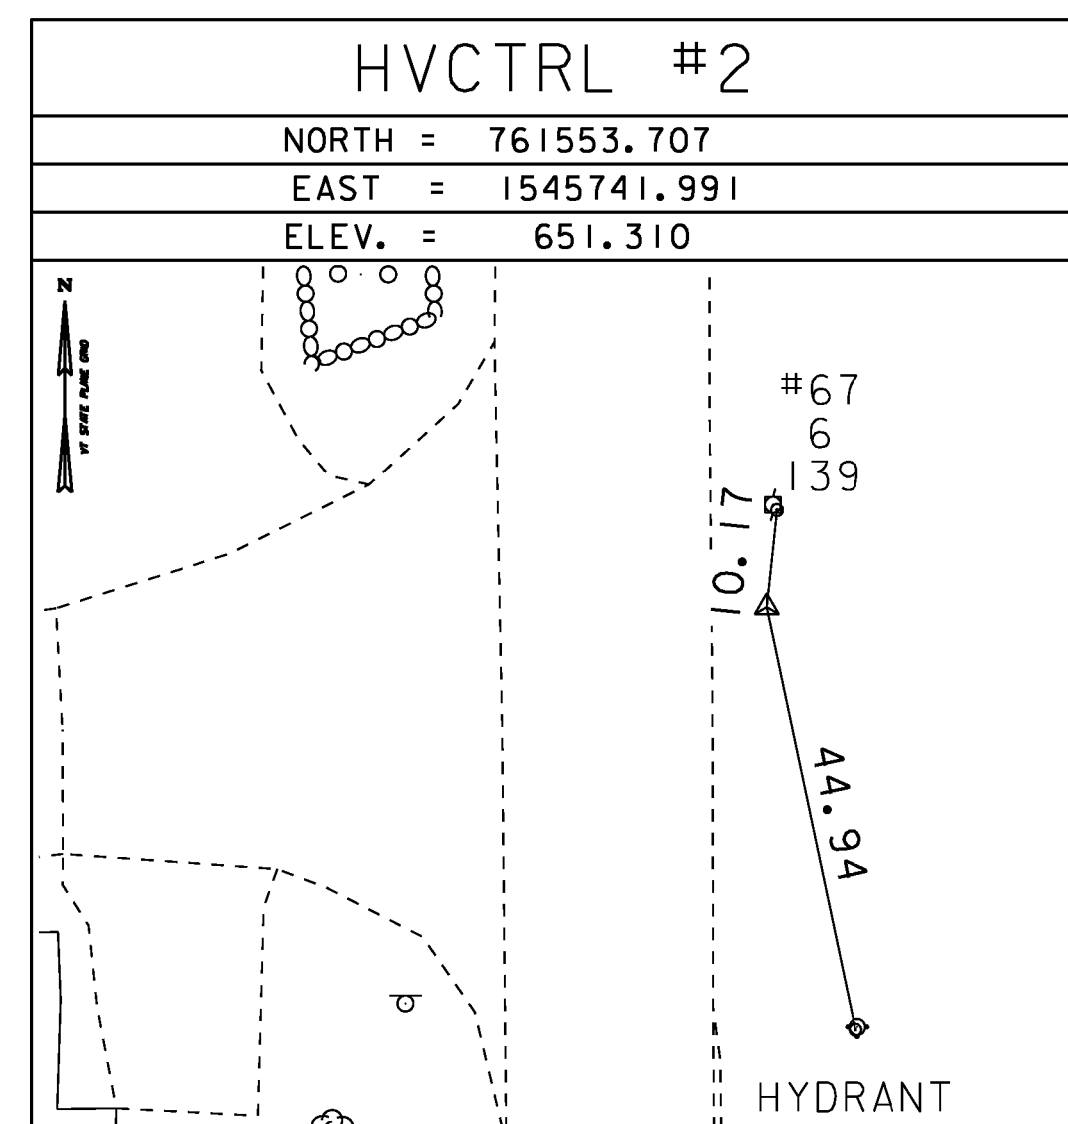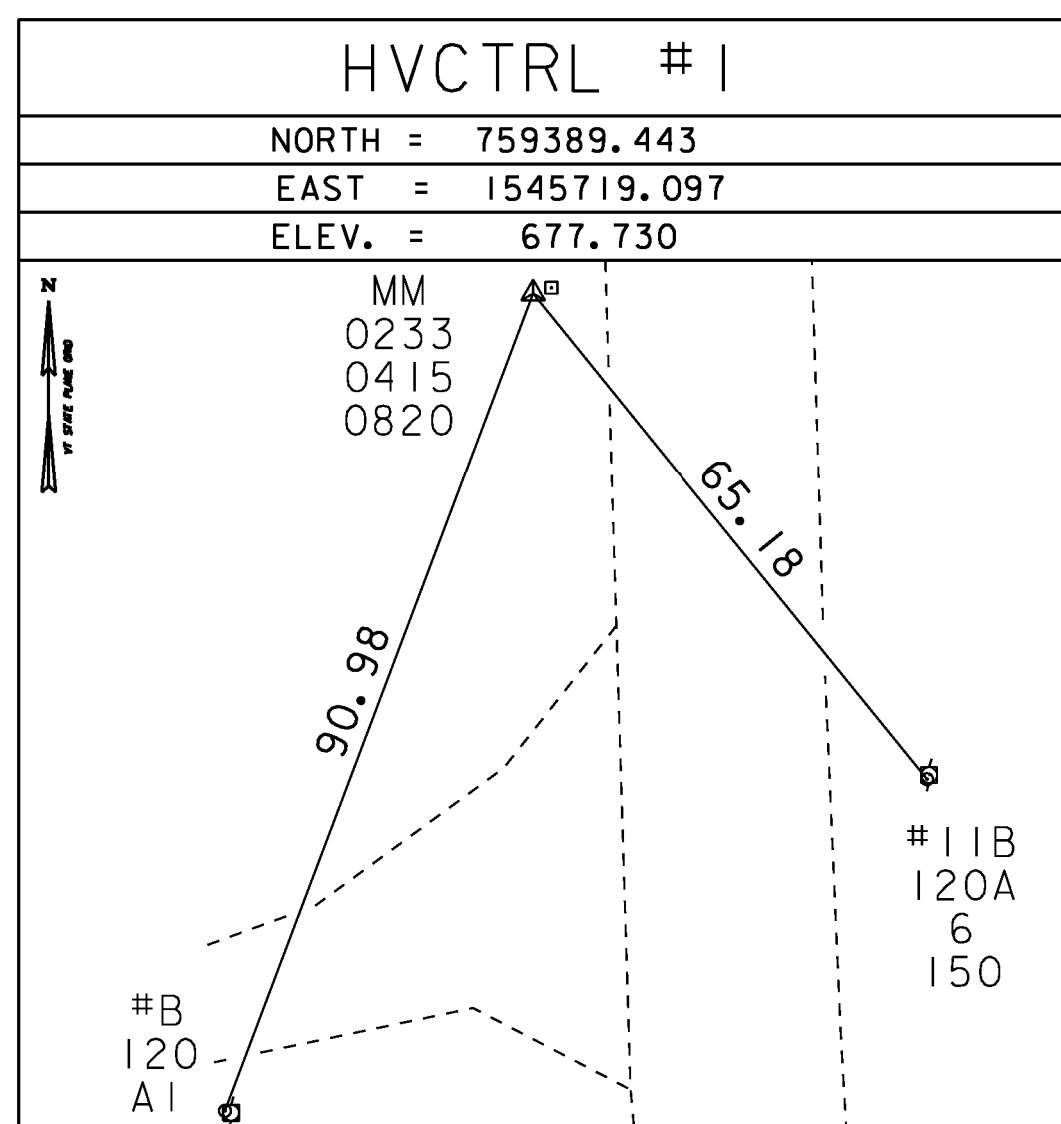

ALIGNMENT TIES

     



DATUM  
 VERTICAL NAVD 88  
 HORIZONTAL NAD 83 (07)  
 ADJUSTMENT COMPASS

PROJECT NAME: CAMBRIDGE  
 PROJECT NUMBER: BRO 1448 (39)  
 FILE NAME: x12j166+1.dgn PLOT DATE: 29-AUG-2014  
 PROJECT LEADER: K. HIGGINS DRAWN BY: R. BULLOCK  
 DESIGNED BY: G. LAROCHE CHECKED BY: P. BEYOR  
 TIE SHEET SHEET 8 OF 34

**BUTLER, JOHN A. &  
CAROL L. PENBERTHY**

LyD LYMAN-TUNBRIDGE  
FINE SANDY LOAMS  
WITH 15%-25% SLOPES  
"K" FACTOR = .24 -.28  
VERY STONY

**TISBERT, JOSEPH M. &  
ANNE MARIE  
joined by VERMONT LAND TRUST, INC.**

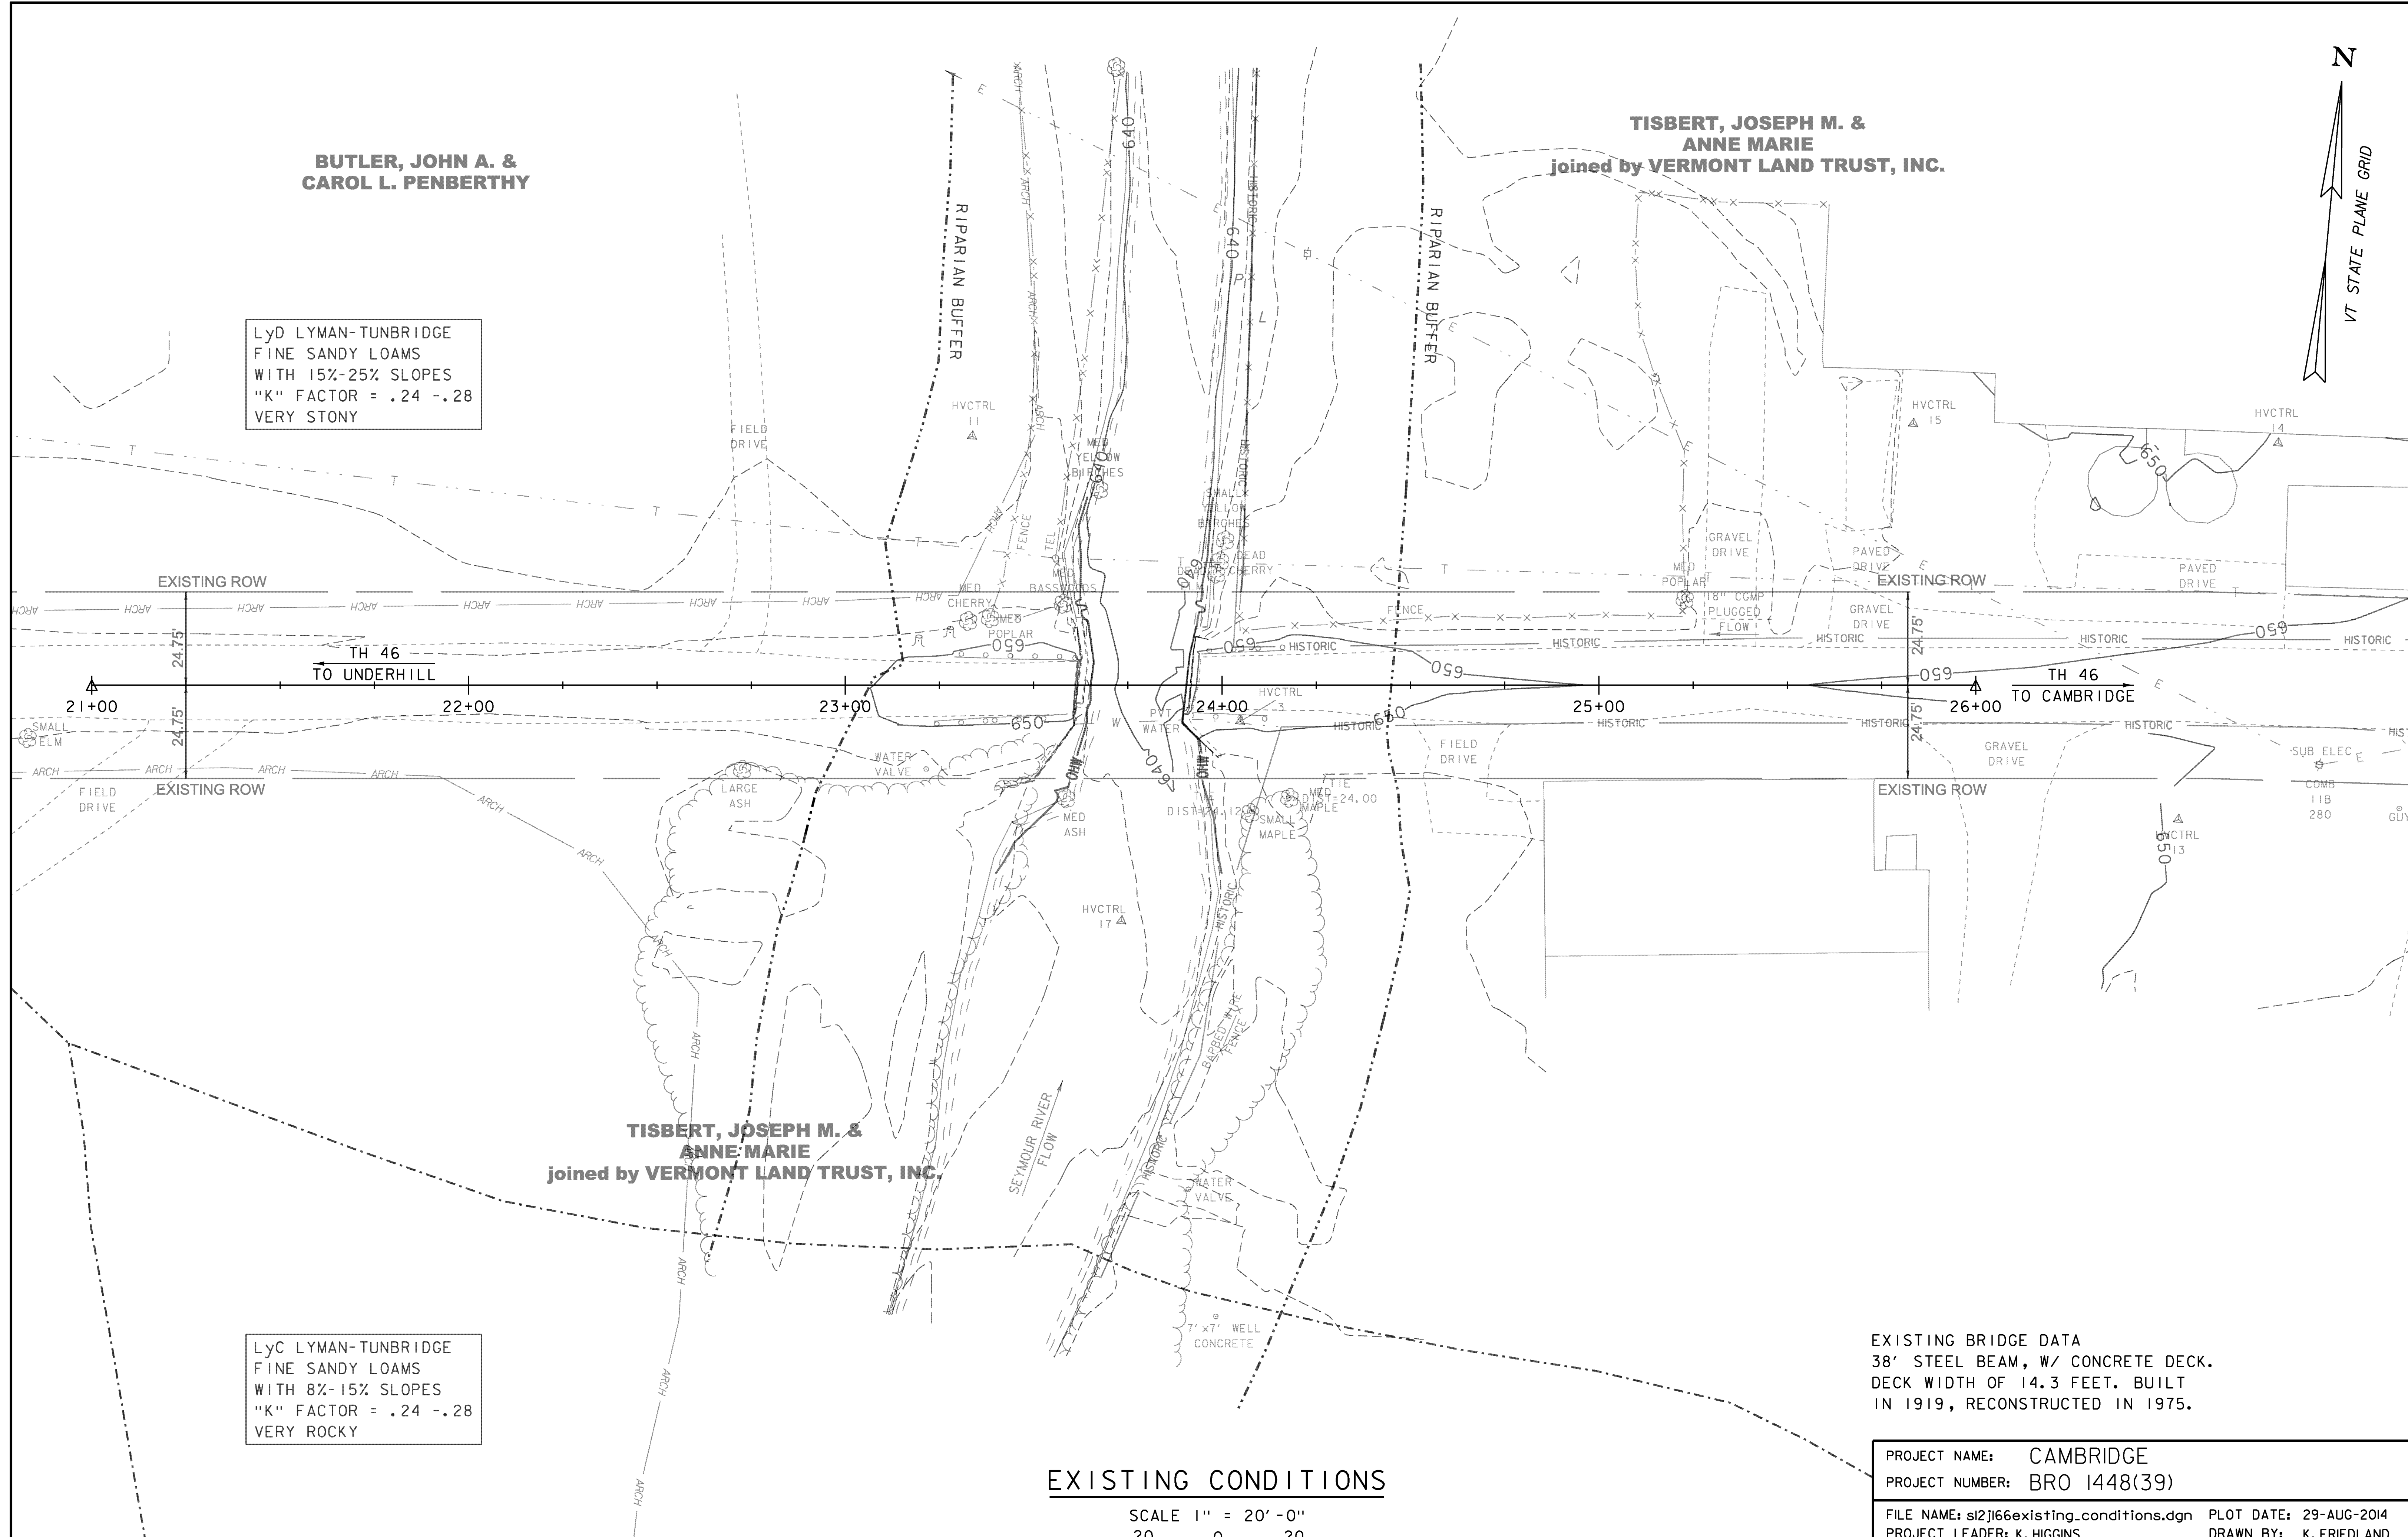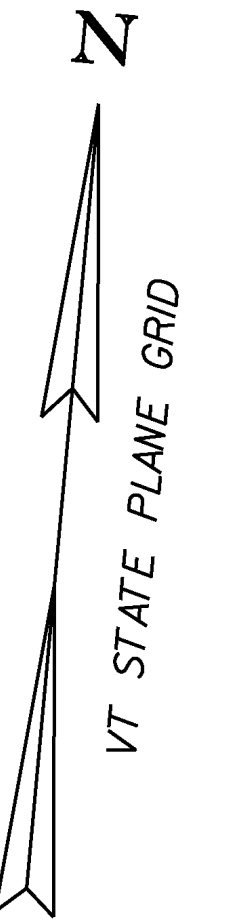


**TISBERT, JOSEPH M. &  
ANNE MARIE  
joined by VERMONT LAND TRUST, INC.**



LyC LYMAN-TUNBRIDGE  
FINE SANDY LOAMS  
WITH 8%-15% SLOPES  
"K" FACTOR = .24 -.28  
VERY ROCKY

EXISTING BRIDGE DATA  
38' STEEL BEAM, W/ CONCRETE DECK.  
DECK WIDTH OF 14.3 FEET. BUILT  
IN 1919, RECONSTRUCTED IN 1975.

**EXISTING CONDITIONS**

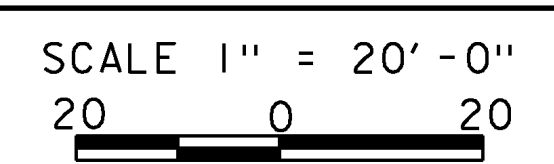

PROJECT NAME:	CAMBRIDGE	PLOT DATE:	29-AUG-2014
PROJECT NUMBER:	BRO I448(39)	DRAWN BY:	K. FRIEDLAND
FILE NAME:	sl2j166existing_conditions.dgn	CHECKED BY:	J. SALVATORI
PROJECT LEADER:	K. HIGGINS	EXISTING CONDITIONS	SHEET 9 OF 34
DESIGNED BY:	G. LAROCHE		

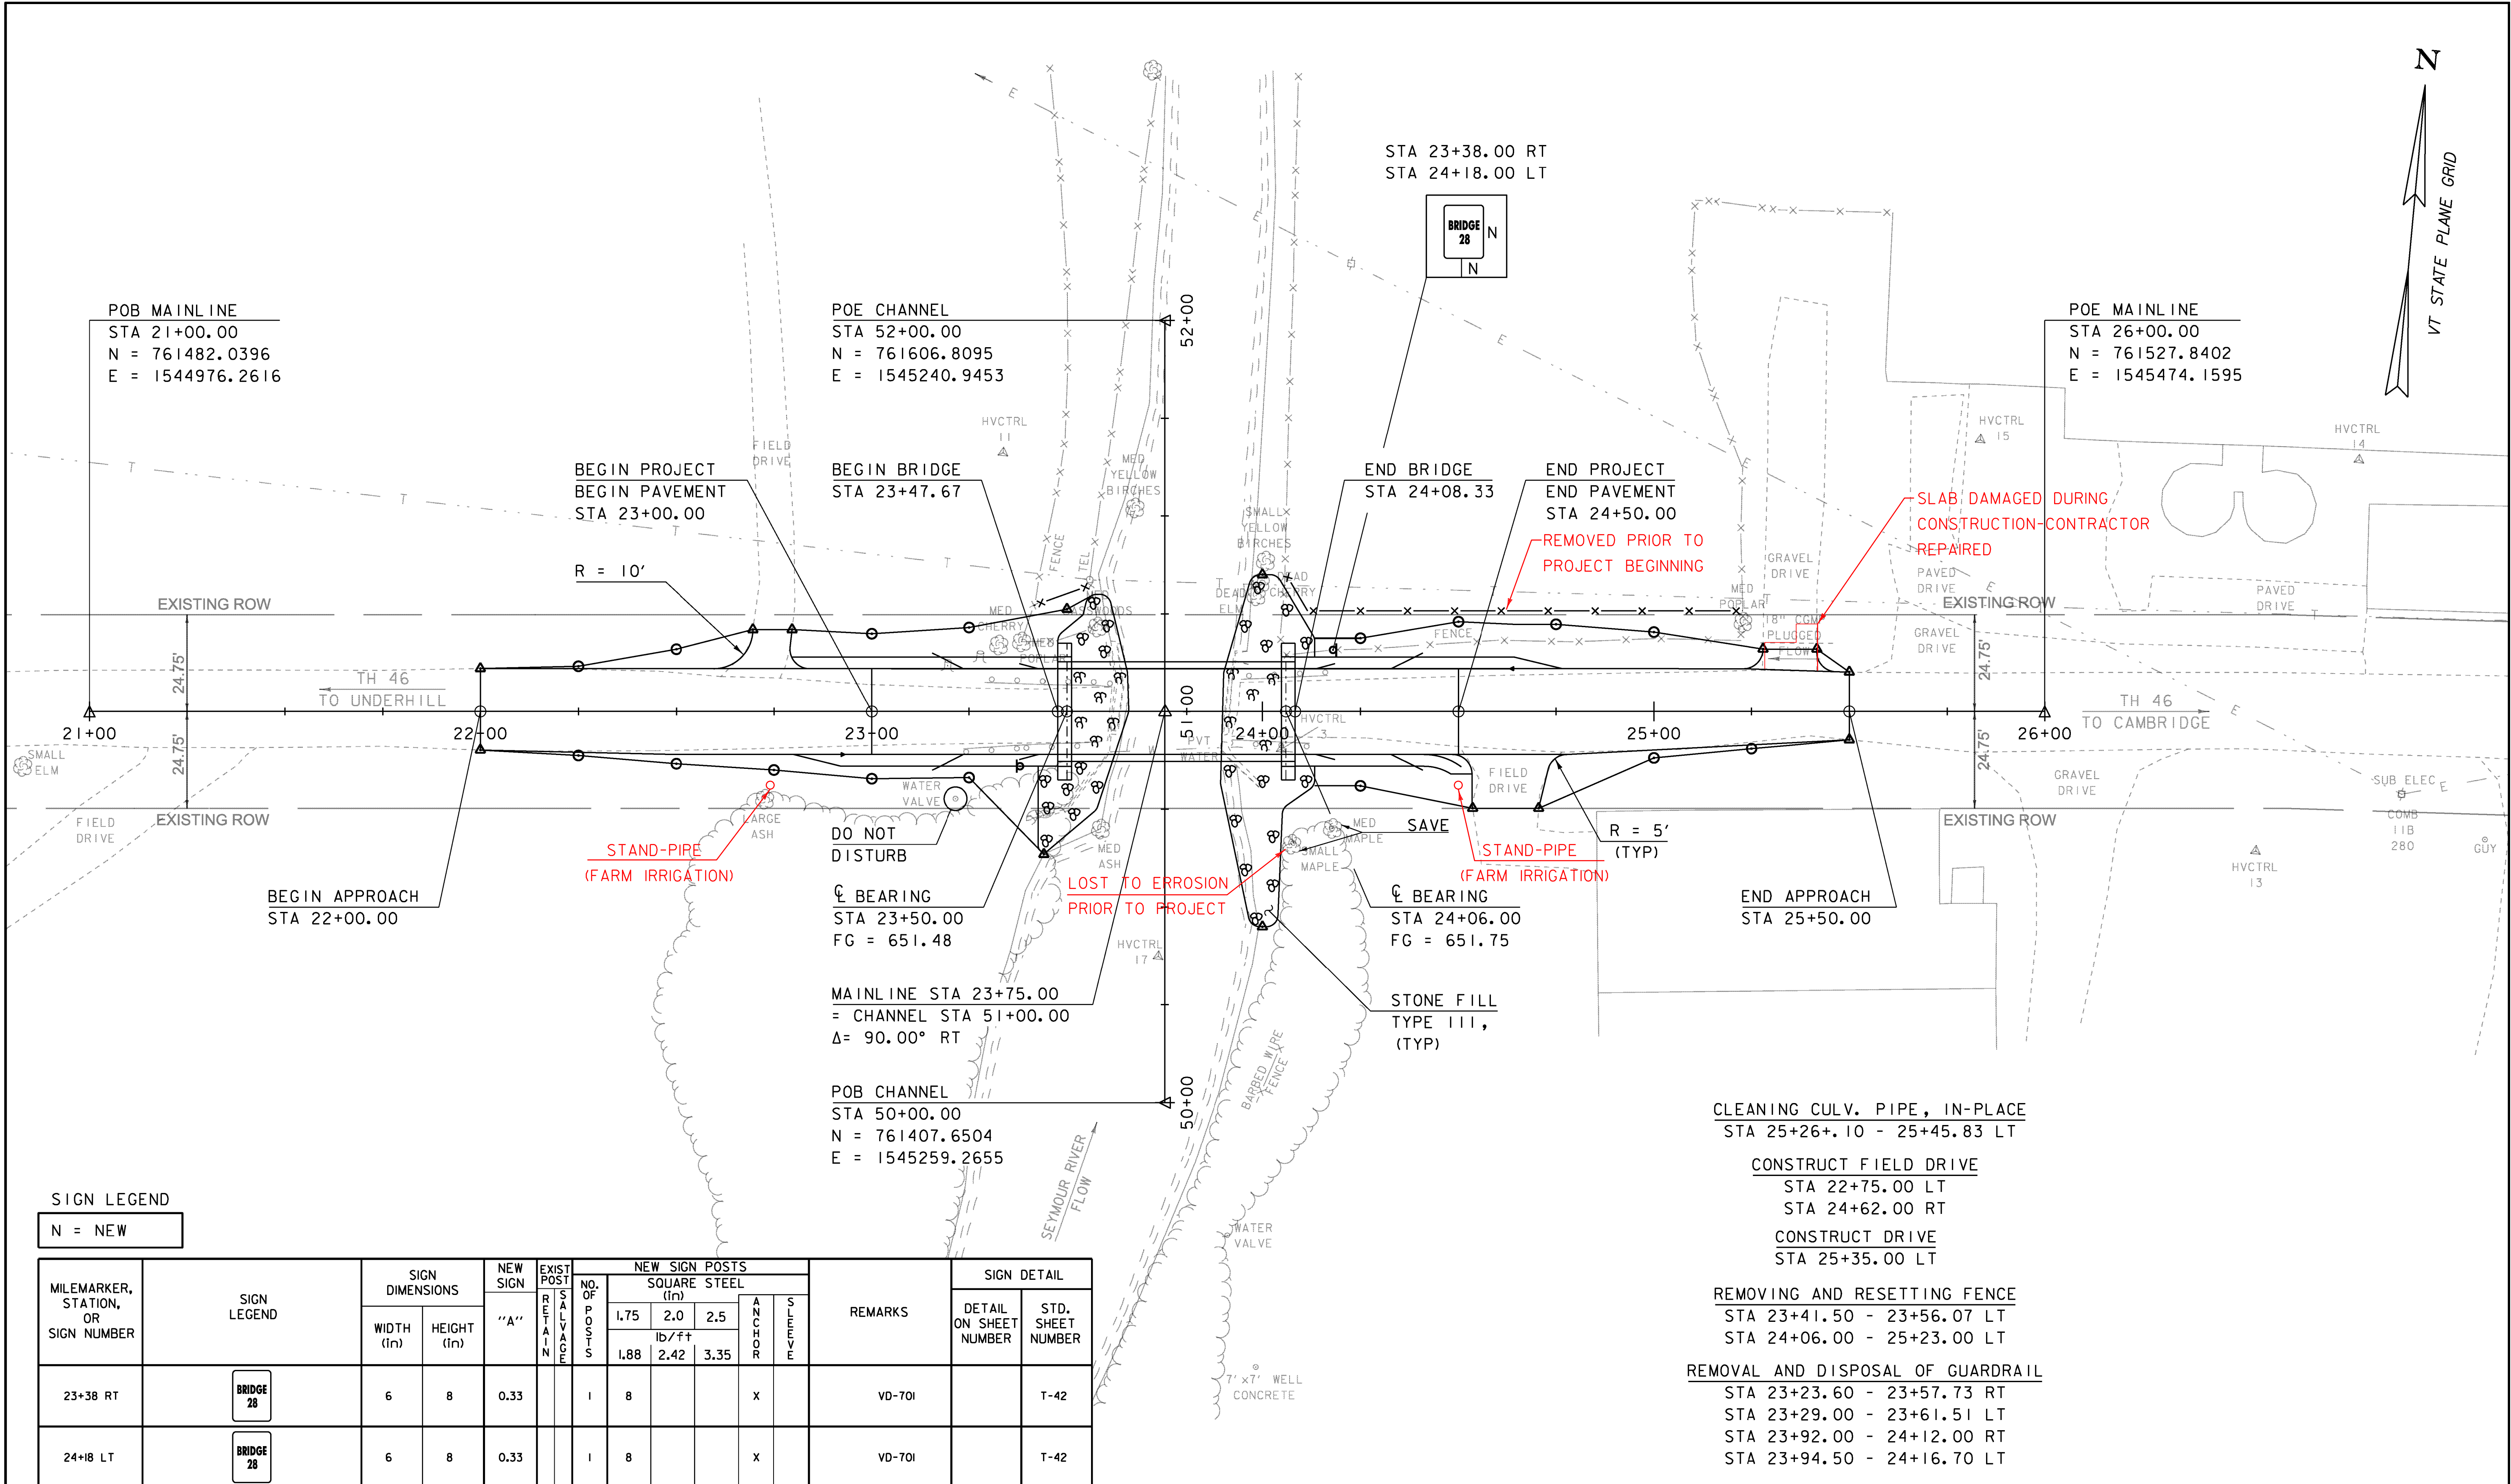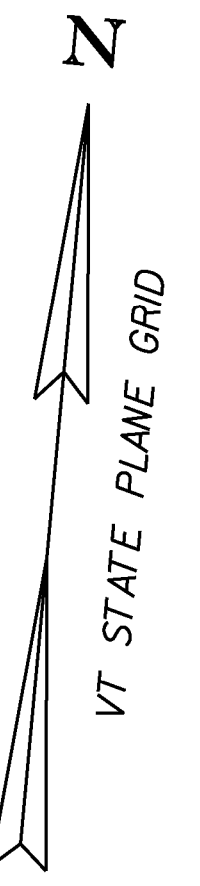


SIGN LEGEND  
N = NEW

MILEMARKER, STATION, OR SIGN NUMBER	SIGN LEGEND	SIGN DIMENSIONS		NEW SIGN "A"	EXIST. POST REL. TO MAINLINE	NO. OF POSTS	NEW SIGN POSTS SQUARE STEEL (in)				REMARKS	SIGN DETAIL		
		WIDTH (in)	HEIGHT (in)				lb/ft		A	S		DETAIL ON SHEET NUMBER	STD. SHEET NUMBER	
							1.75	2.0						2.5
23+38 RT	BRIDGE 28	6	8	0.33		1	8					VD-701	T-42	
24+18 LT	BRIDGE 28	6	8	0.33		1	8					VD-701	T-42	
							FT	FT	FT	EA				
							16							
<b>TOTALS</b>				SF			FT							
				0.66			16							

SHS = STANDARD HIGHWAY SIGNS (MUTCD)


LAYOUT SHEET  
SCALE 1" = 20'-0"  
20 0 20

PROJECT NAME: CAMBRIDGE  
PROJECT NUMBER: BRO 1448(39)  
FILE NAME: s12j166bdr.dgn  
PROJECT LEADER: K. HIGGINS  
DESIGNED BY: G. LAROCHE  
LAYOUT SHEET  
PLOT DATE: 29-AUG-2014  
DRAWN BY: K. FRIEDLAND  
CHECKED BY: J. SALVATORI  
SHEET 10 OF 34

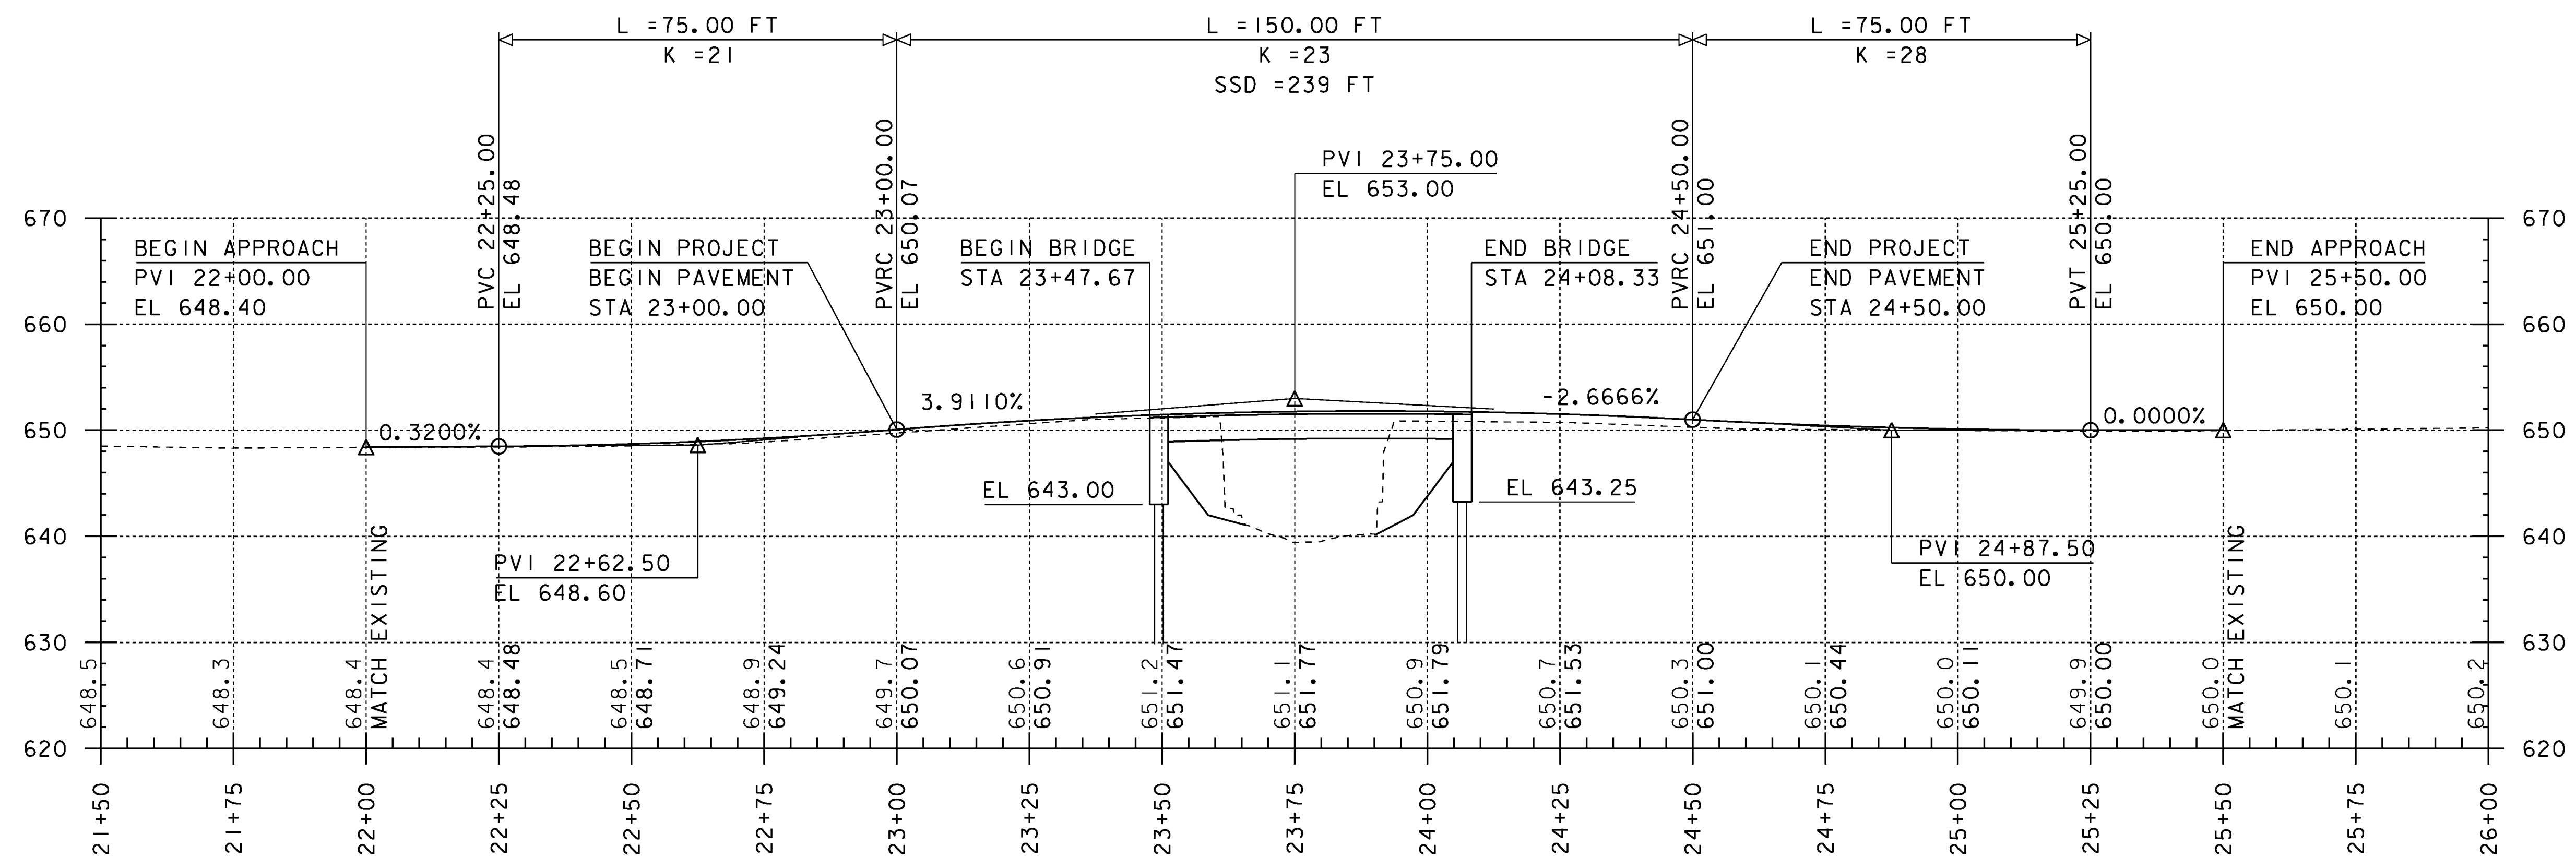

**MAINLINE PROFILE**

SCALE: HORIZONTAL 1"=20'-0"  
 VERTICAL 1"=10'-0"

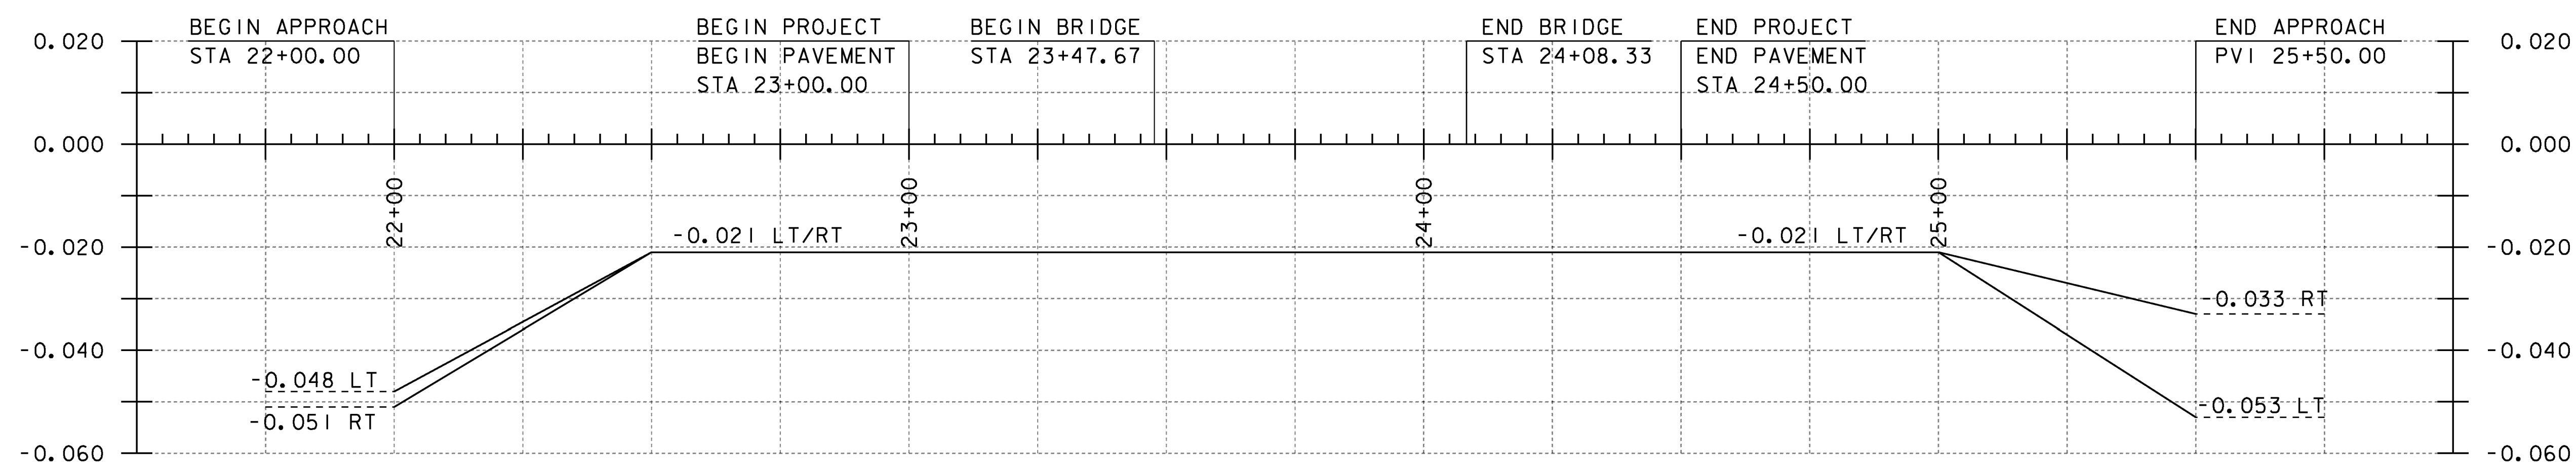

**BANKING DIAGRAM**

SCALE: HORIZONTAL 1"=20'-0"  
 NO VERTICAL SCALE



THE GRADES SHOWN TO THE NEAREST TENTH ARE THE ORIGINAL GROUND ELEVATIONS ALONG THE PROPOSED ALIGNMENT.

THE GRADES SHOWN TO THE NEAREST HUNDREDTH ARE THE FINISH GRADES ALONG THE PROPOSED ALIGNMENT.


PROJECT NAME: CAMBRIDGE  
 PROJECT NUMBER: BRO 1448 (39)

FILE NAME: s12j166profile.dgn  
 PROJECT LEADER: K. HIGGINS  
 DESIGNED BY: G. LAROCHE  
 MAINLINE PROFILE AND BANKING DIAGRAM

PLOT DATE: 29-AUG-2014  
 DRAWN BY: G. LAROCHE  
 CHECKED BY: J. SALVATORI  
 SHEET 11 OF 34

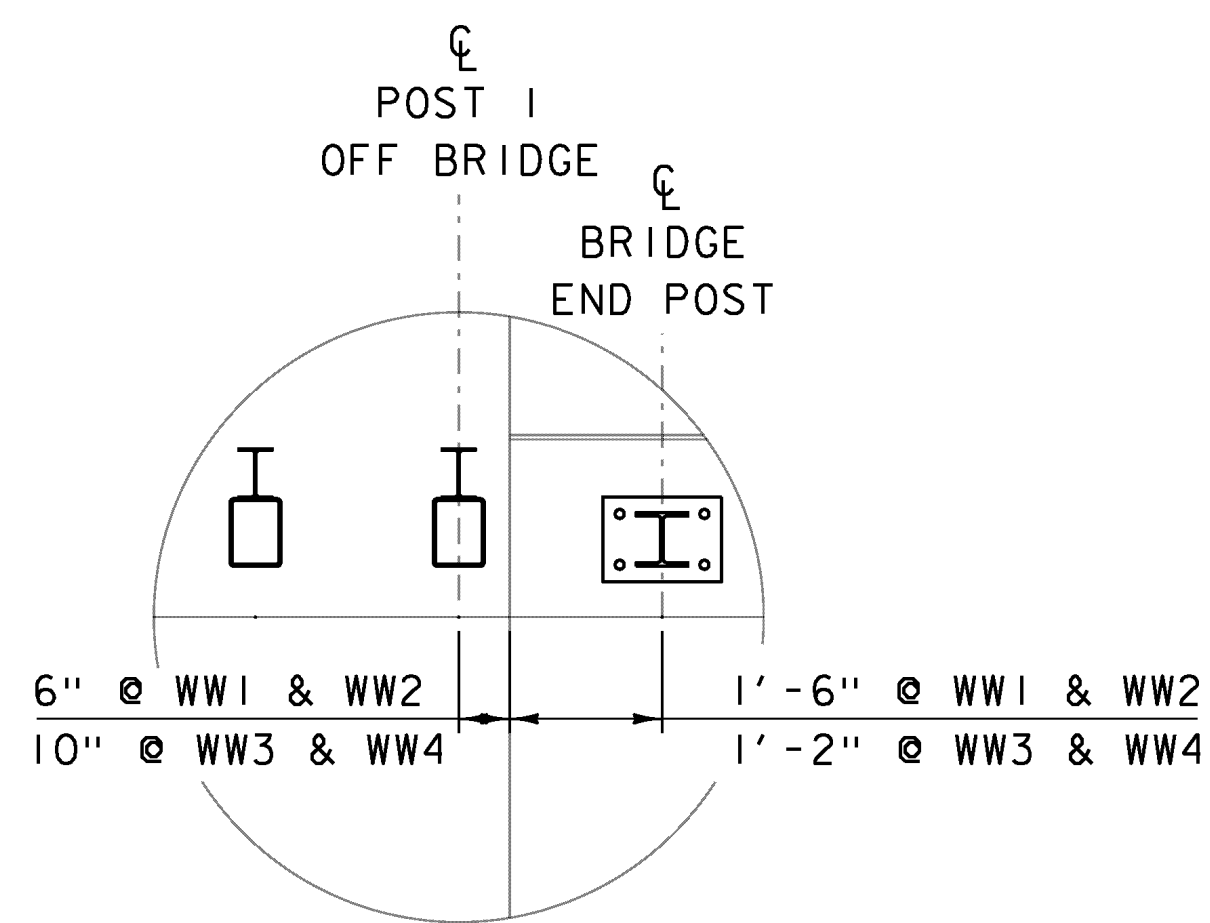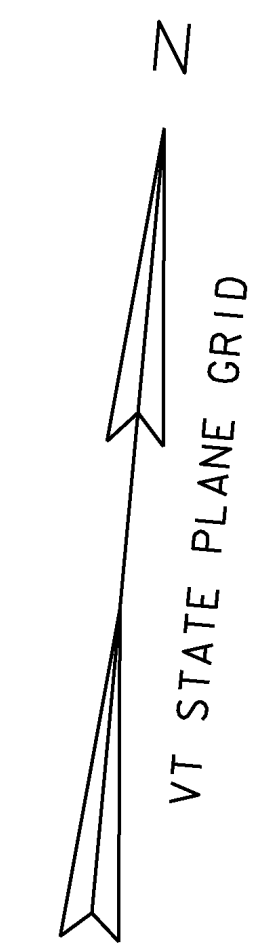

**INSET "A"**  
NOT TO SCALE

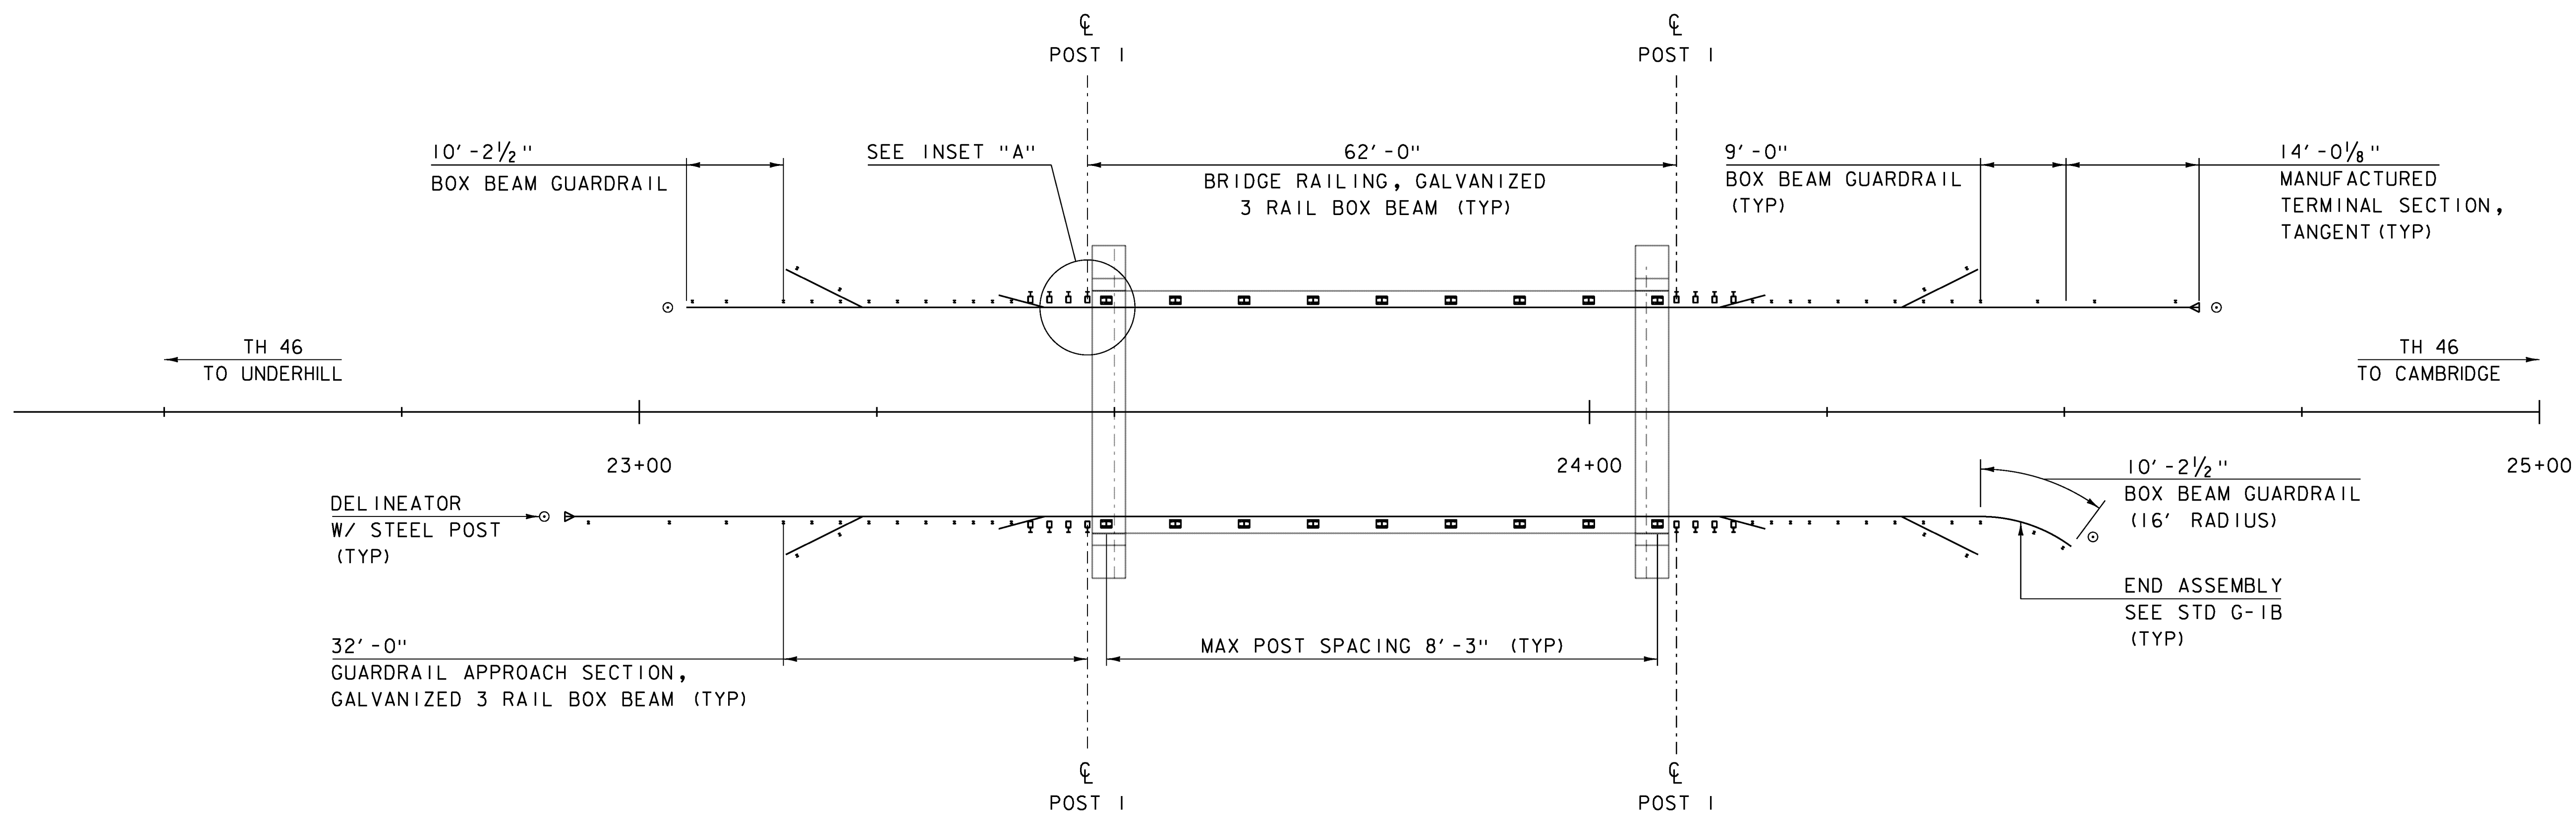

**RAIL LAYOUT SHEET**  
SCALE 1" = 10'-0"

- DELINEATOR W/ STEEL POST**  
 STA 23+03.00 LT (GREEN)  
 STA 22+90.00 RT (BLUE)  
 STA 24+53.00 RT (GREEN)  
 STA 24+66.00 LT (BLUE)

**NOTES:**

1. SEE STANDARDS G-1b, S-364A, S-364B, S-364C AND T-40 FOR FURTHER DETAILS.

PROJECT NAME: CAMBRIDGE	PLOT DATE: 29-AUG-2014
PROJECT NUMBER: BRO 1448(39)	DRAWN BY: J. SALVATORI
FILE NAME: sl2j166rail.dgn	CHECKED BY: J. SALVATORI
PROJECT LEADER: K. HIGGINS	SHEET 12 OF 34
DESIGNED BY: G. LAROCHE	
RAIL LAYOUT SHEET	

**SOIL CLASSIFICATION**

**AASHTO**

A1	Gravel and Sand
A3	Fine Sand
A2	Silty or Clayey Gravel and Sand
A4	Silty Soil - Low Compressibility
A5	Silty Soil - Highly Compressible
A6	Clayey Soil - Low Compressibility
A7	Clayey Soil - Highly Compressible

**ROCK QUALITY DESIGNATION**

R.Q.D. (%)	ROCK DESCRIPTION
<25	Very Poor
25 to 50	Poor
51 to 75	Fair
76 to 90	Good
>90	Excellent

**SHEAR STRENGTH**

UNDRAINED SHEAR STRENGTH IN P.S.F.	CONSISTENCY
<250	Very Soft
250-500	Soft
500-1000	Med. Stiff
1000-2000	Stiff
2000-4000	Very Stiff
>4000	Hard

**CORRELATION GUIDE OF "N" TO DENSITY/CONSISTENCY**


DENSITY (GRANULAR SOILS)		CONSISTENCY (COHESIVE SOILS)	
N	DESCRIPTIVE TERM	N	DESCRIPTIVE TERM
<5	Very Loose	<2	Very Soft
5-10	Loose	2-4	Soft
11-24	Med. Dense	5-8	Med. Stiff
25-50	Dense	9-15	Stiff
>50	Very Dense	16-30	Very Stiff
		31-60	Hard
		>60	Very Hard

**COMMONLY USED SYMBOLS**

- ▼ Water Elevation
- ⊕ Standard Penetration Boring
- ⊕ Auger Boring
- ⊕ Rod Sounding
- S Sample
- N Standard Penetration Test
- Blow Count Per Foot For:  
2" O.D. Sampler  
1 3/8" I.D. Sampler  
Hammer Weight Of 140 Lbs.  
Hammer Fall Of 30"
- VS Field Vane Shear Test
- US Undisturbed Soil Sample
- B Blast
- DC Diamond Core
- MD Mud Drill
- WA Wash Ahead
- HSA Hollow Stem Auger
- AX Core Size 1 1/8"
- BX Core Size 1 3/8"
- NX Core Size 2 1/8"
- M Double Tube Core Barrel Used
- LL Liquid Limit
- PL Plastic Limit
- PI Plasticity Index
- NP Non Plastic
- w Moisture Content (Dry Wgt. Basis)
- D Dry
- M Moist
- MTW Moist To Wet
- W Wet
- Sat Saturated
- Bo Boulder
- Gr Gravel
- Sa Sand
- Sl Silt
- Cl Clay
- HP Hardpan
- Le Ledge
- NLTD No Ledge To Depth
- CNPF Can Not Penetrate Further
- TLOB Top of Ledge Or Boulder
- NR No Recovery
- Rec. Recovery
- %Rec. Percent Recovery
- ROD Rock Quality Designation
- CBR California Bearing Ratio
- < Less Than
- > Greater Than
- R Refusal (N > 100)
- VTSPG NAD83 - See Note 7

**COLOR**

blk	Black	pnk	Pink
bl	Blue	pu	Purple
brn	Brown	rd	Red
dk	Dark	tn	Tan
gry	Gray	wh	White
gn	Green	yel	Yellow
lt	Light	mitc	Multicolored
or	Orange		

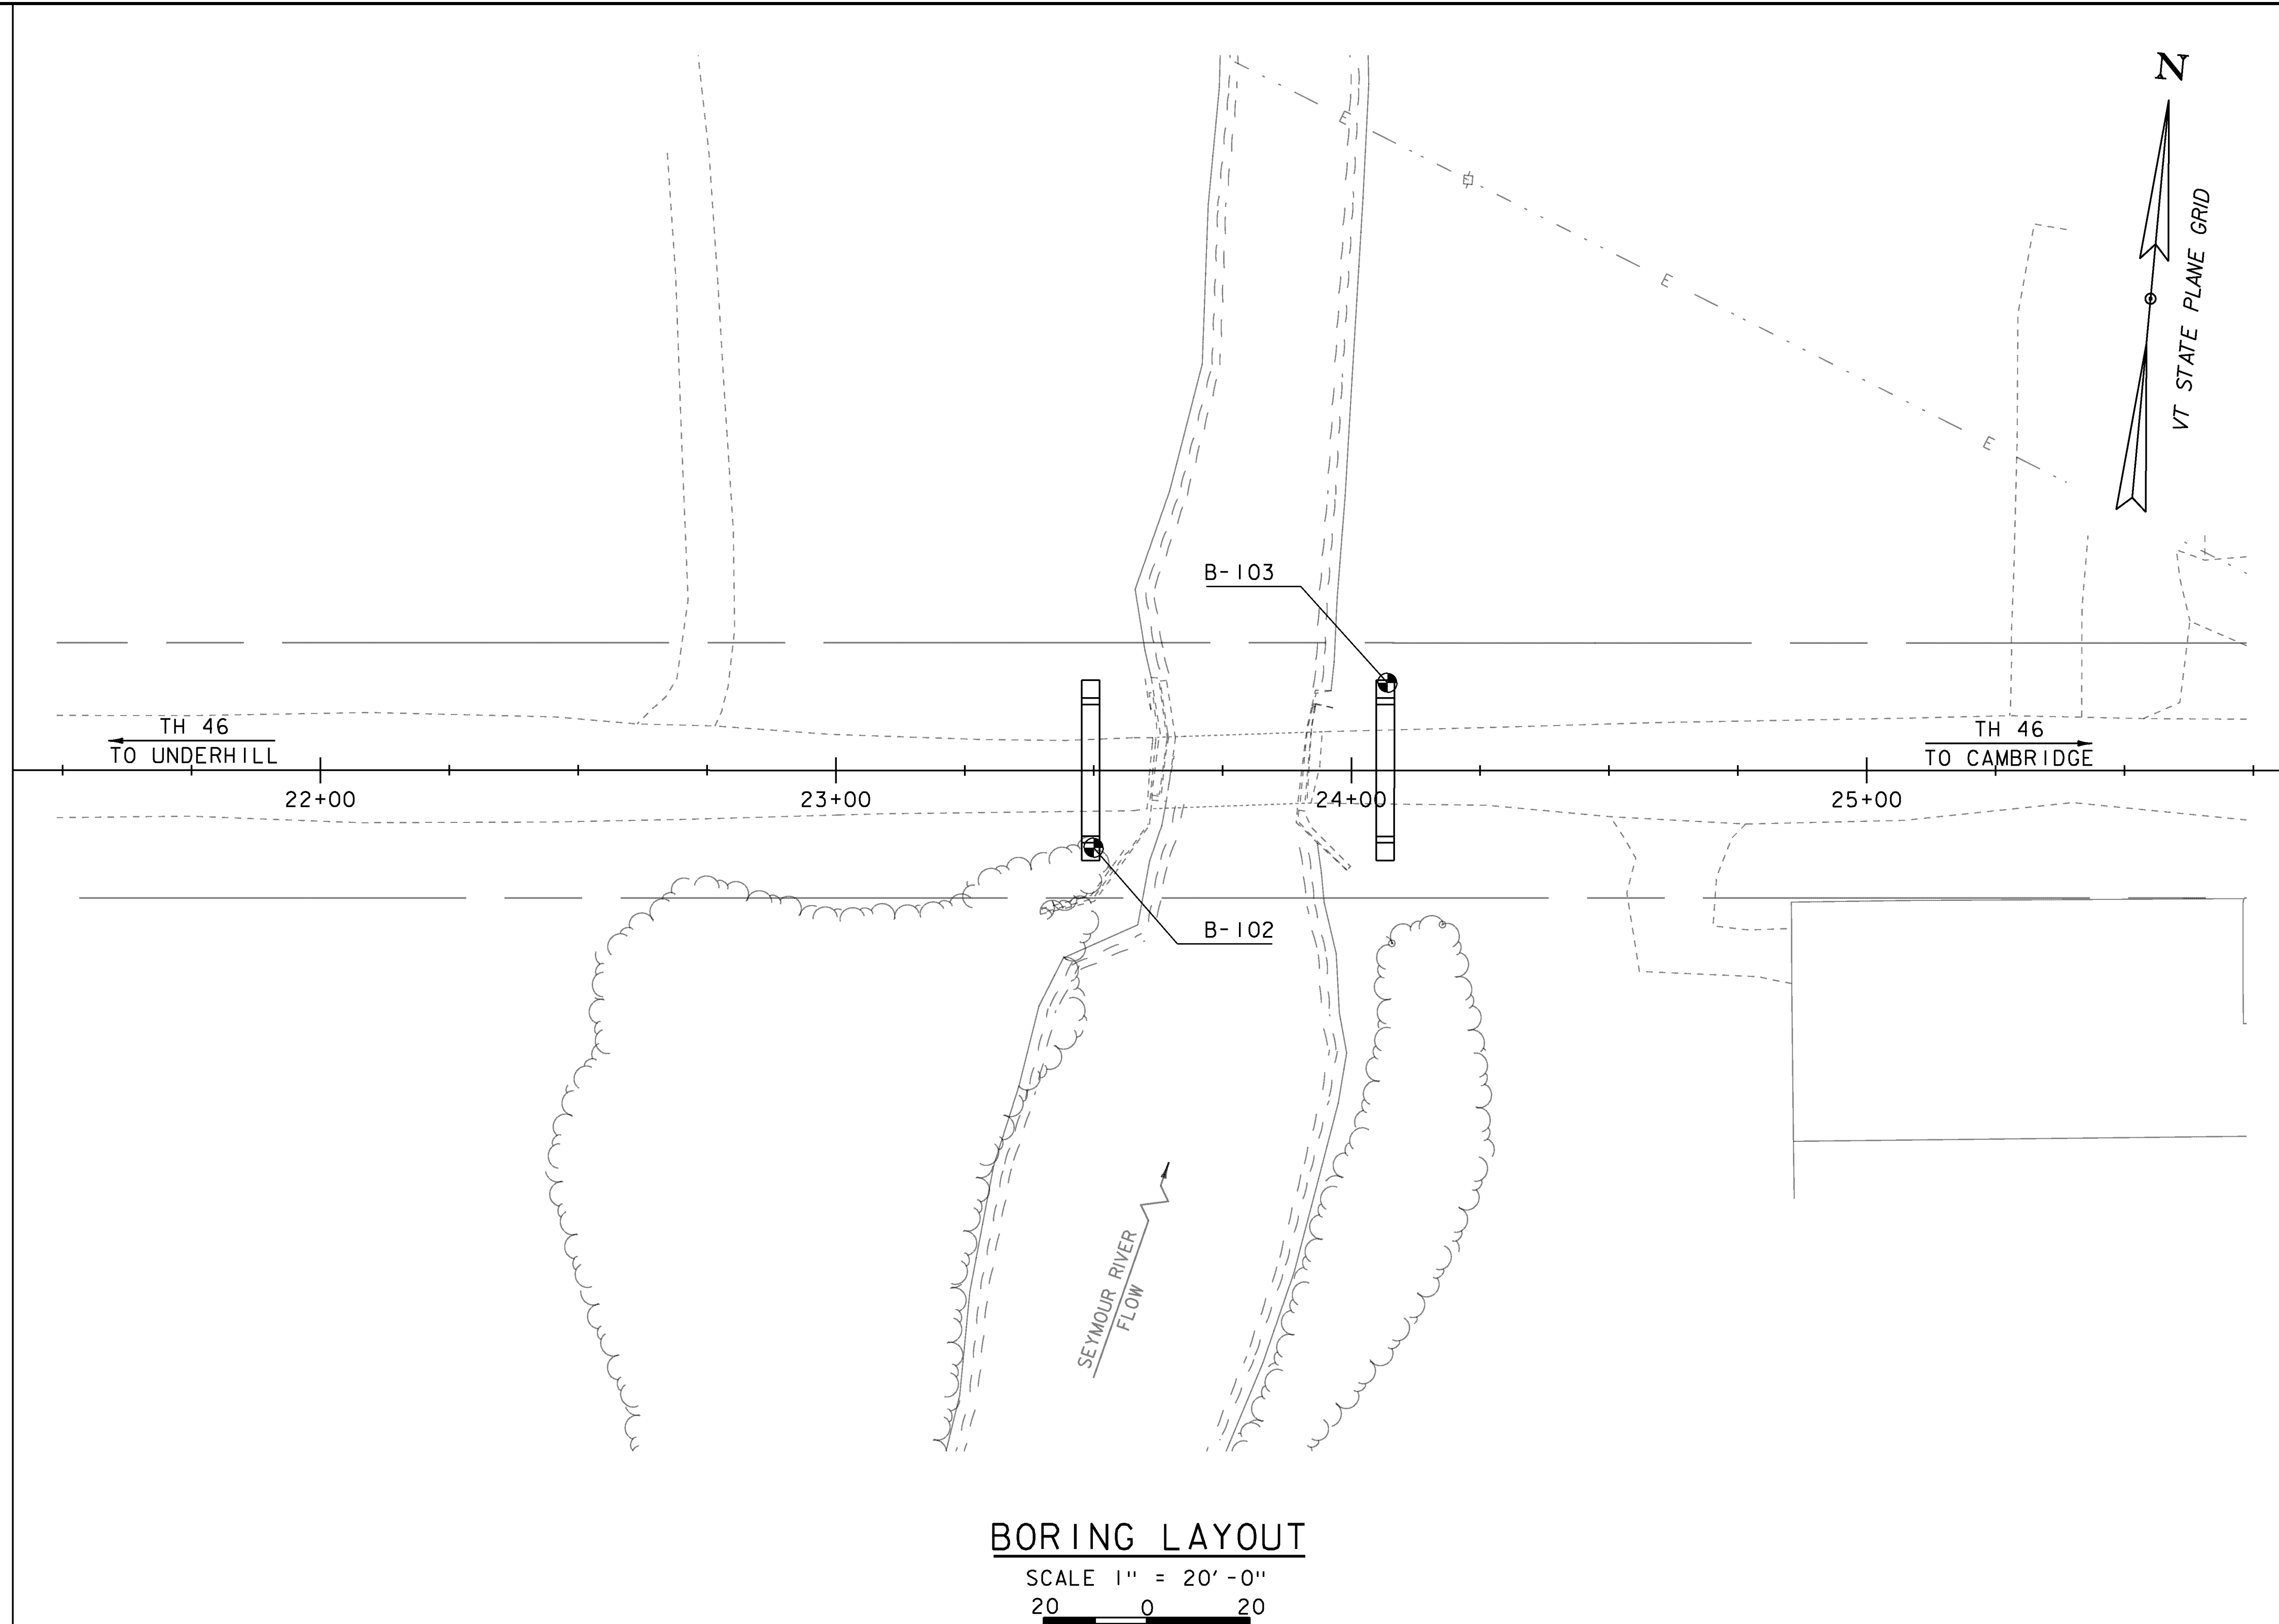

**BORING LAYOUT**

SCALE 1" = 20'-0"  
20 0 20

**DEFINITIONS (AASHTO)**

- BEDROCK (LEDGE)** - Rock in its native location of indefinite thickness.
- BOULDER** - A rock fragment with an average dimension > 12 inches.
- COBBLE** - Rock fragments with an average dimension between 3 and 12 inches.
- GRAVEL** - Rounded particles of rock < 3" and > 0.075" (#10 sieve).
- SAND** - Particles of rock < 0.075" (#10 sieve) and > 0.0025" (#200 sieve).
- SILT** - Soil < 0.0025" (#200 sieve), non or slightly plastic and exhibits no strength when air-dried.
- CLAY** - Fine grained soil, exhibits plasticity when moist and considerable strength when air-dried.
- VARVED** - Alternate layers of silt and clay.
- HARDPAN** - Extremely dense soil, cemented layer, not softened when wet.
- MUCK** - Soft organic soil (containing > 10% organic material).
- MOISTURE CONTENT** - Weight of water divided by dry weight of soil.
- FLOWING SAND** - Granular soil so saturated (loose) that it flows into drill casing during extraction of wash rod.
- STRIKE** - Angle from magnetic north to line of intersection of bed with a horizontal plane.
- DIP** - Inclination of bed with a horizontal plane.

**GENERAL NOTES**

1. The subsurface explorations shown herein were made between 2-4-2013 and 2-21-2013 by the Agency.
2. Soil and rock classifications, properties and descriptions are based on engineering interpretation from available subsurface information by the Agency and may not necessarily reflect actual variations in subsurface conditions that may be encountered between individual boring or sample locations.
3. Observed water levels and/or conditions indicated are as recorded at the time of exploration and may vary according to the prevailing rainfall, methods of exploration and other factors.
4. Engineering judgment was exercised in preparing the subsurface information presented herein. Analysis and interpretation of subsurface data was performed and interpreted for Agency design and estimating purposes. Presentation of the information in the Contract is intended to provide the Contractor access to the same data available to the Agency. The subsurface information is presented in good faith and is not intended as a substitute for personal investigation, independent interpretation, independent analysis or judgment by the Contractor.
5. Pictorial structure details shown on the boring plan layout or soils profile are for illustrative purposes only and may not accurately portray final contract details.
6. Terminology used on boring logs to describe the hardness, degree of weathering, and spacing of fractures, joints and other discontinuities in the bedrock is defined in the AASHTO Manual on Subsurface Investigations, 1988.
7. Northing and Easting coordinates are shown in Vermont State Plane Grid North American Datum 1983 in meters and survey feet.

PROJECT NAME:	CAMBRIDGE	PLOT DATE:	29-AUG-2014
PROJECT NUMBER:	BRO 1448 (39)	DRAWN BY:	K. FRIEDLAND
FILE NAME:	sl2j166boring.dgn	CHECKED BY:	J. SALVATORI
PROJECT LEADER:	K. HIGGINS	BORING LAYOUT	SHEET 13 OF 34
DESIGNED BY:	G. LAROCHE		

VT Trans		STATE OF VERMONT AGENCY OF TRANSPORTATION MATERIALS & RESEARCH SECTION SUBSURFACE INFORMATION		BORING LOG		Boring No.: B-102					
		CAMBRIDGE BRO 1448(39) TH-46 BR-28		Page No.: 1 of 2		Pin No.: 12J166					
		Checked By:		Groundwater Observations							
Boring Crew: GARROW, DAIGNEAULT, WHITLOCK		Type: WB SS		Date							
Date Started: 2/04/13 Date Finished: 2/21/13		I.D.: 4 in 1.5 in		Depth (ft)							
VTSPG NAD83: N 761519.87 ft E 1545223.83 ft		Hammer Wt: N.A. 140 lb.		Notes							
Station: 23+50 Offset: 15.00		Hammer Fall: N.A. 30 in.		02/06/13 7.9 AM							
Ground Elevation: 649.19 ft		Hammer/Rod Type: Auto/AWJ		02/14/13 6.3 AM							
		Rig: CME 55 TRACK CE = 1.46		02/21/13 4.3 AM							
Depth (ft)	Strata (1)	Run (dip deg.)	Core Rec. % (ROD %)	Drill Rate minutes/ft	Blows/6" (N Value)	Moisture Content %	Gravel %	Sand %	Fines %	LL %	PI %
	A-1-b, SaGr, gry, Moist, Rec. = 1.2 ft, Broken Rocks were within sample.				7-31-27-22 (58)	8.2	47.0	37.9	15.1		
	A-1-b, SiSaGr, gry, Moist, Rec. = 0.6 ft, Roots & Broken Rock were within sample.				10-3-20-9 (25)	19.2	51.1	27.5	21.4		
	Field Note: NXDC, GrSa										
	A-1-b, SiSaGr, brn, Moist, Rec. = 0.5 ft, Broken Rocks were within sample.				2-4-7-5 (11)	14.0	48.8	30.3	20.9		
	Field Note: No Recovery				4-3-3-6 (6)						
	Field Note: NXDC, SaSi										
	A-4, Si, gry, MTW, Rec. = 0.9 ft				1-2-3-3 (5)	32.1	0.6	12.1	87.3		
	A-6, SiCl, gry, MTW, Rec. = 1.4 ft				2-2-2-3 (4)	40.6		3.7	96.3	32	13
	A-6, SiCl, gry, Moist, Rec. = 0.7 ft, No N-Value data.					39.6		0.6	99.4	35	11
	A-4, Si, gry, Moist, Rec. = 1.5 ft				WH-2-2-3 (4)	33.9		12.0	88.0		
	A-6, SiCl, gry, Moist, Rec. = 2.0 ft				2-WH-WH-WH (WH)	33.9		1.8	98.2	35	11
	A-4, SaSi, gry, Moist, Rec. = 1.1 ft				2-4-5-7 (9)	30.9		26.8	73.2	25	6
	A-4, Si, gry, Moist, Rec. = 1.4 ft				1-2-4-5 (6)	33.0		11.4	88.6		
	A-4, SaSi, gry, Moist, Rec. = 1.0 ft				1-3-6-10 (9)	29.6		24.6	75.4		
	A-4, Si, gry, Moist, Rec. = 0.7 ft				2-5-5-4 (10)	33.4		16.7	83.3		

ABUTMENT I  
BOTTOM OF  
PILE CAP  
EL 643.00

BORING LOG 2 CAMBRIDGE BRO 1448(39).GPJ VERMONT AOT.GDT 3/12/13

Notes:  
1. Stratification lines represent approximate boundary between material types. Transition may be gradual.  
2. N Values have not been corrected for hammer energy. CE is the hammer energy correction factor.  
3. Water level readings have been made at times and under conditions stated. Fluctuations of groundwater may occur due to other factors than those present at the time measurements were made.

VT Trans		STATE OF VERMONT AGENCY OF TRANSPORTATION MATERIALS & RESEARCH SECTION SUBSURFACE INFORMATION		BORING LOG		Boring No.: B-102					
		CAMBRIDGE BRO 1448(39) TH-46 BR-28		Page No.: 2 of 2		Pin No.: 12J166					
		Checked By:		Groundwater Observations							
Boring Crew: GARROW, DAIGNEAULT, WHITLOCK		Type: WB SS		Date							
Date Started: 2/04/13 Date Finished: 2/21/13		I.D.: 4 in 1.5 in		Depth (ft)							
VTSPG NAD83: N 761519.87 ft E 1545223.83 ft		Hammer Wt: N.A. 140 lb.		Notes							
Station: 23+50 Offset: 15.00		Hammer Fall: N.A. 30 in.		02/06/13 7.9 AM							
Ground Elevation: 649.19 ft		Hammer/Rod Type: Auto/AWJ		02/14/13 6.3 AM							
		Rig: CME 55 TRACK CE = 1.46		02/21/13 4.3 AM							
Depth (ft)	Strata (1)	Run (dip deg.)	Core Rec. % (ROD %)	Drill Rate minutes/ft	Blows/6" (N Value)	Moisture Content %	Gravel %	Sand %	Fines %	LL %	PI %
	A-4, Si, gry, Moist, Rec. = 0.5 ft				1-1-WH-WH (1)	33.5		1.8	98.2	29	2
	A-4, Si, gry, Moist, Rec. = 1.2 ft				3-4-4-3 (8)	30.4		9.8	90.2	24	2
	A-4, SaSi, gry, Moist, Rec. = 1.2 ft				1-1-4-4 (5)	24.2		27.4	72.6		
	A-4, SaSi, gry, Moist, Rec. = 1.4 ft				2-3-4-1 (7)	26.8		24.0	76.0		
	Field Note: Cleaned out casing. Appears to be Gr Sa										
	A-1-b, SiGrSa, gry, Moist, Rec. = 0.5 ft				7-2-3-5 (5)	9.8		35.7	39.2	25.1	
	Field Note: Cleaned out casing. Appears to be Gravel										
	A-2-4, GrSiSa, gry, Moist, Rec. = 0.7 ft				31-R (R)	9.6		29.4	37.5	33.1	
	102.0 ft - 107.0 ft, Silvery-green, Phyllite, Moderately soft, Moderately weathered, Poor rock, NXMDC, RMR = 25		1 (80)	54 (0)	6 6 5 6 5						
	107.0 ft - 112.0 ft, Silvery-green, Phyllite, Moderately soft, Slightly weathered, Poor rock, NXMDC, RMR = 25		2 (80)	94 (10)	6 6 7 6 7						
	Hole stopped @ 112.0 ft										
	Remarks: Ground surface elevation estimated from topographic plan.										

PILE TIP  
EL 547.19

BORING LOG 2 CAMBRIDGE BRO 1448(39).GPJ VERMONT AOT.GDT 3/12/13

Notes:  
1. Stratification lines represent approximate boundary between material types. Transition may be gradual.  
2. N Values have not been corrected for hammer energy. CE is the hammer energy correction factor.  
3. Water level readings have been made at times and under conditions stated. Fluctuations of groundwater may occur due to other factors than those present at the time measurements were made.

PROJECT NAME: CAMBRIDGE  
PROJECT NUMBER: BRO 1448 (39)  
FILE NAME: s12j166boring.dgn  
PROJECT LEADER: K. HIGGINS  
DESIGNED BY: G. LAROCHE  
BORING LOG I  
PLOT DATE: 29-AUG-2014  
DRAWN BY: J. SALVATORI  
CHECKED BY: G. LAROCHE  
SHEET 14 OF 34

VT Trans		STATE OF VERMONT AGENCY OF TRANSPORTATION MATERIALS & RESEARCH SECTION SUBSURFACE INFORMATION		BORING LOG		Boring No.: B-103						
		CAMBRIDGE BRO 1448(39) TH-46 BR-28		Page No.: 1 of 2		Pin No.: 12J166						
		Checked By:		Groundwater Observations								
Boring Crew: GARROW, DAIGNEAULT, WHITLOCK		Type: WB SS		Date								
Date Started: 2/25/13 Date Finished: 2/28/13		I.D.: 4 in 1.5 in		Depth (ft)								
VTSPG NAD83: N 761493.24 ft E 1545283.52 ft		Hammer Wt: N.A. 140 lb.		Notes								
Station: 24+07 Offset: -17.00		Hammer Fall: N.A. 30 in.		02/26/13 3.4 AM								
Ground Elevation: 648.64 ft		Hammer/Rod Type: Auto/AWJ		02/28/13 3.3 AM								
		Rig: CME 55 TRACK CE = 1.46										
Depth (ft)	Strata (1)	CLASSIFICATION OF MATERIALS (Description)	Run (dip deg.)	Core Rec. % (ROD %)	Drill Rate (min/ft)	Blows/6" (N Value)	Moisture Content %	Gravel %	Sand %	Fines %	LL %	PI %
		Field Note: Cleaned out casing										
		Field Note: No Recovery				2-3-2-4 (5)						
		Field Note: Lost Water Return at 6.0 ft.										
10		A-1-a, SaGr, brn, MTW, Rec. = 0.5 ft, Broken Rock was within sample.				4-4-4-6 (8)	15.9	59.1	33.5	7.4		
		Field Note: Cleaned out casing. Appears to be SaSi										
		A-4, Si, gry, MTW, Rec. = 1.2 ft, A very thin layer of Clay was noticeable.				2-3-3-5 (6)	32.0	0.3	4.5	95.2		
20		A-4, Cisi, gry, MTW, Rec. = 2.0 ft				1-WH-WH-1 (WH)	32.9	5.6	94.4	27	7	
		A-4, Cisi, gry, MTW, Rec. = 1.4 ft				2-1-2-2 (3)	36.8	7.8	92.2	29	10	
30		A-4, Cisi, gry, MTW, Rec. = 1.6 ft, Regained Water Return at 29.0 ft.				1-WH-1-1 (1)	56.9	6.1	93.9	30	9	
		A-4, SaSi, gry, MTW, Rec. = 1.5 ft				1-3-6-3 (9)	31.2	22.1	77.9			
		Field Note: Cleaned out casing. Appears to be Si Sa										
40		A-4, Cisi, gry, MTW, Rec. = 1.2 ft				4-5-4-4 (9)	38.4	0.1	11.3	88.6	28	9
		A-4, Si, gry, MTW, Rec. = 1.8 ft, A very thin layer of Clay was noticeable.				2-2-3-3 (5)	34.5	11.7	88.3			
50		A-4, SaSi, gry, MTW, Rec. = 1.0 ft				2-2-3-3 (5)	30.1	43.2	56.8			
		A-4, Si, gry, MTW, Rec. = 1.4 ft				2-3-2-2 (5)	33.0	15.2	84.8			
		A-4, Si, gry, MTW, Rec. = 2.0 ft				WH-WH-WH-2 (WH)	36.0	2.0	98.0	31	4	

ABUTMENT 2  
BOTTOM OF  
PILE CAP  
EL 643.25

BORING LOG 2 CAMBRIDGE BRO 1448(39).GPJ VERMONT AOT.GDT 3/12/13

Notes:  
1. Stratification lines represent approximate boundary between material types. Transition may be gradual.  
2. N Values have not been corrected for hammer energy. CE is the hammer energy correction factor.  
3. Water level readings have been made at times and under conditions stated. Fluctuations of groundwater may occur due to other factors than those present at the time measurements were made.



VT Trans		STATE OF VERMONT AGENCY OF TRANSPORTATION MATERIALS & RESEARCH SECTION SUBSURFACE INFORMATION		BORING LOG		Boring No.: B-103						
		CAMBRIDGE BRO 1448(39) TH-46 BR-28		Page No.: 2 of 2		Pin No.: 12J166						
		Checked By:		Groundwater Observations								
Boring Crew: GARROW, DAIGNEAULT, WHITLOCK		Type: WB SS		Date								
Date Started: 2/25/13 Date Finished: 2/28/13		I.D.: 4 in 1.5 in		Depth (ft)								
VTSPG NAD83: N 761493.24 ft E 1545283.52 ft		Hammer Wt: N.A. 140 lb.		Notes								
Station: 24+07 Offset: -17.00		Hammer Fall: N.A. 30 in.		02/26/13 3.4 AM								
Ground Elevation: 648.64 ft		Hammer/Rod Type: Auto/AWJ		02/28/13 3.3 AM								
		Rig: CME 55 TRACK CE = 1.46										
Depth (ft)	Strata (1)	CLASSIFICATION OF MATERIALS (Description)	Run (dip deg.)	Core Rec. % (ROD %)	Drill Rate (min/ft)	Blows/6" (N Value)	Moisture Content %	Gravel %	Sand %	Fines %	LL %	PI %
		A-4, SaSi, gry, MTW, Rec. = 2.0 ft, A very thin layer of Clay was noticeable.				WH-1-WH-1 (1)	26.5	0.1	27.5	72.4		
70		A-4, Si, gry, MTW, Rec. = 1.8 ft				1-WH-1-2 (1)	29.0	18.2	81.8			
		Field Note: Cleaned out casing. Appears to be Sa Gr										
80		A-1-b, SiSaGr, gry, Moist, Rec. = 0.4 ft				10-7-1-2 (8)	9.3	45.2	34.6	20.2		
		Field Note: Cleaned out casing. Appears to be Sa										
90		Field Note: No Recovery				8-27-20-16 (47)						
		Field Note: No Recovery				R@6.0"						
100		98.2 ft - 102.2 ft, Soft, Broken, Weathered Rock. Poor rock, NXDC										
		102.2 ft - 107.2 ft, Silvery-green, Quartz-muscovite-chlorite Schist, Moderately hard, Unweathered, Fair rock, NXMDC, RMR = 56				1 (80)	100 (62)	4	5	5		
110		107.2 ft - 112.2 ft, Silvery-green, Quartz-muscovite-chlorite Schist, Moderately hard, Unweathered, Good rock, NXMDC, RMR = 63				2 (80)	100 (92)	5	7	7		
		Hole stopped @ 112.2 ft										
		Remarks: Ground surface elevation estimated from topographic plan.										

PILE TIP  
EL 546.44

BORING LOG 2 CAMBRIDGE BRO 1448(39).GPJ VERMONT AOT.GDT 3/12/13

Notes:  
1. Stratification lines represent approximate boundary between material types. Transition may be gradual.  
2. N Values have not been corrected for hammer energy. CE is the hammer energy correction factor.  
3. Water level readings have been made at times and under conditions stated. Fluctuations of groundwater may occur due to other factors than those present at the time measurements were made.

PROJECT NAME: CAMBRIDGE  
PROJECT NUMBER: BRO 1448 (39)  
FILE NAME: sl2j166boring.dgn PLOT DATE: 29-AUG-2014  
PROJECT LEADER: K. HIGGINS DRAWN BY: J. SALVATORI  
DESIGNED BY: G. LAROCHE CHECKED BY: G. LAROCHE  
BORING LOG 2 SHEET 15 OF 34

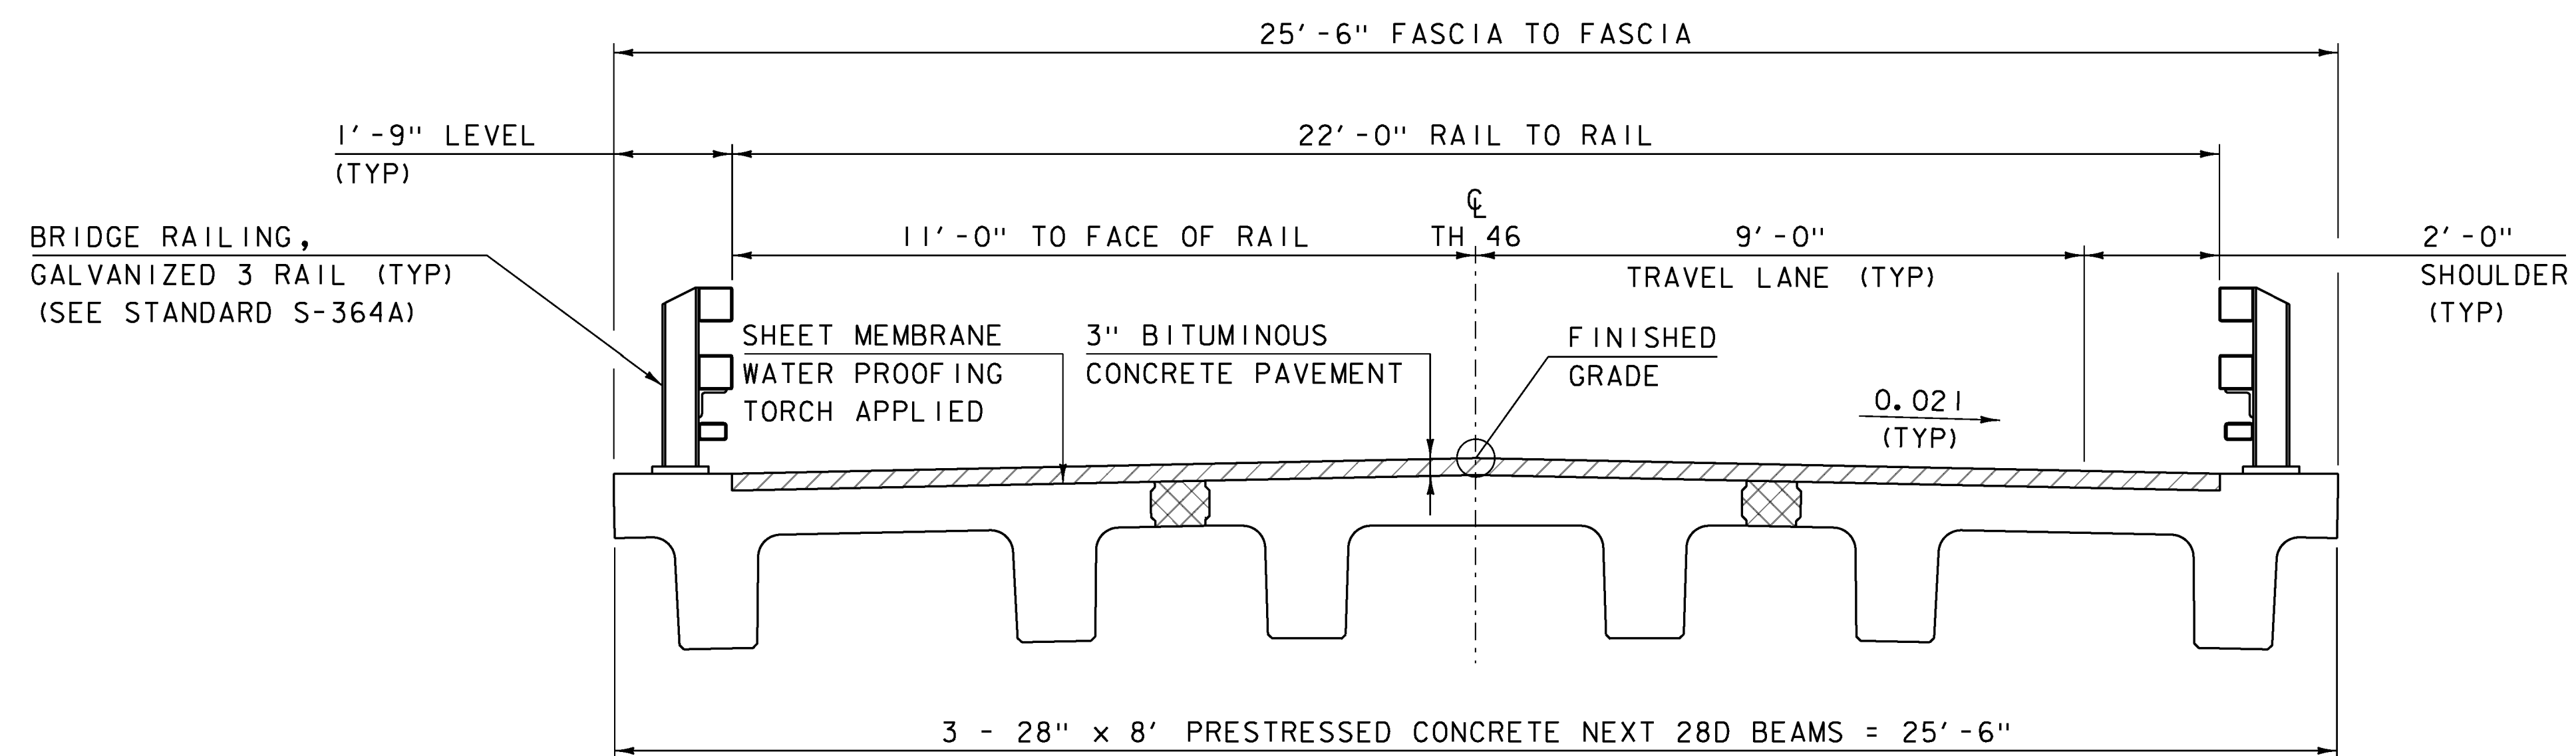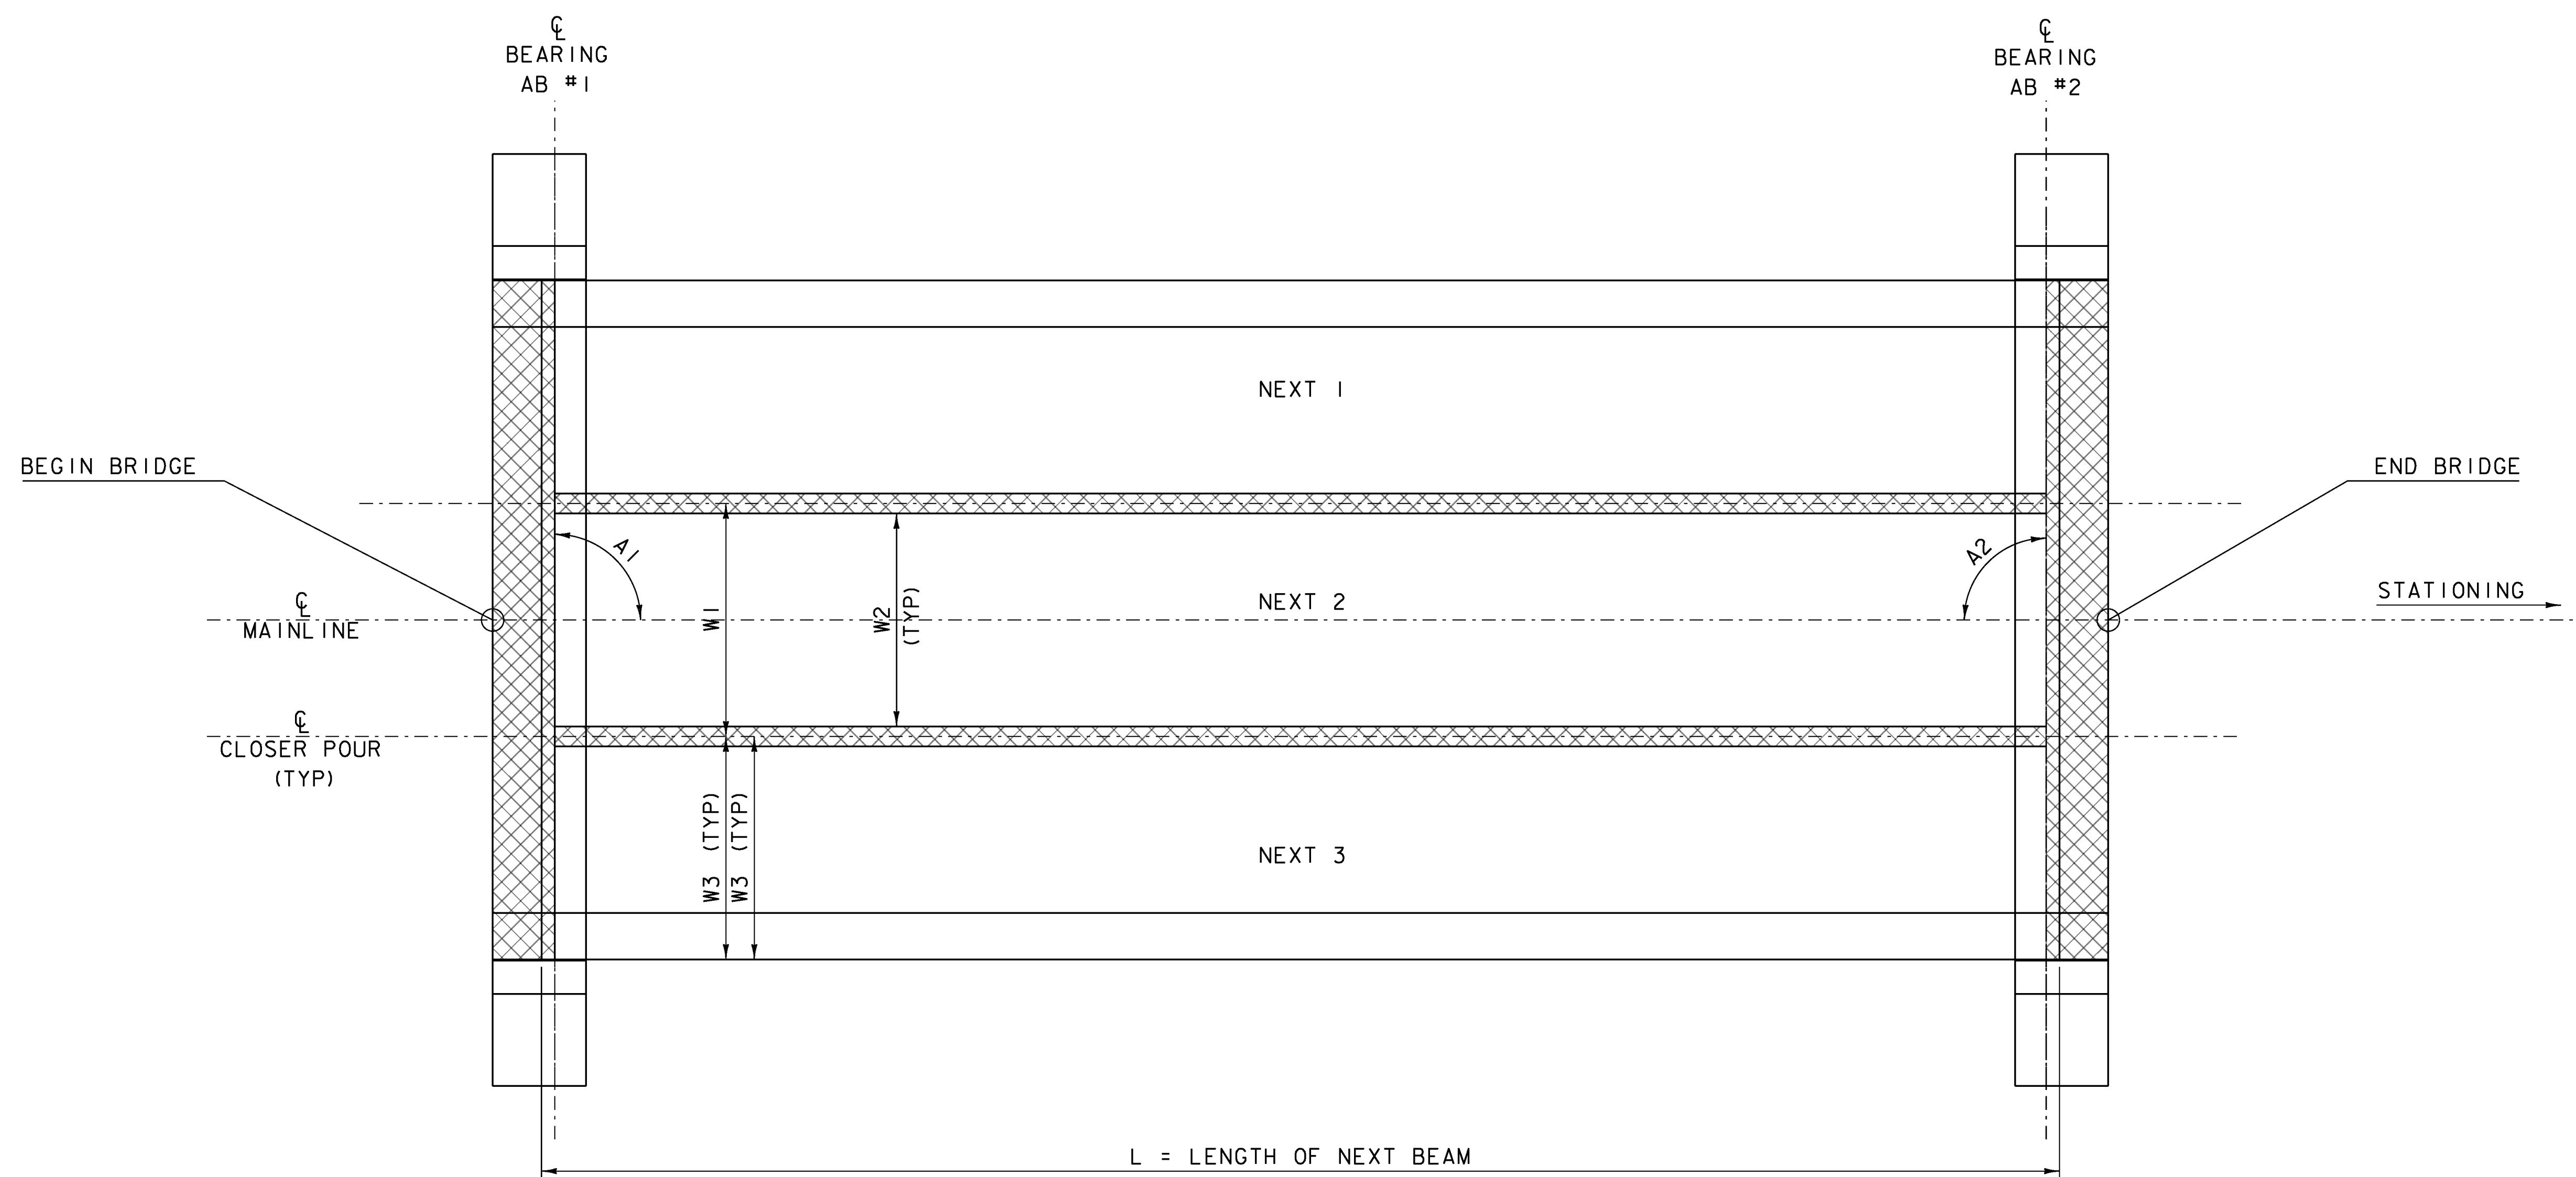

SPECIAL PROVISION (HIGH PERFORMANCE CONCRETE, RAPID SET)

BITUMINOUS CONCRETE PAVEMENT


L	57' - 0"
W1	8' - 9"
W2	8' - 0"
W3	8' - 4 1/2"

SKEW	A1	90°
	A2	90°


PROJECT NAME: CAMBRIDGE  
PROJECT NUMBER: BRO 1448(39)

FILE NAME: s12j166sup.dgn  
PROJECT LEADER: K. HIGGINS  
DESIGNED BY: G. LAROCHE  
FRAMING PLAN


PLOT DATE: 16-SEP-2014  
DRAWN BY: G. LAROCHE  
CHECKED BY: J. SALVATORI  
SHEET 16 OF 34

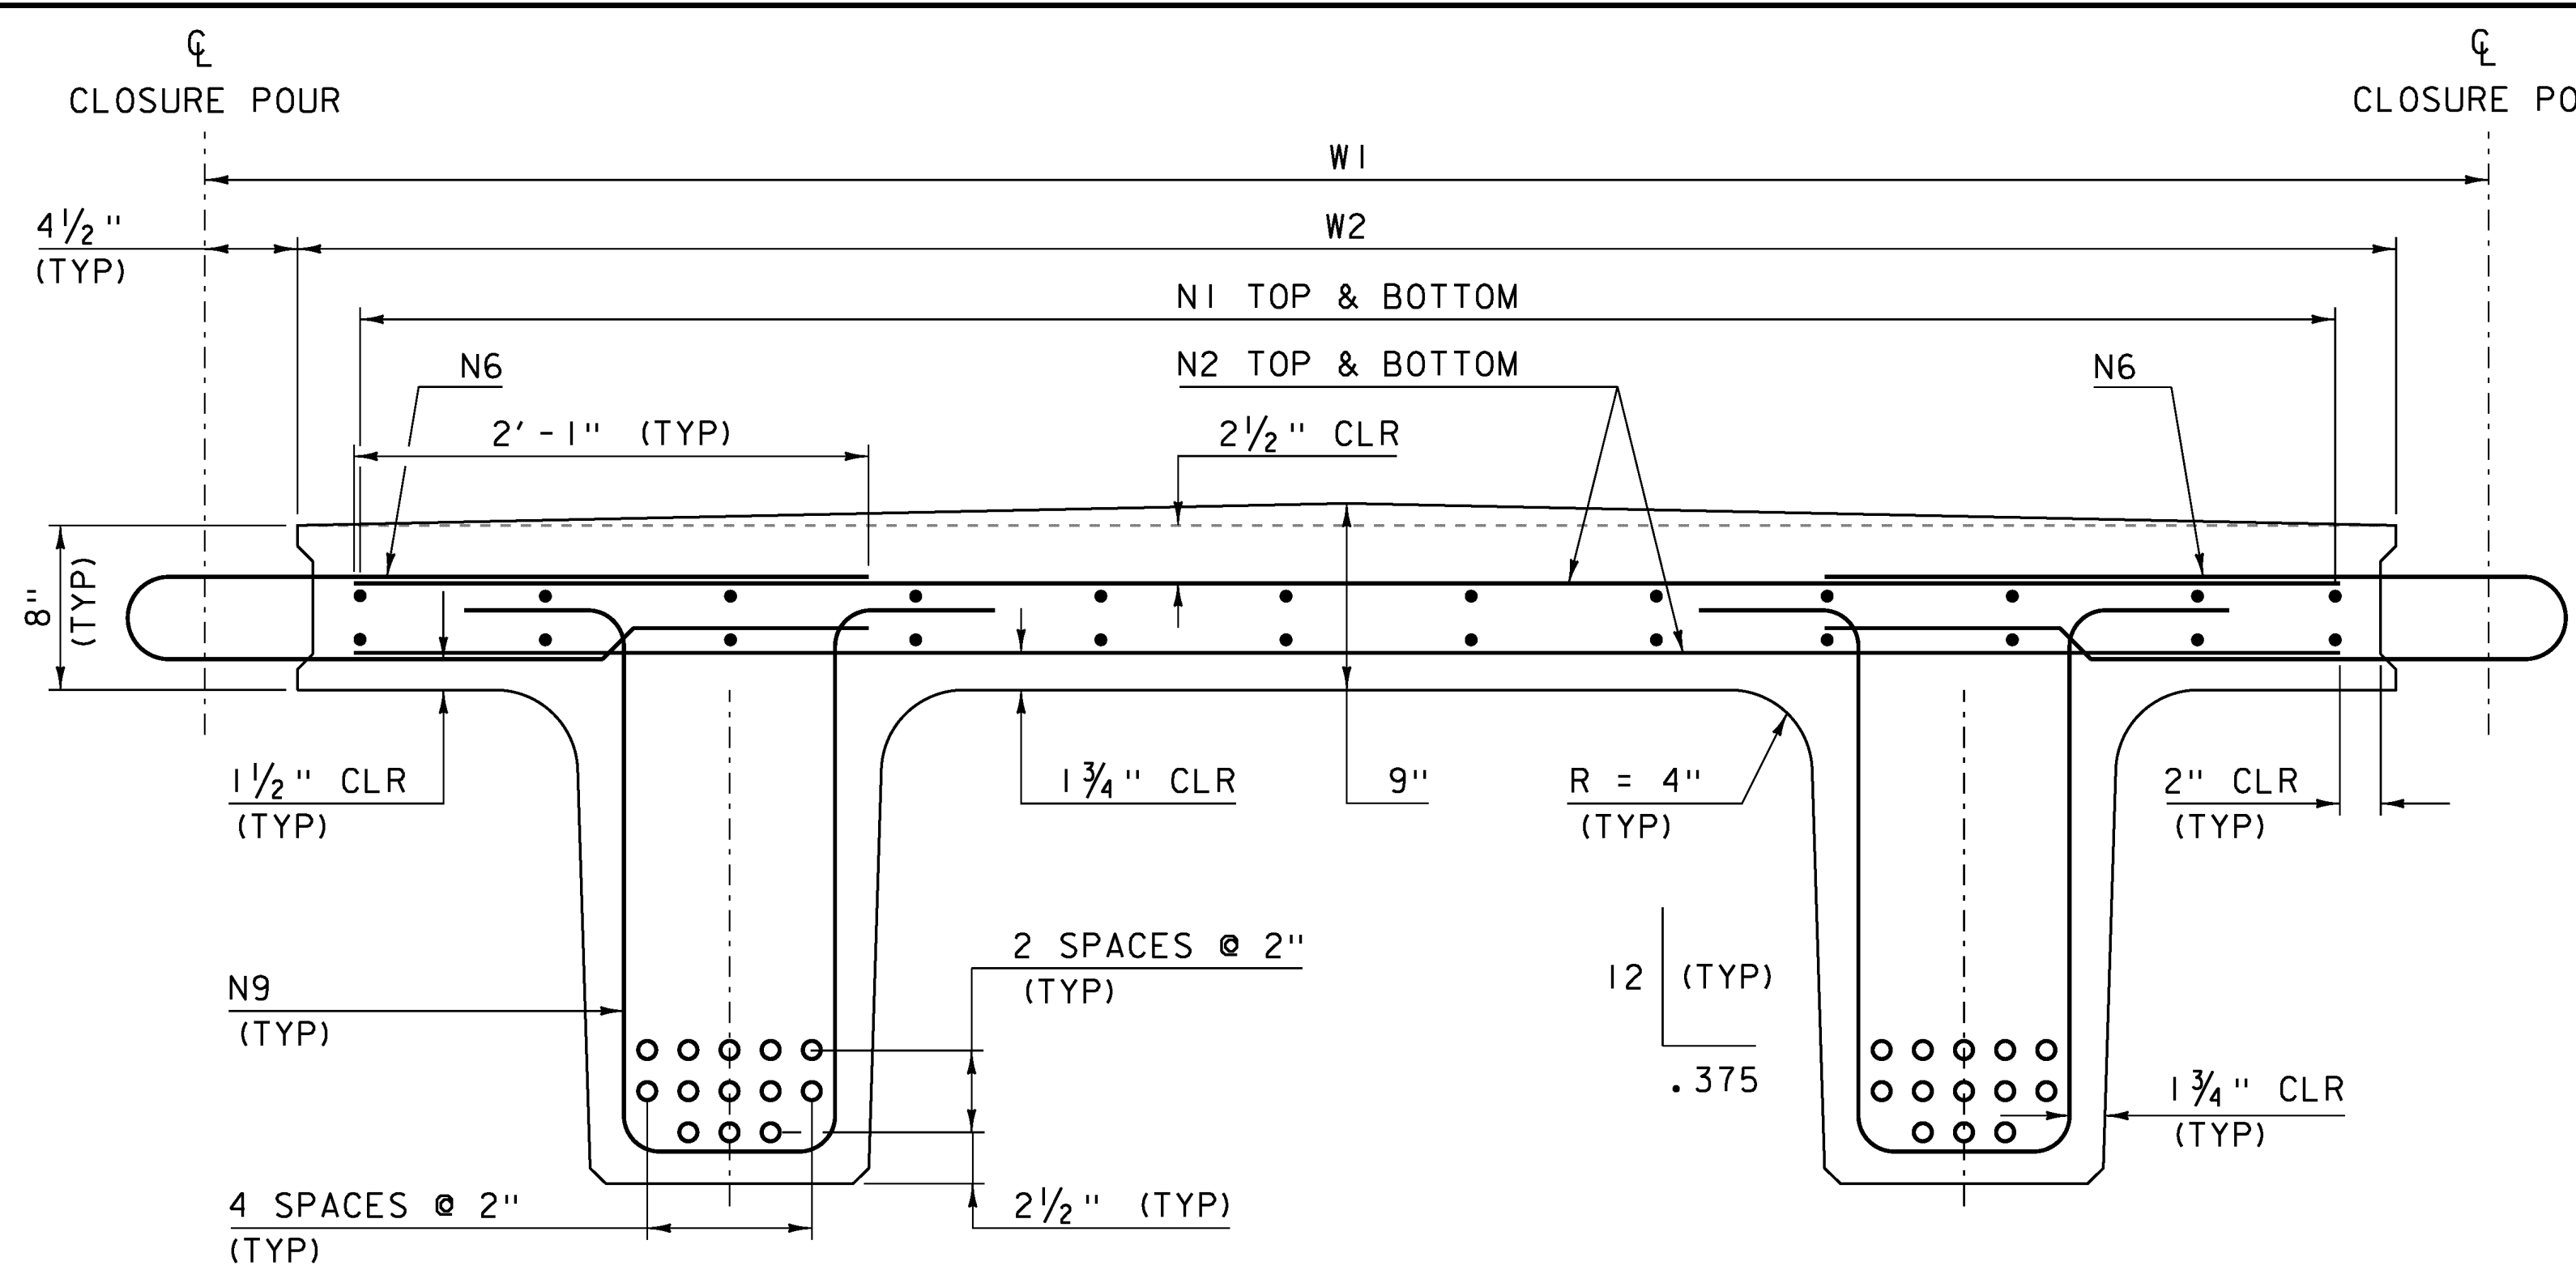

**UNIT 2**  
NOT TO SCALE

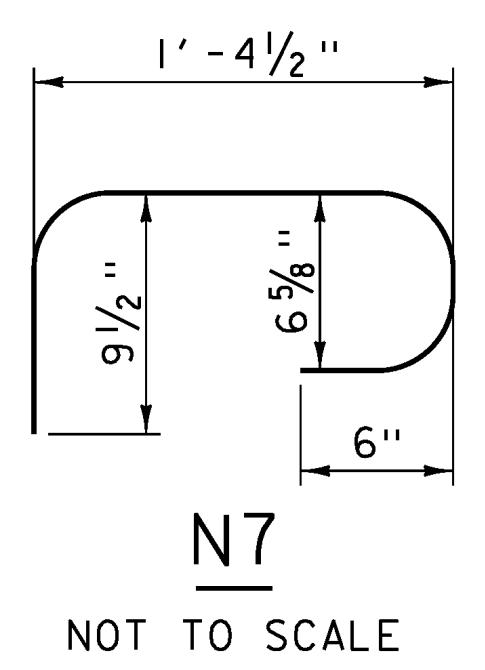


**N7**  
NOT TO SCALE

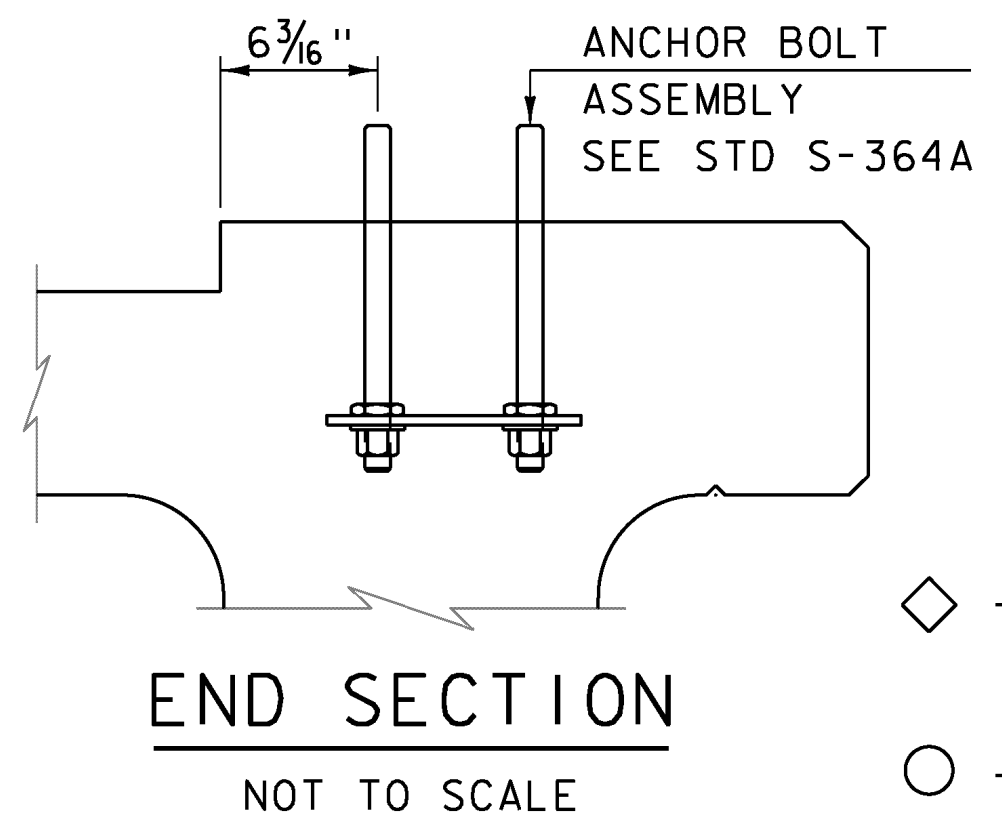


**END SECTION**  
NOT TO SCALE

- LEGEND**
- ◇ - EXTEND 2' - 11" OUT OF BEAM (90° BEND @ 1' - 5" OUT)
  - - DEBONDED 0' - 6"
  - - DEBONDED 1' - 0"
  - ▽ - DEBONDED 1' - 6"

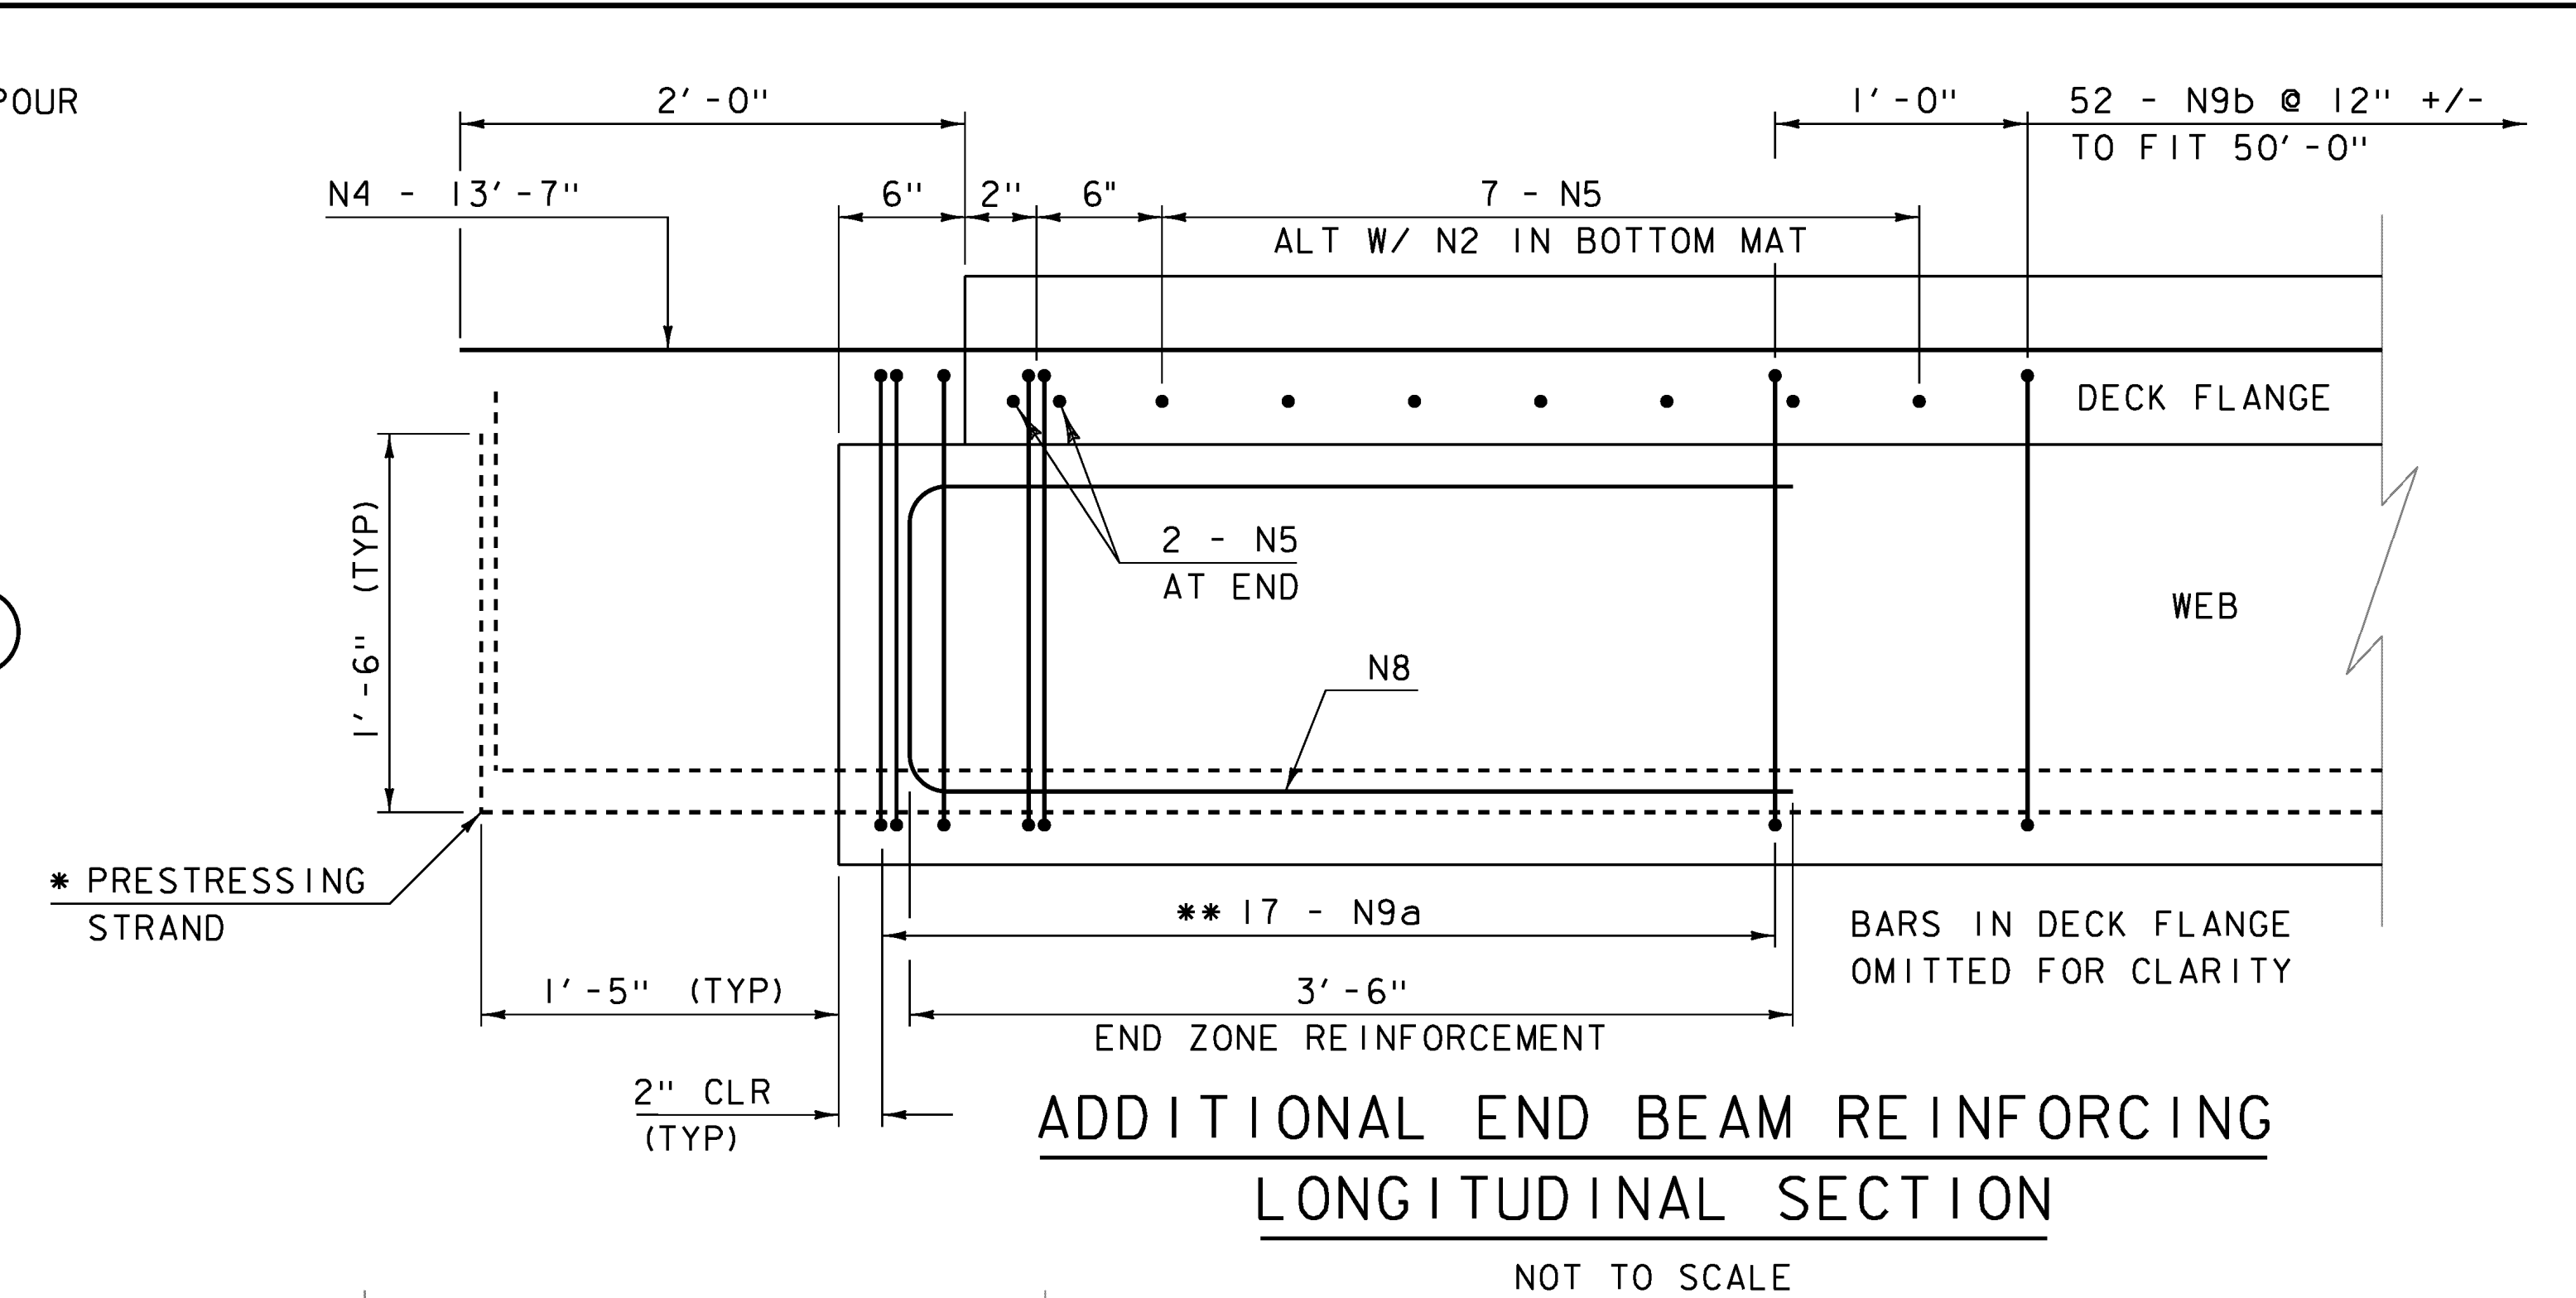


**ADDITIONAL END BEAM REINFORCING**  
**LONGITUDINAL SECTION**  
NOT TO SCALE

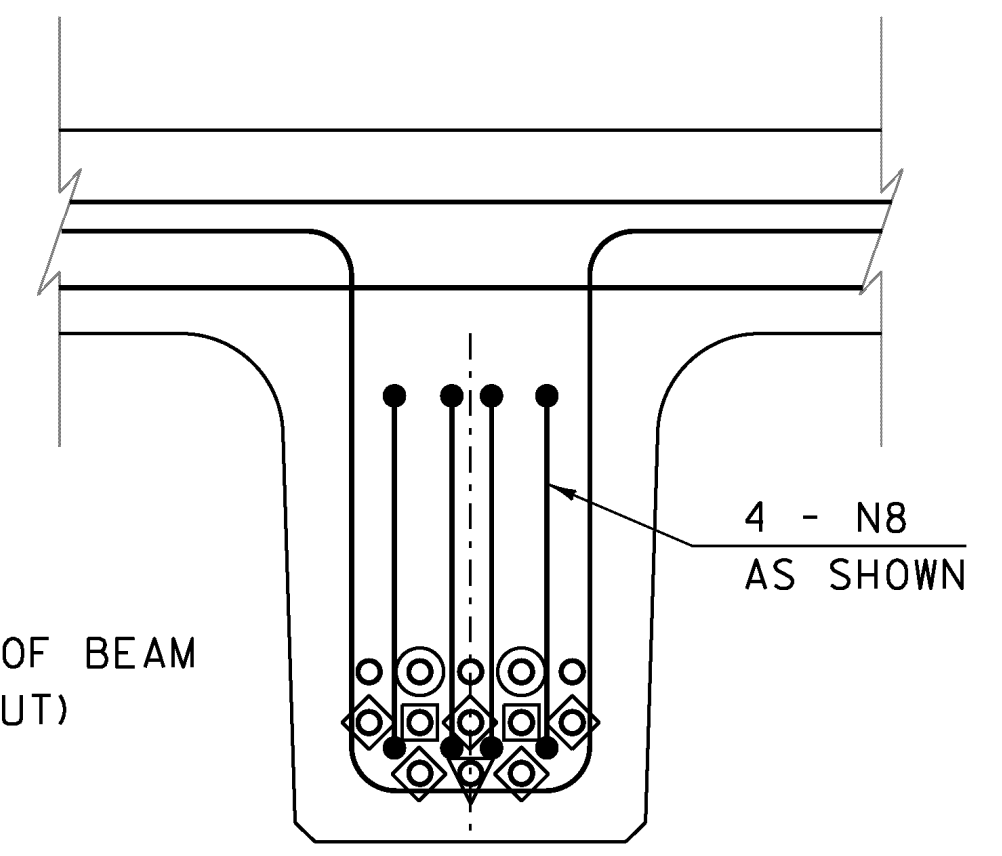


**BEAM SECTION**  
NOT TO SCALE

**NOTES:**

- * LEAVE FIVE STRANDS LONG PER STEM AS INDICATED. TIE STRANDS TO HORIZONTAL FF REINFORCING IN DECK CLOSURE POUR. SLEEVES FOR PERMANENT BENDING OF THE PRESTRESSING STRANDS WILL NOT BE ALLOWED INSIDE THE CLOSURE POUR.
- ** THE FIRST AND THIRD PAIRS WILL BE BUNDLED.

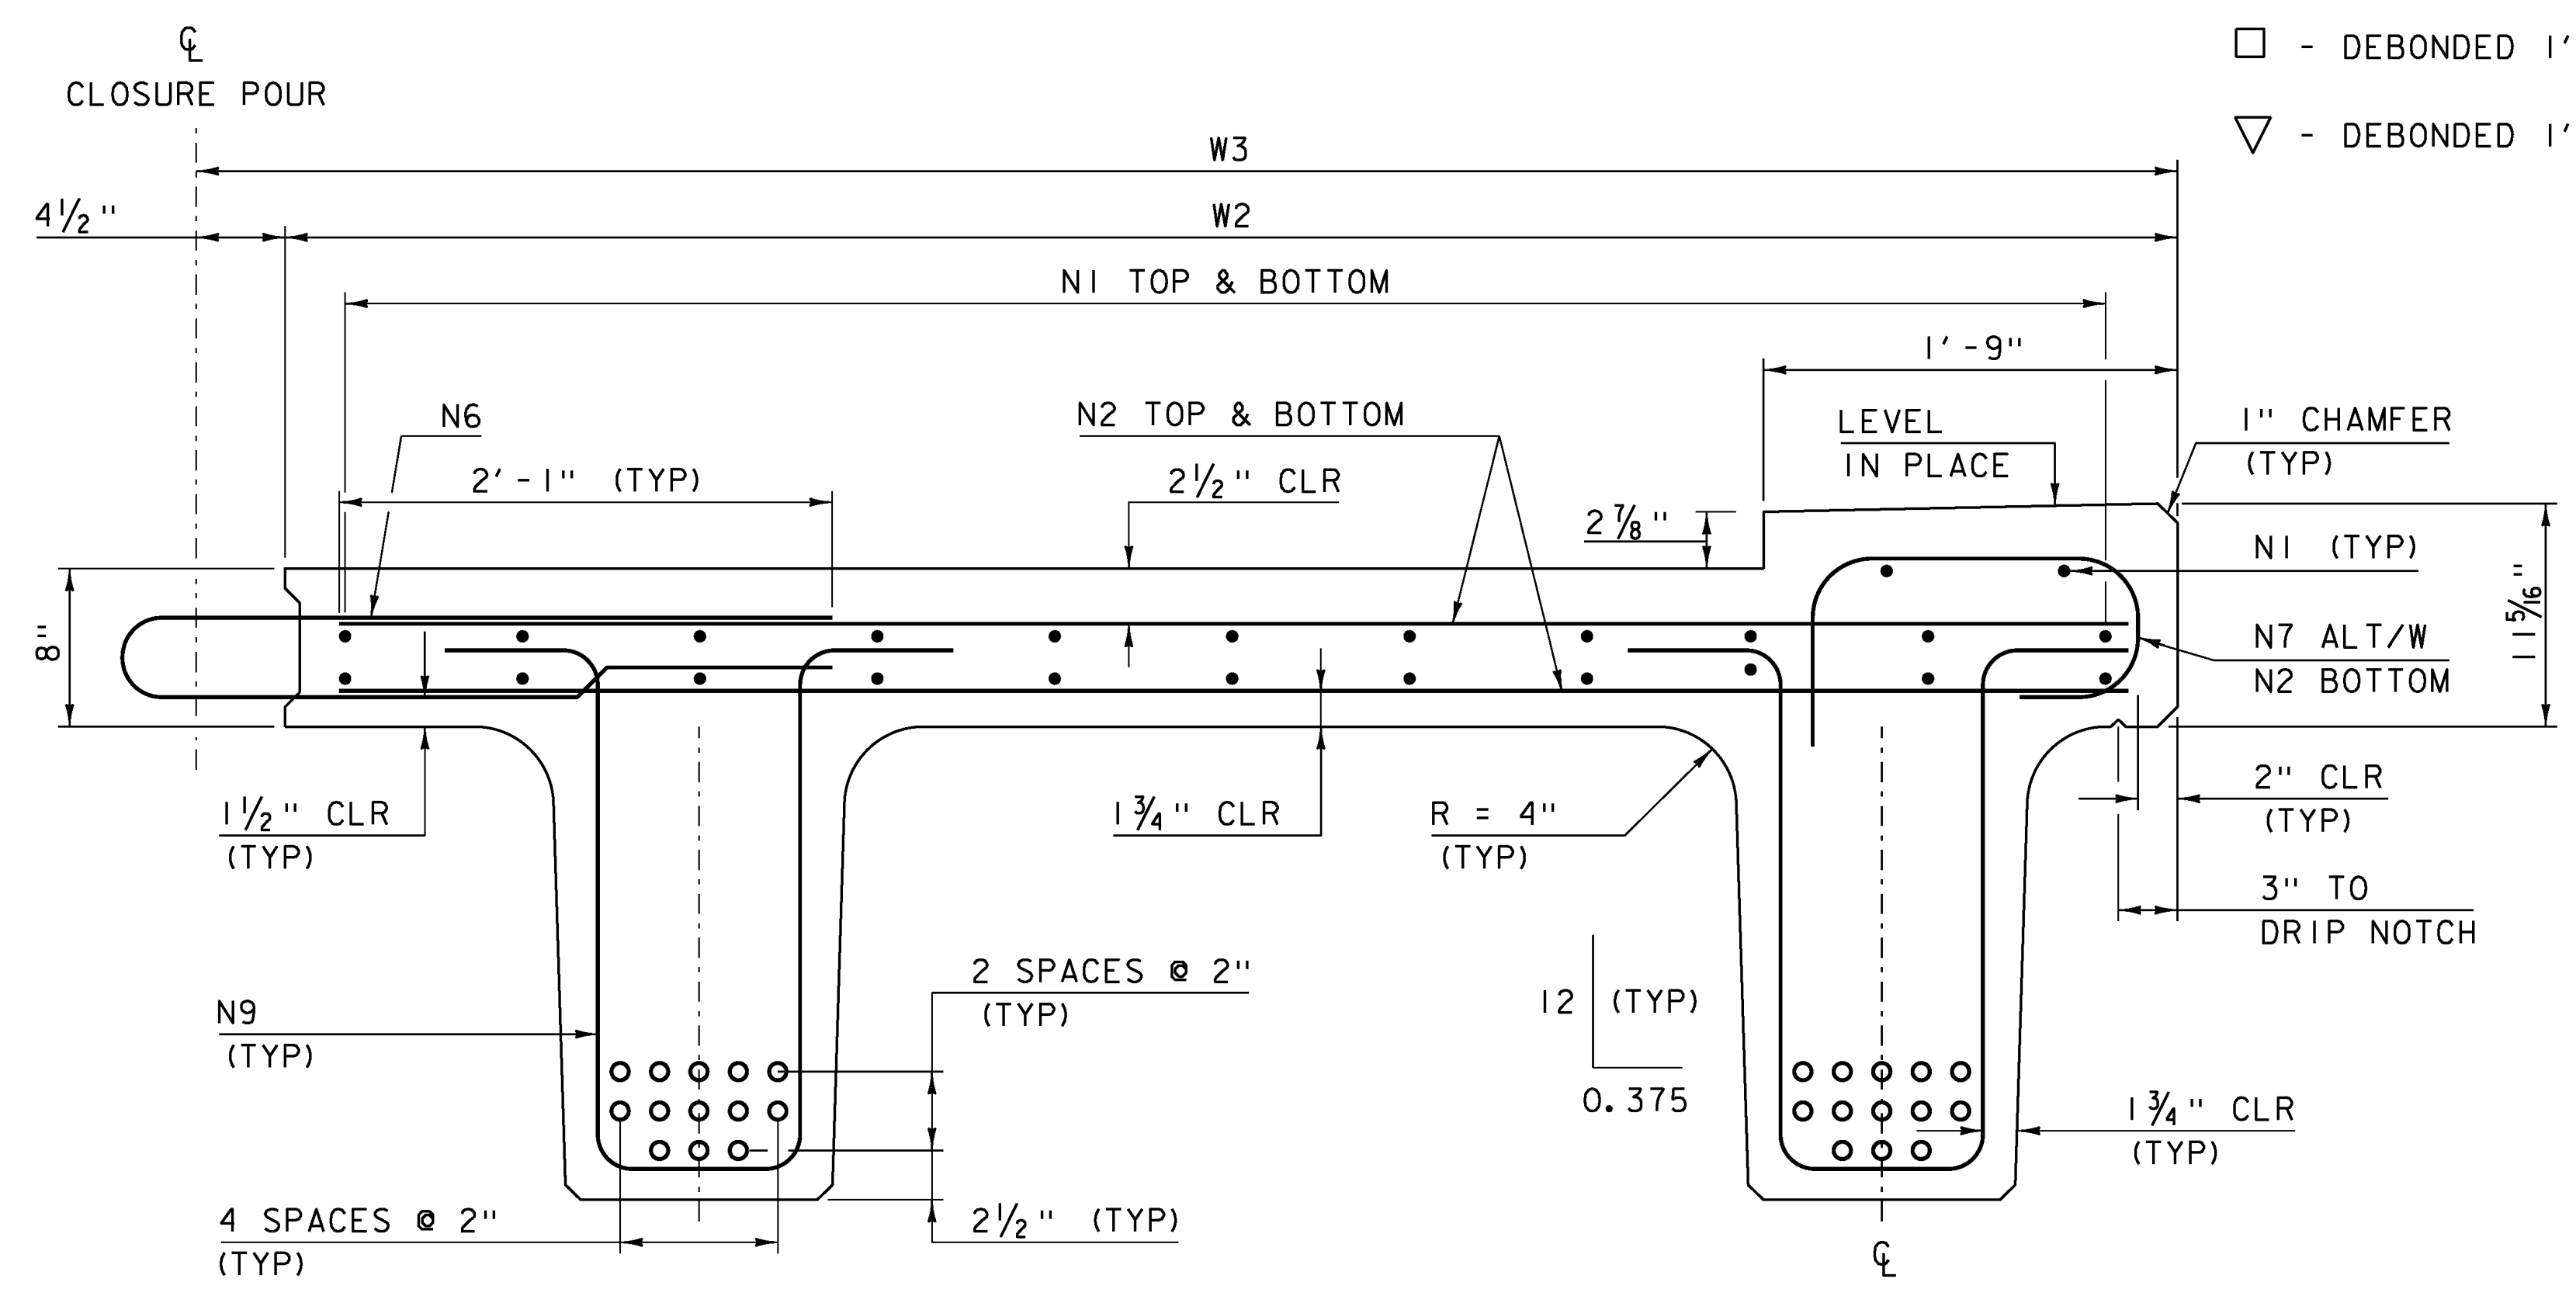

**UNITS 1 & 3**  
NOT TO SCALE

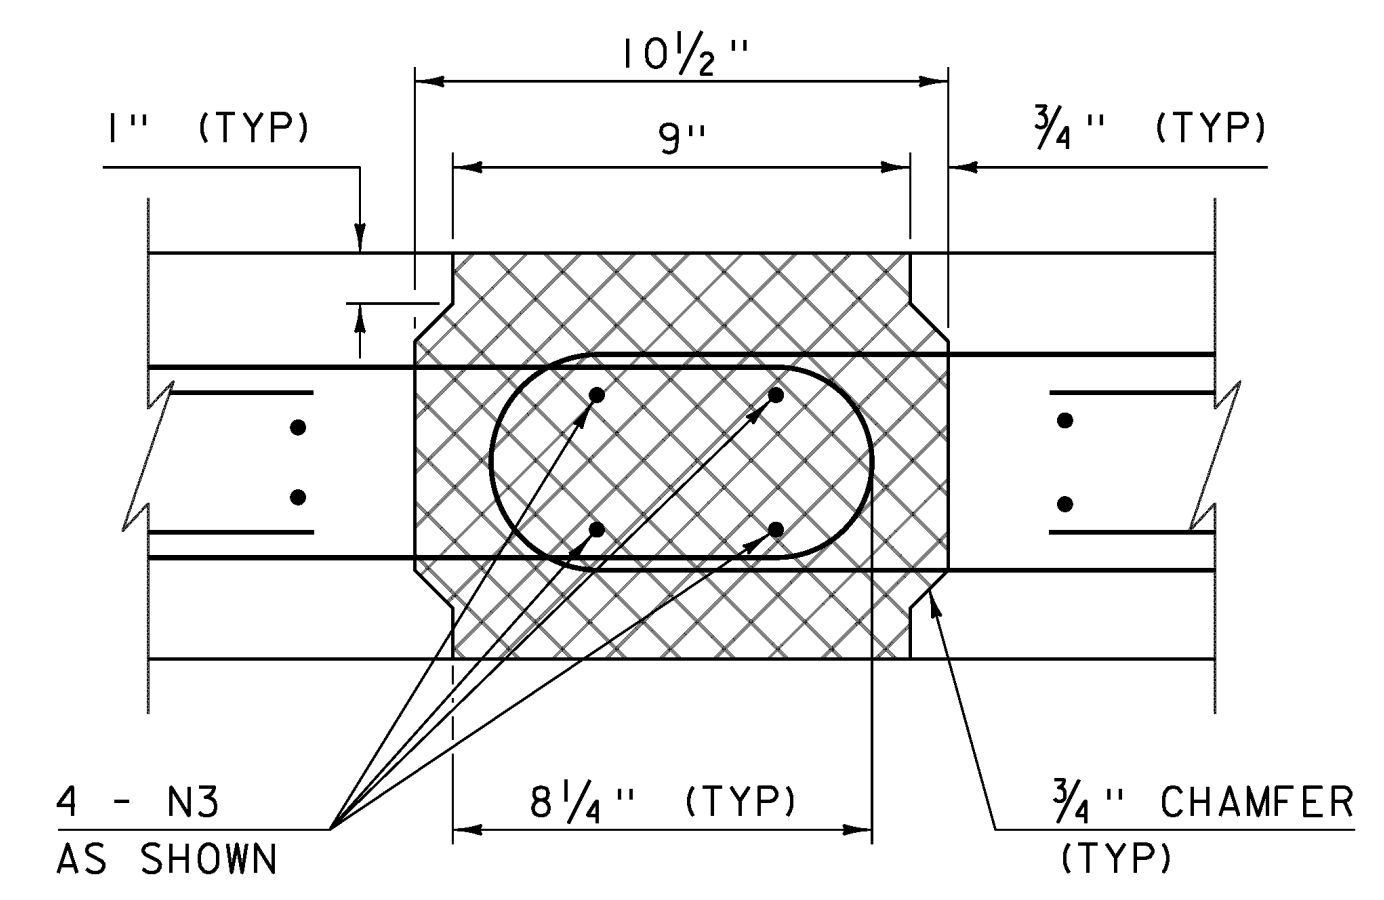


**CONNECTION DETAIL SECTION**  
NOT TO SCALE

**NEXT BEAM REINFORCING CHART**

BAR	SIZE	SPACING	TYPE
N1	5	9"	STR
N2	5	6"	STR
N3	4	AS SHOWN	STR
N4	6	6"	STR
N5	4	6"	STR
N6	4	6"	S11
N7	5	6"	SEE DETAIL
N8	5	AS SHOWN	S10
N9	4	12"	S4
N9a	4	3"	S4
N9b	4	12"	S4

PROJECT NAME: CAMBRIDGE  
 PROJECT NUMBER: BRO 1448(39)  
 FILE NAME: sl2j166sup.dgn  
 PROJECT LEADER: K. HIGGINS  
 DESIGNED BY: G. LAROCHE  
 NEXT BEAM TYPICAL SECTIONS

PLOT DATE: 29-AUG-2014  
 DRAWN BY: G. LAROCHE  
 CHECKED BY: J. SALVATORI  
 SHEET 17 OF 34

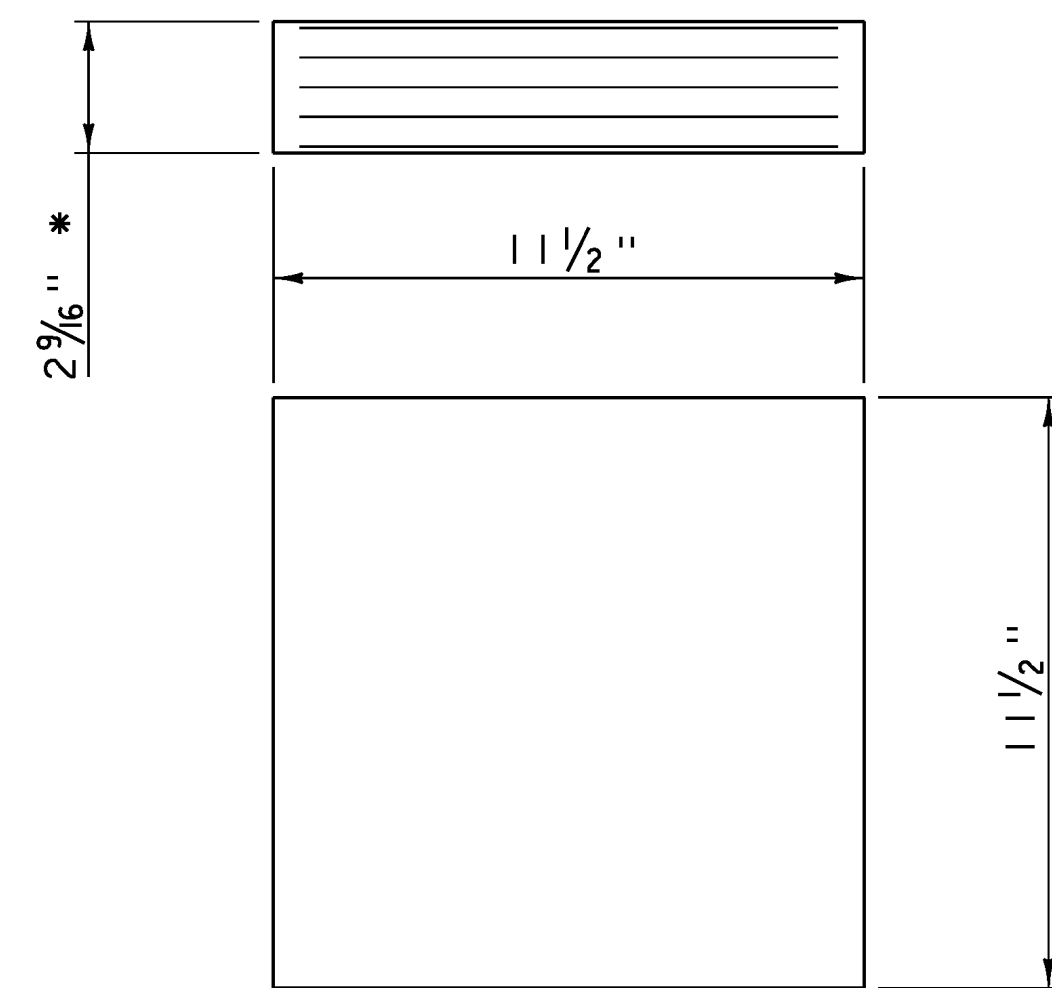


**ELASTOMERIC BEARING DETAIL**

SCALE 3" = 1'-0"

- * 2 - 1/8" EXTERIOR LAYERS OF ELASTOMER
- 4 - 1/2" INTERIOR LAYERS OF ELASTOMER
- 5- 1/16" STEEL REINFORCING PLATES

**BEARING NOTES:**

1. BEARINGS SHALL CONFORM TO THE APPLICABLE SUBSECTIONS OF SECTIONS 531 AND 731.
2. ALL REINFORCEMENT BETWEEN LAYERS OF ELASTOMER SHALL BE STEEL MEETING THE REQUIREMENTS OF SUBSECTION 714.02. ALL INTERNAL STEEL PLATES SHALL BE SAND BLASTED AND FREE OF COATINGS, RUST AND MILL SCALE. THE PLATES SHALL BE FREE OF SHARP EDGES AND BURRS.
3. STEEL REINFORCED ELASTOMERIC BEARINGS SHALL HAVE A MINIMUM 1/8" EDGE SEAL OF ELASTOMER INTEGRAL WITH BEARING OVER ALL INTERNAL PLATES.
4. THE ELASTOMER WAS DESIGNED WITH A SHEAR MODULUS OF 100 PSI +/- 15%
5. THE CONTRACTOR IS ADVISED TO HAVE A MINIMUM OF 12 - 1/4"x12 1/2"x12 1/2" GALVANIZED STEEL SHIMS AVAILABLE FOR USE FOR ELEVATION ADJUSTMENTS UPON THE SETTING OF THE SUPERSTRUCTURE UNITS. THE SHIMS SHALL BE FABRICATED ACCORDING TO SECTION 531 AND SHALL BE INCLUDED IN THE UNIT PRICE BID FOR ITEM 531.17,"BEARING DEVICE ASSEMBLY, STEEL REINFORCED ELASTOMERIC PAD".

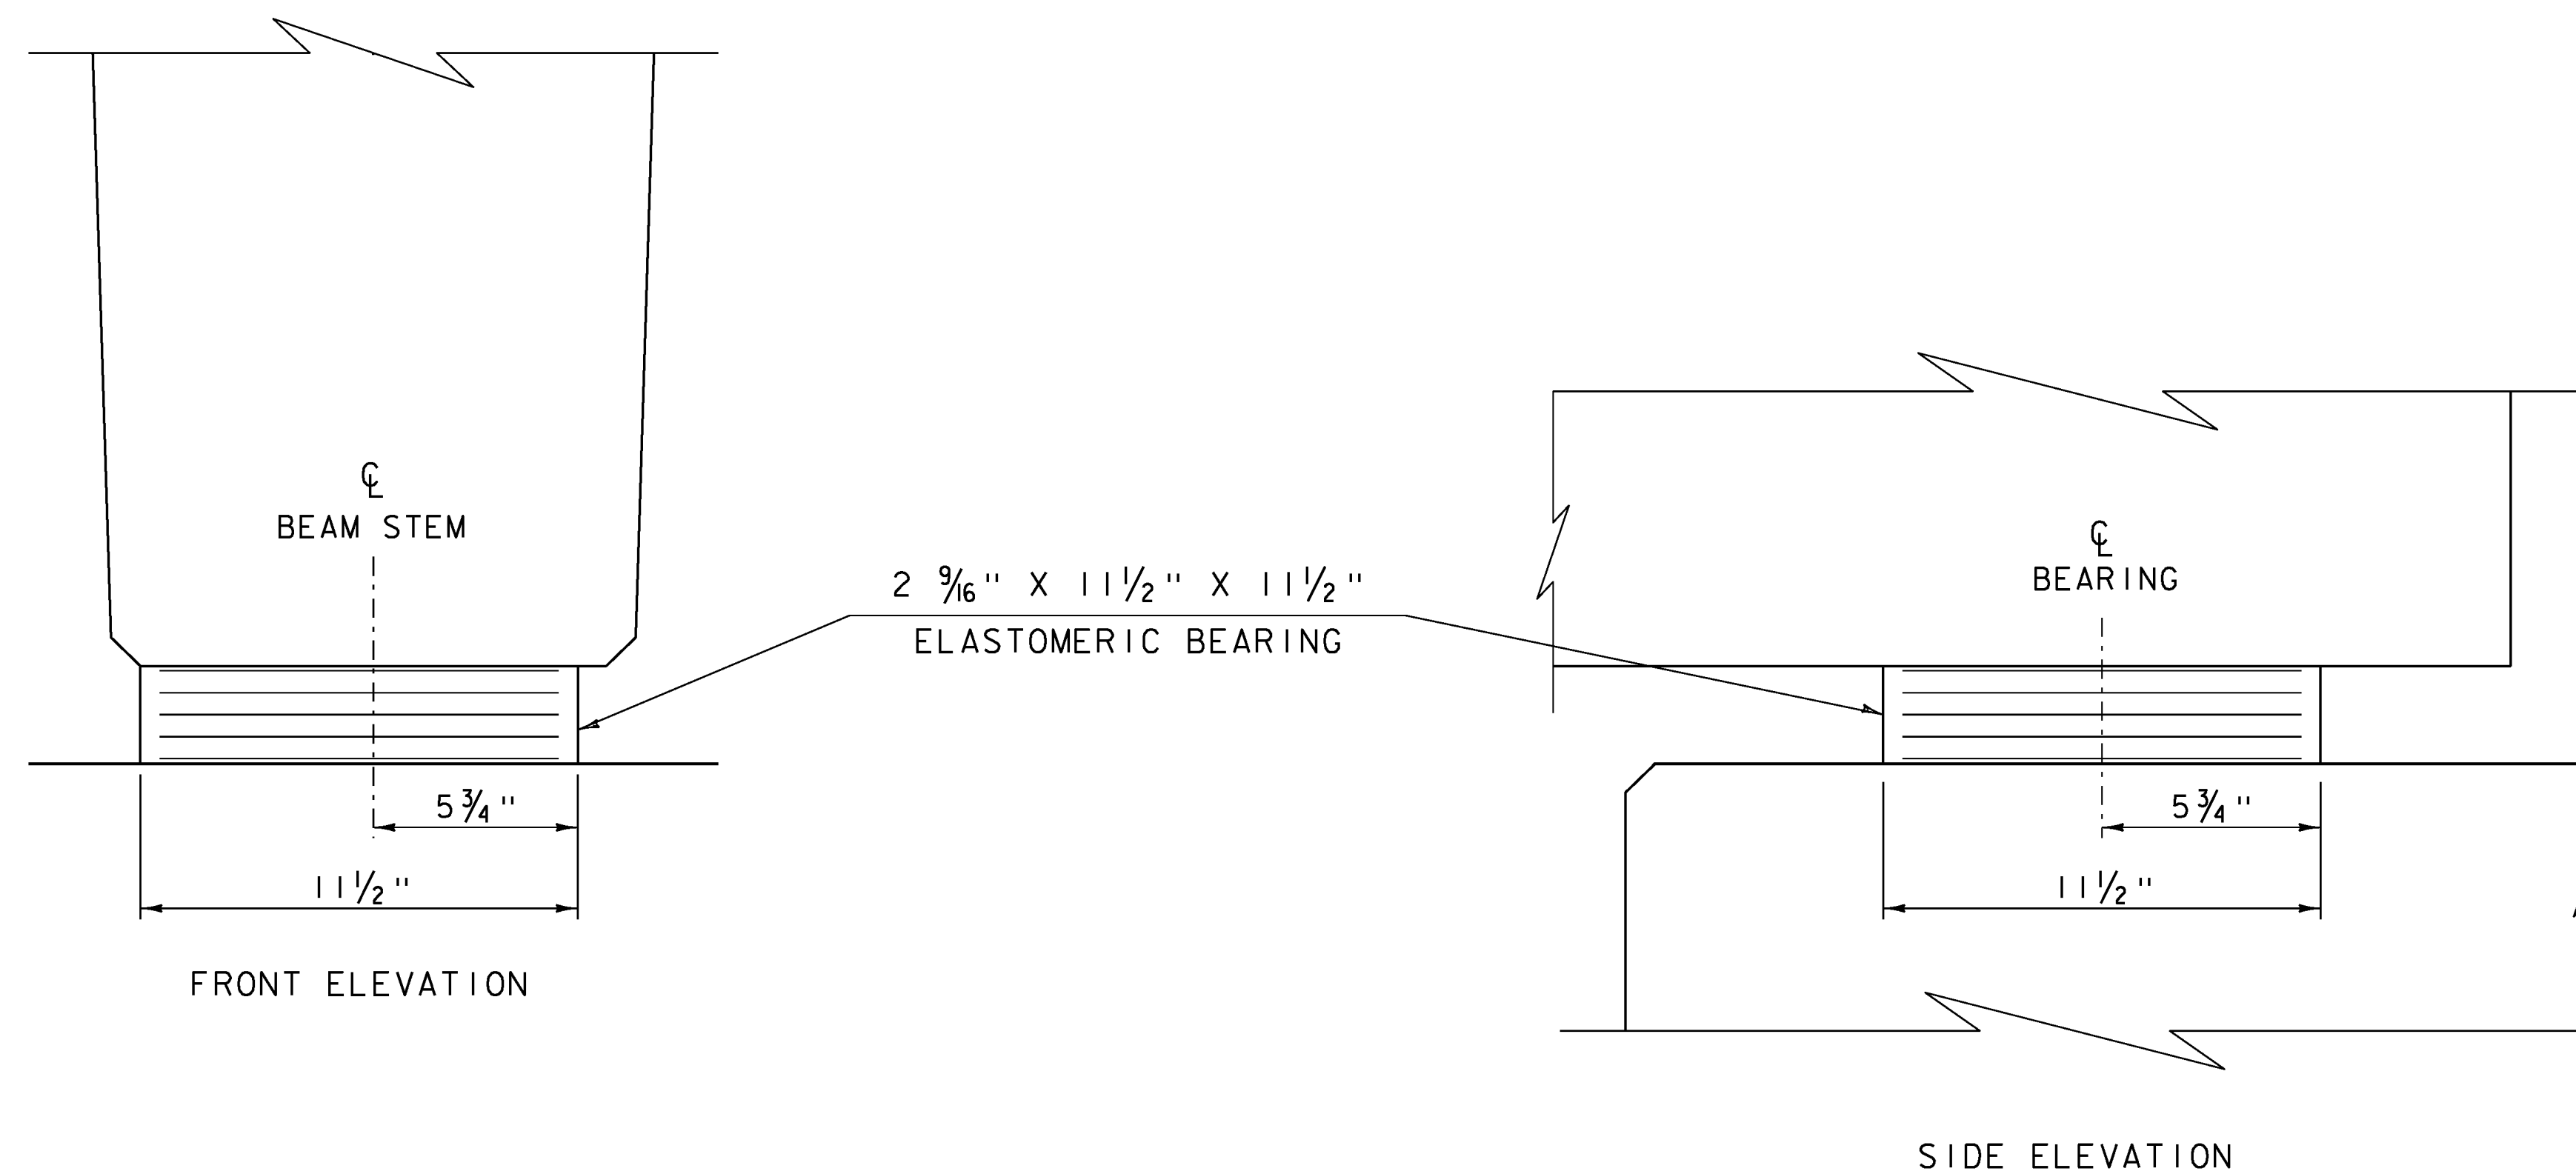


**ELASTOMERIC BEARING DETAILS**

SCALE 3" = 1'-0"


PROJECT NAME: CAMBRIDGE  
PROJECT NUMBER: BRO 1448(39)

FILE NAME: s12j166brg.dgn  
PROJECT LEADER: K. HIGGINS  
DESIGNED BY: G. LAROCHE  
BEARING DETAILS

PLOT DATE: 29-AUG-2014  
DRAWN BY: G. LAROCHE  
CHECKED BY: W. LAMMER  
SHEET 18 OF 34

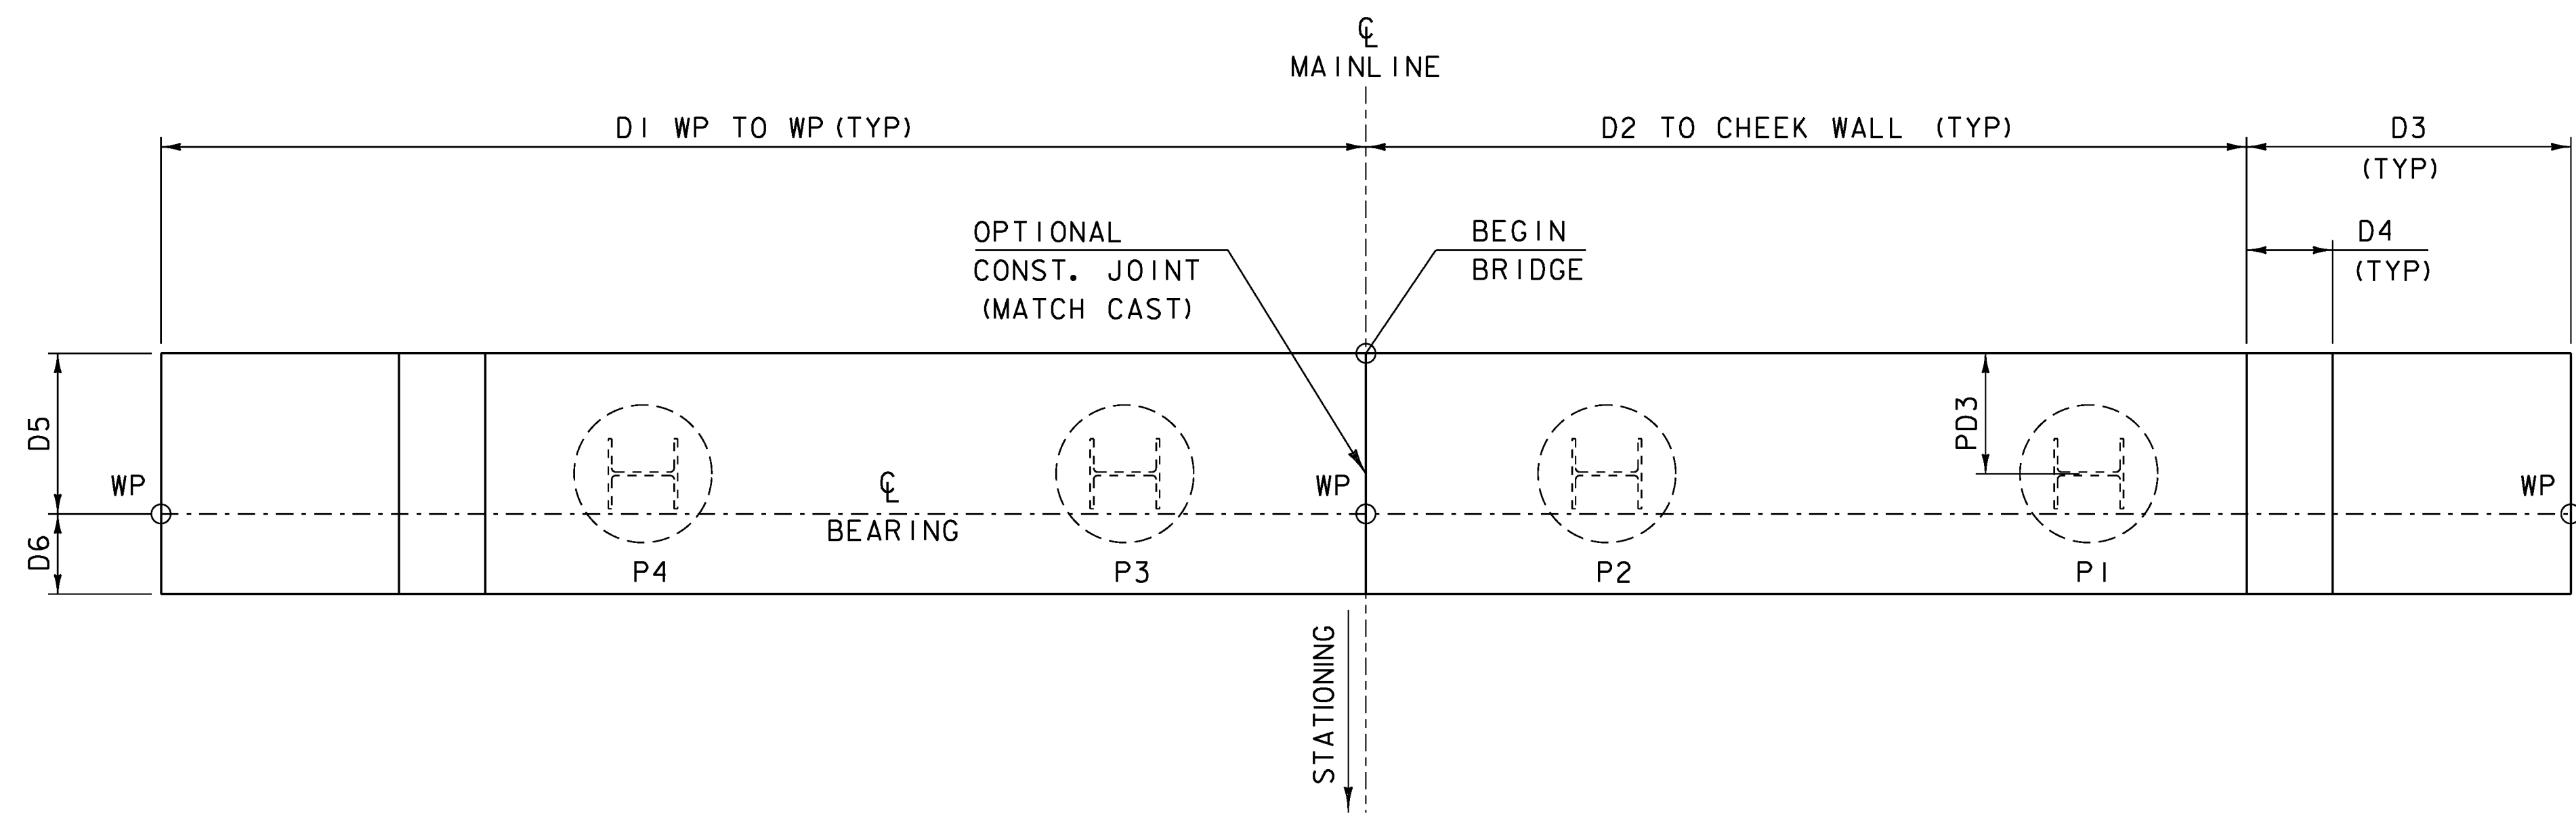

**ABUTMENT PLAN**  
SCALE 1/2" = 1'-0"

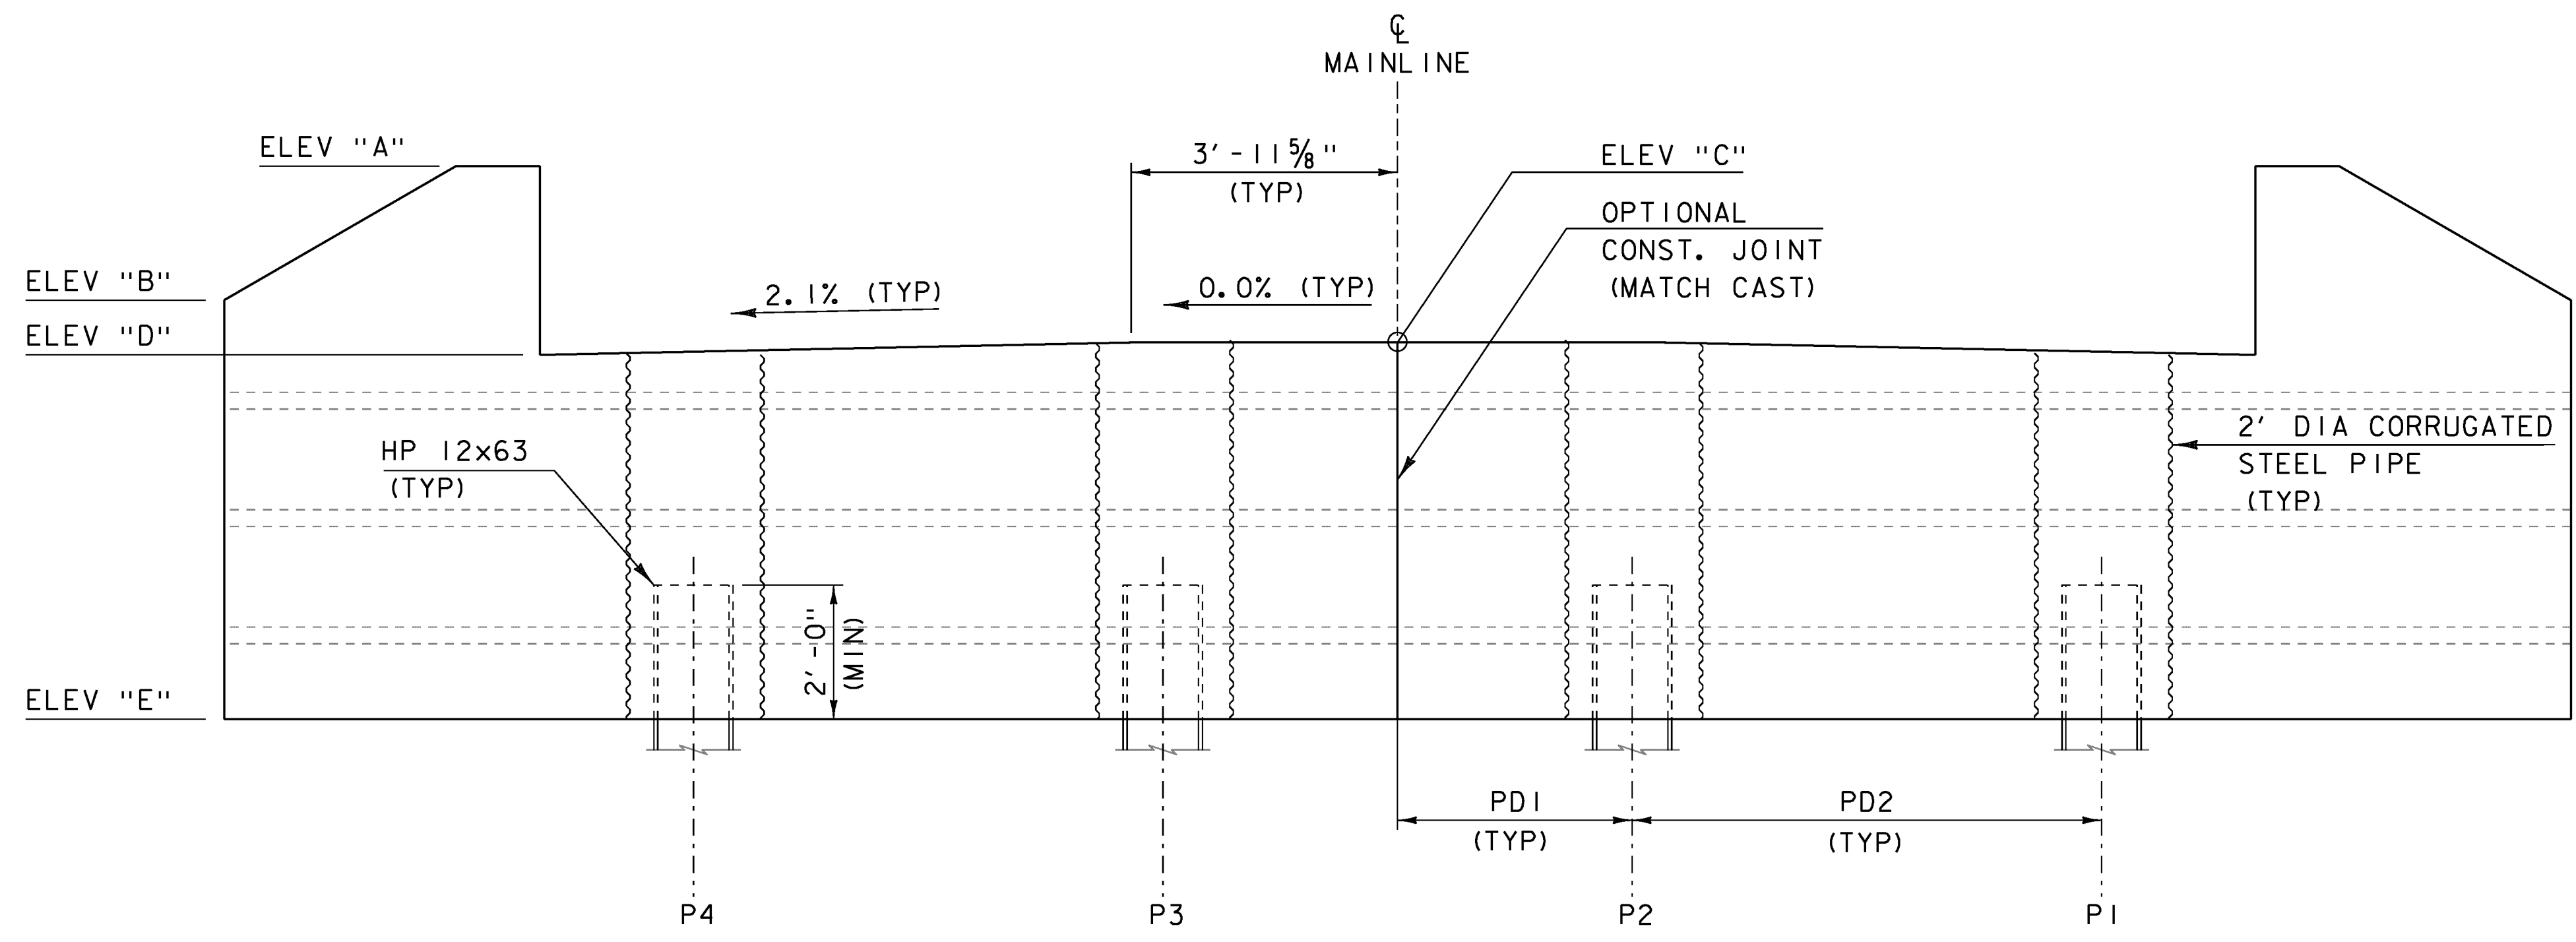


**ABUTMENT ELEVATION**  
SCALE 1/2" = 1'-0"

**ABUTMENT ELEVATIONS**

	AB1	AB2
ELEV "A"	651.50	651.70
ELEV "B"	649.50	649.80
ELEV "C"	648.60	648.87
ELEV "D"	648.42	648.69
ELEV "E"	643.00	643.25

**ABUTMENT DIMENSIONS**

	AB1	AB2
D1	17'-6"	17'-6"
D2	12'-9 1/2"	12'-9 1/2"
D3	4'-8 1/2"	4'-8 1/2"
D4	1'-3"	1'-3"
D5	2'-4"	2'-4"
D6	1'-2"	1'-2"
D7	1'-10"	1'-10"
PD1	3'-6"	3'-6"
PD2	7'-0"	7'-0"
PD3	1'-9"	1'-9"

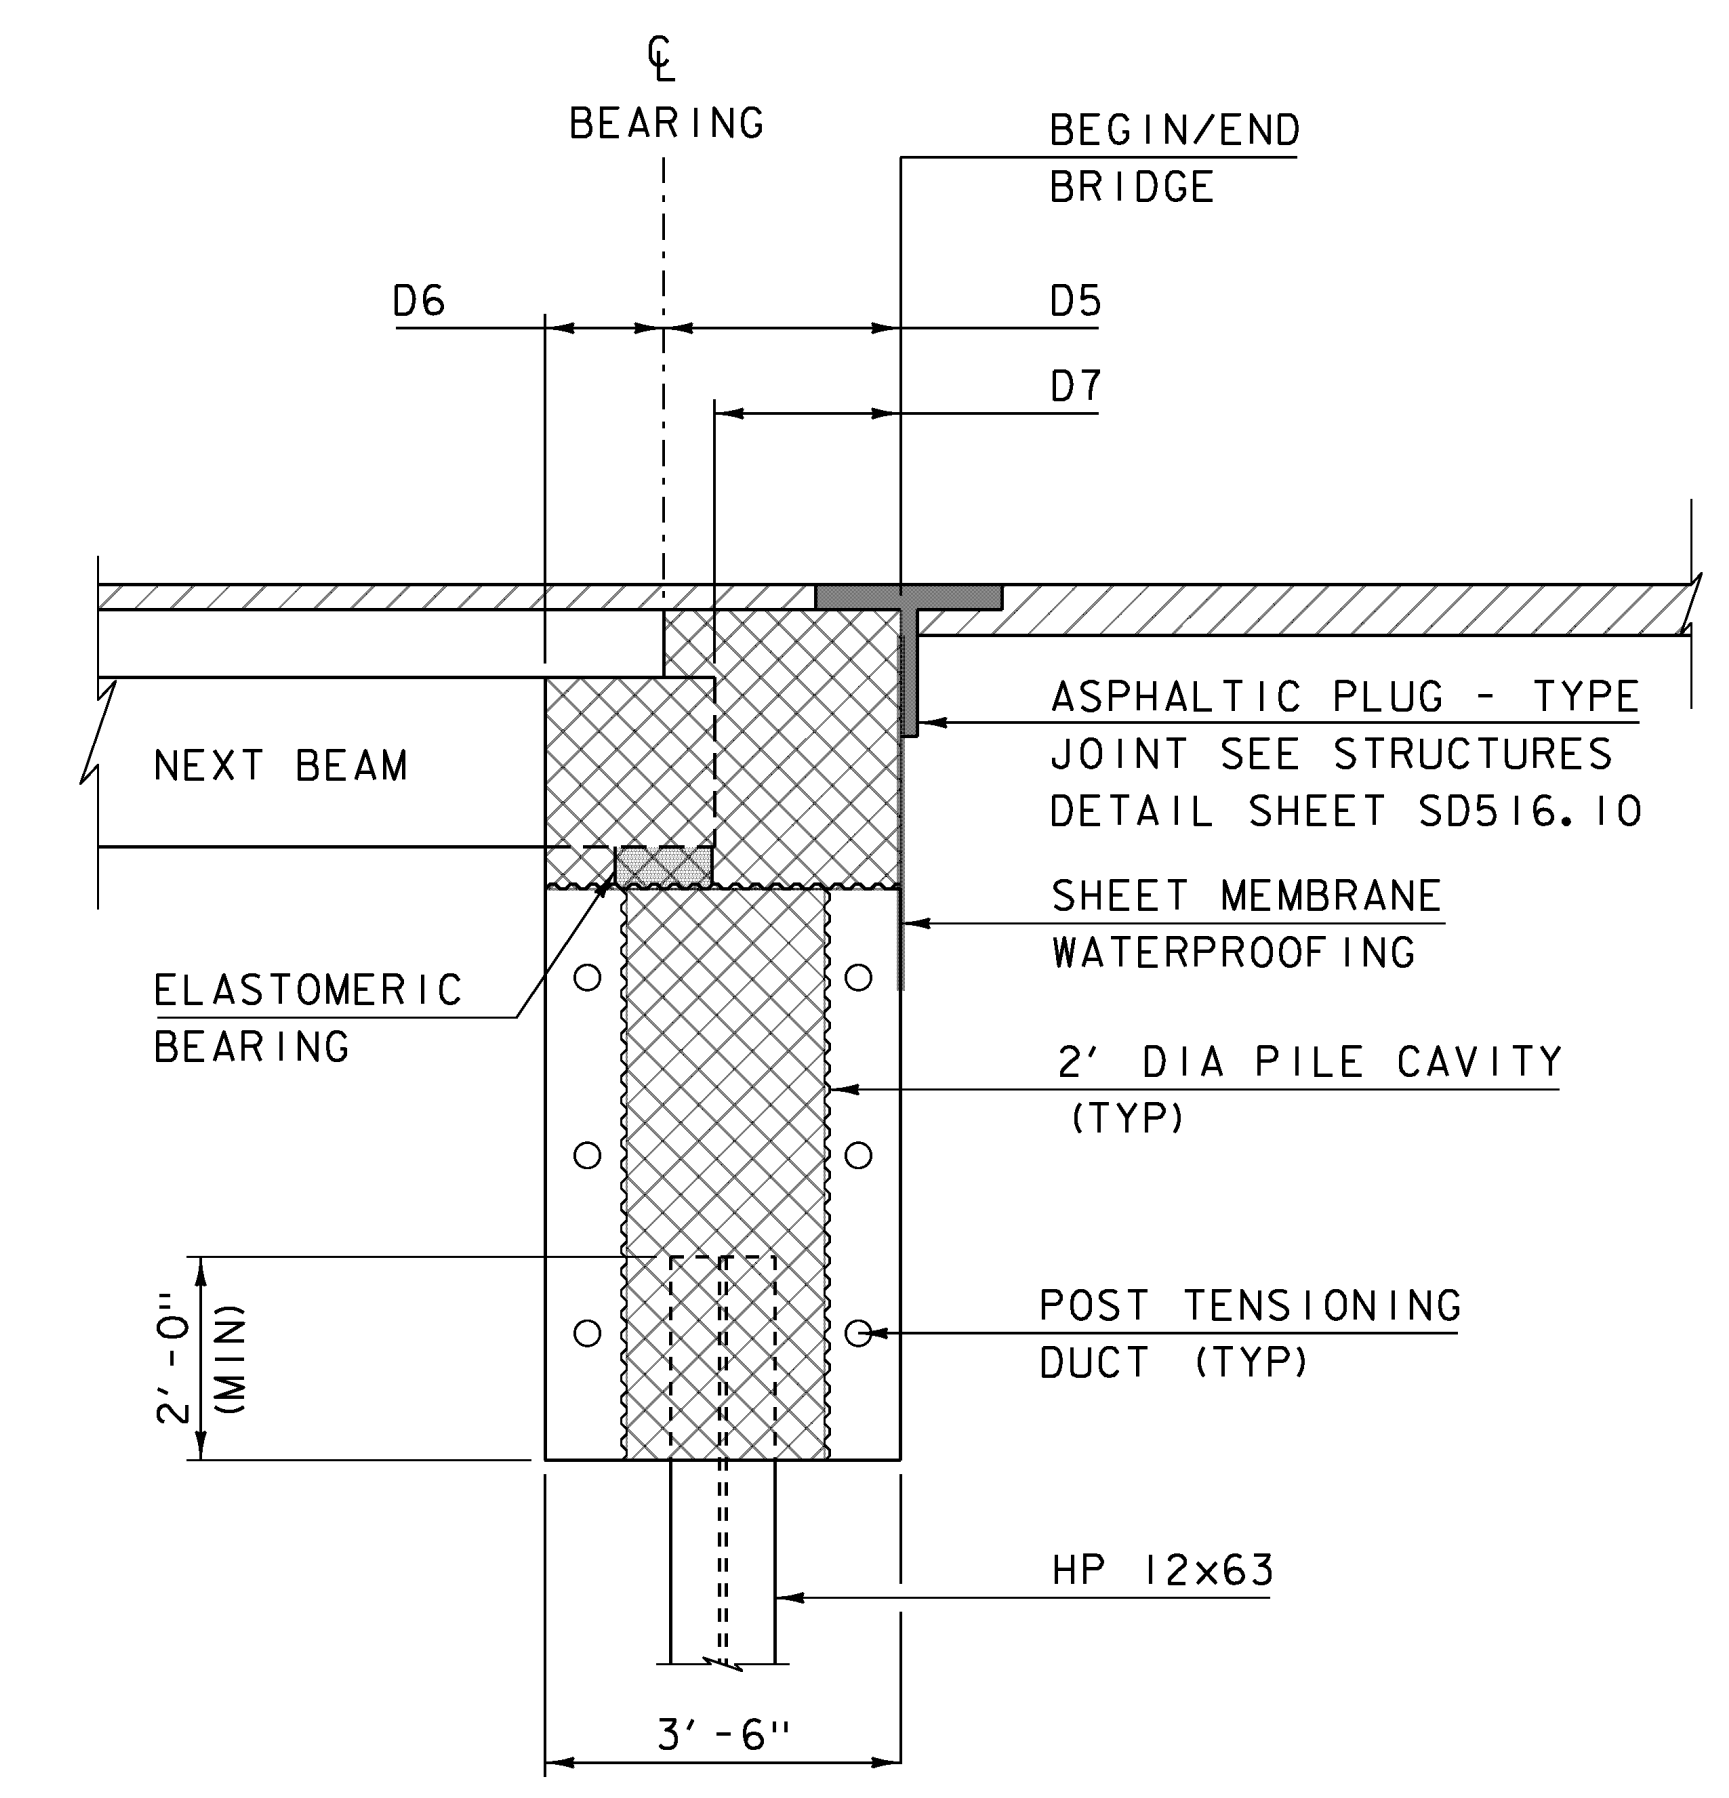


**ABUTMENT TYPICAL**  
SCALE 1/2" = 1'-0"

**NOTES:**

1. ABUTMENT 1 SHOWN, ABUTMENT 2 SIMILAR.
2. THE BRIDGE PLAQUE FURNISHED BY THE AGENCY SHALL BE CAST INTO ABUTMENT 1. ALL WORK TO INSTALL THE PLAQUE SHALL BE INCIDENTAL TO THE APPROPRIATE PRECAST ITEM. SEE SD-502.00 FOR FURTHER DETAILS.
3. THE BRIDGE SEAT SHALL HAVE A ROUGHENED FINISH. AREAS UNDER BEARING PADS SHALL BE TROWELED SMOOTH TO THE PROPOSED SLOPE.

PROJECT NAME: CAMBRIDGE	PLOT DATE: 29-AUG-2014
PROJECT NUMBER: BRO 1448(39)	DRAWN BY: J. SALVATORI
FILE NAME: s12j166sub.dgn	DESIGNED BY: G. LAROCHE
PROJECT LEADER: K. HIGGINS	CHECKED BY: W. LAMMER
ABUTMENT PLAN	SHEET 19 OF 34

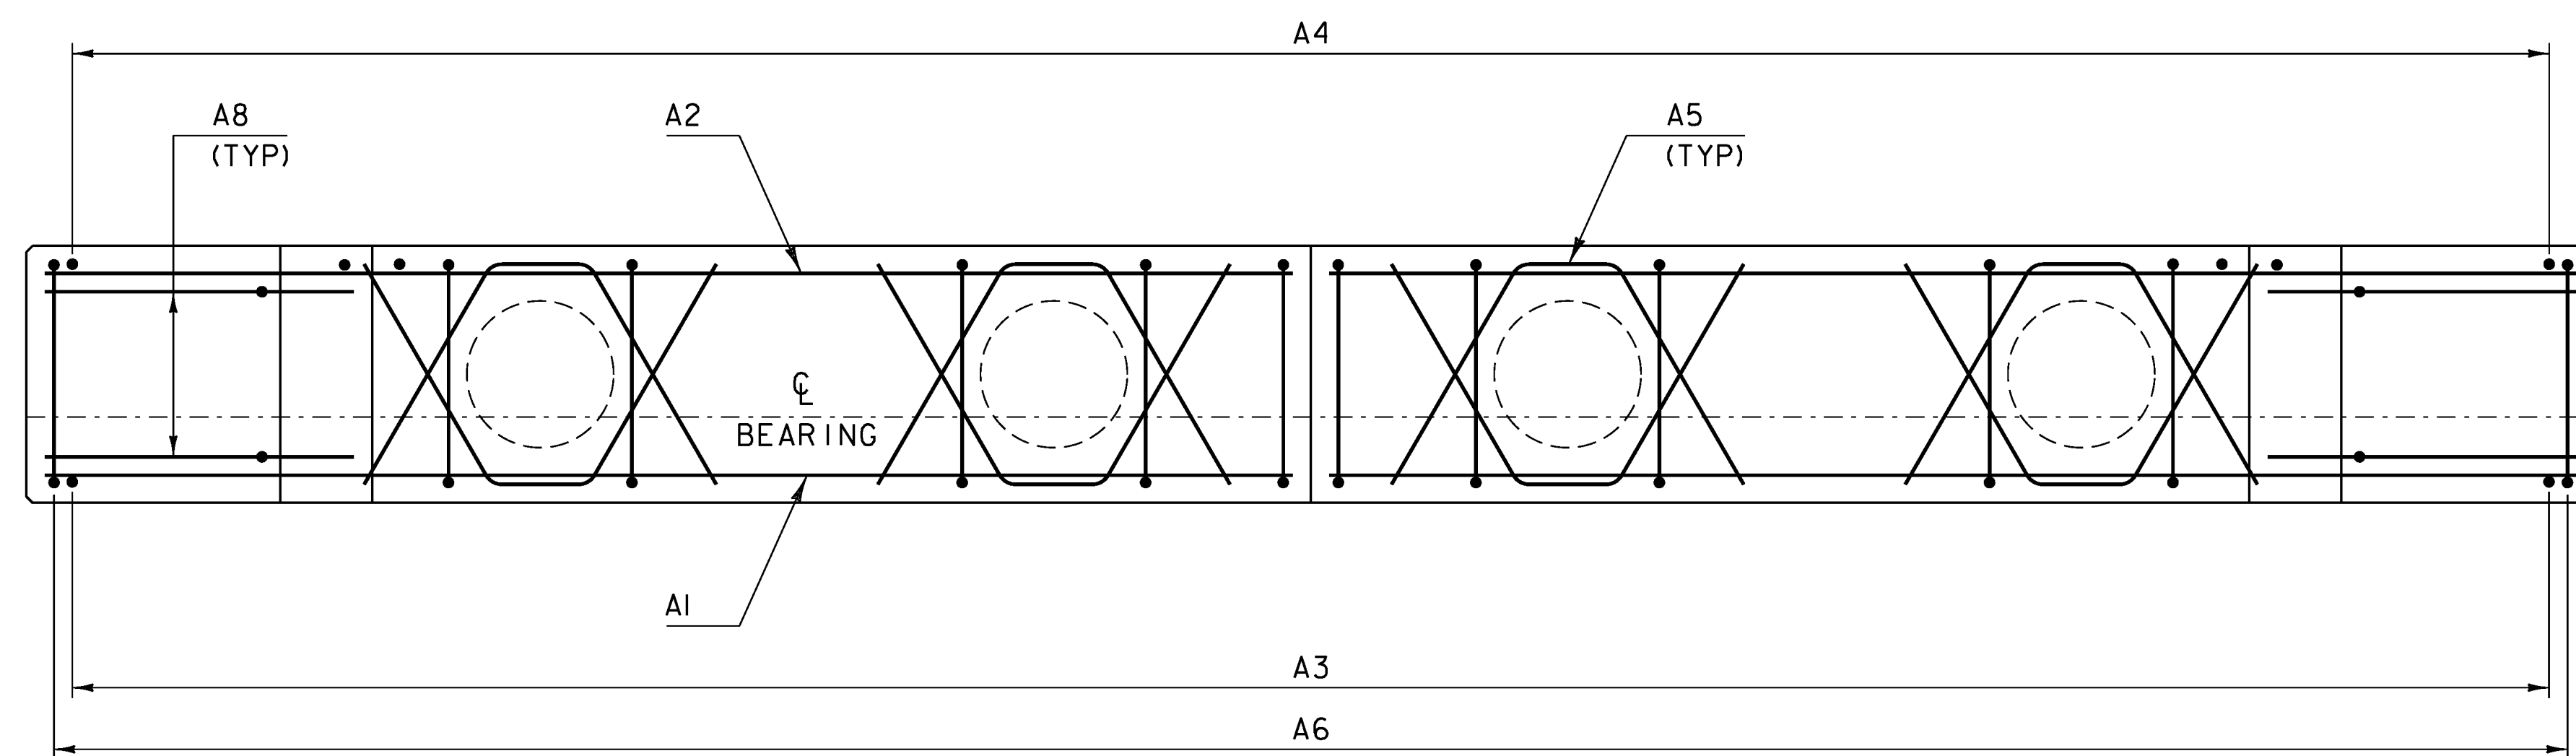


**ABUTMENT REINFORCING PLAN**

SCALE 1/2" = 1'-0"


**ABUTMENT REINFORCING CHART**

BAR	SIZE	SPACING	FACE	TYPE
A1	5	12"	NF	STR
A2	5	6"	FF	STR
A3	5	12"	NF	STR
A4	6	6"	FF	STR
A5	6	---	EF	14
A6	5	12	---	17
A7	5	---	EF	19

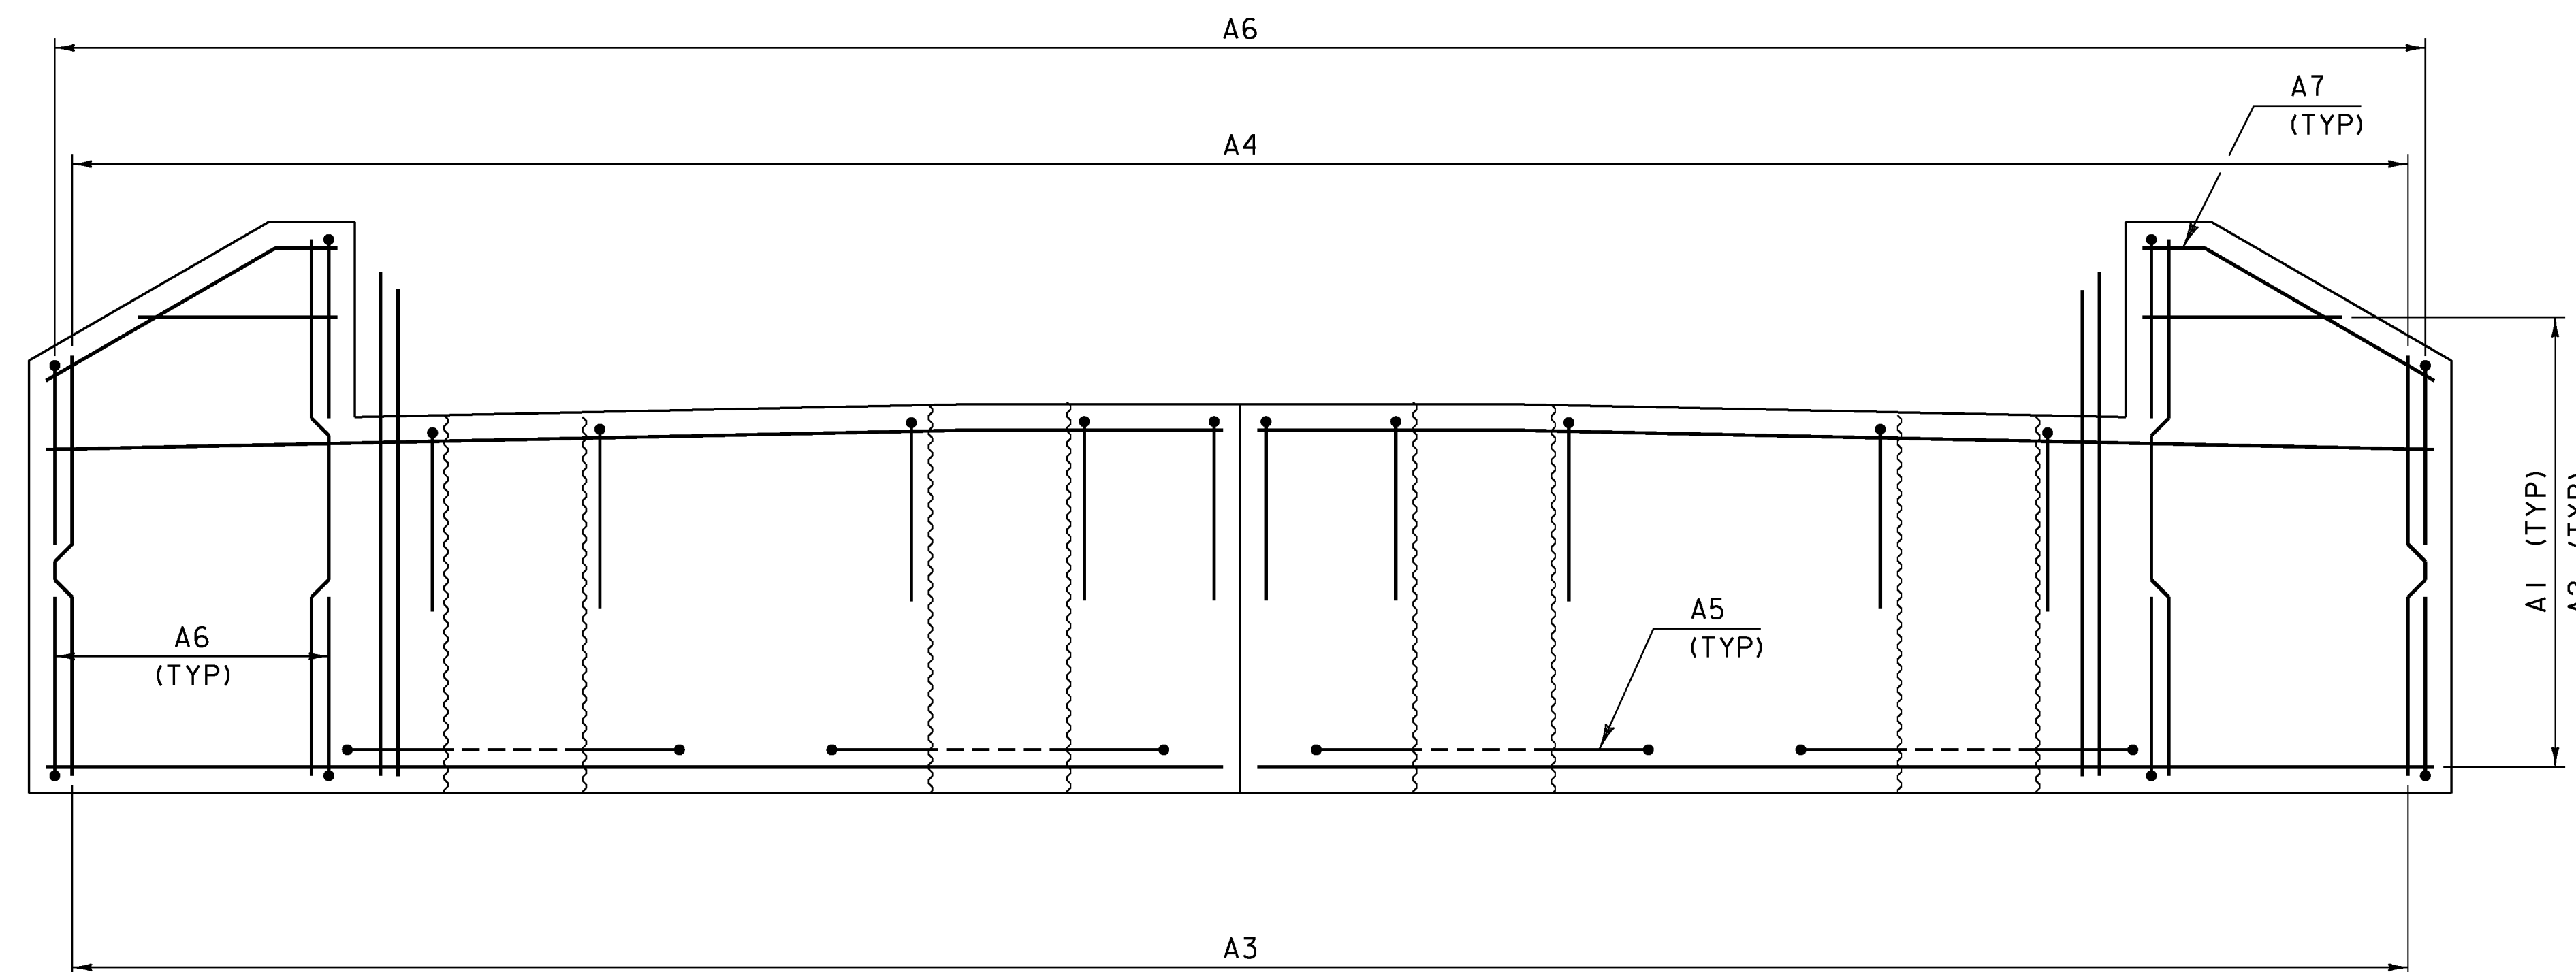


**ABUTMENT REINFORCING ELEVATION**

SCALE 1/2" = 1'-0"

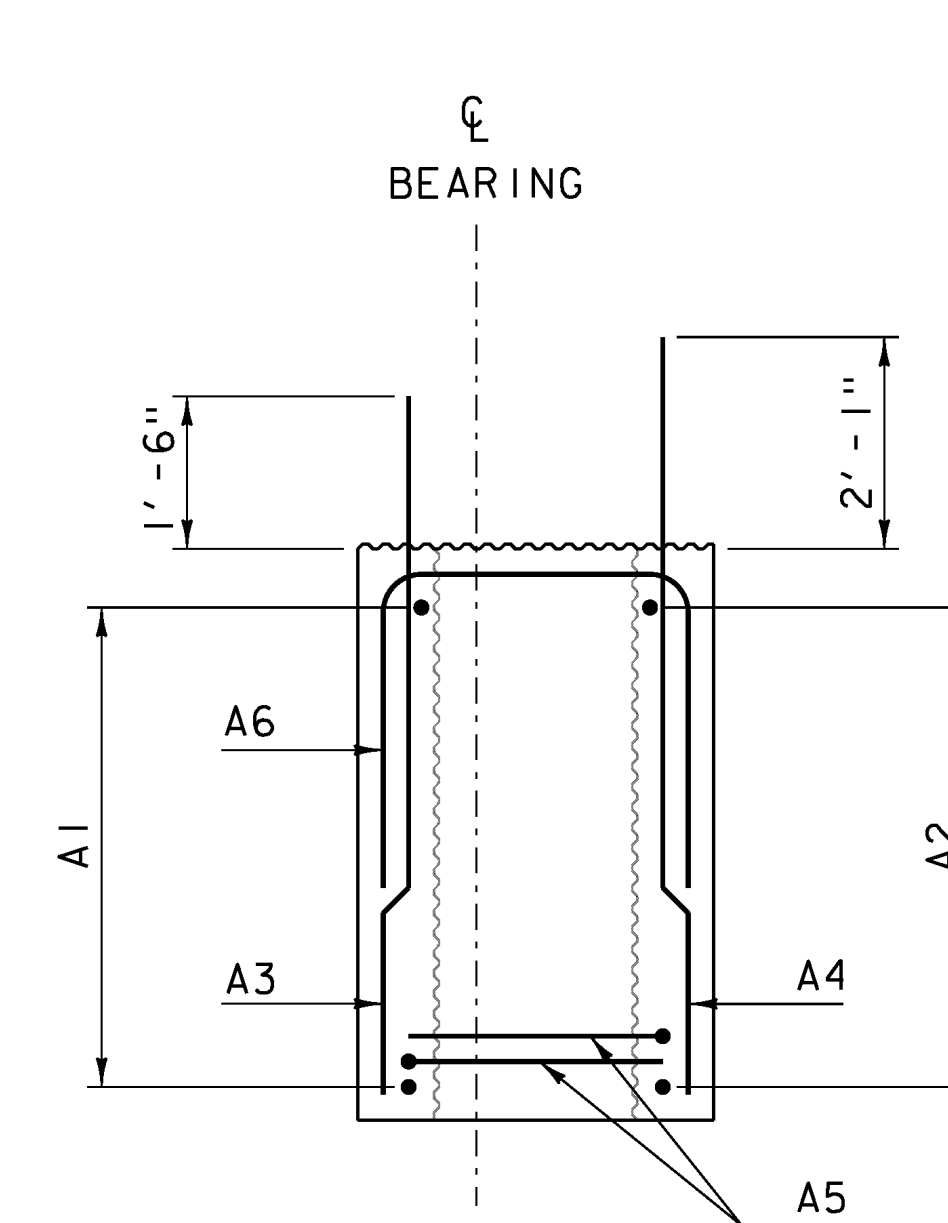

**ABUTMENT REINFORCING AT BRIDGE SEAT**

SCALE 1/2" = 1'-0"

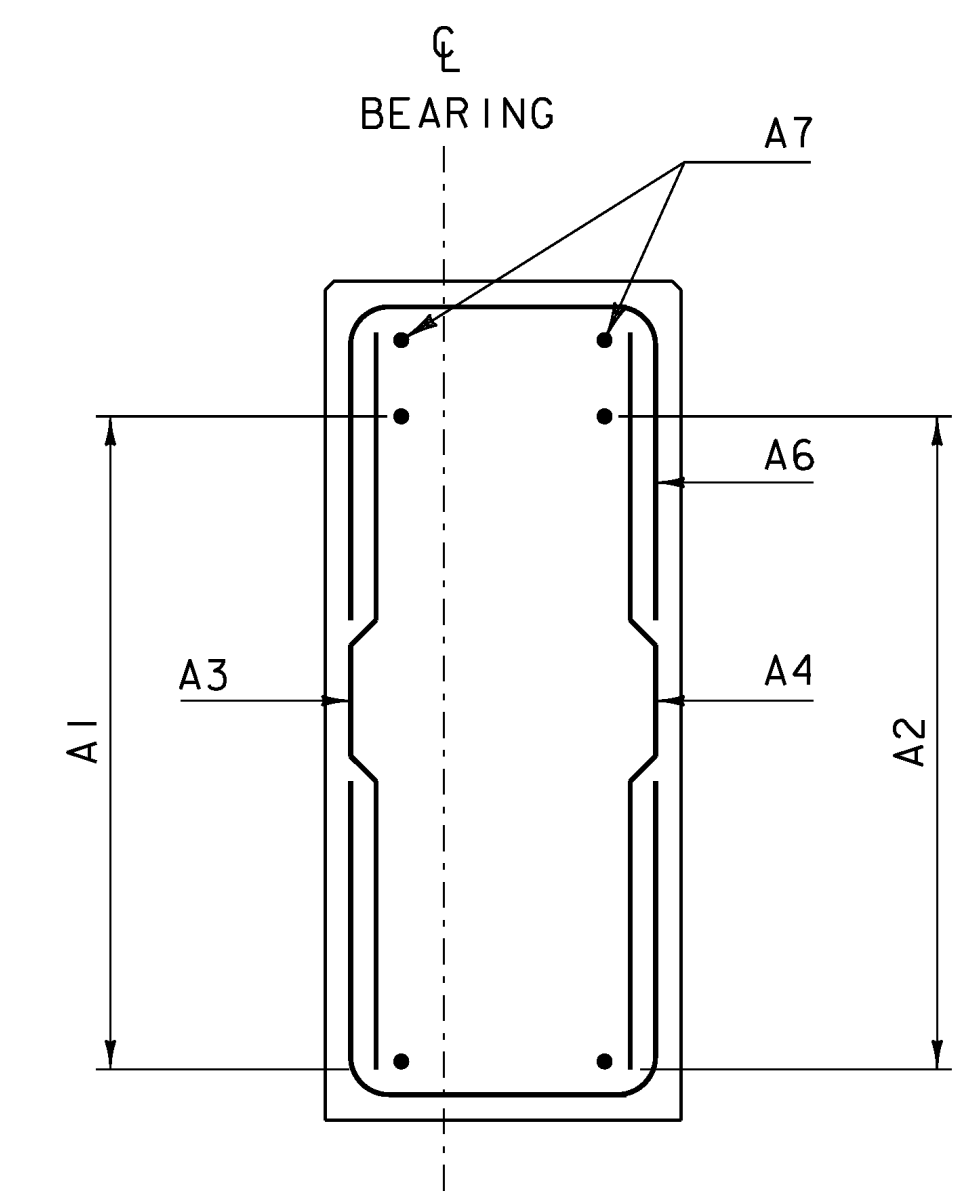

**ABUTMENT REINFORCING AT CHEEK WALL**

SCALE 1/2" = 1'-0"

**NOTES:**

1. ABUTMENT 1 SHOWN, ABUTMENT 2 SIMILAR.
2. CUT TO FIT A3 AT STEM LOCATIONS.

**NOTE:**

NF = NEAR FACE  
 FF = FAR FACE  
 EF = EACH FACE  
 3" CLEAR, UNLESS OTHERWISE SPECIFIED ON THE PLANS.  
 2'-7" BAR LAP UNLESS OTHERWISE SPECIFIED ON THE PLANS.


PROJECT NAME: CAMBRIDGE  
 PROJECT NUMBER: BRO 1448(39)

FILE NAME: s12j166sub.dgn  
 PROJECT LEADER: K. HIGGINS  
 DESIGNED BY: G. LAROCHE  
 ABUTMENT REINFORCING


PLOT DATE: 29-AUG-2014  
 DRAWN BY: J. SALVATORI  
 CHECKED BY: W. LAMMER  
 SHEET 20 OF 34

**CLOSURE POUR REINFORCING**


BAR	SIZE	SPACING	FACE	TYPE
C1	5	12"	NF	STR
C2	5	6"	AS SHOWN	STR
C3	5	12"	---	17
C4	6	6"	---	17

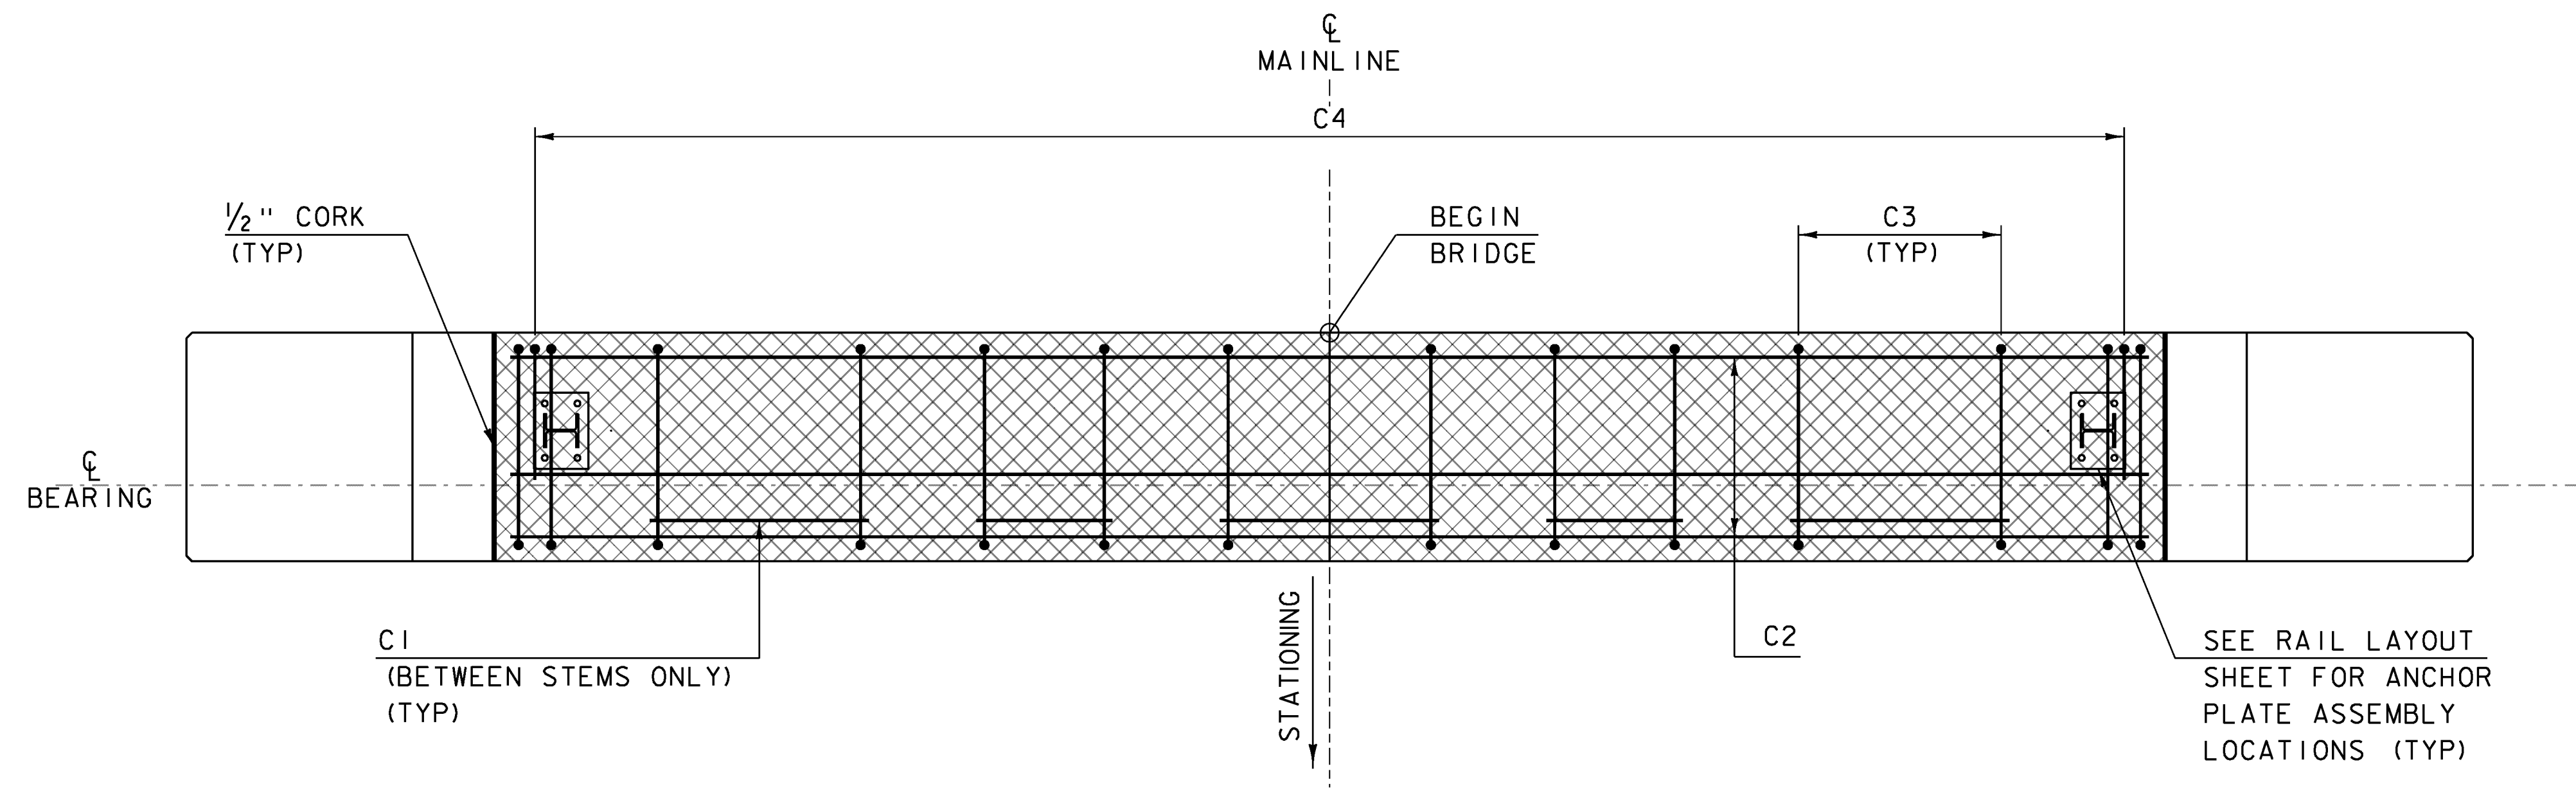

**DECK CLOSURE POUR  
REINFORCING PLAN**  
SCALE 1/2" = 1'-0"

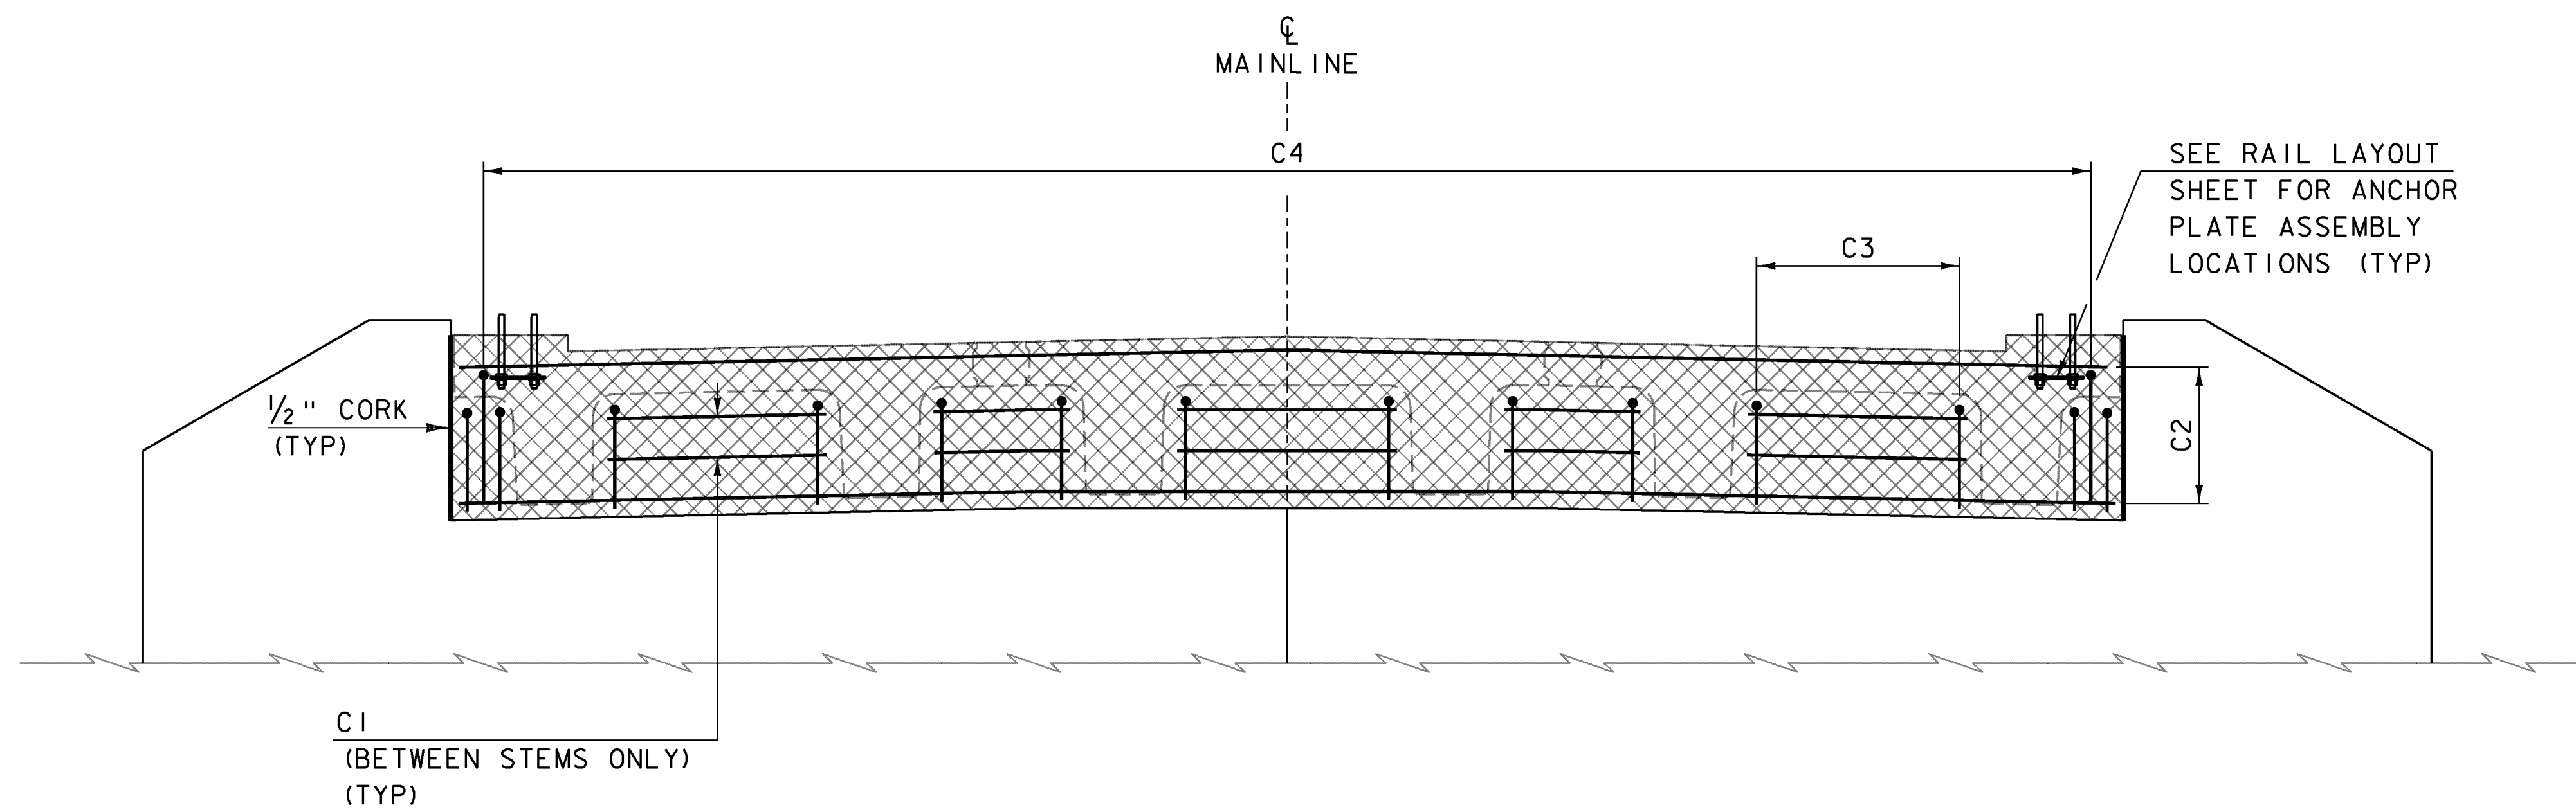

**DECK CLOSURE POUR  
REINFORCING ELEVATION**  
SCALE 1/2" = 1'-0"

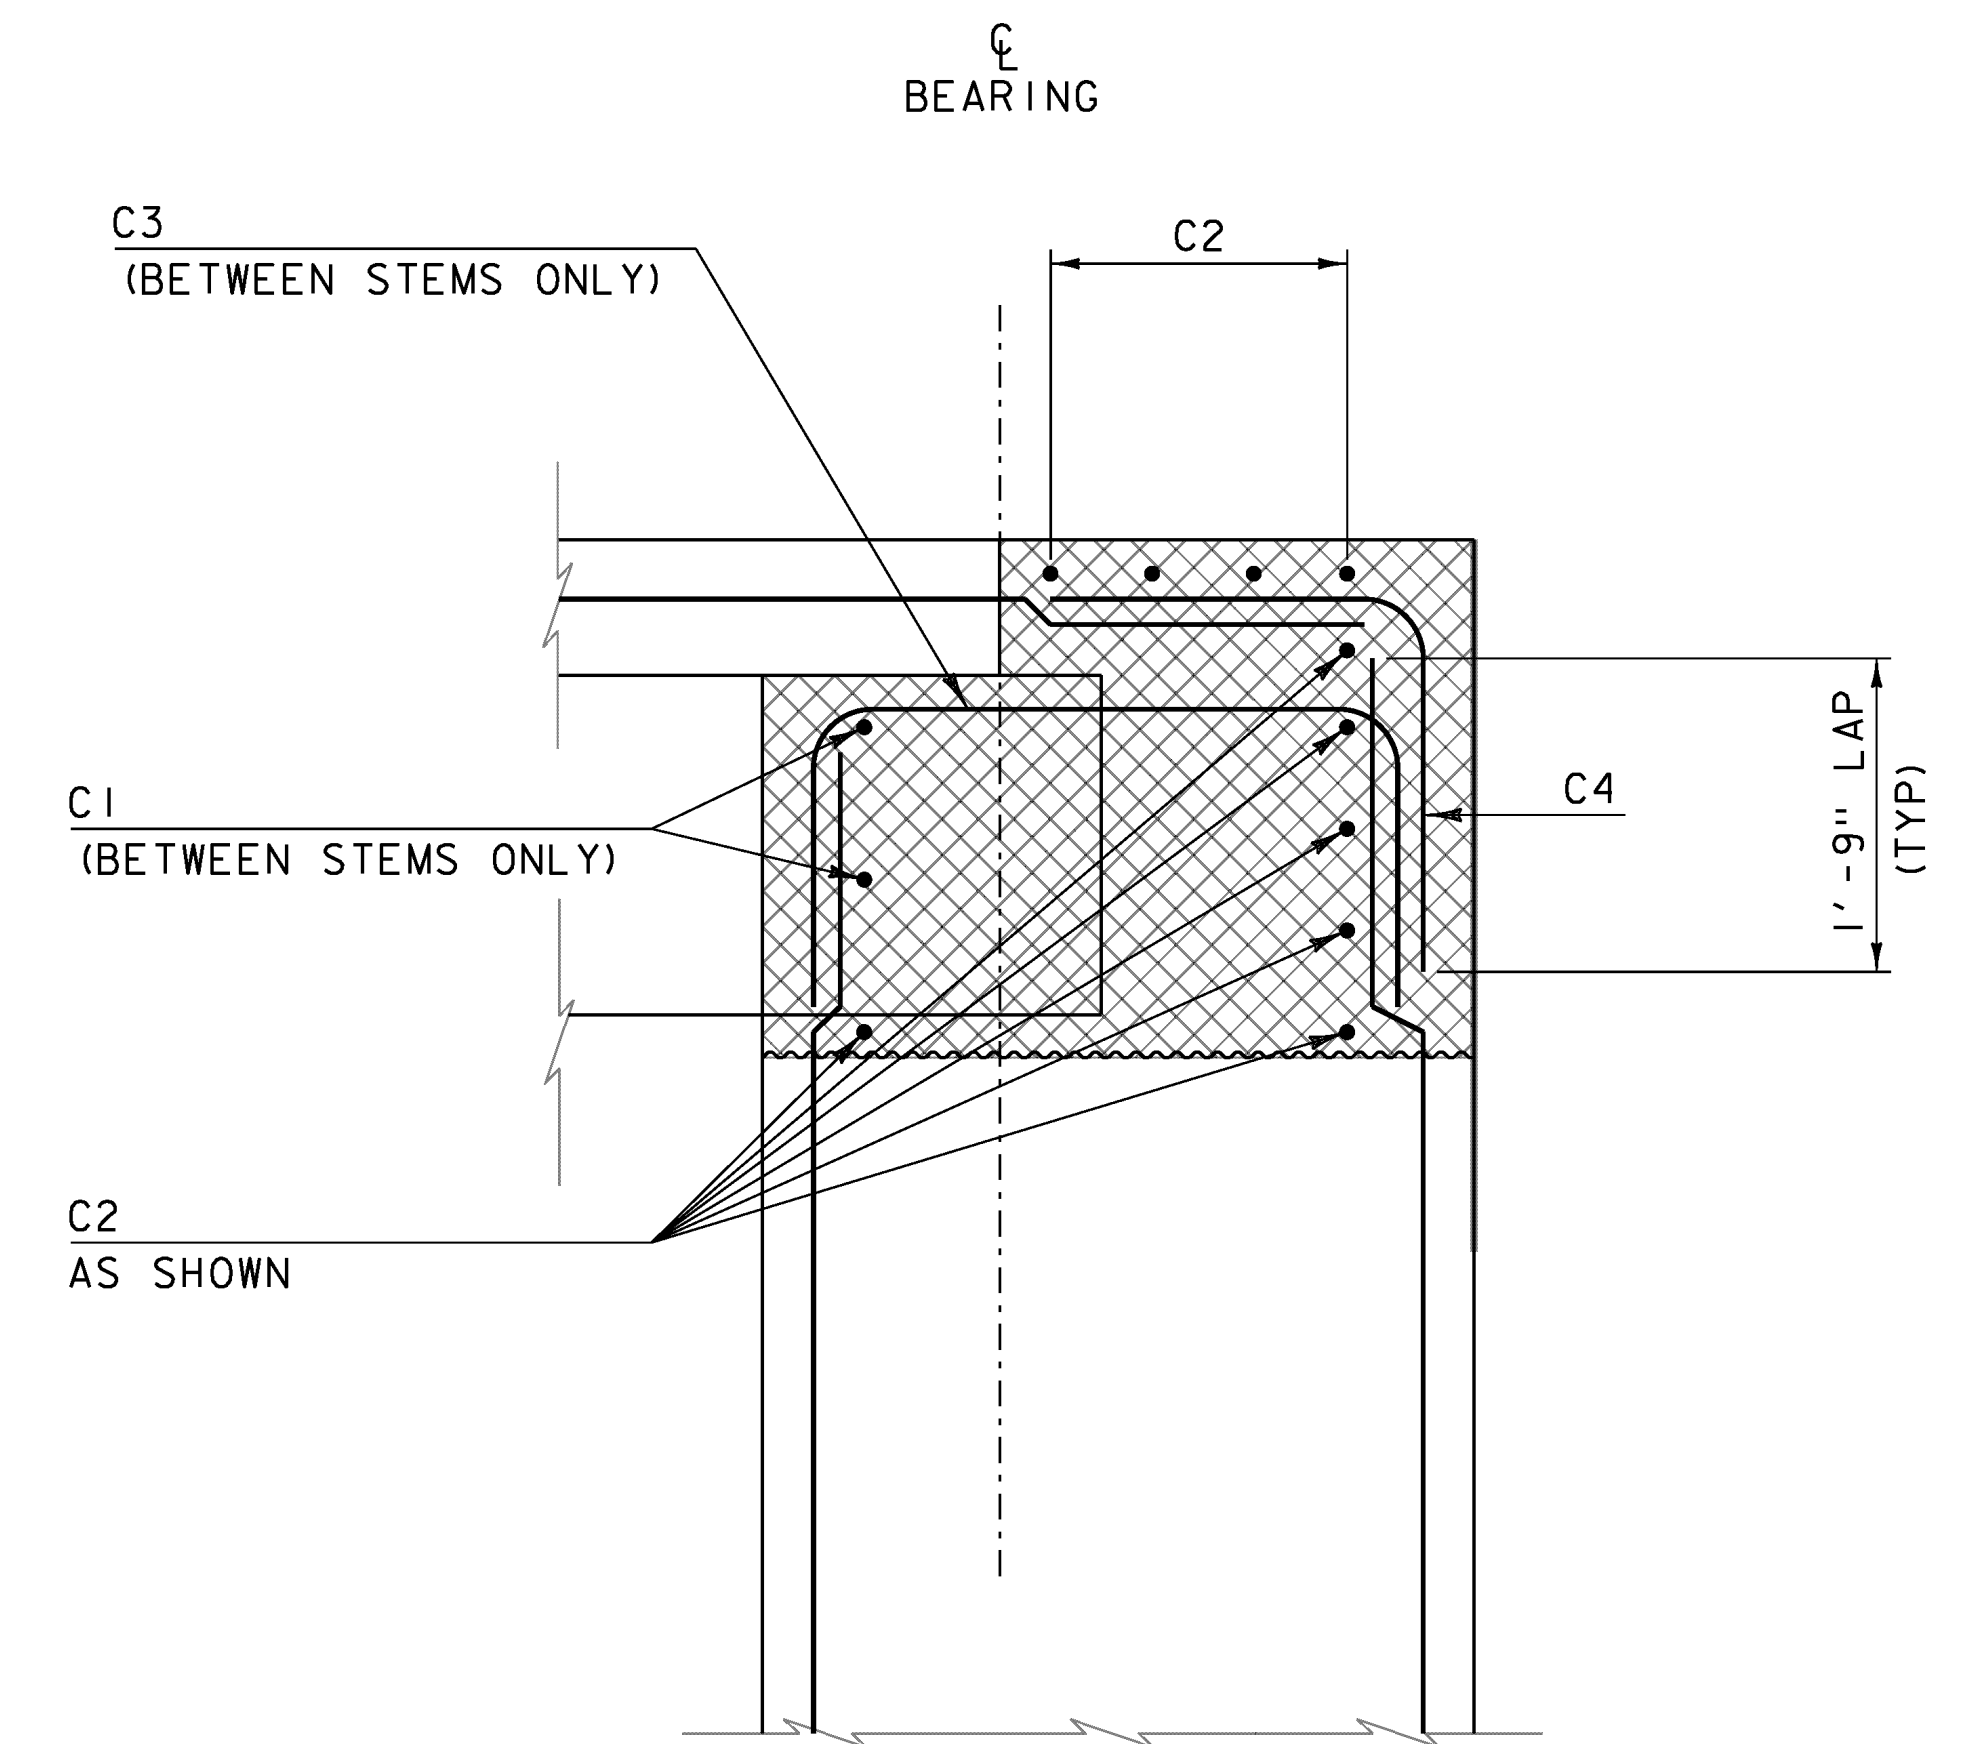

**REINFORCING TYPICAL**  
SCALE 1" = 1'-0"

NOTE:  
1. ABUTMENT 1 SHOWN, ABUTMENT 2 SIMILAR.

NOTE:  
NF = NEAR FACE  
FF = FAR FACE  
EF = EACH FACE  
▲ = CUT TO FIT IN FIELD  
3" CLEAR, UNLESS OTHERWISE SPECIFIED ON THE PLANS.  
2'-7" BAR LAP UNLESS OTHERWISE SPECIFIED ON THE PLANS.

PROJECT NAME: CAMBRIDGE  
PROJECT NUMBER: BRO 1448(39)

FILE NAME: sl2j166sub.dgn  
PROJECT LEADER: K. HIGGINS  
DESIGNED BY: G. LAROCHE  
DECK CLOSURE POUR

PLOT DATE: 29-AUG-2014  
DRAWN BY: J. SALVATORI  
CHECKED BY: W. LAMMER  
SHEET 21 OF 34

## EPSC PLAN NARRATIVE

### 1.1 PROJECT DESCRIPTION

THIS PROJECT INVOLVES THE REPLACEMENT OF BRIDGE 28 WITH RELATED APPROACH AND CHANNEL WORK. BRIDGE 28 WILL BE REPLACED WITH A PRECAST STRUCTURE. THE PROJECT LOCATION IS IN THE TOWN OF CAMBRIDGE, VT ON TOWN HIGHWAY 46 (IRISH SETTLEMENT ROAD) 0.1 MILES WEST FROM THE JUNCTION WITH TOWN HIGHWAY 1 (PLEASANT VALLEY ROAD).

THE NEW STRUCTURE WILL BE APPROXIMATELY 60 FEET WITH 89 FEET OF ROAD WORK.

NOTE: AREA OF DISTURBANCE INCLUDES LIMITS OF EARTH DISTURBANCE WITHIN THE PROJECT AREA, AS WELL AS WASTE, BORROW AND STAGING AREAS, AND OTHER EARTH DISTURBING ACTIVITIES WITHIN OR DIRECTLY ADJACENT TO THE PROJECT LIMITS AS SHOWN ON THE ATTACHED EPSC PLAN.

TOTAL AREA OF DISTURBANCE AS SHOWN ON THE ATTACHED EPSC PLAN IS APPROXIMATELY 0.40 ACRES.

IT IS ANTICIPATED THAT THIS PROJECT WILL LAST ONE CONSTRUCTION SEASON.

### 1.2 SITE INVENTORY

#### 1.2.1 TOPOGRAPHY

THE TOPOGRAPHY OF THE AREA IS RELATIVELY FLAT WITH OPEN FARM FIELDS AND SOME RIPARIAN VEGETATION AND TREES.

#### 1.2.2 DRAINAGE, WATERWAYS, BODIES OF WATER, AND PROXIMITY TO NATURAL OR MAN-MADE WATER FEATURES

SEYMOUR BROOK IS THE ONLY WATER SOURCE ON THE PROJECT SITE. THE BROOK IS CLASSIFIED AS SINUOUS AND ALLUVIAL, WITH A MODERATELY WIDE VALLEY FLOOD PLAIN. THE STREAMBED CONSISTS OF SAND, GRAVEL AND COBBLES.

#### 1.2.3 VEGETATION

THE VEGETATION IN THE PROJECT AREA CONSISTS OF SMALL DIAMETER TREES ALONG THE BANKS OF THE SEYMOUR RIVER WITH FARM FIELDS OUTSIDE OF THIS VEGETATED AREA. THE IMPACT TO VEGETATION WILL BE LIMITED TO THAT WHICH IS DIRECTLY AFFECTED BY REPLACEMENT OF THE EXISTING BRIDGE. UPON PROJECT COMPLETION, THE CHANNEL WILL BE ARMORED WITH STONE FILL TYPE III AS SPECIFIED ON THE PLANS. DISTURBED VEGETATION WILL BE REESTABLISHED WITH STANDARD SEED AND MULCH PRACTICES.

#### 1.2.4 SOILS

ALL SOIL DATA CAME FROM THE U.S. DEPARTMENT OF AGRICULTURE SOIL CONSERVATION SERVICE FOR THE COUNTY OF LAMOILLE, VERMONT.

LyD LYMAN-TUNBRIDGE	15% - 25% SLOPES	"K" FACTOR = 0.24 - 0.28
LyC LYMAN-TUNBRIDGE	8% - 15% SLOPES	"K" FACTOR = 0.24 - 0.28

NOTE: K-VALUES GENERALLY INDICATE THE FOLLOWING:  
0.0-0.23 = LOW EROSION POTENTIAL  
0.24-0.36 = MODERATE EROSION POTENTIAL  
0.37 AND HIGHER = HIGH EROSION POTENTIAL

#### 1.2.5 SENSITIVE RESOURCE AREAS

CRITICAL HABITATS: NO  
HISTORICAL OR ARCHEOLOGICAL AREAS:  
YES - ARCHEOLOGICAL, (SEE PLANS, STA 21+00.00 - 23+50.00 LT)  
YES - HISTORICAL, (SEE PLANS, STA 24+03.00 - 25+50.00 LT, STA 24+00.00 - 25+50.00 RT)  
PRIME AGRICULTURAL LAND: YES  
THREATENED AND ENDANGERED SPECIES: NO  
WATER RESOURCE: SEYMOUR RIVER  
WETLANDS: NO

### 1.3 RISK EVALUATION

THIS PROJECT DOES NOT FALL UNDER THE JURISDICTION OF GENERAL PERMIT 3-9020 FOR STORM WATER RUNOFF FROM CONSTRUCTION SITES. SHOULD CHANGES PRIOR TO OR DURING CONSTRUCTION RESULT IN ONE OR MORE ACRES OF EARTH DISTURBANCE OR SHOULD THE PROJECT BECOME PART OF A LARGER PLAN OF DEVELOPMENT, THE CONTRACTOR WILL BE RESPONSIBLE FOR ANY ADDITIONAL PERMITTING.

### 1.4 EROSION PREVENTION AND SEDIMENT CONTROL

THE EROSION CONTROL PLANS ARE MEANT AS A GUIDELINE FOR PREVENTING EROSION AND CONTROLLING SEDIMENT TRANSPORT. THE PRINCIPLES OUTLINED IN THIS NARRATIVE CONSIST OF APPLYING MEASURES THROUGHOUT CONSTRUCTION OF THE PROJECT IN ORDER TO MINIMIZE SEDIMENT TRANSPORT TO THE RECEIVING WATERS. THE MEASURES INCLUDE STABILIZATION AND STRUCTURAL PRACTICES, STORM WATER CONTROLS AND OTHER POLLUTION PREVENTION PRACTICES. THEY HAVE BEEN PROPOSED BY THE DESIGNER AS A BASIS FOR PROTECTING RESOURCES AND WILL NEED TO BE BUILT UPON BASED ON THE SPECIFIC MEANS AND METHODS OF THE CONTRACTOR. REFER TO THE LOW RISK SITE HANDBOOK AND APPROPRIATE DETAIL SHEETS FOR SPECIFIC GUIDANCE AND CONSTRUCTION DETAILING.

ALL MEASURES SHALL BE REGULARLY MAINTAINED AND SHALL BE CHECKED FOR SEDIMENT BUILD-UP. SEDIMENT SHALL BE DISPOSED OF AT AN APPROVED SITE WHERE IT WILL NOT BE SUBJECT TO EROSION.

#### 1.4.1 MARK SITE BOUNDARIES

SITE BOUNDARIES AND AREAS CONSTRUCTION EQUIPMENT CAN ACCESS SHALL BE DELINEATED.

PROJECT DEMARCATION FENCING (PDF) AND BARRIER FENCE SHALL BE USED TO PHYSICALLY MARK SITE BOUNDARIES AS SHOWN ON THE PLANS.

#### 1.4.2 LIMIT DISTURBANCE AREA

PREVENTING INITIAL SOIL EROSION BY MINIMIZING THE EXPOSED AREA IS MUCH MORE EFFECTIVE THAN TREATING ERODED SEDIMENT. EARTH DISTURBANCE CAN BE MINIMIZED THROUGH CONSTRUCTION PHASING BY ONLY OPENING UP EARTH AS NECESSARY. THIS CAN LIMIT THE AREA THAT WILL BE DISTURBED AND EXPOSED TO EROSION. EMPLOY TEMPORARY CONSTRUCTION STABILIZATION PRACTICES IN INCREMENTAL STAGES AS PHASES CHANGE. FOR PROJECTS WHICH FALL UNDER THE CONSTRUCTION GENERAL PERMIT, ONLY THE ACREAGE LISTED ON THE PERMIT AUTHORIZATION MAY BE EXPOSED AT ANY GIVEN TIME.

MAINTAINING VEGETATED BUFFERS ALONG STREAM BANKS, WETLANDS OR OTHER SENSITIVE AREAS IS A CRUCIAL EROSION AND SEDIMENT CONTROL MEASURE THAT SHOULD BE ESTABLISHED WHEREVER POSSIBLE.

#### 1.4.3 SITE ENTRANCE/EXIT STABILIZATION

TRACKING OF SEDIMENT ONTO PUBLIC HIGHWAYS SHALL BE MINIMIZED TO REDUCE THE POTENTIAL FOR RUNOFF ENTERING RECEIVING WATERS. INSTALLATION SHALL COINCIDE WITH THE CONTRACTORS PROGRESS SCHEDULE.

STABILIZED CONSTRUCTION ENTRANCES SHALL BE INSTALLED AS PROPOSED ON THE EPSC PLAN AND ANYWHERE EQUIPMENT WILL BE GOING FROM AREAS OF EXPOSED SOILS TO PAVED SURFACES.

#### 1.4.4 INSTALL SEDIMENT BARRIERS

SEDIMENT BARRIERS SHALL BE UTILIZED TO INTERCEPT RUNOFF AND ALLOW SUSPENDED SEDIMENT TO SETTLE OUT. THEY SHALL BE INSTALLED PRIOR TO ANY UP SLOPE WORK.

SILT FENCE WILL BE INSTALLED AS PROPOSED ON THE EPSC PLAN.

FILTER CURTAIN WILL BE INSTALLED AS PROPOSED ON THE EPSC PLAN.

#### 1.4.5 DIVERT UPLAND RUNOFF

DIVERSIONARY MEASURES SHALL BE USED TO INTERCEPT RUNOFF FROM ABOVE THE CONSTRUCTION AND DIRECT IT AROUND THE DISTURBED AREA SO THAT CLEAN WATER DOES NOT BECOME MUDDIED WHILE TRAVELING OVER EXPOSED SOILS ON THE CONSTRUCTION SITE.

THE PROJECT AREA IS RELATIVELY FLAT. THEREFORE IT IS NOT ANTICIPATED THAT DIVERSION MEASURES WILL BE NECESSARY.

#### 1.4.6 SLOW DOWN CHANNELIZED RUNOFF

CHECK STRUCTURES SHALL BE UTILIZED TO REDUCE THE VELOCITY, AND THUS THE EROSION POTENTIAL, OF CONCENTRATED FLOW IN CHANNELS.

IT IS NOT ANTICIPATED THAT CHECK STRUCTURES WILL BE NECESSARY.

#### 1.4.7 CONSTRUCT PERMANENT CONTROLS

PERMANENT STORM WATER TREATMENT DEVICES SHALL BE INSTALLED AS SHOWN ON THE PLANS AND IN ACCORDANCE WITH PERMIT CONDITIONS.

THERE ARE NO PERMANENT STORM WATER TREATMENT DEVICES ANTICIPATED ON THIS PROJECT.

#### 1.4.8 STABILIZE EXPOSED SOILS DURING CONSTRUCTION

ALL AREAS OF DISTURBANCE MUST HAVE TEMPORARY STABILIZATION IN PLACE WITHIN 48 HOURS OF DISTURBANCE OR IN ACCORDANCE WITH THE CONSTRUCTION GENERAL PERMIT 3-9020 AUTHORIZATION.

SURFACE ROUGHENING OF ALL EXPOSED SLOPES, COMBINED WITH TEMPORARY MULCHING, SHALL BE UTILIZED ON A REGULAR BASIS. BIODEGRADABLE EROSION CONTROL MATTING OR AN EQUIVALENT SHALL BE USED TO STABILIZE ALL SLOPES STEEPER THAN 1:3.

THE FORECAST OF RAINFALL EVENTS SHALL TRIGGER IMMEDIATE PROTECTION OF EXPOSED SOILS.

#### 1.4.9 WINTER STABILIZATION

VARIOUS MEASURES SPECIFIC TO WINTER MAY BE NECESSARY SHOULD THE PROJECT EXTEND INTO WINTER (OCTOBER 15 THROUGH APRIL 15). REFER TO THE LOW RISK SITE HANDBOOK FOR GUIDANCE.

#### 1.4.10 STABILIZE SOIL AT FINAL GRADE

EXPOSED SOIL MUST BE STABILIZED WITHIN 48 HOURS OF REACHING FINAL GRADE.

SEED, MULCH, FERTILIZER AND LIME SHALL BE USED TO ESTABLISH PERMANENT VEGETATION. FOR SLOPES STEEPER THAN 1:3, BIODEGRADABLE EROSION CONTROL MATTING OR AN EQUIVALENT SHALL BE USED INSTEAD OF MULCH.

#### 1.4.11 DE-WATERING ACTIVITIES

DISCHARGE FROM DEWATERING ACTIVITIES THAT FLOWS OFF OF THE CONSTRUCTION SITE MUST NOT CAUSE OR CONTRIBUTE TO A VIOLATION OF THE VERMONT WATER QUALITY STANDARDS.

TREATMENT OF DEWATERING COFFERDAM IS NOT ANTICIPATED.

#### 1.4.12 INSPECT YOUR SITE

INSPECT THE PROJECT SITE BASED ON SPECIAL PROVISION REQUIREMENTS OR CONSTRUCTION GENERAL PERMIT AUTHORIZATION STIPULATIONS.

### 1.5 SEQUENCE AND STAGING

THIS SECTION WILL BE DEVELOPED BY THE CONTRACTOR USING THE GUIDANCE OUTLINED IN THE VTRANS EPSC PLAN CONTRACTOR CHECKLIST.


#### 1.5.1 CONSTRUCTION SEQUENCE

#### 1.5.2 OFF-SITE ACTIVITIES

IN ADDITION TO THE CONTRACTOR CHECKLIST ANY ACTIVITIES OUTSIDE THE CONSTRUCTION LIMITS SHALL FOLLOW SPECIFICATION 105.25- 105.29 OF THE STANDARD SPECIFICATIONS FOR CONSTRUCTION.

PROJECT NAME: CAMBRIDGE  
PROJECT NUMBER: BRO 1448 (39)

FILE NAME: sl2j166epsc_nar.dgn	PLOT DATE: 29-AUG-2014
PROJECT LEADER: K. HIGGINS	DRAWN BY: K. FRIEDLAND
DESIGNED BY: G. LAROCHE	CHECKED BY: J. SALVATORI
EPSC NARRATIVE	SHEET 22 OF 34

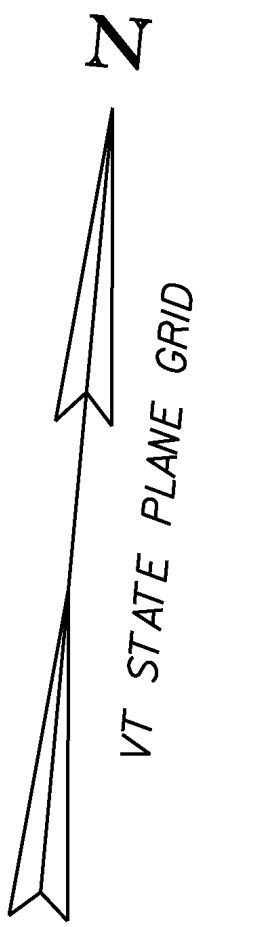


LyD LYMAN-TUNBRIDGE  
FINE SANDY LOAMS  
WITH 15%-25% SLOPES  
"K" FACTOR = .24 -.28  
VERY STONY

BEGIN PROJECT  
BEGIN PAVEMENT  
STA 23+00.00

BEGIN BRIDGE  
STA 23+47.67

END BRIDGE  
STA 24+08.33

END PROJECT  
END PAVEMENT  
STA 24+50.00

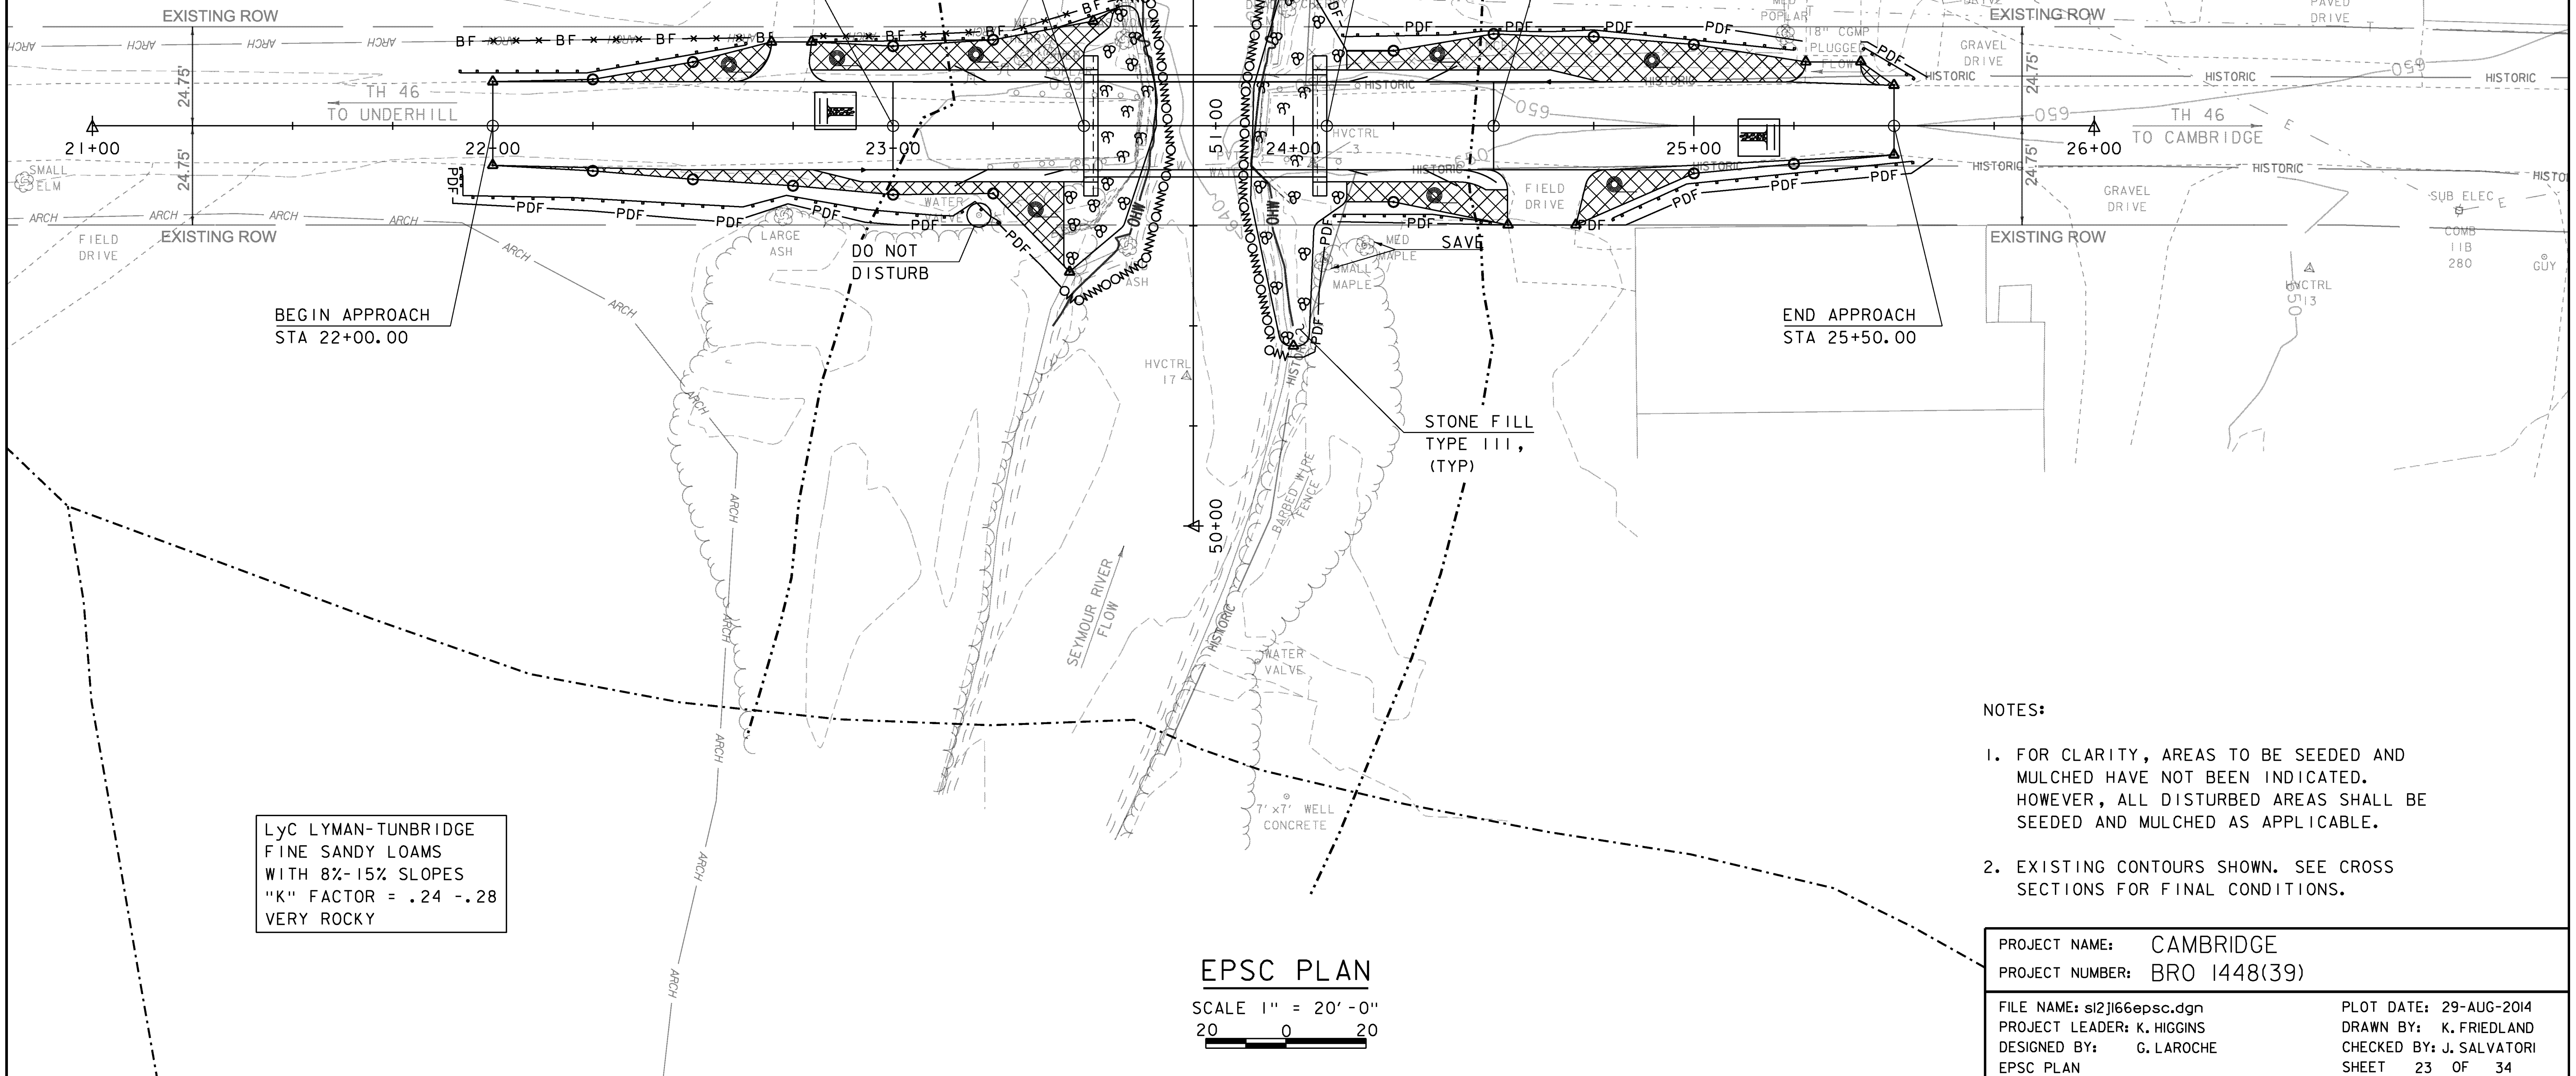

LyC LYMAN-TUNBRIDGE  
FINE SANDY LOAMS  
WITH 8%-15% SLOPES  
"K" FACTOR = .24 -.28  
VERY ROCKY

NOTES:

1. FOR CLARITY, AREAS TO BE SEEDED AND MULCHED HAVE NOT BEEN INDICATED. HOWEVER, ALL DISTURBED AREAS SHALL BE SEEDED AND MULCHED AS APPLICABLE.
2. EXISTING CONTOURS SHOWN. SEE CROSS SECTIONS FOR FINAL CONDITIONS.



PROJECT NAME: CAMBRIDGE  
PROJECT NUMBER: BRO 1448(39)

FILE NAME: s12j166epsc.dgn  
PROJECT LEADER: K. HIGGINS  
DESIGNED BY: G. LAROCHE  
EPSC PLAN

PLOT DATE: 29-AUG-2014  
DRAWN BY: K. FRIEDLAND  
CHECKED BY: J. SALVATORI  
SHEET 23 OF 34

EPSC PLAN

SCALE 1" = 20'-0"  
20 0 20

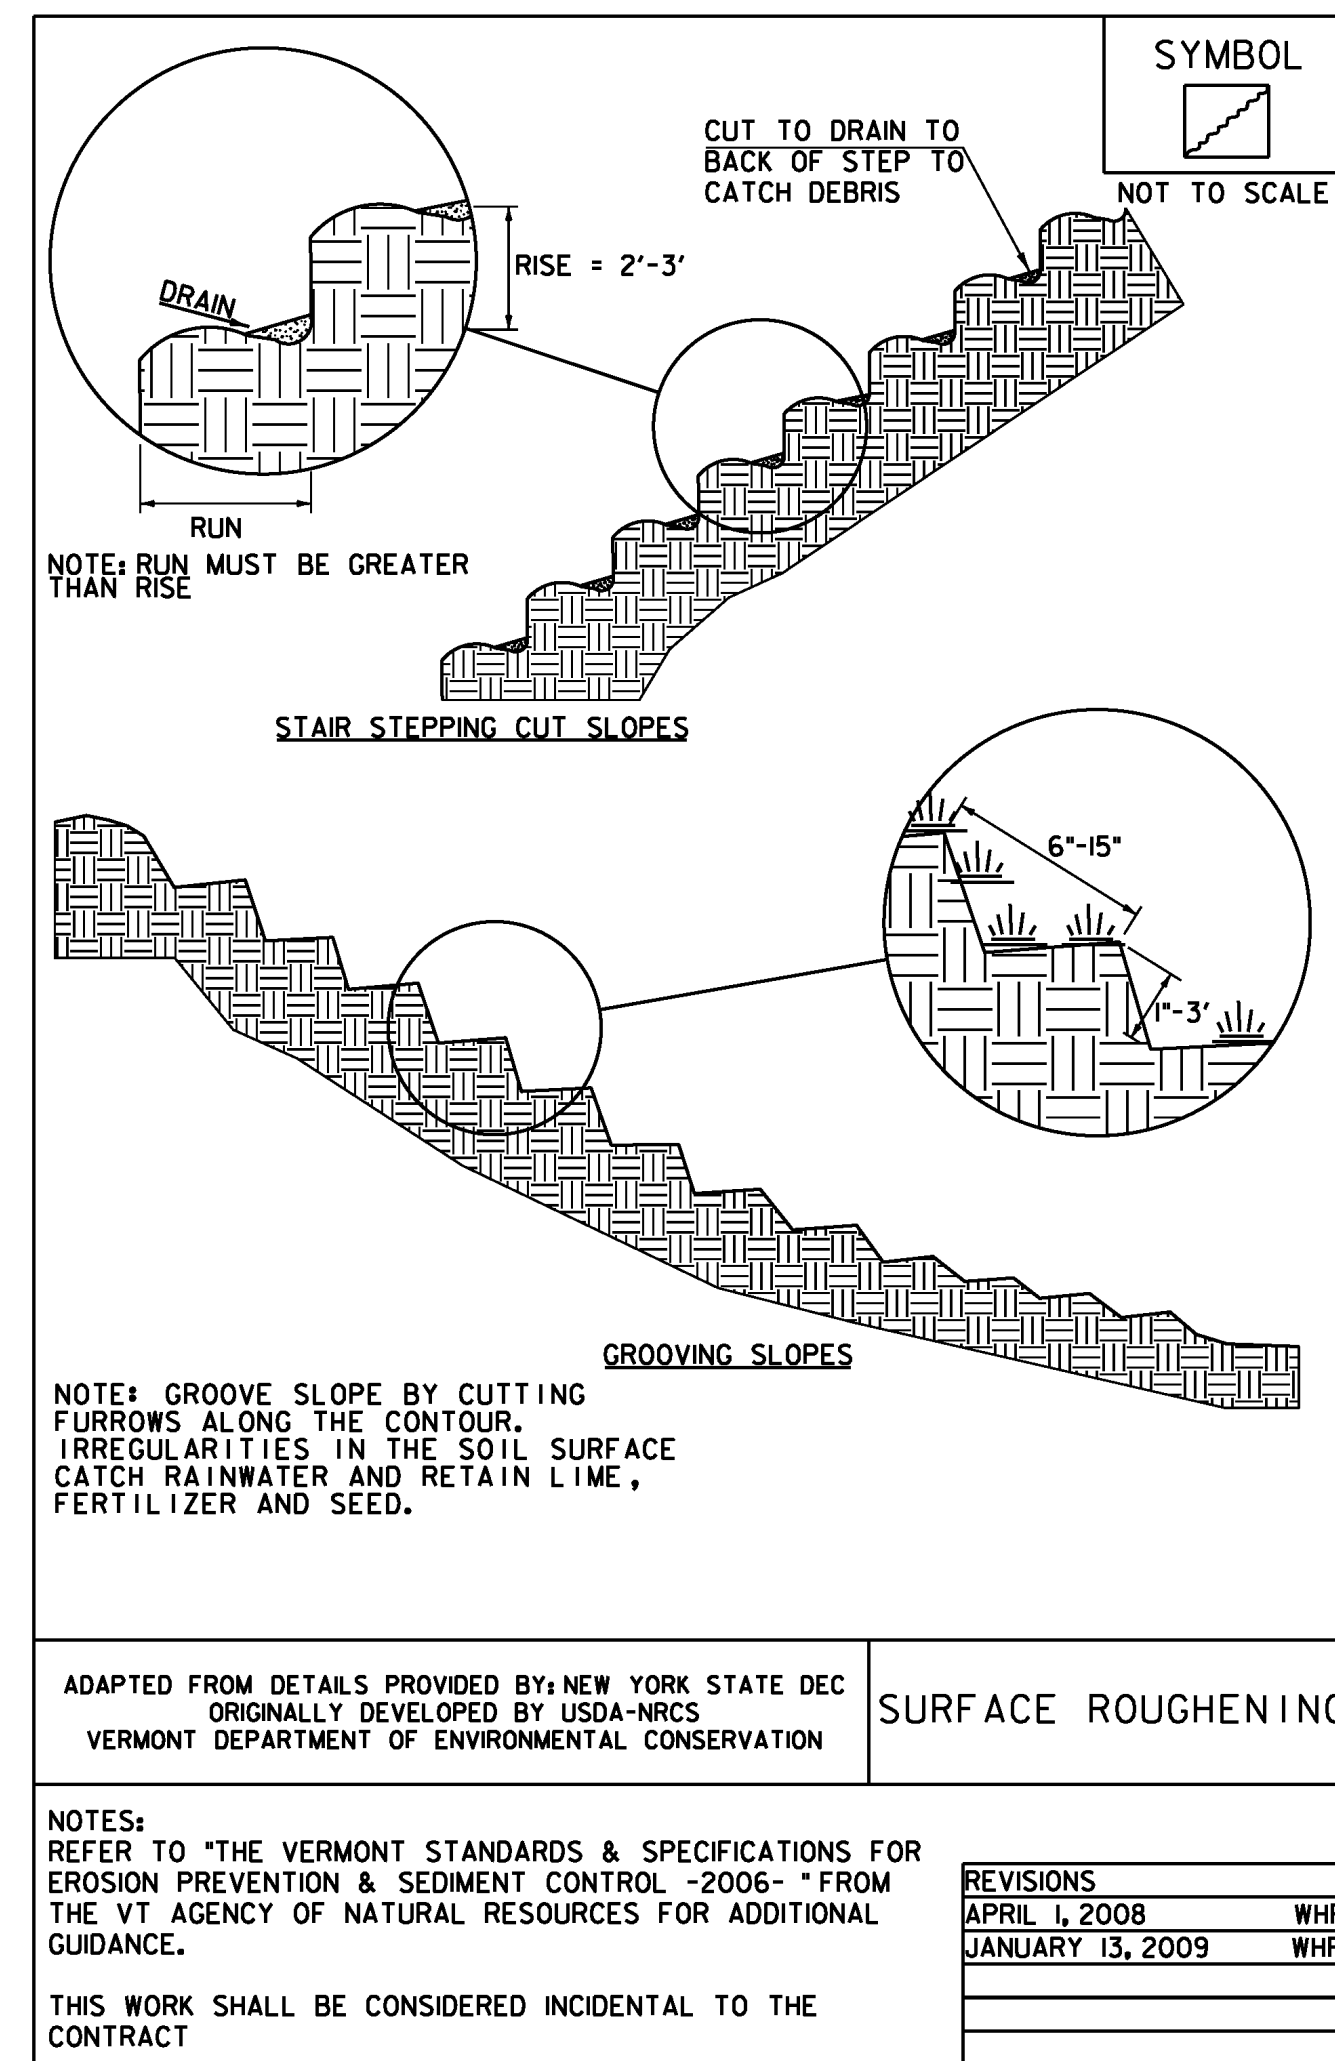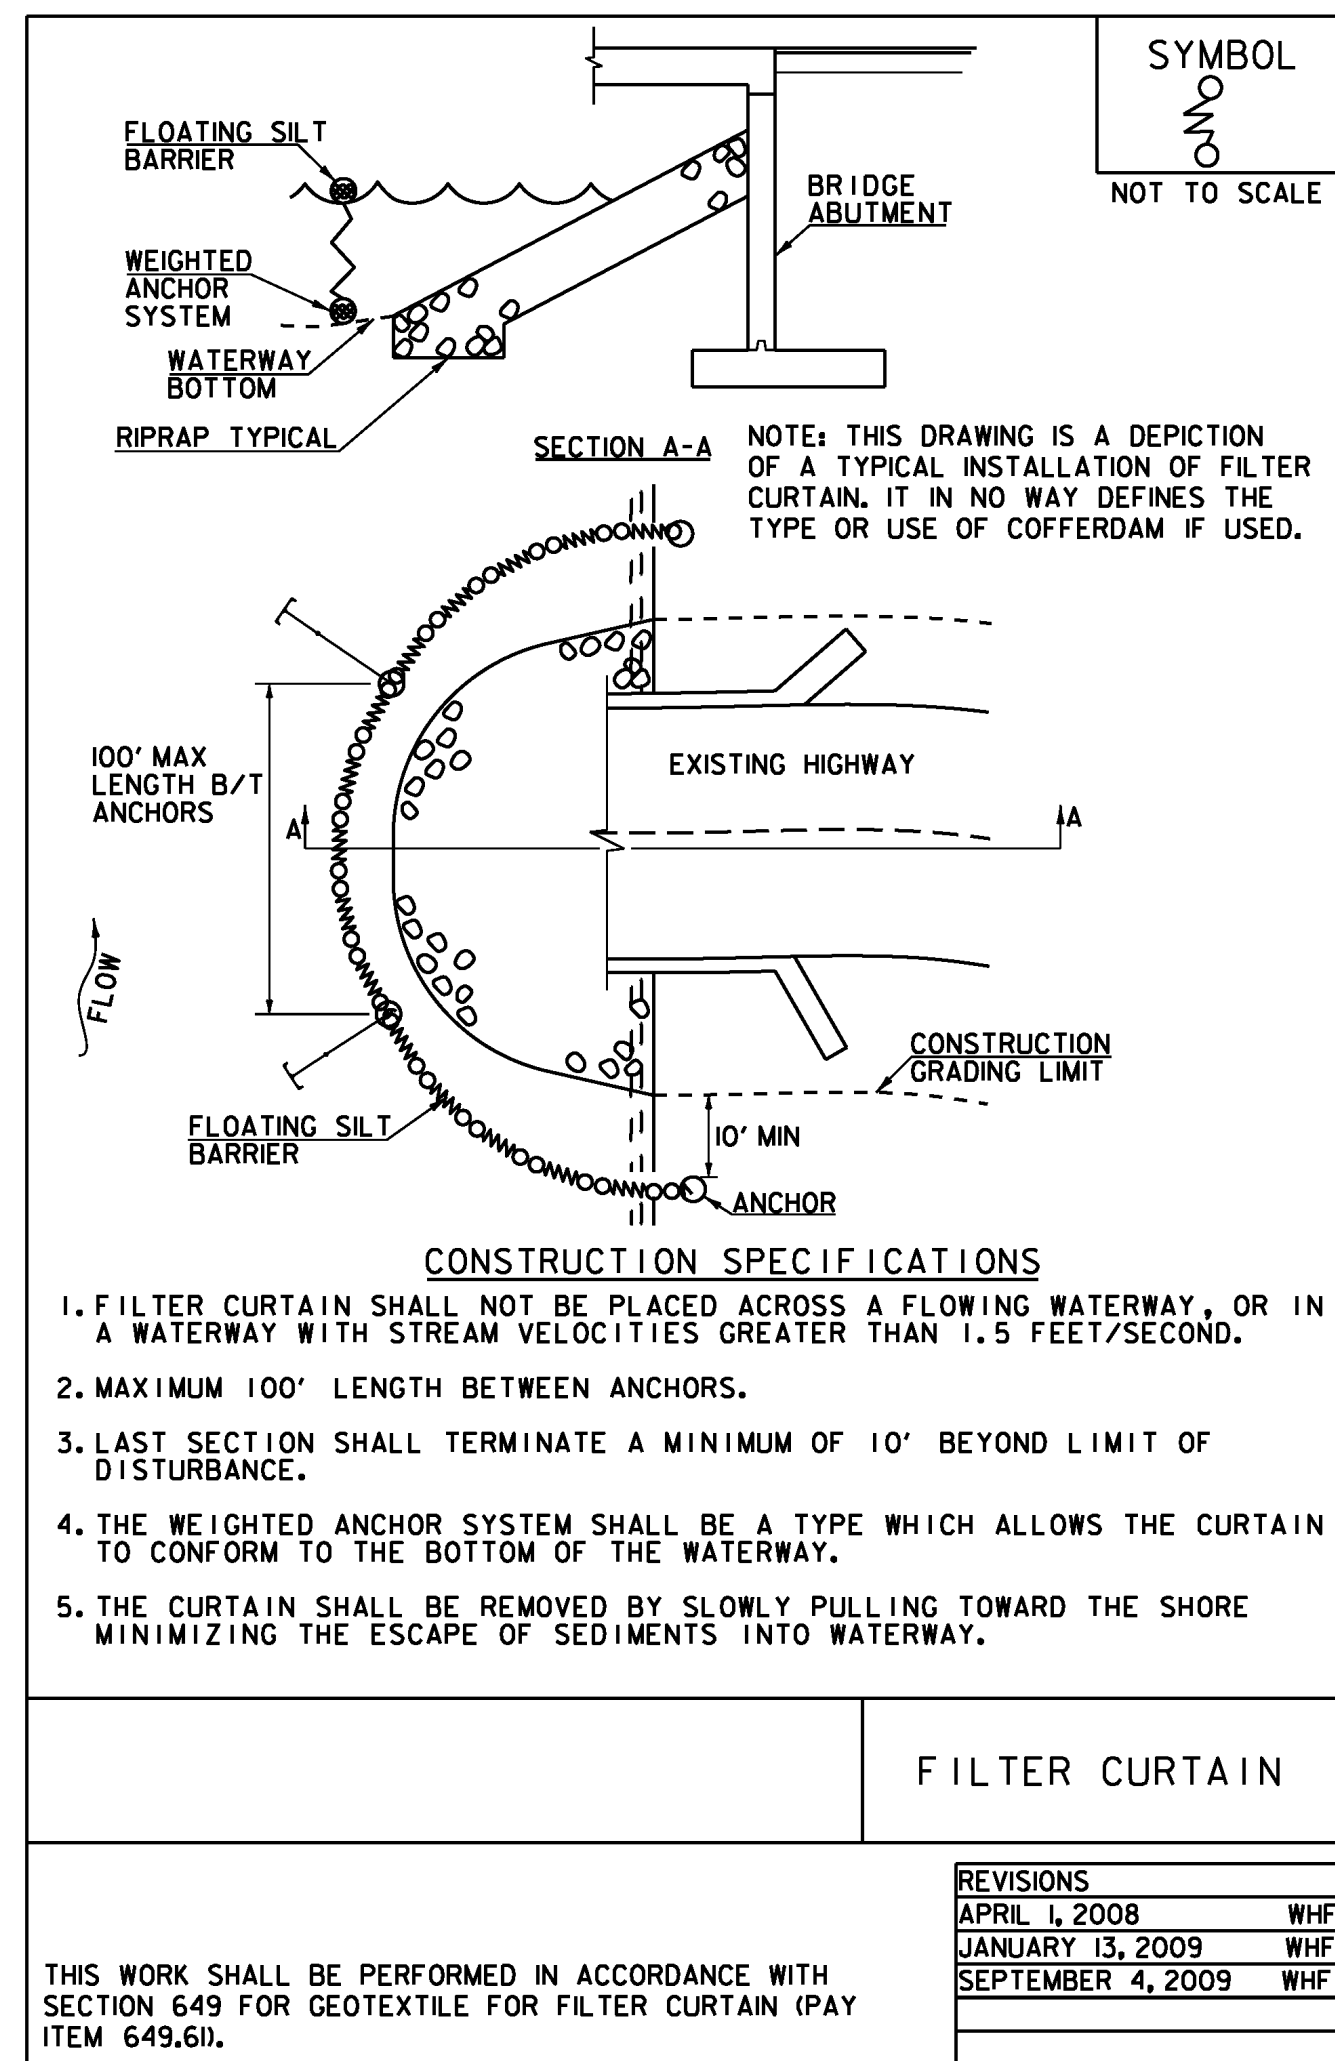

**VAOT RURAL AREA MIX**

% WEIGHT	BROADCAST	HYDROSEED	NAME	GERM %	PURITY %
37.5%	22.5	45	CREeping RED FESCUE	85%	98%
37.5%	22.5	45	TALL FESCUE	90%	95%
5.0%	3	6	RED TOP	90%	95%
15.0%	9	18	BIRDSFOOT TREFOIL	85%	98%
5.0%	3	6	ANNUAL RYE GRASS	85%	95%
100%	60	120			

**VAOT URBAN AREA MIX**

% WEIGHT	BROADCAST	HYDROSEED	NAME	GERM %	PURITY %
42.5%	34	68	CREeping RED FESCUE	85%	98%
10.0%	8	16	PERENNIAL RYE GRASS	90%	95%
42.5%	34	68	KENTUCKY BLUE GRASS	85%	85%
5.0%	4	8	ANNUAL RYE GRASS	85%	95%
100%	80	160			

**SOIL AMENDMENT GUIDANCE**

FERTILIZER		LIME	
BROADCAST	HYDROSEED	BROADCAST	HYDROSEED
10-20-10	FOLLOW	PELLETIZED	FOLLOW
500 LBS/AC	MANUFACTURER	2 TONS/AC	MANUFACTURER

**CONSTRUCTION GUIDANCE**




1. RURAL SEED MIX: USE AS INDICATED IN THE PLANS AND/OR FOR ALL ESTABLISHED UPLAND (NON WETLAND) AREAS DISTURBED BY THE CONTRACTOR.
2. URBAN SEED MIX: USE AS INDICATED IN THE PLANS AND/OR FOR ALL ESTABLISHED LAWN AREAS DISTURBED BY THE CONTRACTOR.
3. ALL SEED MIXTURES: SHALL NOT HAVE A WEED CONTENT EXCEEDING 0.40% BY WEIGHT AND SHALL BE FREE OF ALL NOXIOUS SEED.
4. FERTILIZER AND LIMESTONE: SHALL FOLLOW RATES SHOWN ON PLAN OR AS DIRECTED BY THE ENGINEER.
5. HAY MULCH: TO BE PLACED ON EARTH SLOPES AT THE RATE OF 2 TONS/ACRE, ACHIEVE 90% GROUND COVER OR AS DIRECTED BY THE ENGINEER.
6. TOPSOIL: TO BE USED WITH SEED AS INDICATED ON THE PLANS, OR AS DIRECTED BY THE ENGINEER.
7. HYDROSEEDING: ALTHOUGH GUIDANCE IS GIVEN ABOVE THE SITE CONDITIONS AND THE TYPE OF HYDROSEED WILL ULTIMATELY DICTATE THE AMOUNTS AND TYPES OF SOIL AMENDMENTS TO BE APPLIED
8. TURF ESTABLISHMENT: PLACING SEED, FERTILIZER, LIME AND MULCH PRIOR TO SEPTEMBER 15 AND AFTER APRIL 15 CAN BETTER ENSURE A VIGOROUS GROWTH OF GRASS.

**TURF ESTABLISHMENT**

ADAPTED FROM VTTRANS TECHNICAL LANDSCAPE MANUAL FOR ROADWAYS AND TRANSPORTATION FACILITIES

THIS WORK SHALL BE PERFORMED IN ACCORDANCE WITH SECTION 651 FOR SEED (PAY ITEM 651.15)


REVISIONS	
JUNE 23, 2009	WHF
JANUARY 15, 2010	WHF
FEBRUARY 16, 2011	WHF

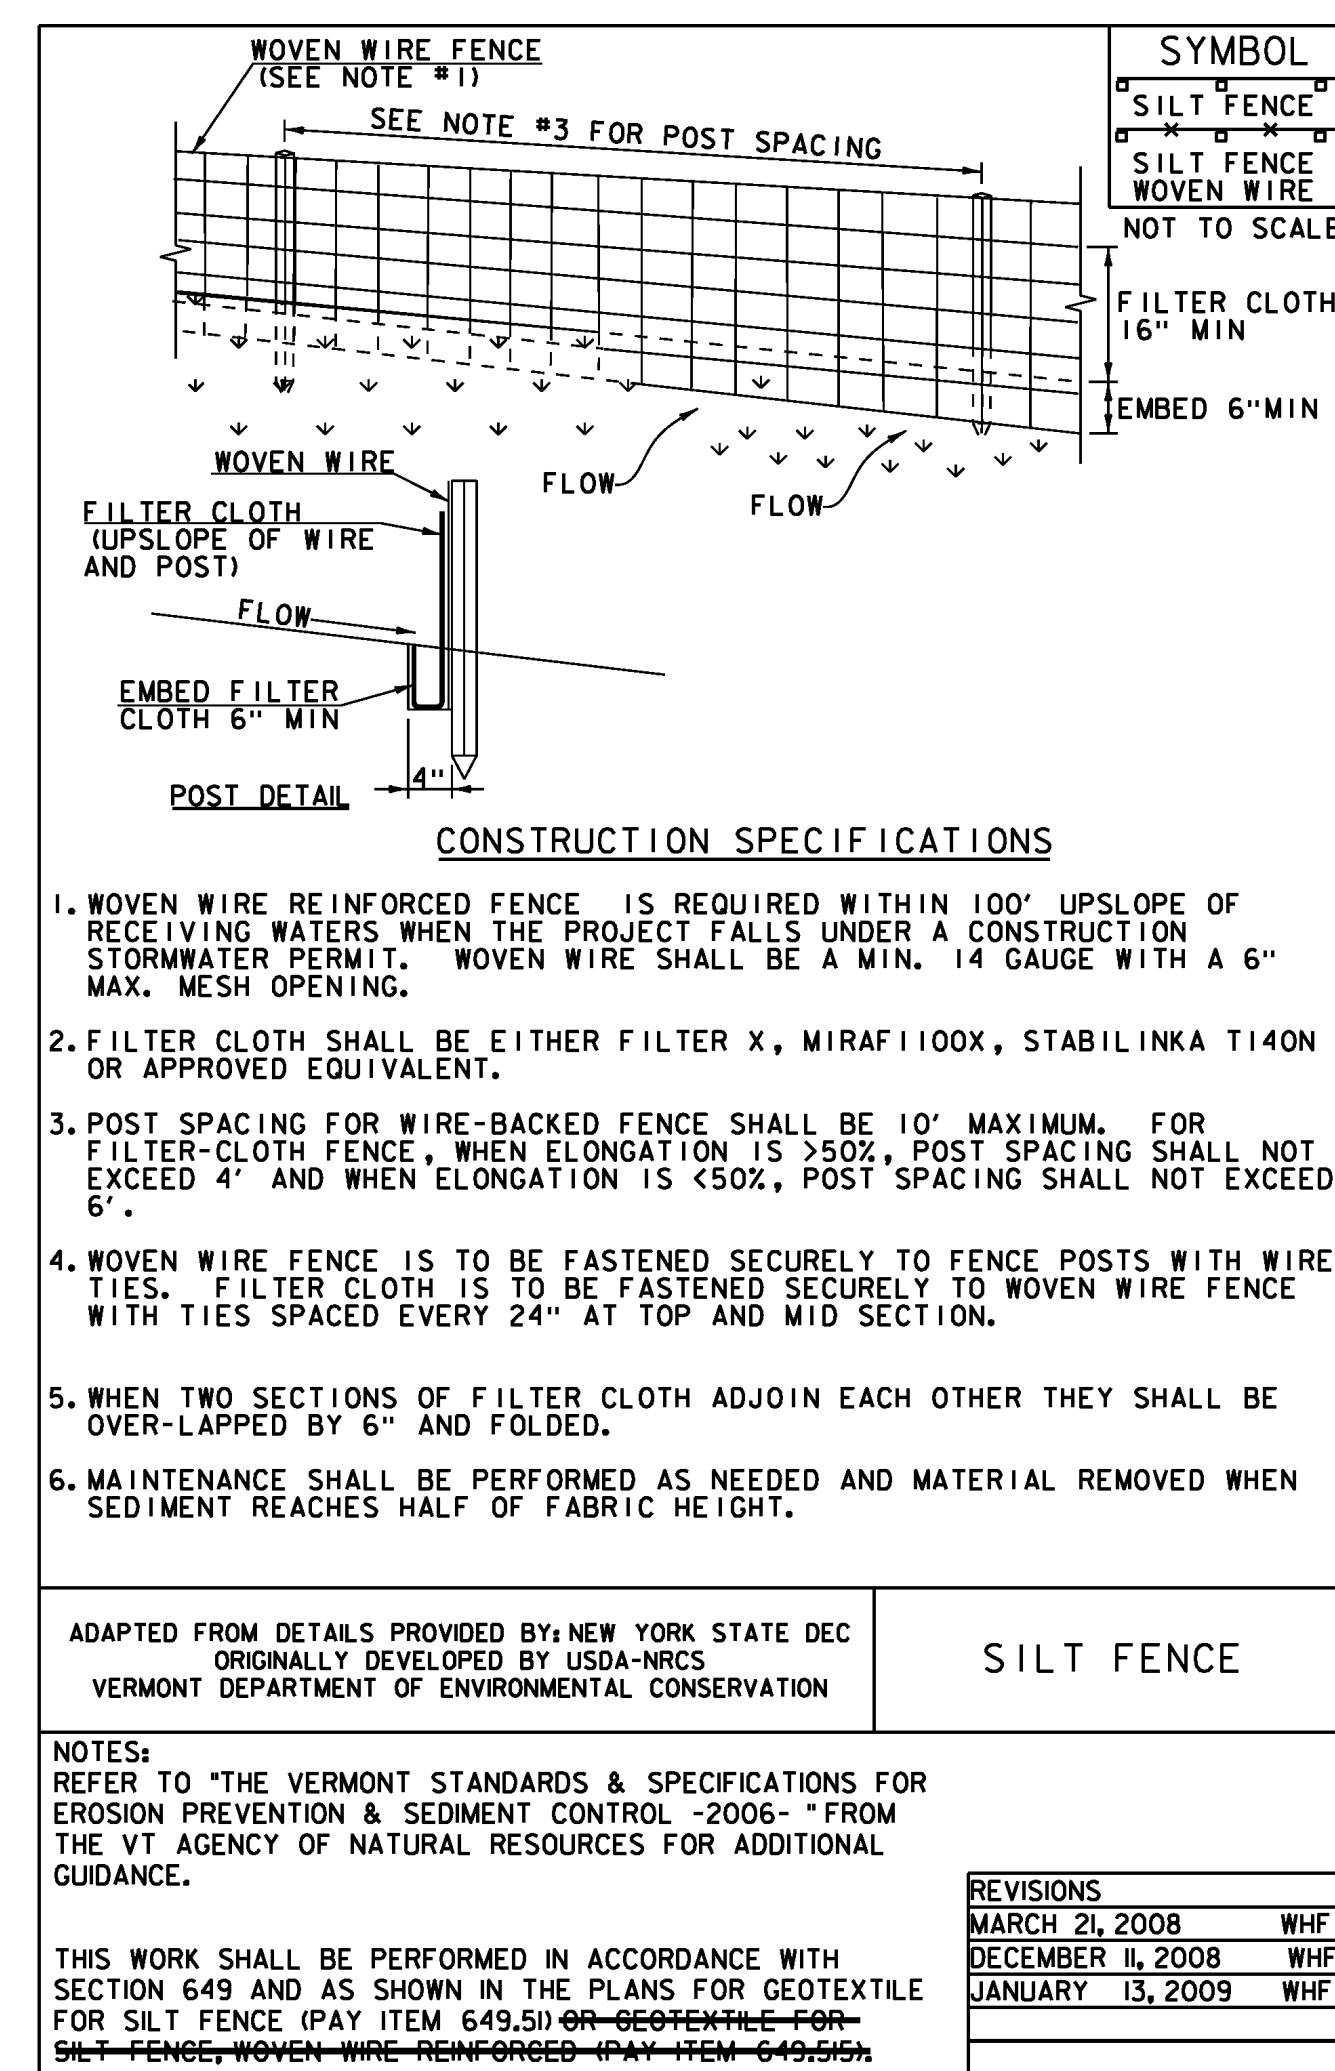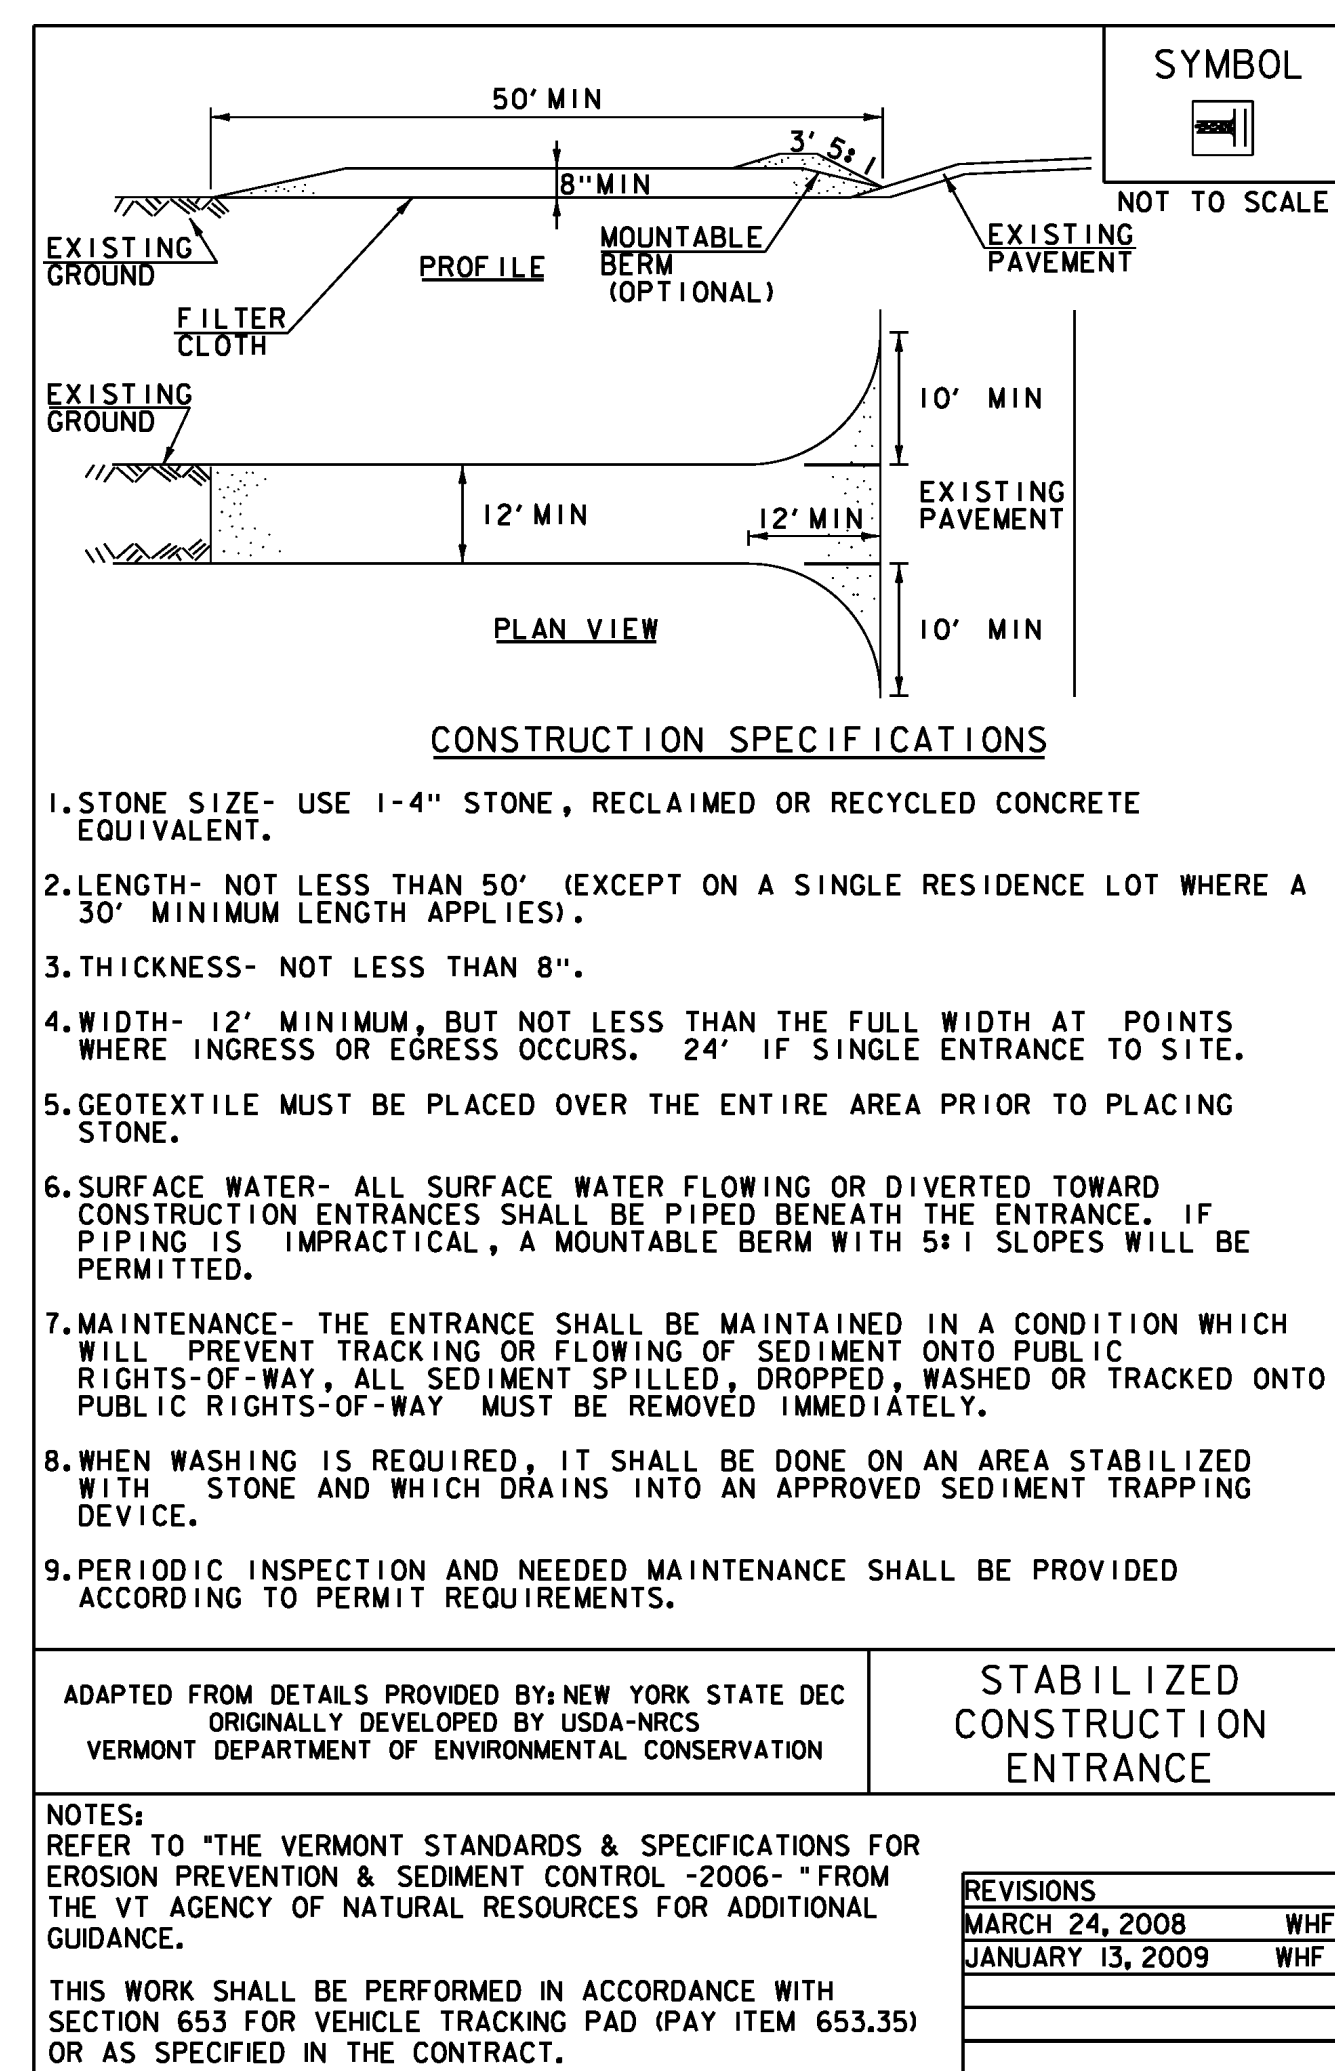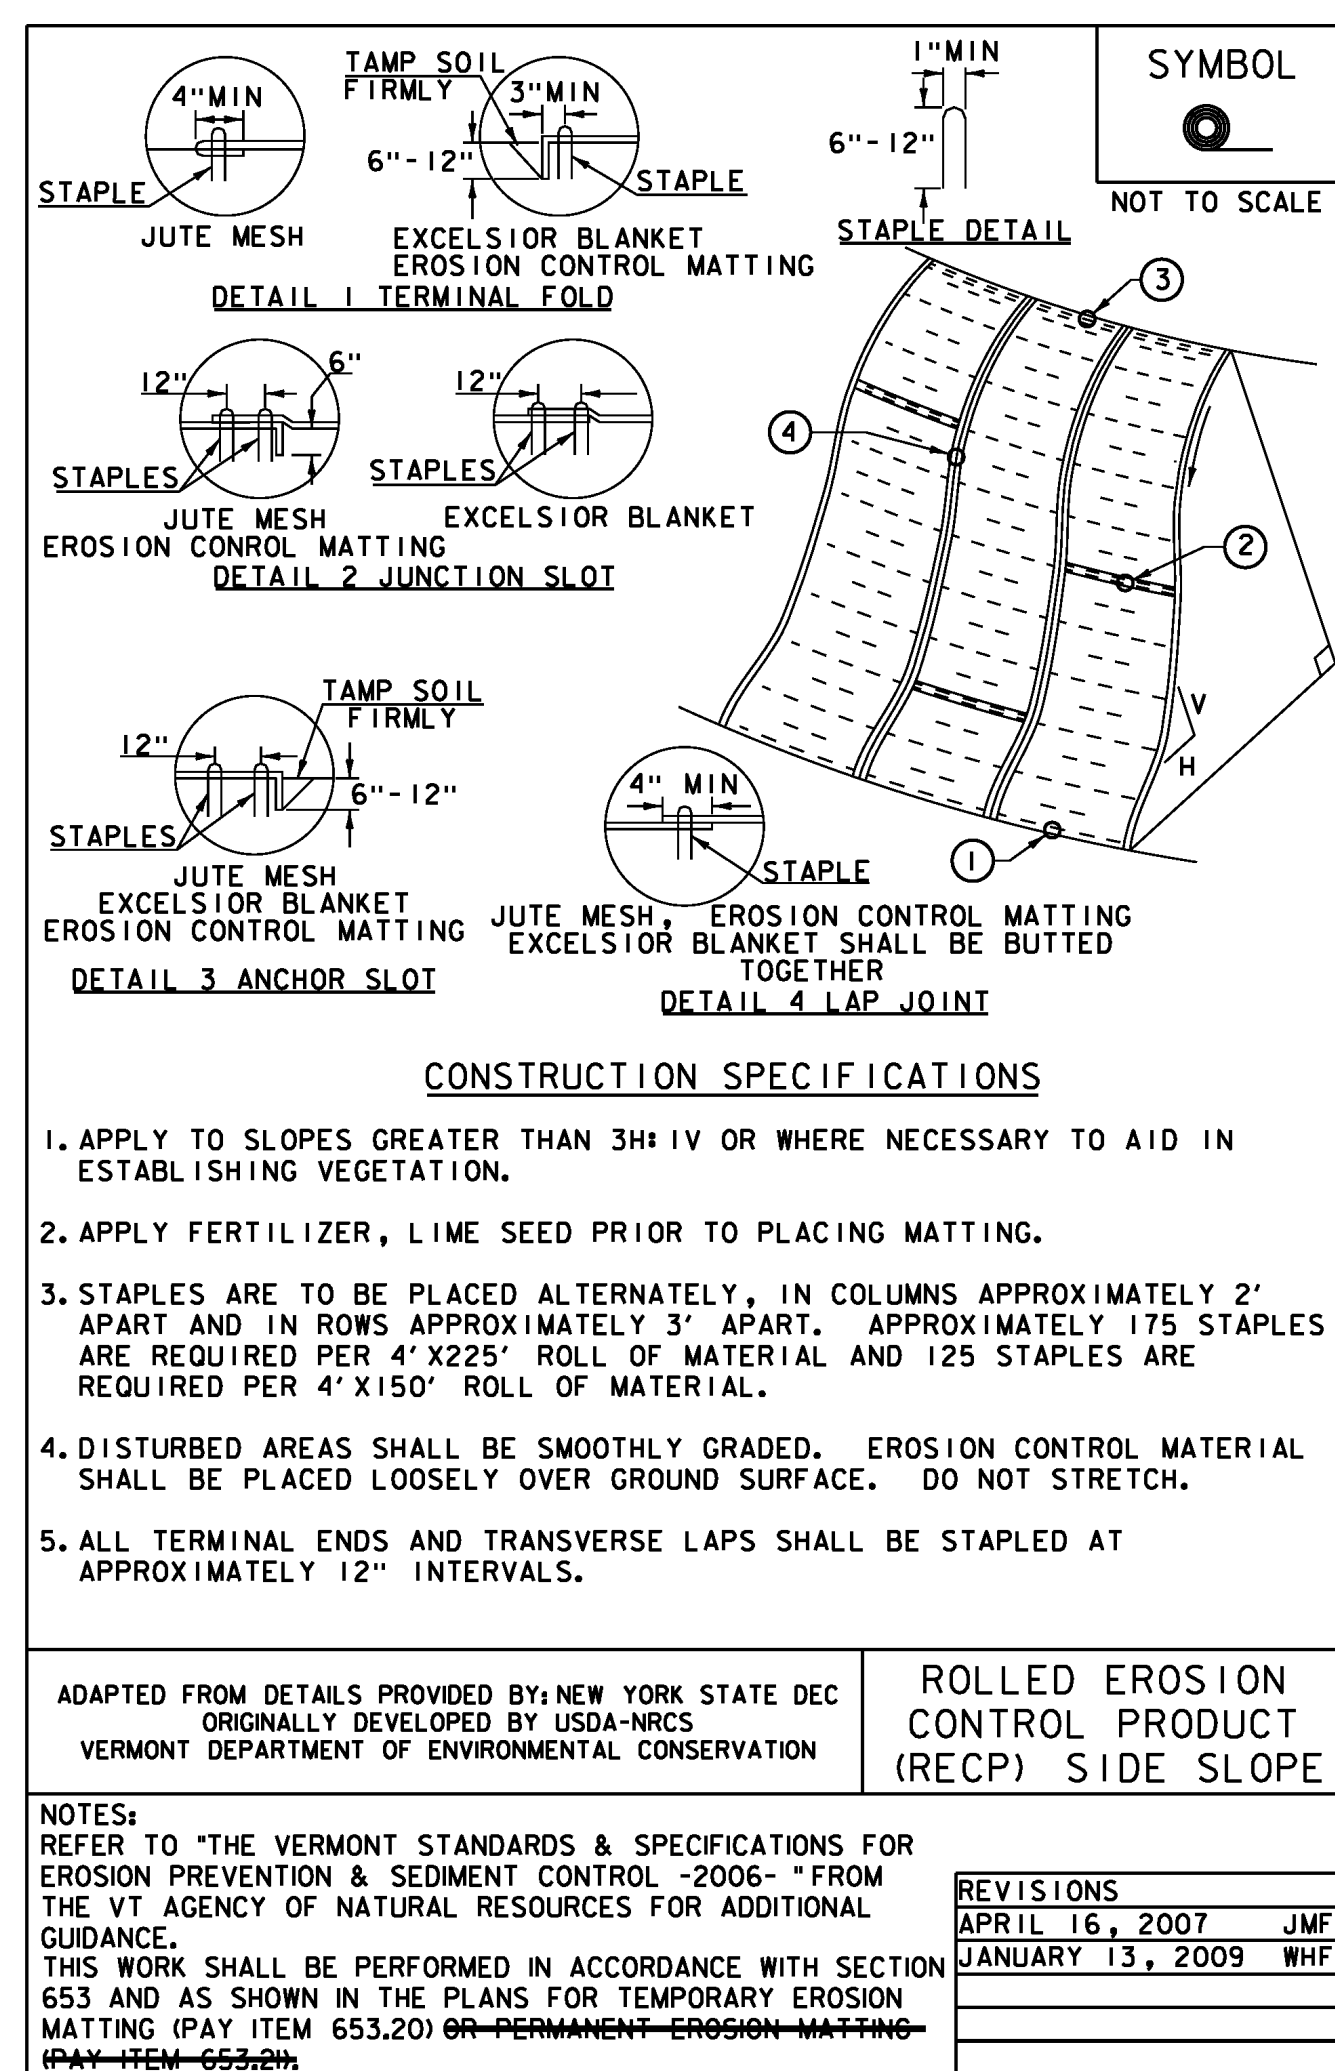


PROJECT NAME: CAMBRIDGE  
PROJECT NUMBER: BRO 1448 (39)

FILE NAME: sl2j166ero.def.dgn  
PROJECT LEADER: K. HIGGINS  
DESIGNED BY: G. LAROCHE  
EPSC DETAILS


PLOT DATE: 29-AUG-2014  
DRAWN BY: K. FRIEDLAND  
CHECKED BY: J. SALVATORI  
SHEET 24 OF 34

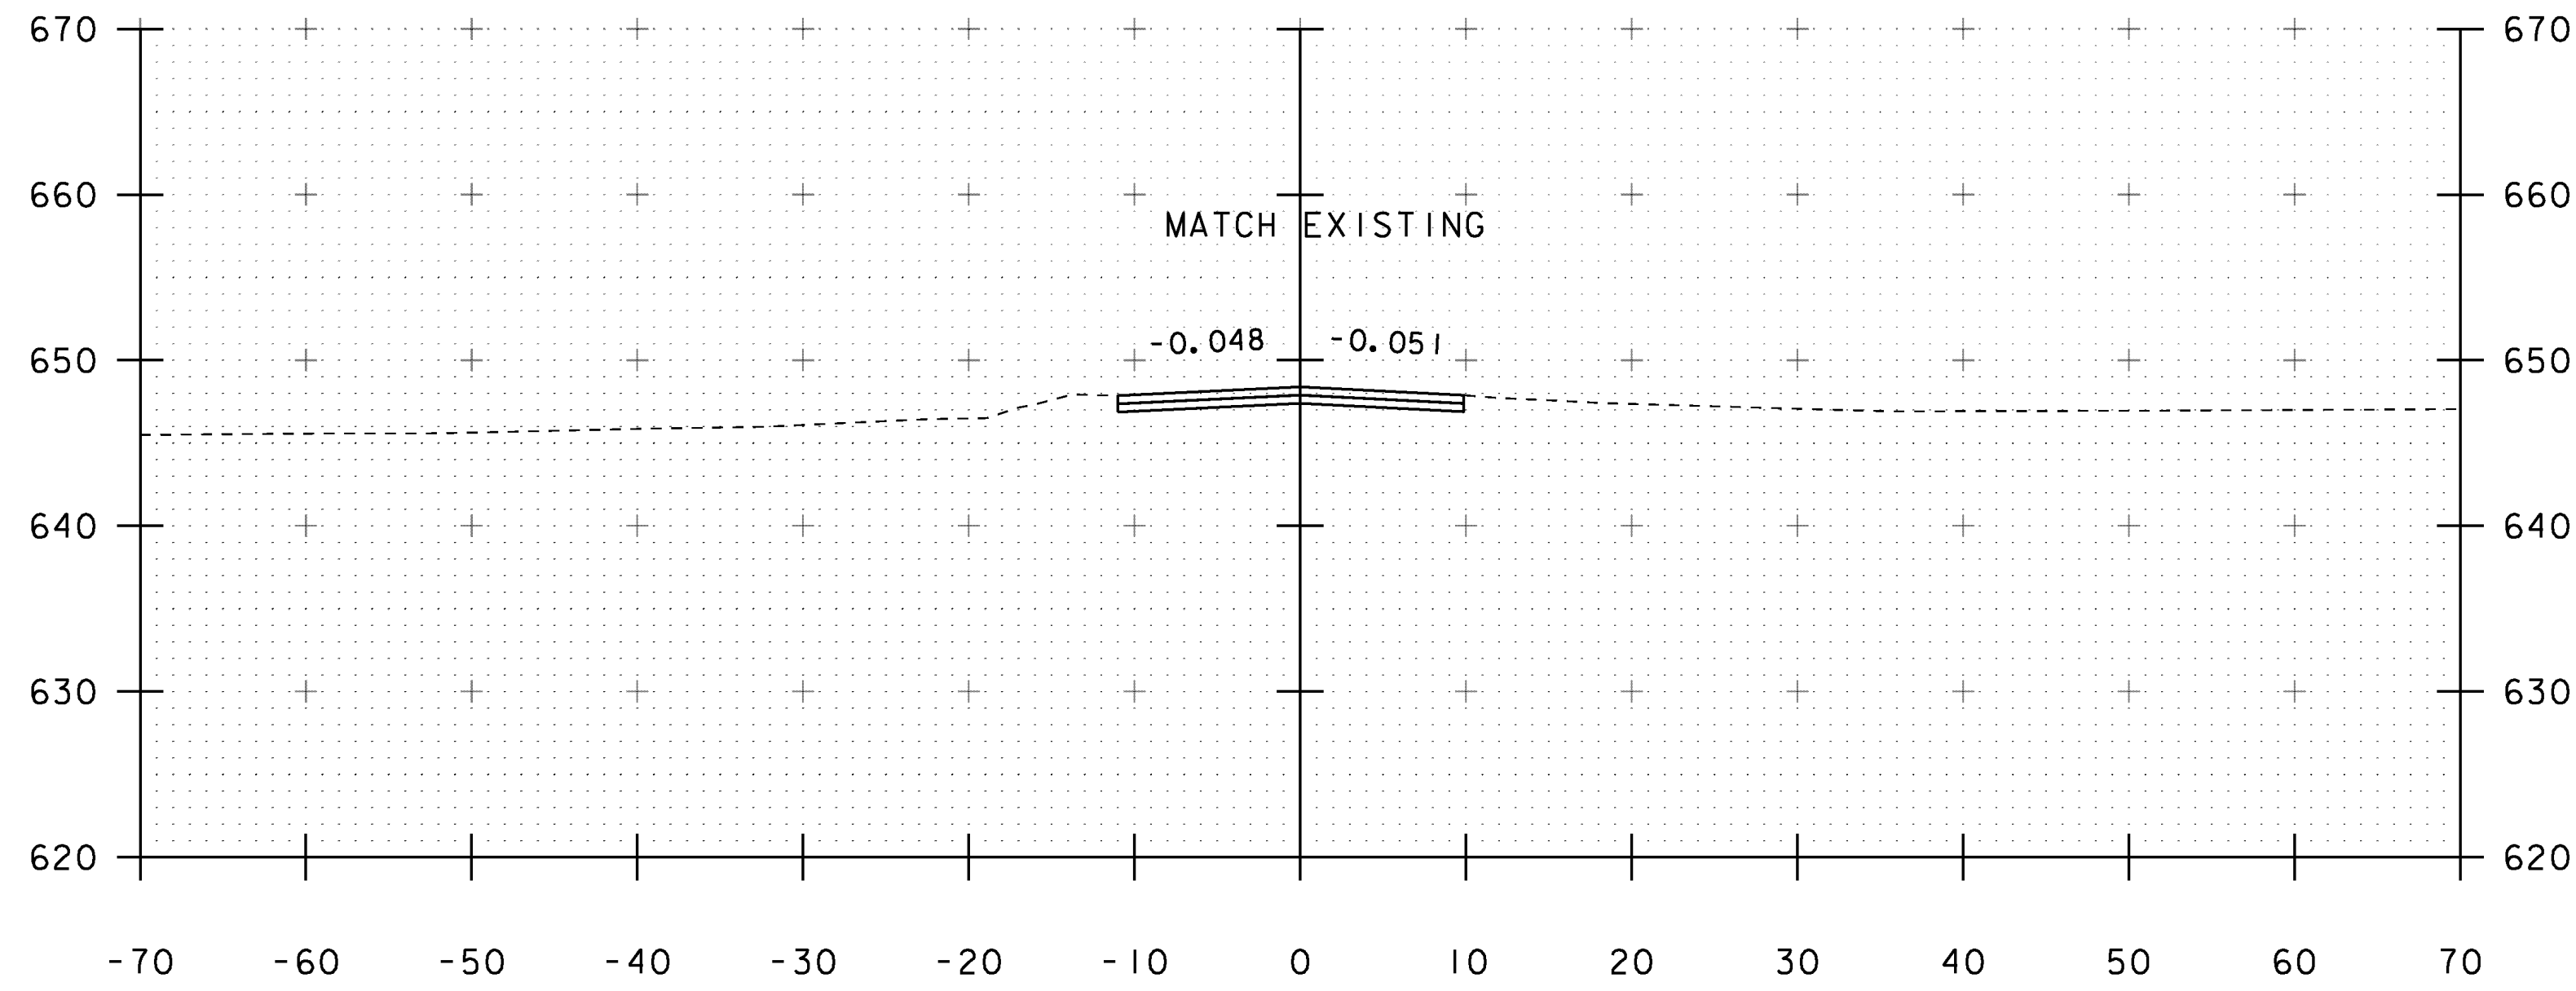


22+00  
BEGIN APPROACH

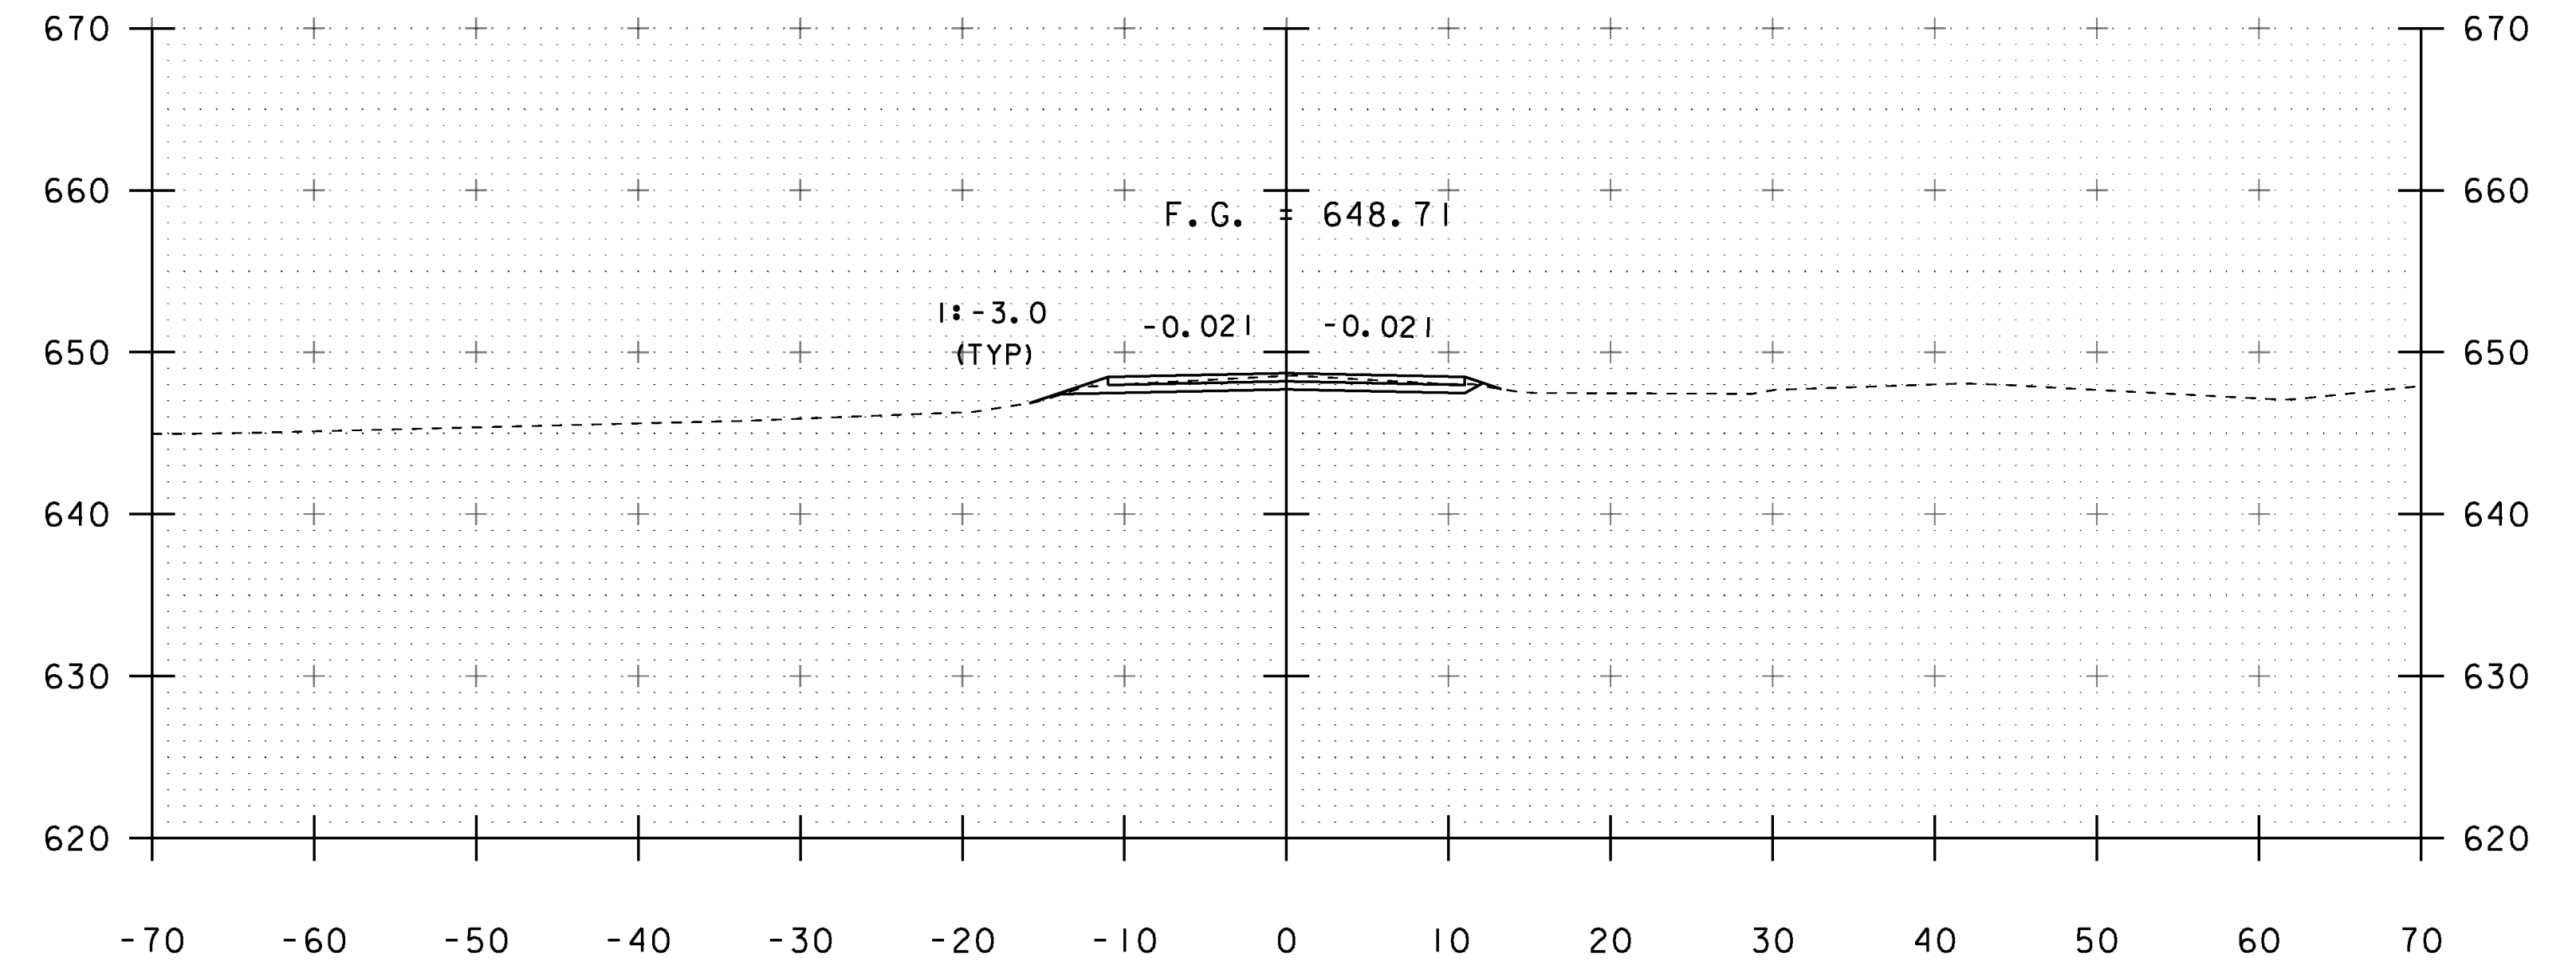

22+50

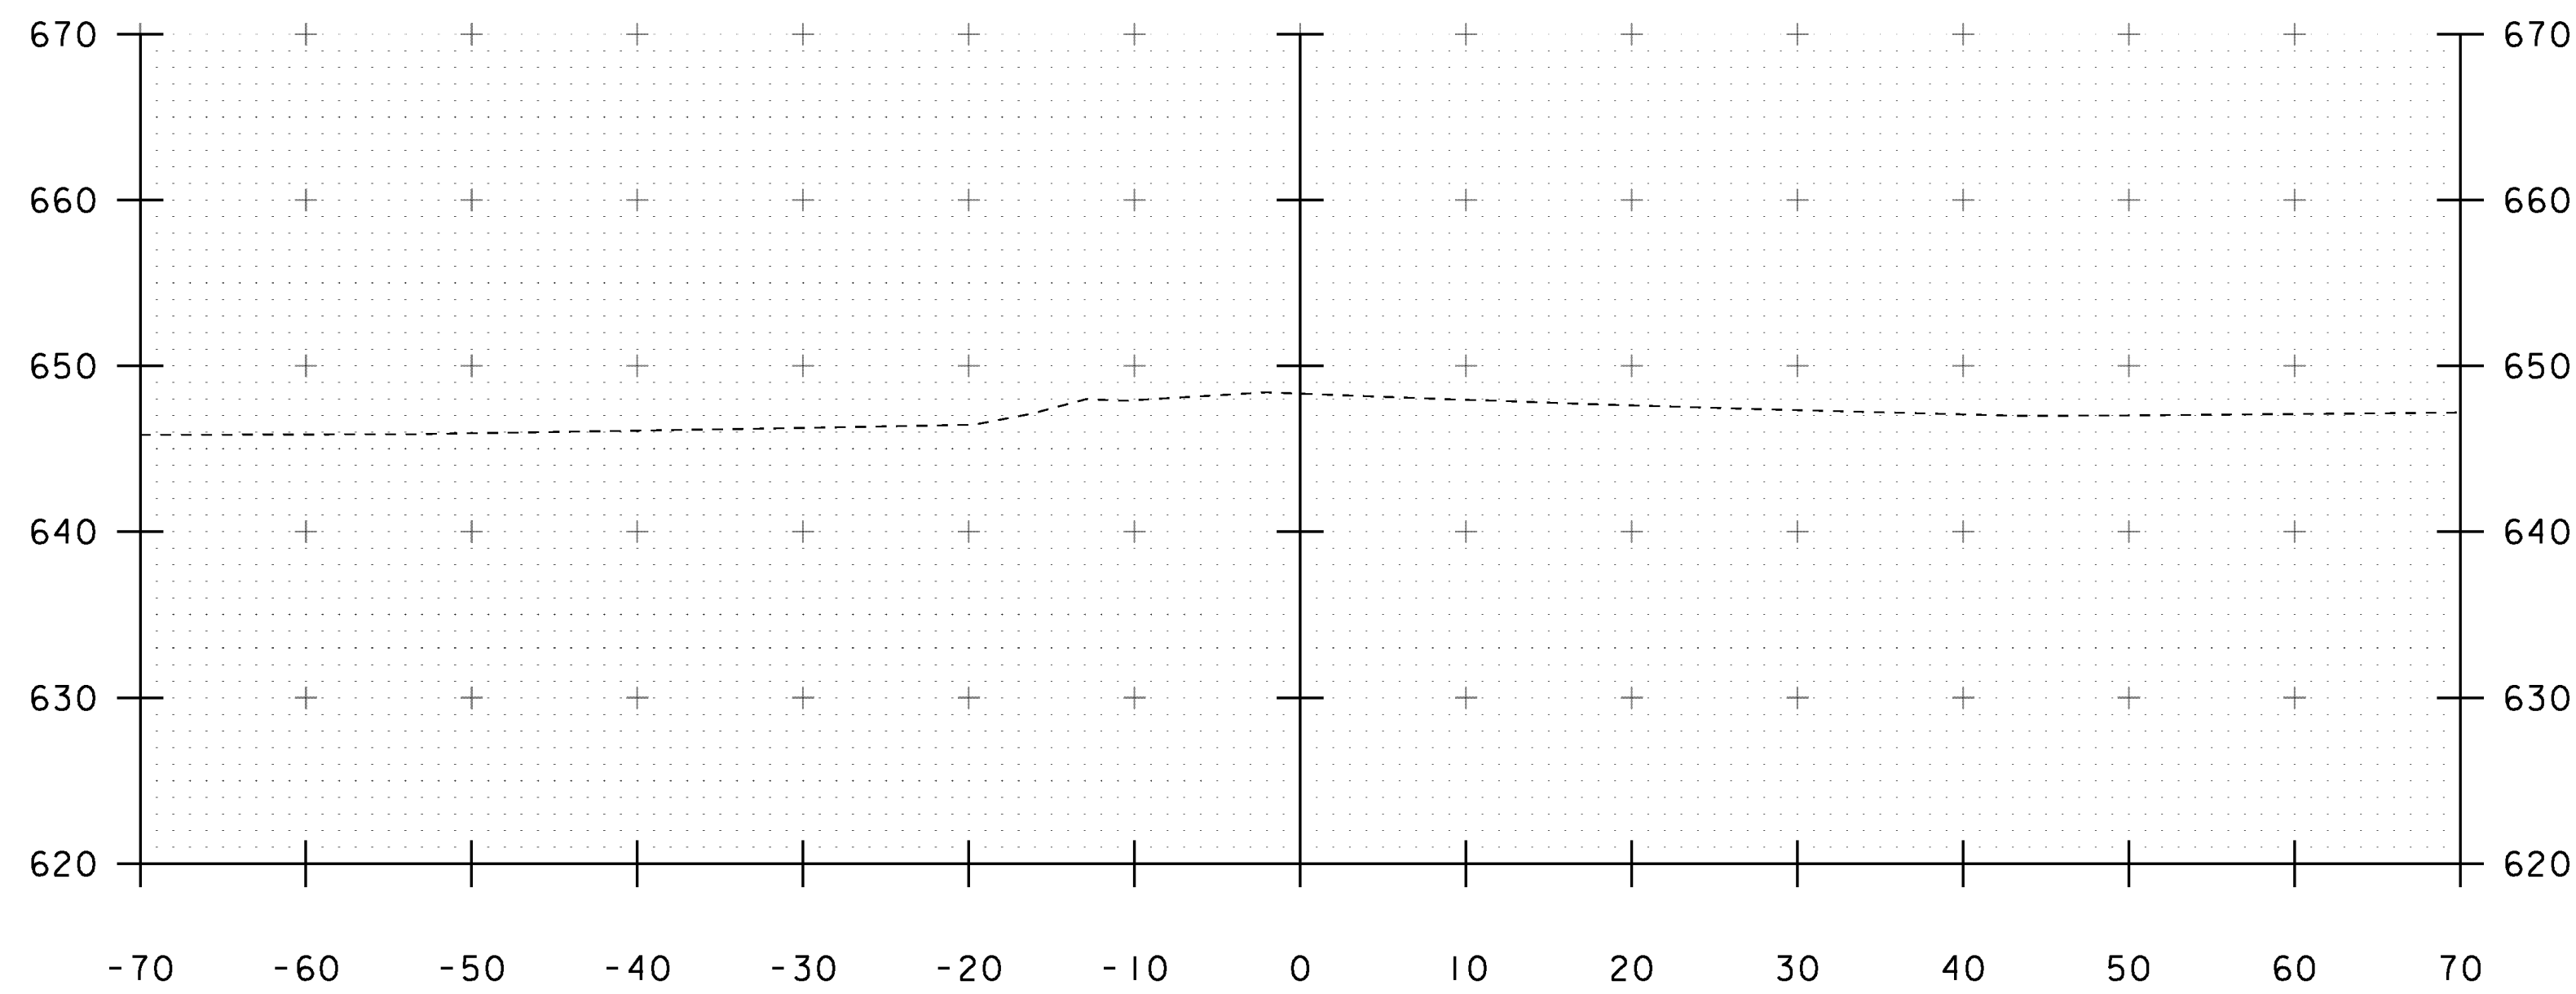

21+75

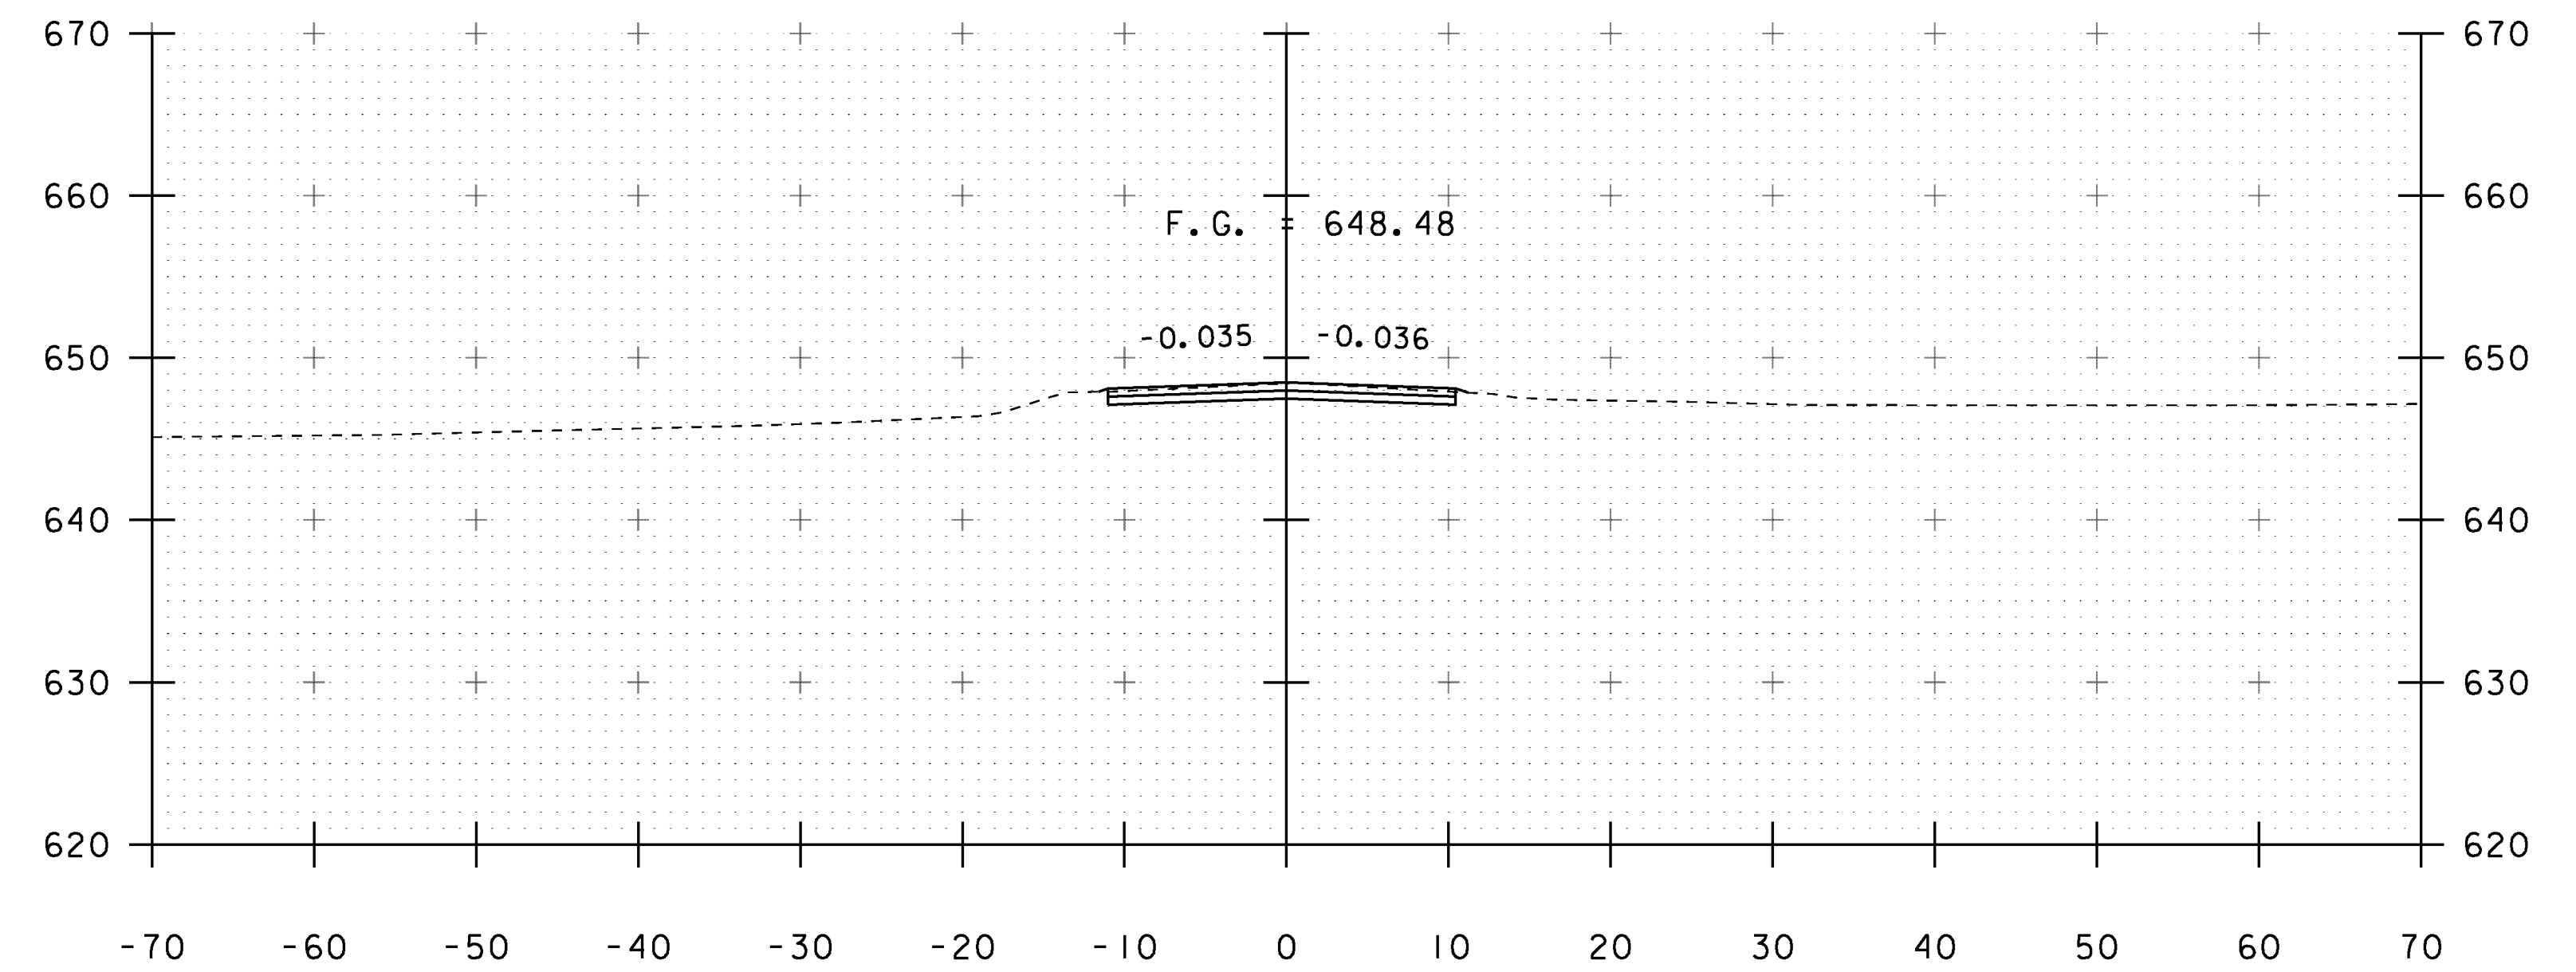


22+25

STA. 21+75 TO STA. 22+50


PROJECT NAME: CAMBRIDGE  
PROJECT NUMBER: BRO 1448(39)

FILE NAME: s12j166xs.dgn  
PROJECT LEADER: K. HIGGINS  
DESIGNED BY: G. LAROCHE  
MAINLINE SECTIONS 1


PLOT DATE: 29-AUG-2014  
DRAWN BY: G. LAROCHE  
CHECKED BY: J. SALVATORI  
SHEET 25 OF 34

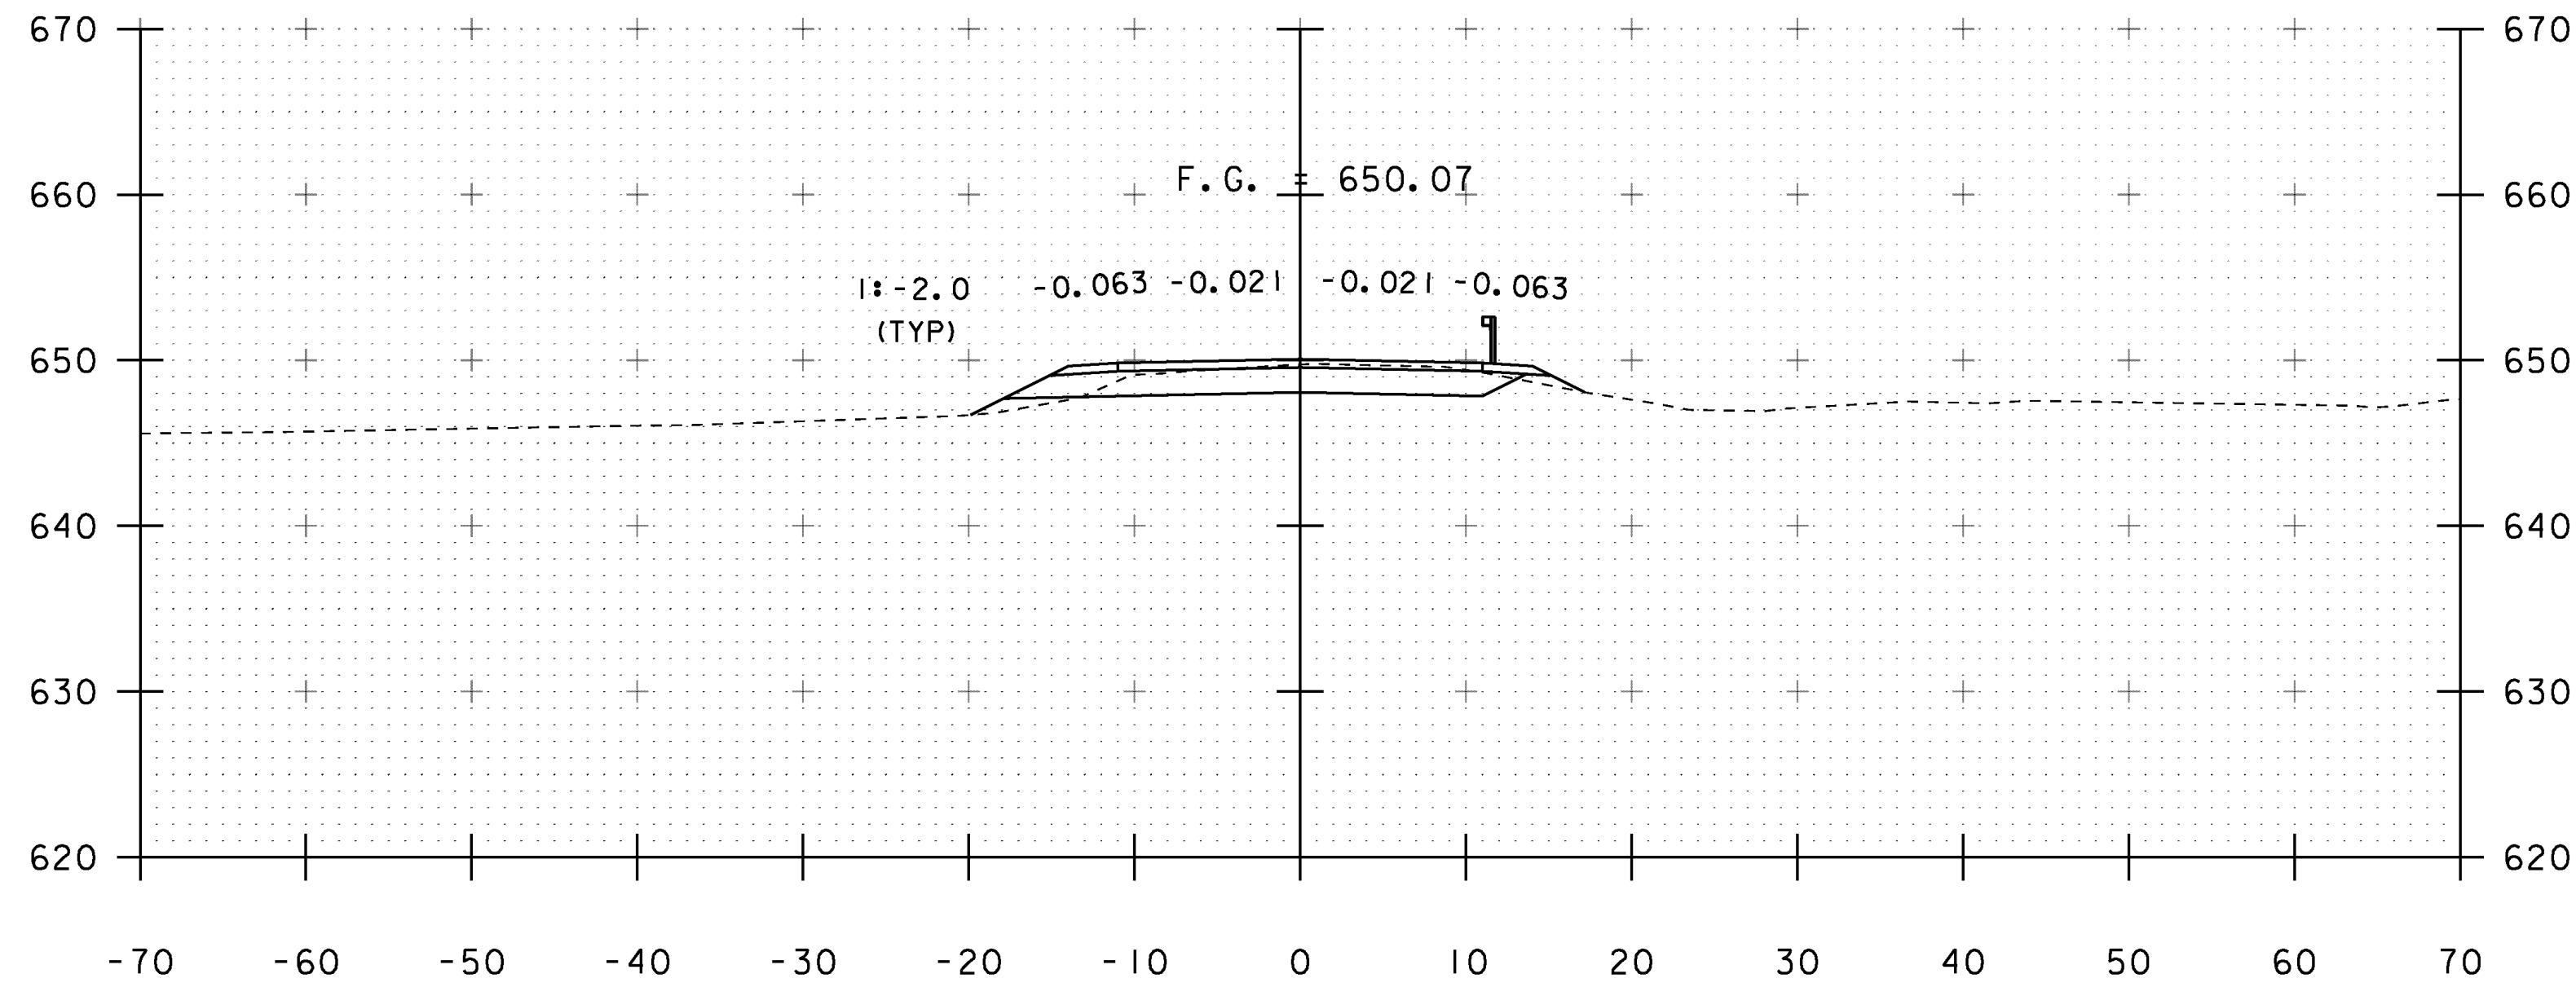


23+00  
 BEGIN PROJECT  
 BEGIN PAVEMENT

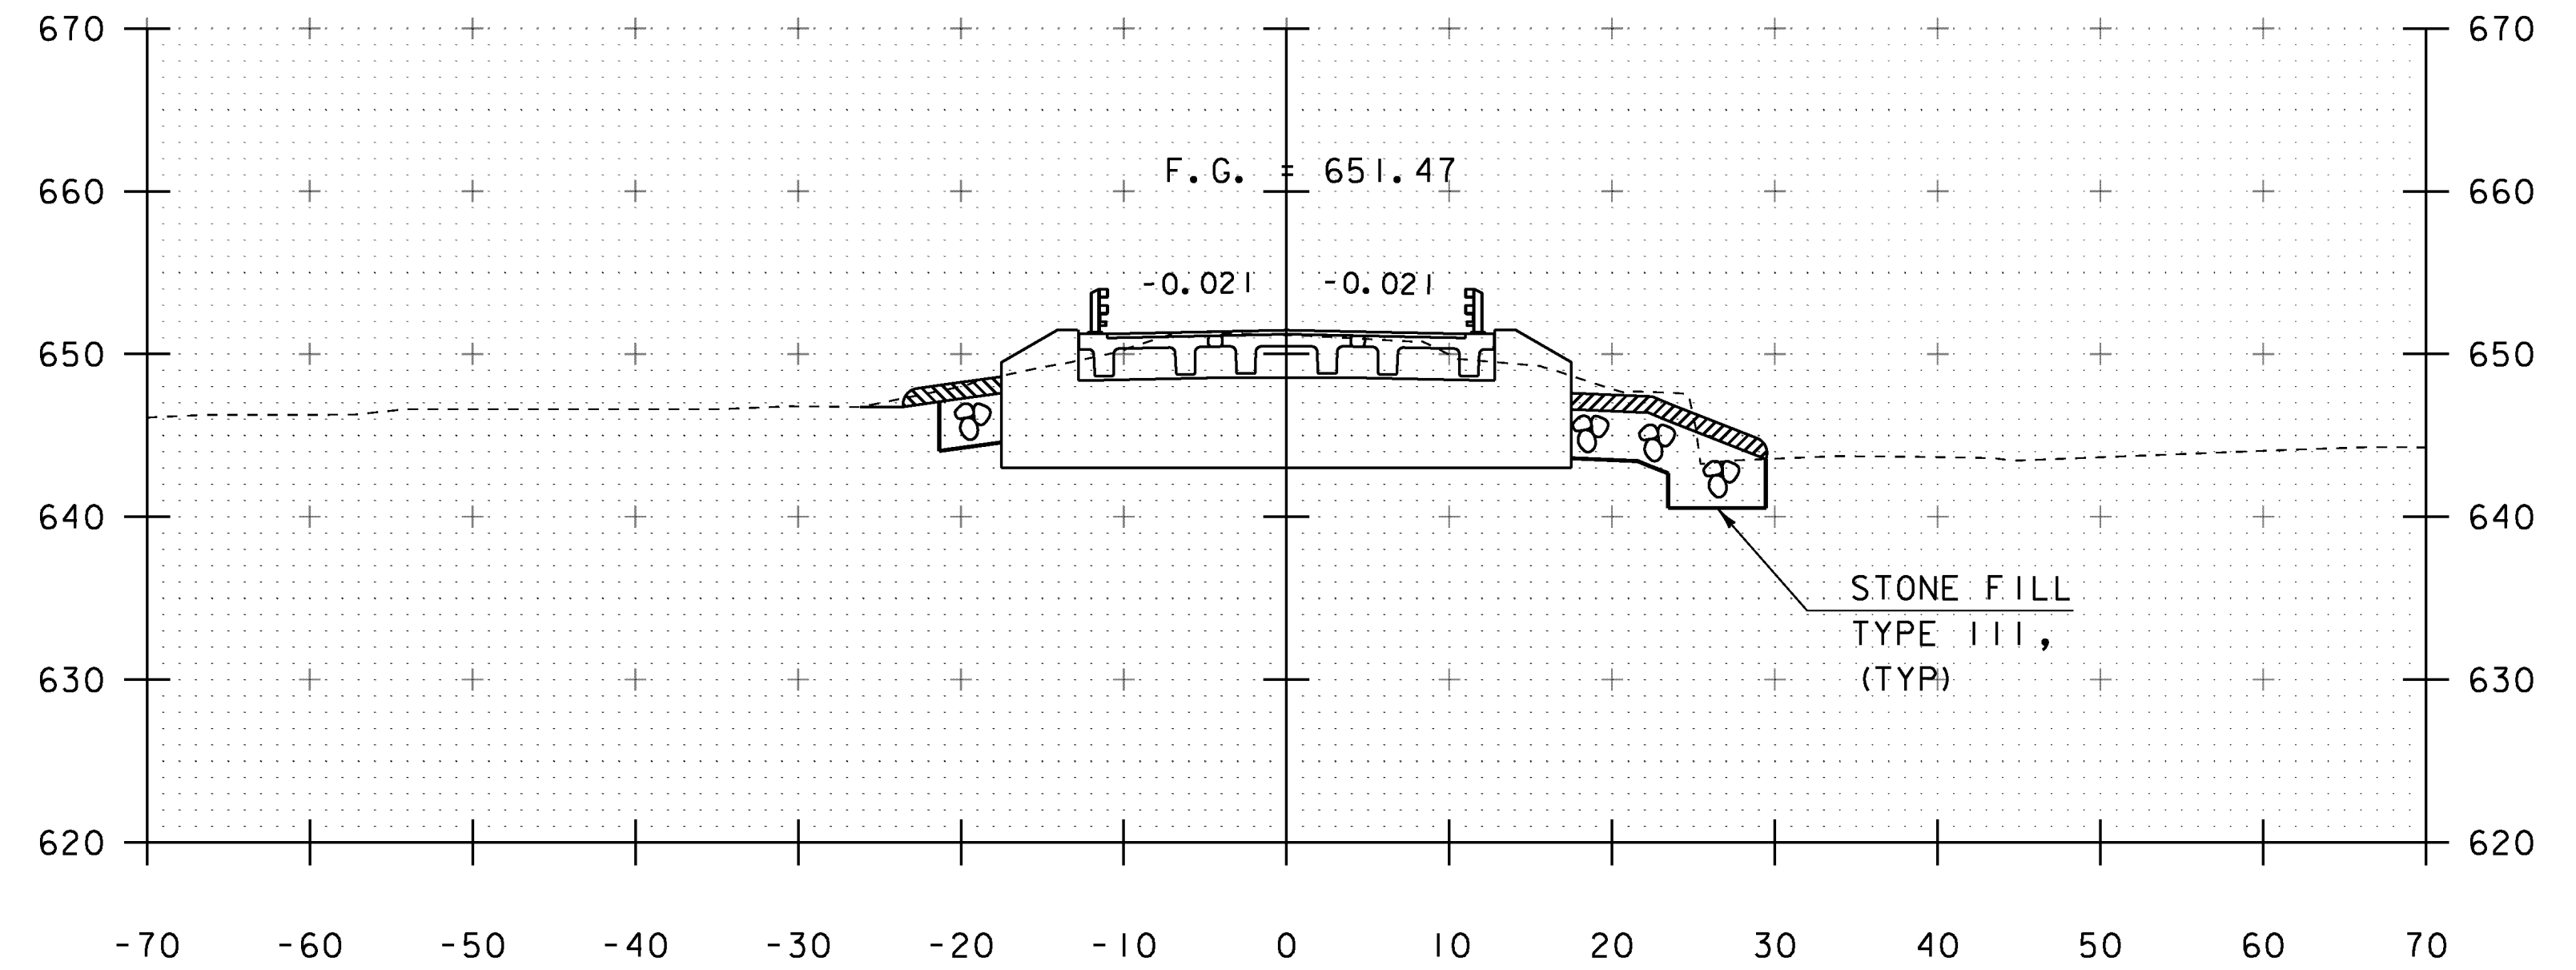

23+50  
 23+47.67 BEGIN BRIDGE

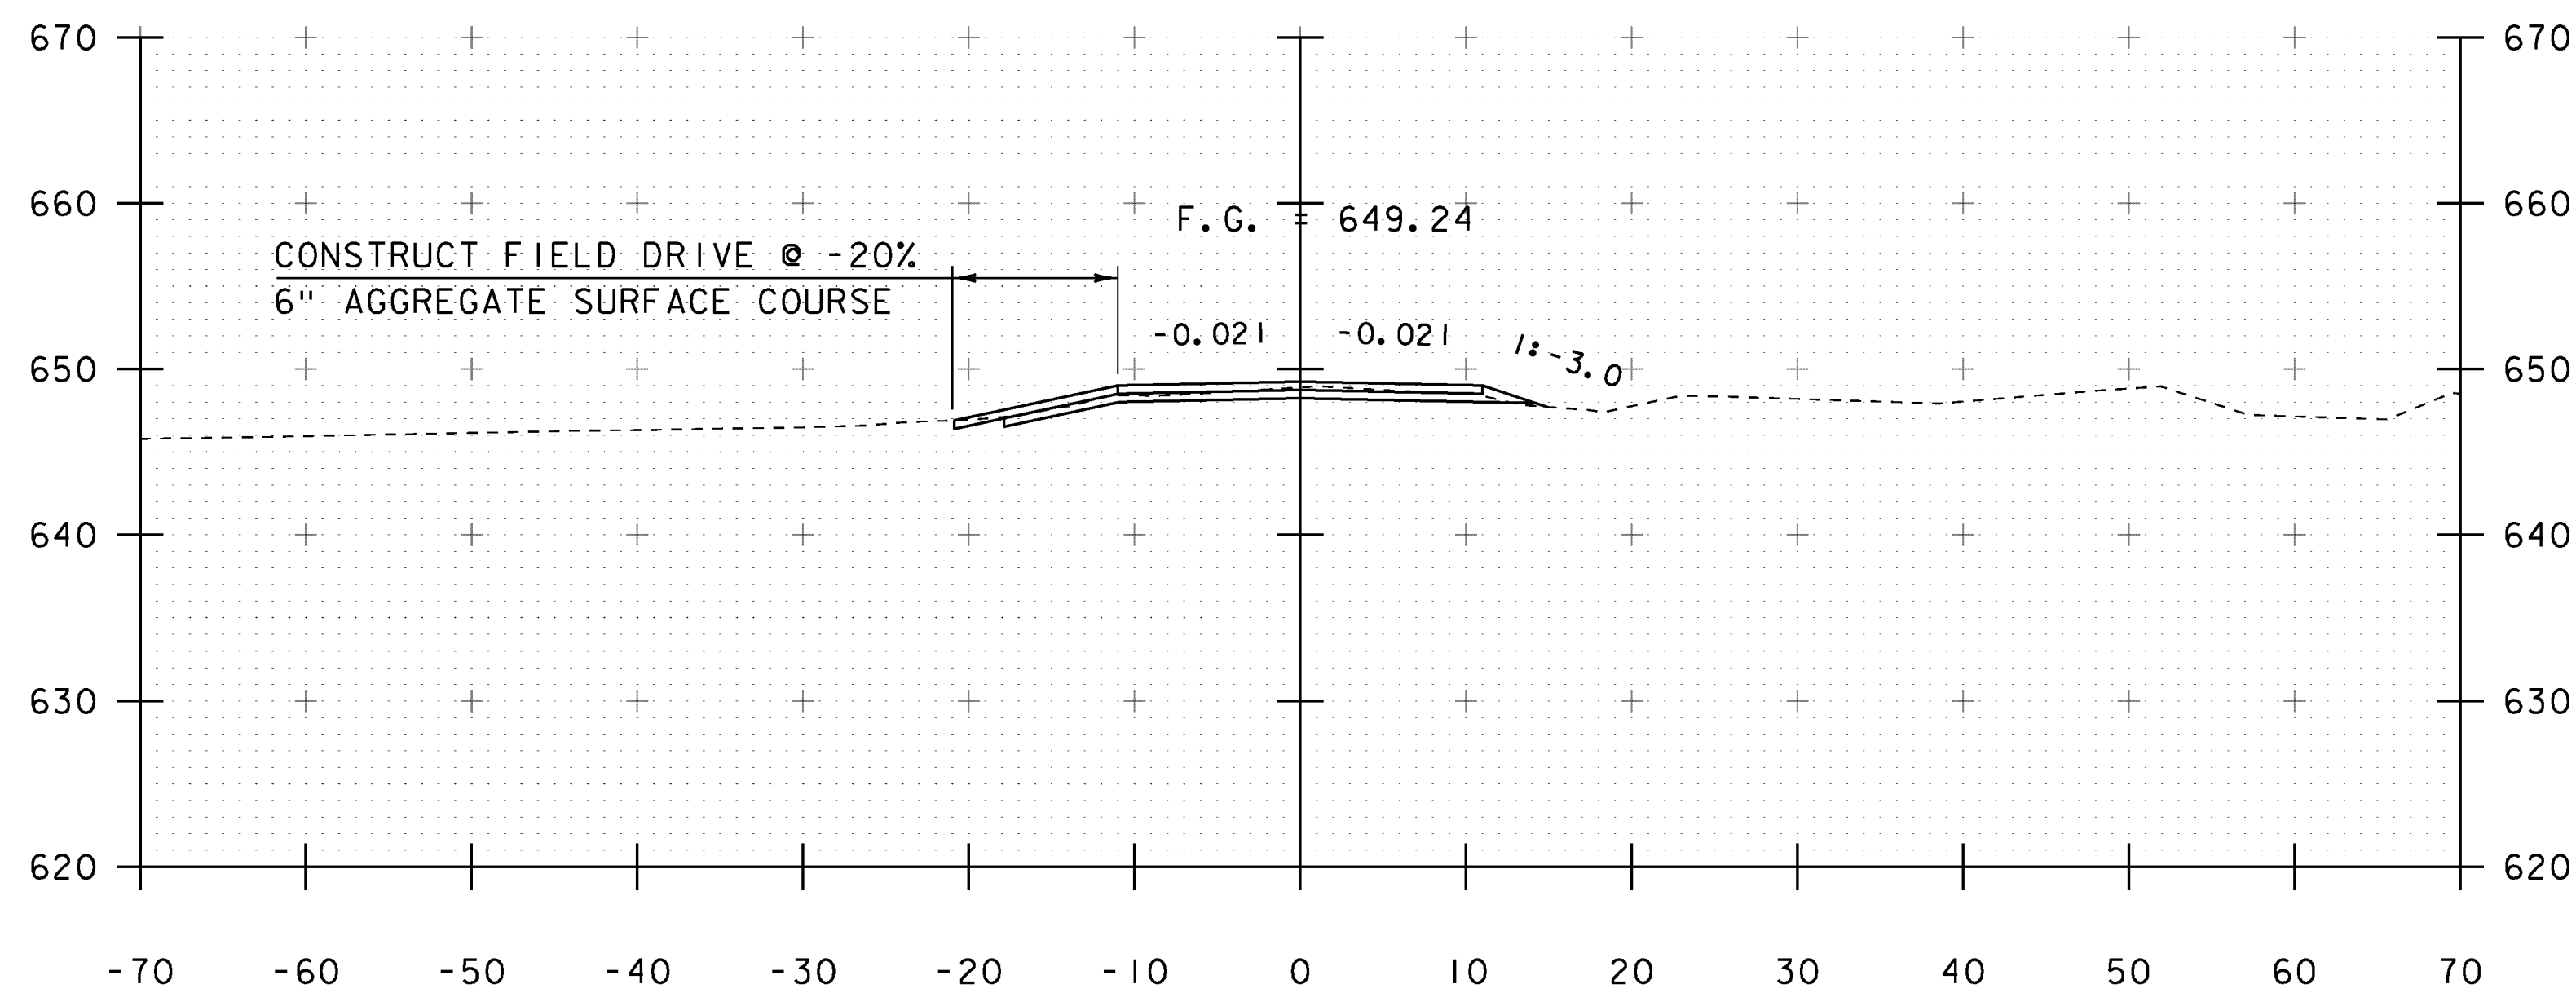


22+75

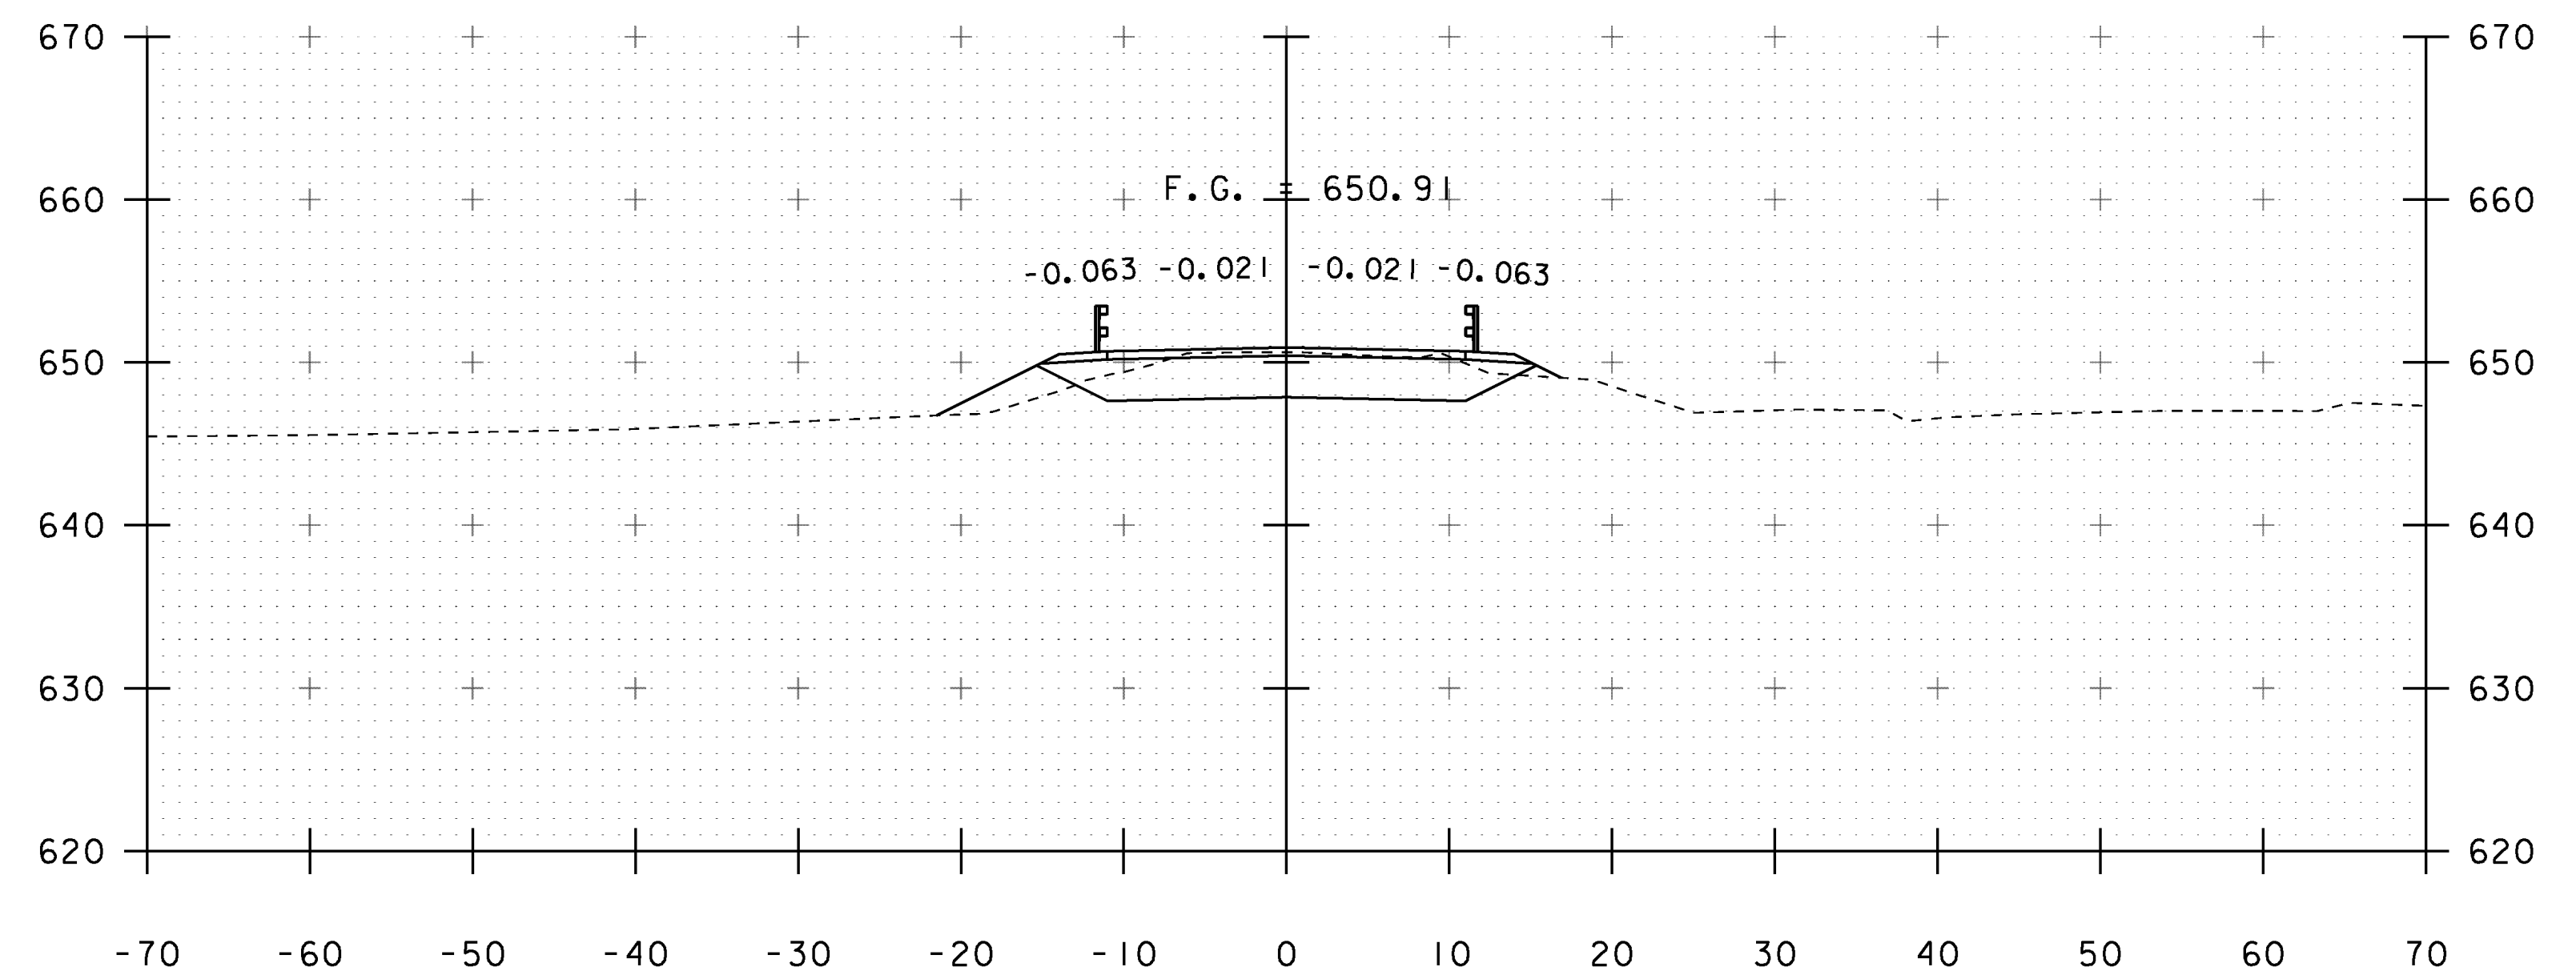


23+25

STA. 22+75 TO STA. 23+50


PROJECT NAME: CAMBRIDGE	PLOT DATE: 29-AUG-2014
PROJECT NUMBER: BRO 1448(39)	DRAWN BY: G. LAROCHE
FILE NAME: s12j166xs.dgn	CHECKED BY: J. SALVATORI
PROJECT LEADER: K. HIGGINS	SHEET 26 OF 34
DESIGNED BY: G. LAROCHE	
MAINLINE SECTIONS 2	

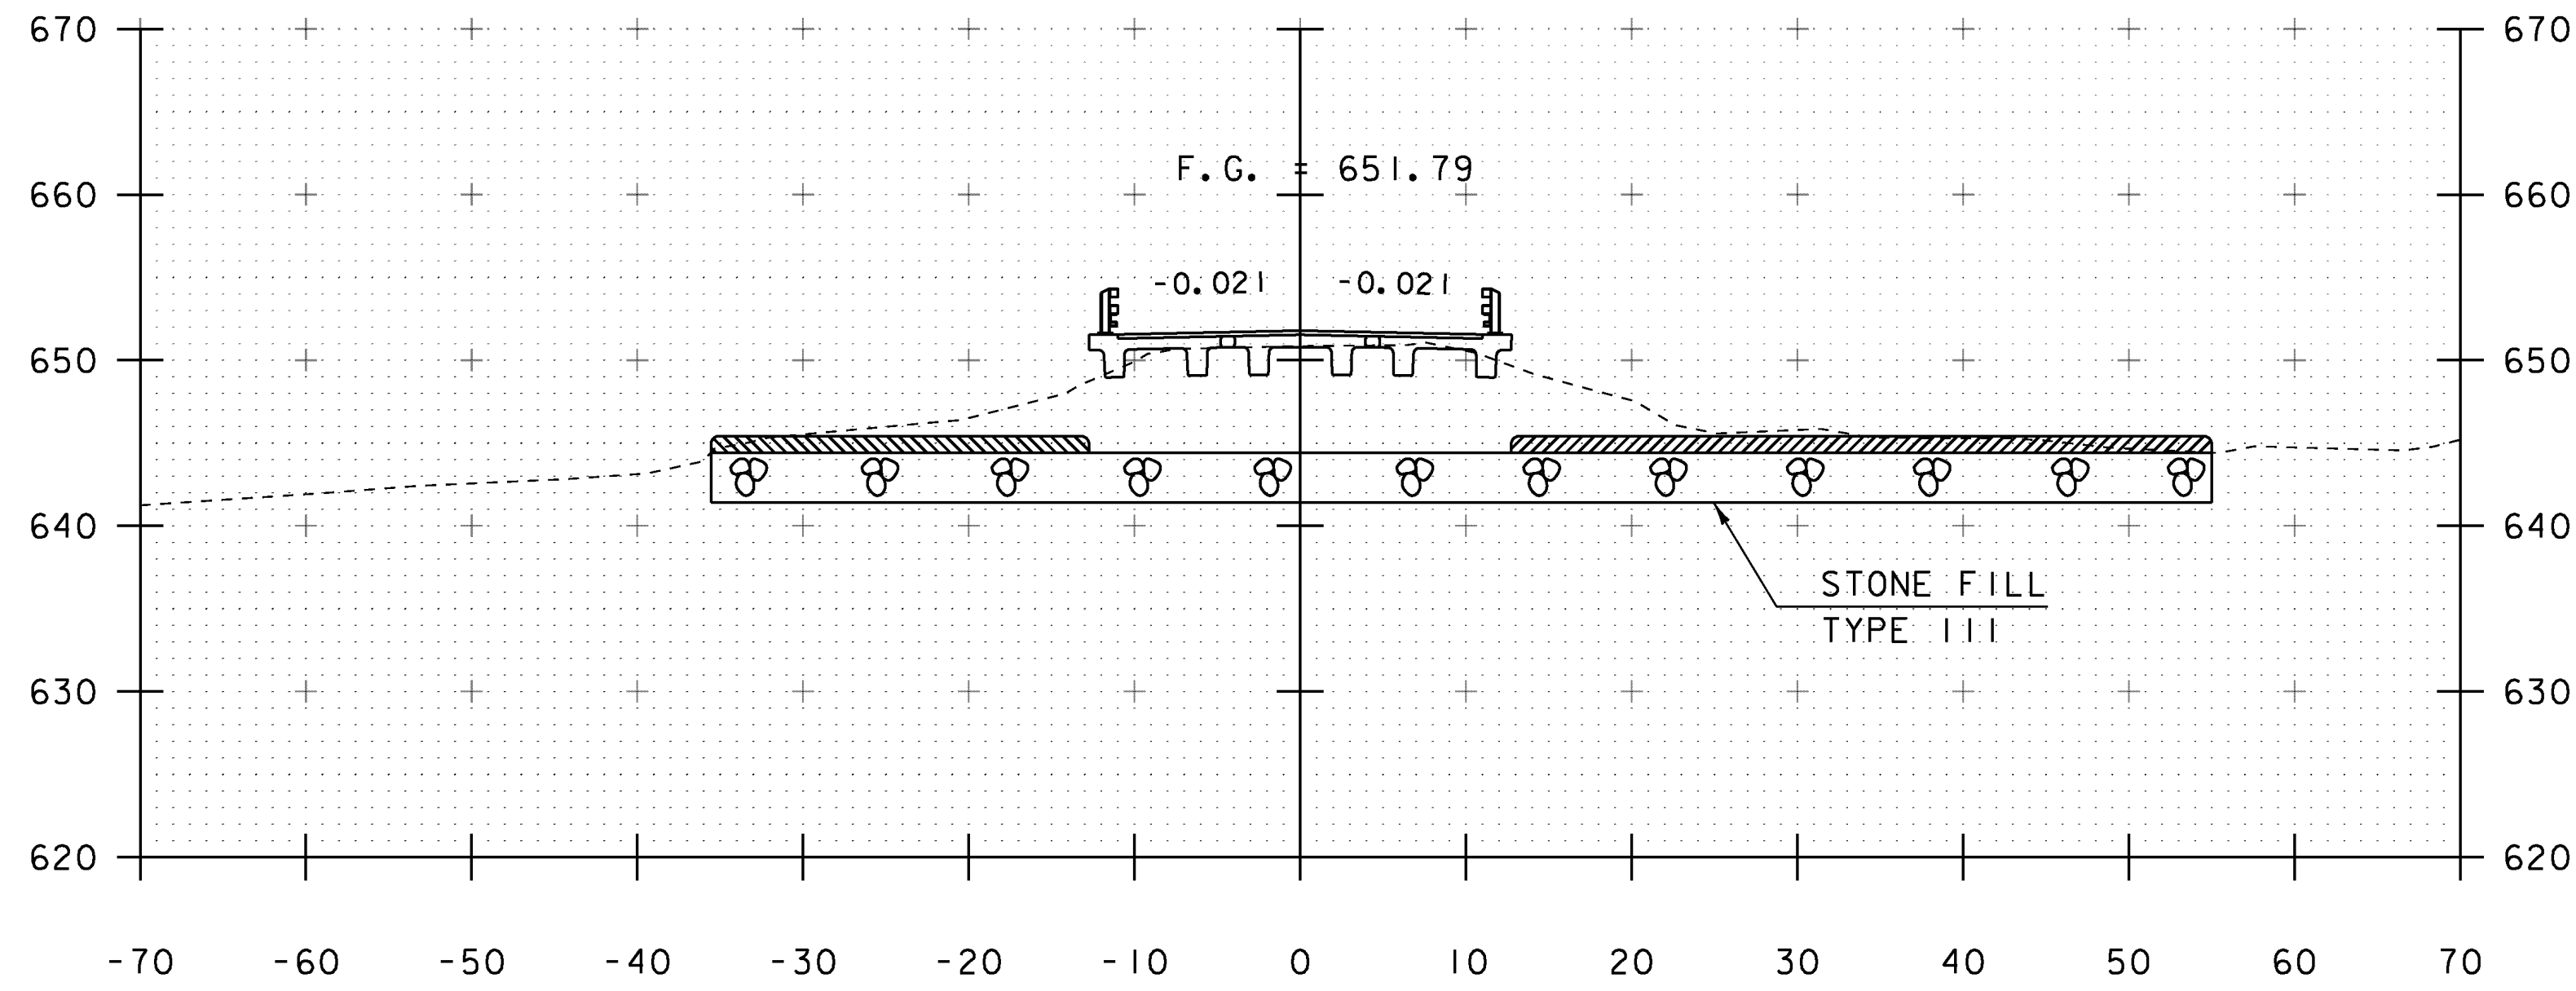


24+00  
24+08.33 END BRIDGE

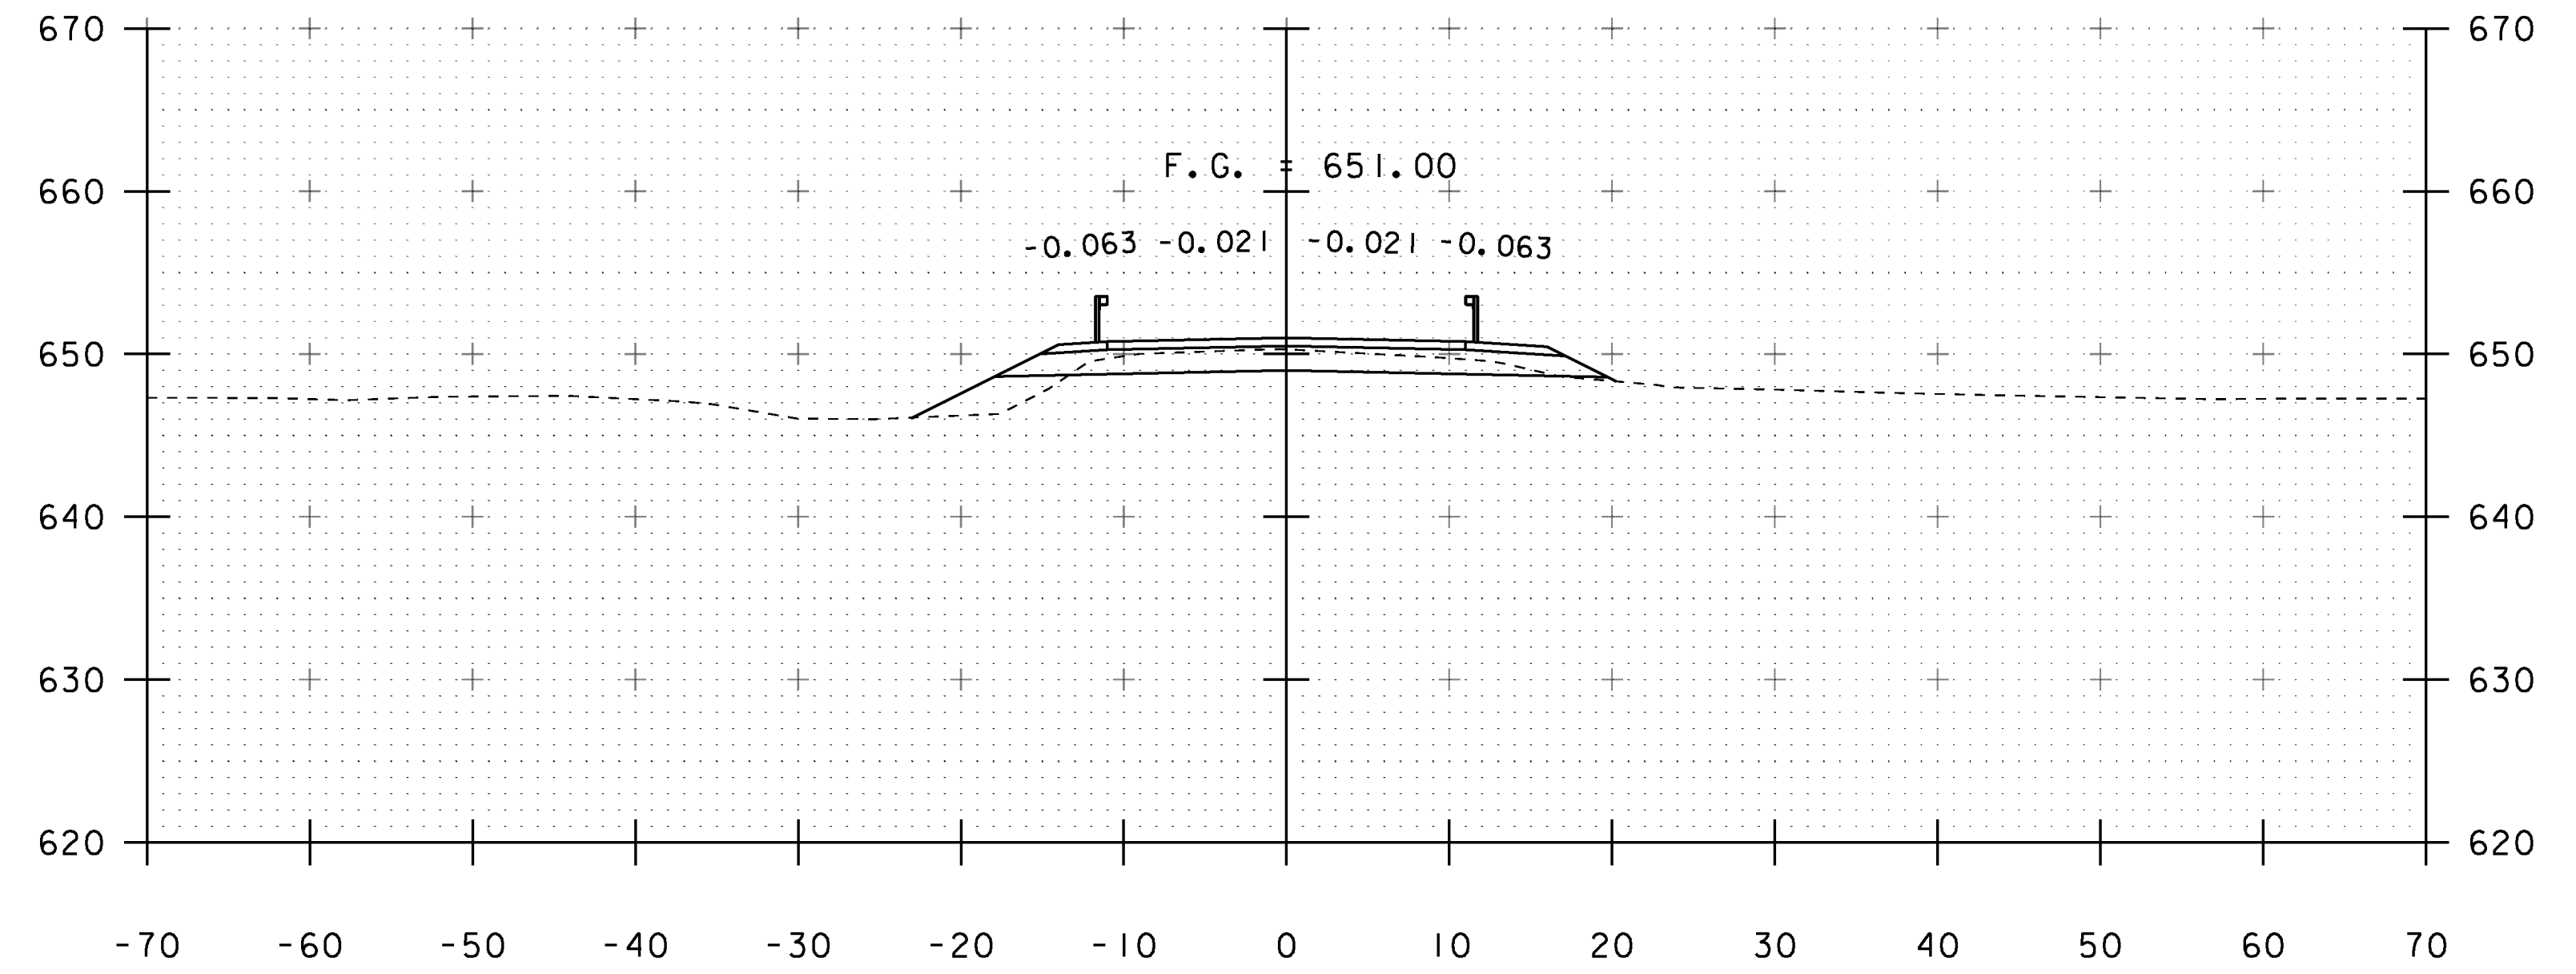

24+50  
END PROJECT  
END PAVEMENT

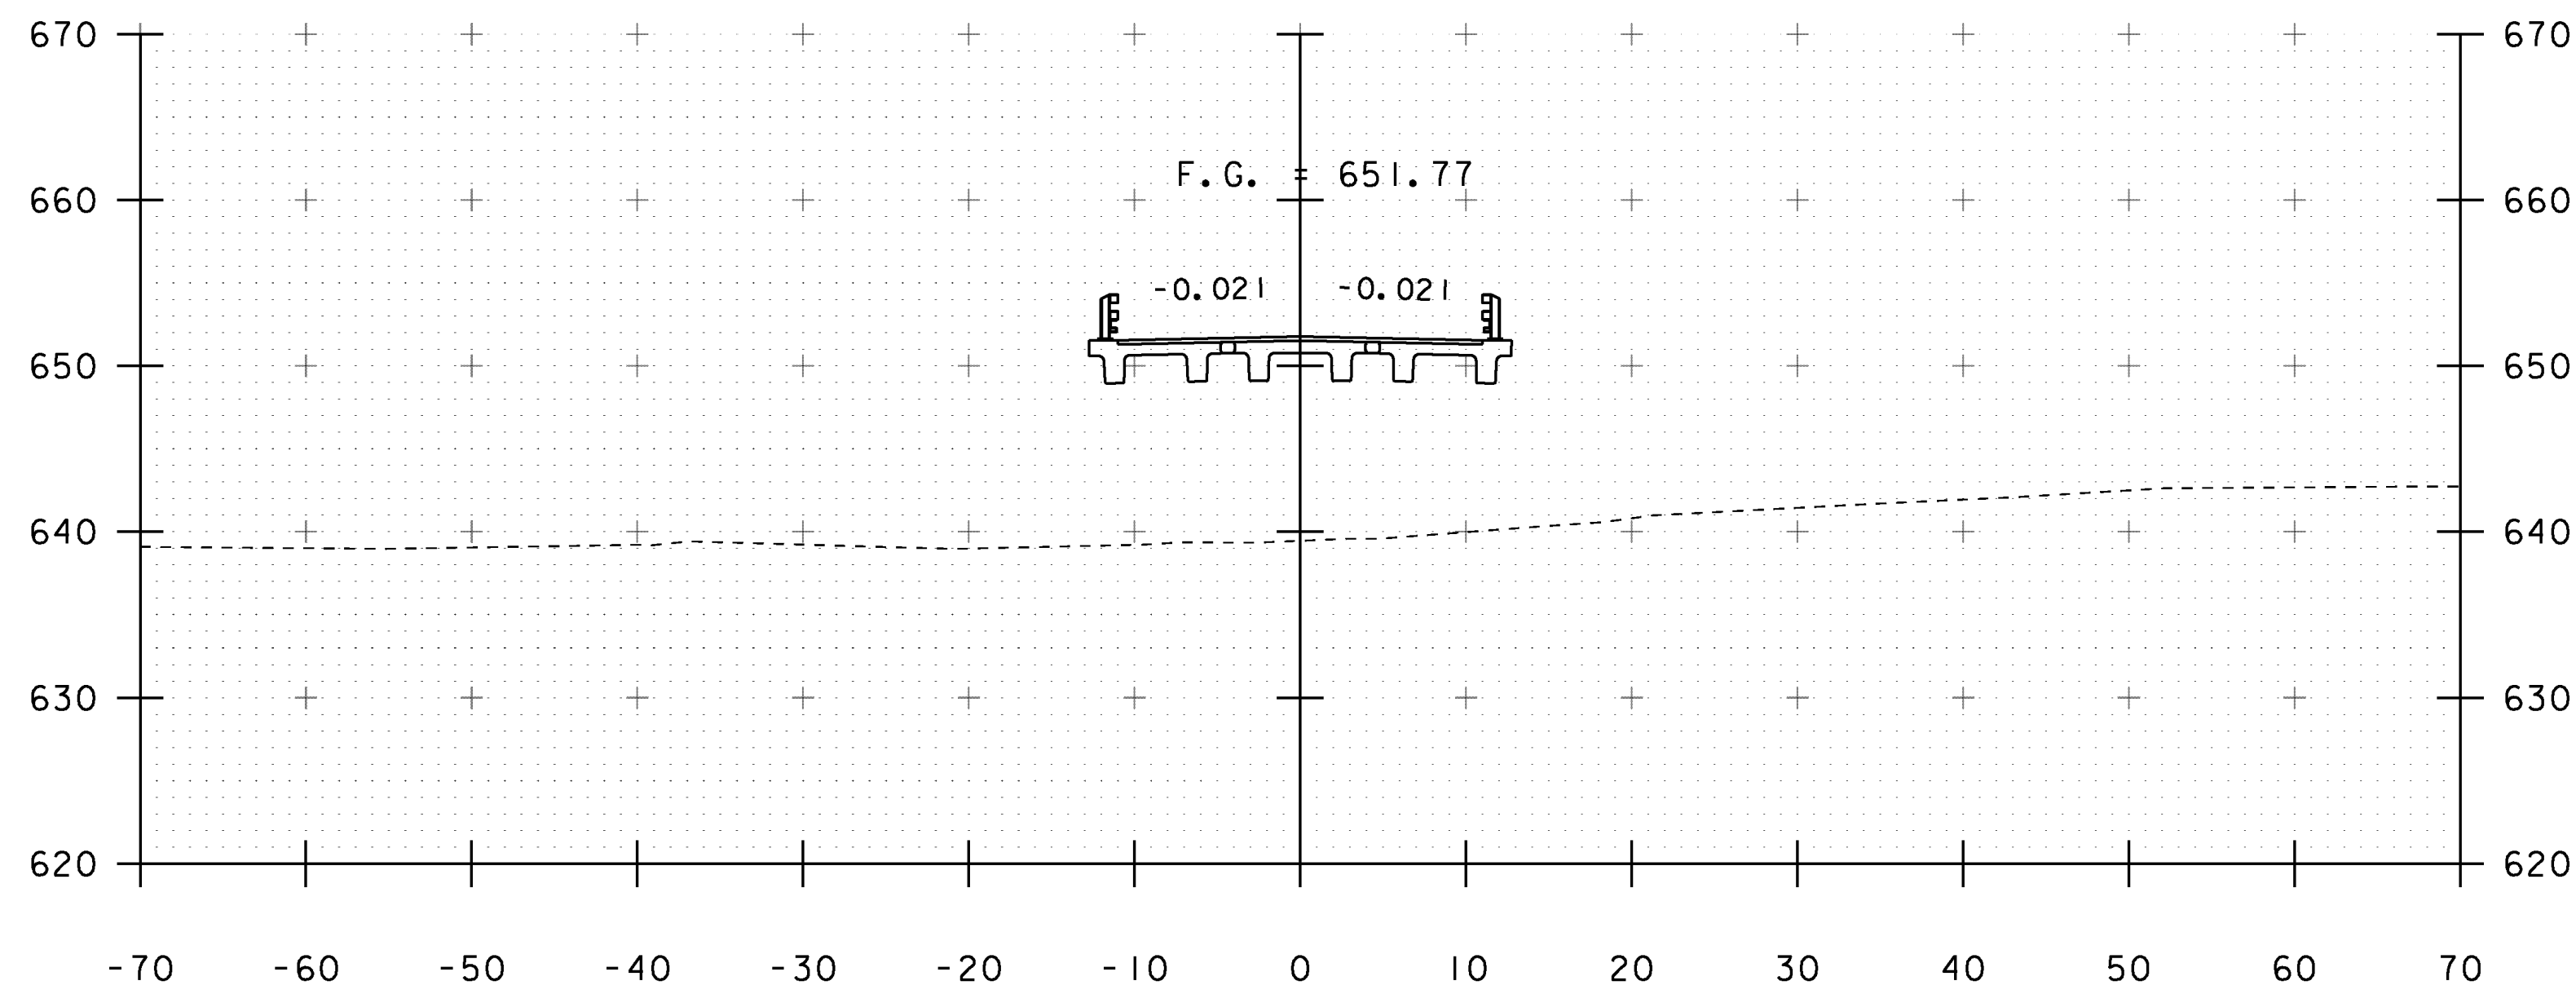


23+75

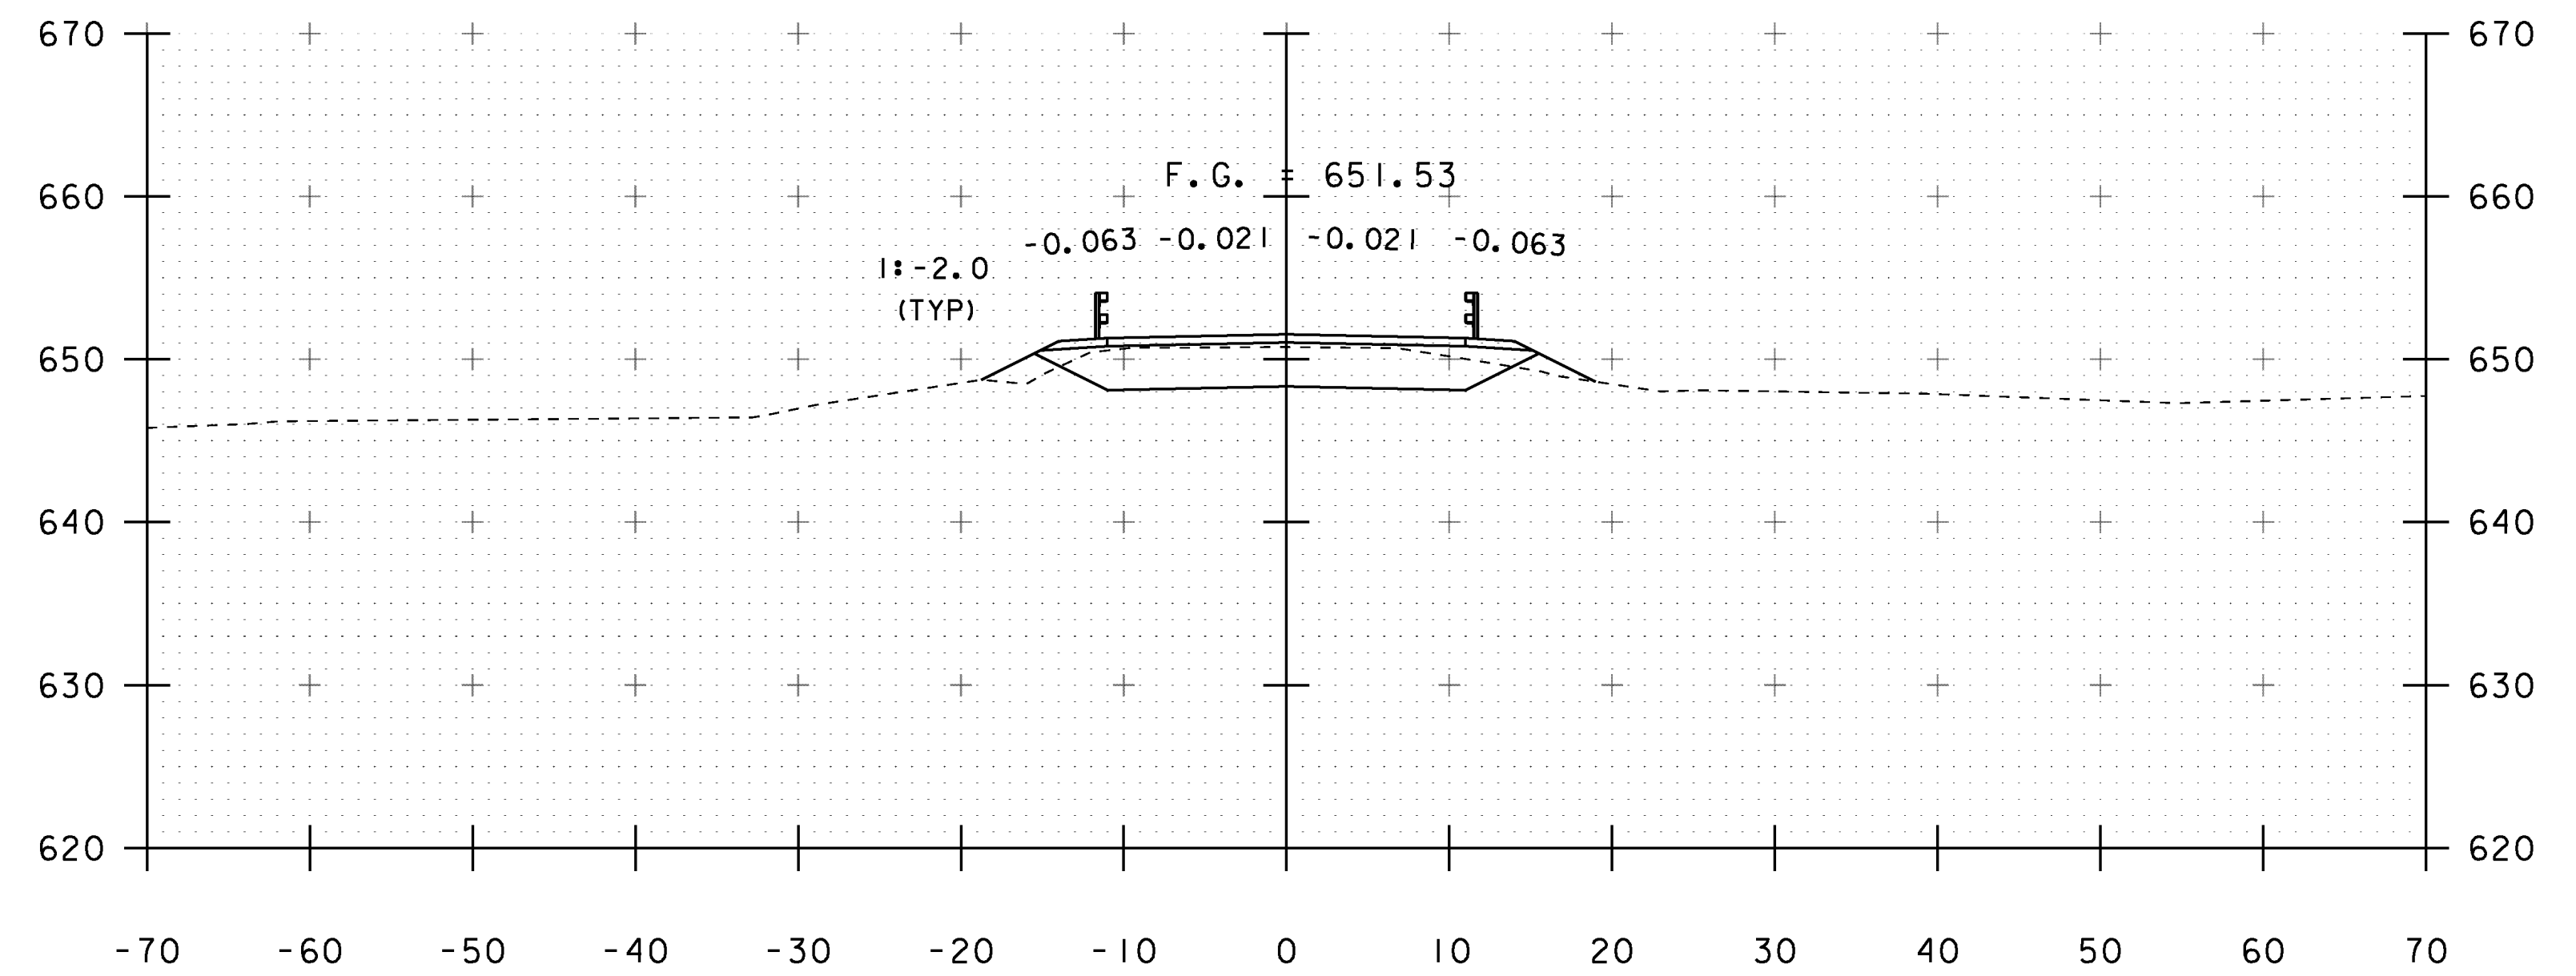


24+25

STA. 23+75 TO STA. 24+50


PROJECT NAME: CAMBRIDGE	PLOT DATE: 29-AUG-2014
PROJECT NUMBER: BRO 1448(39)	DRAWN BY: G. LAROCHE
FILE NAME: s12j166xs.dgn	CHECKED BY: J. SALVATORI
PROJECT LEADER: K. HIGGINS	SHEET 27 OF 34
DESIGNED BY: G. LAROCHE	
MAINLINE SECTIONS 3	

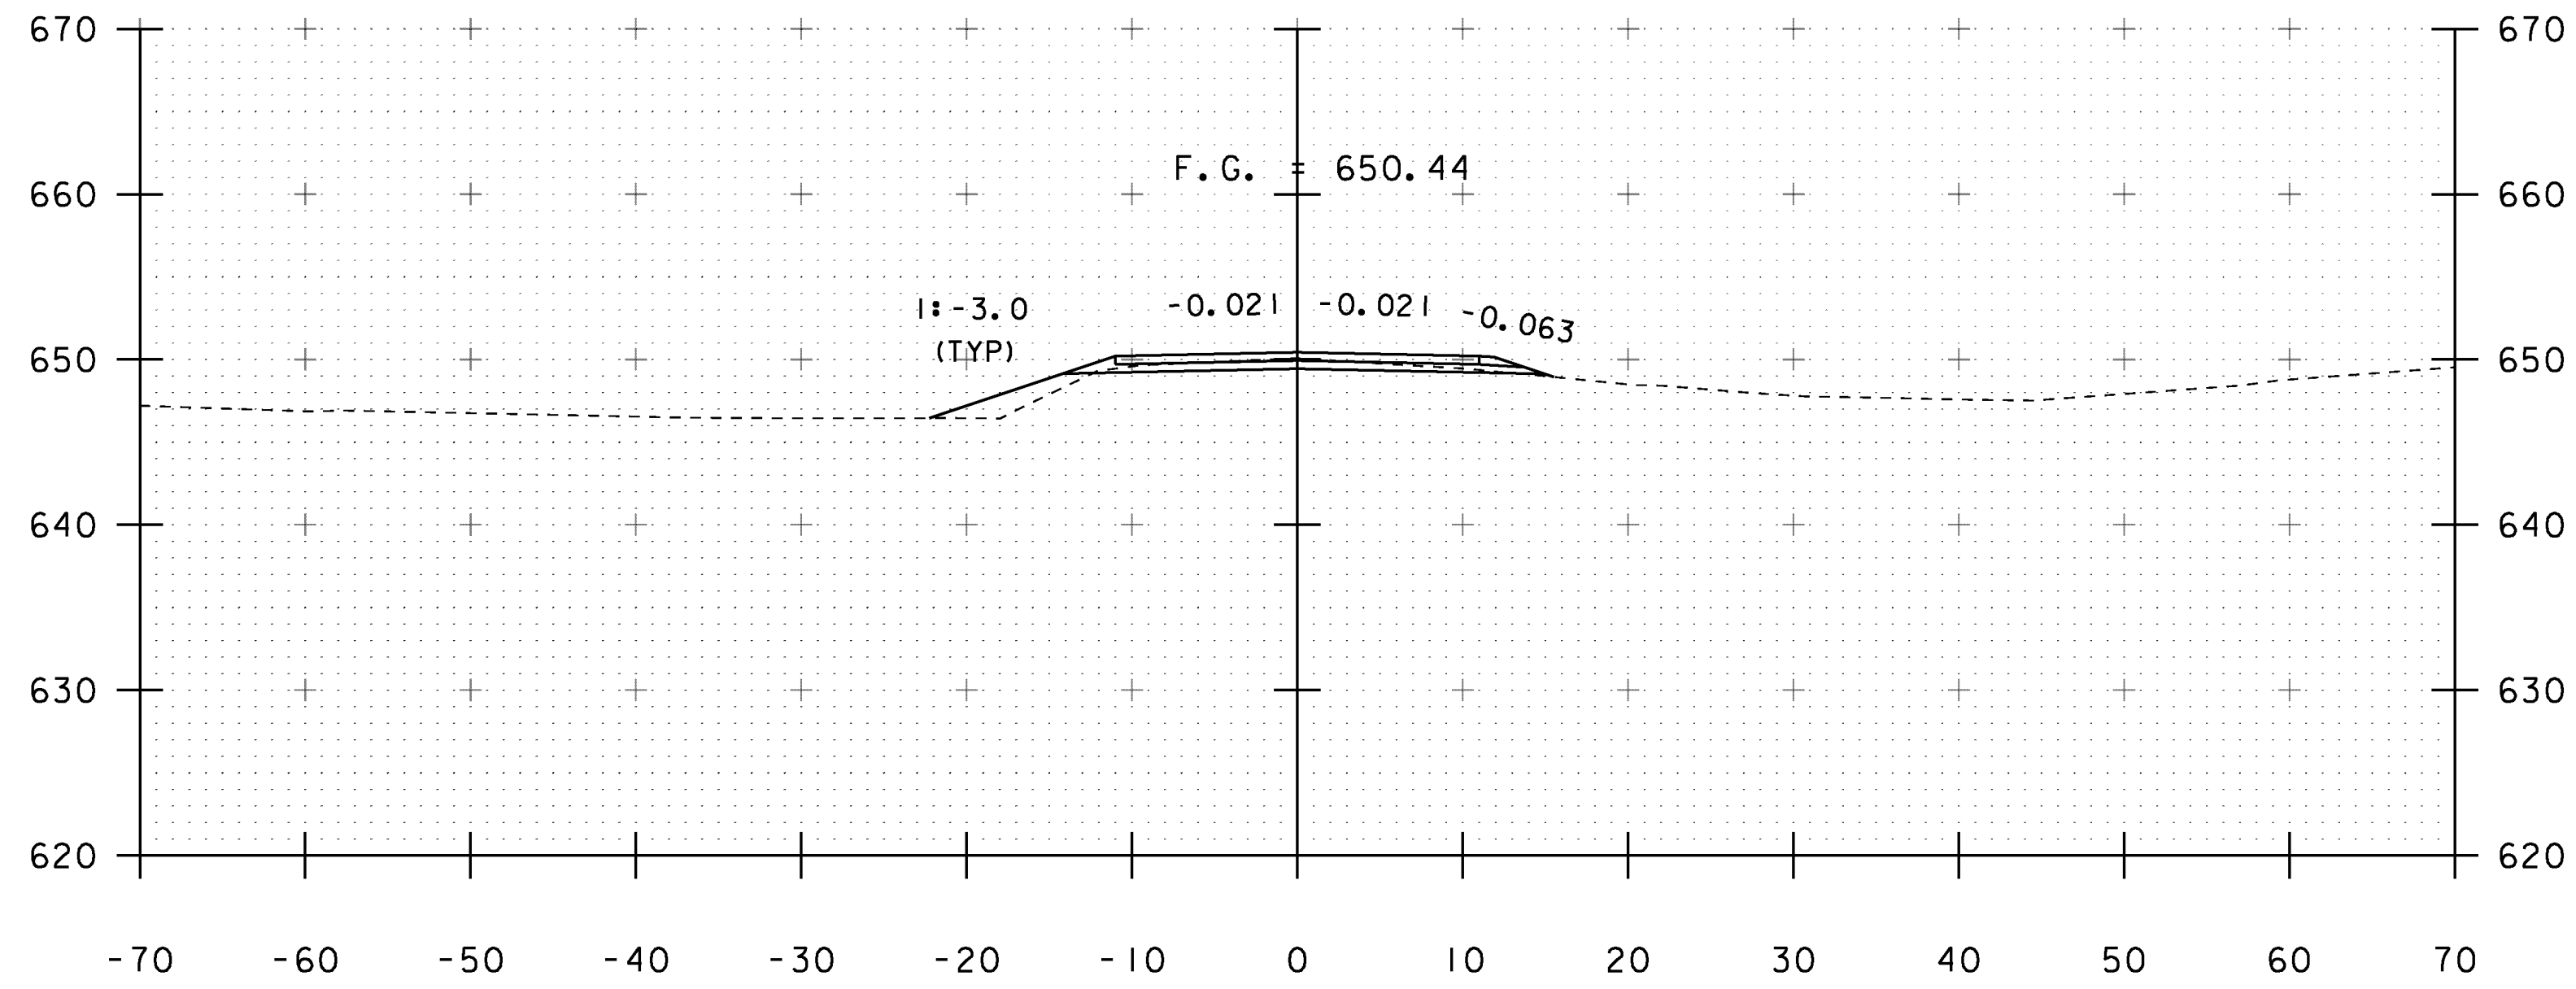


24+75

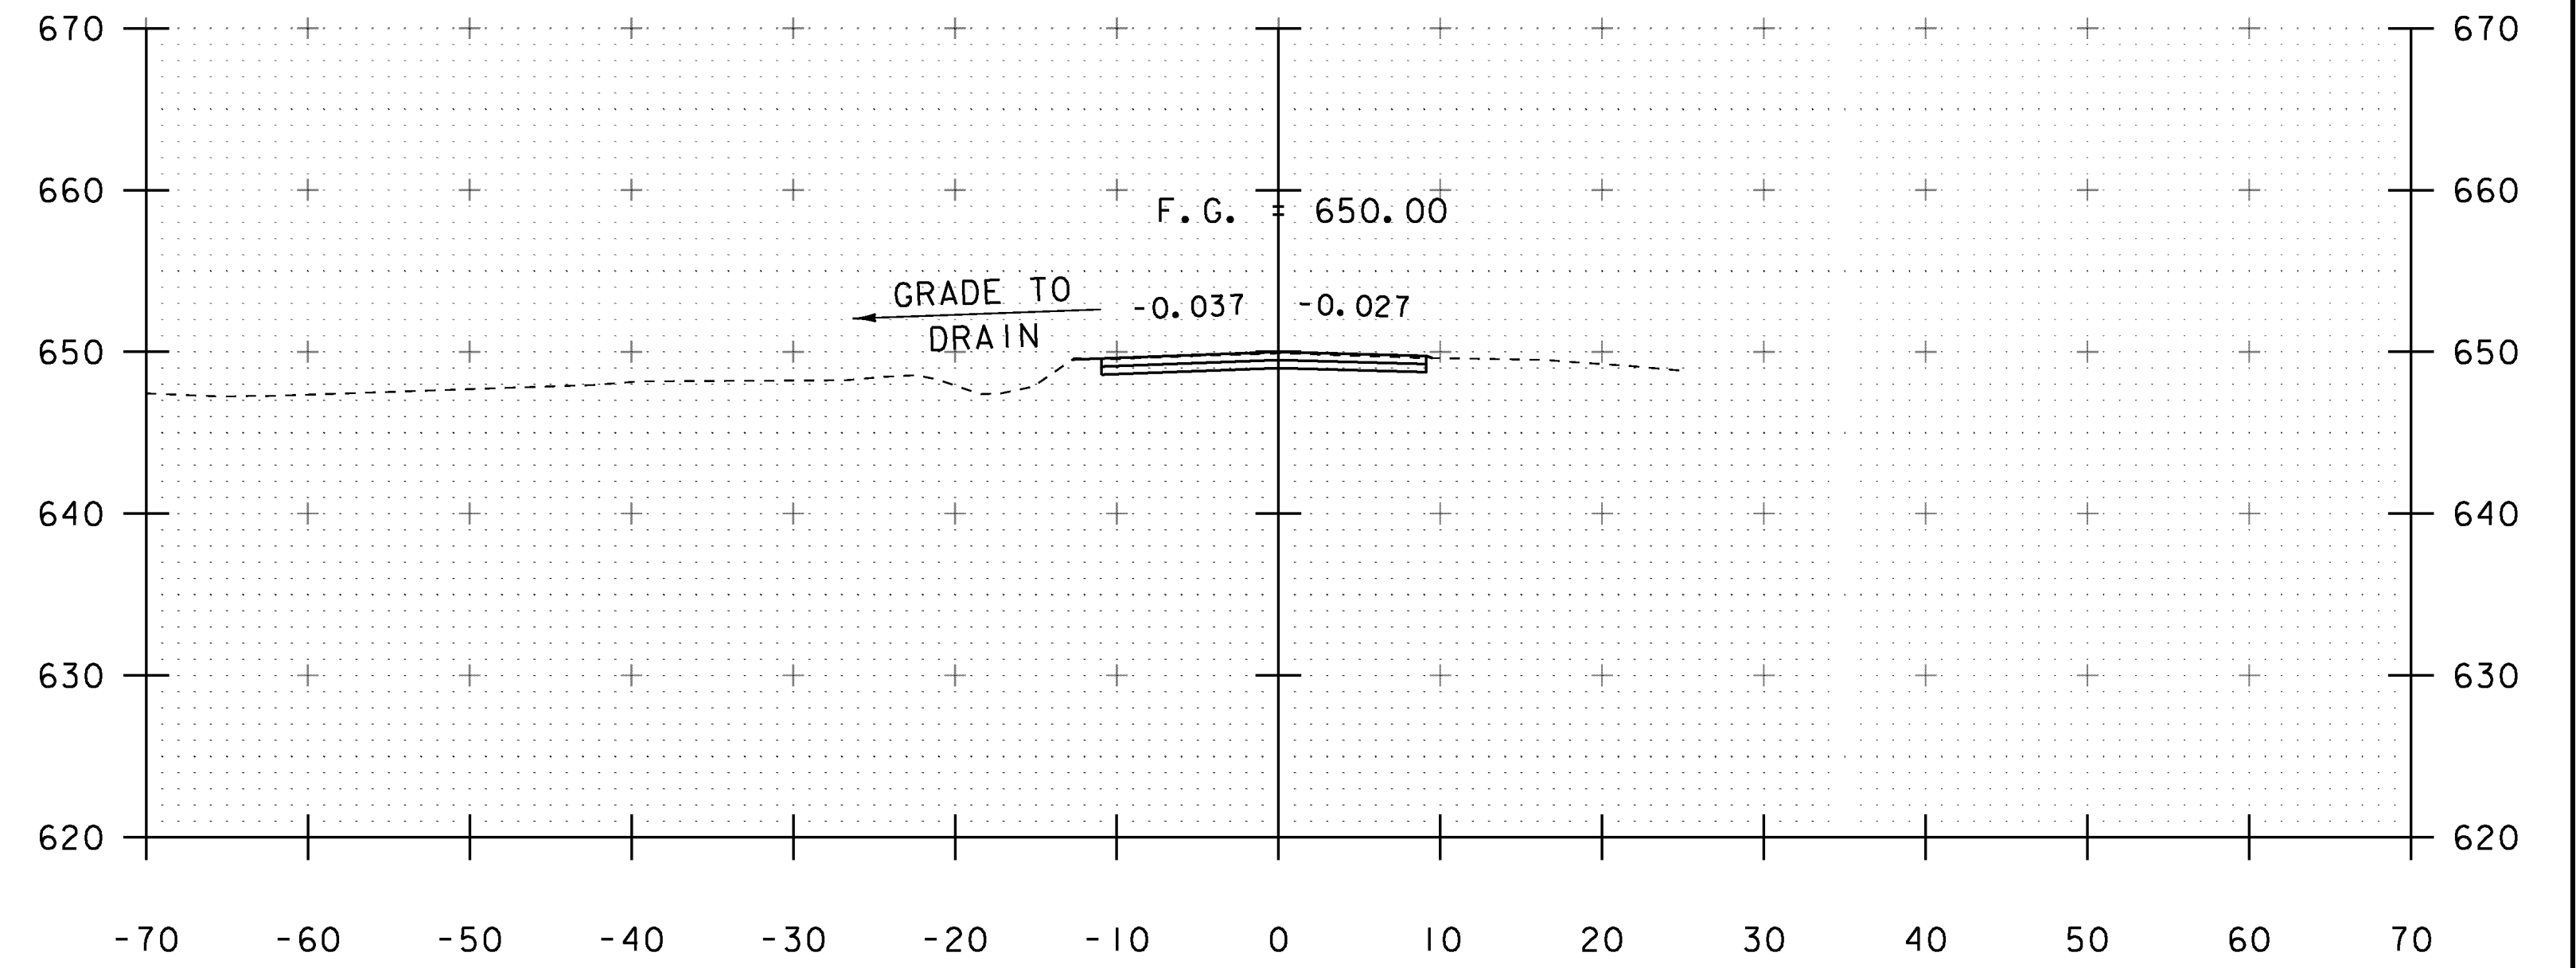

25+25

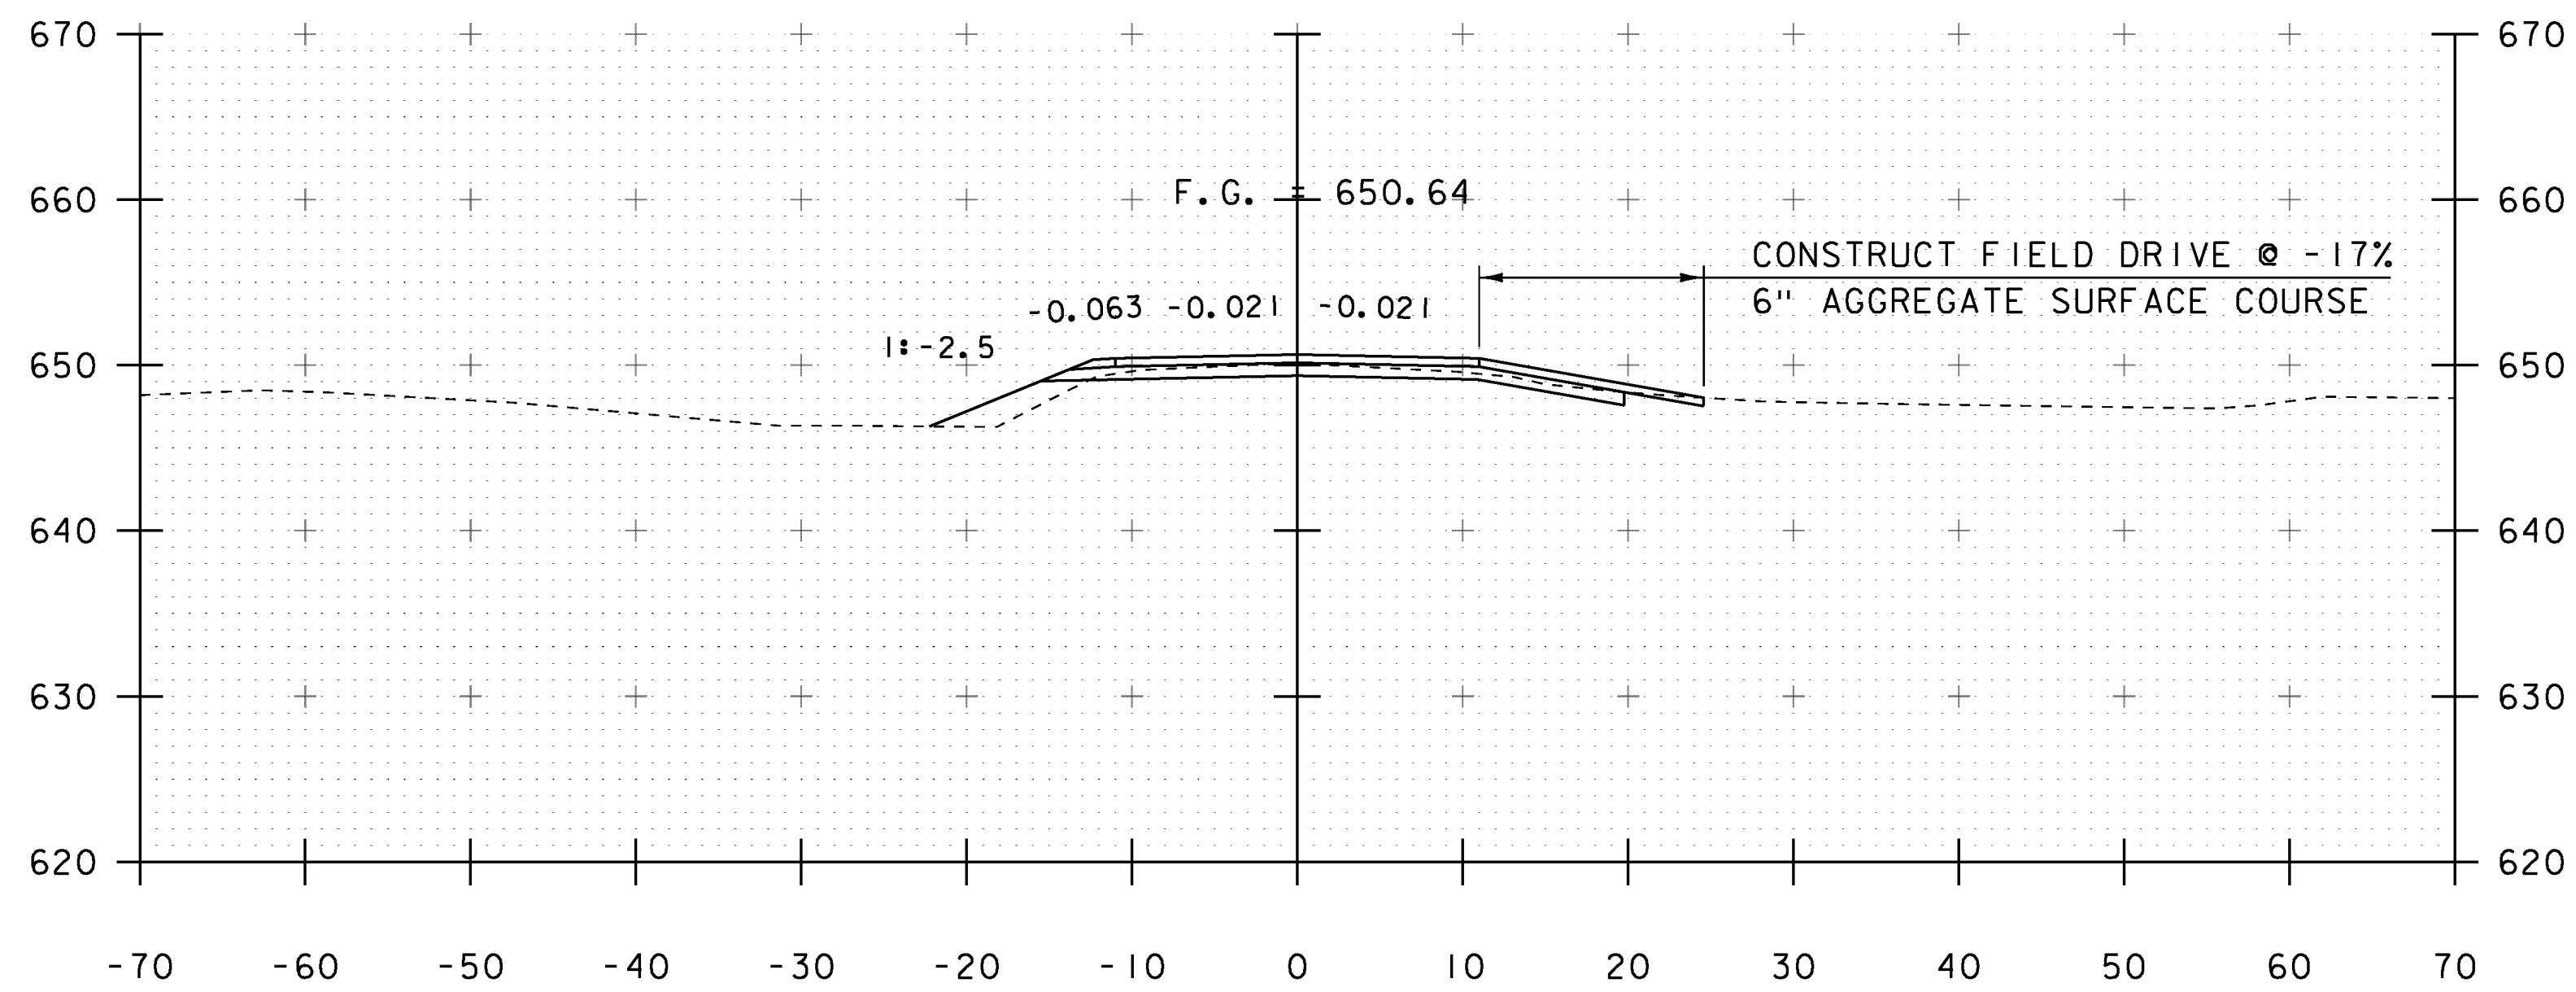


24+65

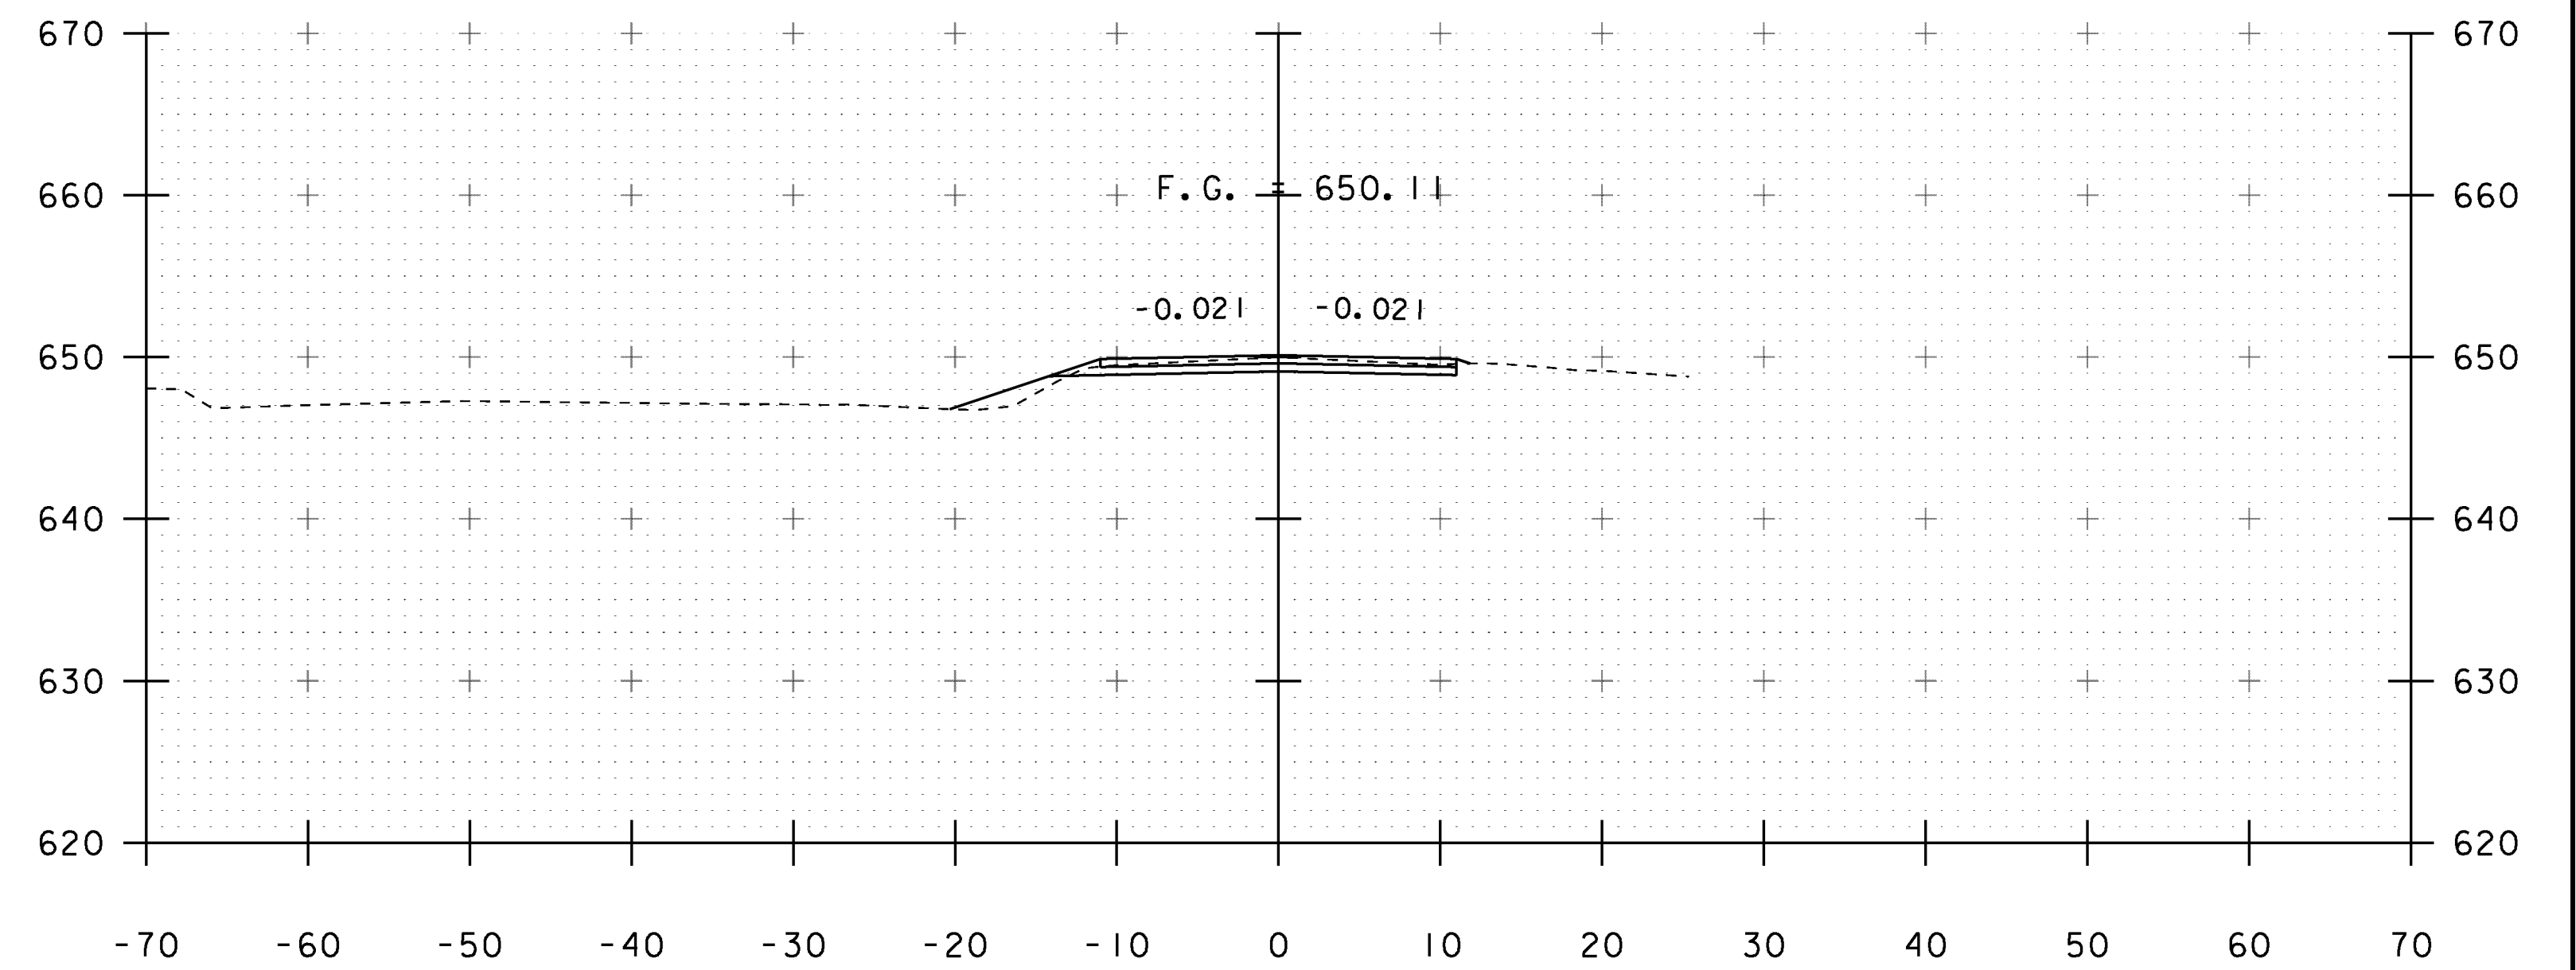


25+00

STA. 24+65 TO STA. 25+25


PROJECT NAME: CAMBRIDGE	PLOT DATE: 29-AUG-2014
PROJECT NUMBER: BRO 1448(39)	DRAWN BY: G. LAROCHE
FILE NAME: s12j166xs.dgn	CHECKED BY: J. SALVATORI
PROJECT LEADER: K. HIGGINS	SHEET 28 OF 34
DESIGNED BY: G. LAROCHE	MAINLINE SECTIONS 4

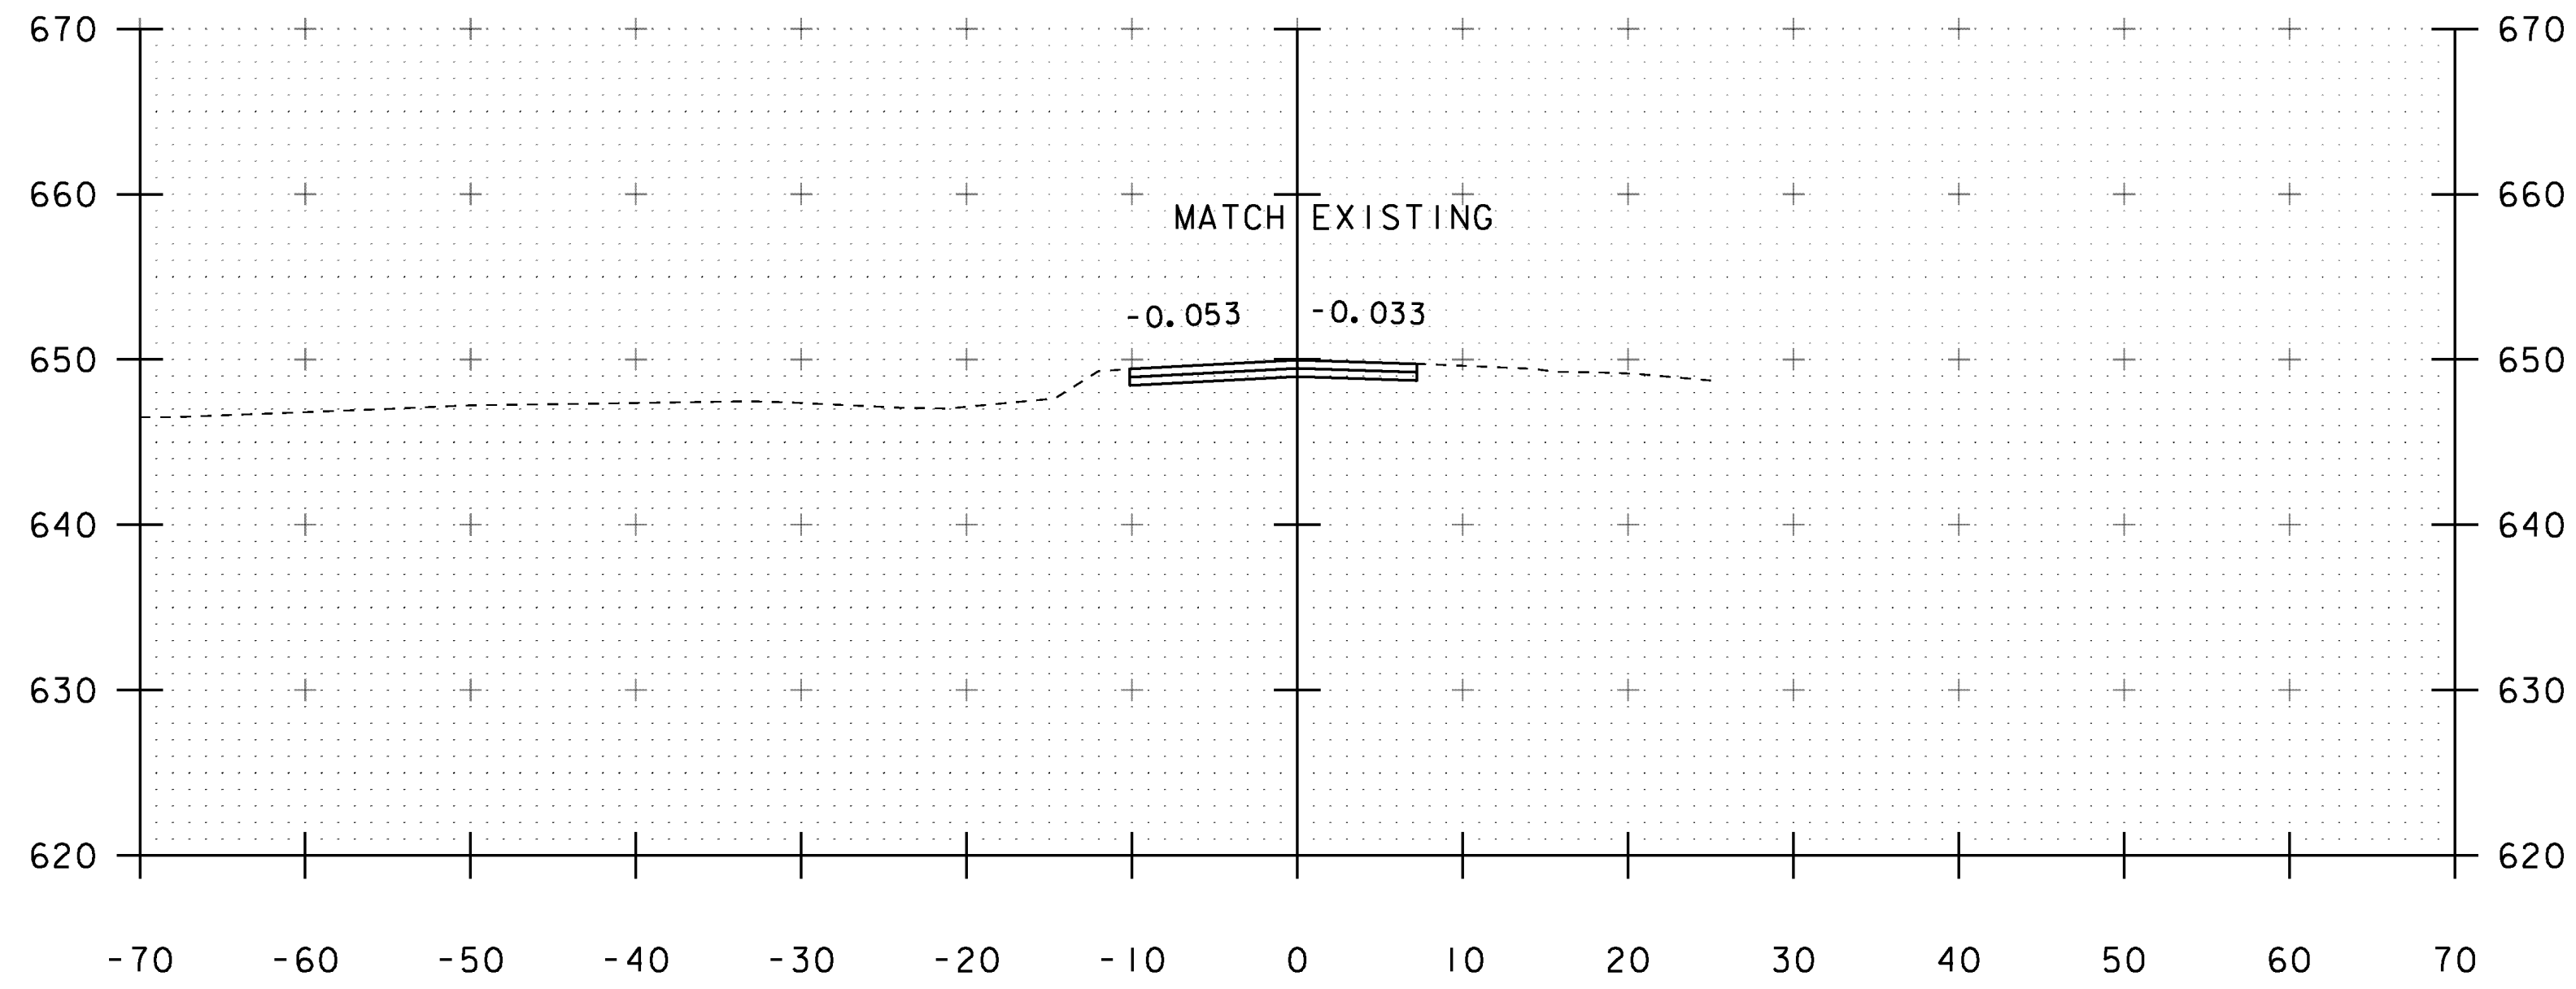


25+50  
END APPROACH

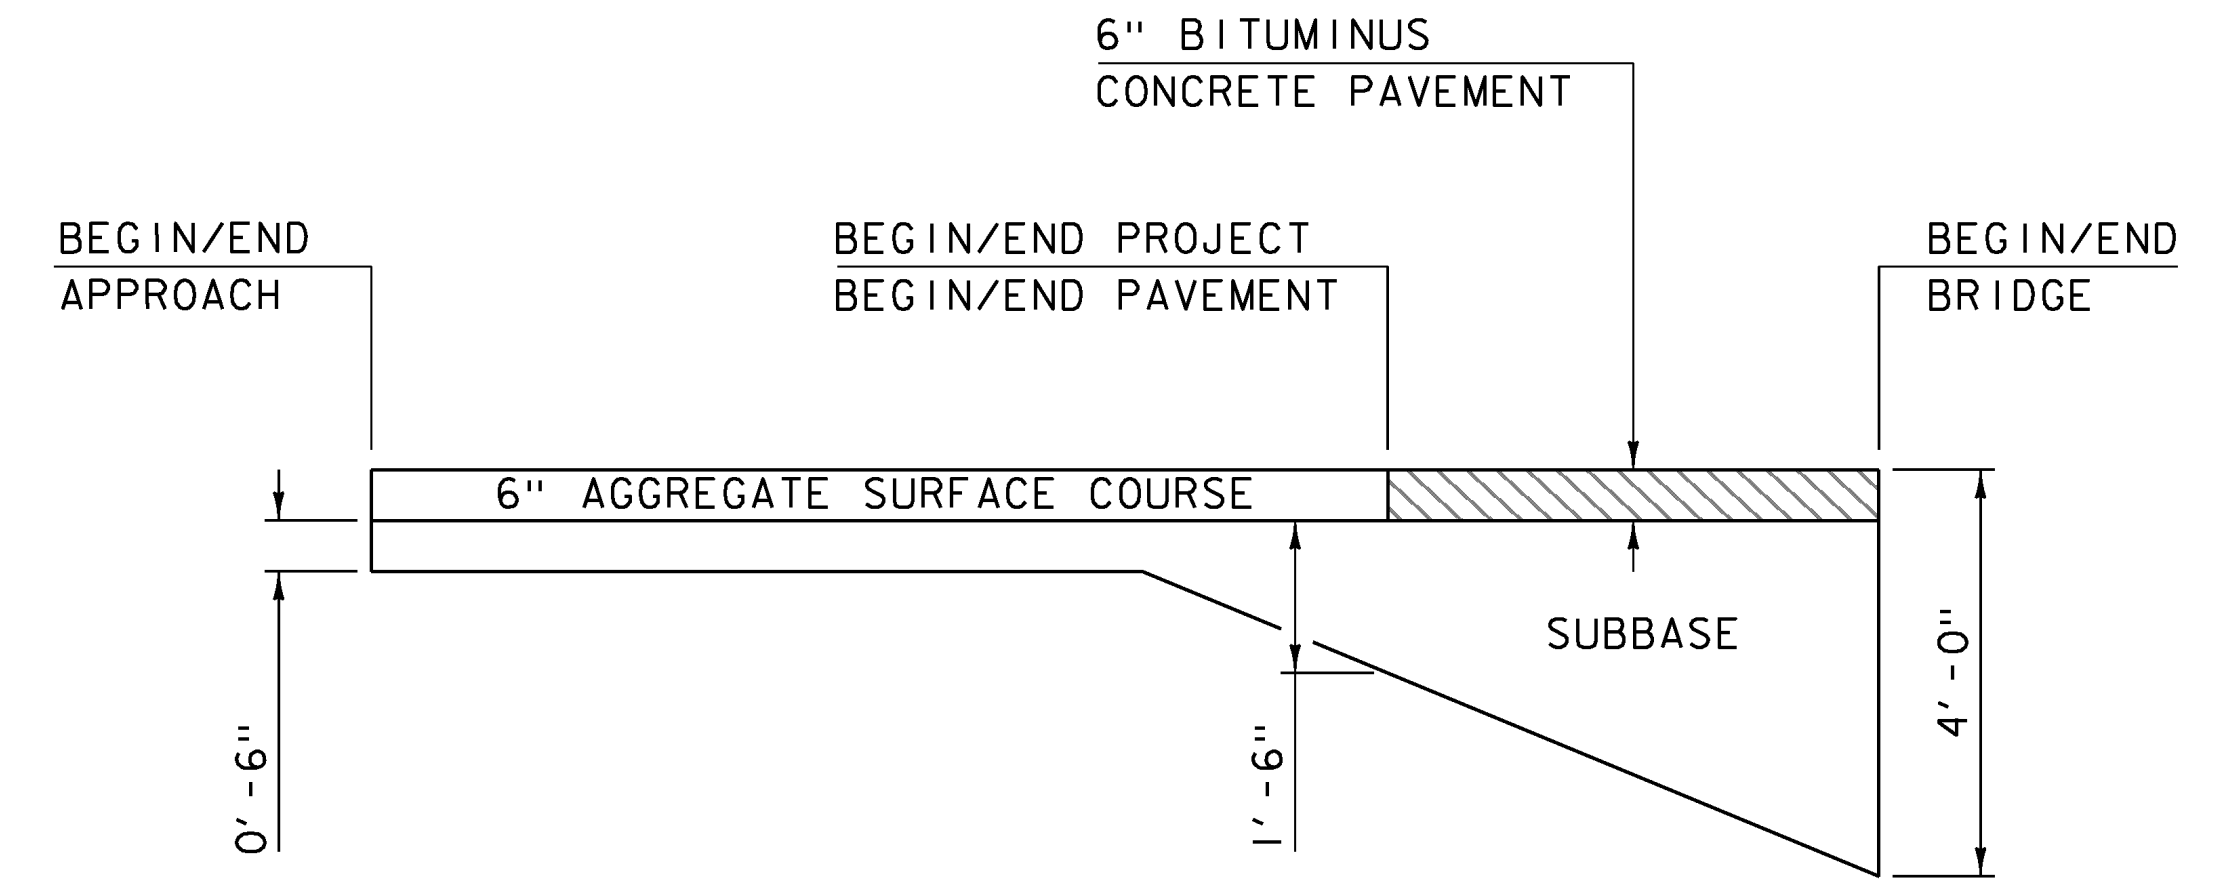

MATERIAL TRANSITION  
NOT TO SCALE

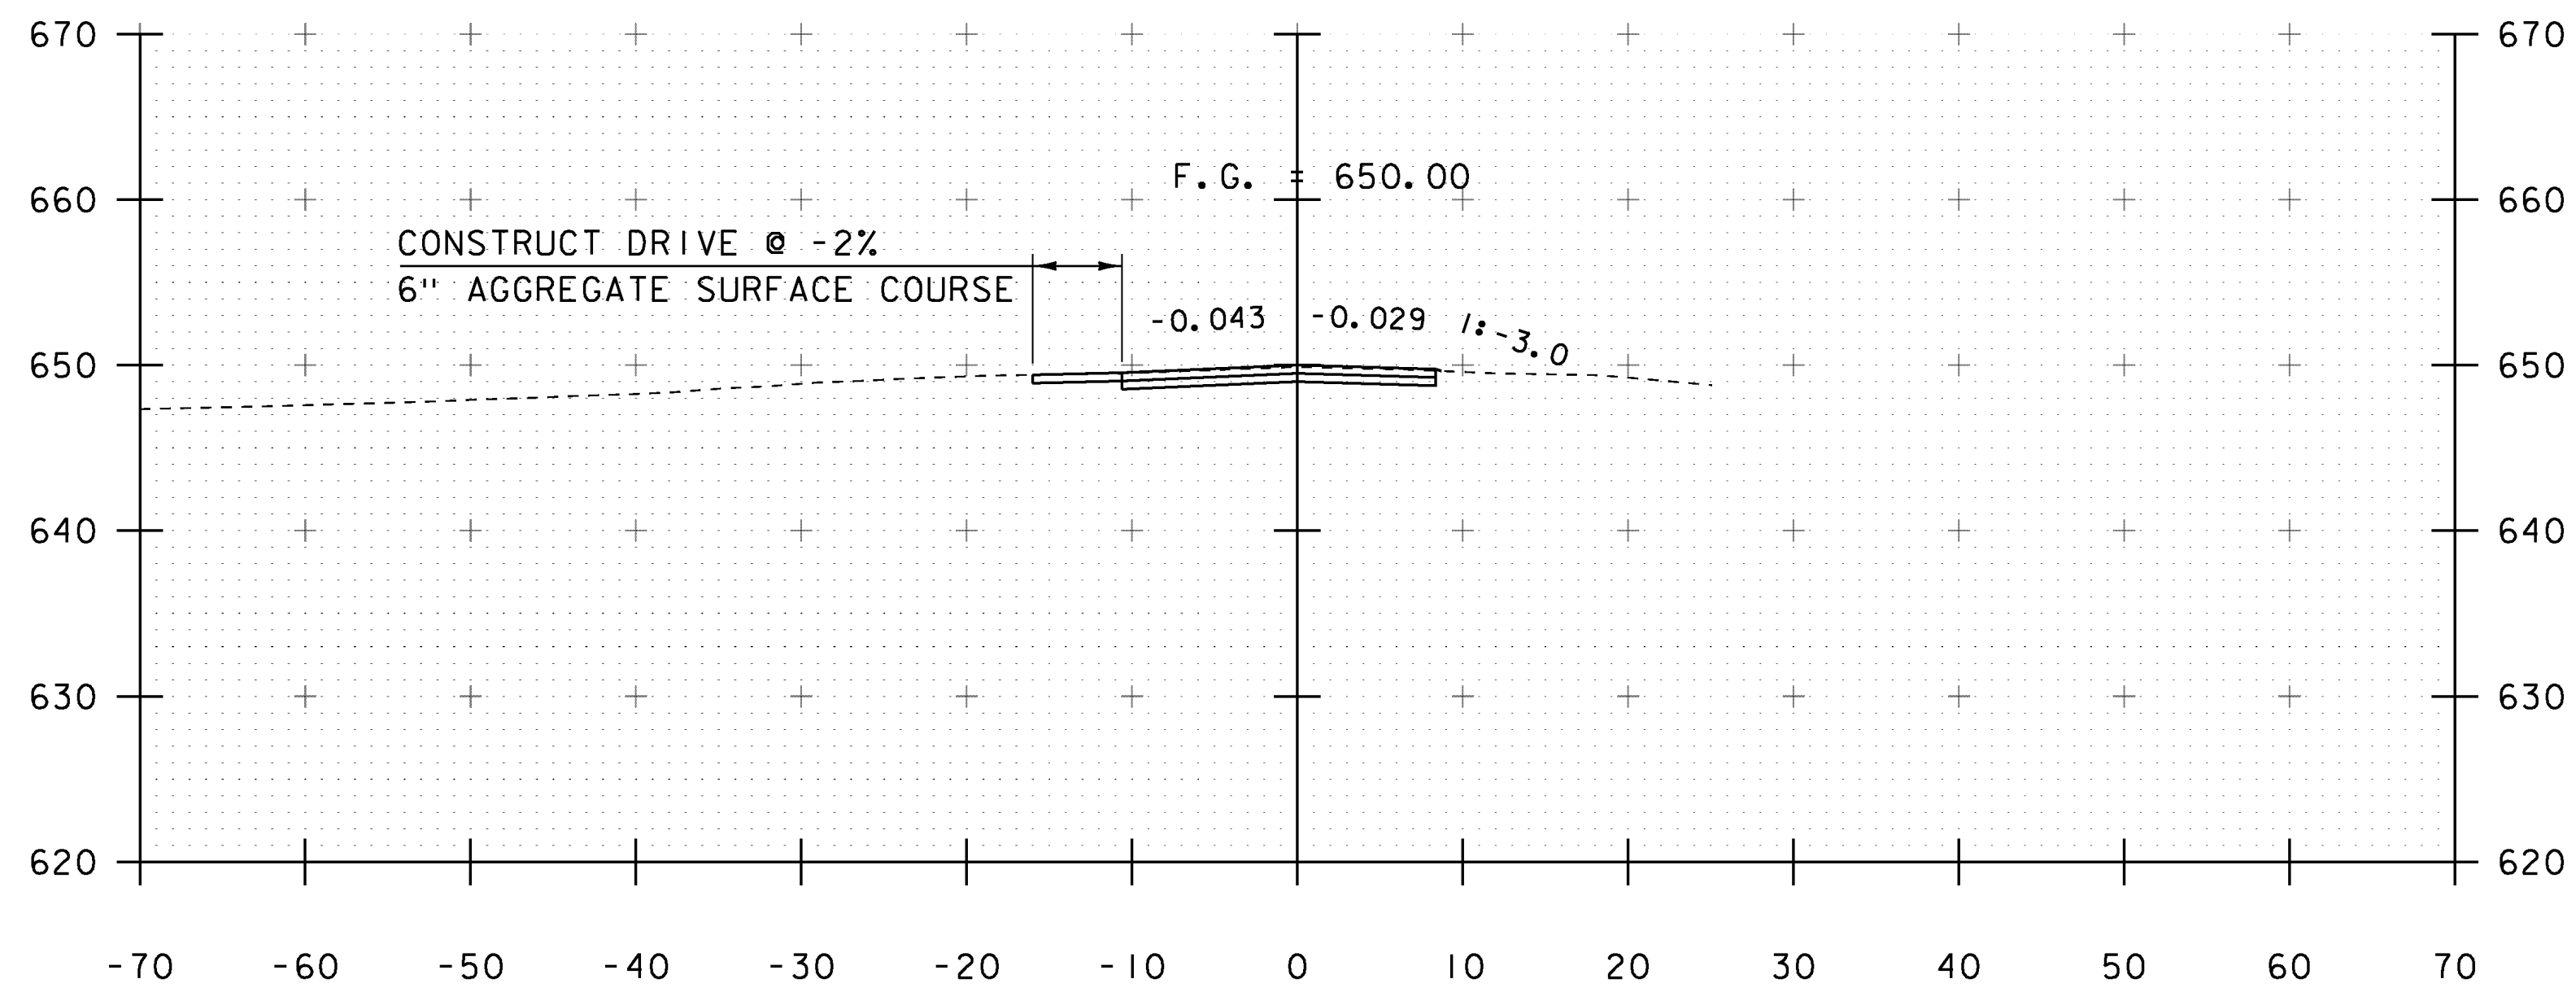


25+35

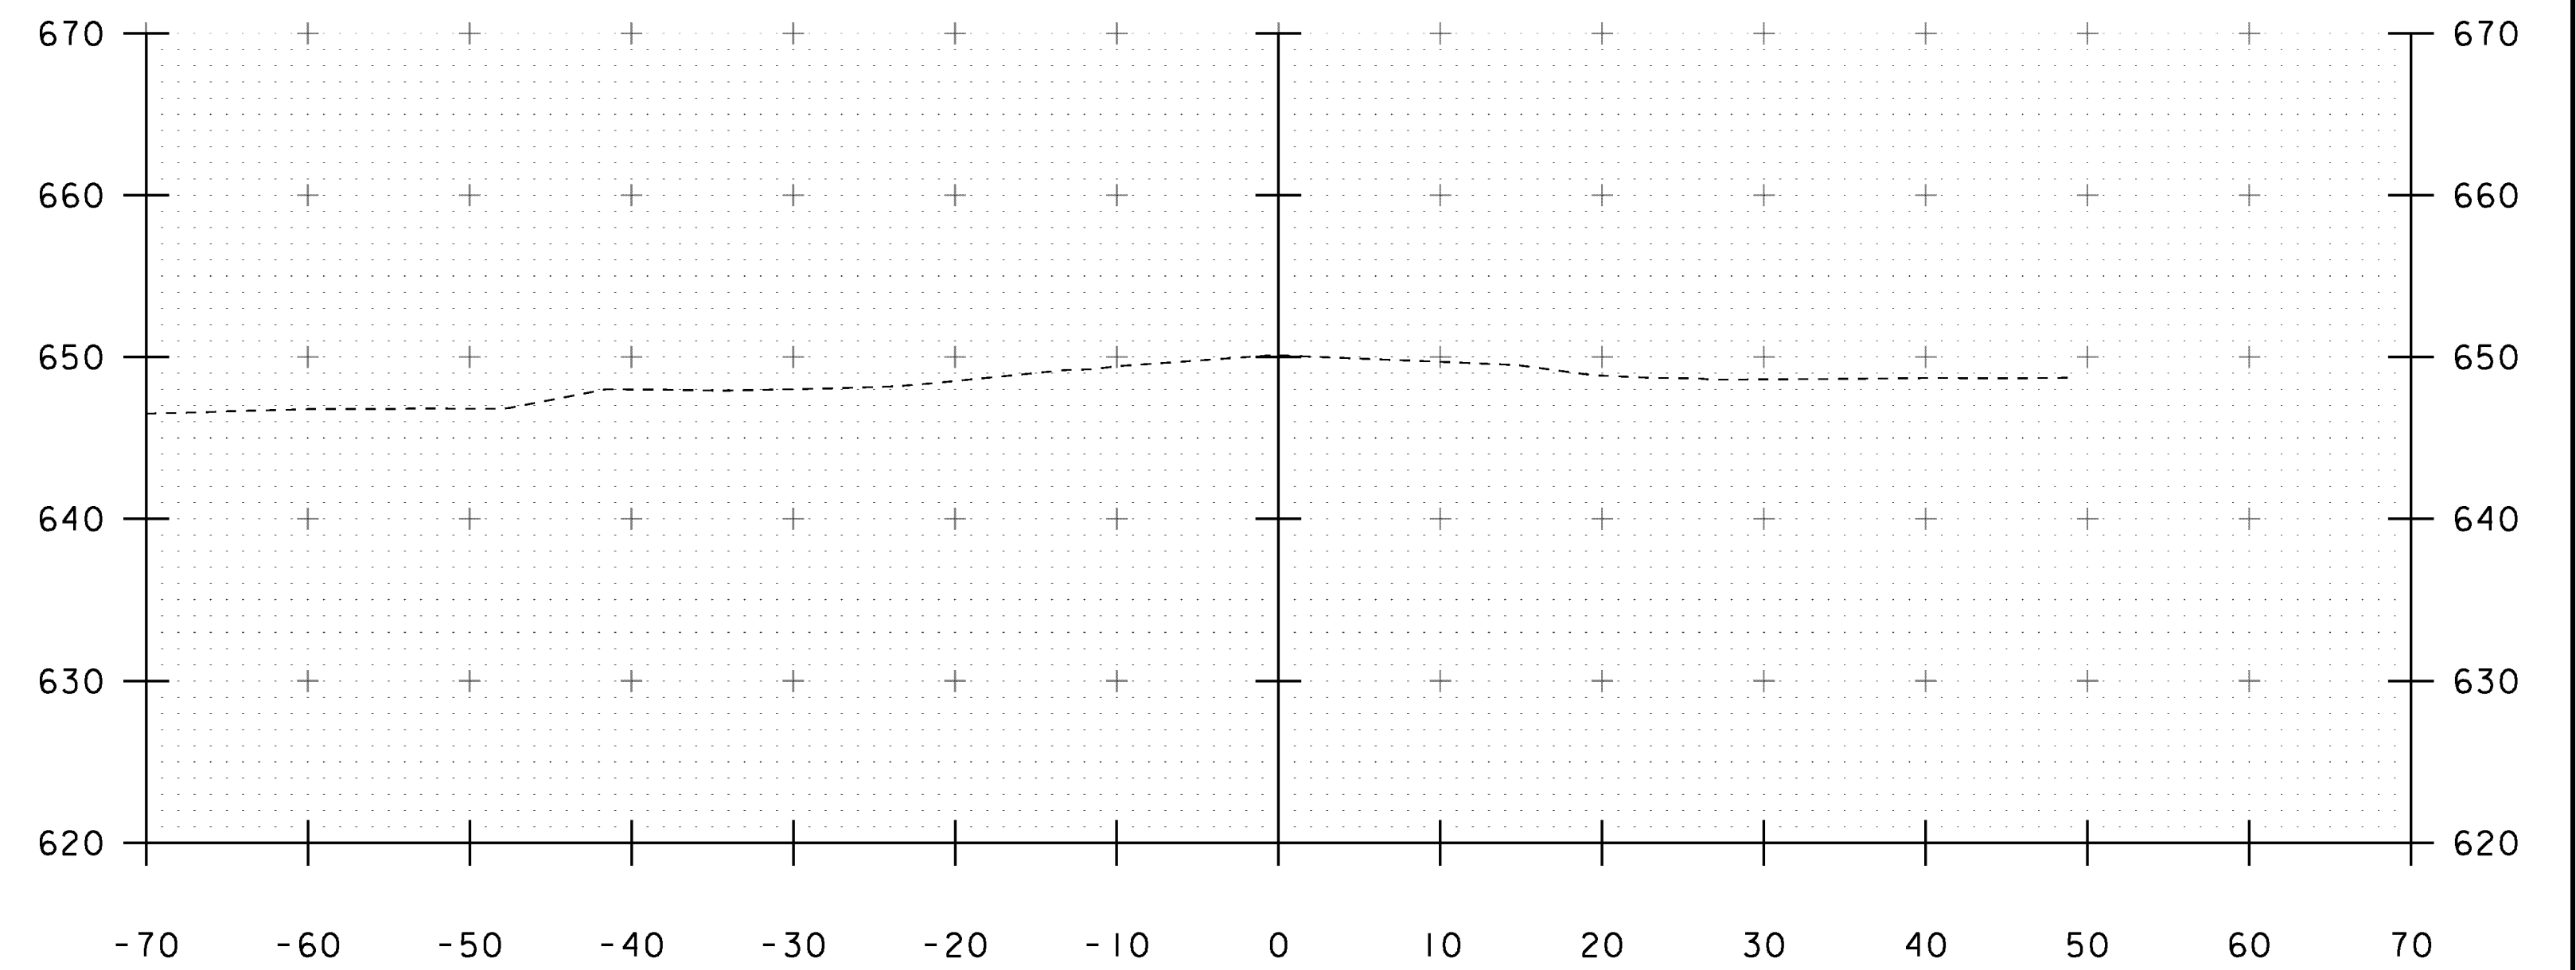


25+75

STA. 25+35 TO STA. 25+75


PROJECT NAME: CAMBRIDGE	PLOT DATE: 29-AUG-2014
PROJECT NUMBER: BRO 1448(39)	DRAWN BY: G. LAROCHE
FILE NAME: s12j166xs.dgn	CHECKED BY: J. SALVATORI
PROJECT LEADER: K. HIGGINS	SHEET 29 OF 34
DESIGNED BY: G. LAROCHE	MAINLINE SECTIONS 5

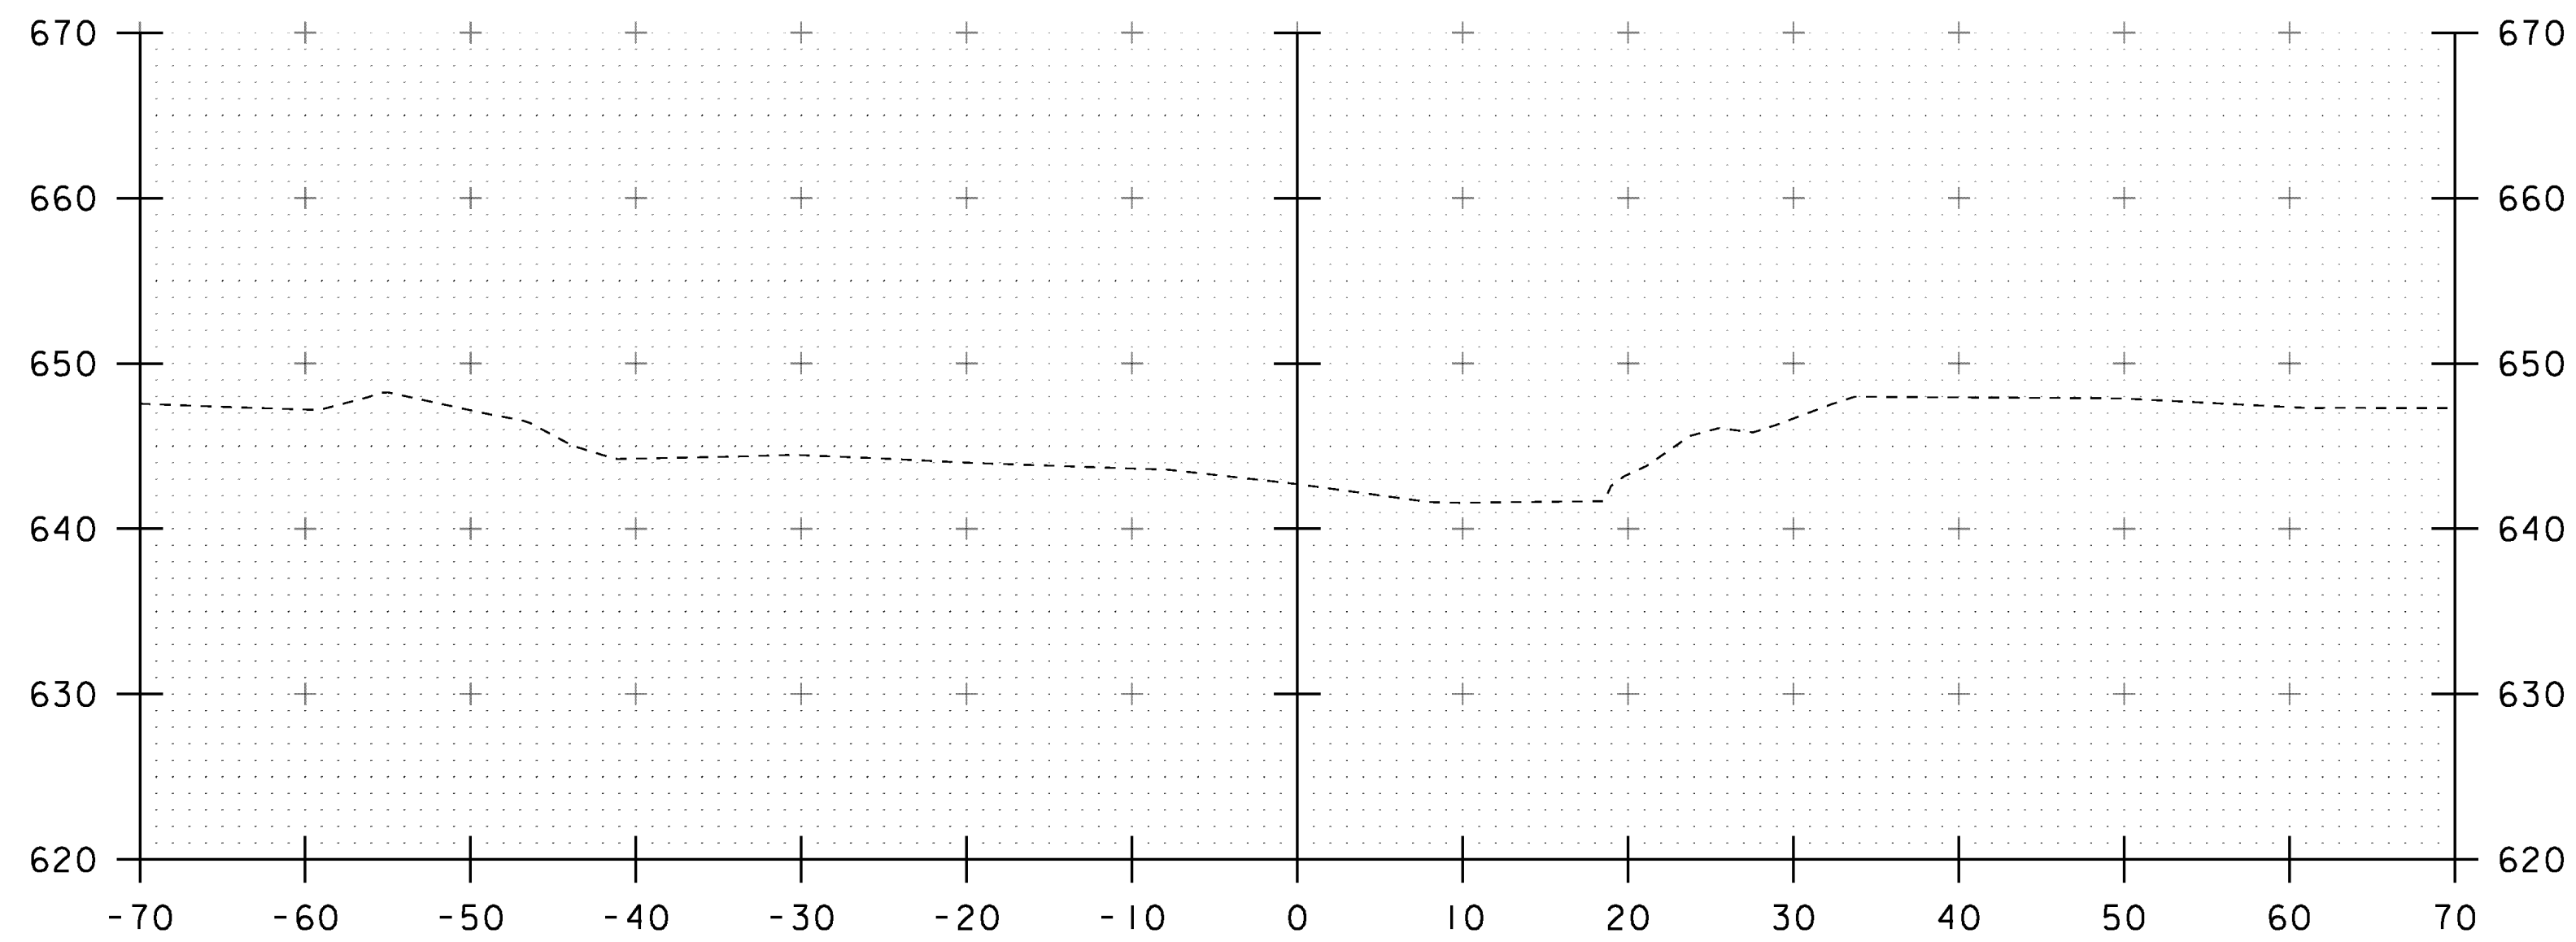


50+25

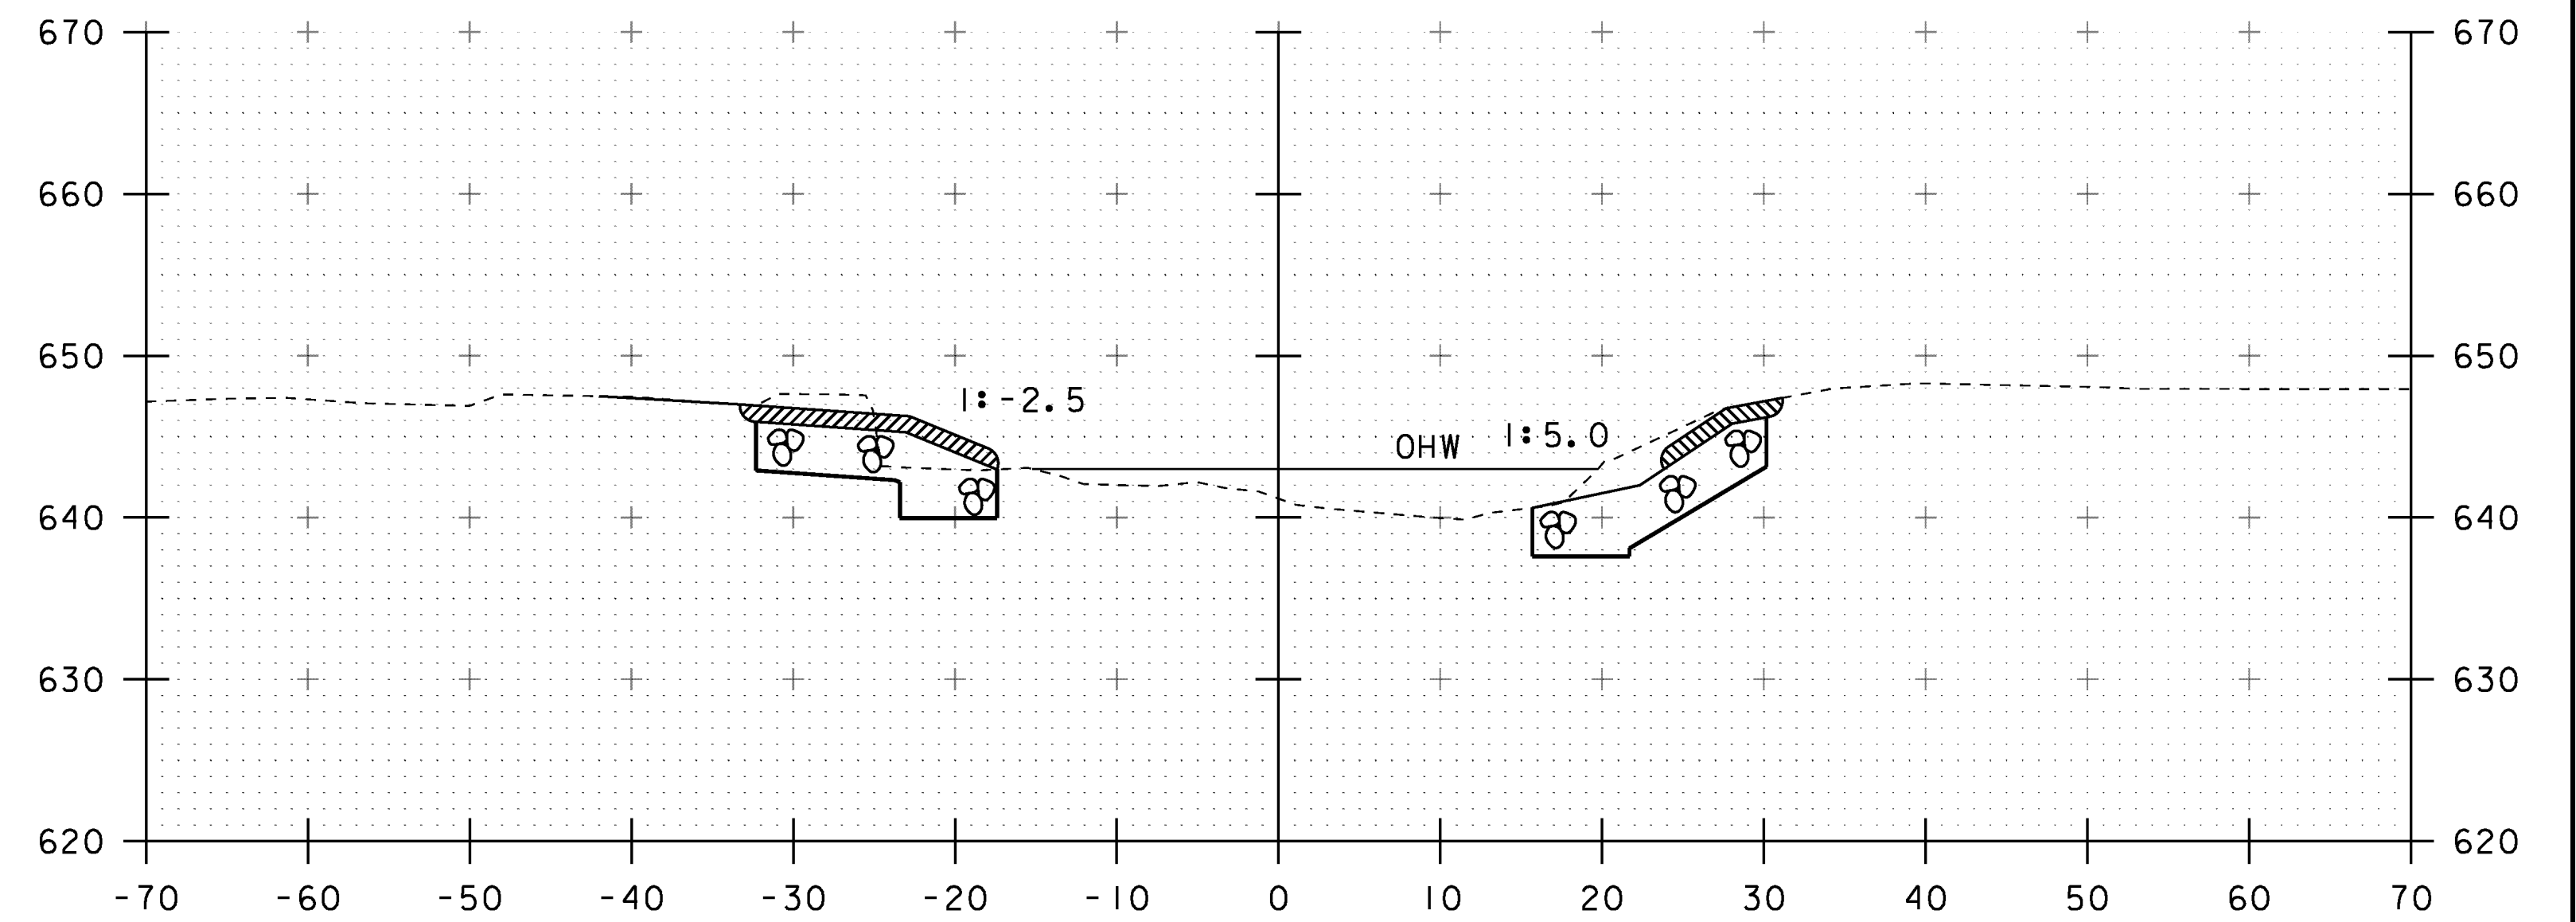

50+75

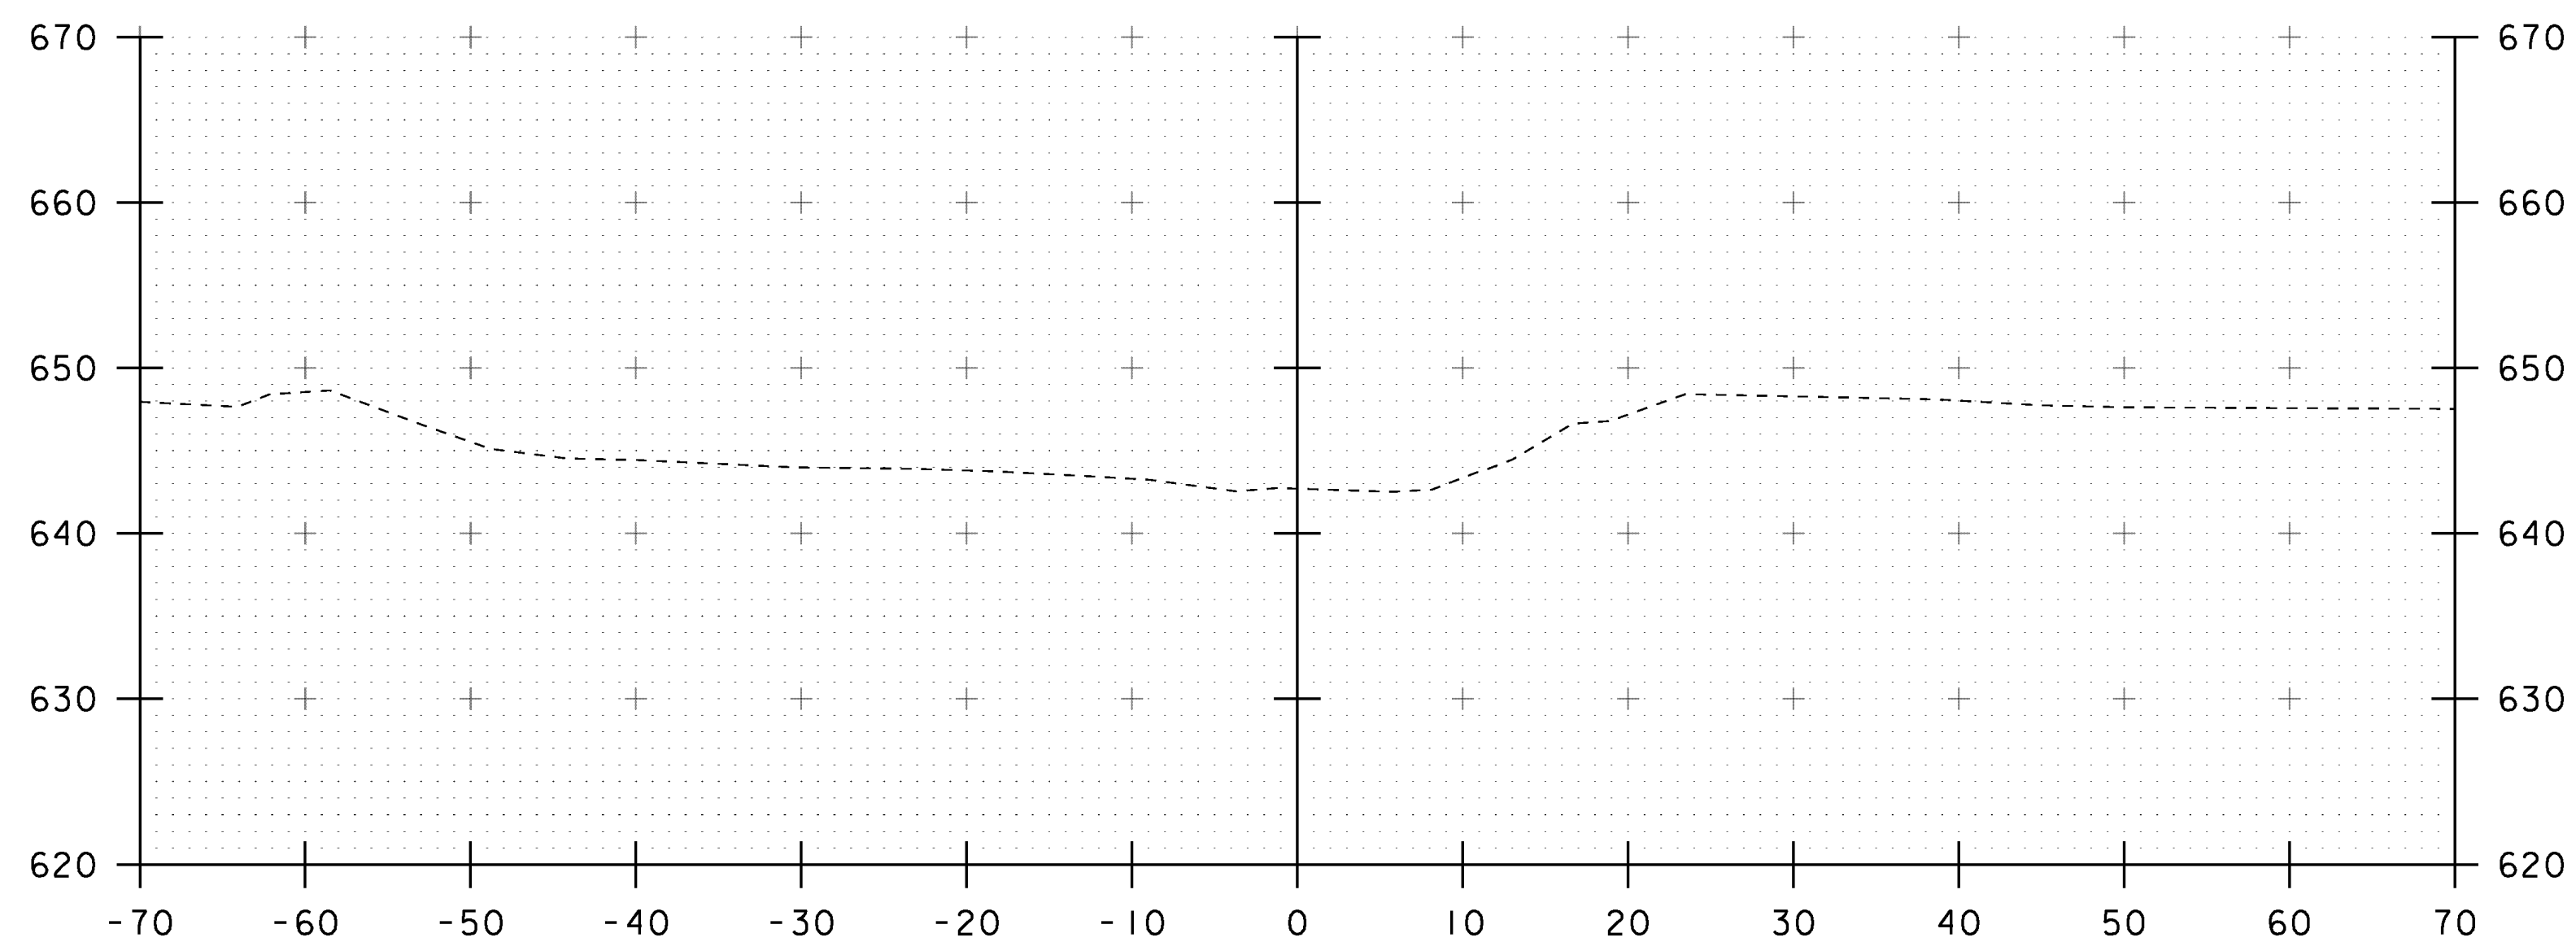

50+00

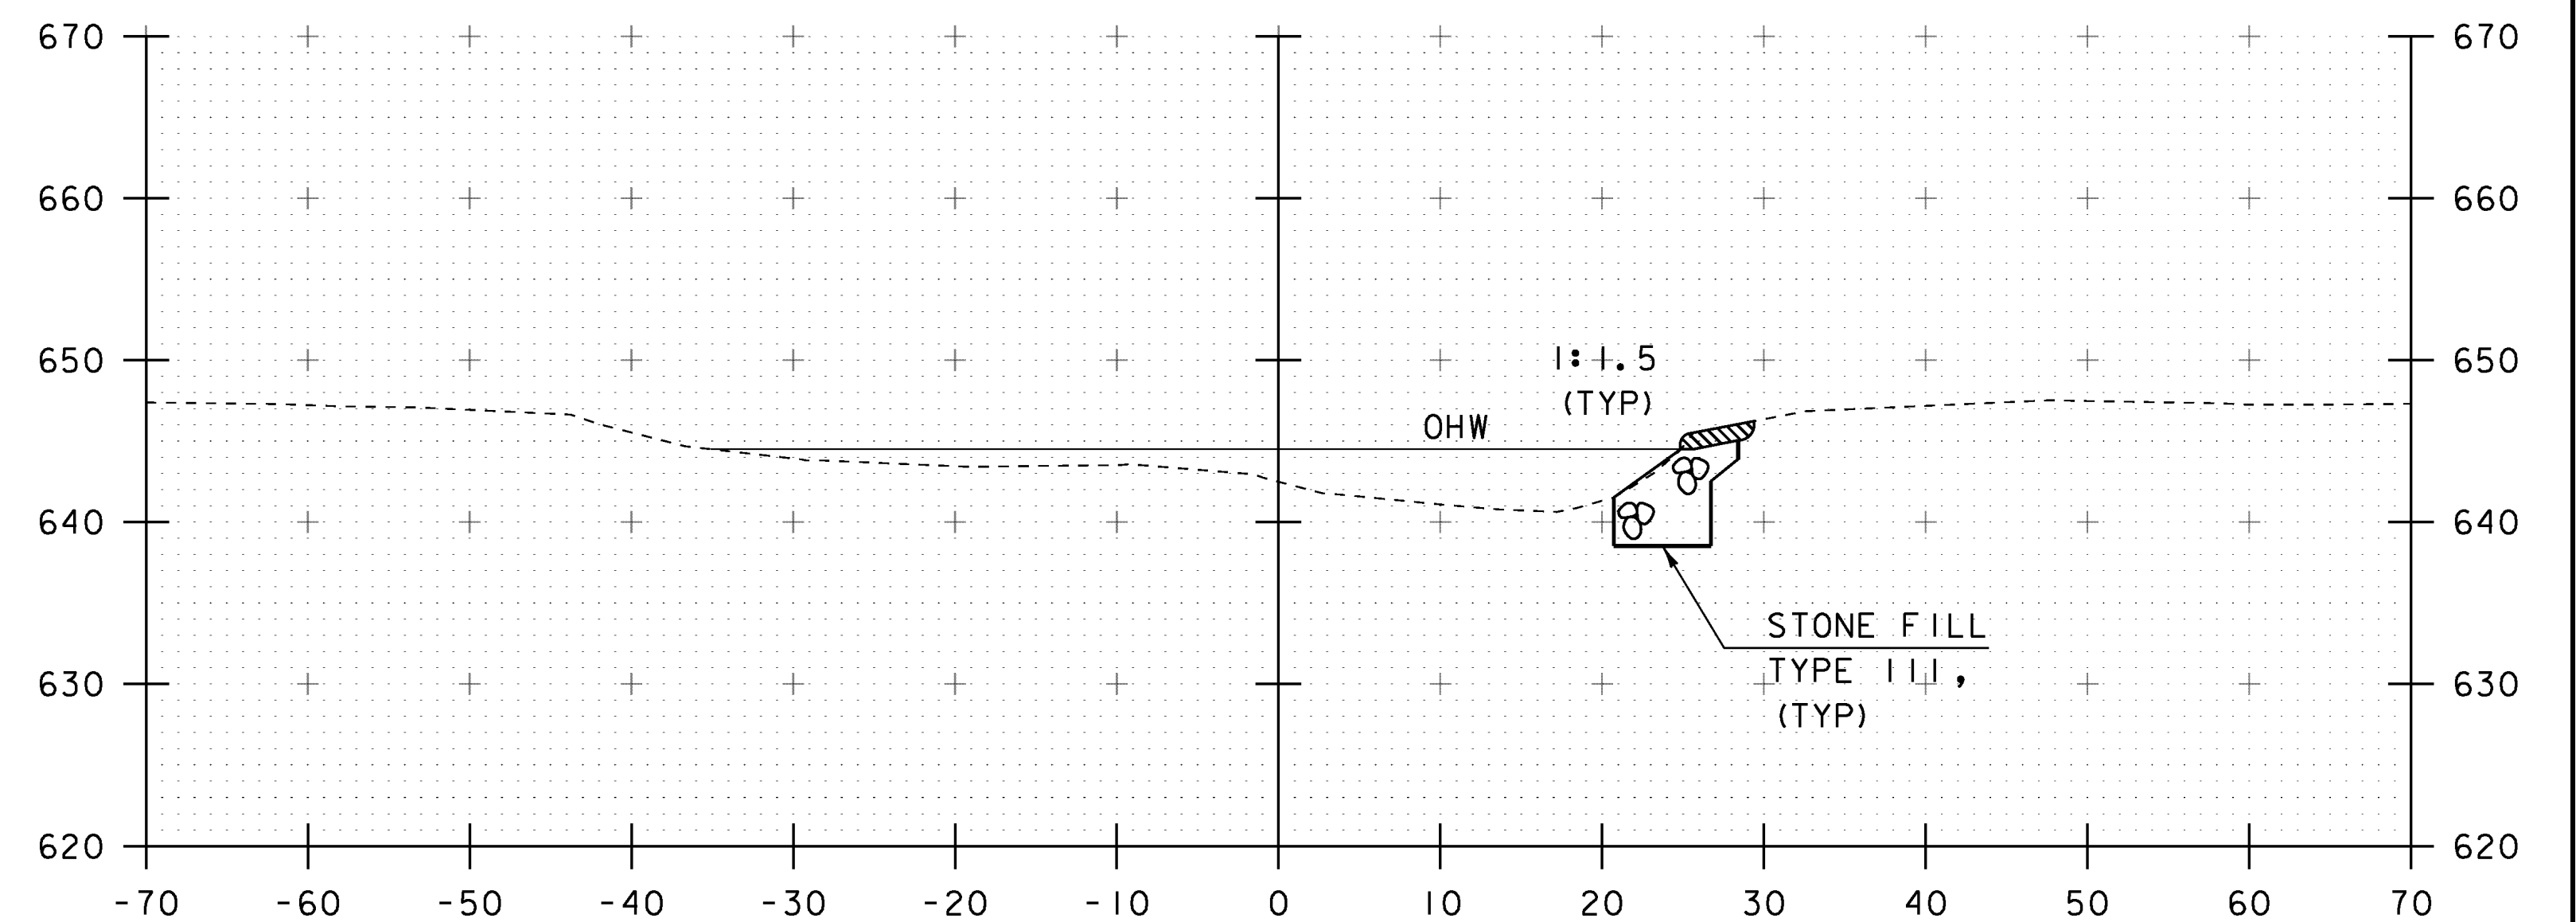


50+50

STA 50+64.10 LT (AB #1)  
 BEGIN UNCLASSIFIED CHANNEL EXCAVATION  
 BEGIN STONEFILL, TYPE III  
 BEGIN GEOTEXTILE UNDER STONE FILL  
 BEGIN GRUBBING MATERIAL


STA 50+45.00 RT (AB #2)  
 BEGIN UNCLASSIFIED CHANNEL EXCAVATION  
 BEGIN STONEFILL, TYPE III  
 BEGIN GEOTEXTILE UNDER STONE FILL  
 BEGIN GRUBBING MATERIAL

STA. 50+00 TO STA. 50+75


PROJECT NAME: CAMBRIDGE	
PROJECT NUMBER: BRO 1448(39)	
FILE NAME: s12j166xs.dgn	PLOT DATE: 29-AUG-2014
PROJECT LEADER: K. HIGGINS	DRAWN BY: G. LAROCHE
DESIGNED BY: G. LAROCHE	CHECKED BY: J. SALVATORI
CHANNEL SECTIONS 1	SHEET 30 OF 34

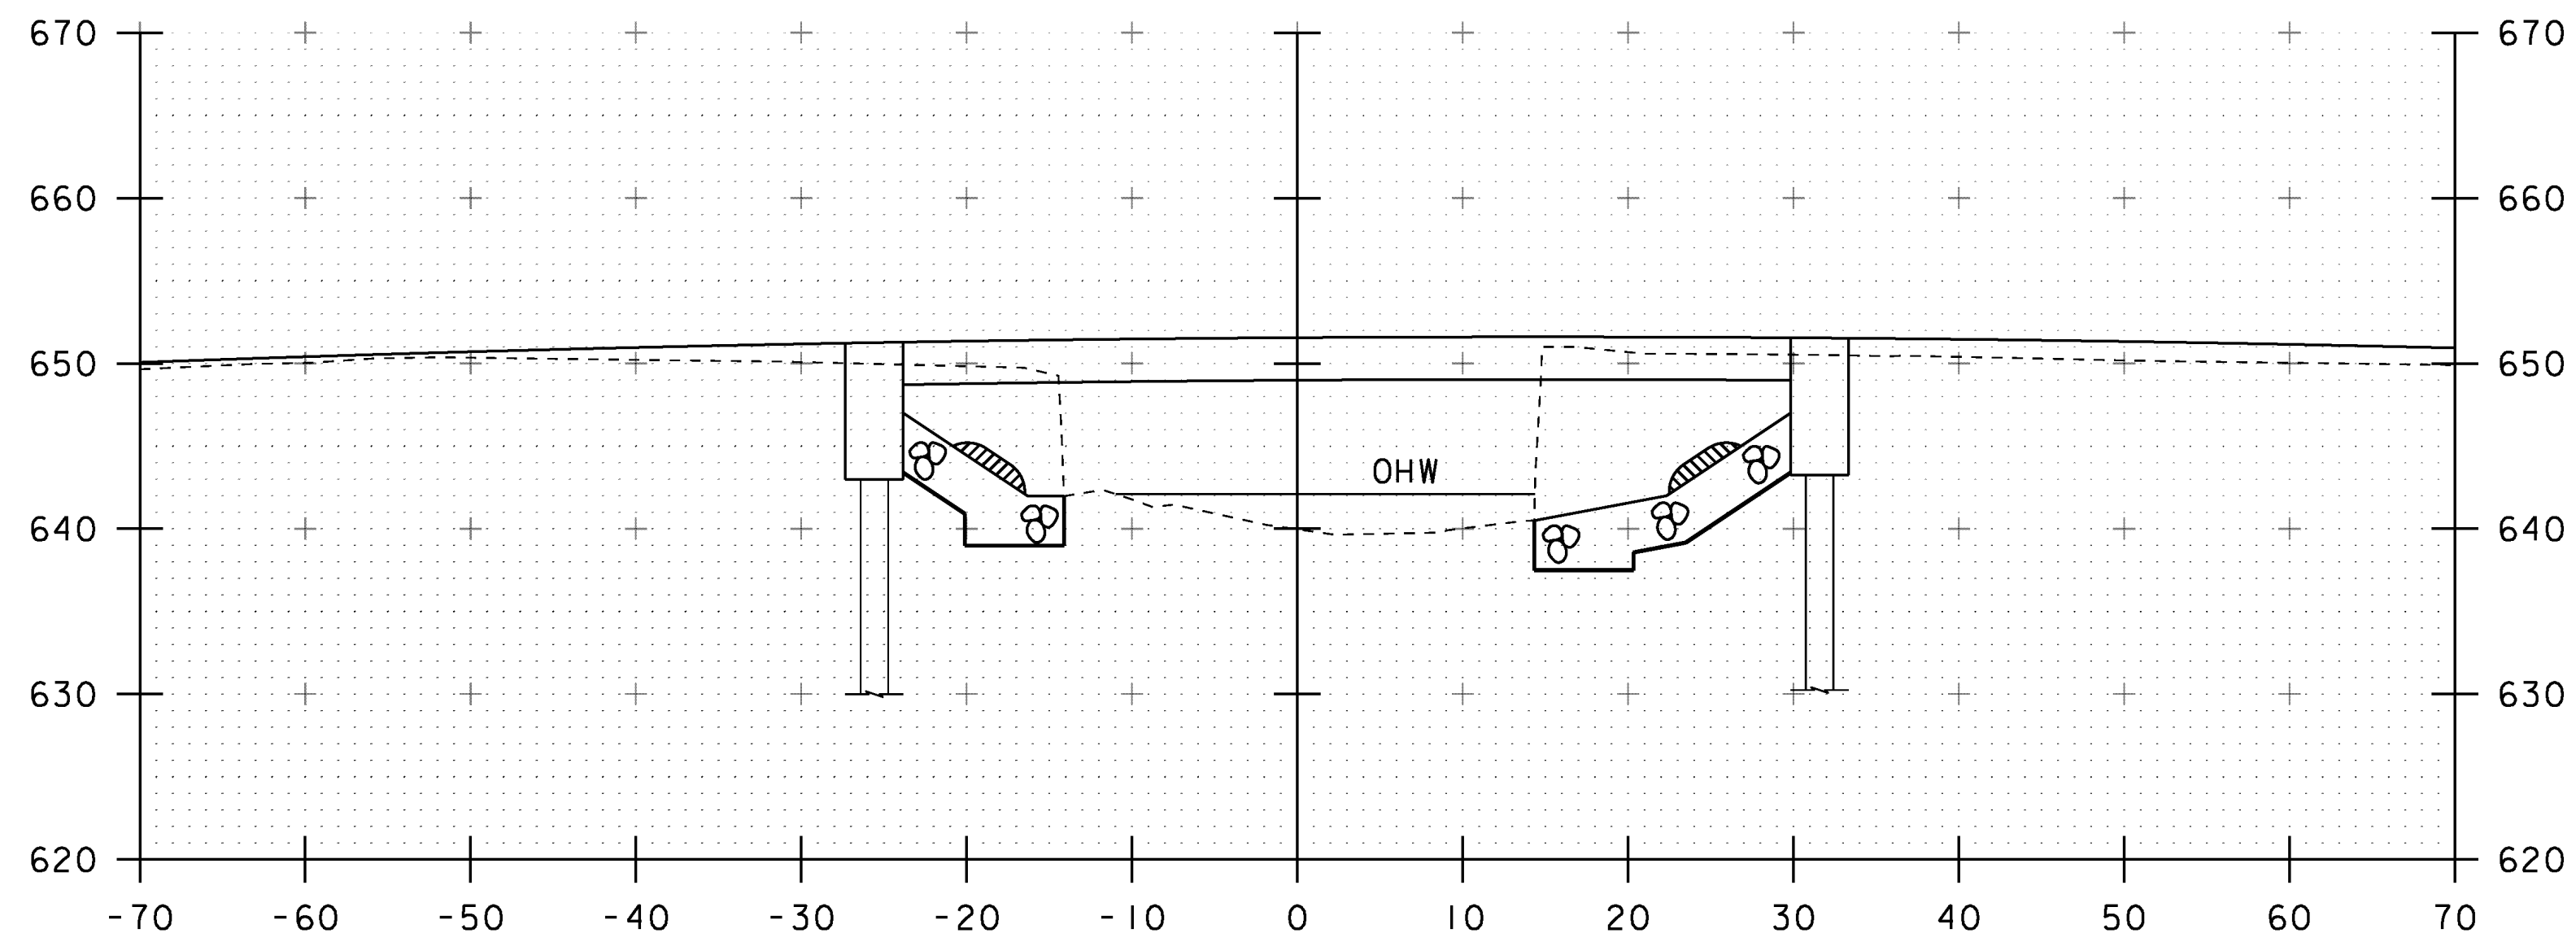


50+90

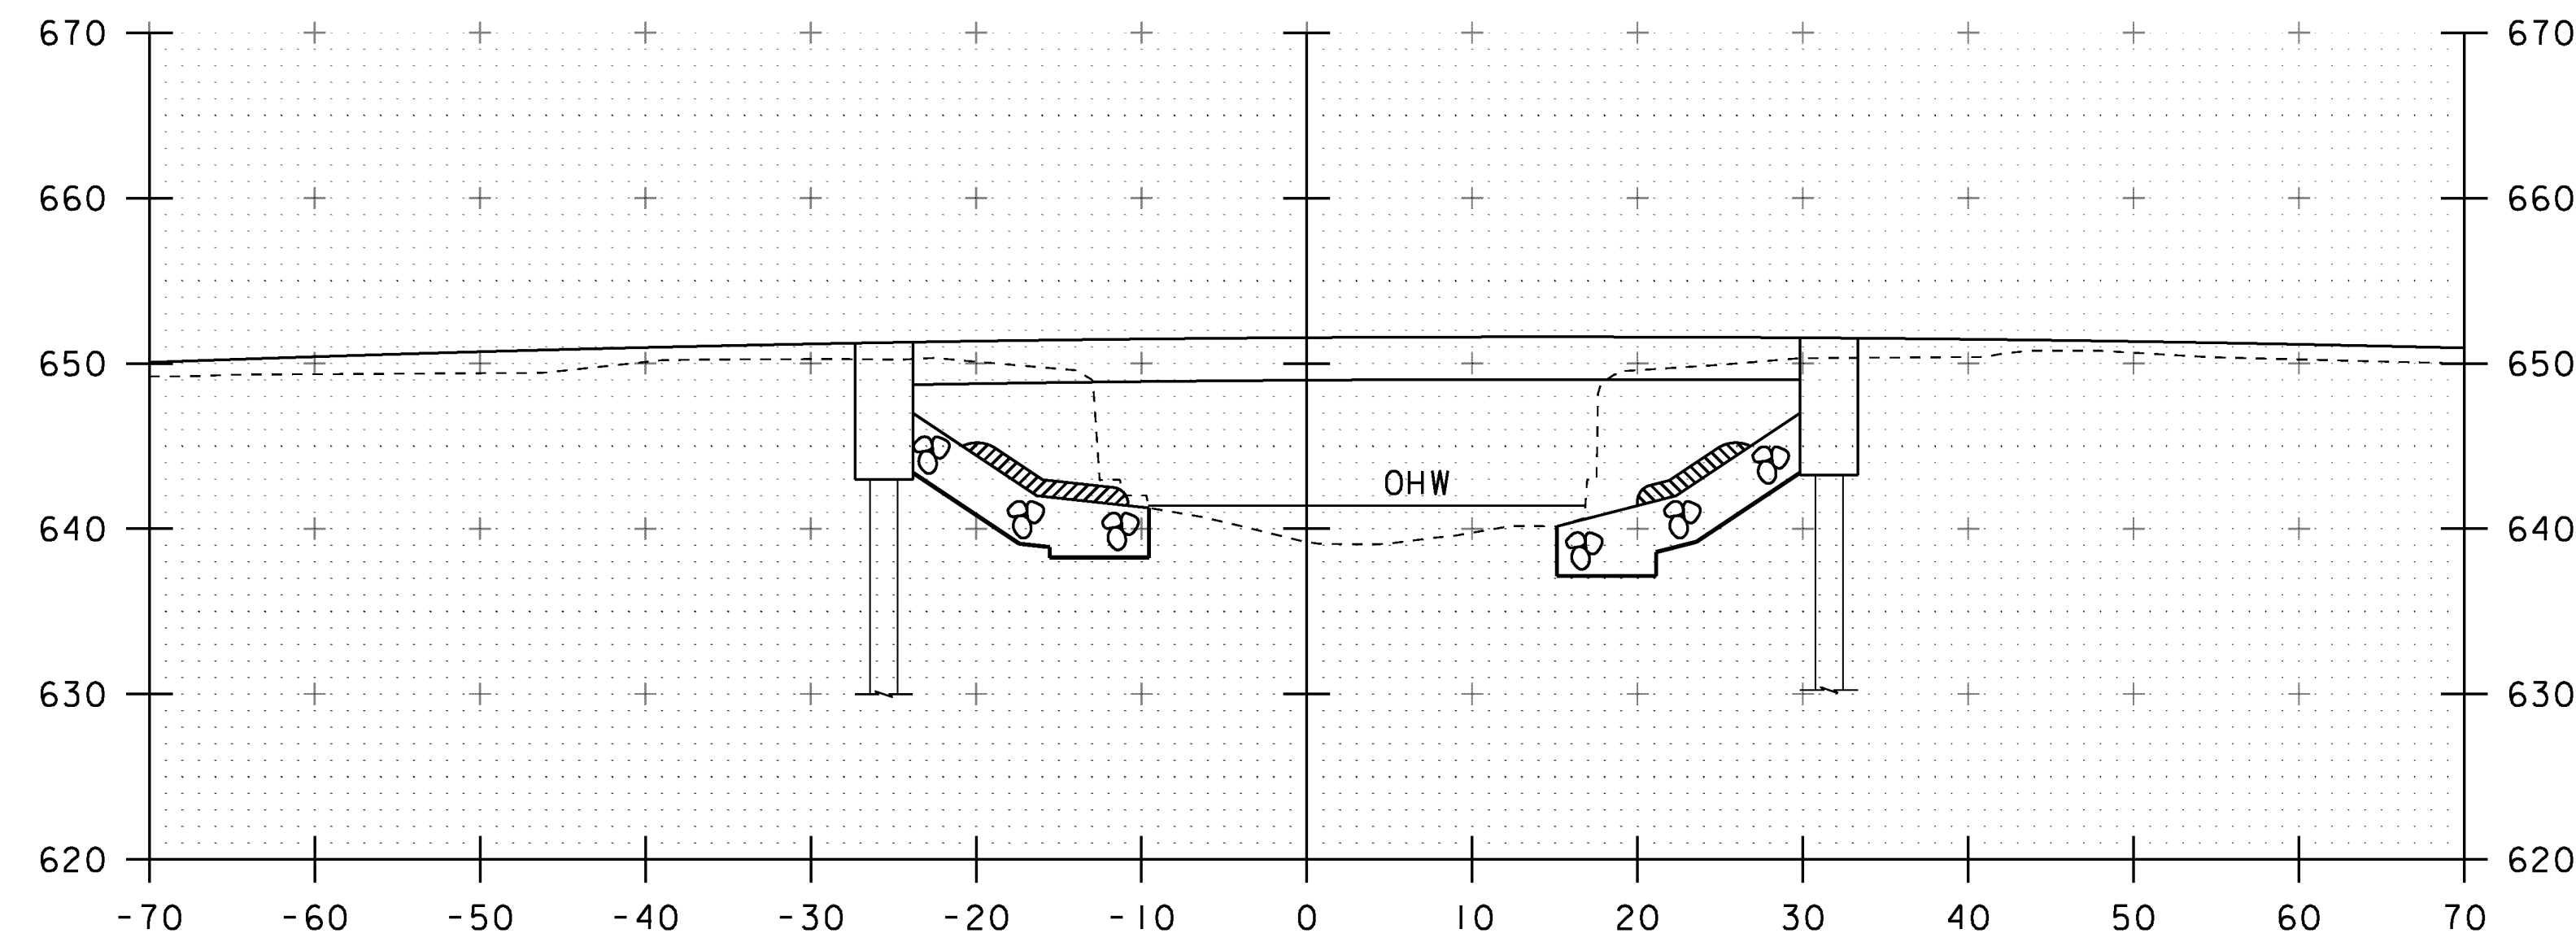

51+10

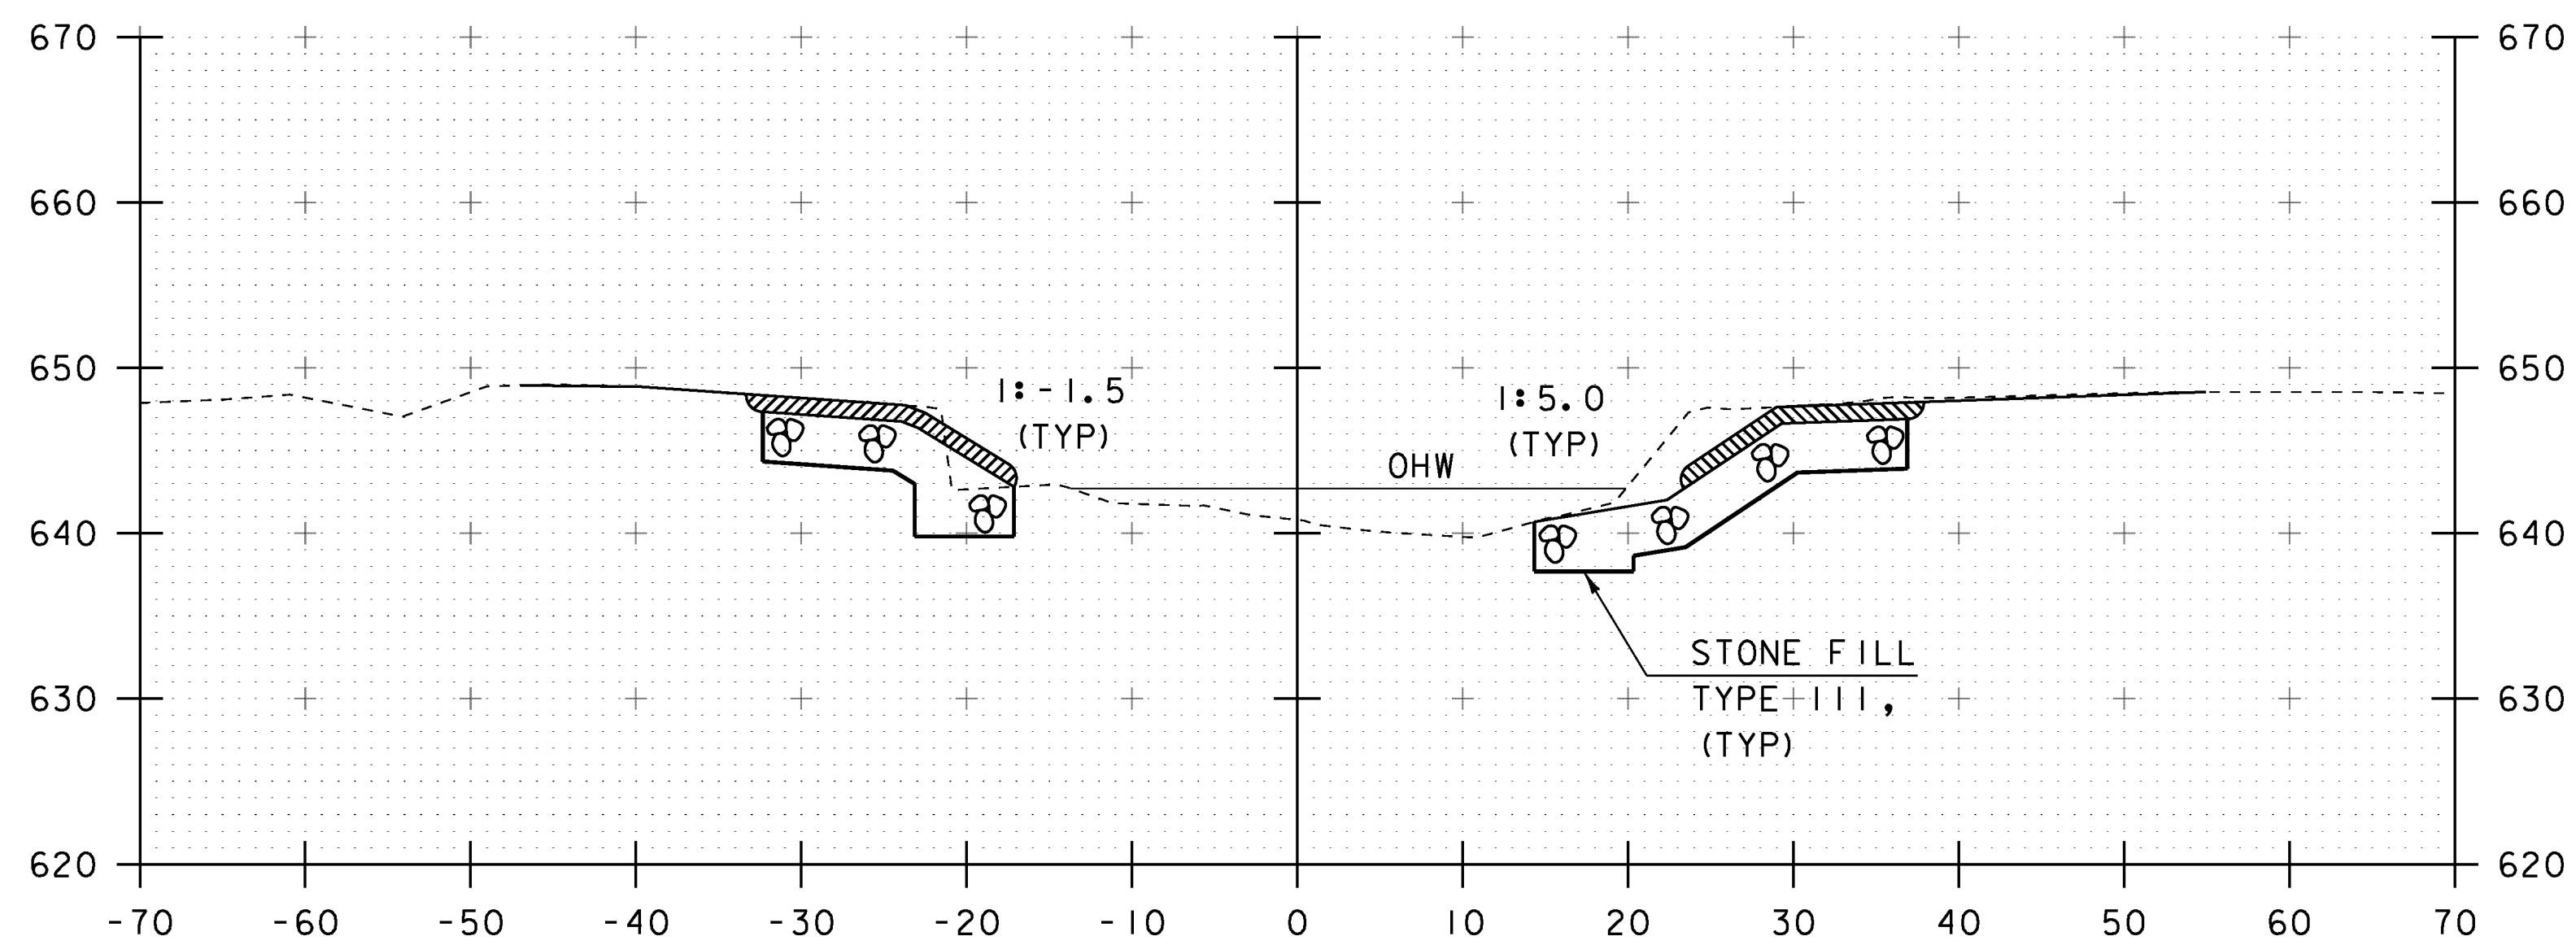

50+80

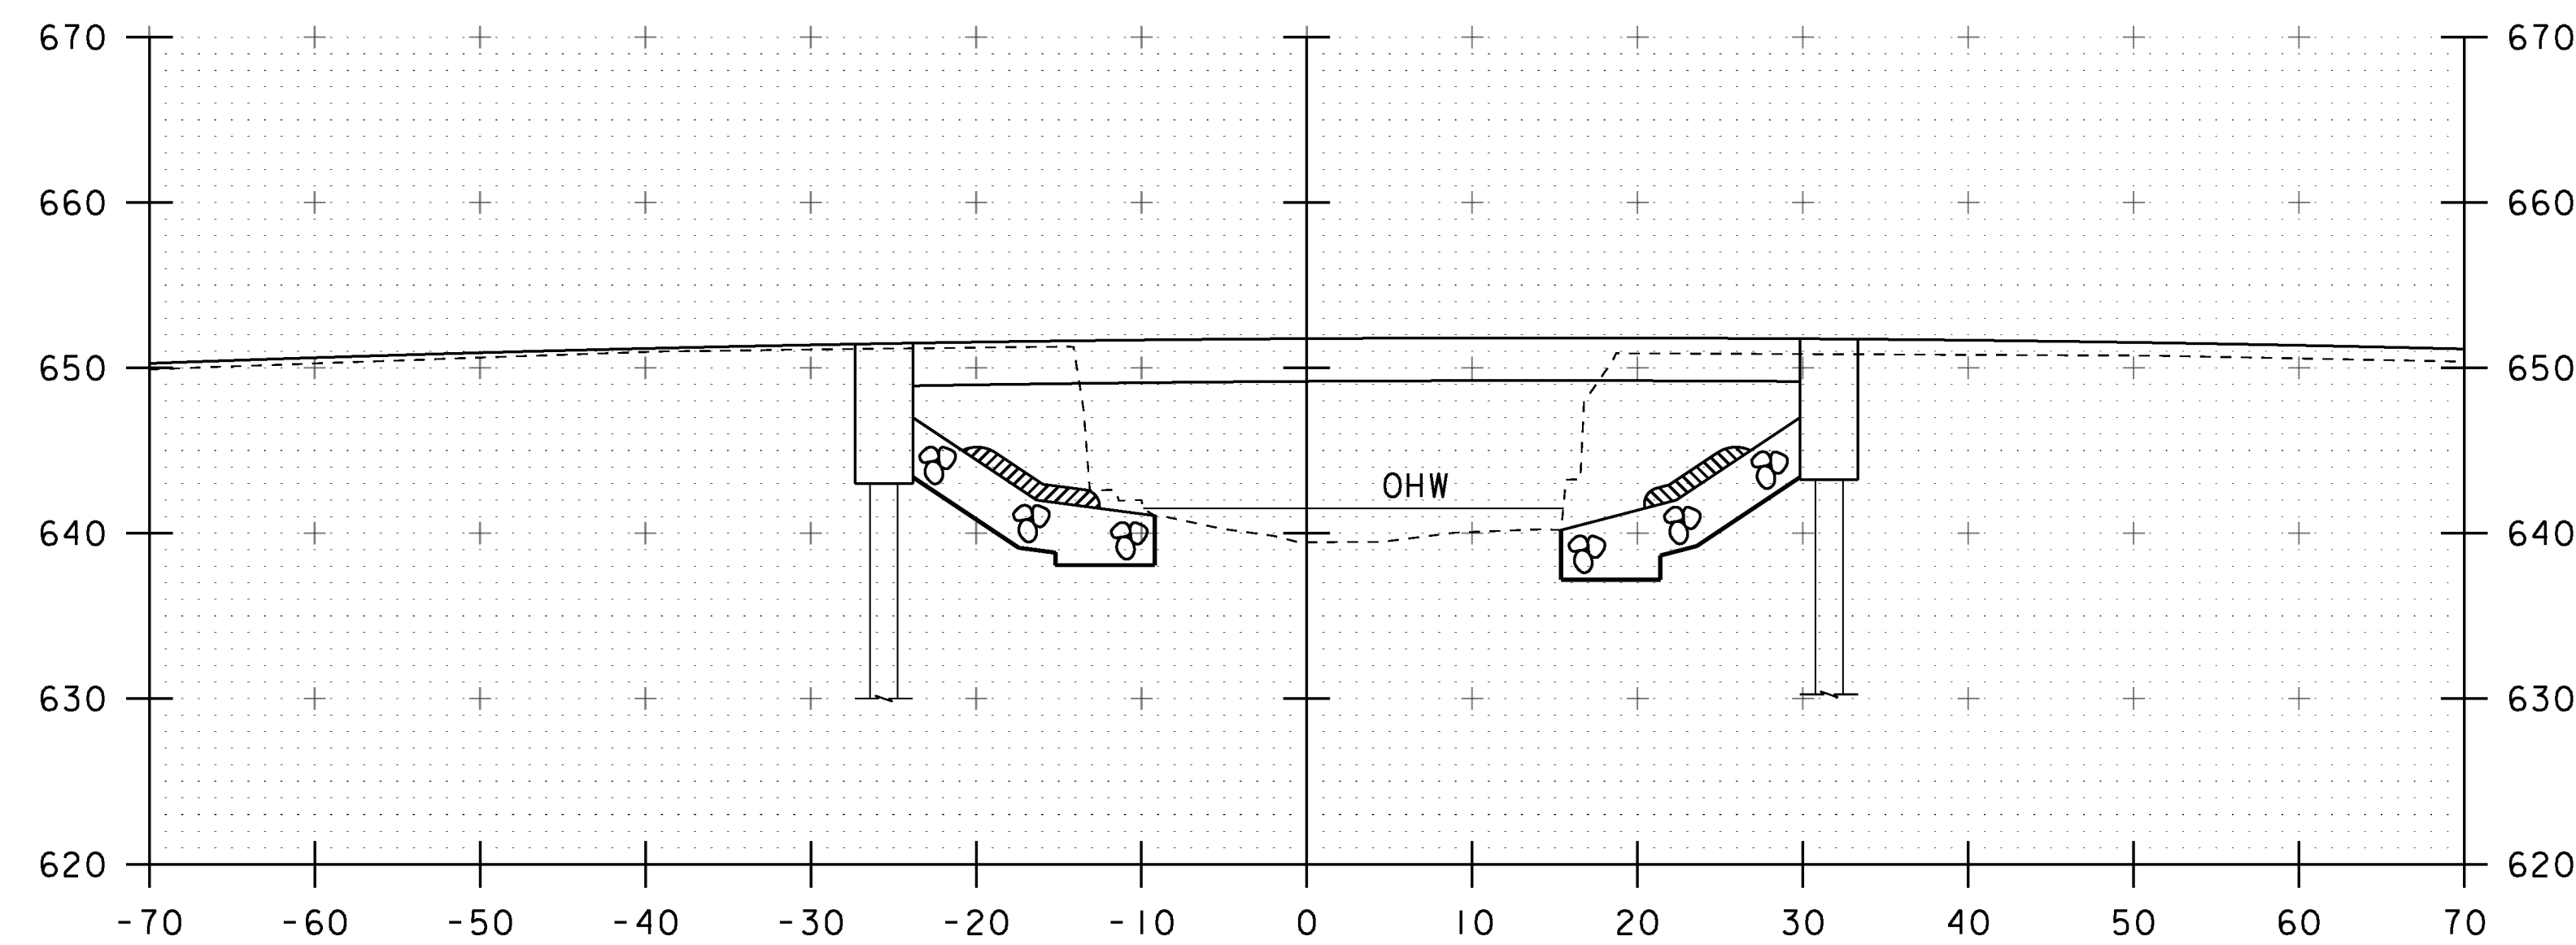


51+00

STA. 50+80 TO STA. 51+10


PROJECT NAME: CAMBRIDGE  
PROJECT NUMBER: BRO 1448(39)

FILE NAME: s12j166xs.dgn  
PROJECT LEADER: K. HIGGINS  
DESIGNED BY: G. LAROCHE  
CHANNEL SECTIONS 2


PLOT DATE: 29-AUG-2014  
DRAWN BY: G. LAROCHE  
CHECKED BY: J. SALVATORI  
SHEET 31 OF 34

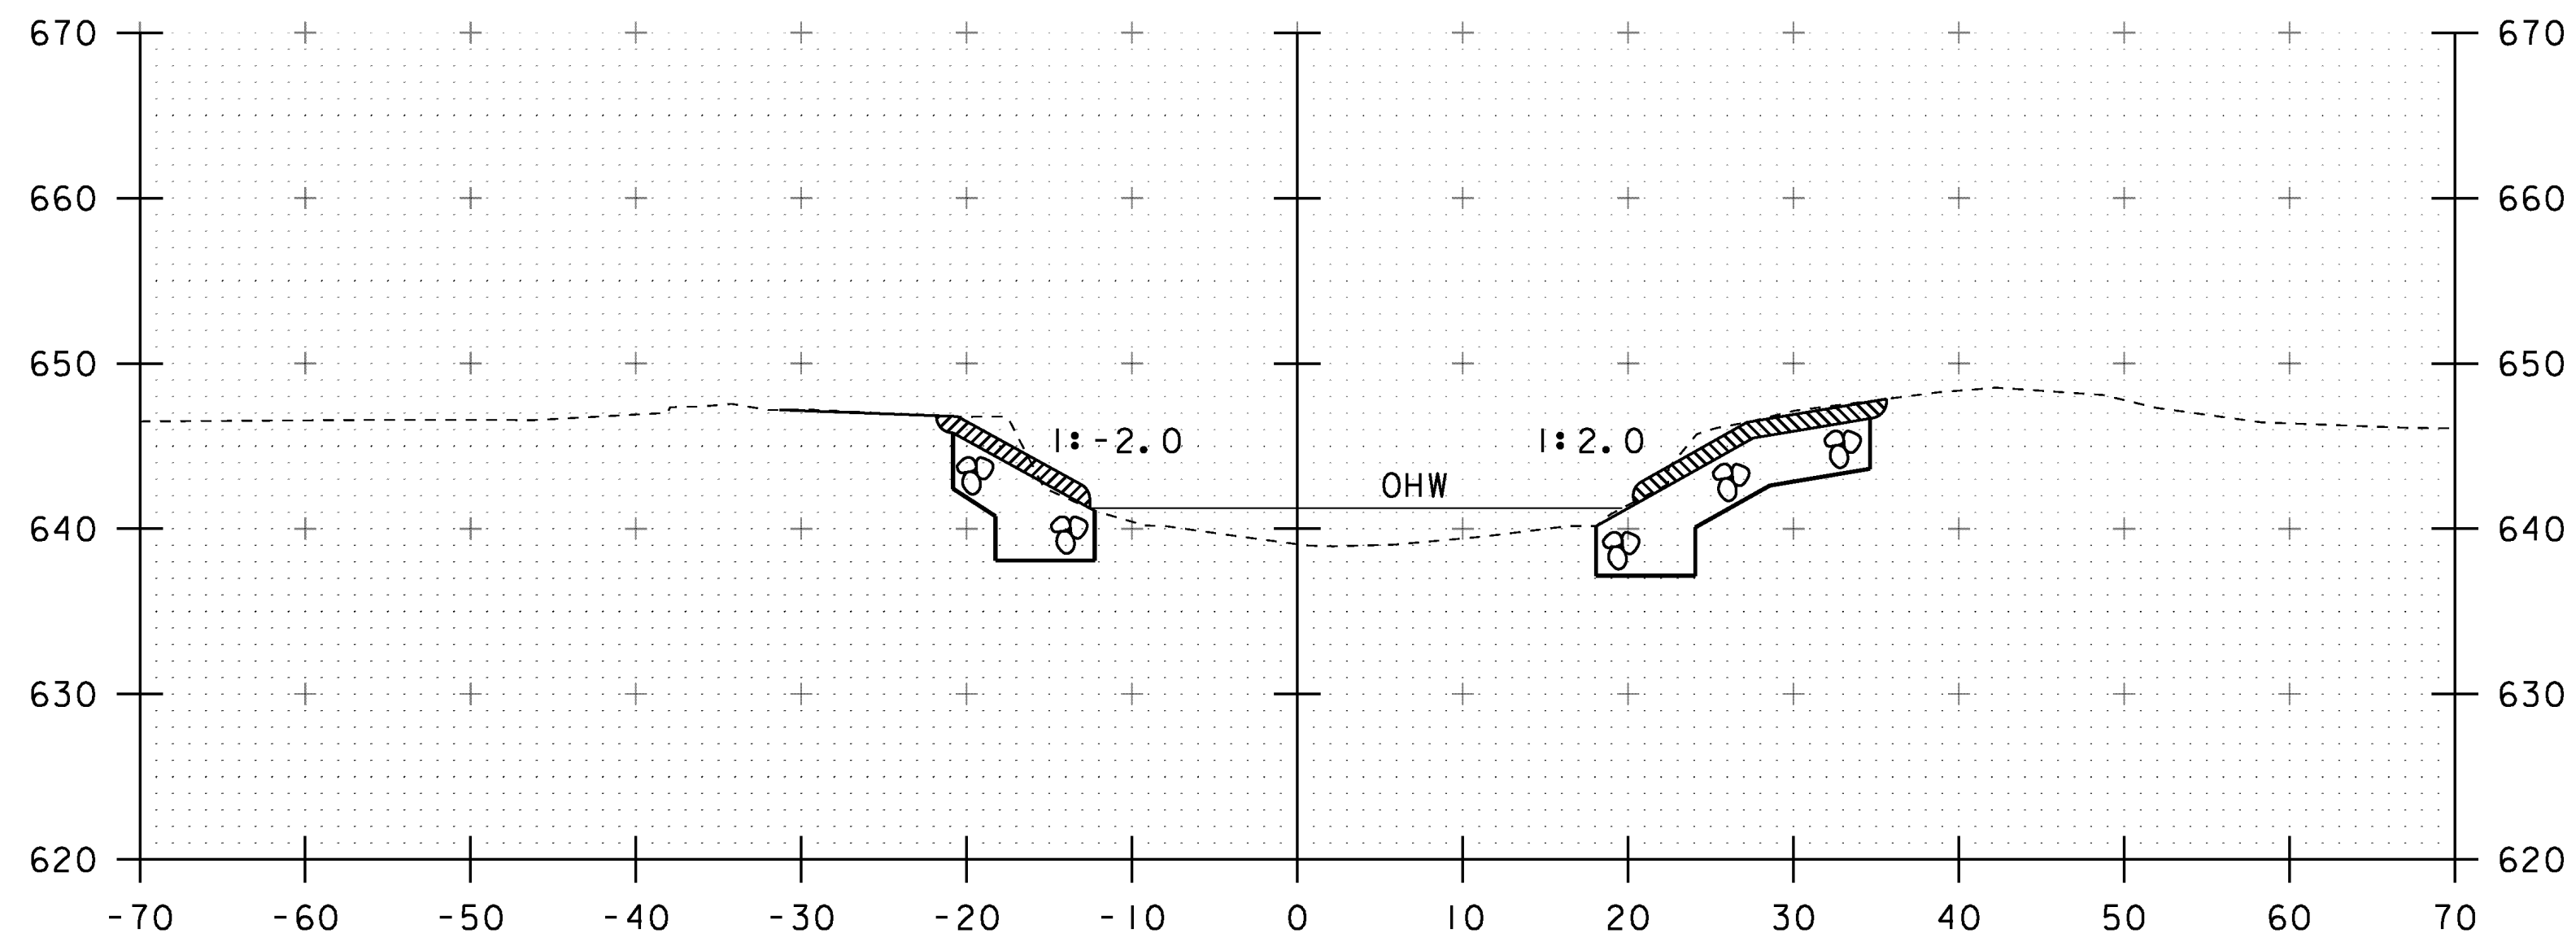


51+25

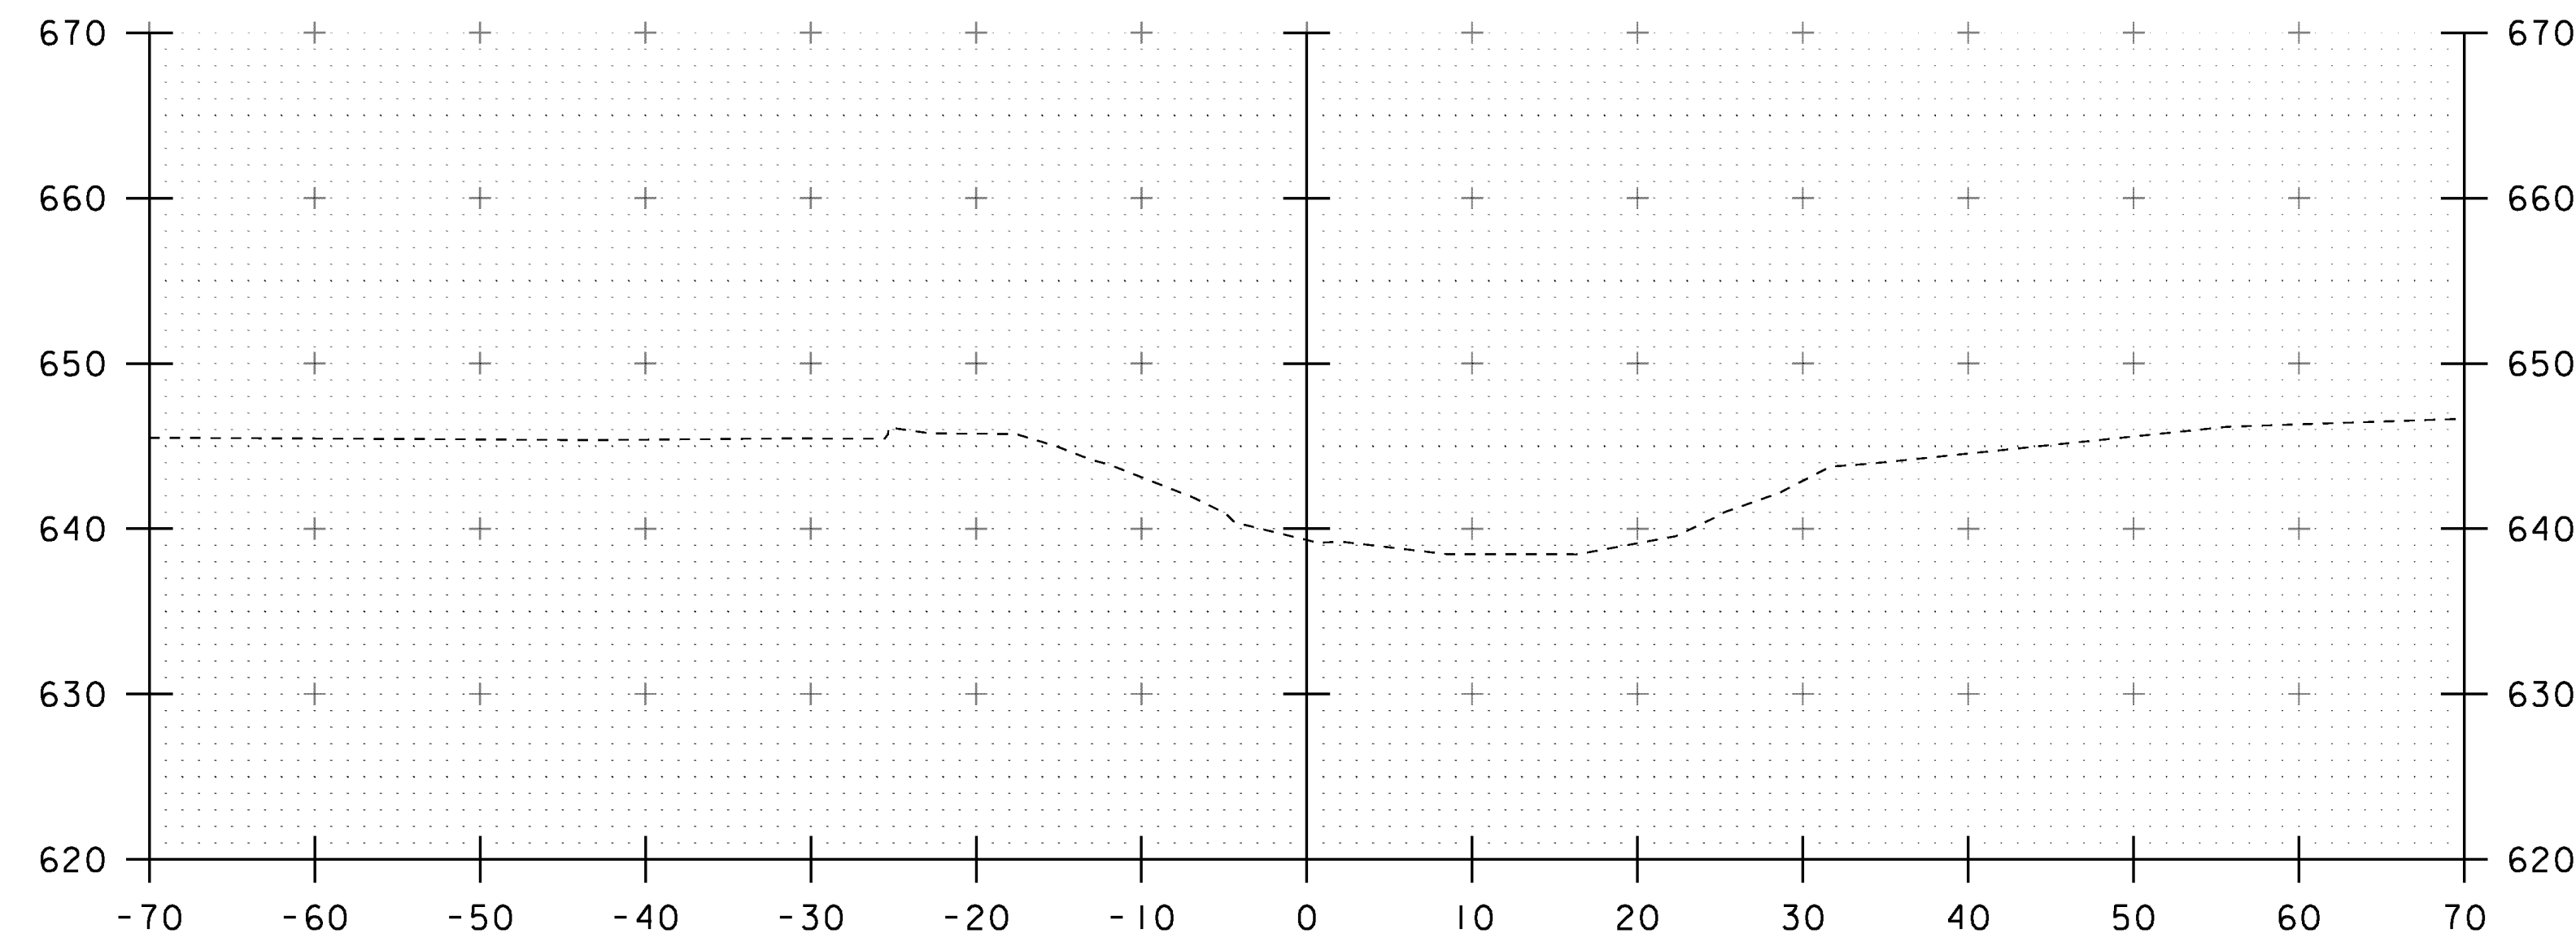

51+75

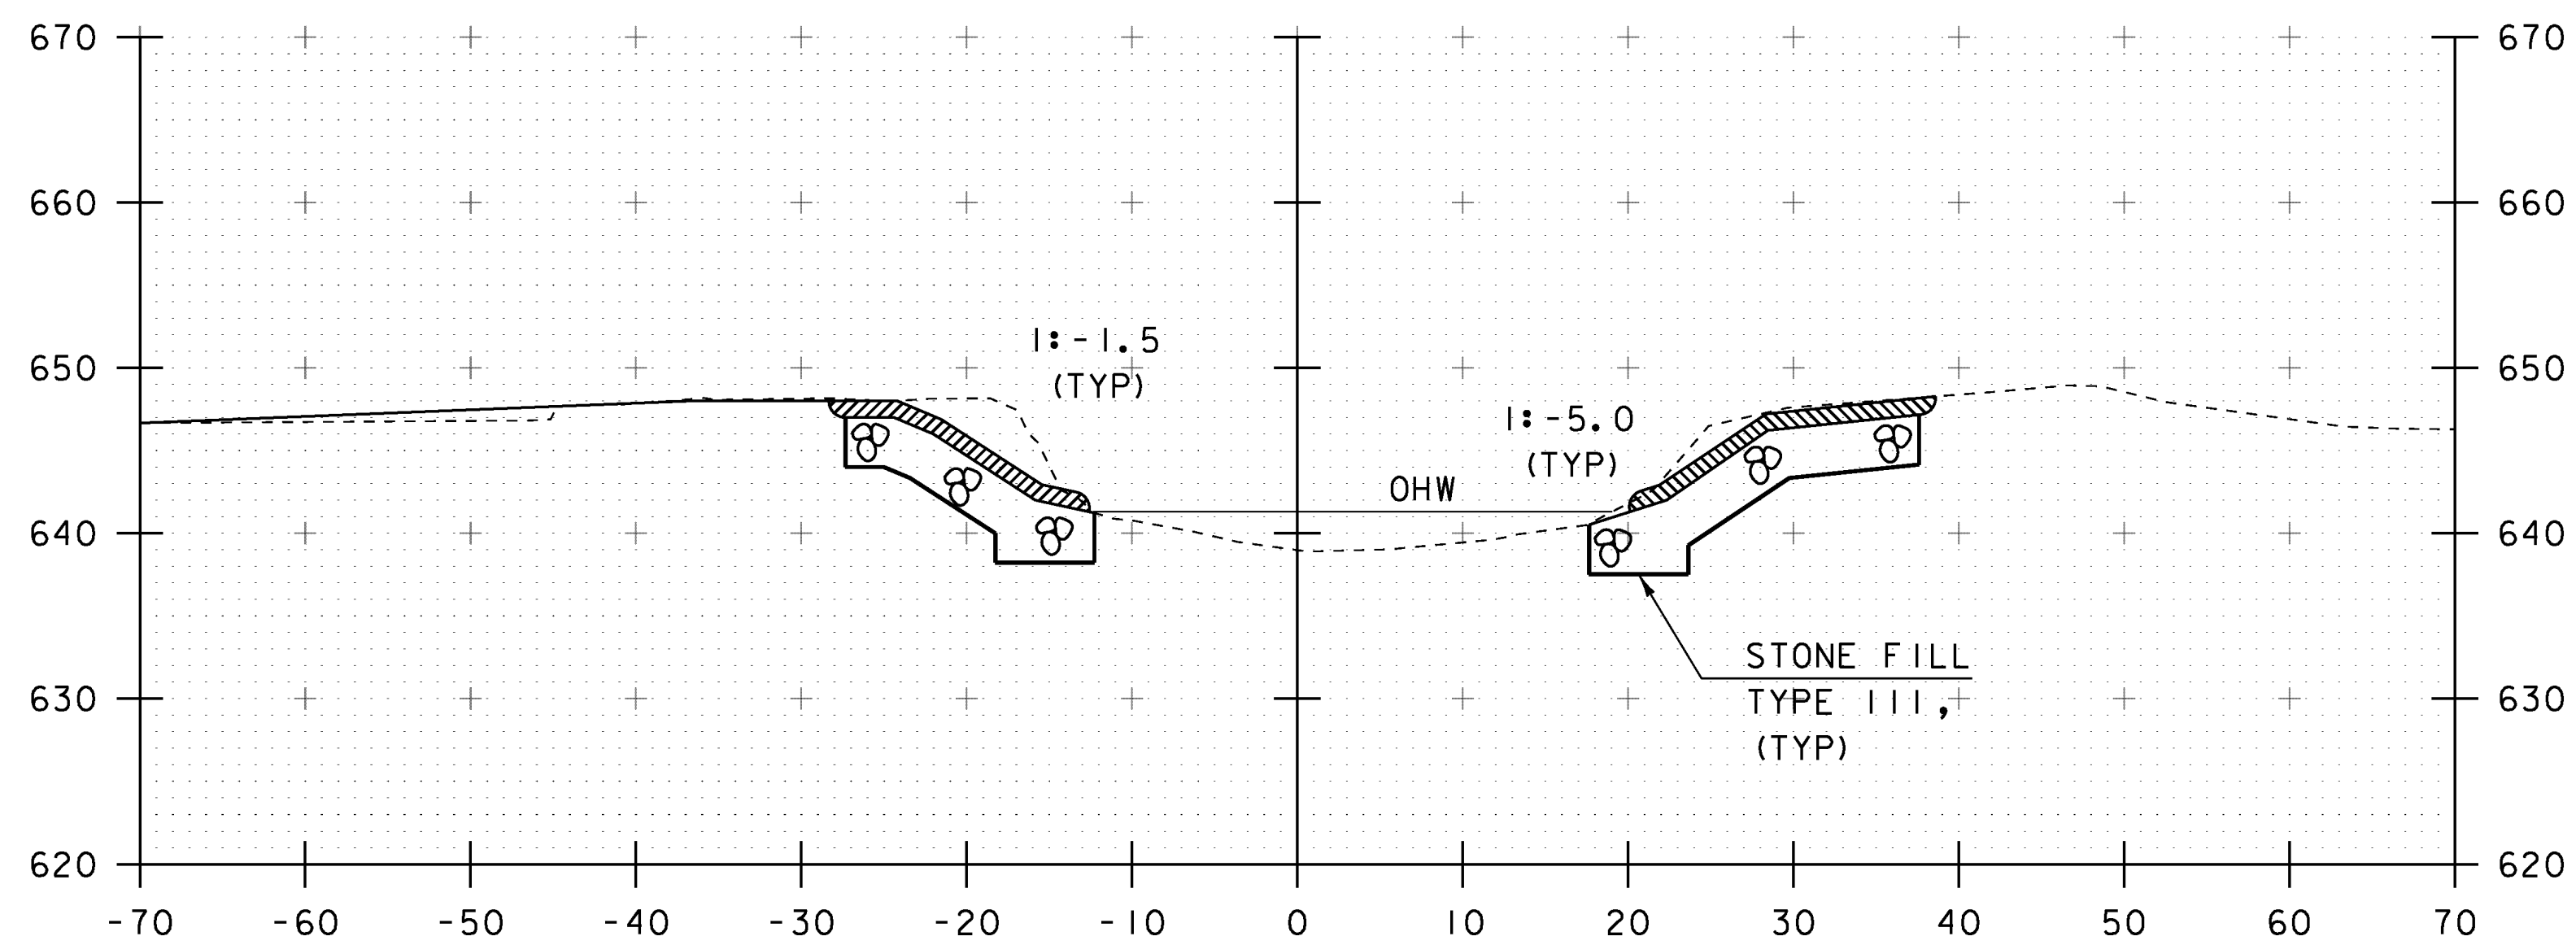

51+20

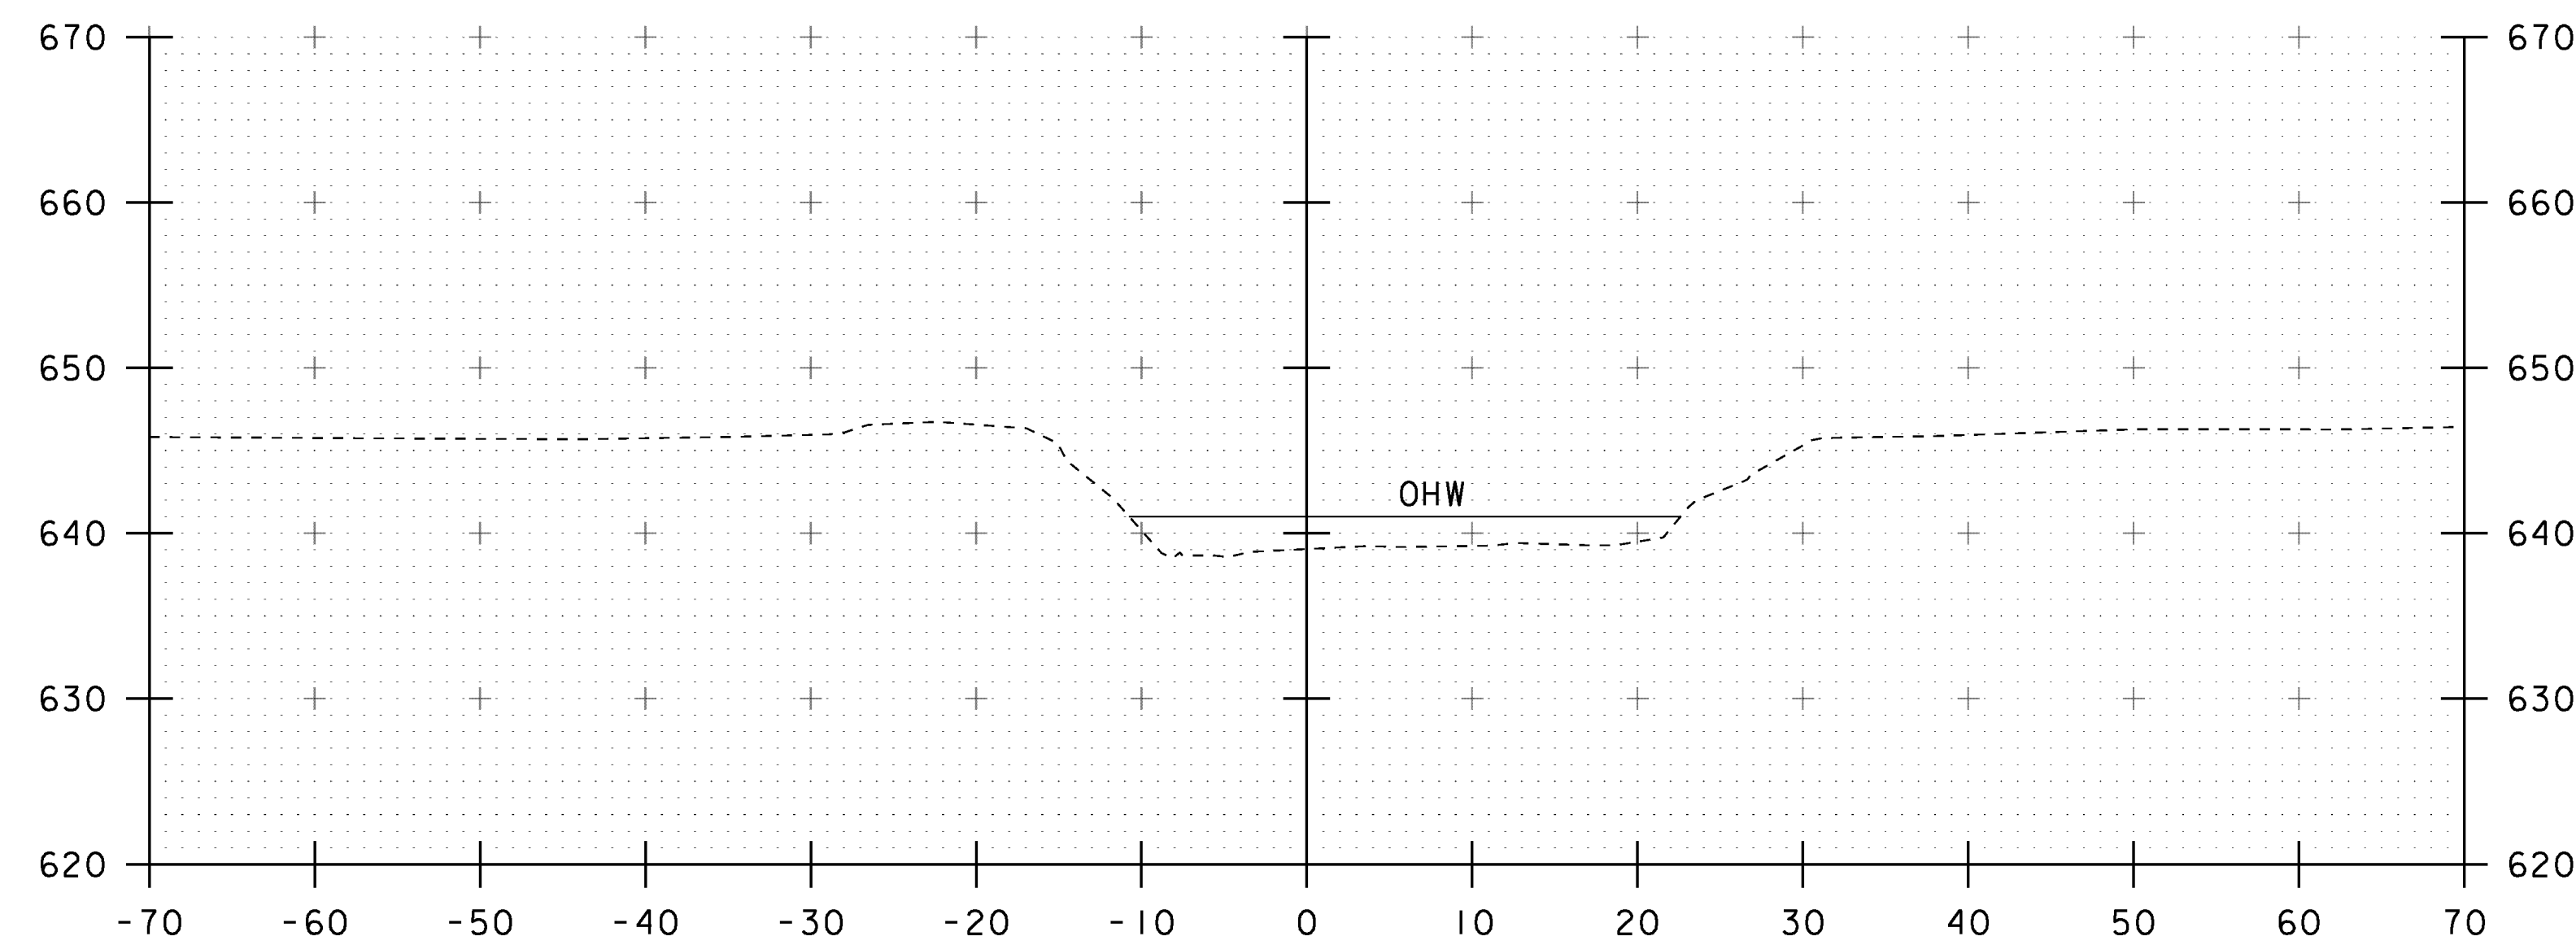

51+50

STA 51+30.00 LT (AB #1)  
 END UNCLASSIFIED CHANNEL EXCAVATION  
 END STONEFILL, TYPE III  
 END GEOTEXTILE UNDER STONE FILL  
 END GRUBBING MATERIAL

STA 51+35.00 RT (AB #2)  
 END UNCLASSIFIED CHANNEL EXCAVATION  
 END STONEFILL, TYPE III  
 END GEOTEXTILE UNDER STONE FILL  
 END GRUBBING MATERIAL

STA. 51+20 TO STA. 51+75

PROJECT NAME: CAMBRIDGE	
PROJECT NUMBER: BRO 1448(39)	
FILE NAME: s12j166xs.dgn	PLOT DATE: 29-AUG-2014
PROJECT LEADER: K. HIGGINS	DRAWN BY: G. LAROCHE
DESIGNED BY: G. LAROCHE	CHECKED BY: J. SALVATORI
CHANNEL SECTIONS 3	SHEET 32 OF 34

1  
**BUTLER, JOHN A. &  
 CAROL L. PENBERTHY**

2B  
**TISBERT, JOSEPH M. &  
 ANNE MARIE  
 joined by VERMONT LAND TRUST, INC.**

**END ROW PROJECT  
 BRO 1448 (39)  
 STA. 25+23 24.75' LT**

STA 26+00.00  
 N = 761527.8402  
 E = 1545474.1595

POB MAINLINE  
 STA 21+00.00  
 N = 761482.0396  
 E = 1544976.2616

FIELD LYMAN-TUNBRIDGE  
 FINE SANDY LOAMS  
 WITH 15%-25% SLOPES  
 "K" FACTOR = .24 -.28  
 VERY STONY


POE CHANNEL  
 STA 52+00.00  
 N = 761606.8095  
 E = 1545240.9453

BEGIN PROJECT  
 BEGIN PAVEMENT  
 STA 23+00.00

BEGIN BRIDGE  
 STA 23+47.67

END BRIDGE  
 STA 24+08.33

END PROJECT  
 END PAVEMENT  
 STA 24+50.00

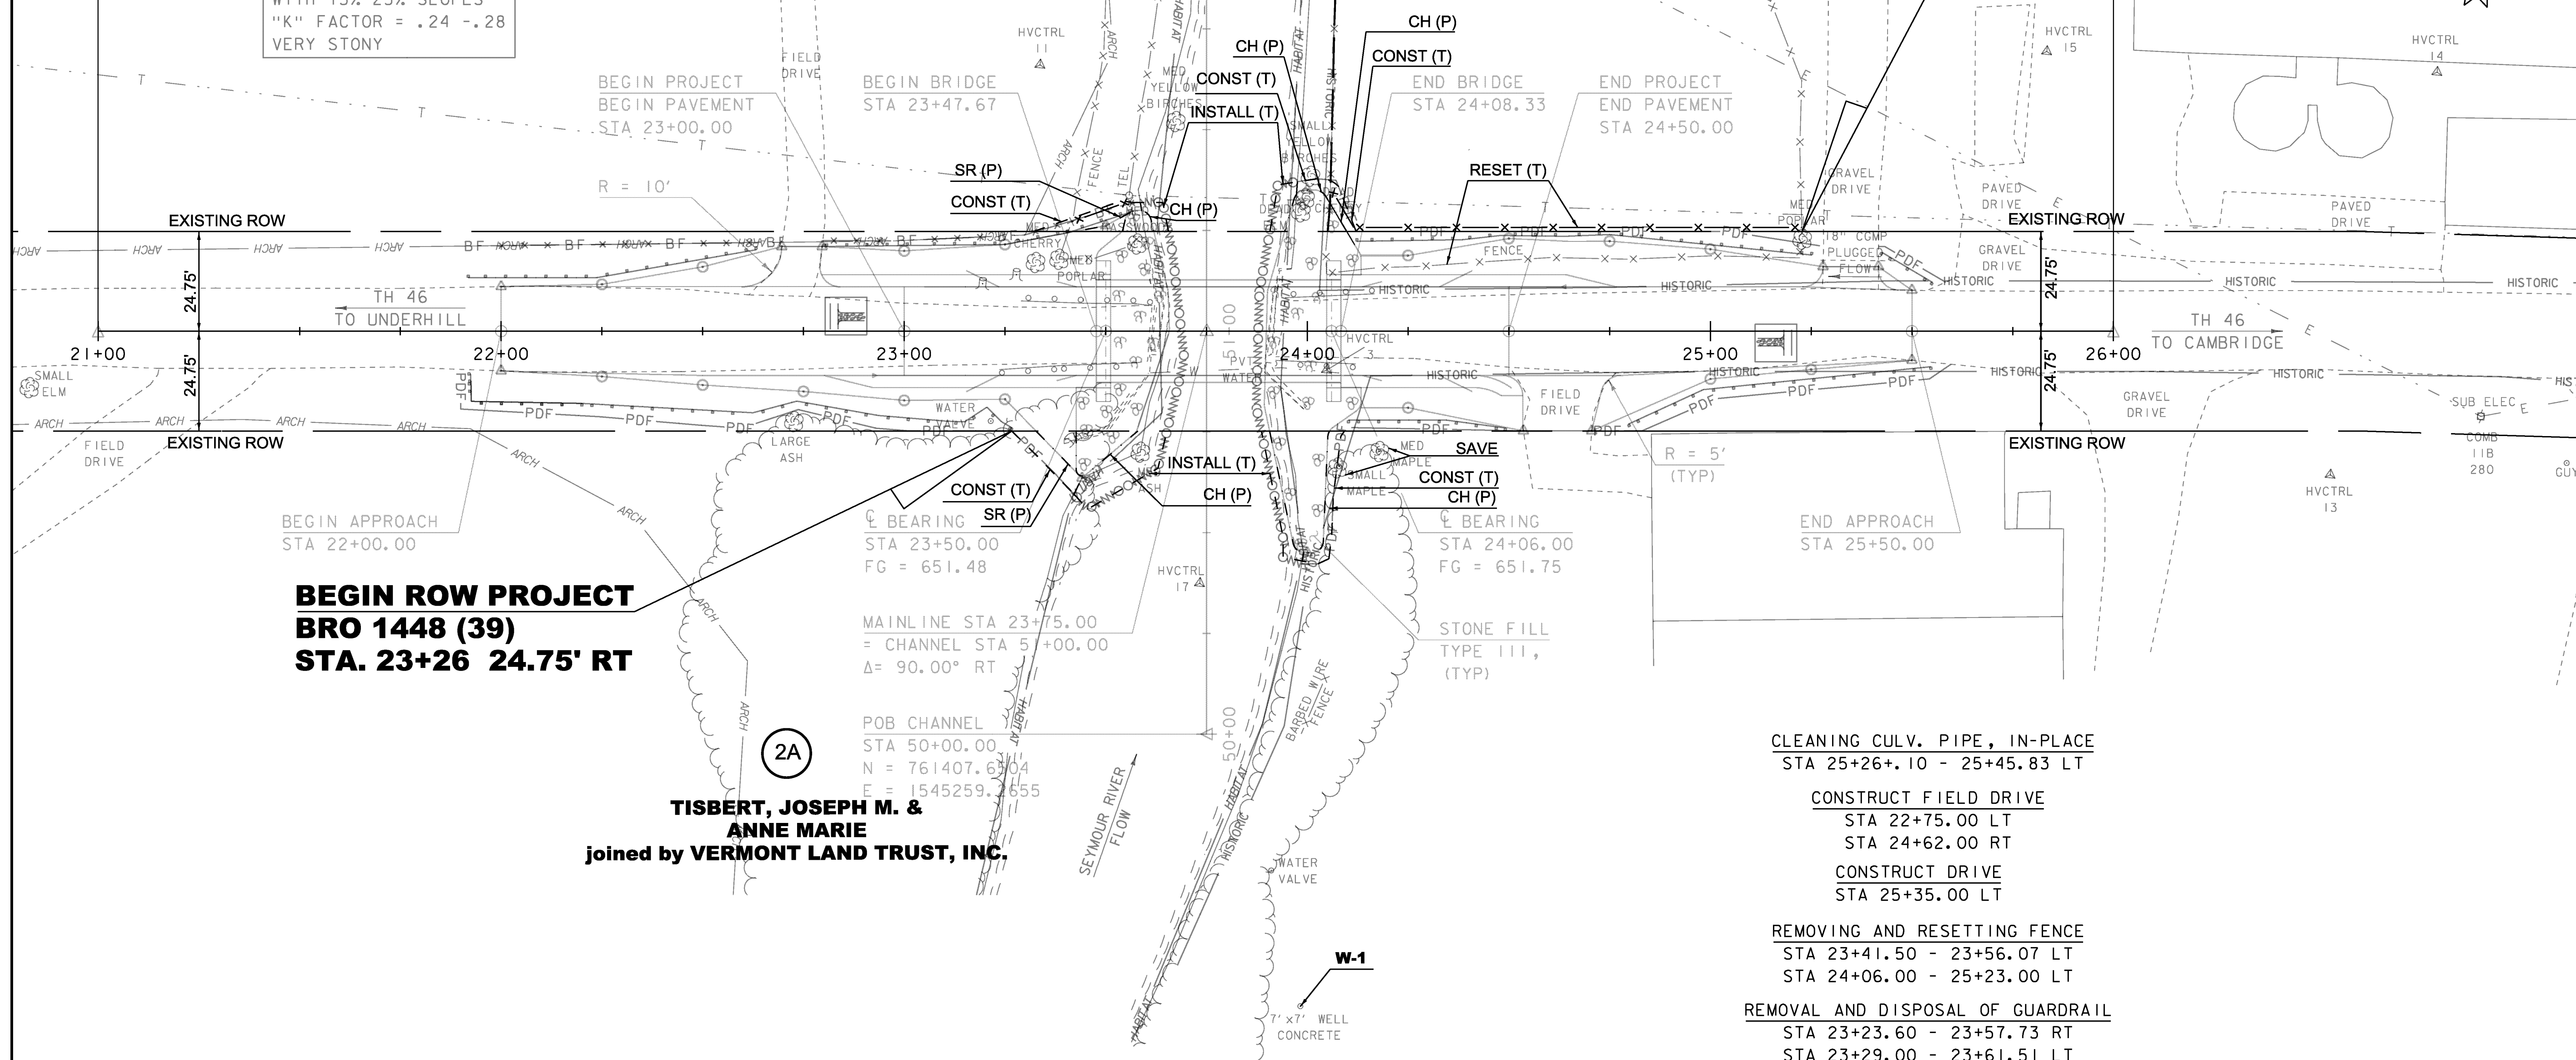

**BEGIN ROW PROJECT  
 BRO 1448 (39)  
 STA. 23+26 24.75' RT**

2A  
**TISBERT, JOSEPH M. &  
 ANNE MARIE  
 joined by VERMONT LAND TRUST, INC.**

- CLEANING CULV. PIPE, IN-PLACE  
 STA 25+26.10 - 25+45.83 LT
- CONSTRUCT FIELD DRIVE  
 STA 22+75.00 LT  
 STA 24+62.00 RT
- CONSTRUCT DRIVE  
 STA 25+35.00 LT
- REMOVING AND RESETTING FENCE  
 STA 23+41.50 - 23+56.07 LT  
 STA 24+06.00 - 25+23.00 LT
- REMOVAL AND DISPOSAL OF GUARDRAIL  
 STA 23+23.60 - 23+57.73 RT  
 STA 23+29.00 - 23+61.51 LT  
 STA 23+92.00 - 24+12.00 RT  
 STA 23+94.50 - 24+16.70 LT

LINES SHOWN ON THIS PLAN AS EXISTING  
 PROPERTY LINES P/L ARE BELIEVED TO  
 BE ACCURATE BUT SHOULD NOT BE RELIED  
 UPON FOR PURPOSES UNRELATED TO THE  
 TOWN OF CAMBRIDGE'S ACQUISITION OF  
 LAND AND RIGHTS FOR THIS PROJECT.

**FOR R.O.W.  
 USE ONLY**

LAYOUT SHEET  
 SCALE 1" = 20' - 0"  
 20 0 20

PROJECT NAME: CAMBRIDGE  
 PROJECT NUMBER: BRO 1448 (39)  
 FILE NAME: r12j166lay.dgn  
 PROJECT LEADER: K. HIGGINS  
 DESIGNED BY: G. LAROCHE  
 ROW LAYOUT SHEET 1 OF 1  
 PLOT DATE: 29-AUG-2014  
 DRAWN BY: A. EGIZI  
 CHECKED BY: R. CLOUTIER  
 SHEET 33 OF 34

# RIGHT - OF - WAY DETAIL SHEET

TABLE OF PROPERTY ACQUISITION

PARCEL NO.	PROPERTY OWNER	ROW LAYOUT NO.	BEGINNING STATION	ENDING STATION	TAKE	REMAINDER	RIGHT			RECORDING DATA					REMARKS		
					AREA±	AREA±	TYPE	T / P	AREA ±	TITLE	DATE	TOWN / CITY	BOOK	PAGE			
1	BUTLER, JOHN A. & CAROL L. PENBERTHY	1	23+33 LT	23+59 LT			CONST	T	80 SF							INCL. BF, RESETTING FENCE	
			23+42 LT	23+56 LT			SLOPE	P	18 SF								INCL. EC
			23+59 LT	23+66 LT			INSTALL	T	32 SF								FILTER CURTAIN
			23+54 LT	23+62 LT			CHANNEL	P	32 SF								INCL. STONE FILL
			23+91 LT	23+98 LT			INSTALL	T	52 SF								FILTER CURTAIN
			23+94 LT	24+06 LT			CHANNEL	P	94 SF								INCL. STONE FILL
			23+98 LT	24+06 LT			CONST	T	26 SF								INCL. PDF
2A	TISBERT, JOSEPH M. & ANNE MARIE, joined by VERMONT LAND TRUST, INC.	1	23+26 RT	23+44 RT			CONST	T	80 SF	WDOE	06/17/14	CAMBRIDGE	400	334-337		INCL. PDF	
			23+33 RT	23+43 RT			SLOPE	P	51 SF								INCL. EC
			23+42 RT	23+65 RT			INSTALL	T	212 SF								FILTER CURTAIN
			23+43 RT	23+58 RT			CHANNEL	P	96 SF								INCL. STONE FILL
			23+89 RT	23+99 RT			INSTALL	T	74 SF								FILTER CURTAIN
			23+91 RT	24+06 RT			CHANNEL	P	320 SF								INCL. STONE FILL
			23+98 RT														MONITOR WELL W-1
			23+99 RT	24+09 RT			CONST	T	88 SF								INCL. PDF
2B		1	24+05 LT	24+10 LT			CHANNEL	P	16 SF							INCL. STONE FILL	
			24+06 LT	24+12 LT			CONST	T	35 SF								INCL. PDF
			24+06 LT	25+23 LT			RESET	T									FENCE
3	VERMONT ELECTRIC COOPERATIVE, INC.	1													UTILITY		
4	FAIRPOINT COMMUNICATIONS, INC.	1													UTILITY		

TABLE OF REVISIONS


REVISION NO.	ROW SET SHEET #	DESCRIPTION	DATE
1	3, 4	PARCEL 2, TISBERT - ADDED CLAUSE TO PROPERTY OWNER NAME BY: MT C.O. 9862 APPR BY: RC	02/12/14
2	3, 4	PARCEL 2, TISBERT - CHANGED NAME FROM AMERICAN FARMLAND TRUST, INC. TO VERMONT LAND TRUST, INC. BY: MT C.O. 9884 APPR BY: RC	05/12/14

APPROVED: RYAN CLOUTIER DATE: 12-04-13  
CHIEF, PLANS & TITLES


PROJECT NAME: **CAMBRIDGE**  
PROJECT NUMBER: **BRO 1448 (39)**  
FILE NAME: **r12j166Detail.xls** PLOT DATE: **29-AUG-2014**  
PROJECT LEADER: **K. HIGGINS** DRAWN BY: **M. TROTTIER**  
DESIGNED BY: **R. WHITE** CHECKED BY: **A. EGZI**  
R.O.W. DETAIL SHEET #1 SHEET **34** OF **34**

**CONCRETE GENERAL NOTES**

1. ALL EXPOSED EDGES OF CONCRETE SHALL BE CHAMFERED 1" x 1"
2. REINFORCING STEEL SIZE AND SPACING SHOWN IN THE PLANS IS BASED ON 60 KSI STEEL, UNLESS NOTED OTHERWISE. WITH THE ENGINEER'S PERMISSION, BAR SIZE AND SPACING MAY BE MODIFIED ACCORDING TO THE LATEST AASHTO LRFD BRIDGE DESIGN SPECIFICATION AND STRUCTURES DESIGN MANUAL WHEN USING HIGHER STRENGTH STEEL.

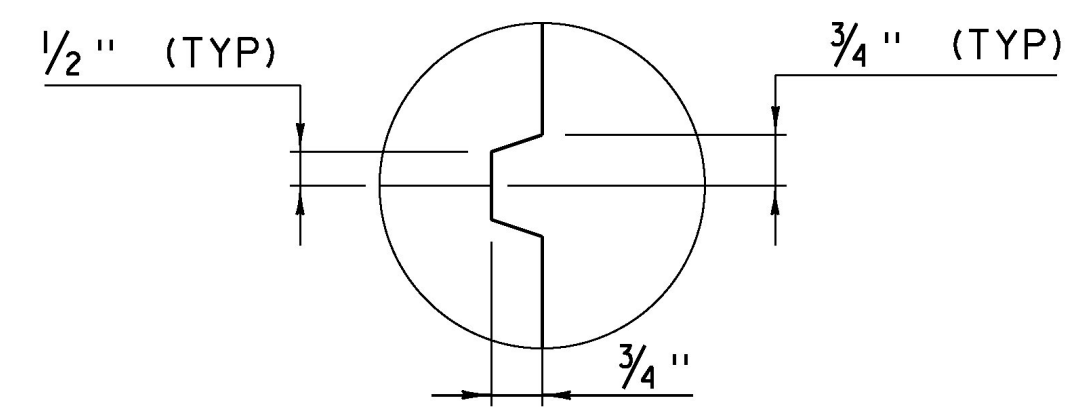


**SCORE MARK DETAIL**  
(NOT TO SCALE)

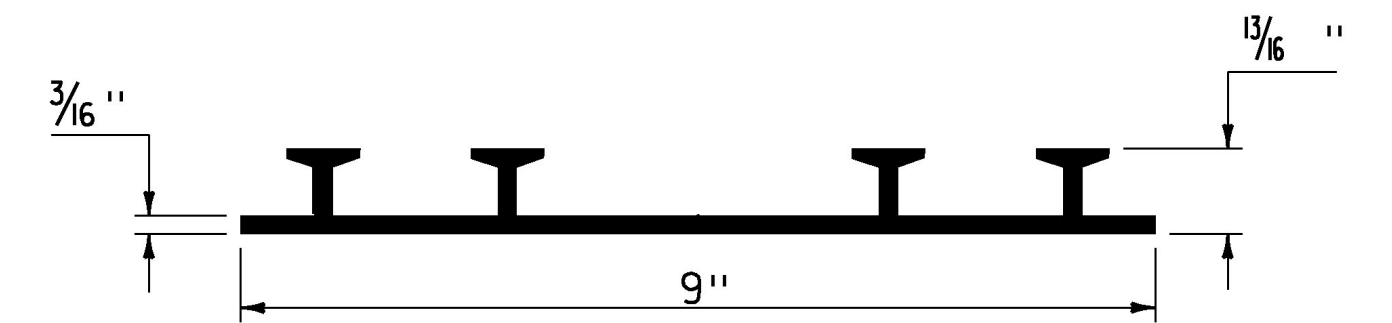

**P.V.C. WATERSTOP FOR CONSTRUCTION JOINTS**  
(NOT TO SCALE)


PAYMENT FOR THE P.V.C. WATERSTOP SHALL BE INCIDENTAL TO THE UNIT BID PRICE FOR THE ADJACENT CONCRETE.

OTHER CONFIGURATIONS OF WATERSTOP MAY BE USED UPON APPROVAL OF THE ENGINEER.

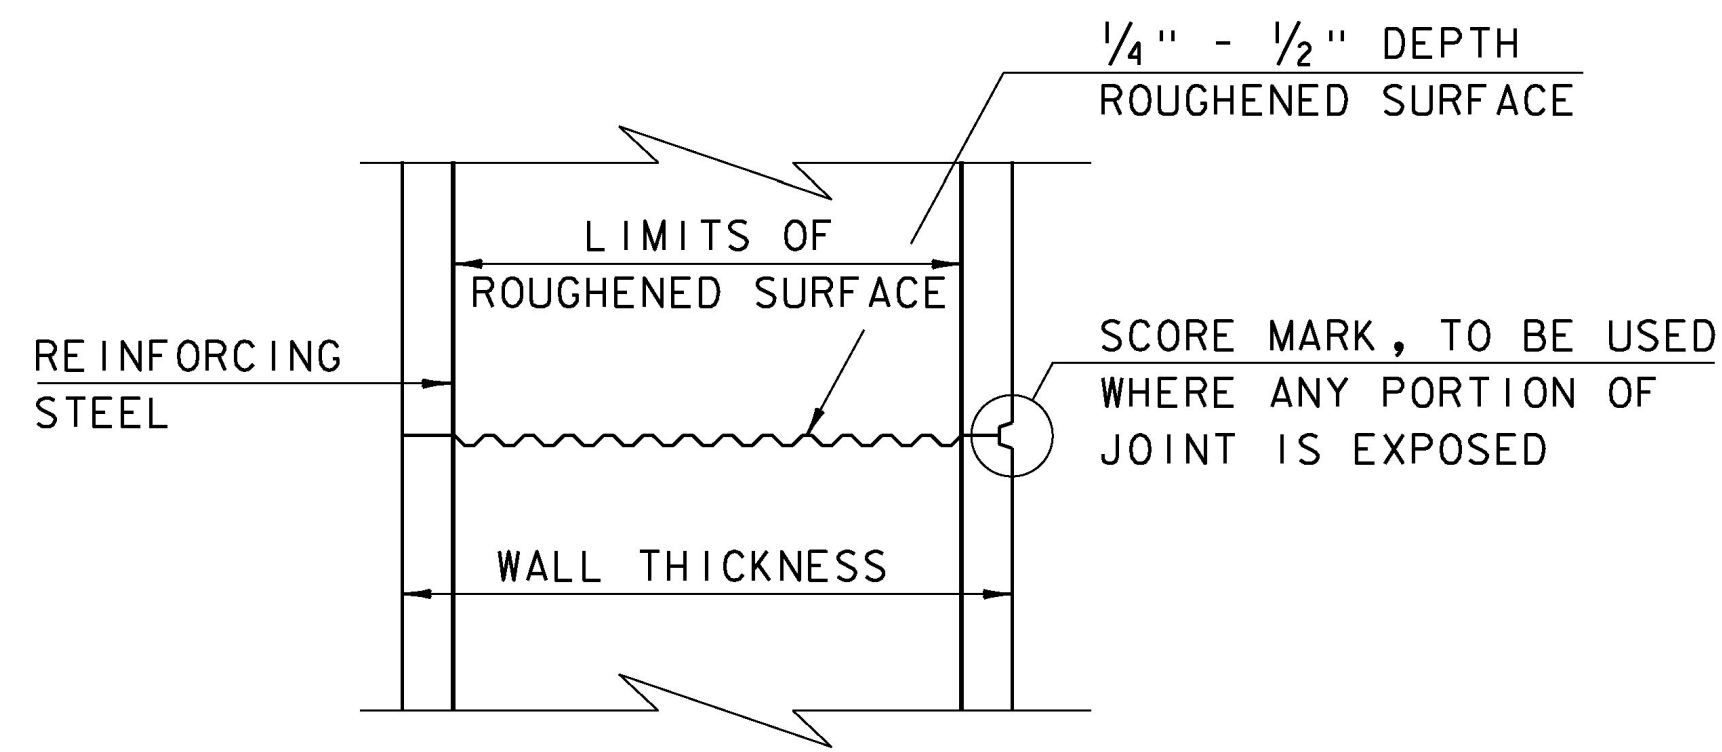


**TYPICAL HORIZONTAL CONSTRUCTION JOINT**  
(NOT TO SCALE)

1. THE SURFACE OF THE CONCRETE CONSTRUCTION JOINTS SHALL BE CLEANED AND FREE OF LAITANCE.
2. IMMEDIATELY BEFORE NEW CONCRETE IS PLACED, ALL CONSTRUCTION JOINTS SHALL BE WETTED AND STANDING WATER REMOVED.

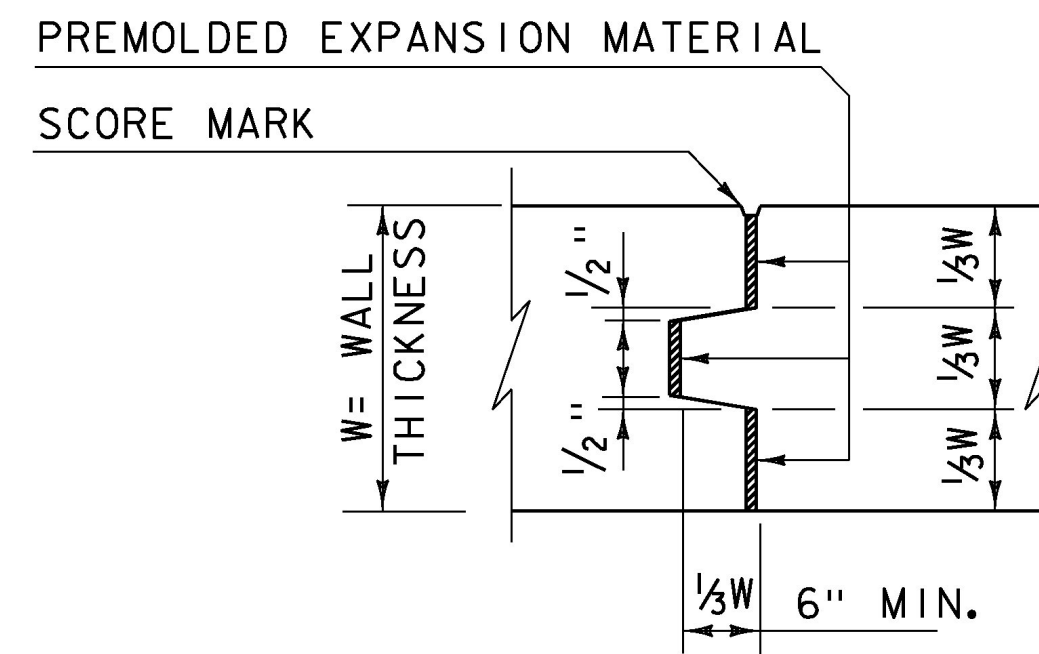


**TYPICAL CONCRETE EXPANSION JOINT**  
(NOT TO SCALE)

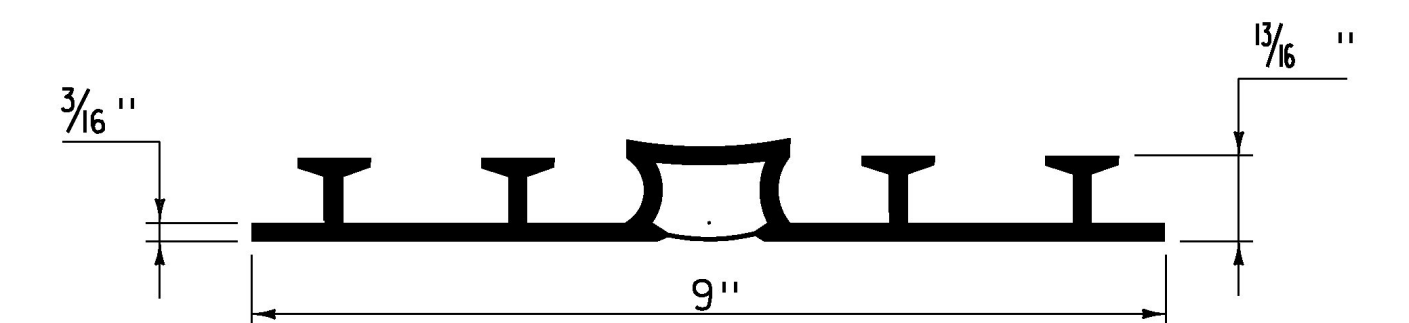


**P.V.C. WATERSTOP FOR EXPANSION JOINTS**  
(NOT TO SCALE)

PAYMENT FOR THE P.V.C. WATERSTOP SHALL BE INCIDENTAL TO THE UNIT BID PRICE FOR THE ADJACENT CONCRETE.


OTHER CONFIGURATIONS OF WATERSTOP MAY BE USED UPON APPROVAL OF THE ENGINEER.

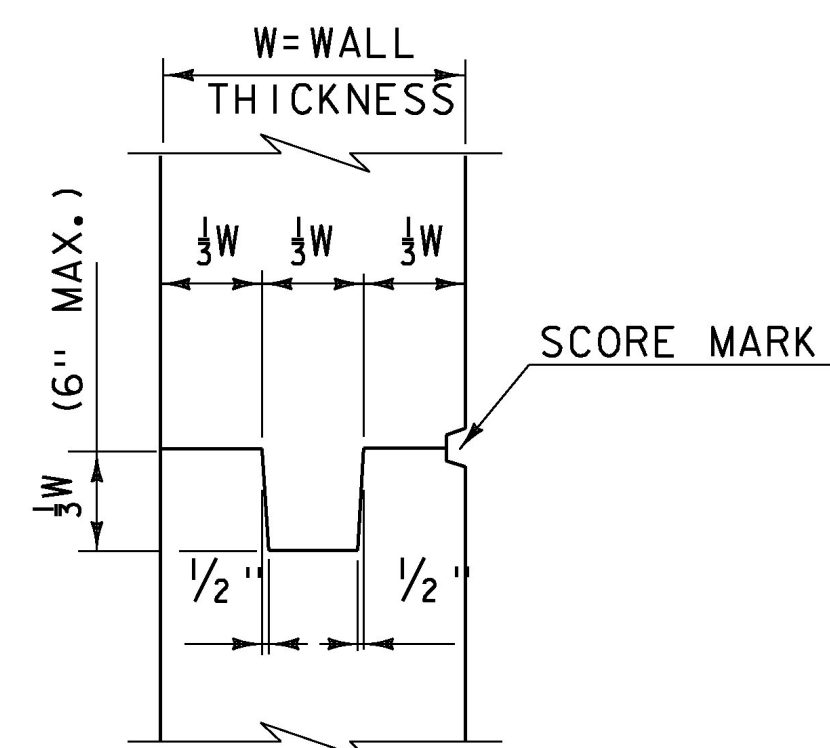

**TYPICAL CONCRETE CONSTRUCTION JOINT**  
(NOT TO SCALE)

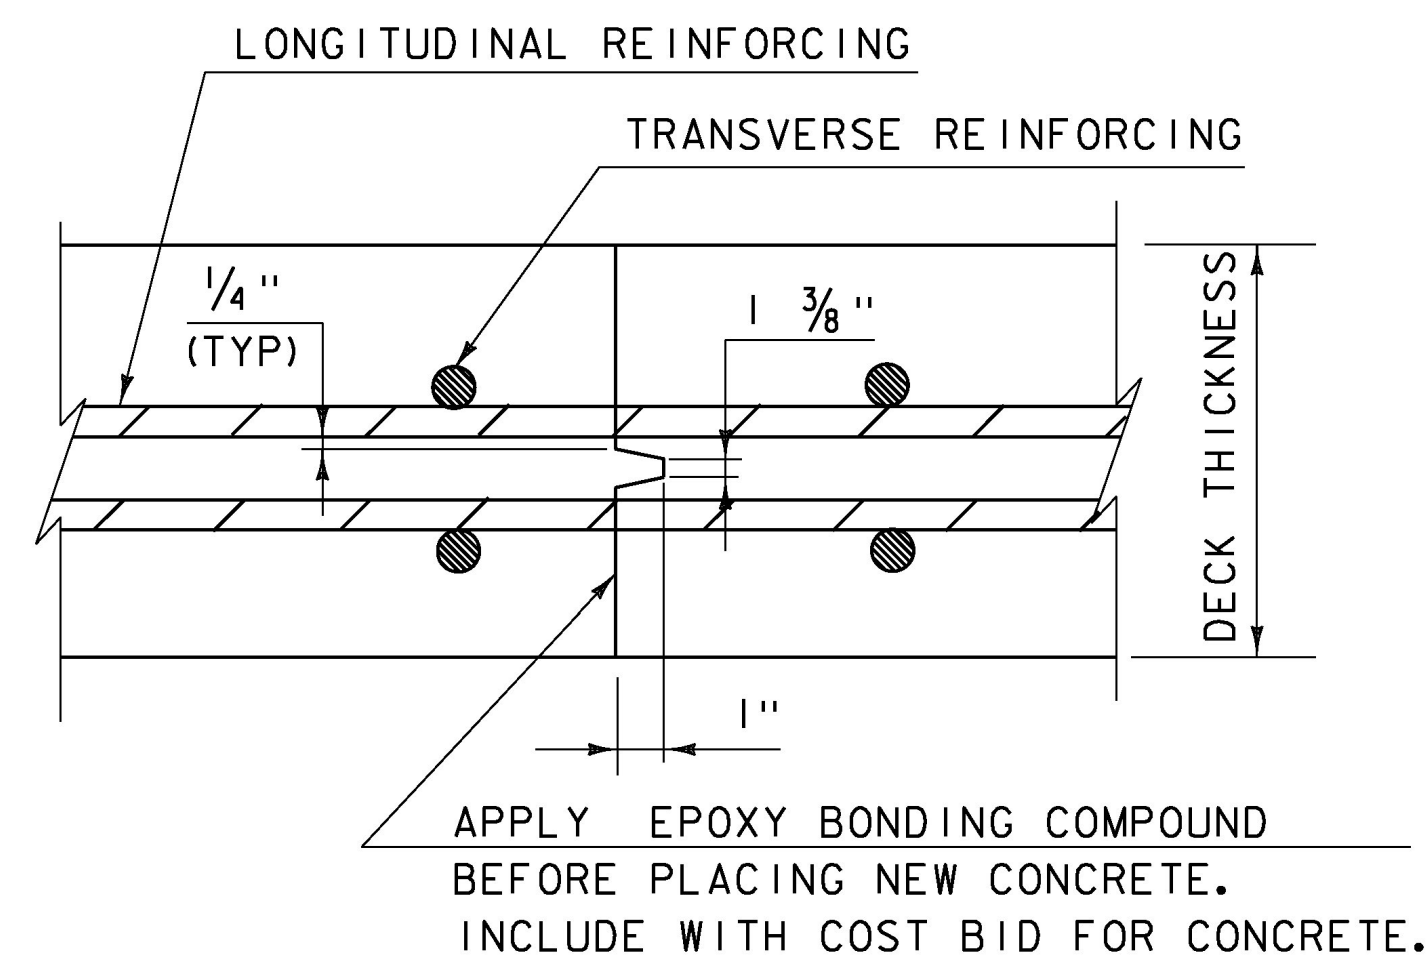


**TRANSVERSE BRIDGE SLAB CONSTRUCTION JOINT DETAILS**  
(NOT TO SCALE)

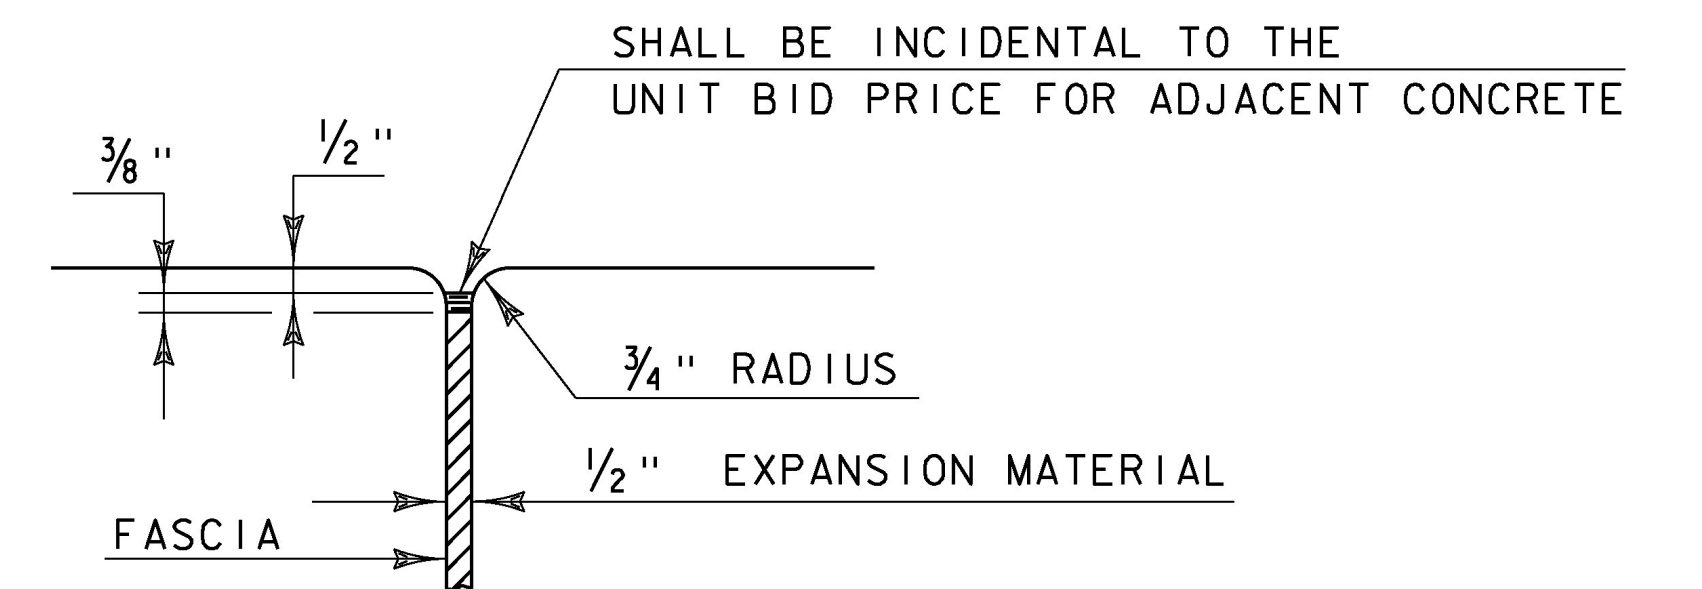

**JOINT BETWEEN FASCIA AND WINGWALL**  
(NOT TO SCALE)

REVISIONS	
MAY 7, 2010	APPROVED FOR USE BY VAOT STRUCTURES SECTION
FEBRUARY 9, 2012	REBAR SUBSTITUTION ALLOWANCE ADDED TO CONCRETE GENERAL NOTES.

**CONCRETE  
DETAILS AND NOTES**

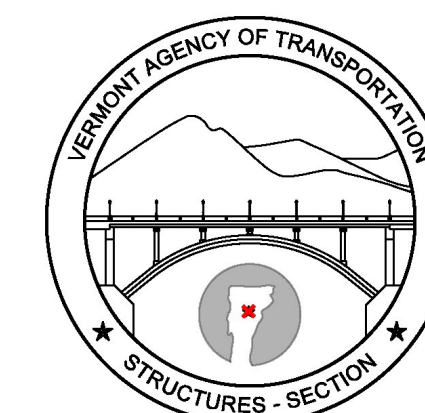


**STRUCTURES  
DETAIL  
SD-501.00**


POLYURETHANE JOINT SEALER MEETING THE REQUIREMENTS OF SECTION 524. COLOR TO MATCH CONCRETE. PAYMENT TO BE INCIDENTAL TO THE BRIDGE CURB CONCRETE ITEM

ADHERE TO THESE SURFACES

DETAIL "B"  
(NOT TO SCALE)

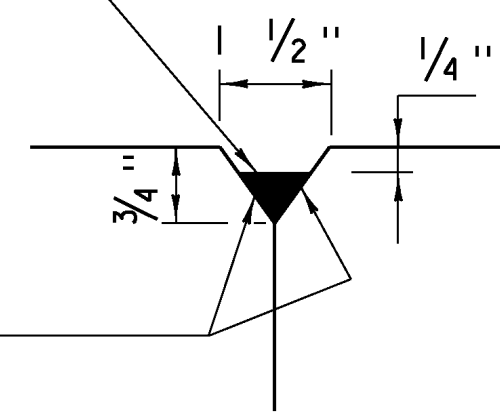


1/4" - 1/2" DEPTH  
ROUGHENED SURFACE

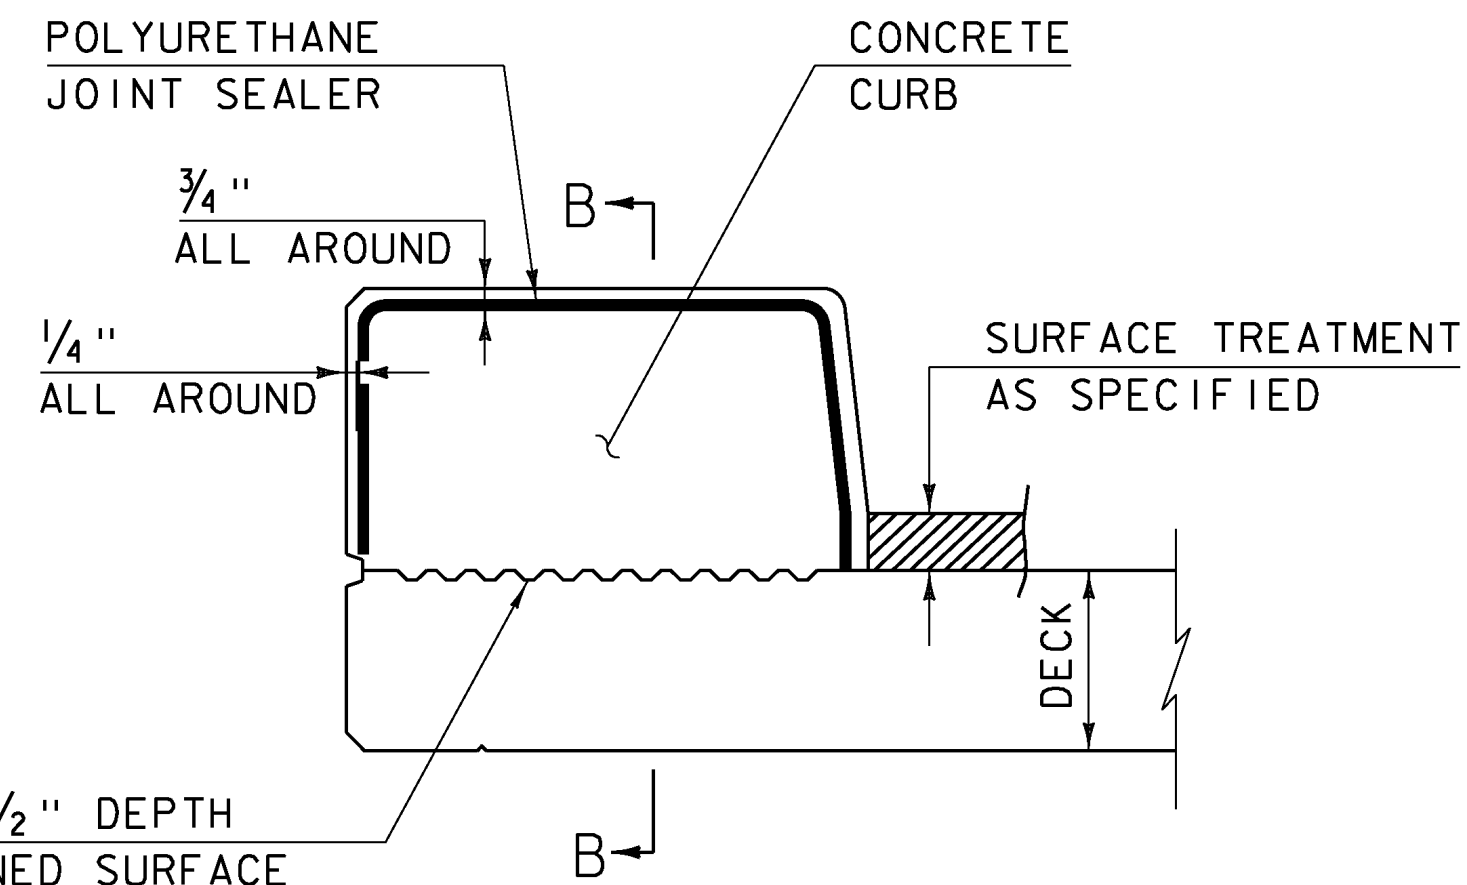


CONCRETE CURB JOINT SECTION  
(NOT TO SCALE)

1. SEE TYPICAL HORIZONTAL CONSTRUCTION JOINT DETAIL FOR ADDITIONAL INFORMATION

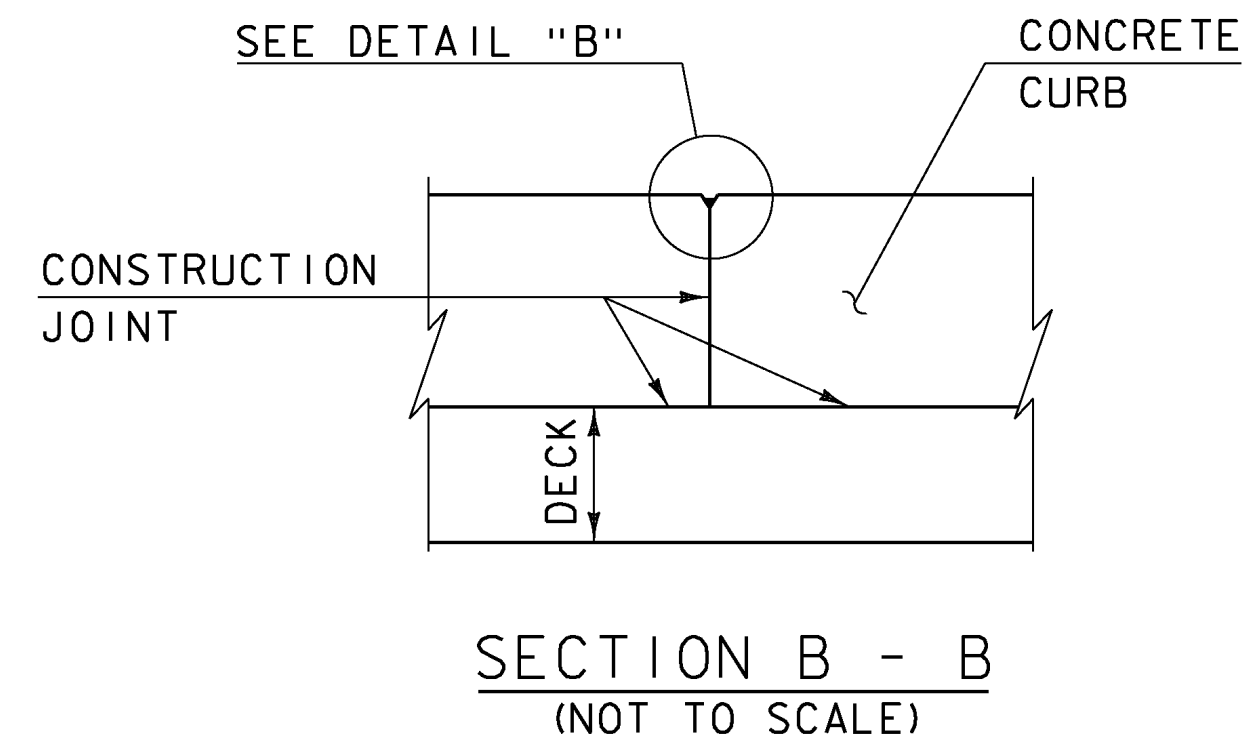


SECTION B - B  
(NOT TO SCALE)

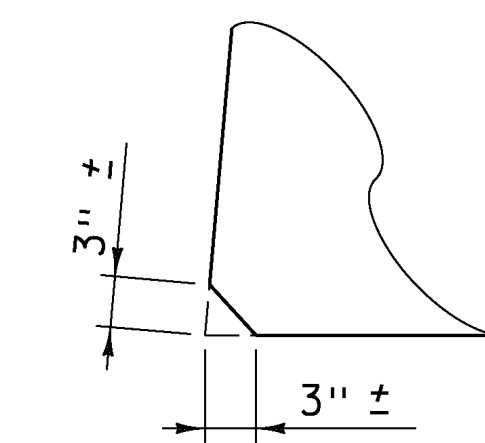


ACUTE ANGLE  
CLIP DETAIL  
(NOT TO SCALE)

CONCRETE CURB JOINT NOTES


1. CONCRETE CURBS MAY BE PLACED IN ONE CONTINUOUS OPERATION IF AN APPROVED SHRINKAGE REDUCING ADMIXTURE LISTED IN THE SPECIAL PROVISIONS IS USED WITH THE CONCRETE MIX DESIGN. PAYMENT FOR THE SHRINKAGE REDUCING ADMIXTURE WILL BE INCIDENTAL TO THE BRIDGE CURB CONCRETE ITEM.
2. IF THE CONTRACTOR CHOOSES NOT TO USE AN APPROVED SHRINKAGE REDUCING ADMIXTURE, THE CURBS SHALL BE CONSTRUCTED WITH CONSTRUCTION JOINTS SPACED AT A MAXIMUM OF 15'-0" CENTER TO CENTER AND 2'-0" MINIMUM FROM THE CENTER OF NEAREST BRIDGE RAILING POST.
3. ON MULTI-SPAN CONTINUOUS SUPERSTRUCTURES, REGARDLESS OF WHETHER APPROVED SHRINKAGE REDUCING ADMIXTURE IS USED, CURB JOINTS SHALL BE LOCATED OVER THE CENTERLINE OF PIERS AND 7'-0" EACH SIDE OF THE CENTERLINE OF EACH PIER.
4. WHEN CURB JOINTS ARE USED THE CURBS SHALL BE PLACED IN ALTERNATE SECTIONS WITH A MINIMUM OF 48 HOUR DELAY BETWEEN ADJACENT PLACEMENTS.
5. LONGITUDINAL REINFORCING SHALL BE CONTINUOUS THROUGH CURB CONSTRUCTION JOINTS. CURB STIRRUP BARS SHALL BE TURNED AS NECESSARY TO MAINTAIN COVER IN THE FLARED CURB ENDS.
6. THE JOINT SPACING AND DETAILS SHOWN SHALL APPLY TO SIDEWALKS WHEN SHOWN IN THE PLANS.

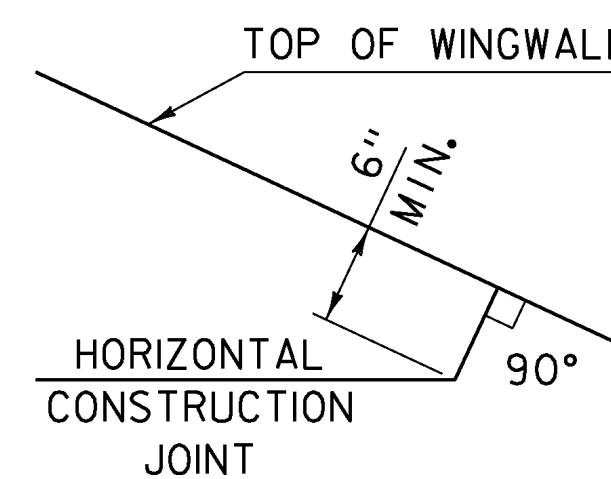


HORIZONTAL WINGWALL  
CONSTRUCTION JOINT  
(NOT TO SCALE)

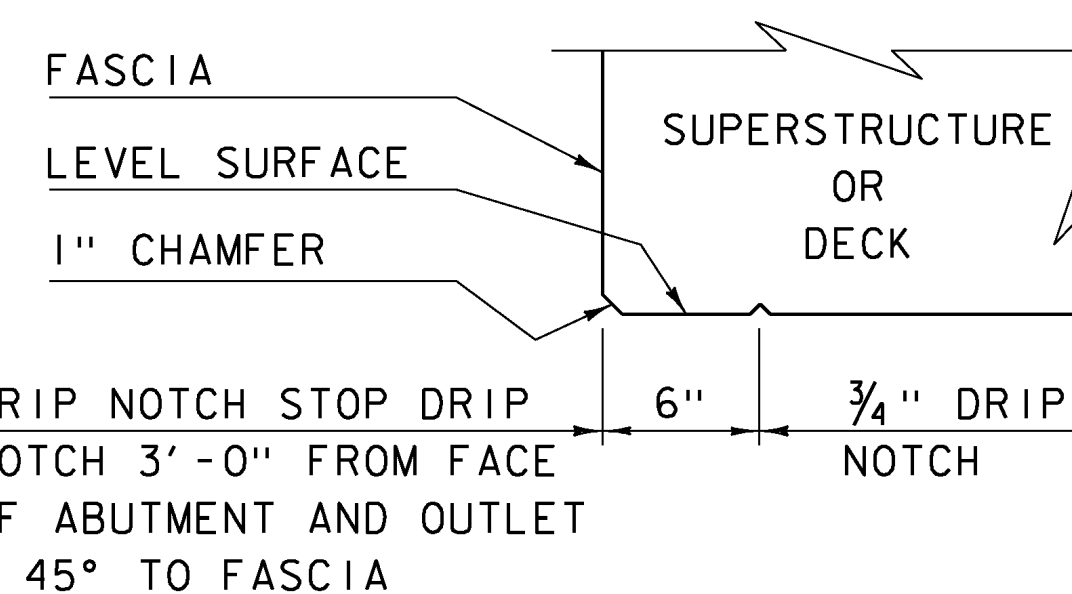

DRIP NOTCH DETAIL  
(NOT TO SCALE)

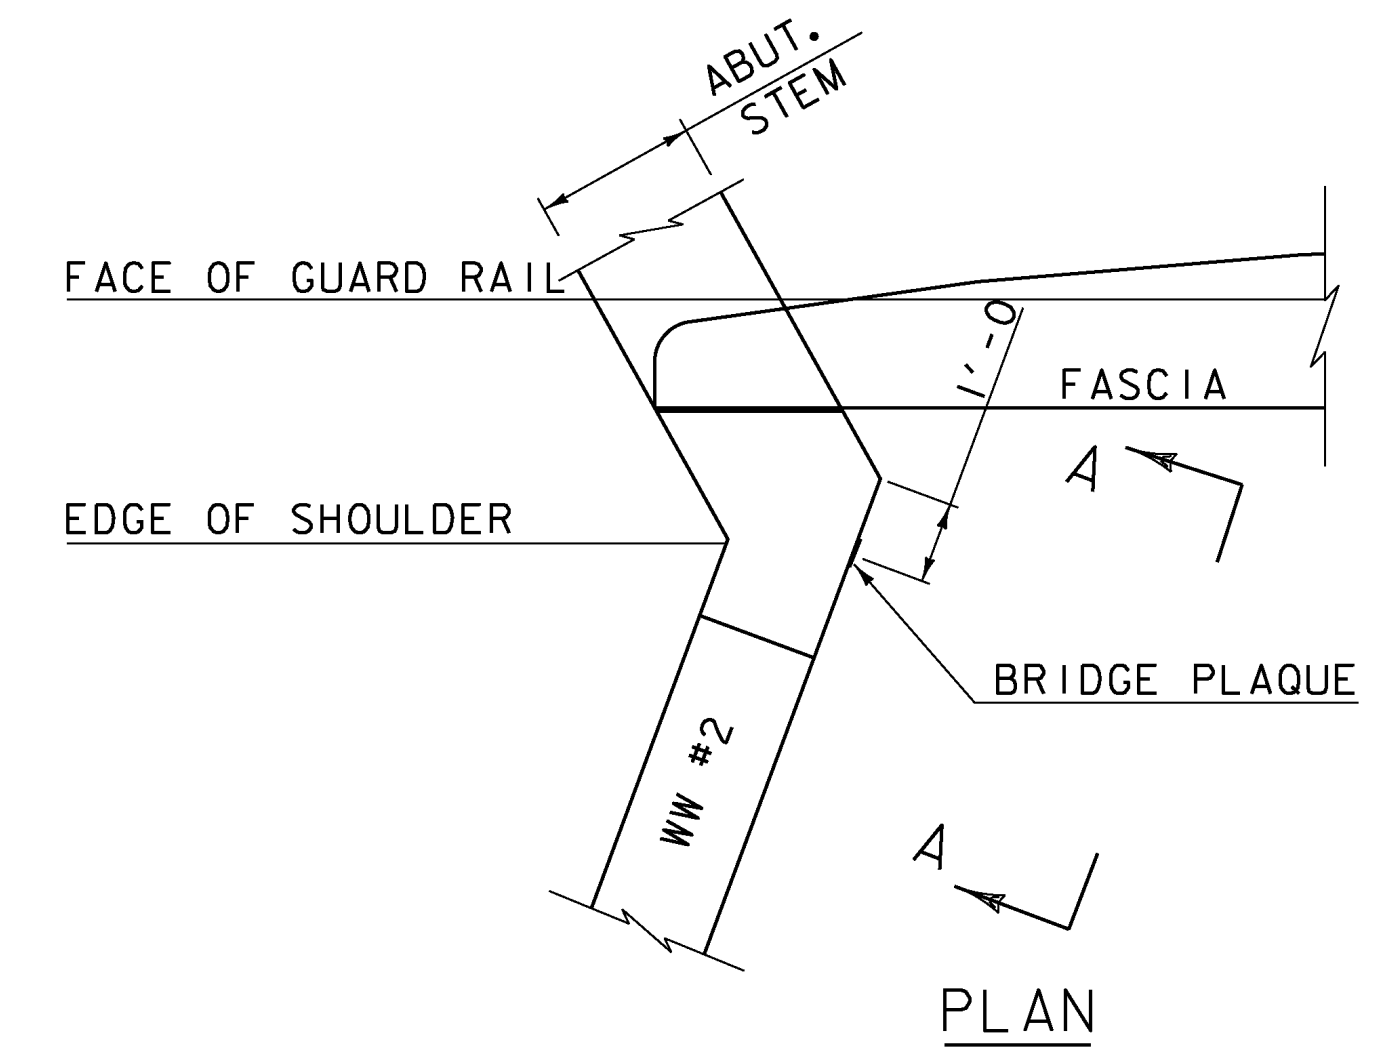

PLAN

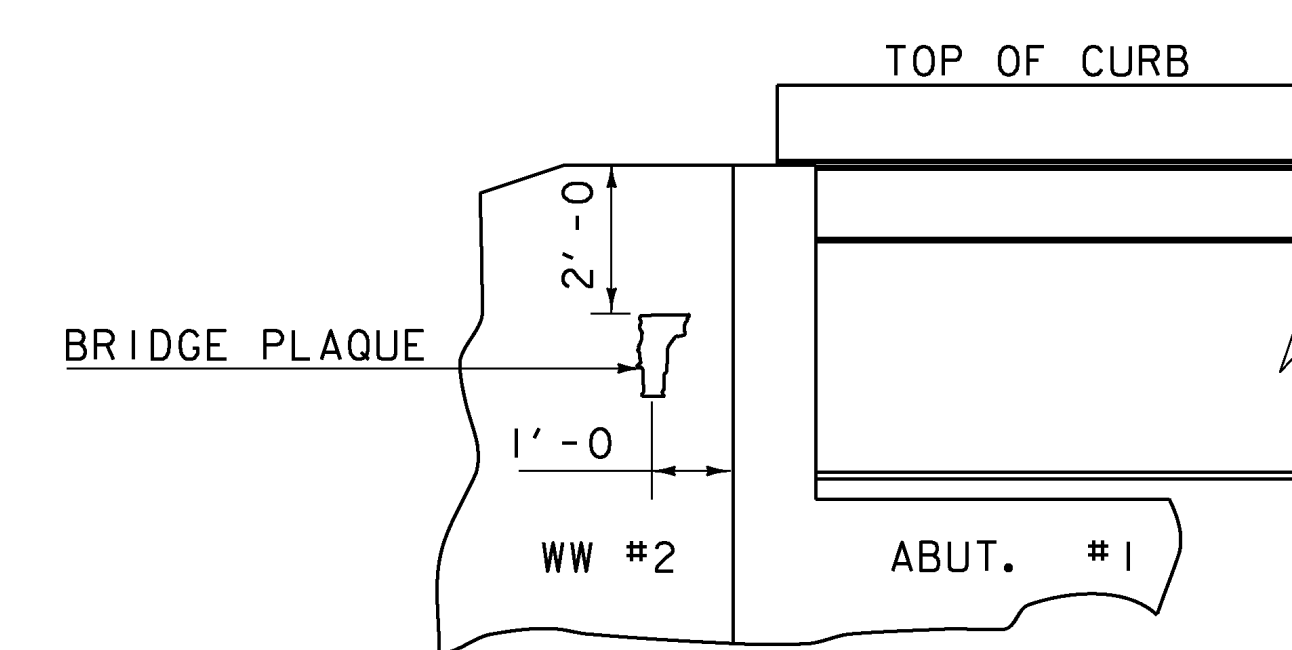

VIEW "A - A"  
BRIDGE PLAQUE  
(NOT TO SCALE)


THE BRIDGE PLAQUE WILL BE SUPPLIED BY THE AGENCY OF TRANSPORTATION AND SHALL BE INSTALLED BY THE CONTRACTOR AT ABUTMENT #1 ON THE RIGHT SIDE AS SHOWN OR AS DIRECTED BY THE ENGINEER.

PAYMENT FOR INSTALLATION OF THE BRIDGE PLAQUE SHALL BE INCIDENTAL TO THE ADJACENT CONCRETE.

REVISIONS


MAY 7, 2010	APPROVED FOR USE BY VAOT STRUCTURES SECTION
JUNE 4, 2010	MODIFIED AND ADDED TWO DETAILS
OCTOBER 10, 2012	MODIFIED HORZ. JOINT WINGWALL ADD 6" MIN. DIMENSION

CONCRETE  
DETAILS AND NOTES

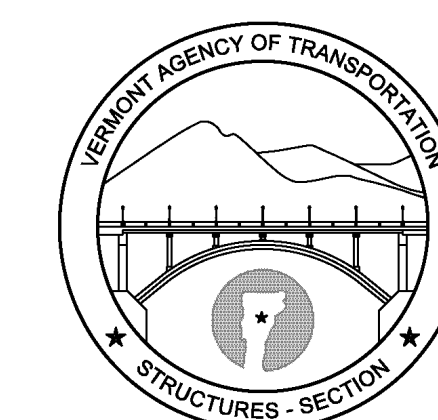

STRUCTURES  
DETAIL  
SD-502.00


## ASPHALTIC PLUG JOINT NOTES

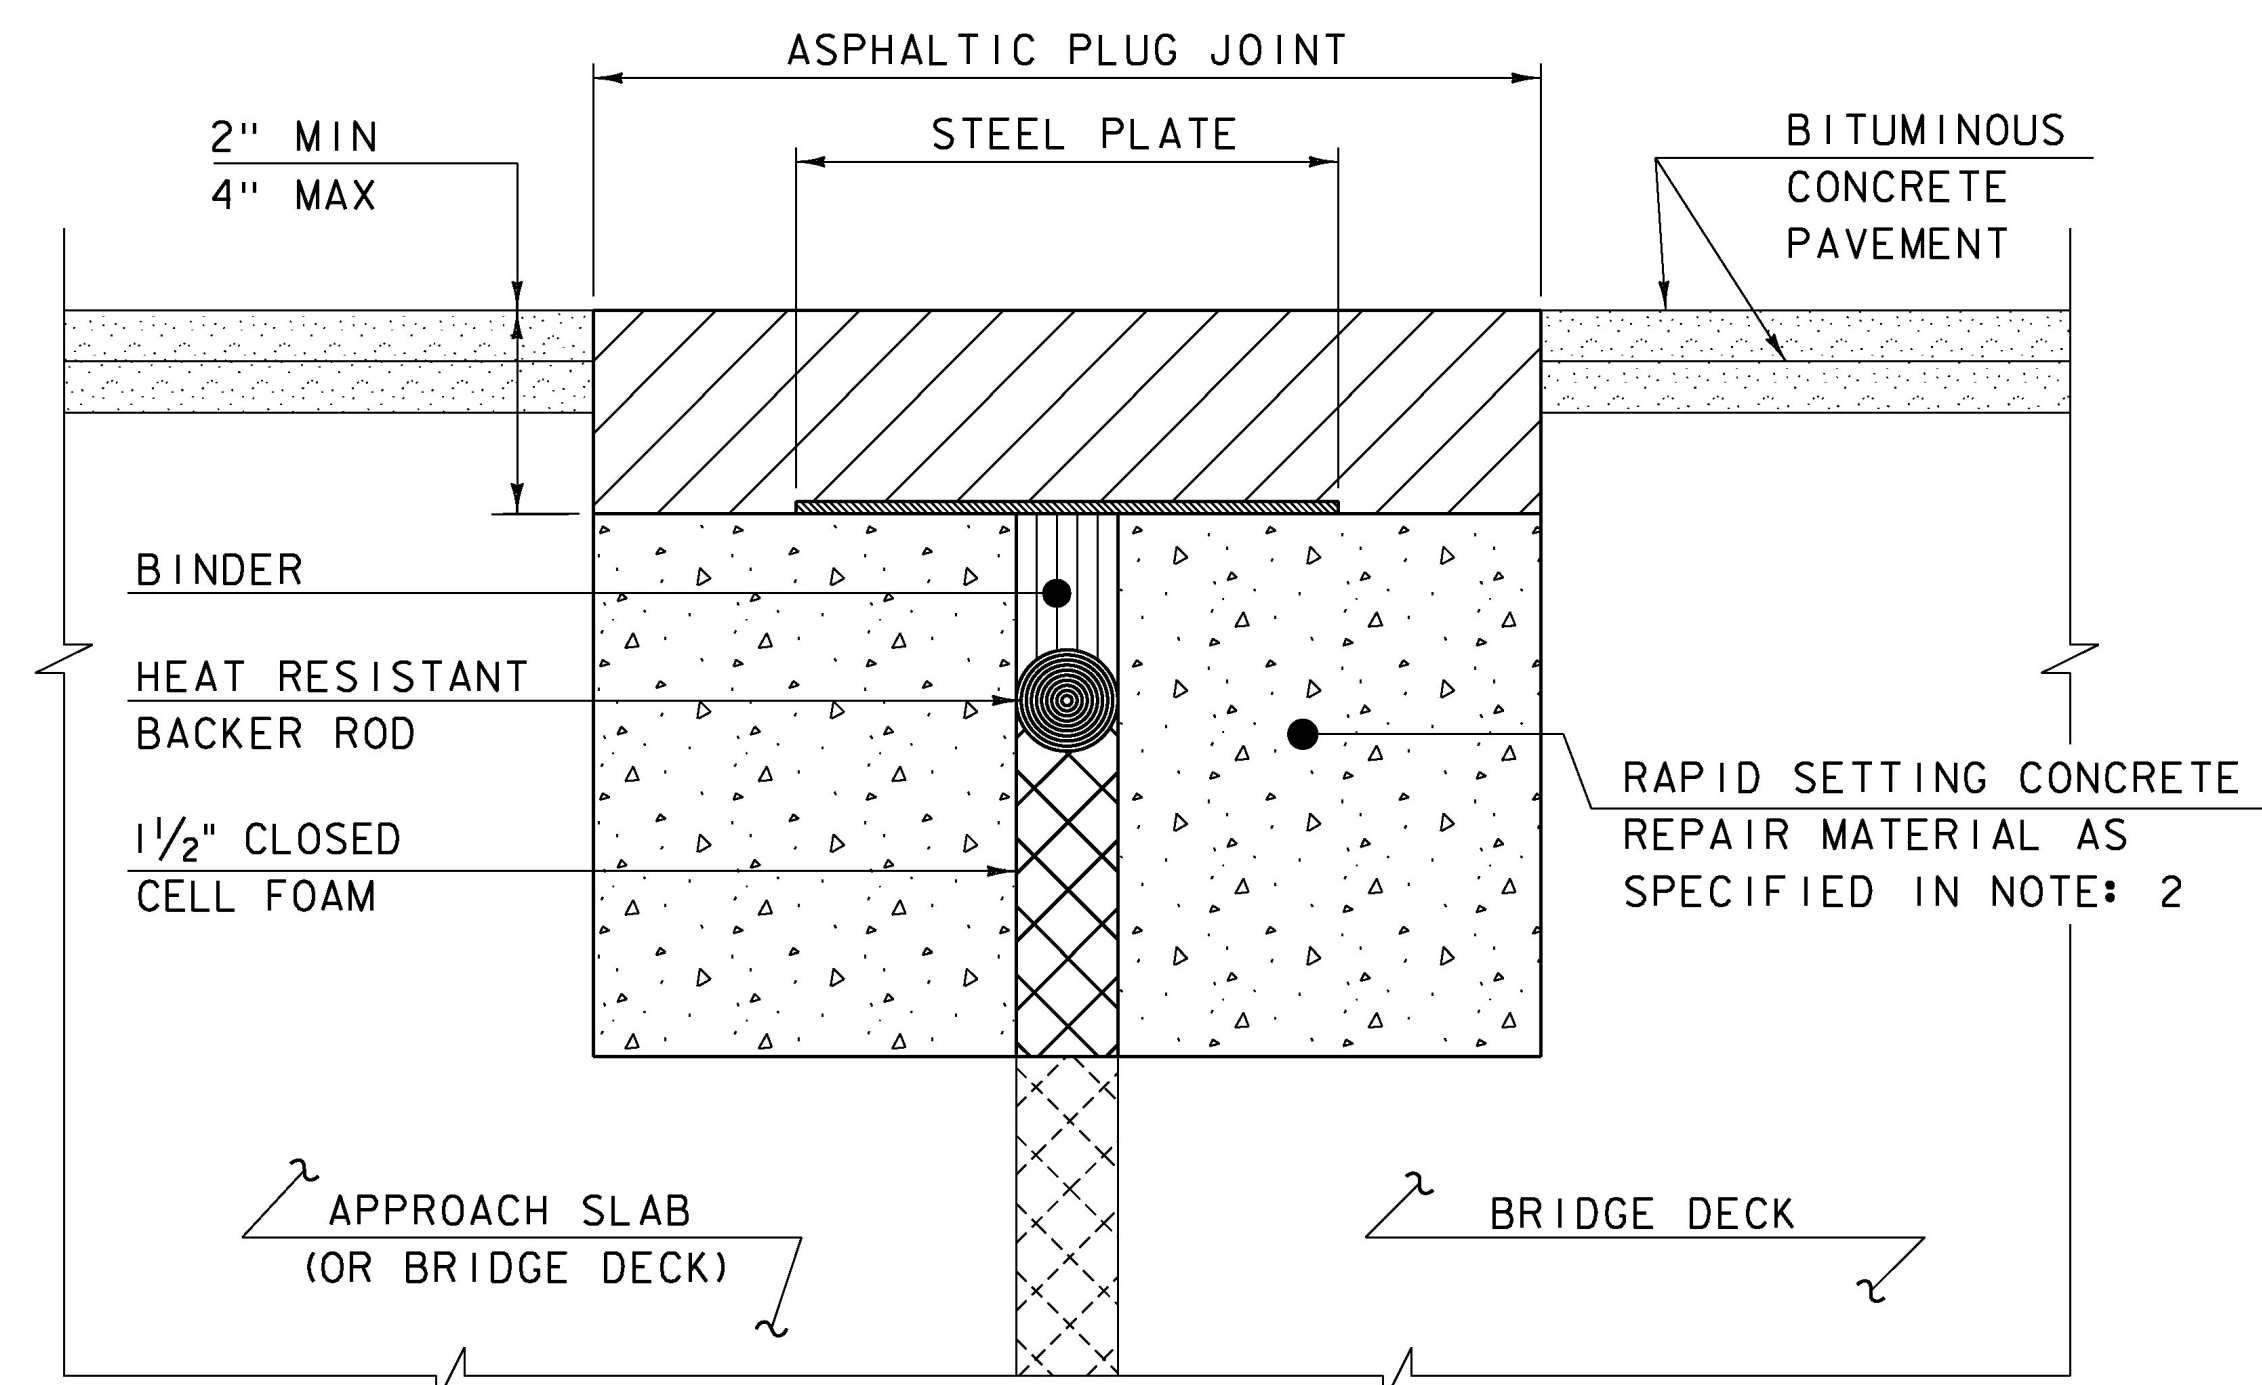

ASPHALTIC PLUG JOINT DETAIL - REHAB

**NOTES:**

1. THE CONTRACTOR SHALL REMOVE ALL ASPHALTIC PLUG JOINT MATERIAL AND DETERIORATED CONCRETE AS DIRECTED BY THE ENGINEER. REMOVAL OF THE FIRST 4 INCHES OF MATERIAL SHALL BE INCLUDED IN THE BID PRICE FOR ITEM 516.10 BRIDGE EXPANSION JOINT, ASPHALTIC PLUG. ANY REMOVAL OF MATERIAL GREATER THAN 4 INCHES SHALL BE INCLUDED IN THE BID PRICE OF ITEM 580.20 RAPID SETTING CONCRETE REPAIR MATERIAL WITH COARSE AGGREGATE.
2. THE CONTRACTOR SHALL REPLACE REMOVED MATERIAL THAT IS LESS THAN 4" FROM FINISHED GRADE WITH ASPHALTIC PLUG JOINT MATERIAL MEETING THE REQUIREMENTS OF SUBSECTION 707.15. ALL REMOVED MATERIAL THAT IS GREATER THAN 4 INCHES FROM FINISHED GRADE SHALL BE REPLACED WITH RAPID SETTING CONCRETE REPAIR MATERIAL WITH COARSE AGGREGATE MEETING THE REQUIREMENTS OF SUBSECTION 780.04.
3. REINFORCING STEEL NOT SHOWN FOR CLARITY.
4. PLACE 1/4" THICK BY 8" WIDE SECTIONS OF STEEL PLATE OVER THE CENTER OF THE MOVEMENT GAP. SECURE THE PLATES FROM MOVING BY INSERTING LOCATING PINS THROUGH THE PRE-STAMPED HOLES INTO BACKER ROD AND COVER WITH HOT BINDER. THE STEEL PLATES MAY BE OMITTED WHERE THE ENGINEER DETERMINES THAT THE APPROACH SLAB OR BRIDGE DECK WILL PROVIDE INADEQUATE SUPPORT AND WHERE VERTICAL MOVEMENT OF THE PLATES MIGHT OCCUR.

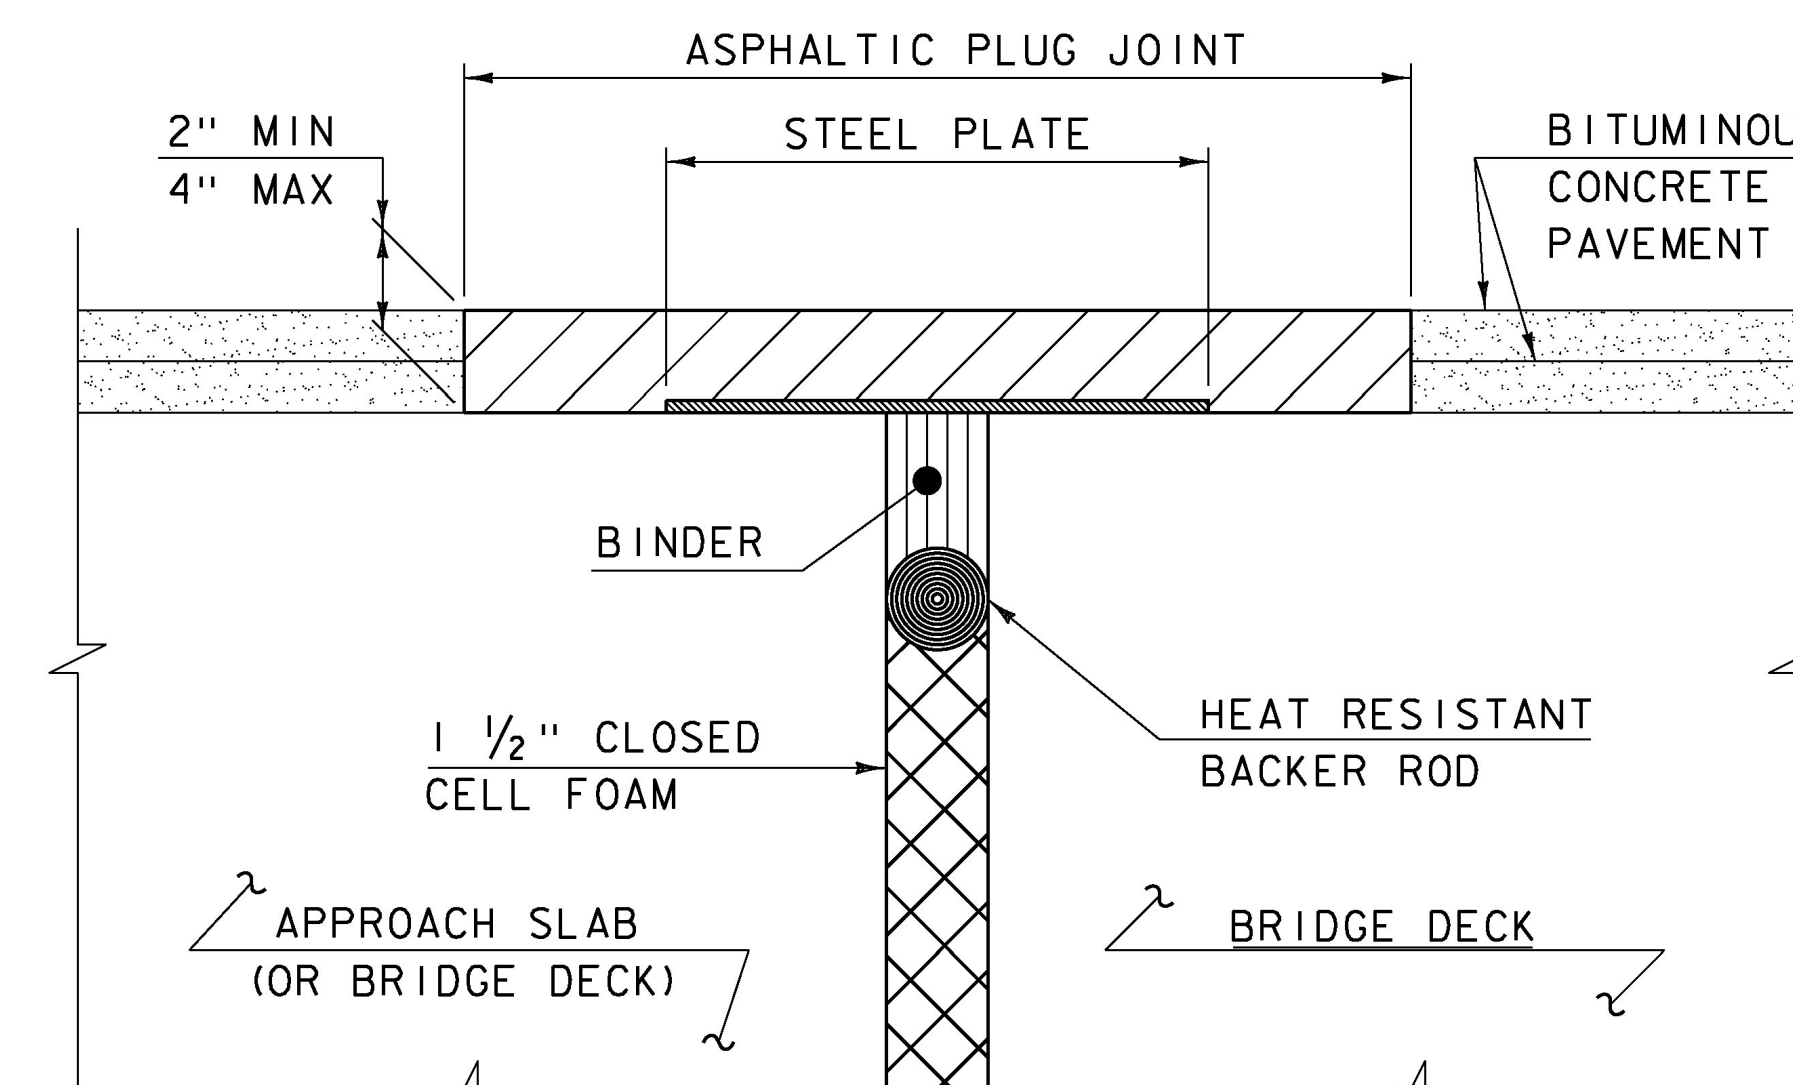

ASPHALTIC PLUG JOINT DETAIL "A" - NEW

**NOTE:**

PLACE 1/4" THICK BY 8" WIDE SECTIONS OF STEEL PLATE OVER THE CENTER OF THE MOVEMENT GAP. SECURE THE PLATES FROM MOVING BY INSERTING LOCATING PINS THROUGH THE PRE-STAMPED HOLES INTO BACKER ROD AND COVER WITH HOT BINDER.


**INSTALLATION:**

1. LOCATE THE JOINT CENTRALLY OVER THE DECK OVERLAY EXPANSION GAP OR FIXED JOINT, MARKED OUT TO THE MANUFACTURER'S RECOMMENDED WIDTH.
2. REMOVE THE BITUMINOUS CONCRETE PAVEMENT FULL DEPTH AS SHOWN ON THE PLANS. THE PAVEMENT SHALL BE DRY AND SAW CUT TO THE LIMITS REQUIRED TO PLACE THE JOINT. A PNEUMATIC HAMMER AND CHISEL MAY BE USED ADJACENT TO THE CURB ONLY WHEN SAW CUTTING IS NOT POSSIBLE.
3. BLAST CLEAN THE JOINT AREA OF DEBRIS, ASPHALT AND SHEET MEMBRANE. THOROUGHLY DRY THE JOINT AREA WITH COMPRESSED AIR PRIOR TO APPLYING BINDER MATERIAL.
4. PLACE PROPERLY SIZED HEAT RESISTANT BACKER ROD IN THE MOVEMENT GAP ALLOWING FOR 1" +/- OF BINDER ABOVE THE ROD.
5. HEAT AND PLACE THE BINDER MATERIAL AS RECOMMENDED BY THE MANUFACTURER.
6. IMMEDIATELY AFTER TOP COATING, CAST AN ANTI-SKID MATERIAL OVER THE JOINT TO REDUCE THE RISK OF TRACKING.

**WEATHER LIMITATIONS**

APPLY BINDER MATERIAL ONLY WHEN THE FOLLOWING CONDITIONS PREVAIL OR AS RECOMMENDED BY THE MANUFACTURER:

1. THE AMBIENT AIR TEMPERATURE IS AT LEAST 10 DEG C (50 DEG F) AND RISING.
2. THE ROAD SURFACE IS DRY.
3. WEATHER CONDITIONS OR OTHER CONDITIONS ARE FAVORABLE AND ARE EXPECTED TO REMAIN SO FOR THE PERFORMANCE OF SATISFACTORY WORK.

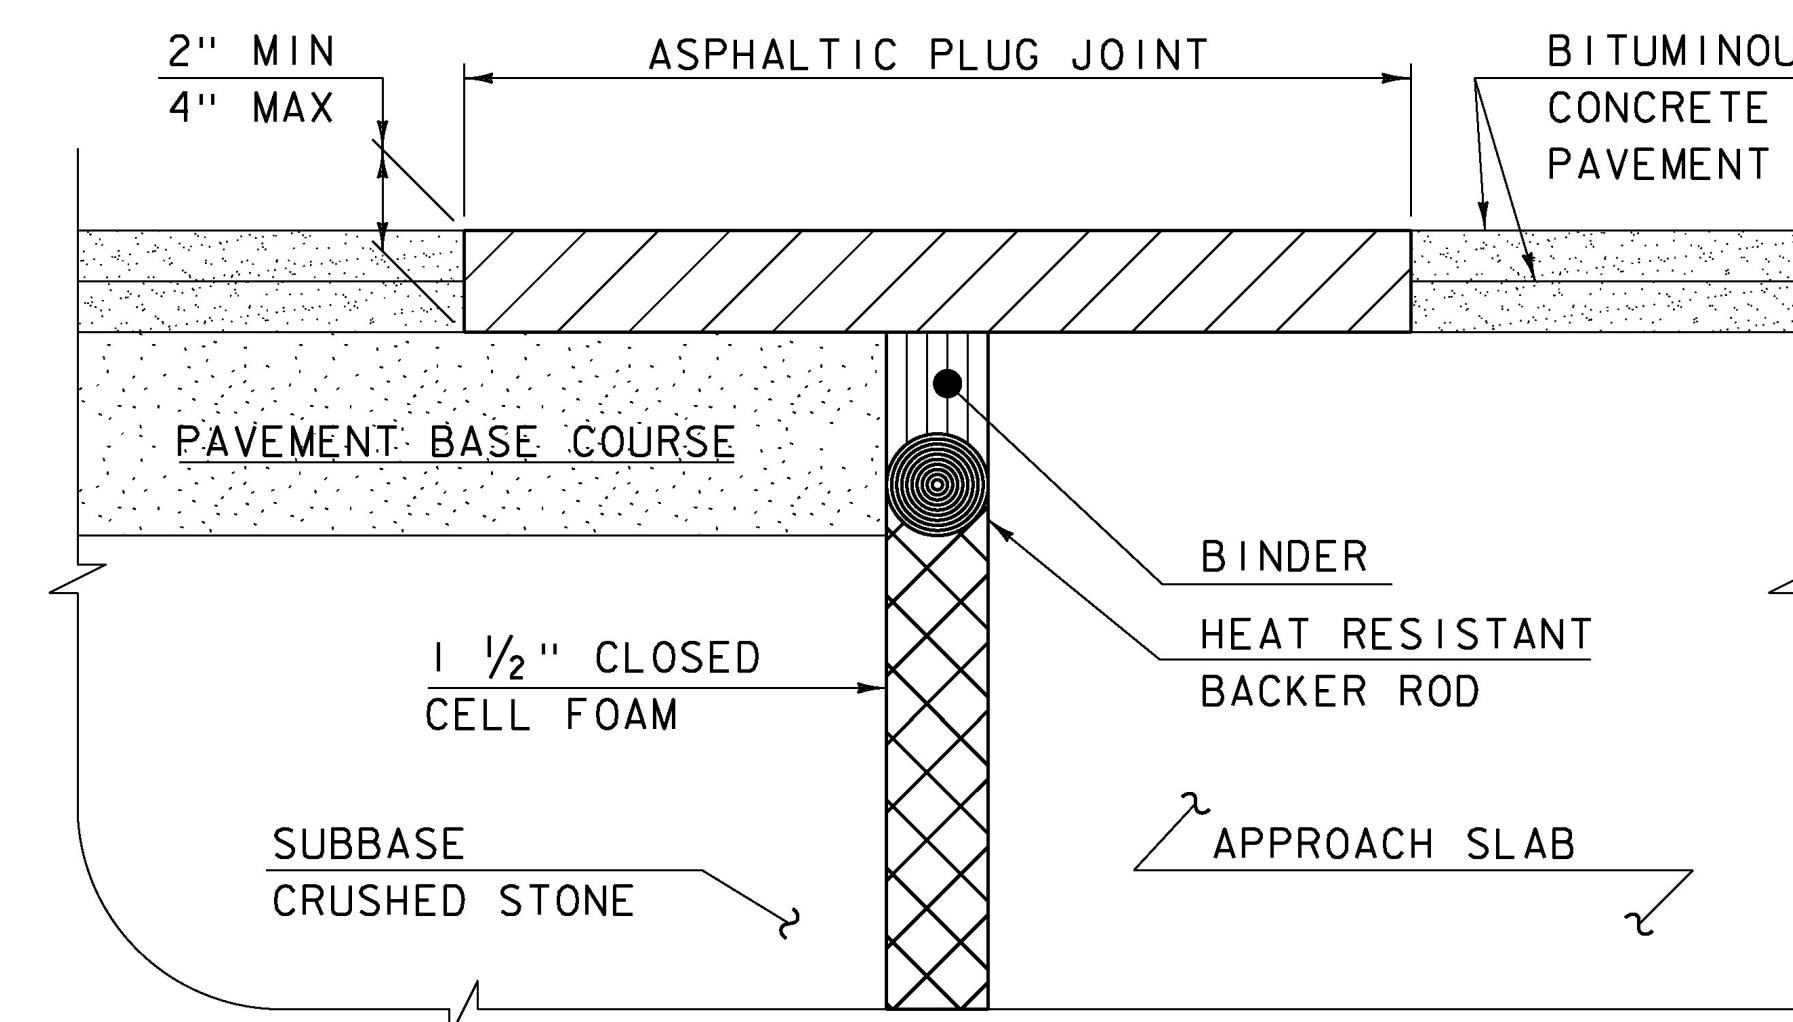


ASPHALTIC PLUG JOINT DETAIL "B" - NEW

DETAILS ON THIS SHEET ARE NOT TO SCALE.

REVISIONS	
MAY 7, 2010	APPROVED FOR USE BY VAOT STRUCTURES SECTION
AUGUST 29, 2011	ADD DETAIL "B" AND REV. NOTES



# BRIDGE JOINT ASPHALTIC PLUG

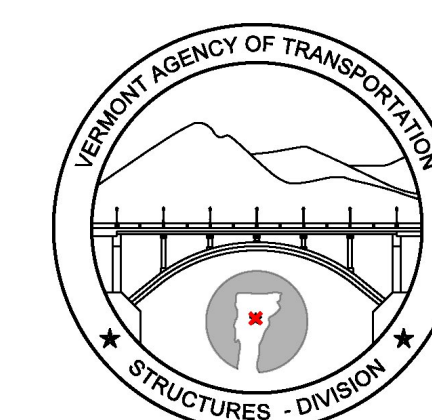

STRUCTURES  
DETAIL  
SD-516.10



32' - PAY LIMIT FOR TRANSITION - BRIDGE RAILING TO BOX BEAM GUIDE RAIL

ELEVATION VIEW

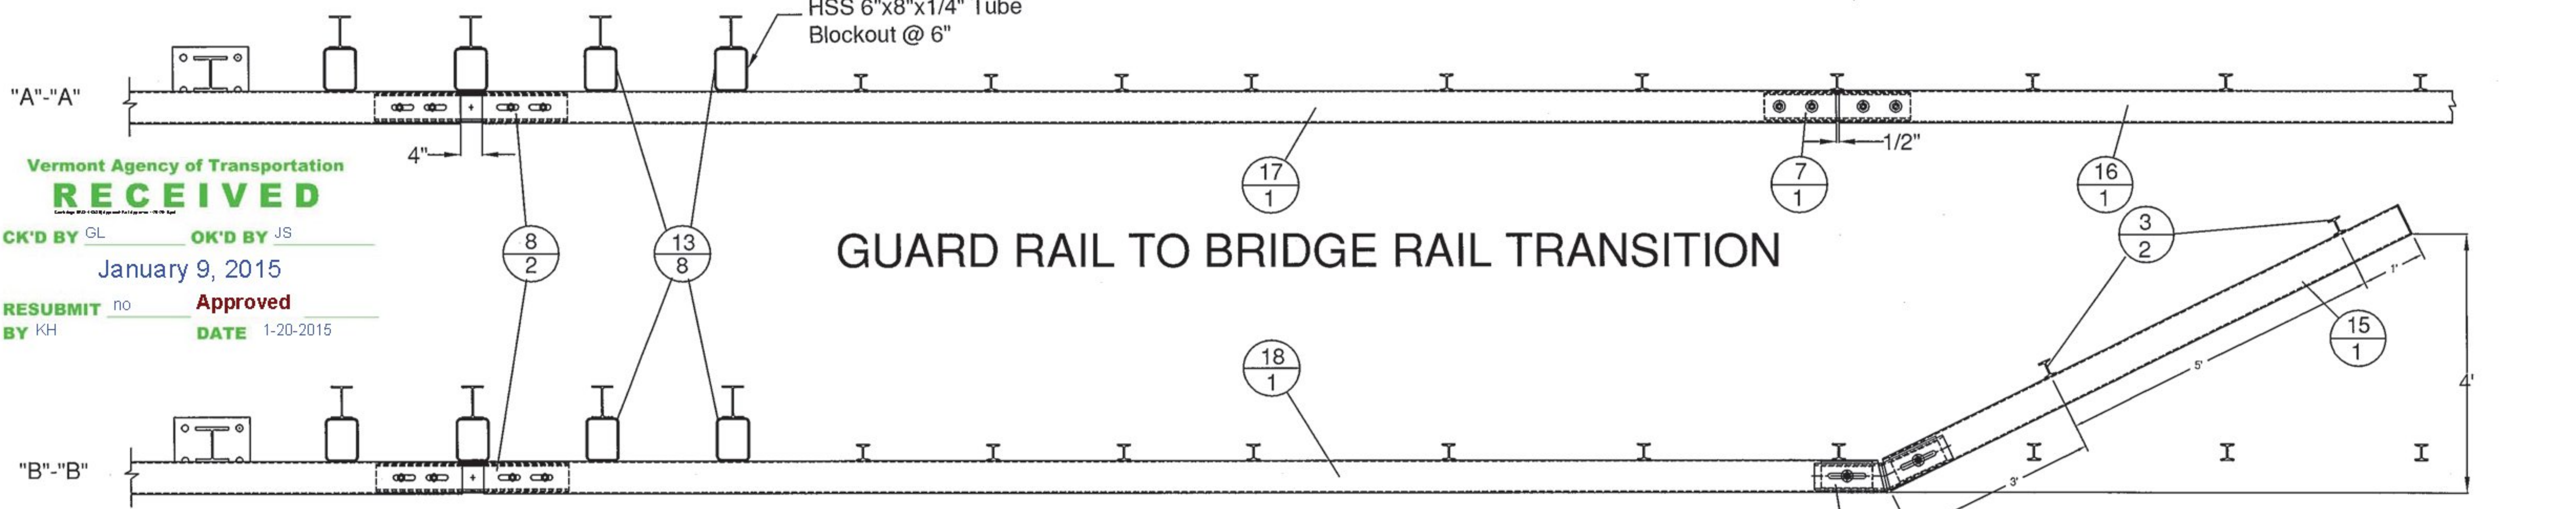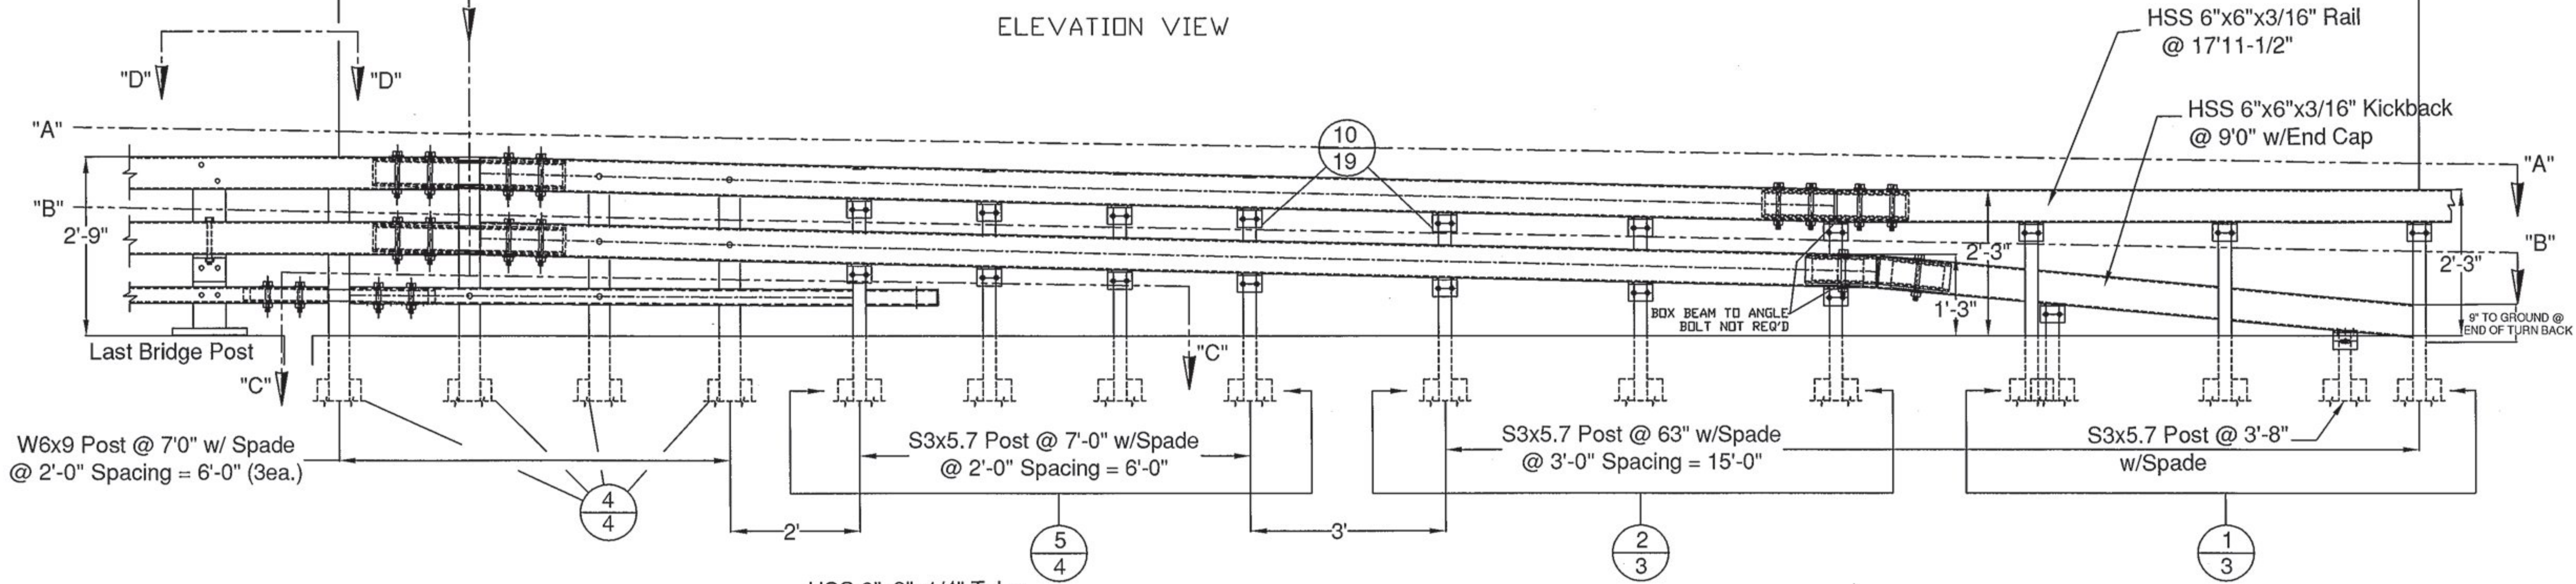

Vermont Agency of Transportation  
**RECEIVED**  
 CK'D BY GL OK'D BY JS  
 January 9, 2015  
 RESUBMIT no Approved  
 BY KH DATE 1-20-2015

GUARD RAIL TO BRIDGE RAIL TRANSITION

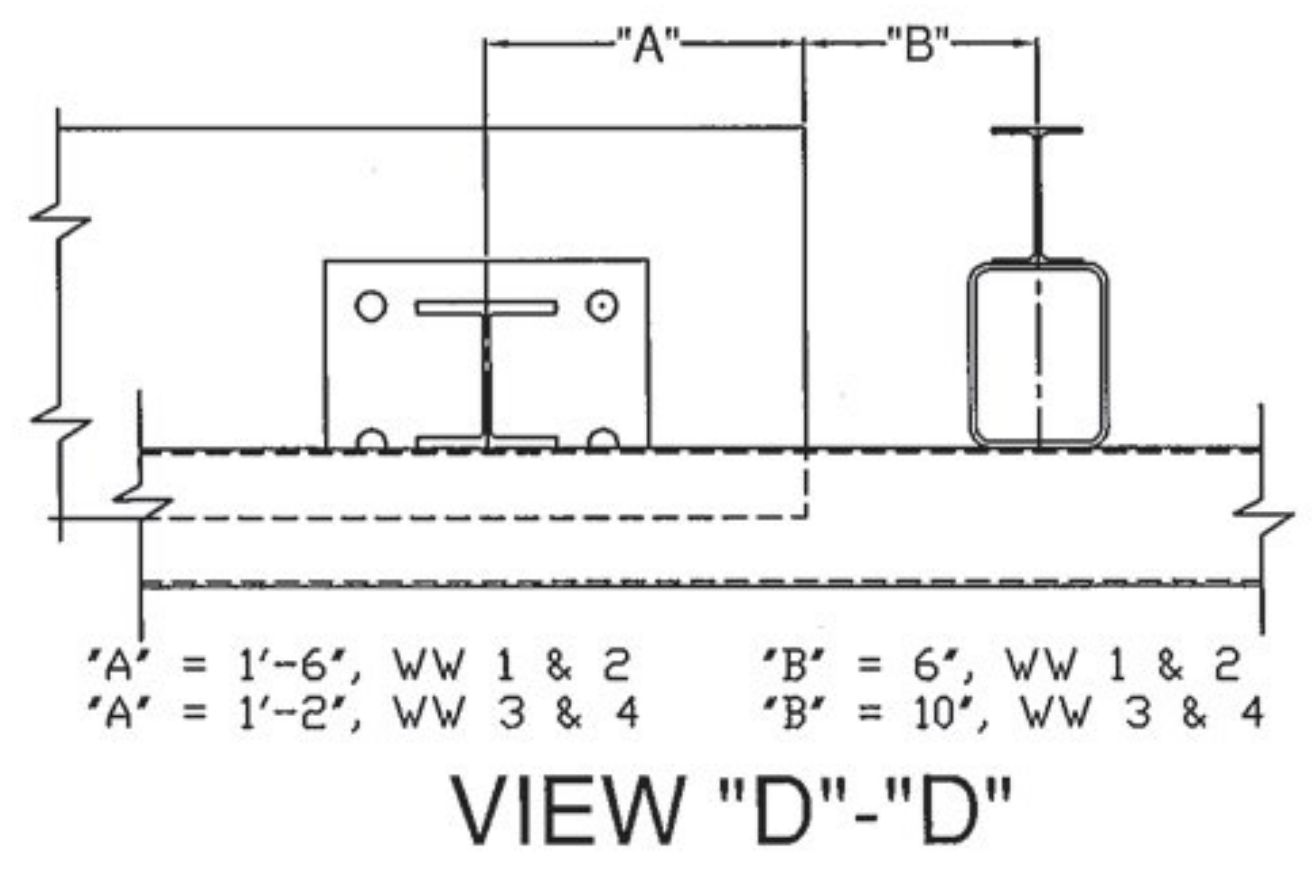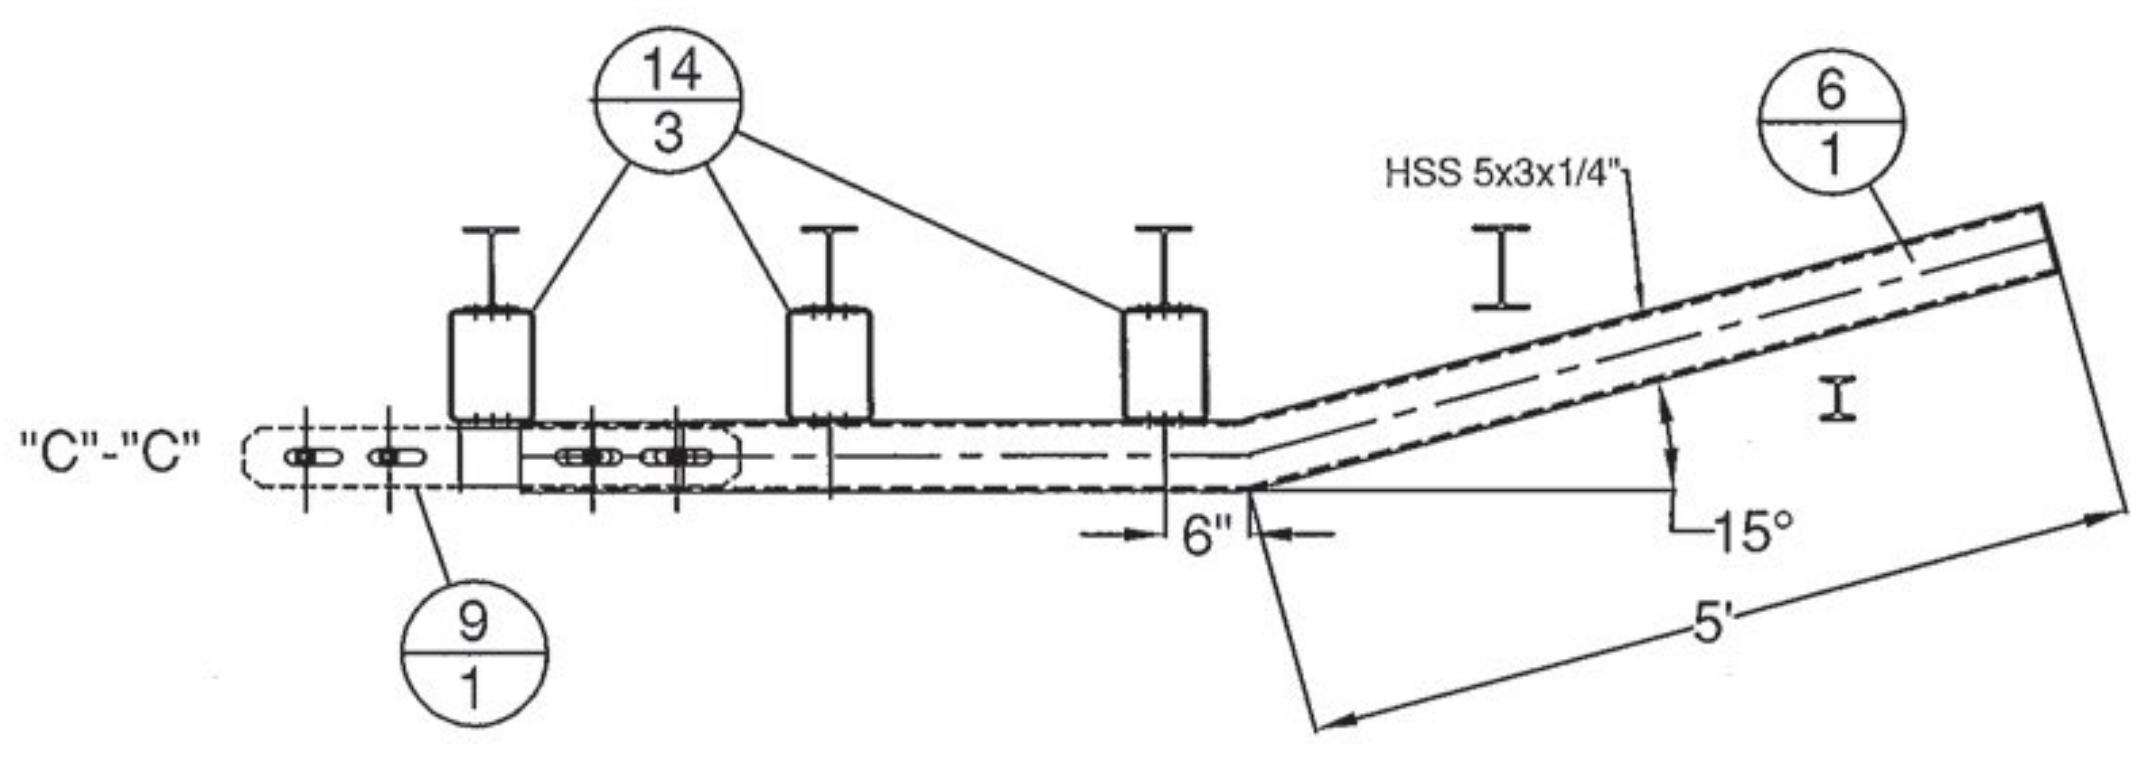

*A' = 1'-6", WW 1 & 2    *B' = 6", WW 1 & 2  
 *A' = 1'-2", WW 3 & 4    *B' = 10", WW 3 & 4

VIEW "D"- "D"

ITEM #: 621.725  
 STRUCTURAL STEEL TO COMPLY W/ ASTM A6  
 TOLERANCE UNLESS OTHERWISE NOTED:  
 FRACTIONS = ± 1/16"  
 ANGLES = ± 1/2"  
 DIAMETERS = ± 1/32"






SHEET 1 OF 5

**GUARD RAIL TO BRIDGE RAIL TRANSITION DETAILS SHEET**  
 TOWN HIGHWAY 46 (IRISH SETTLEMENT ROAD), BRIDGE # 28  
 TOWN OF CAMBRIDGE, COUNTY OF LAMOILLE, VT.

R NO.	DATE	DESCRIPTION	BY	R NO.	DATE	DESCRIPTION	BY
E 1	1/7/15	REVISED PER 12/29/14 MARK-UP	EP	E 1			

DRAWN	E.P.	12/3/14
CHECKED	D.L.	12/3/14
APPROVED		
SCALE	SCHEMATIC	
DRAWING NO. F.R.L.-CAMBRIDGE-T		

**ELDERLEE, INC.**  
 OAKS CORNERS, NEW YORK 14518  
 E-Mail: [dlong@elderlee.com](mailto:dlong@elderlee.com) / [epcek@elderlee.com](mailto:epcek@elderlee.com)  
 Tel: 315-789-6670 Fax: 315-789-6615

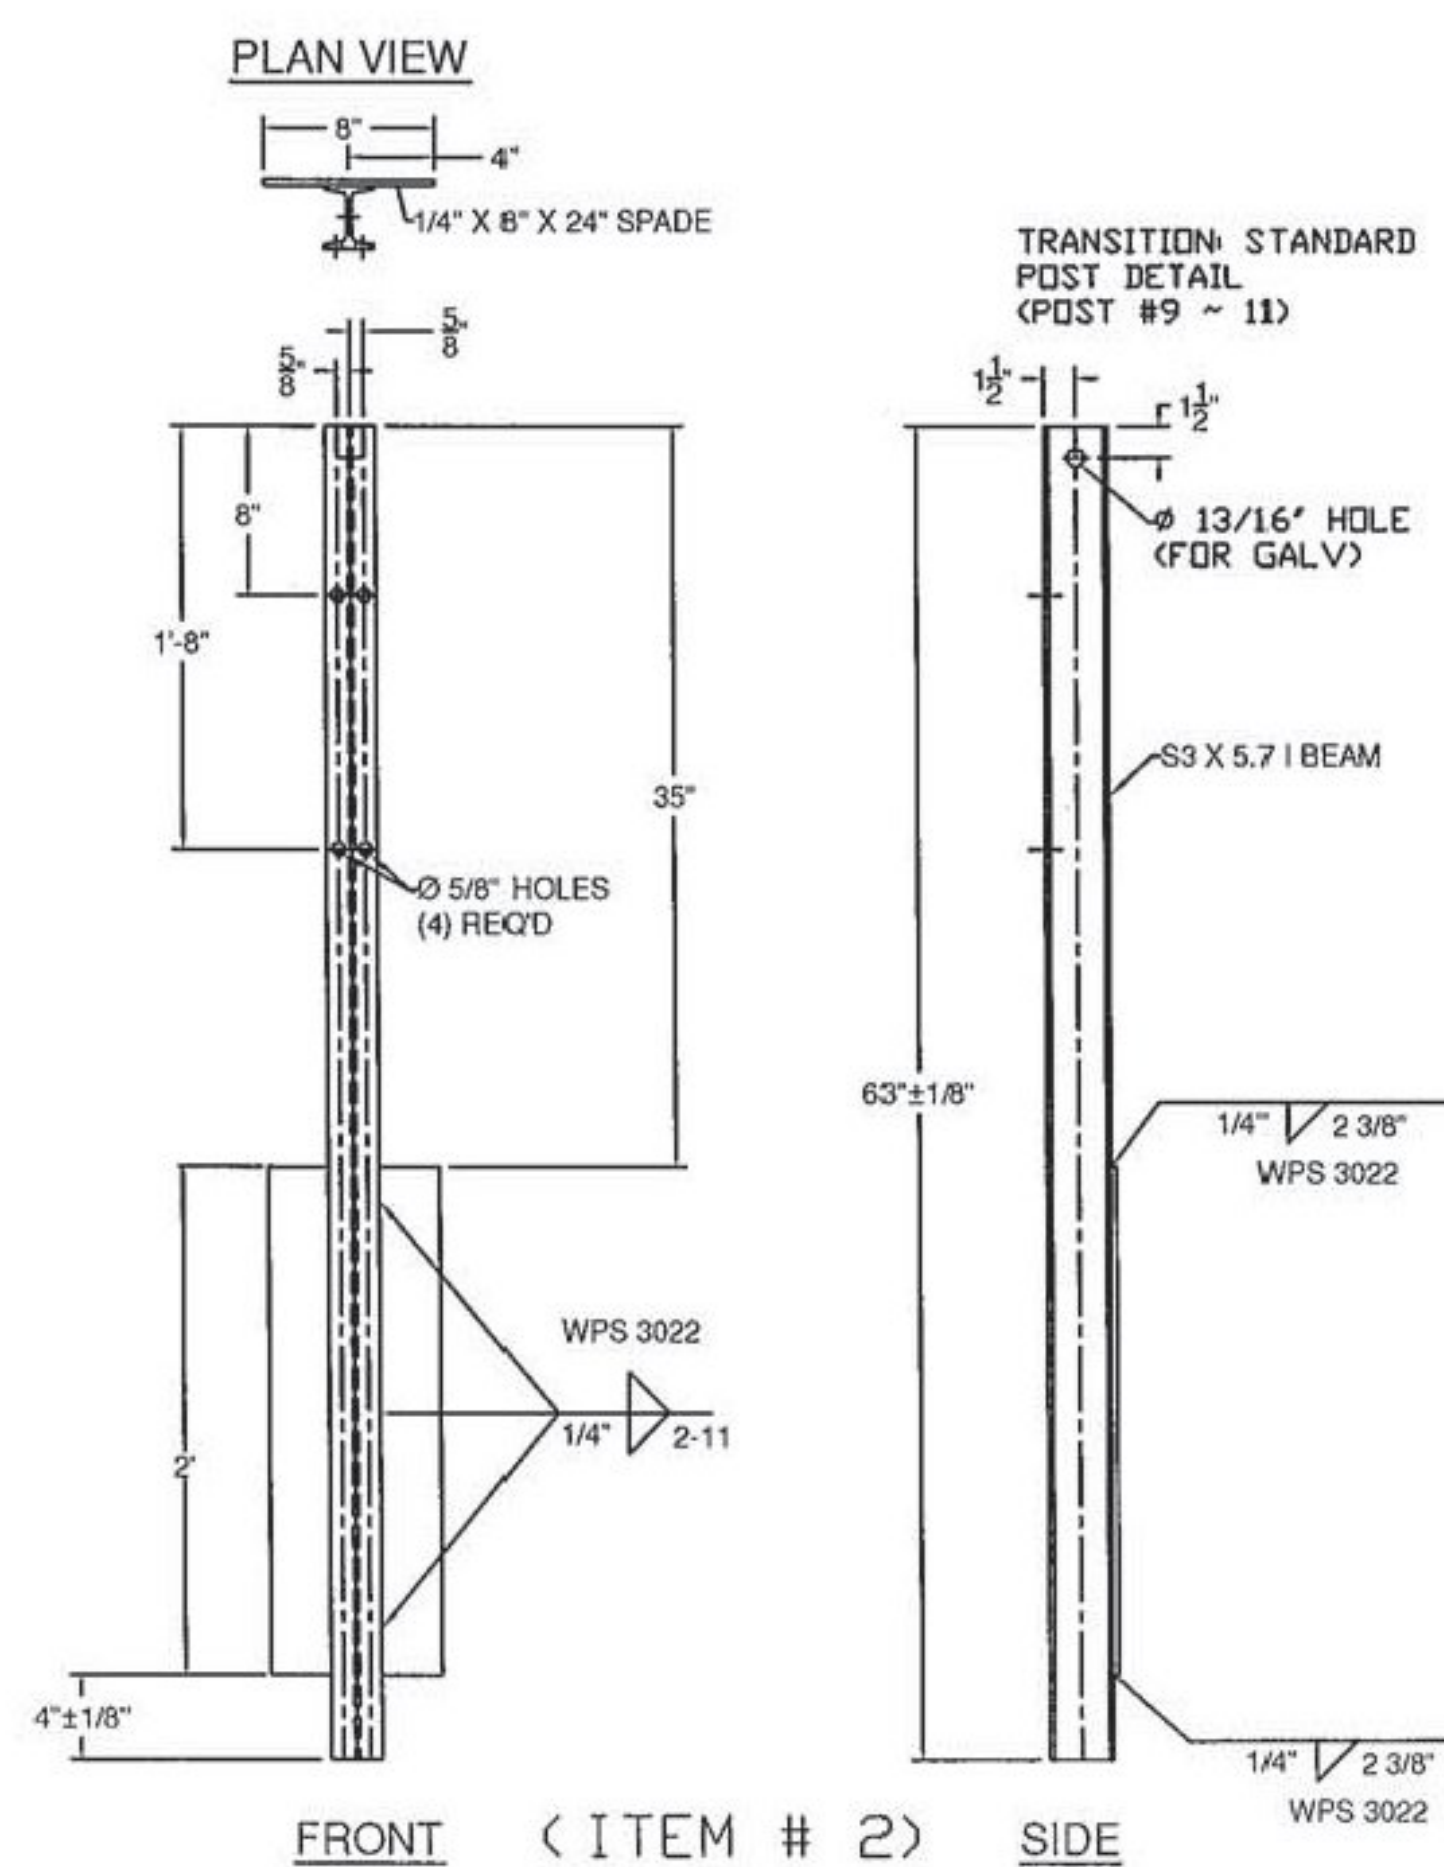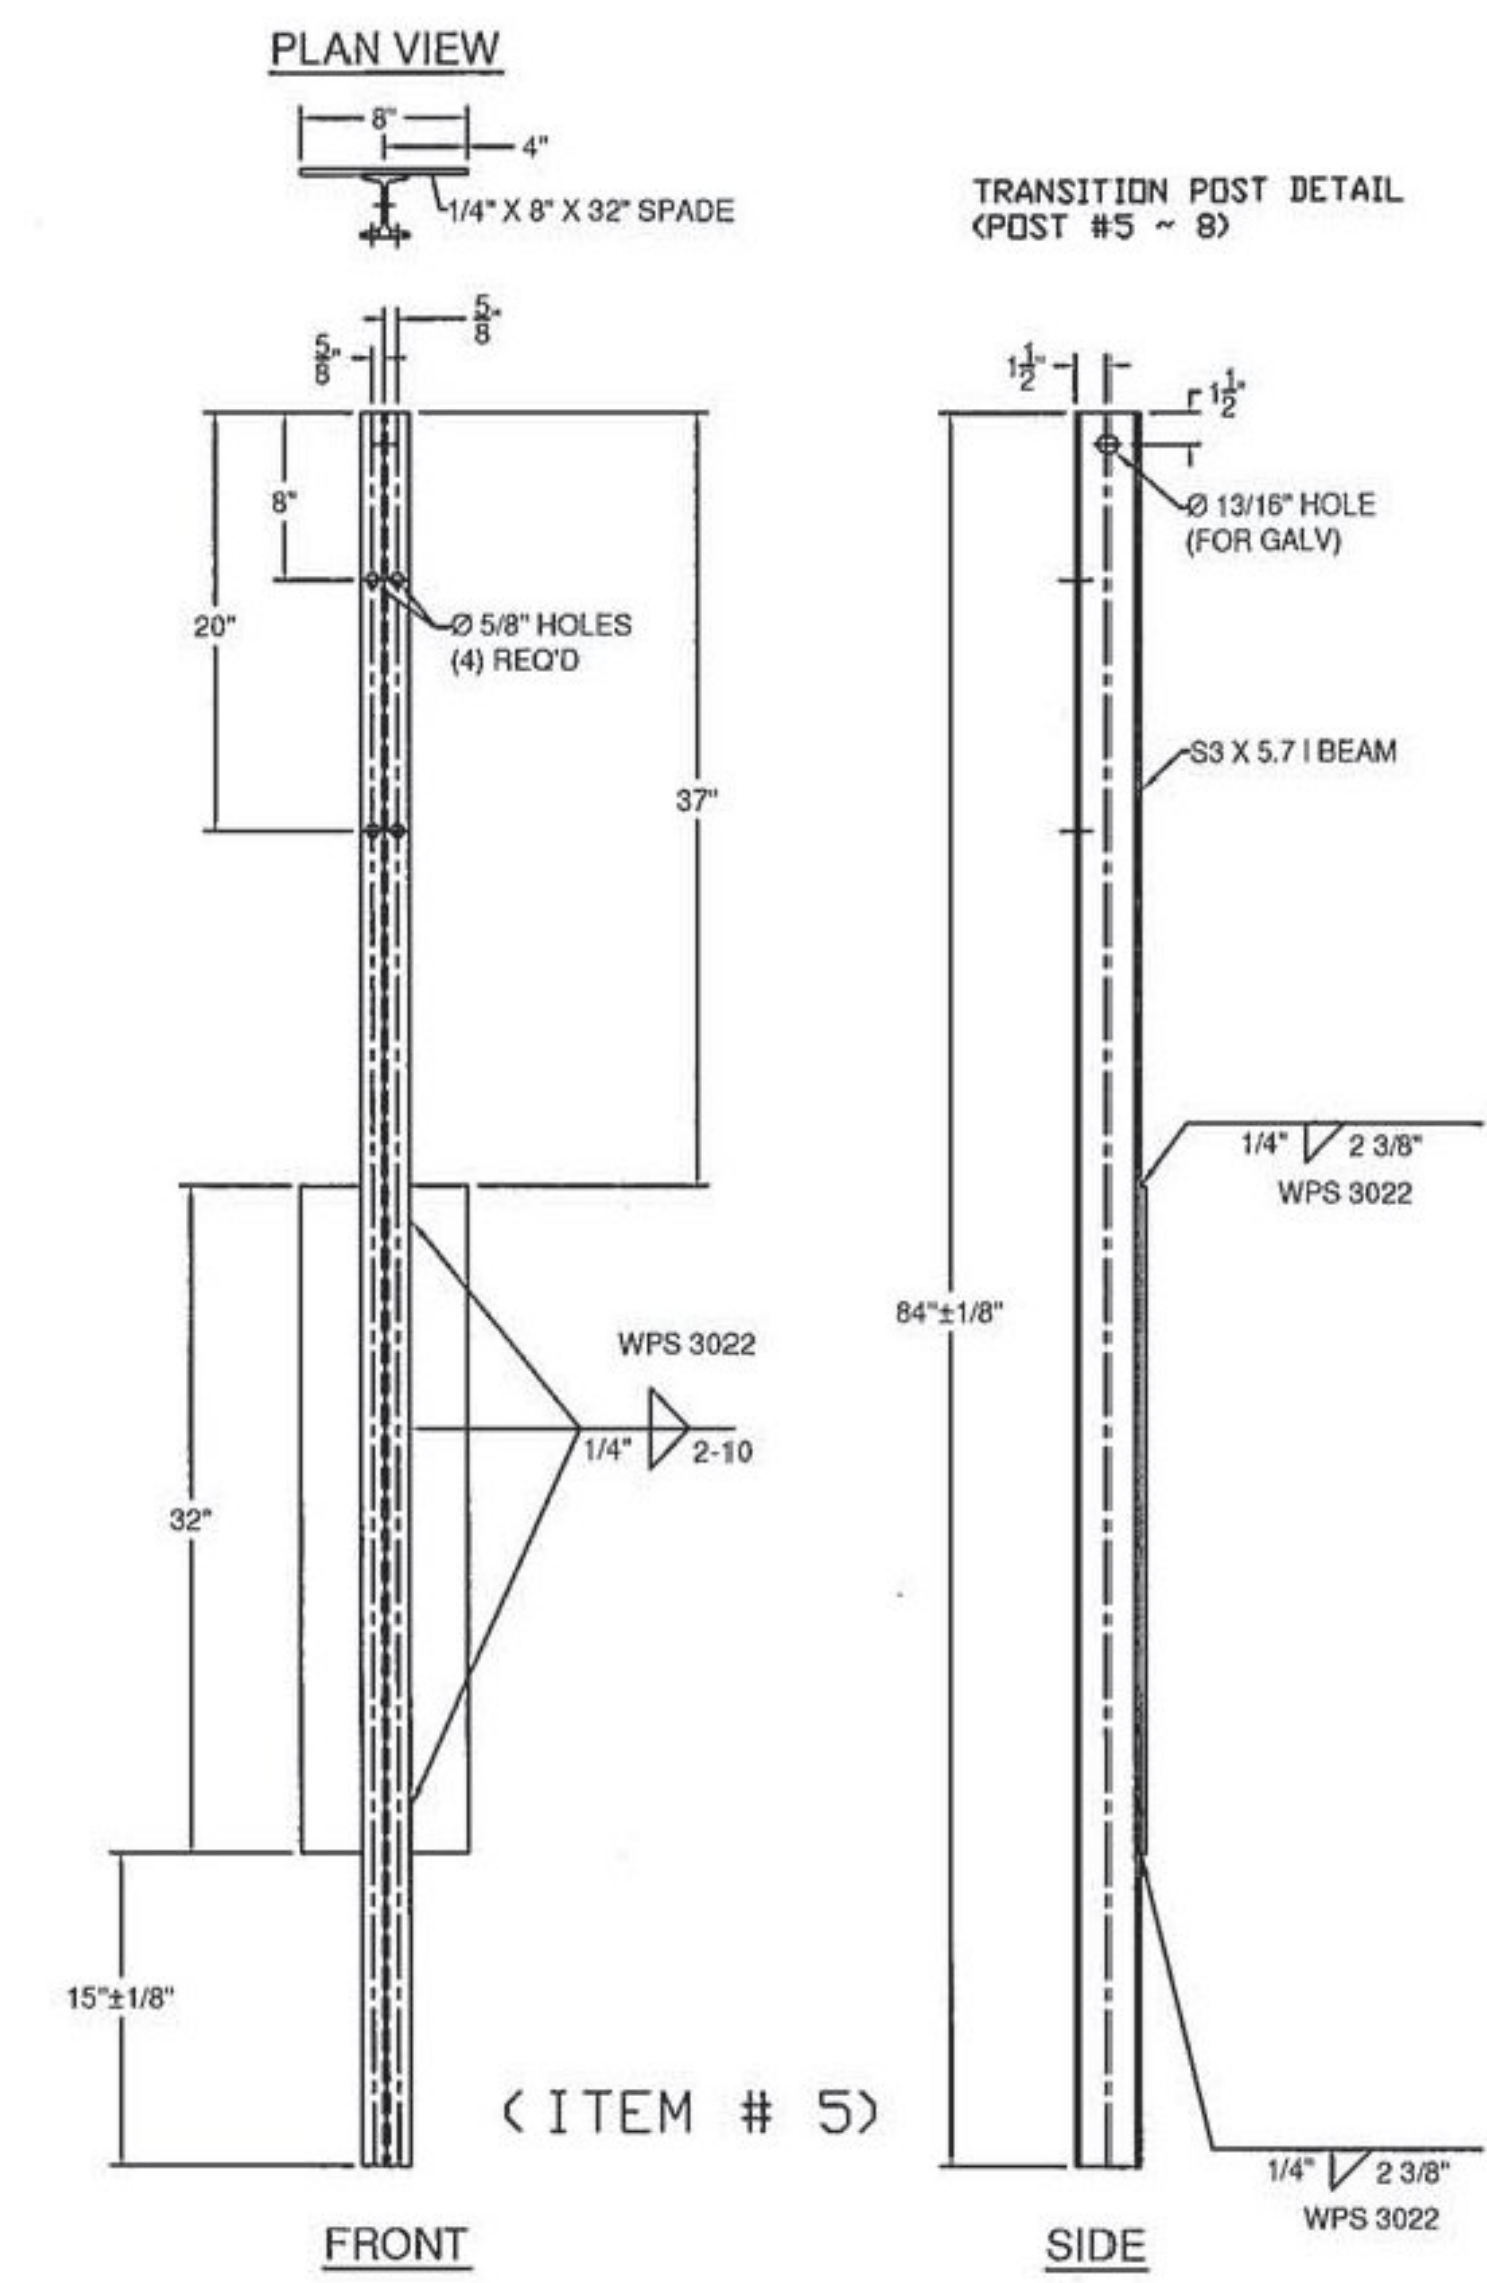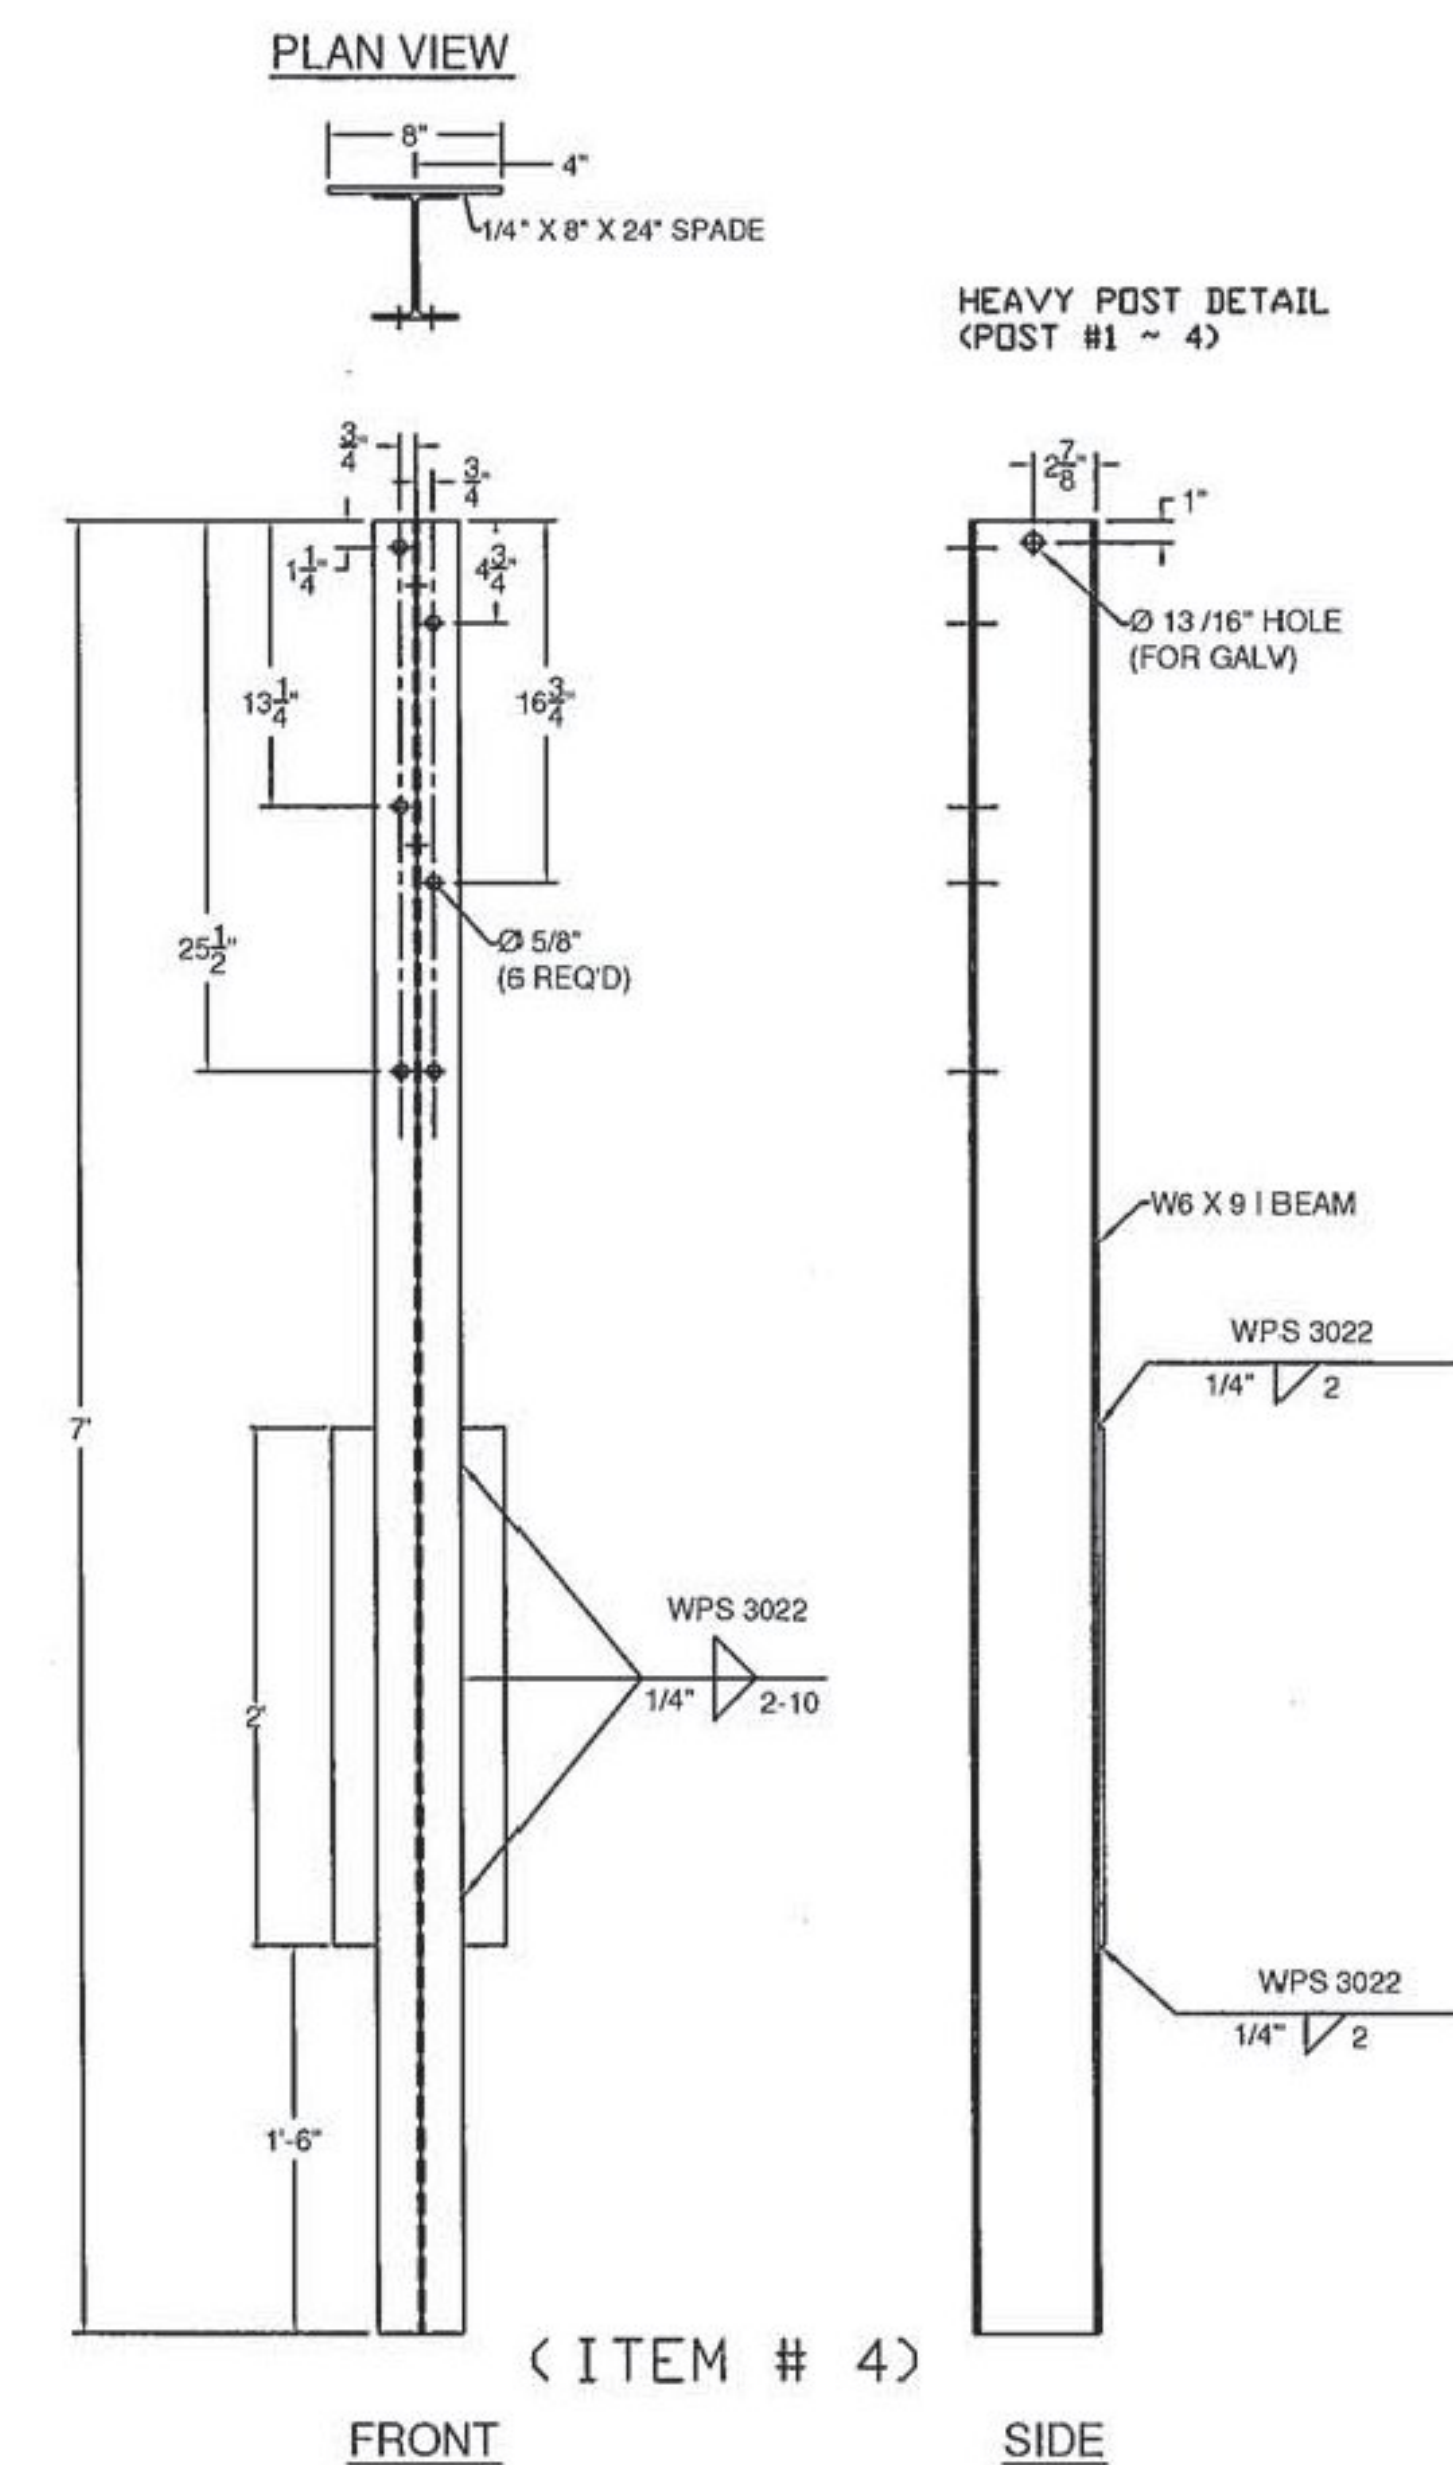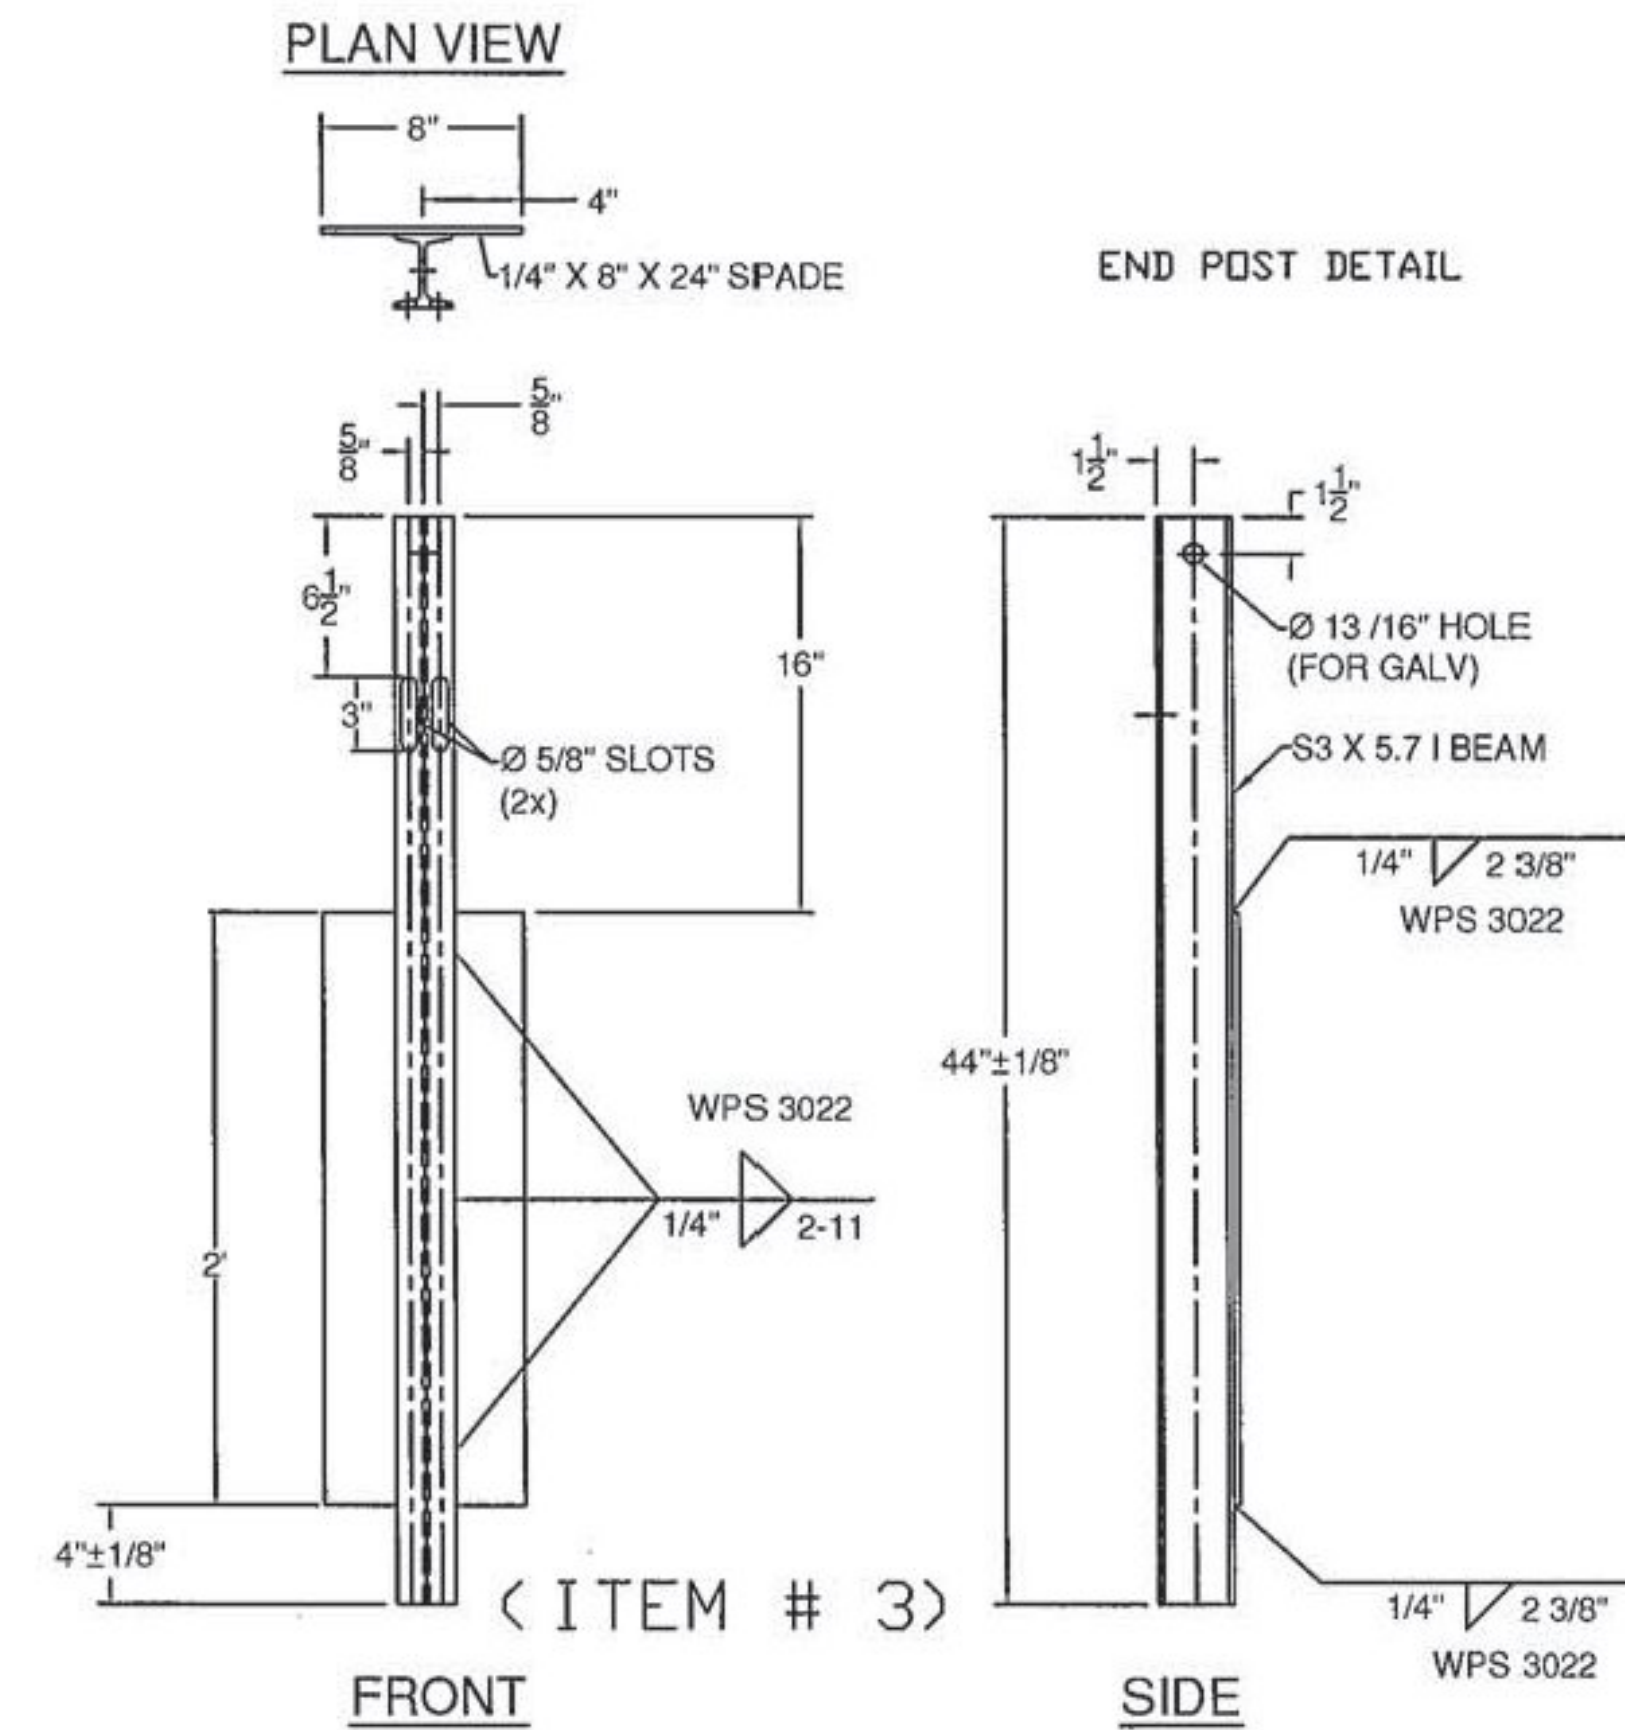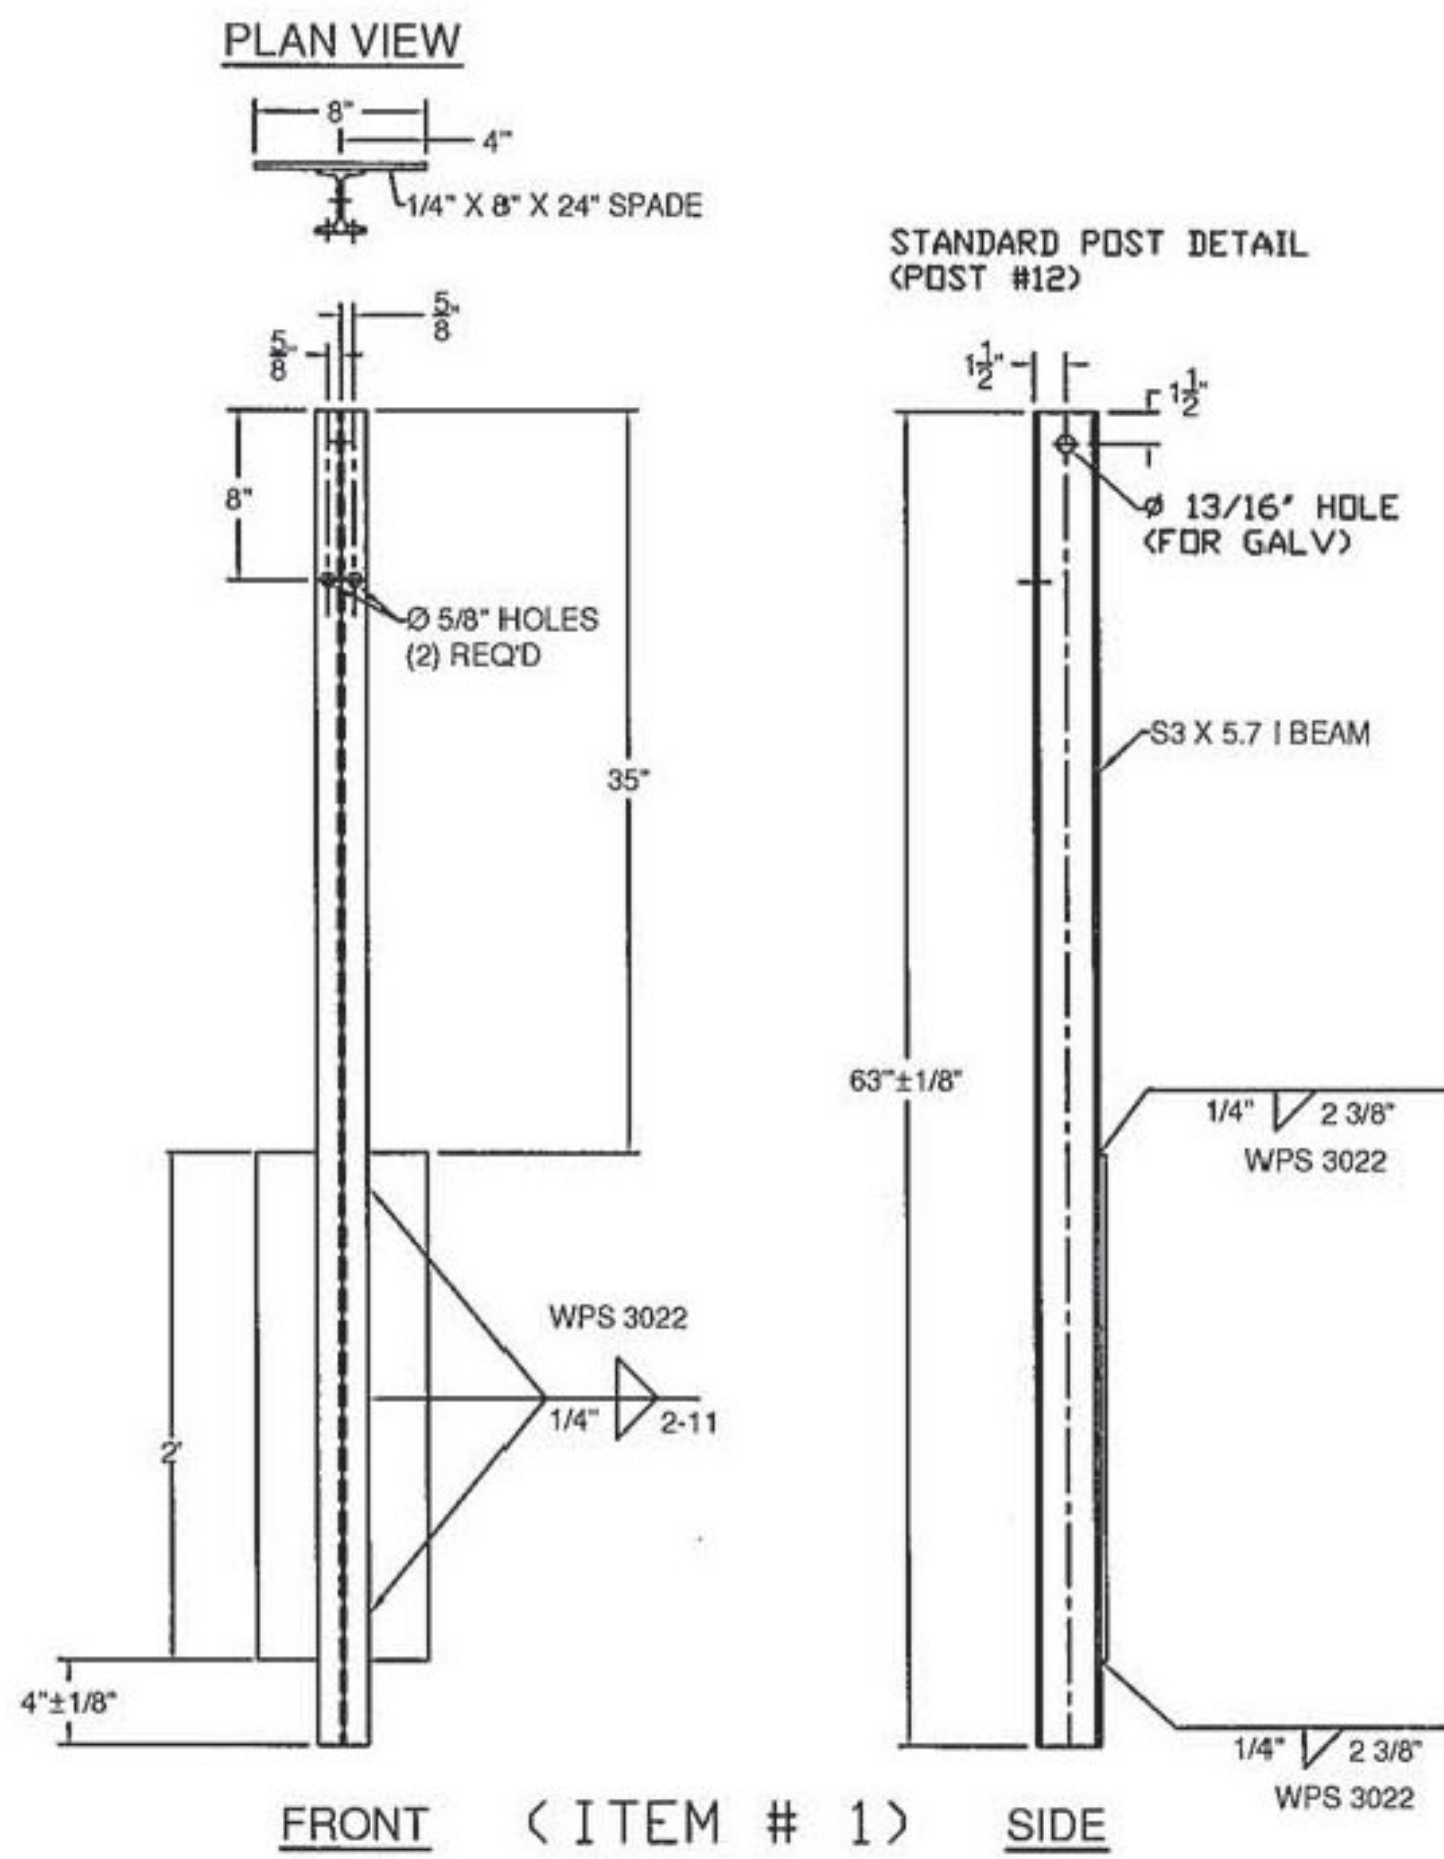

**GENERAL NOTES:**

- 1) ALL RAILING IS TO BE FABRICATED AND ERECTED ACCORDING TO SECTION 525 OF THE STANDARD SPECIFICATIONS.
- 2) BOLTS SHALL BE TORQUED SNUG TIGHT (APPROXIMATELY 100 FT-LB).
- 3) PROTRUSIONS CAUSED BY WELDING OR GALVANIZING ARE NOT PERMITTED ON THE ADJOINING SURFACES OF THE BOX BEAM RAILS, SPLICE TUBES AND FILL PLATES.
- 4) BOX BEAM TUBE AND STEEL POST MATERIALS, DIMENSION SIZES AND NOTES SHALL BE THE SAME AS THOSE OF THE BRIDGE RAIL, UNLESS OTHERWISE NOTED.
- 5) ANY BENDING OF RAIL SHALL BE DONE AT THE FABRICATION PLANT. RADII GREATER THAN 16' TO BE CURVED ON A TUBE BENDING MACHINE, RADII EQUAL OR LESS THAN 16' TO BE "PIE CUT" AND WELDED. CURVED RAILING WILL HAVE AN 18" LENGTH ON EACH END STRAIGHT TO ACCOMADATE SPLICES. "PIE CUTS ARE LOCATED SO AS TO NOT CONFLICT WITH POST FASTENING HOLES. PIE CUTS WILL BE WELDED ACCORDING TO PROCEDURE WPS-3026.

BILL OF MATERIALS (EACH CORNER)				
ITEM #	QTY.	COMPONENT #	DESCRIPTION	MATERIAL (ASTM)
1	3	0013.57021	S3 X 5.7 POST, PUNCH 8" W/SPD @ 63" LG	ASTM A572 Gr. 50
2	3	0013.57025	S3 X 5.7 POST, PUNCH 8", & 20" W/SPD @ 63" LG	ASTM A572 Gr. 50
3	2	0013.57060	S3 X 5.7 END POST W/SPD @ 3'-8" LG	ASTM A572 Gr. 50
4	4	0013.09001	W6 X 9 POST @ 7" W/SPD & 5/8" HOLES	ASTM A572 Gr. 50
5	4	0013.57010	S3 X 5.7 POST, PUNCH 8" & 20", W/8X32" SPADE @ 7"	ASTM A572 Gr. 50
6	1	0033.80403	3 X 5" BTM TRANS RAIL W/5'-0" KB, EXP END	A500 Gr. B
7	1	0033.00640	HSS 5X5 TUBE SPLICE @ 27" LG W/ 1/4" SHIMS	A500 Gr. B / A572 Gr 50
8	2	0033.00730	HSS 5x5 EXP TUBE SPLICE @ 36" LG W/ 1/4" SHIMS	A500 Gr. B / A572 Gr 50
9	1	0033.00930	BR EXP BAR SPLICE 2'-1/8" X 4'-1/4" @ 36" LG	ASTM A36
10	19	0054.00050	REG BB SHELF ANGLES @ 4'-1/2"	ASTM A36
12	1	0054.00074	HSS 5 X 5 X 5/16" DBL BEND TUBE SPL @ 27" LG,	A500 Gr. B / A572 Gr 50
13	8	0054.00563	6 X 8 X 1/4" TRANS. TUBE B/D @ 6' LG	A500 Gr. B
14	3	0054.00565	6 X 8 X 1/4" TRANS. TUBE B/D @ 3' LG	A500 Gr. B
15	1	0054.09000	6 X 6 X 3/16" BB @ 9'-0" KICKBACK, W/ CAP, & 13" MITER	A500 Gr. B / A36
*16	1	0054.18000	6 X 6 X 3/16" BB @ 9'-0" (THIS PAY ITEM), DRILL 3" CC	A500 Gr. B
17	1	0054.90092	6 X 6 X 3/16" BB TOP TRANS @ 20'-9 5/8" LG W/EXP END	A500 Gr. B
18	1	0054.90093	6 X 6 X 3/16" BB BTM TRANS @ 21'-4 5/8" LG W/EXP END	A500 Gr. B
19	18	0080.03355	3/8" X 7 1/2" BOLT, NUT, & 2 FW	A307, A563 DH, F436
20	19	0080.04100	1/2" x 1-1/2" BOLT, NUT, & FW	A307, A563 DH, F436
21	22	0080.04120	1/2" x 1-1/2" BOLT, NUT, 2 FW & LW	A307, A563 DH, F436
22	4	0080.06255	3/4" X 4-1/2" BOLT, NUT, 2 FW	A325, A563 DH, F436
23	12	0080.06340	3/4" X 7-1/2" BOLT, NUT, 2 FW	A325, A563 DH, F436
24	6	0080.06370	3/4" X 8" CARR BOLT, NUT, FW & LW	A307, A563 DH, F436
25	2	0080.06400	3/4" X 8" BOLT, NUT, 2 FW, & LW	A325, A563 DH, F436

* - WW #4 - SPECIAL LENGTH W/ 16' RADIUS IN PAY ITEM 621.30

HARDWARE NOTES	
ITEM #	FUNCTION
19	BOLT RAIL TO SHELF ANGLE (ITEM #10)
20	BOLT SHELF ANGLE (ITEM #'S 10 & 11) TO POST
21	BOLT BLOCK-OUTS (ITEM #'S 13 & 14) TO HEAVY POST
22	(4) PER SPLICE BAR (ITEM #9)
23	(4) PER SPLICE TUBING (ITEM #'S 7 & 8)
24	BOLT RAIL (ITEMS #'S 6,17, & 18 TO BLOCK-OUTS (ITEM #'S 13 & 14) [WHERE FASTENED]
25	BOLT DOUBLE BEND SPLICE TUBE (ITEM #12) TO RAIL (ITEM #18) & KICKBACK (ITEM #15)

APPLICABLE NOTES IN THE BRIDGE RAIL DRAWING SHALL ALSO BE APPLICABLE ON THESE DRAWINGS

Vermont Agency of Transportation  
**RECEIVED**  
 CK'D BY GL OK'D BY JS  
 January 9, 2015  
 RESUBMIT no Approved  
 BY KH DATE 1-20-2015

ITEM #: 621.725  
 STRUCTURAL STEEL TO COMPLY W/ ASTM A6  
 TOLERANCE UNLESS OTHERWISE NOTED:  
 FRACTIONS = ± 1/16"  
 ANGLES = ± 1/2"  
 DIAMETERS = ± 1/32"




**GUARD RAIL TO BRIDGE RAIL TRANSITION DETAILS SHEET**  
 TOWN HIGHWAY 46 (IRISH SETTLEMENT ROAD), BRIDGE #28  
 TOWN OF CAMBRIDGE, COUNTY OF LAMOILLE, VT.

R NO.	DATE	DESCRIPTION	BY	R NO.	DATE	DESCRIPTION	BY
1	1/7/15	REVISED PER 12/29/14 MARK-UP	EP				






  

DRAWN	E.P.	12/3/14
CHECKED	D.L.	12/3/14
APPROVED		
SCALE	SCHEMATIC	
DRAWING NO. F.R.L.-CAMBRIDGE-T		

**ELDERLEE, INC.**  
 OAKS CORNERS, NEW YORK 14518  
 E-Mail: [dlong@elderlee.com](mailto:dlong@elderlee.com) / [epook@elderlee.com](mailto:epook@elderlee.com)  
 Tel: 315-789-6670 Fax: 315-789-6615

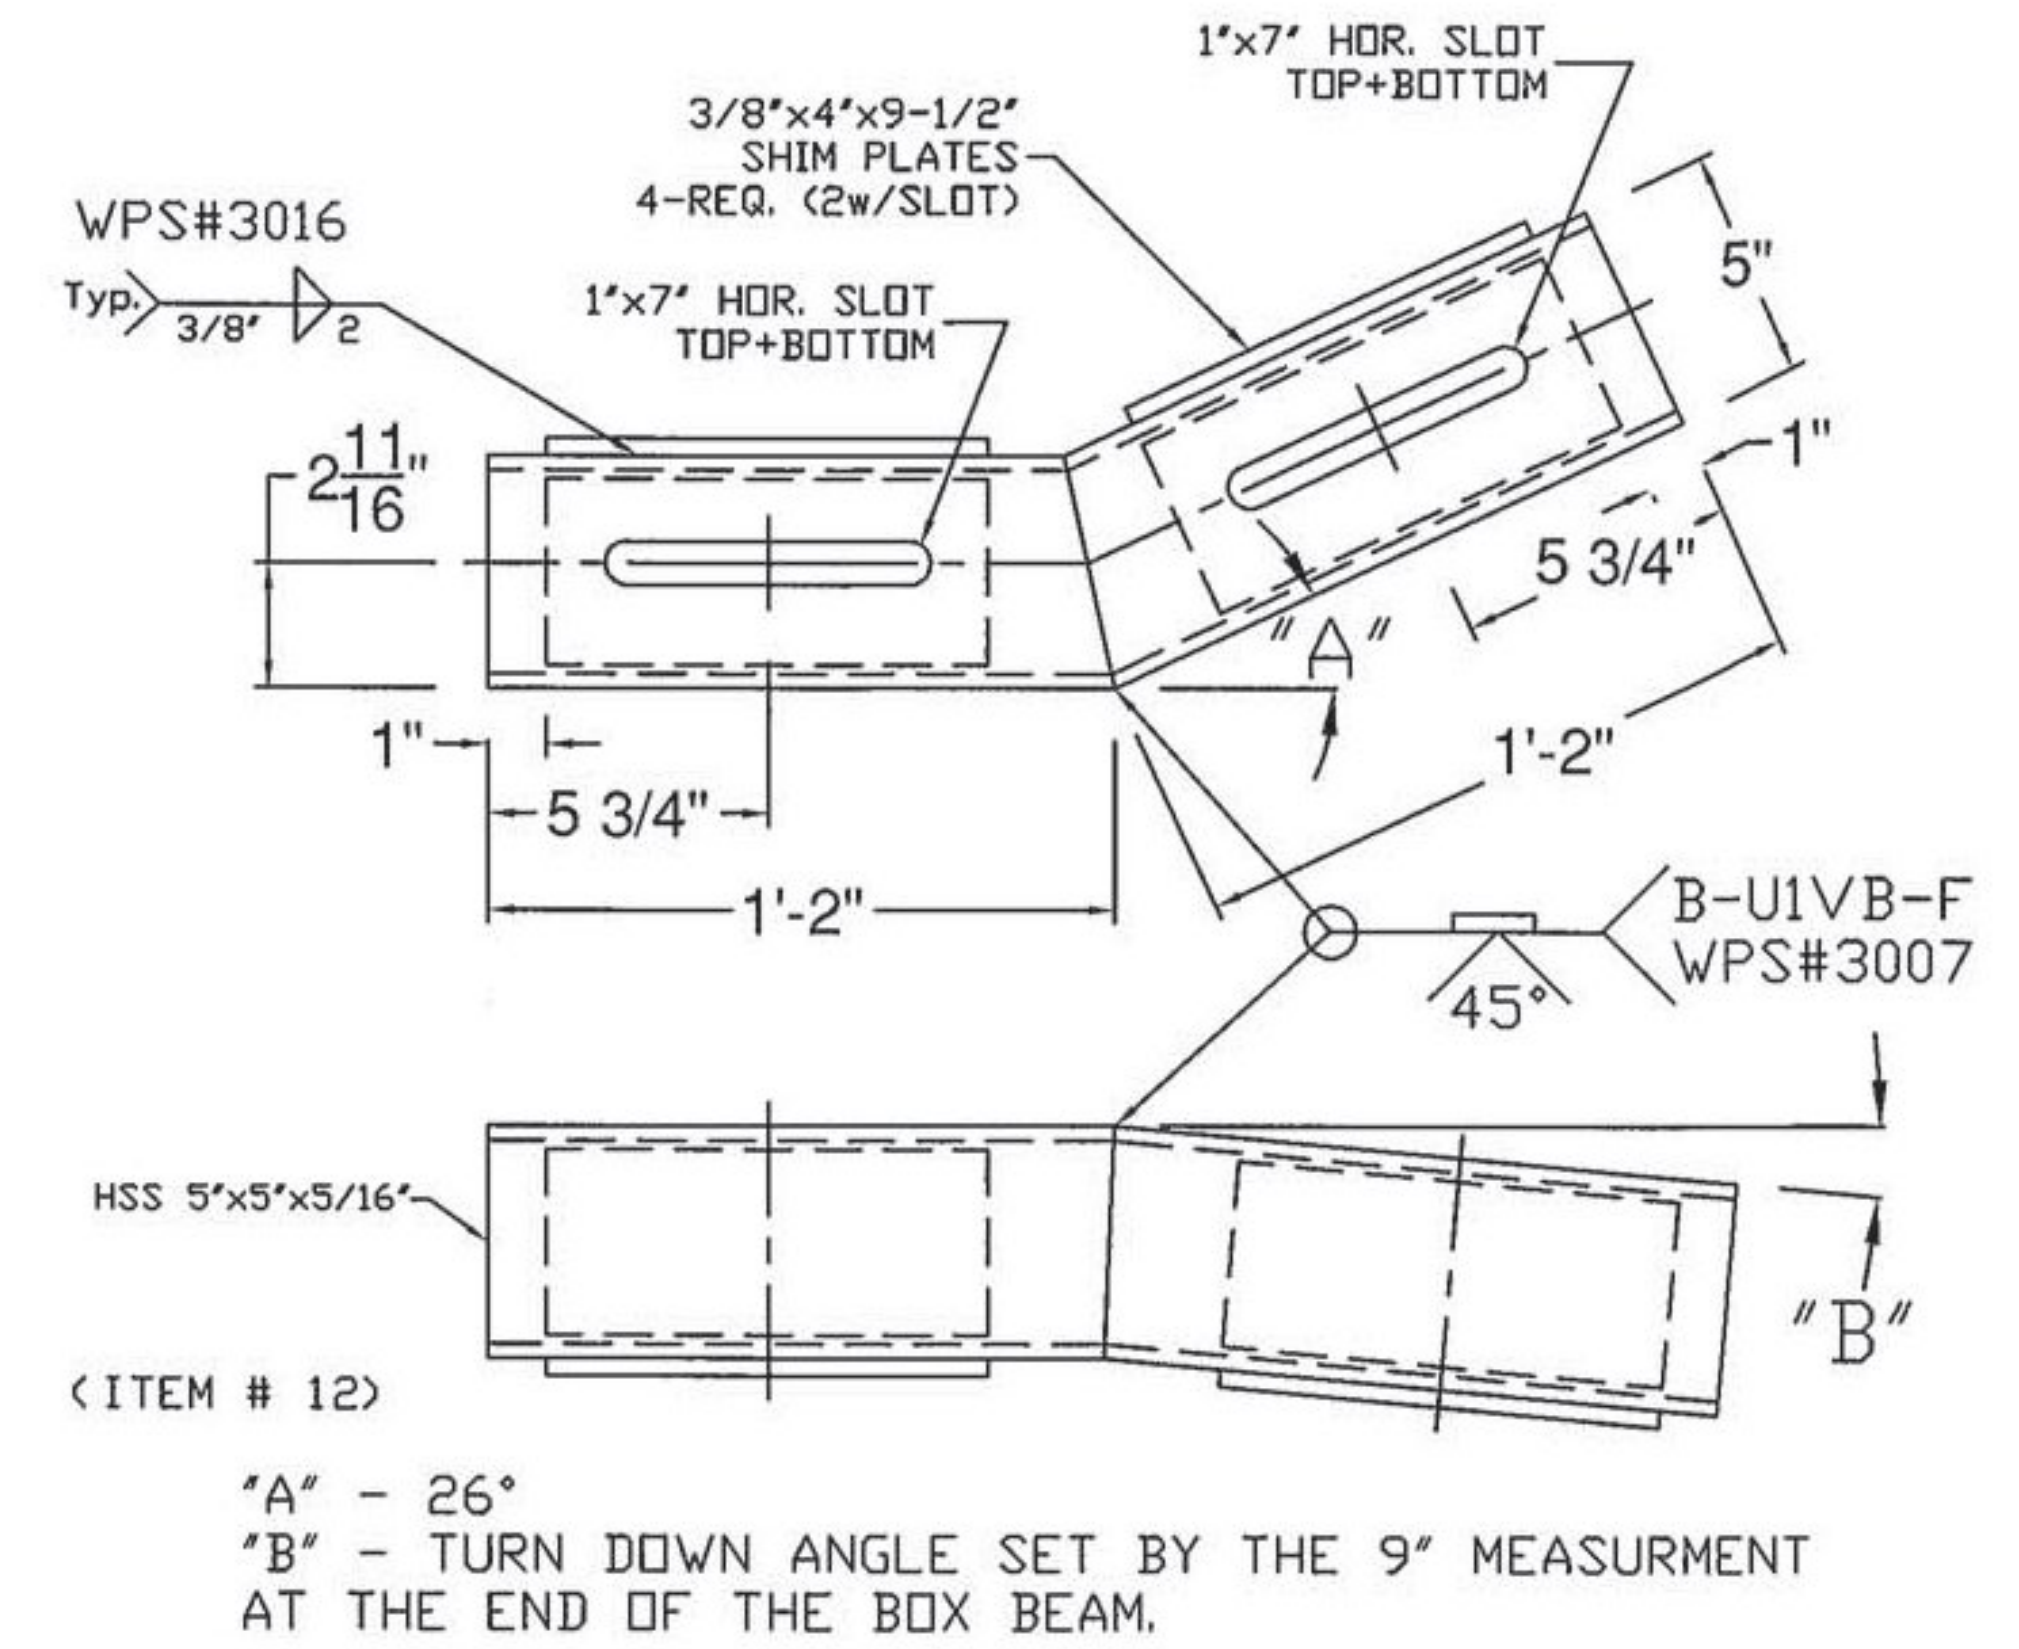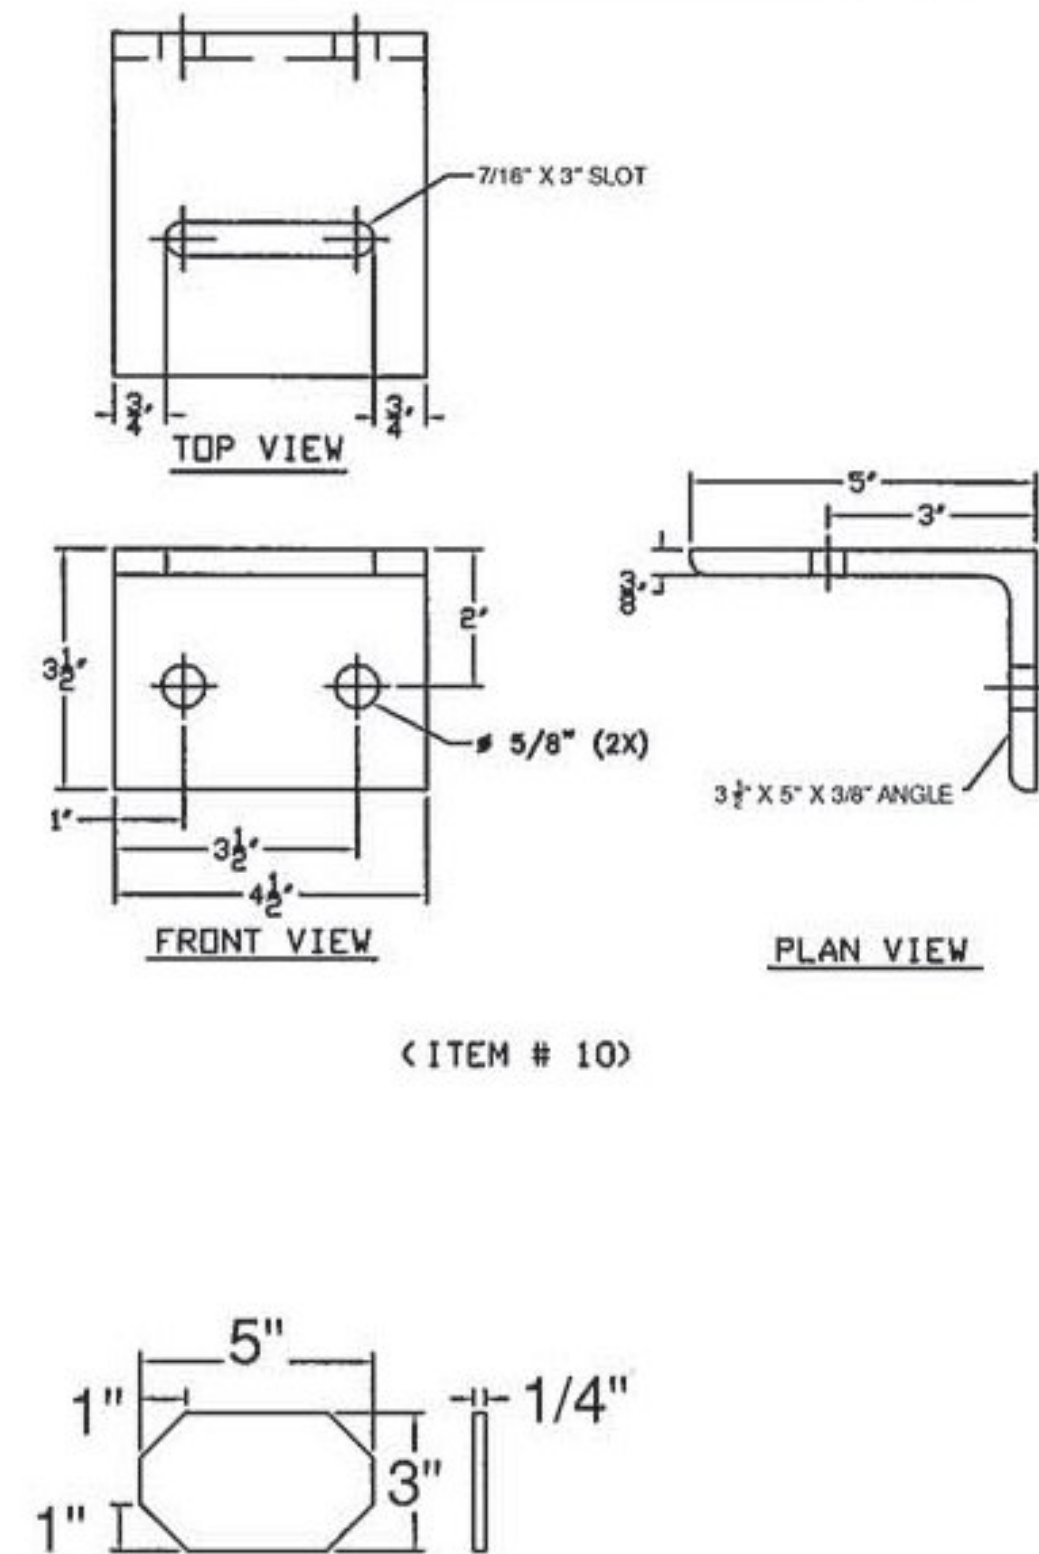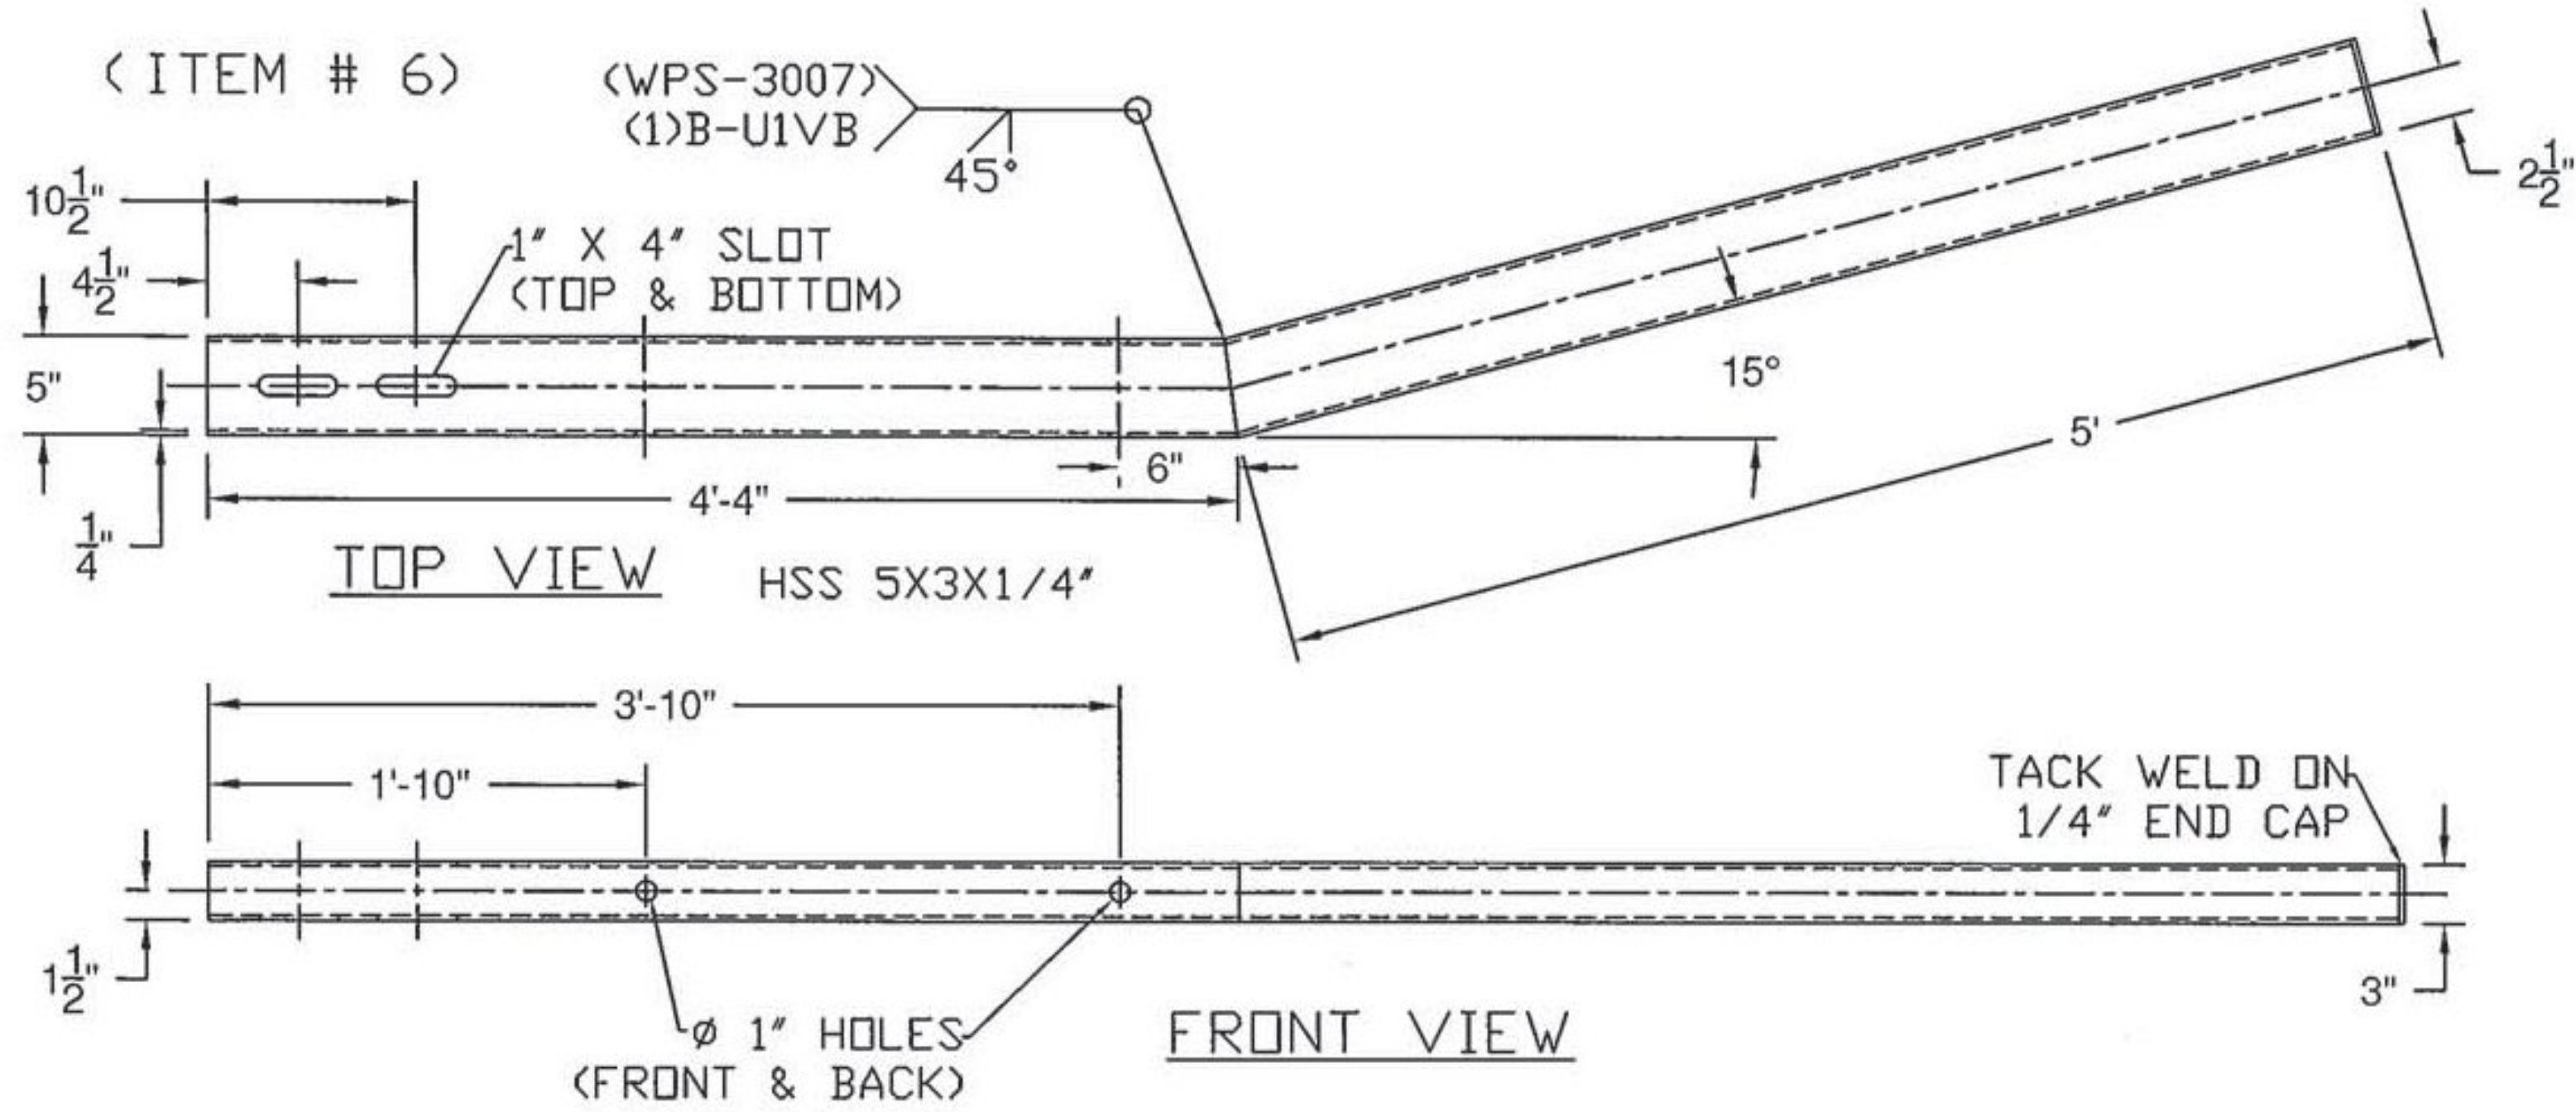

Vermont Agency of Transportation  
**RECEIVED**  
 CK'D BY GL OK'D BY JS  
 January 9, 2015  
 RESUBMIT no Approved  
 BY KH DATE 1-20-2015

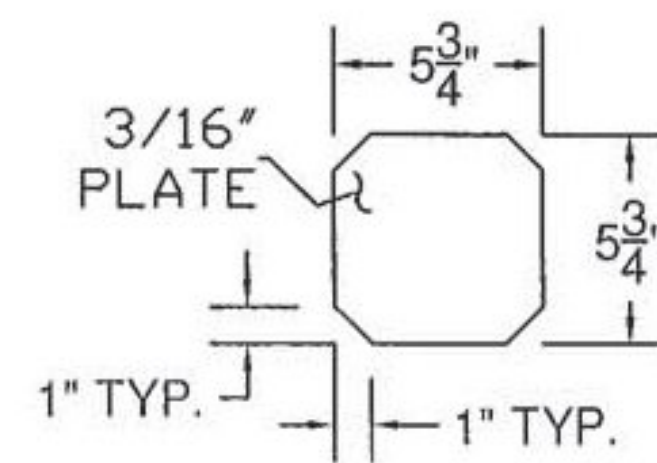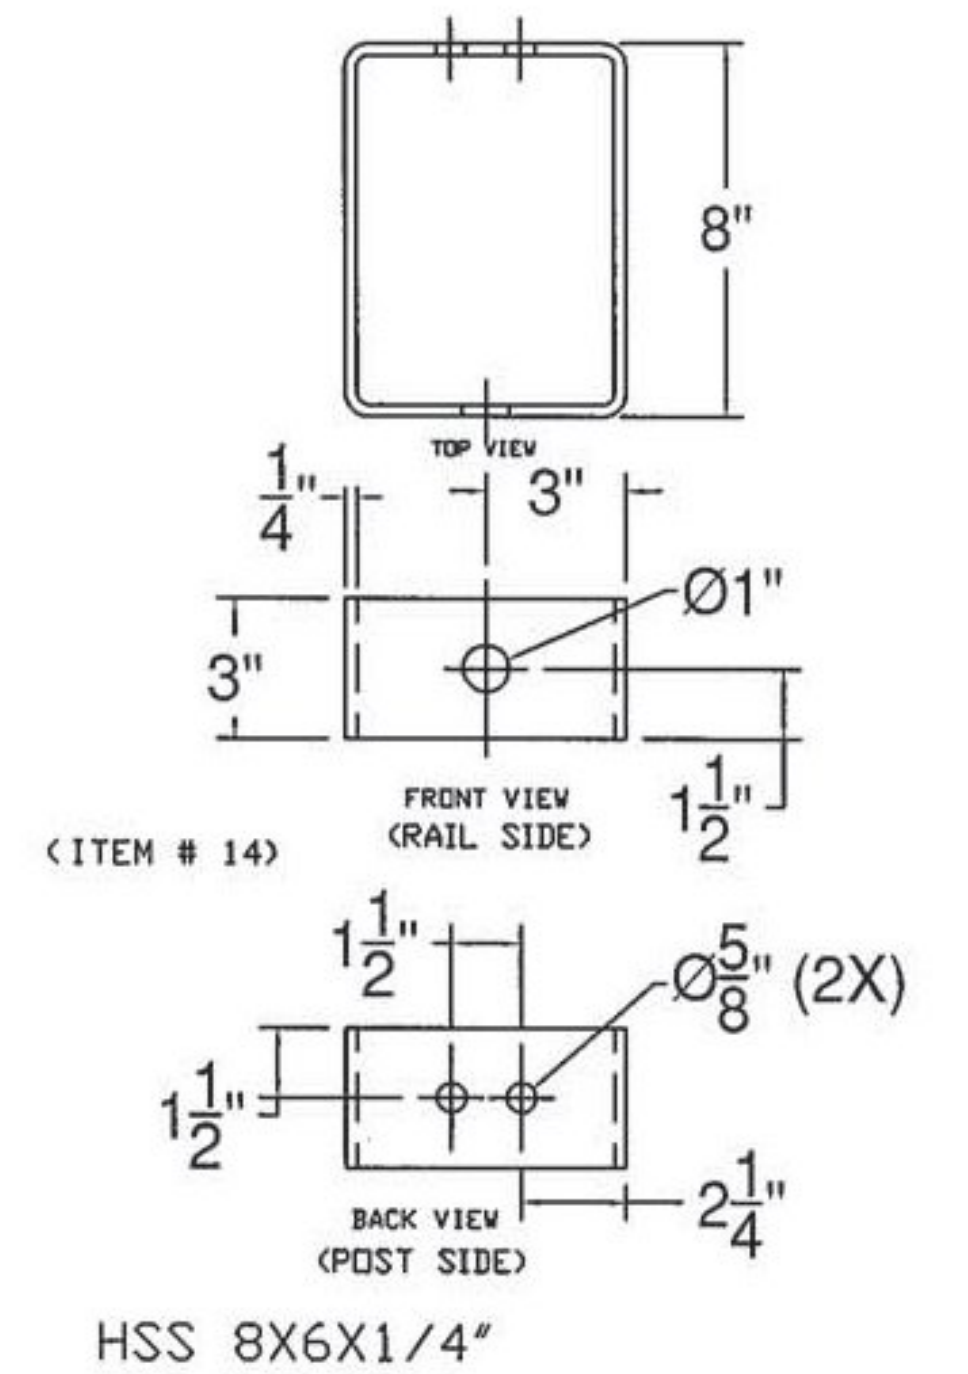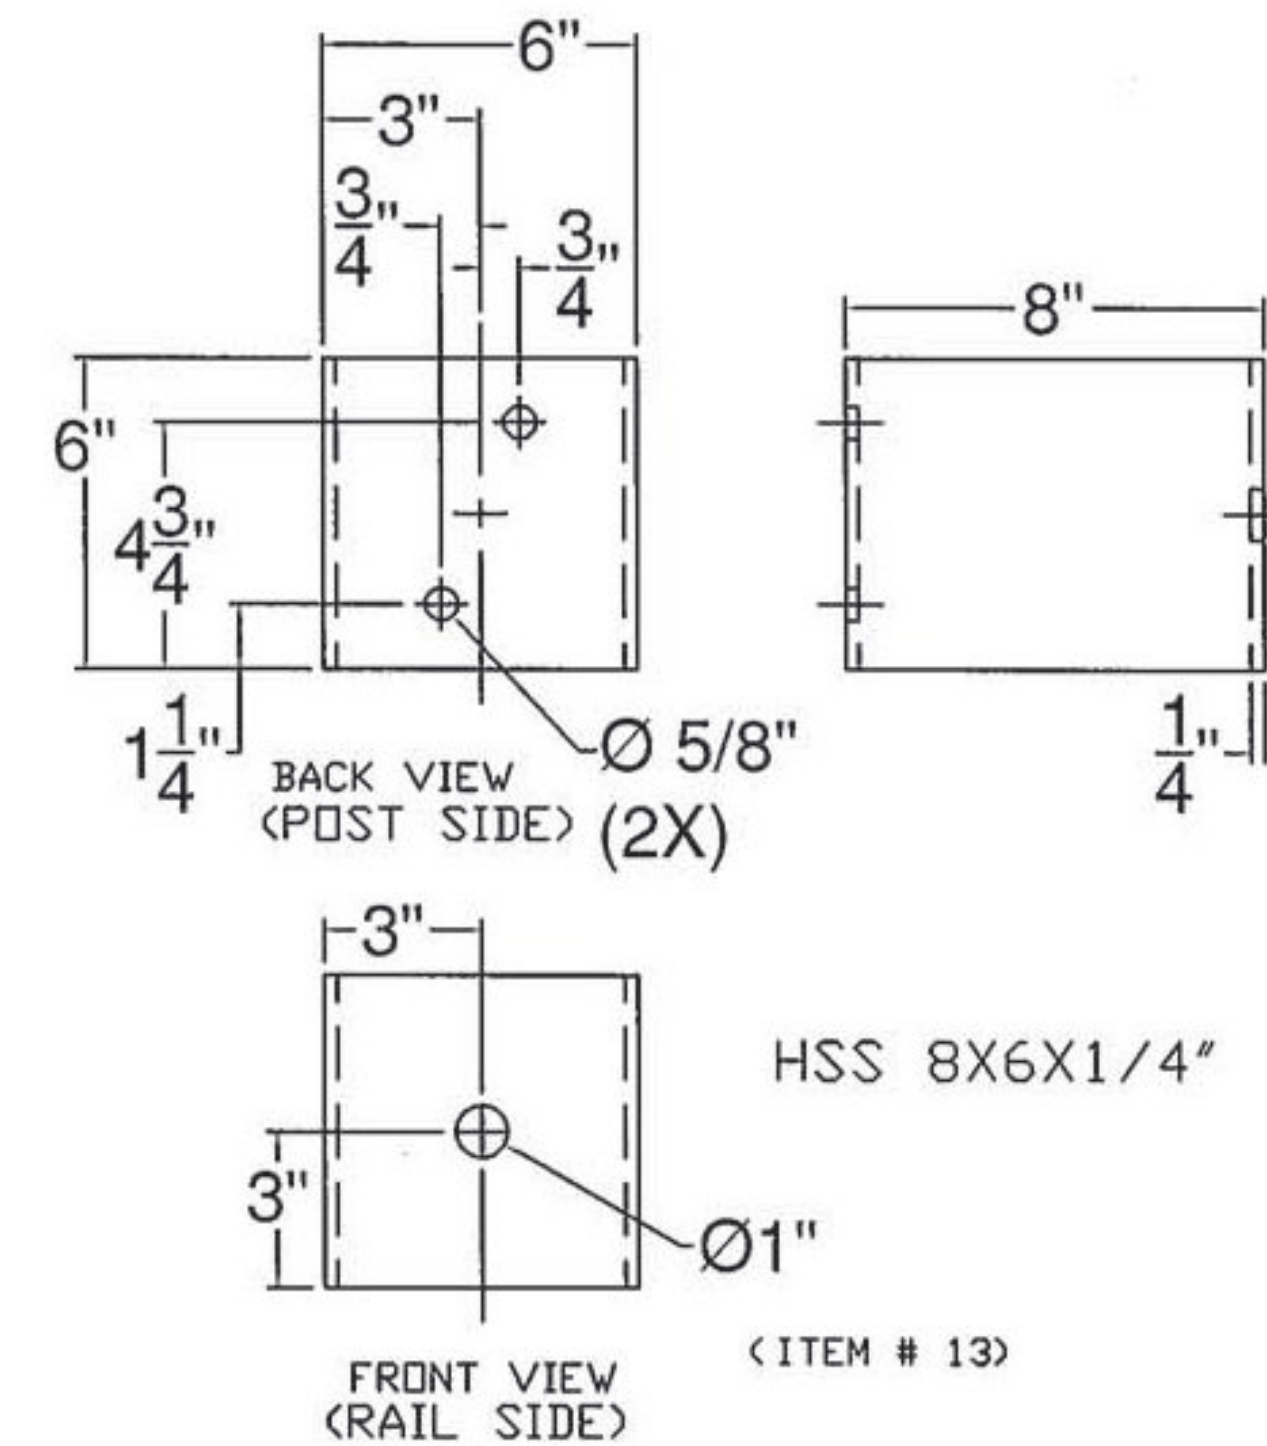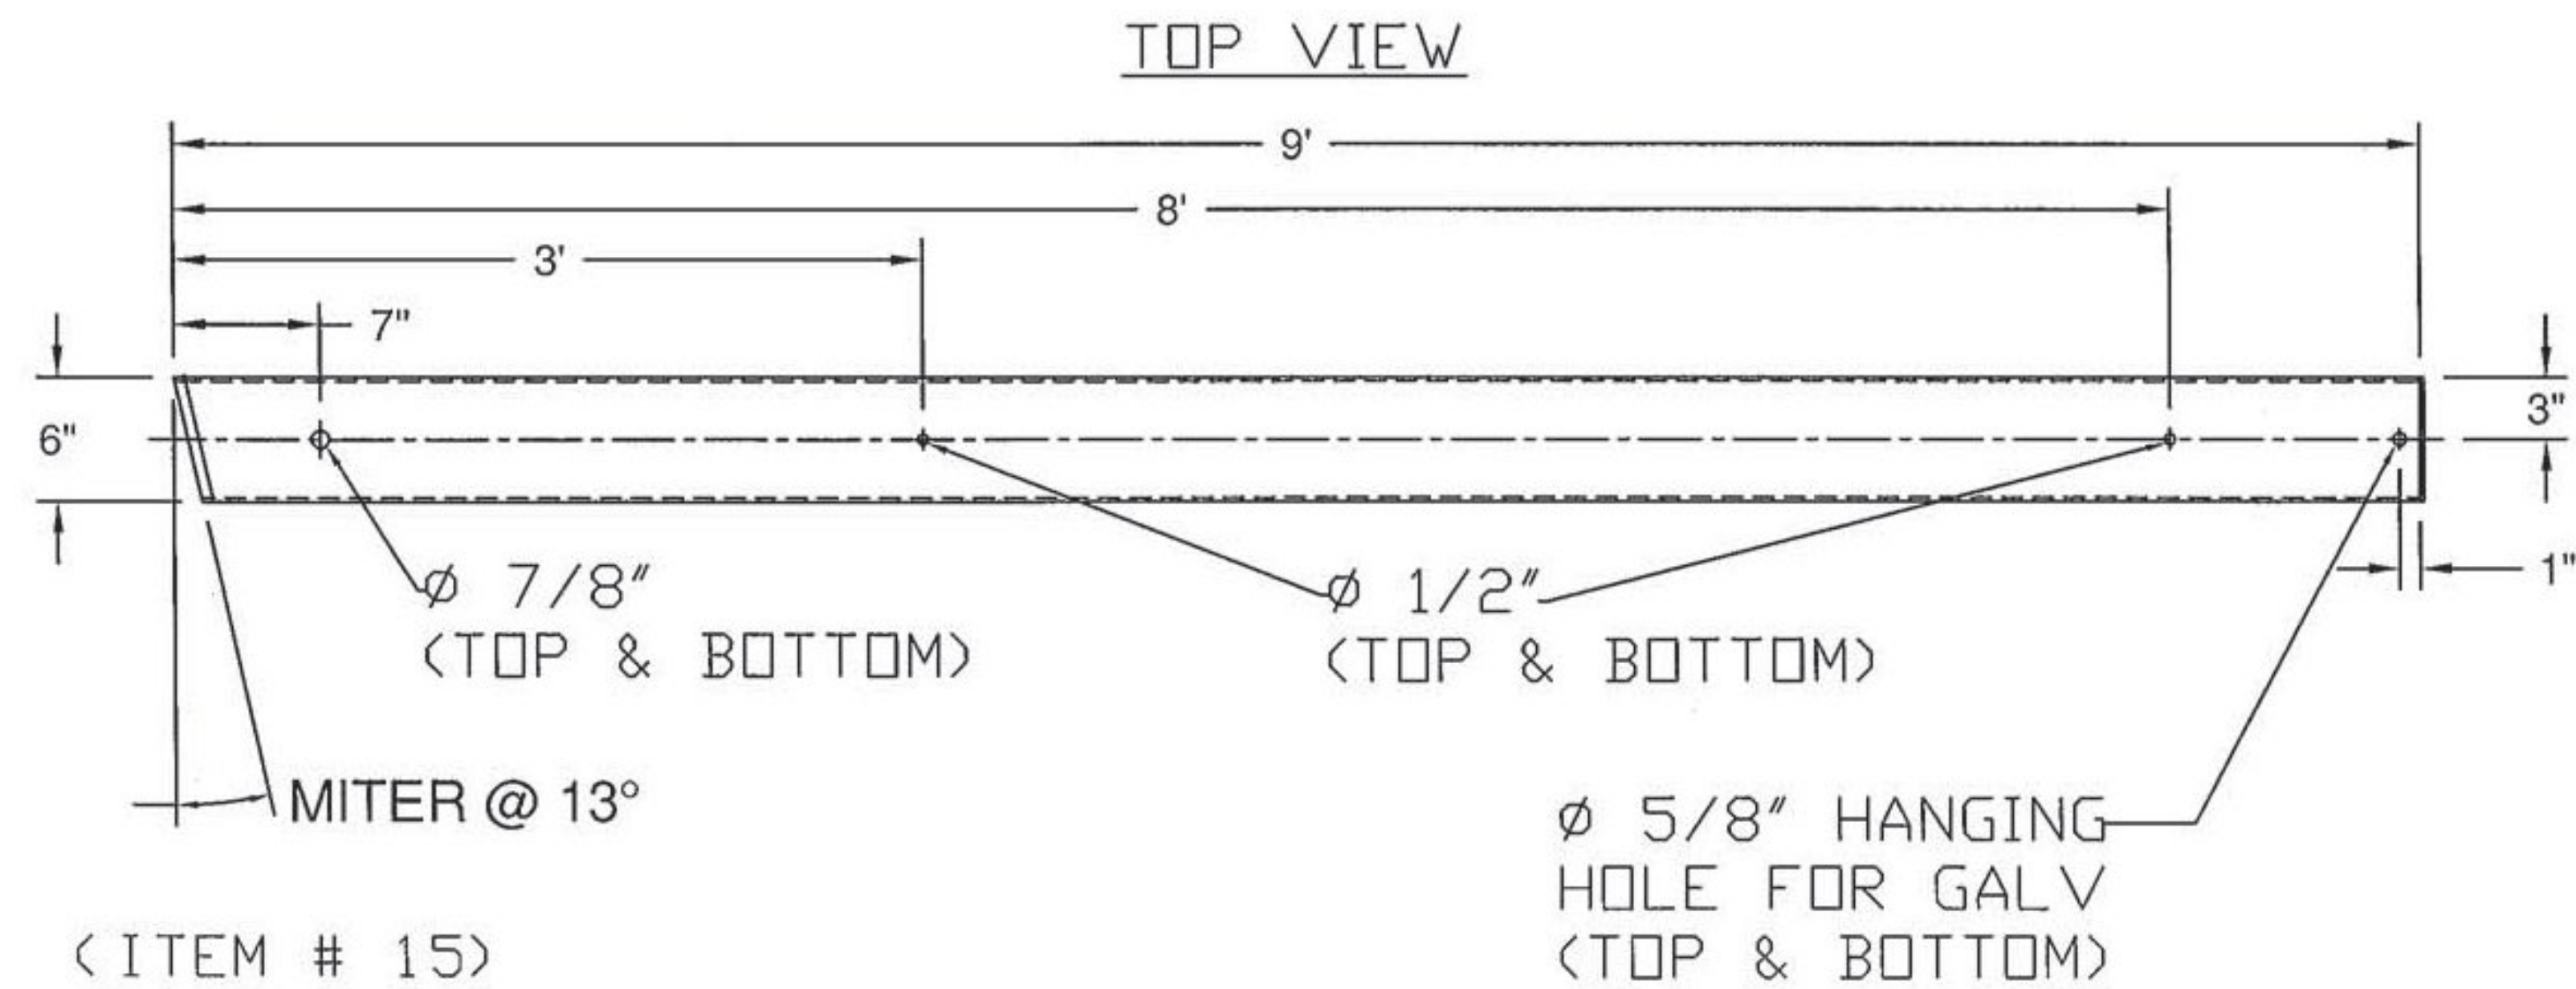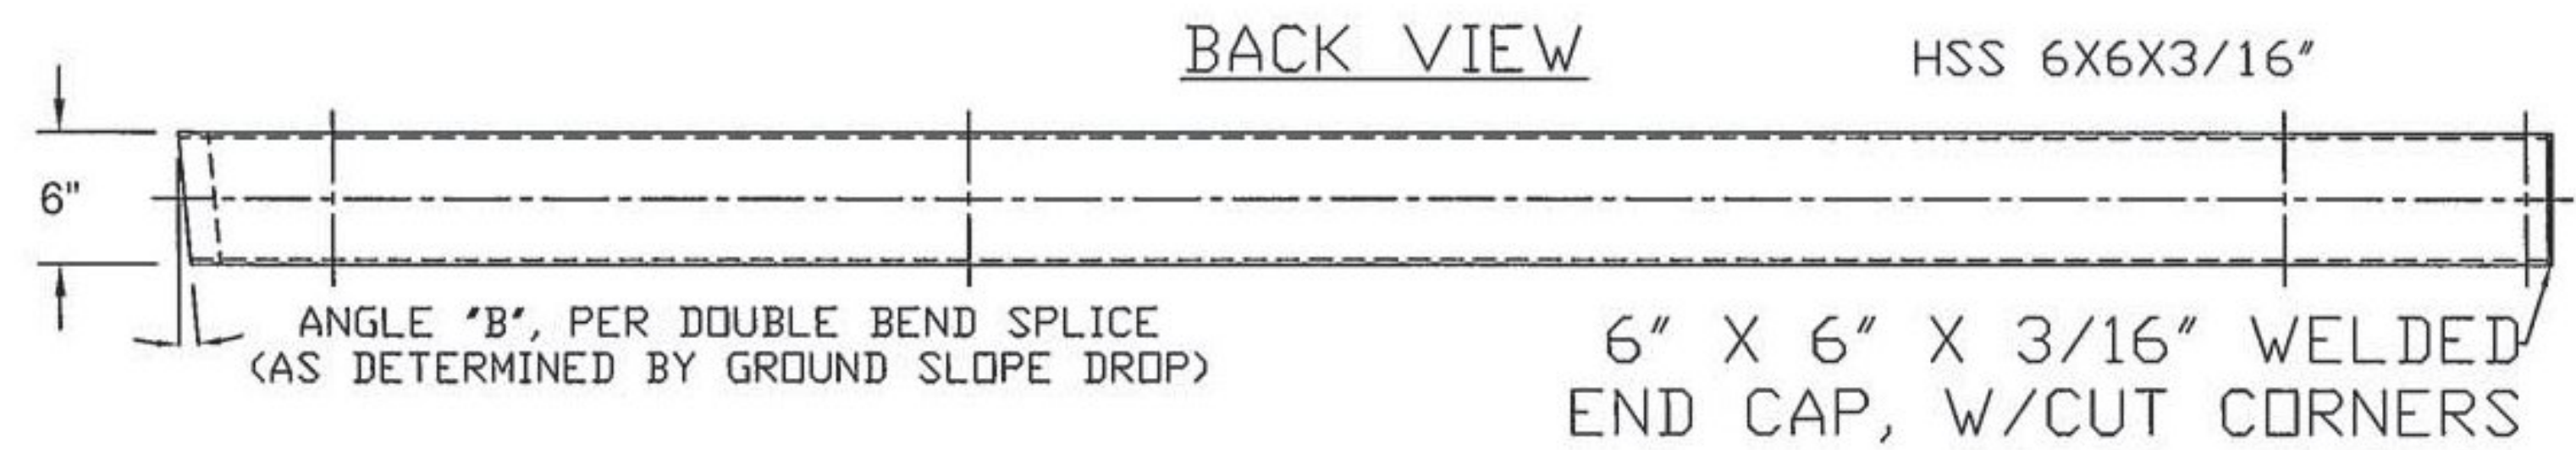

ITEM #: 621.725  
 STRUCTURAL STEEL TO COMPLY W/ ASTM A6  
 TOLERANCE UNLESS OTHERWISE NOTED:  
 FRACTIONS = ± 1/16"  
 ANGLES = ± 1/2°  
 DIAMETERS = ± 1/32"




SHEET 3 OF 5

**GUARD RAIL TO BRIDGE RAIL TRANSITION DETAILS SHEET**  
 TOWN HIGHWAY 46 (IRISH SETTLEMENT ROAD), BRIDGE #28  
 TOWN OF CAMBRIDGE, COUNTY OF LAMOILLE, VT.

R NO.	DATE	DESCRIPTION	BY	R NO.	DATE	DESCRIPTION	BY
E 1	1/7/15	REVISED PER 12/29/14 MARK-UP	EP				

ELDERLEE, INC.  
 OAKS CORNERS, NEW YORK 14518  
 E-Mail: dlong@elderlee.com / epeek@elderlee.com  
 Tel: 315-789-6670 Fax: 315-789-6615

DRAWN E.P. 12/3/14  
 CHECKED D.L. 12/3/14  
 APPROVED  
 SCALE SCHEMATIC  
 DRAWING NO. F.R.L.-CAMBRIDGE-T

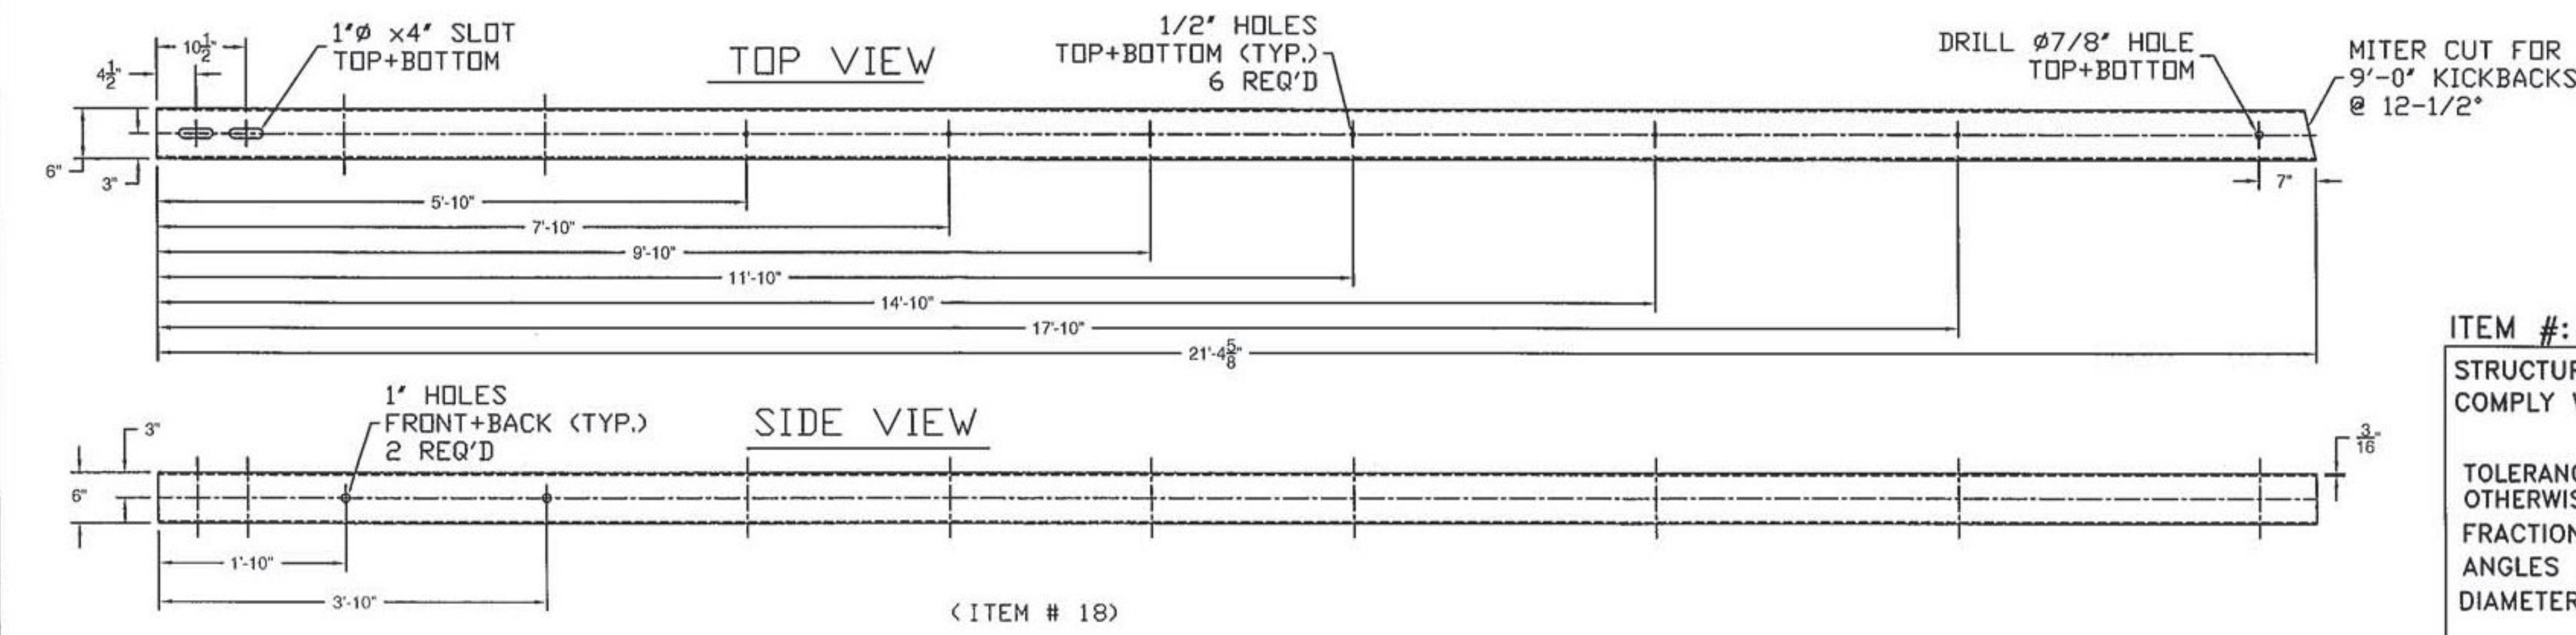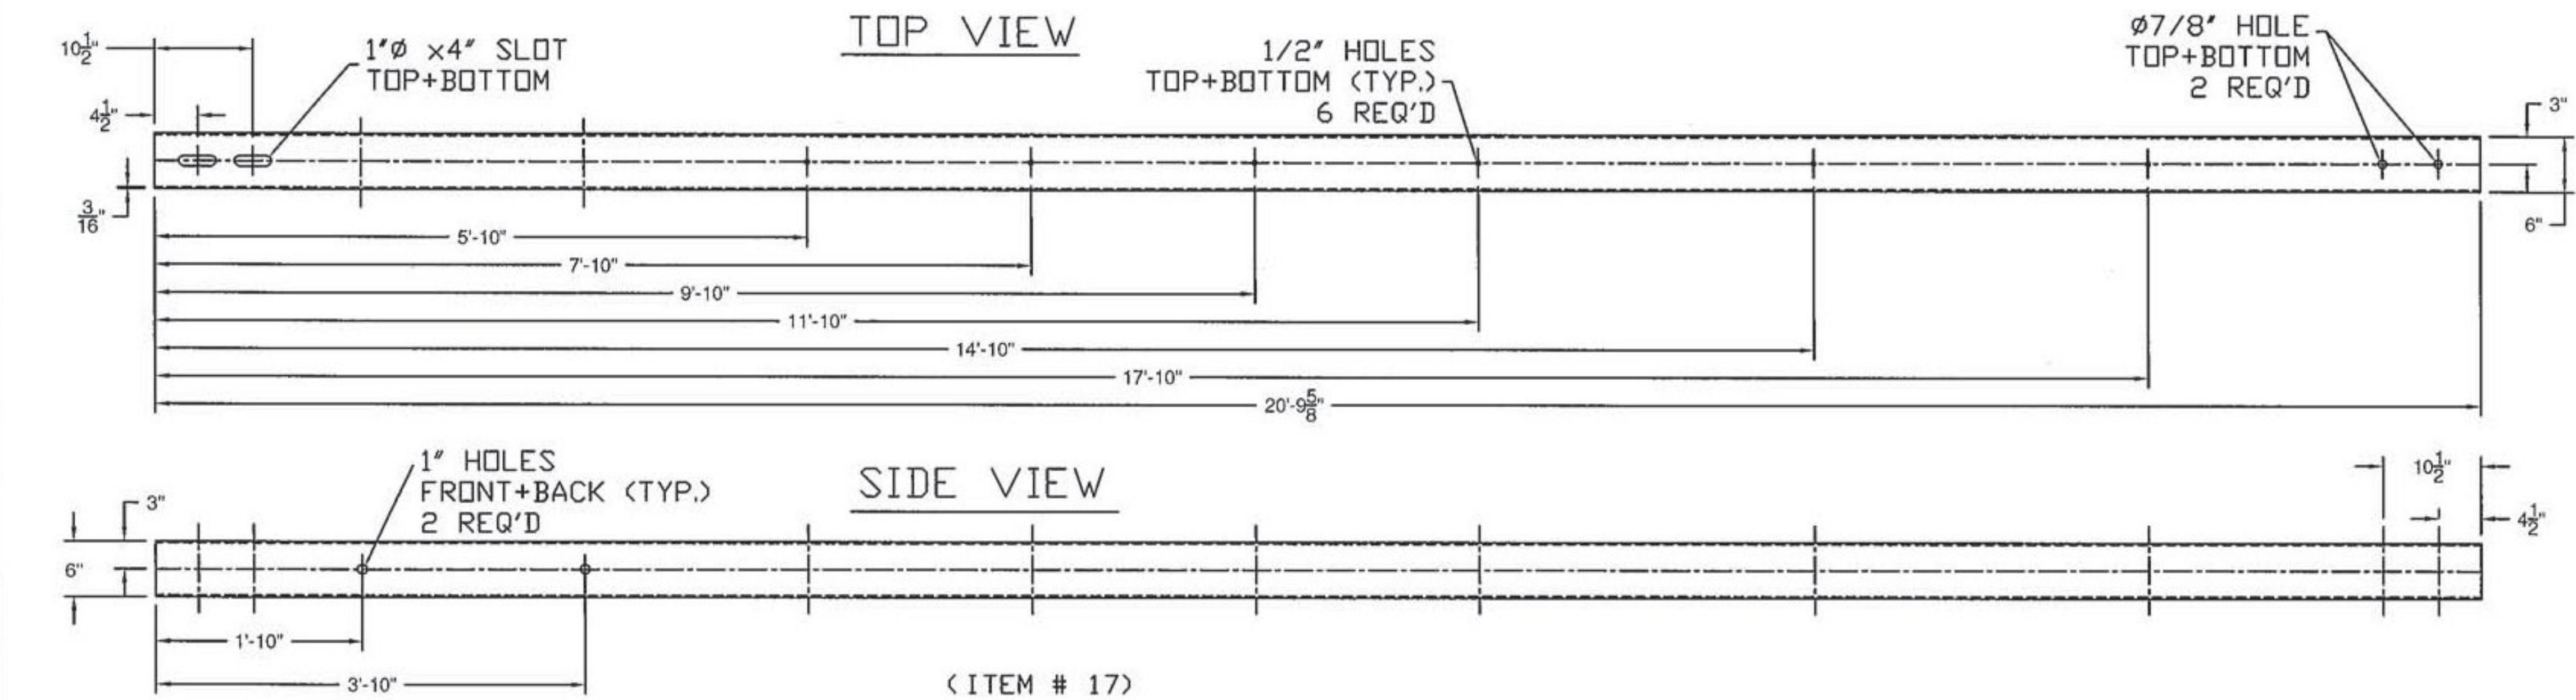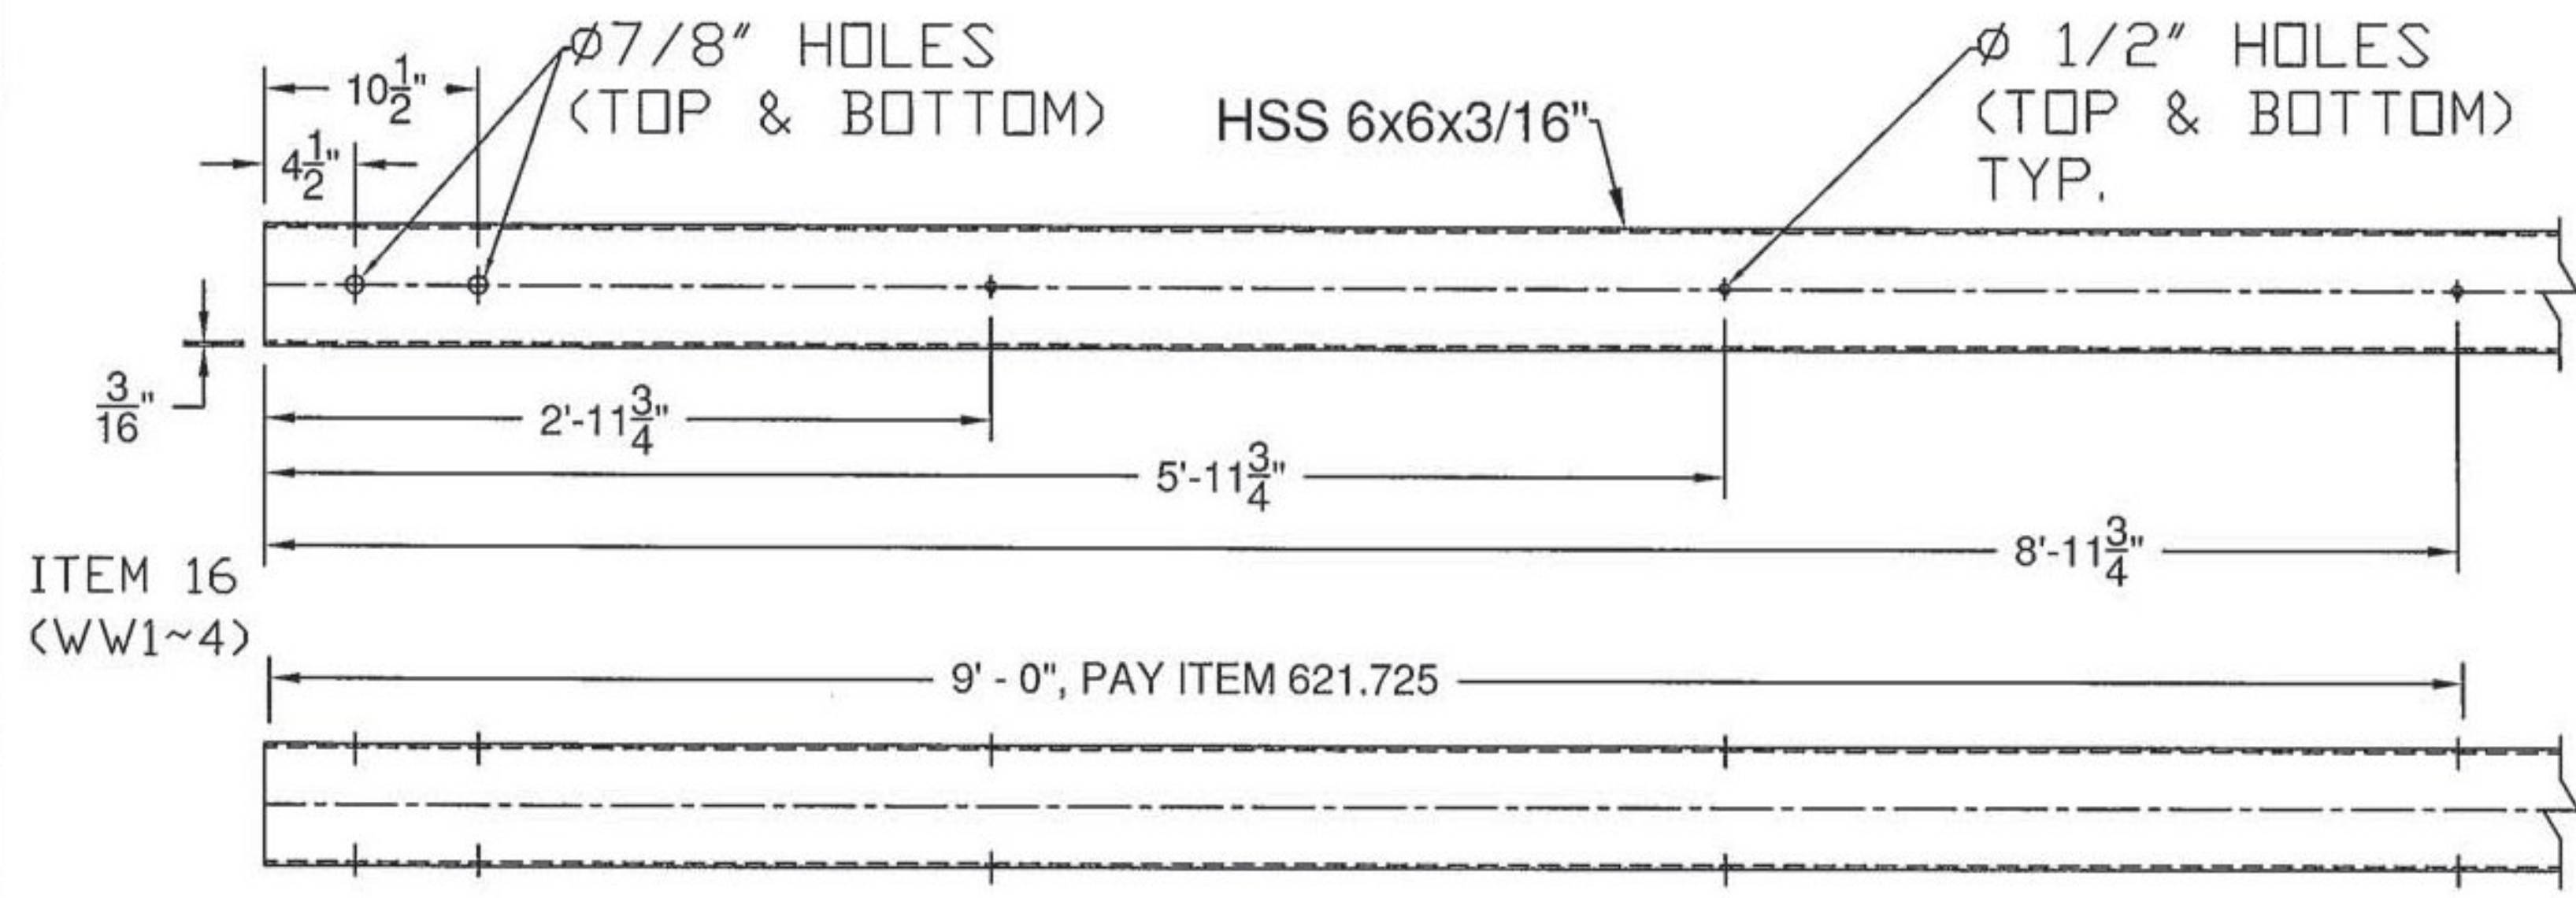

Vermont Agency of Transportation  
**RECEIVED**  
 CK'D BY GL OK'D BY JS  
 January 9, 2015  
 RESUBMIT no Approved  
 BY KH DATE 1-20-2015

ITEM #: 621.725  
 STRUCTURAL STEEL TO COMPLY W/ ASTM A6  
 TOLERANCE UNLESS OTHERWISE NOTED:  
 FRACTIONS = ± 1/16"  
 ANGLES = ± 1/2"  
 DIAMETERS = ± 1/32"

SHEET 4 OF 5



**GUARD RAIL TO BRIDGE RAIL TRANSITION DETAILS SHEET**  
 TOWN HIGHWAY 46 (IRISH SETTLEMENT ROAD), BRIDGE #28  
 TOWN OF CAMBRIDGE, COUNTY OF LAMOILLE, VT.

R NO.	DATE	DESCRIPTION	BY	R NO.	DATE	DESCRIPTION	BY
1	1/7/15	REVISED PER 12/29/14 MARK-UP	EP				


DRAWN	E.P.	12/3/14
CHECKED	D.L.	12/3/14
APPROVED		
SCALE	SCHEMATIC	
DRAWING NO. F.R.L.-CAMBRIDGE-T		

**ELDERLEE, INC.**  
 OAKS CORNERS, NEW YORK 14518  
 E-Mail: dlong@elderlee.com / epeek@elderlee.com  
 Tel: 315-789-6670 Fax: 315-789-6615


**SPLICE BAR - EXPANSION**

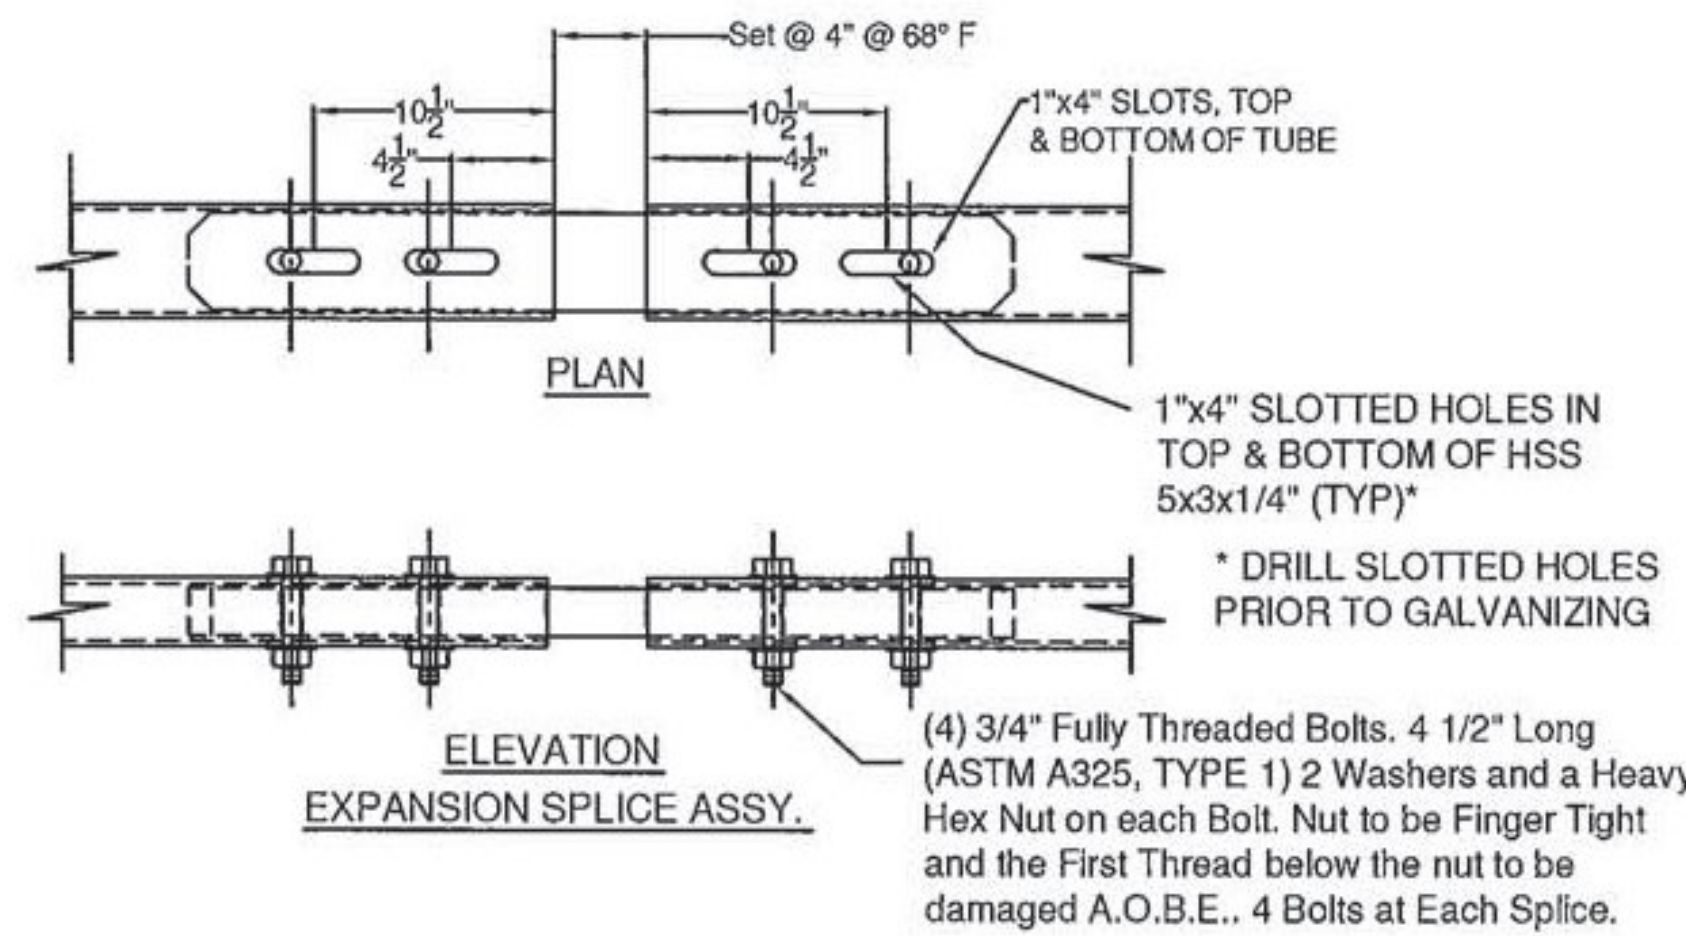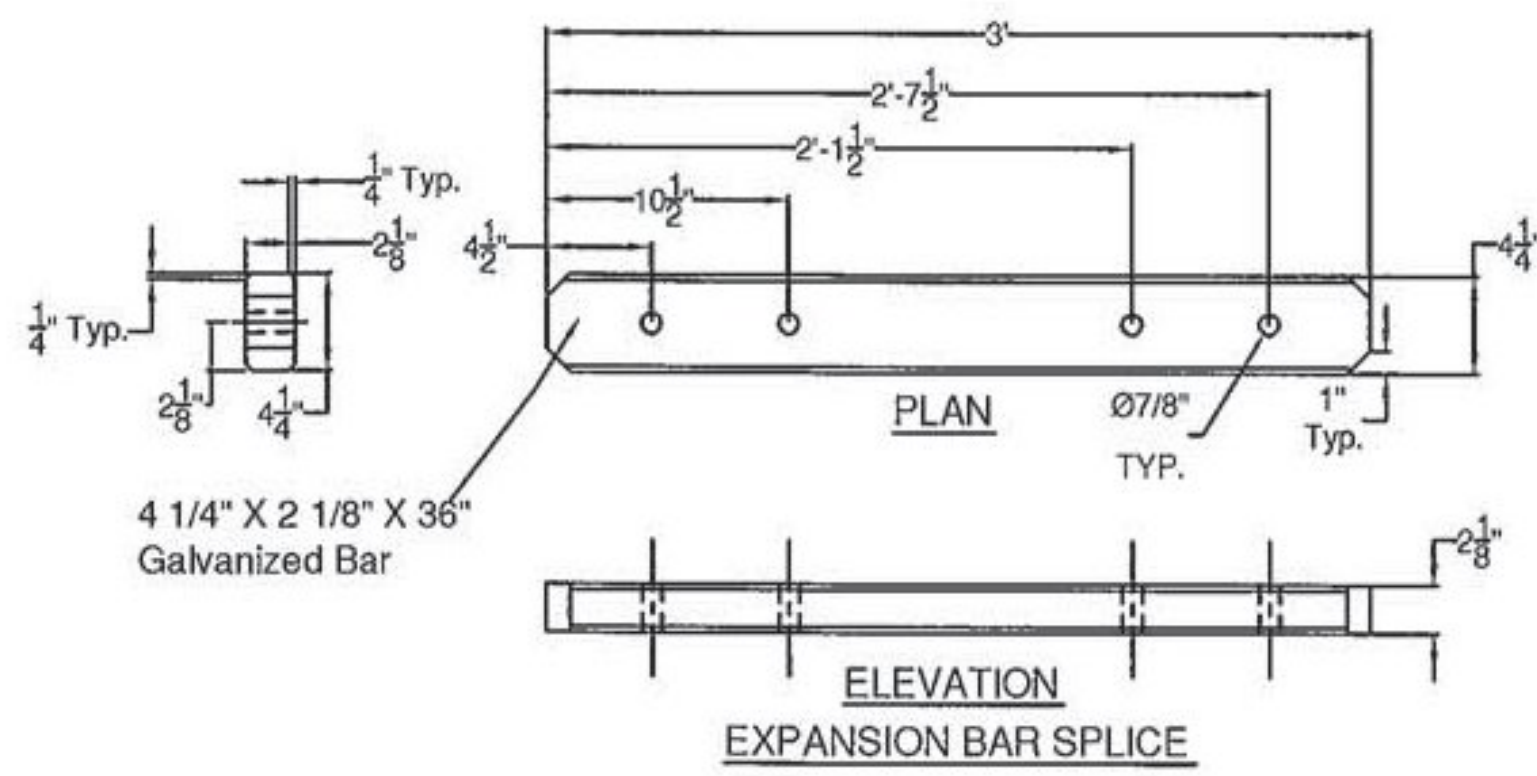



< ITEM # 9 >

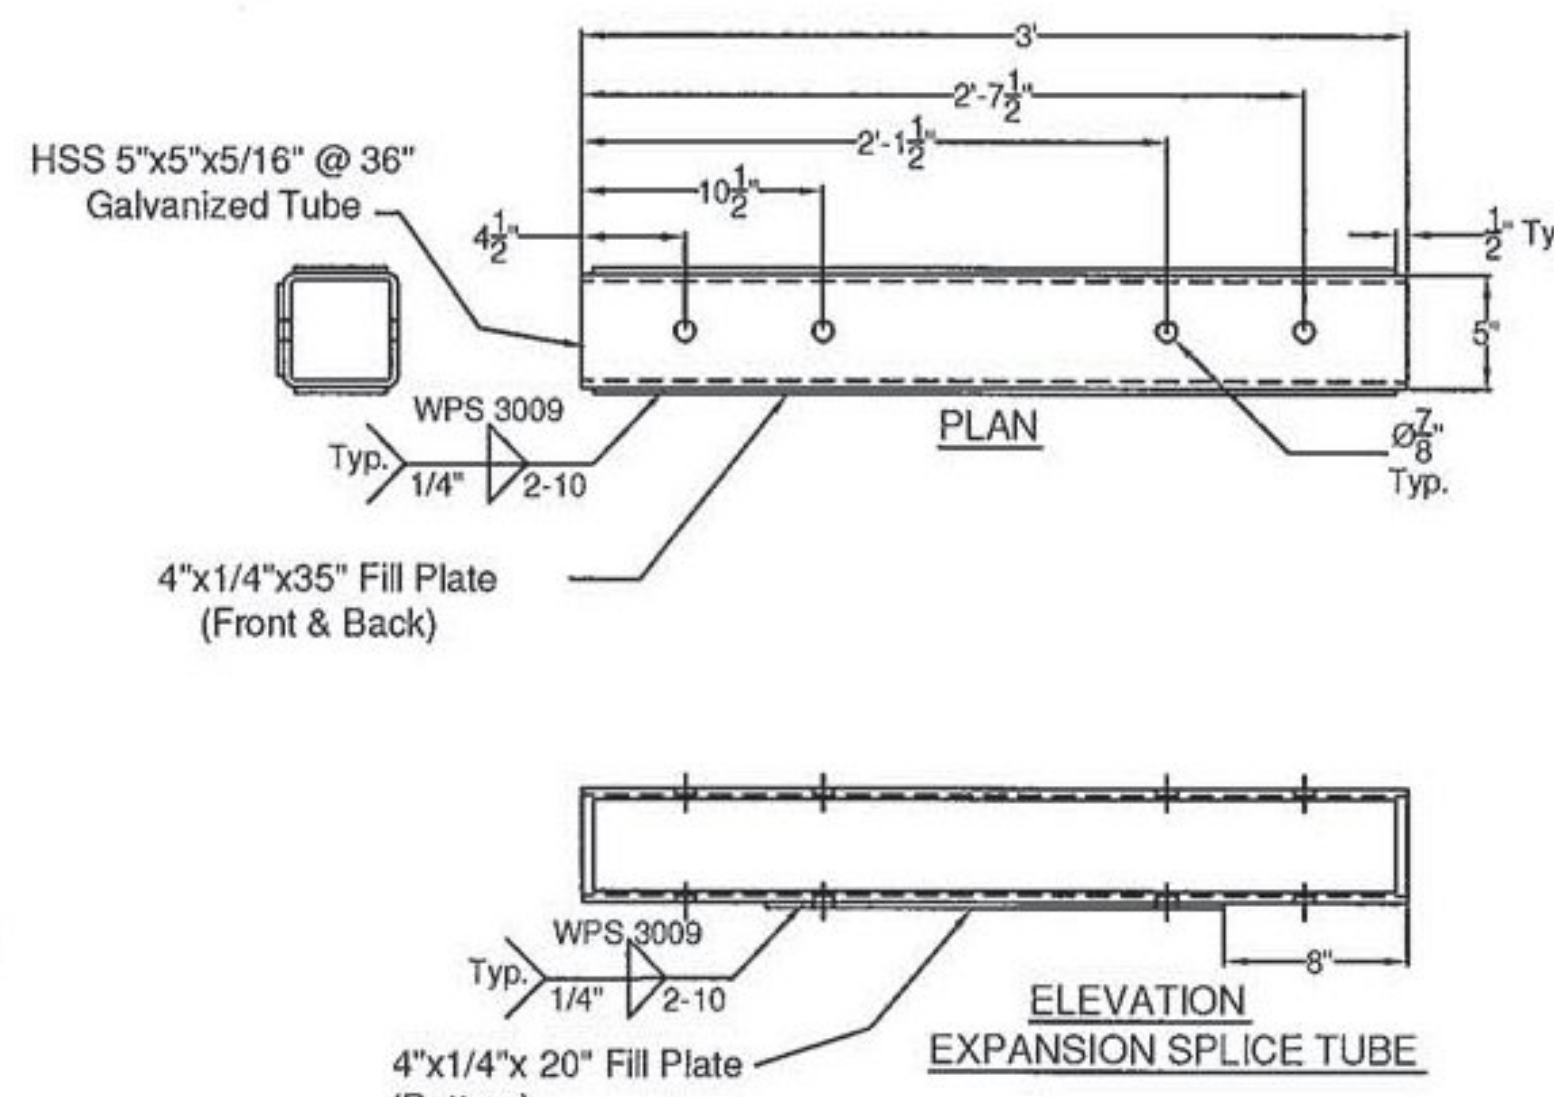

**SPLICE TUBE - EXPANSION**

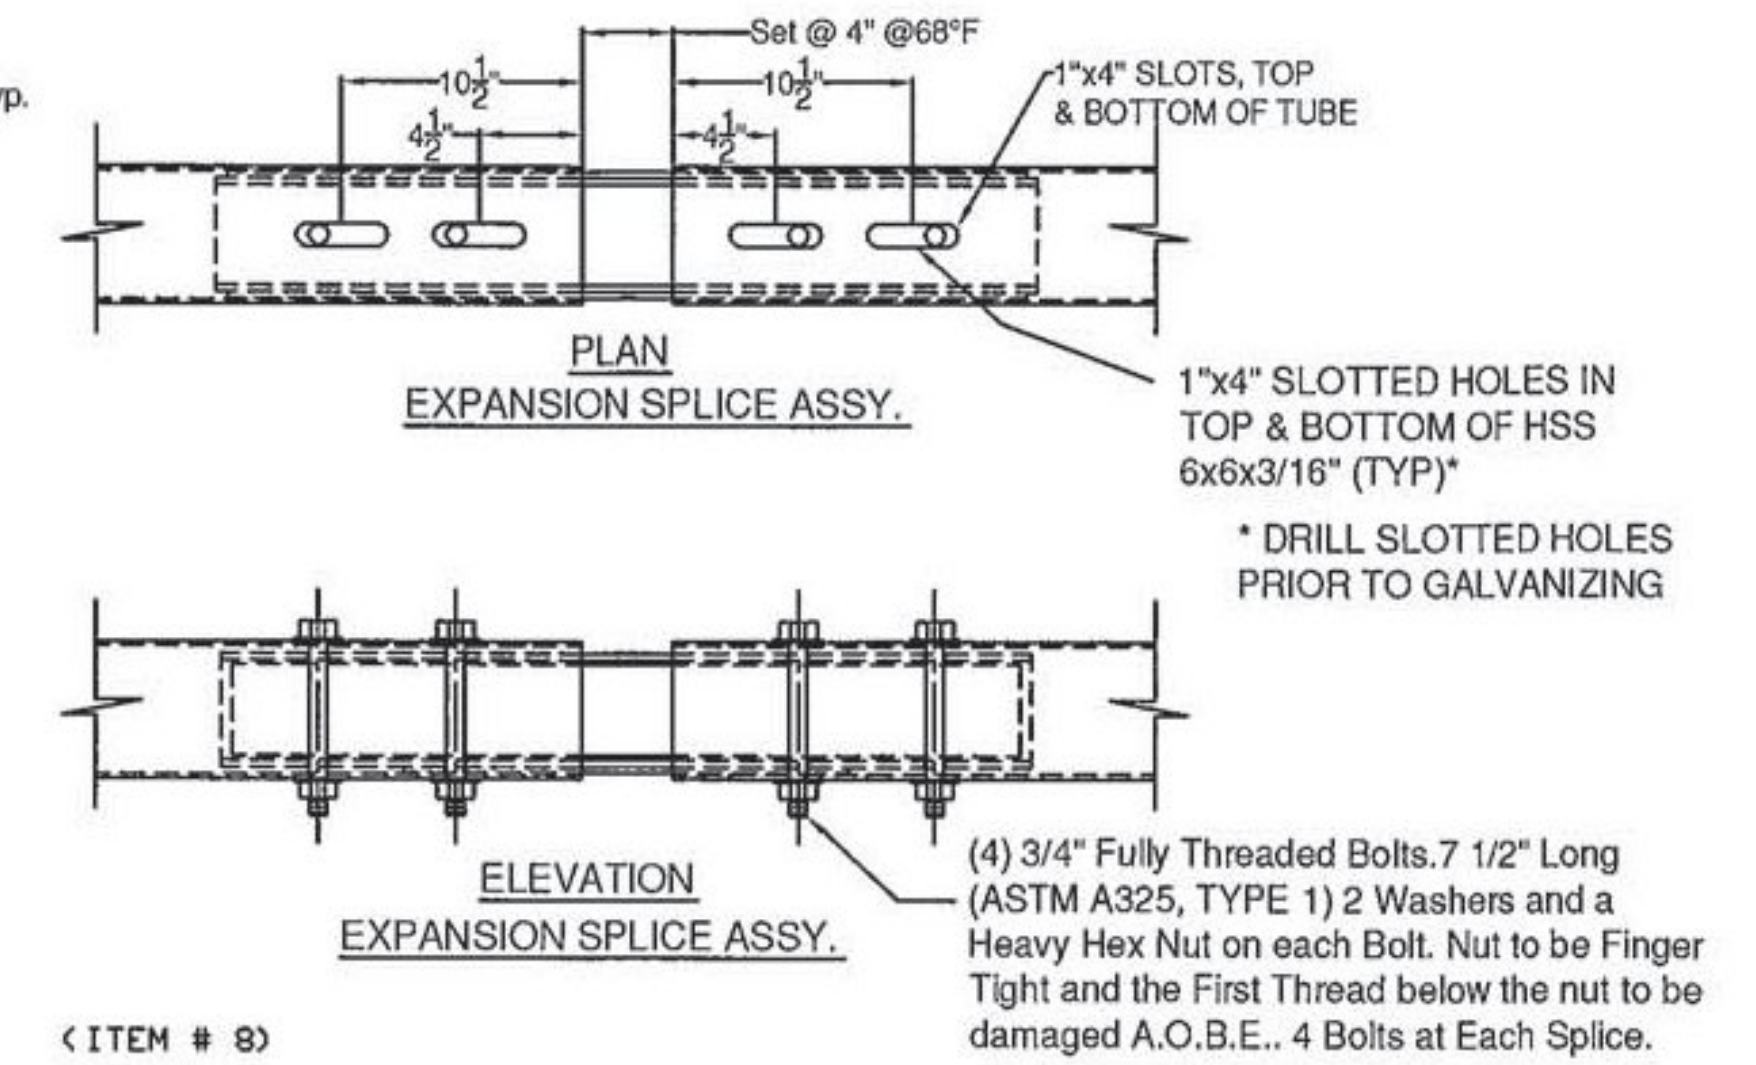

< ITEM # 8 >

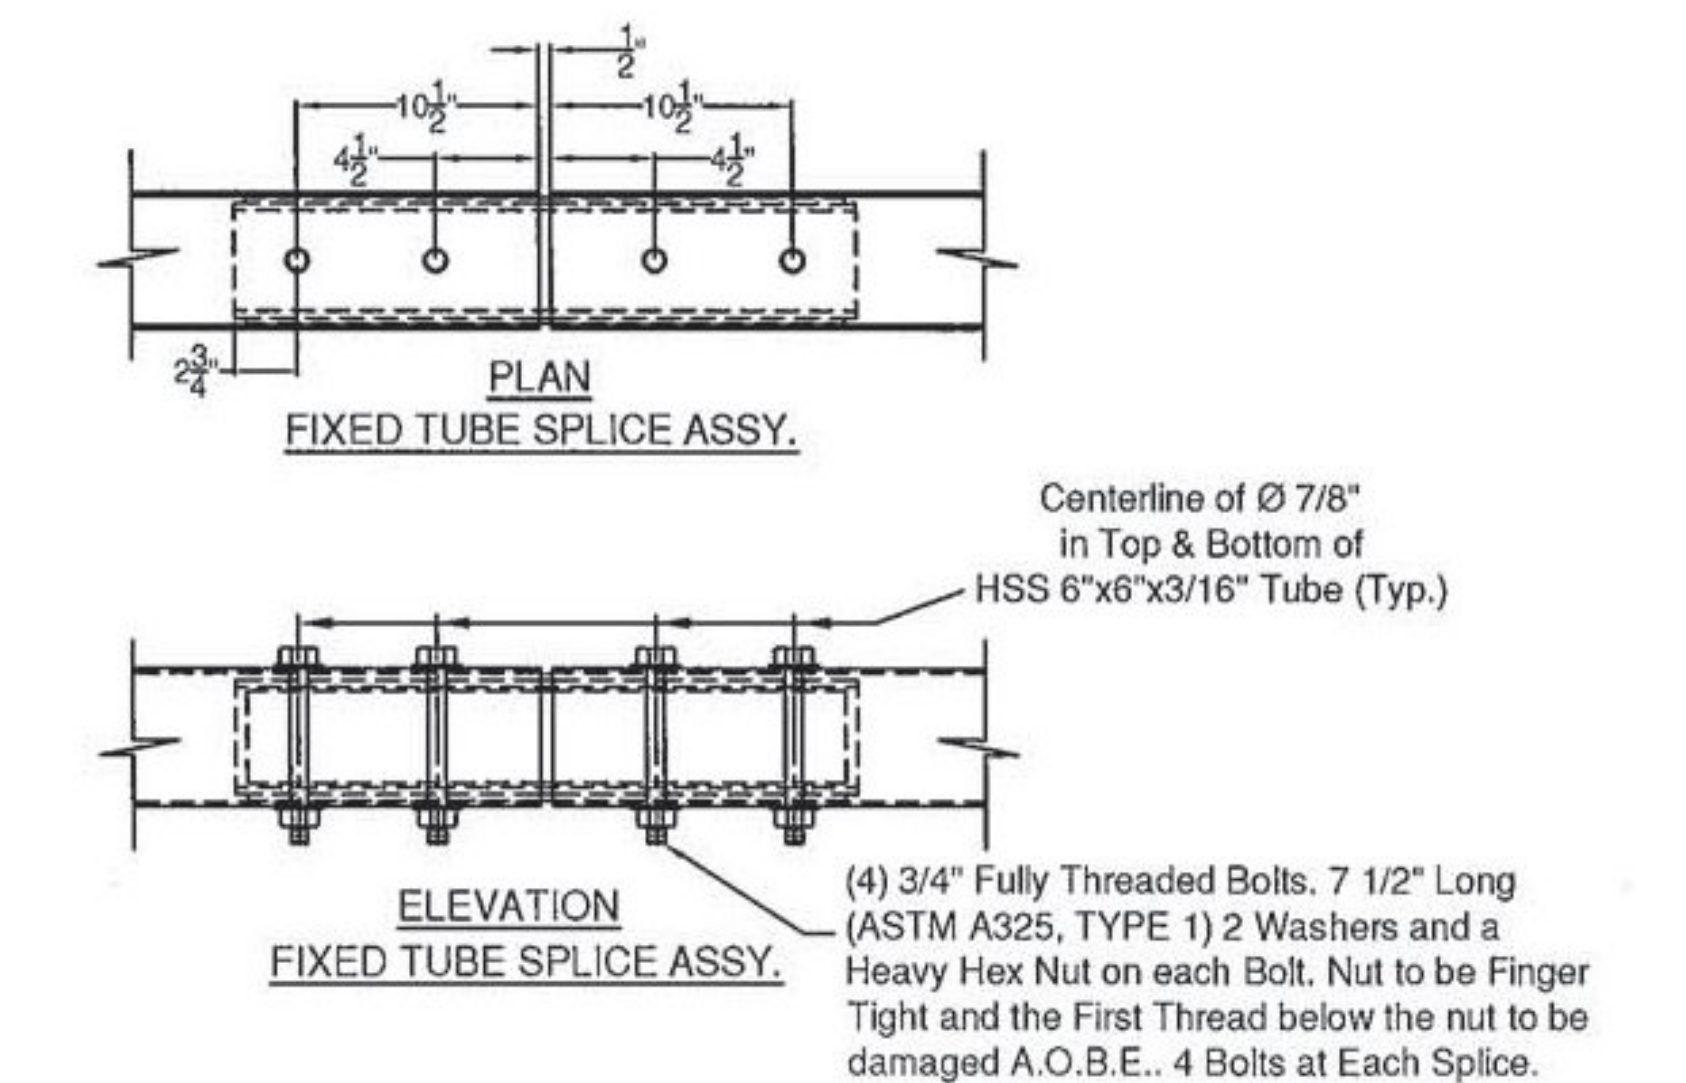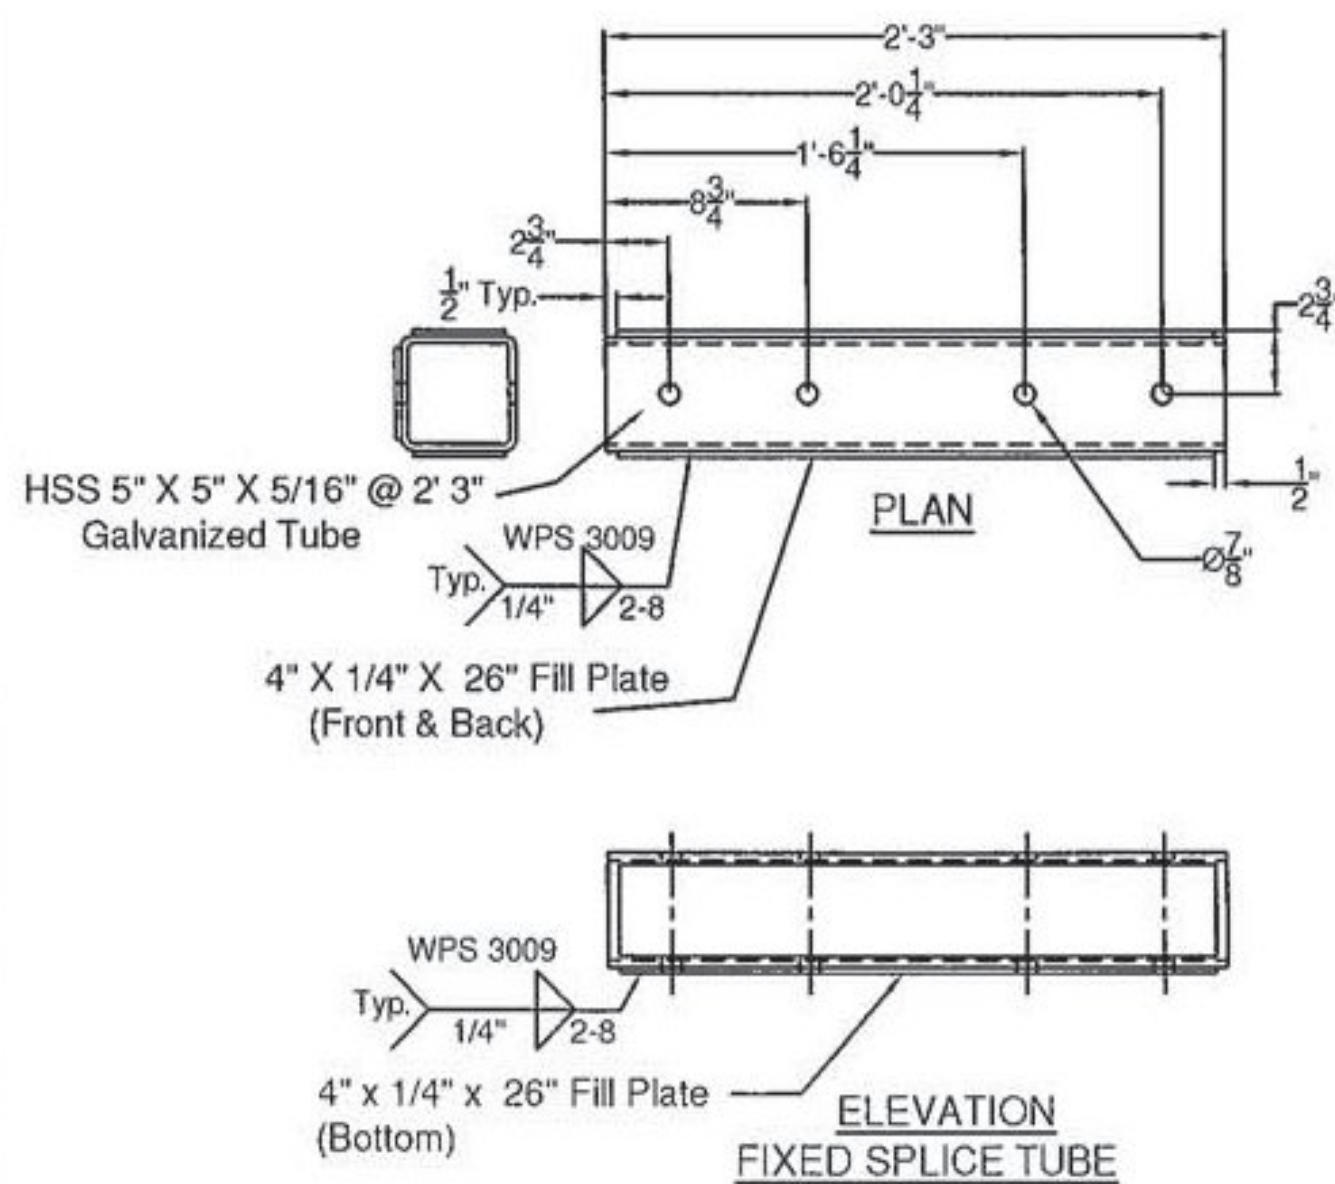

< ITEM # 7 >

**SPLICE TUBE - FIXED**

Vermont Agency of Transportation

**RECEIVED**

CK'D BY GL OK'D BY JS

January 9, 2015

RESUBMIT no Approved  
BY KH DATE 1-20-2015

SHEET 5 OF 5

ITEM #: 621.725

STRUCTURAL STEEL TO COMPLY W/ ASTM A6

TOLERANCE UNLESS OTHERWISE NOTED:  
FRACTIONS = ± 1/16"  
ANGLES = ± 1/2"  
DIAMETERS = ± 1/32"

**GUARD RAIL TO BRIDGE RAIL TRANSITION DETAILS SHEET**

TOWN HIGHWAY 46 (IRISH SETTLEMENT ROAD), BRIDGE # 28  
TOWN OF CAMBRIDGE, COUNTY OF LAMOILLE, VT.

R NO.	DATE	DESCRIPTION	BY	R NO.	DATE	DESCRIPTION	BY
E 1	1/7/15	REVISED PER 12/29/14 MARK-UP	EP				

DRAWN	E.P.	12/3/14
CHECKED	D.L.	12/3/14
APPROVED		
SCALE	SCHEMATIC	
DRAWING NO. F.R.L-CAMBRIDGE-T		



**ELDERLEE, INC.**

OAKS CORNERS, NEW YORK 14518  
E-Mail: dlong@elderlee.com / epeek@elderlee.com  
Tel: 315-789-6670 Fax: 315-789-6615



**WELDING PROCEDURE SPECIFICATION**

PQR ELDERLEE#3

Material Specification A500 GR B to A572 GR 50  
 Welding Process FCAW-G  
 Manual or Machine SEMAUTOMATIC  
 Position of Welding FLAT/HORIZONTAL  
 Filler Metal Specification A5.29  
 Filler Metal Classification E81T1-Ni1C-JH4  
 Flux N/A  
 Shielding Gas CO 2 Dew Point -40DEG F Flow Rate 50CFH  
 Single or Multiple Pass SINGLE  
 Single or Multiple Arc SINGLE  
 Welding Current DC  
 Polarity REVERSE ELECTRODE POSITIVE  
 Welding Progression STRINGER  
 Root Treatment PER D1.5  
 Preheat and Interpass Temperature PER D1.5  
 Postheat Temperature NONE  
 Heat Input Min _____ Max _____

**WELDING PROCEDURE**

Pass no.	Electrode size	Welding Current		Travel speed	Joint detail
		Amperes	Volts		
1	1/16	310	25	11	
Variable	LIMITS	341	27	12	
		TO 269	TO 23	TO 10	

This procedure may vary due to fabrication sequence, fit-up, pass size, etc., within the limitation of variables given in Section 5.

Procedure No. 3007

Contractor Elderlee, Inc.

Revision No. _____

Authorized By RANDY SCOTT

Date 7/28/2014

Vermont Agency of Transportation

**RECEIVED**

CK'D BY _____ OK'D BY JC

January 9, 2015

RESUBMIT NO **Approved**

BY KH DATE 1-20-2015

**WELDING PROCEDURE SPECIFICATION**

PQR ELDERLEE #3

Material Specification A709 TO A500 GR B  
 Welding Process FCAW-G  
 Manual or Machine SEMAUTOMATIC  
 Position of Welding FLAT/HORIZONTAL  
 Filler Metal Specification A5.29  
 Filler Metal Classification E81T1-NI1C-JH4  
 Flux N/A  
 Shielding Gas CO 2 Dew Point -40DEG F Flow Rate 50CFH  
 Single or Multiple Pass SINGLE  
 Single or Multiple Arc SINGLE  
 Welding Current DC  
 Polarity REVERSE ELECTRODE POSITIVE  
 Welding Progression STRINGER  
 Root Treatment D1.5  
 Preheat and Interpass Temperature D1.5  
 Postheat Temperature NONE  
 Heat Input Min _____ Max _____

**WELDING PROCEDURE.**

Pass no.	Electrode size	Welding Current		Travel speed	Joint detail
		Amperes	Volts		
1	1/16	310	25	11	
Variable	LIMITS	341	27	12	
		TO 269	TO 23	TO 10	

This procedure may vary due to fabrication sequence, fit-up, pass size, etc., within the limitation of variables given in Section 5.

Procedure No. 3009

Contractor Elderlee, Inc.

Revision No. _____

Authorized By RANDY SCOTT

Date 3/20/2014

Vermont Agency of Transportation

**RECEIVED**

CK'D BY GL OK'D BY JS

January 9, 2015

RESUBMIT no Approved

BY KH DATE 1-20-2015

**WELDING PROCEDURE SPECIFICATION**

PQR ELDERLEE #3

Material Specification A500 TO A572 GR 50  
 Welding Process FCAW-G  
 Manual or Machine SEMAUTOMATIC  
 Position of Welding FLAT/HORIZONTAL  
 Filler Metal Specification A5.29  
 Filler Metal Classification E81T1-Ni1C-JH4  
 Flux N/A  
 Shielding Gas CO 2 Dew Point -40DEG F Flow Rate 50CFH  
 Single or Multiple Pass SINGLE  
 Single or Multiple Arc SINGLE  
 Welding Current DC  
 Polarity REVERSE  
 Welding Progression STRINGER  
 Root Treatment PER D1.5  
 Preheat and Interpass Temperature PER D1.5  
 Postheat Temperature NONE  
 Heat Input Min _____ Max _____

**WELDING PROCEDURE**

Pass no.	Electrode size	Welding Current		Travel speed	Joint detail
		Amperes	Volts		
1	1/16	310	25	11	
Variable	LIMITS	341	27	12	
		TO 269	TO 23	TO 10	

This procedure may vary due to fabrication sequence, fit-up, pass size, etc., within the limitation of variables given in Section 5.

Procedure No. 3016

Contractor Elderlee, Inc.

Revision No. _____

Authorized By RANDY SCOTT

Date 8/4/2014

Vermont Agency of Transportation  
**RECEIVED**

CK'D BY GL OK'D BY JS

January 9, 2015

RESUBMIT no Approved  
 BY KH DATE 1-20-2015

**WELDING PROCEDURE SPECIFICATION**

Material Specification	A572 GR 50	
Welding Process	GMAW	
Manual or Machine	SEMIAUTOMATIC/ROBOTIC	
Position of Welding	FLAT/HORIZONTAL	
Filler Metal Specification	A5.18	
Filler Metal Classification	L-56 LINCOLN	
Flux	N/A	
Shielding Gas	90% ARGON /10% CO2	Dew Point -40DEG F Flow Rate 45CFH
Single or Multiple Pass	SINGLE	
Single or Multiple Arc	SINGLE	
Welding Current	DC	
Polarity	REVERSE	
Welding Progression	STRINGER	
Root Treatment	PER D1.5	
Preheat and Interpass Temperature	PER D1.5	
Postheat Temperature	NONE	
Heat Input	Min _____	Max _____

**WELDING PROCEDURE**

Pass no.	Electrode size	Welding Current		Travel speed	Joint detail
		Amperes	Volts		
	.045	190	22	19	
Variable	LIMITS	171	20	17	
		TO 209	TO 24	TO 21	

This procedure may vary due to fabrication sequence, fit-up, pass size, etc., within the limitation of variables given in Section 5.

Procedure No. 3022

Contractor Elderlee, Inc.

Revision No. _____

Authorized By RANDY SCOTT

Date 3/20/2014

Vermont Agency of Transportation

**RECEIVED**

CK'D BY GL OK'D BY JS

January 9, 2015

RESUBMIT no Approved


BY KH DATE 1-20-2015

**WELDING PROCEDURE SPECIFICATION**

PQR ELDERLEE #3

Material Specification A500 TO A36  
 Welding Process FCAW-G  
 Manual or Machine SEMAUTOMATIC  
 Position of Welding FLAT/HORIZONTAL  
 Filler Metal Specification A5.29  
 Filler Metal Classification E81T1-Ni1C-JH4  
 Flux N/A  
 Shielding Gas CO 2 Dew Point -40DEG F Flow Rate 50CFH  
 Single or Multiple Pass SINGLE  
 Single or Multiple Arc SINGLE  
 Welding Current DC  
 Polarity REVERSE  
 Welding Progression STRINGER  
 Root Treatment CLEAN PER D1.5  
 Preheat and Interpass Temperature PER D1.5  
 Postheat Temperature NONE  
 Heat Input Min _____ Max _____

**WELDING PROCEDURE**

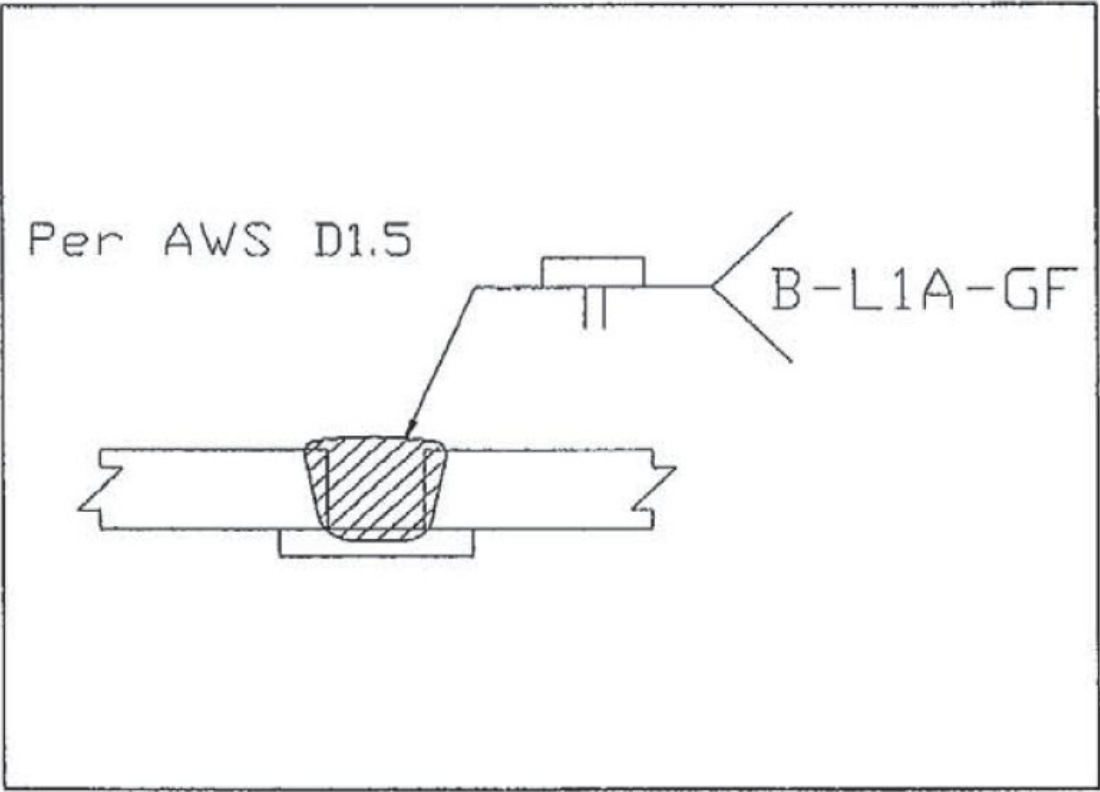Pass no.	Electrode size	Welding Current		Travel speed	Joint detail
		Amperes	Volts		
	1/16	310	25	11	
Variable	LIMITS	341	27	12	
		TO 269	TO 23	TO 10	

This procedure may vary due to fabrication sequence, fit-up, pass size, etc., within the limitation of variables given in Section 5.

Procedure No. 3026

Contractor Elderlee, Inc.

Revision No. _____

Authorized By RANDY SCOTT

Date 3/24/2014

Vermont Agency of Transportation

**RECEIVED**


CK'D BY GL OK'D BY JS

January 9, 2015


RESUBMIT no Approved

BY KH DATE 1-20-2015


REVISIONS					
ZONE	REV	DESCRIPTION	REVISED BY	DATE	APPROVED
--	A	PER ENGINEERS MARKS	EG	12/31/14	BF

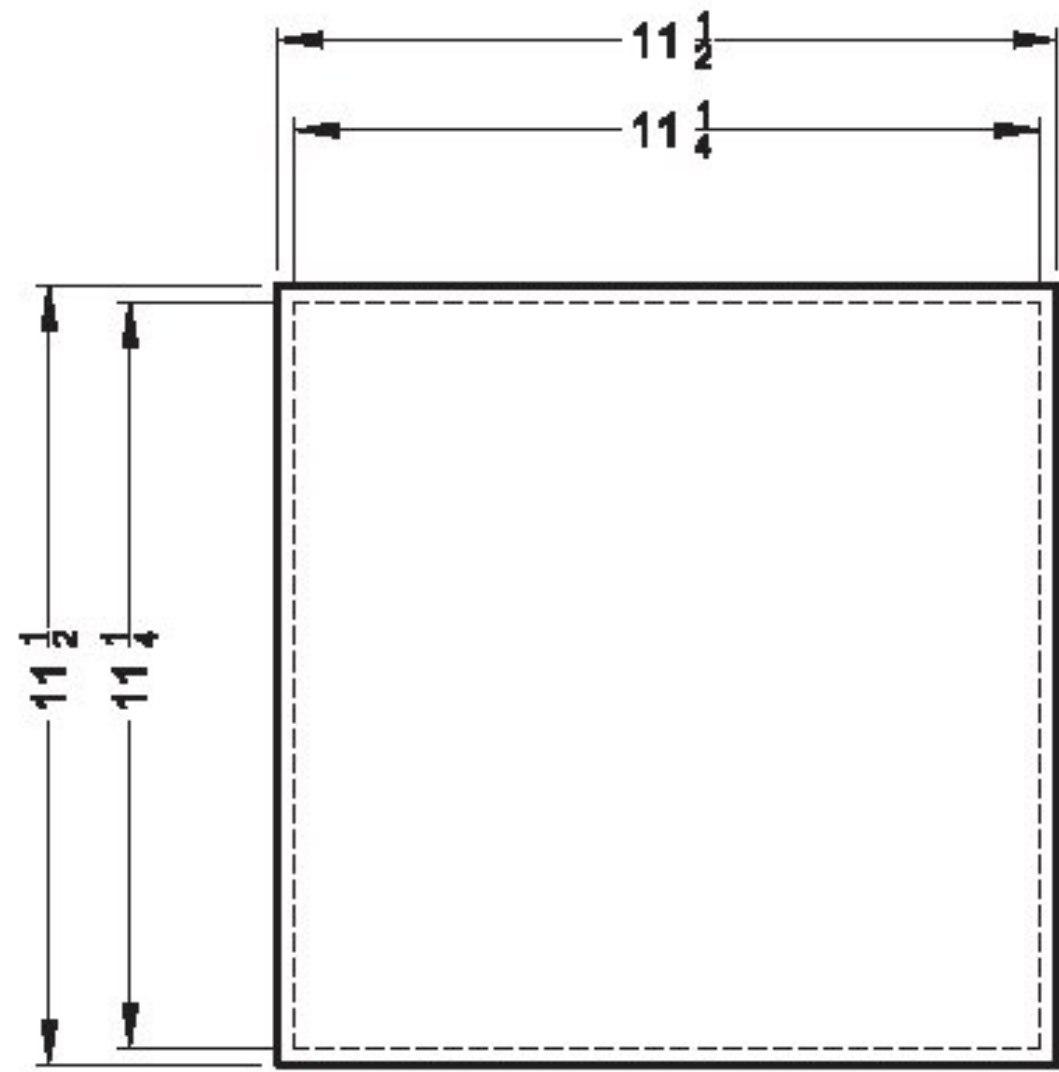

**PLAN VIEW**

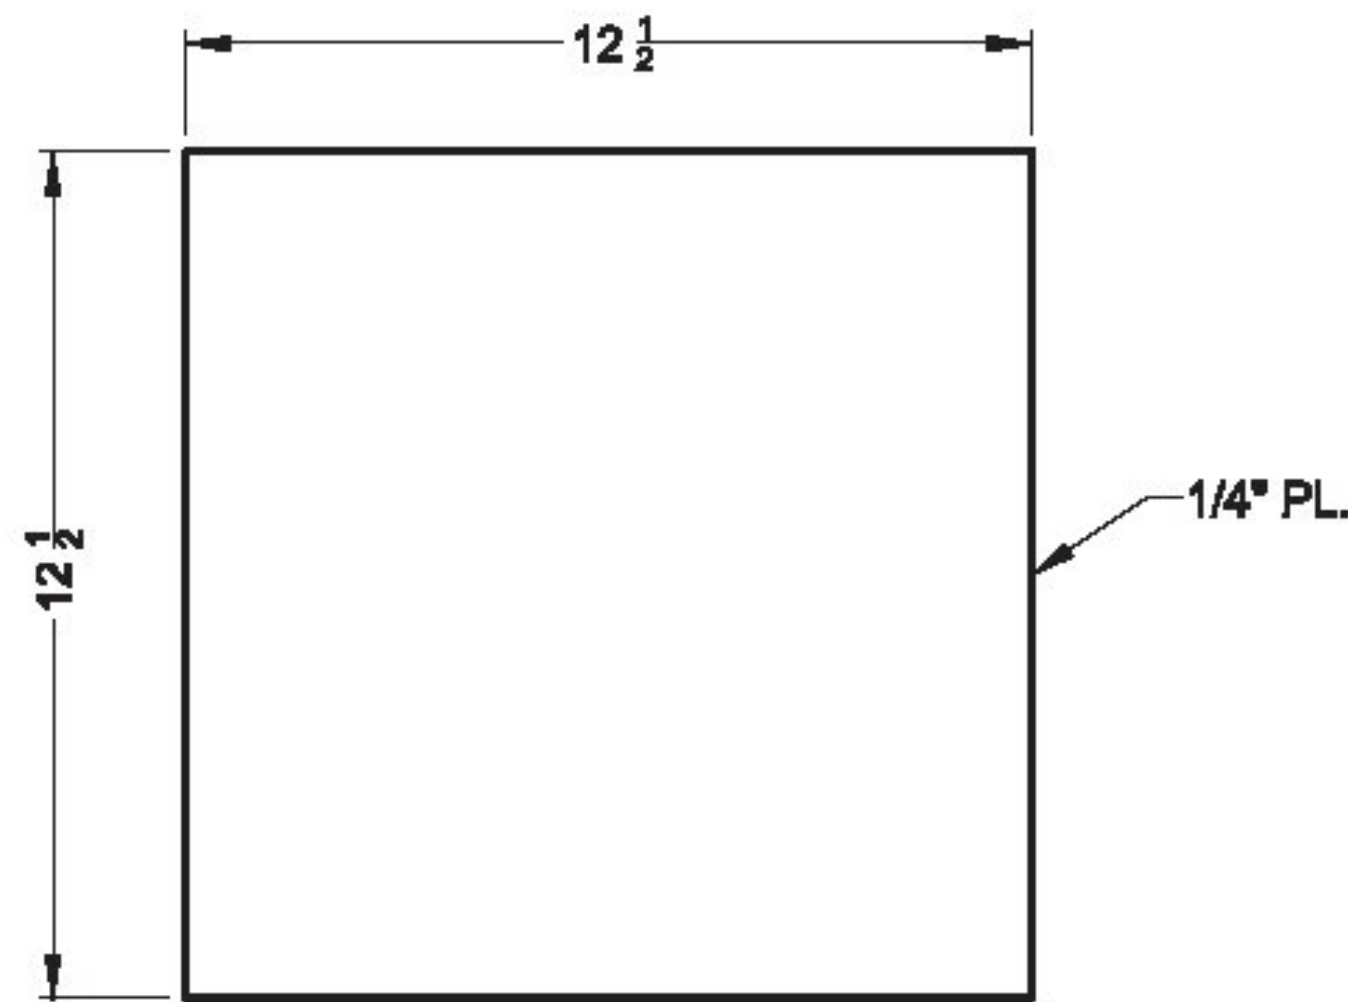

**SHIMS  
PLAN VIEW**

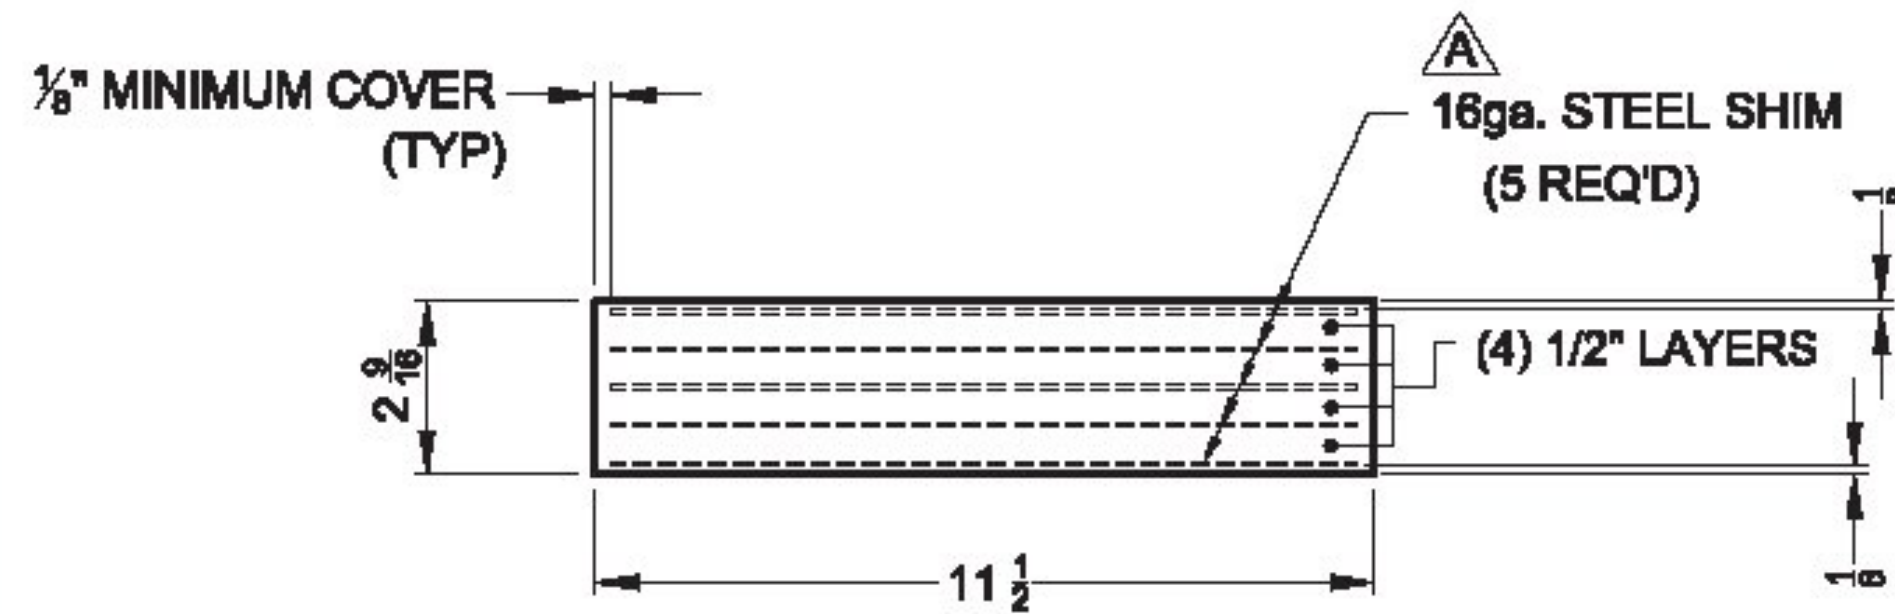

**ELEVATION VIEW**

QTY. REQ'D. = 12

Vermont Agency of Transportation

**RECEIVED**

CK'D BY GL OK'D BY JS

January 6, 2015

RESUBMIT NO Approved AsNoted  
BY KH DATE 1-7-2015

QTY. REQ'D. = 12  
A36 GALVANIZED  
SHIPPED LOOSE

APPROVER NOTE: THESE SHIMS ARE FOR FIELD USE AND ARE NOT PART OF THE BEARING. PLEASE READ NOTE 5 ON SHEET 18 OF CONTRACT DRAWINGS.

AMSCOT IS NOT WELDING ANYTHING ON THIS PROJECT SO NO WELDING PROCEDURE WILL BE PROVIDED. AMSCOT IS NOT BONDING TO EXTERNAL PLATES, SO BONDING PROCEDURE WILL BE NOT BE PROVIDED. 1/16" SHEETS ARE NOT AVAILABLE, SHIM MATERIAL SHALL BE 16ga. SHEETS. SHEET 18 OF THE STATE CONTRACT DRAWINGS CALLS OUT THE STEEL SHIMS AS PLATES IN NOTES 2 & 3 AND ALSO IN THE QUANTITIES LISTED UNDER THE ELASTOMERIC BEARING DETAIL. PLEASE SEND US A REVISED SHEET 18 WITH THESE ERRORS CORRECTED FOR OUR RECORDS.

**NOTES:**

- MANUFACTURING FACILITY LOCATION:  
AMSCOT STRUCTURAL PRODUCTS CORP.  
241 E. BLACKWELL STREET  
DOVER, N.J. 07801  
CONTACT- PETER SOMOGYI  
PH: 973-989-8800  
FAX: 973-989-5851
- ALL BEARING PADS TO BE MANUFACTURED IN ACCORDANCE WITH AASHTO SECTION 18. THE ELASTOMER SHALL BE GRADE 4 NATURAL RUBBER WITH A DUROMETER HARDNESS OF 50 ± 5, WITH A SHEAR MODULUS OF 100 PSI ± 15%. THE STEEL REINFORCING SHEETS SHALL CONFORM TO ASTM A36.
- ALL BEARINGS SHALL CONFORM TO APPLICABLE SUBSECTIONS OF SECTION 631 & 731 OF THE VTAOT STANDARD SPECIFICATIONS.
- ALL INTERNAL SHIM MATERIAL SHALL BE ASTM A1011 GR. 36.
- ALL DIMENSIONS ARE IN INCHES, UNLESS OTHERWISE NOTED.
- TOLERANCES: THICKNESS -0 +1/4  
PLAN -0 +1/4

INCLUDE TEST PADS PER AASHTO SECTION 18.1.5. DESIGN LOAD = 22 KIPS

TOWN HIGHWAY 46 BRIDGE #28 TOWN OF CAMBRIDGE COUNTY OF LAMOILLE VERMONT		
PROJECT NO. : BRO 1448 (39)		
CONTRACT NO. :	PIN NO. :	
<b>STEEL REINFORCED ELASTOMERIC BEARING PAD DETAILS</b>		
<b>AMSCOT</b> STRUCTURAL PRODUCTS CORP.		
SCALE: N.T.S.	APPRVD: BF	DRAWN BY: E.J.G.
DATE: 10/23/13	REVISION: A	
FOR: BLOW & COTE		
DWG NO: BC1481RA		SHEET 1 OF 1


**RECEIVED**

CK'D BY GL OK'D BY JS


January 8, 2015

RESUBMIT NO Approved


BY KH DATE 1-8-2015

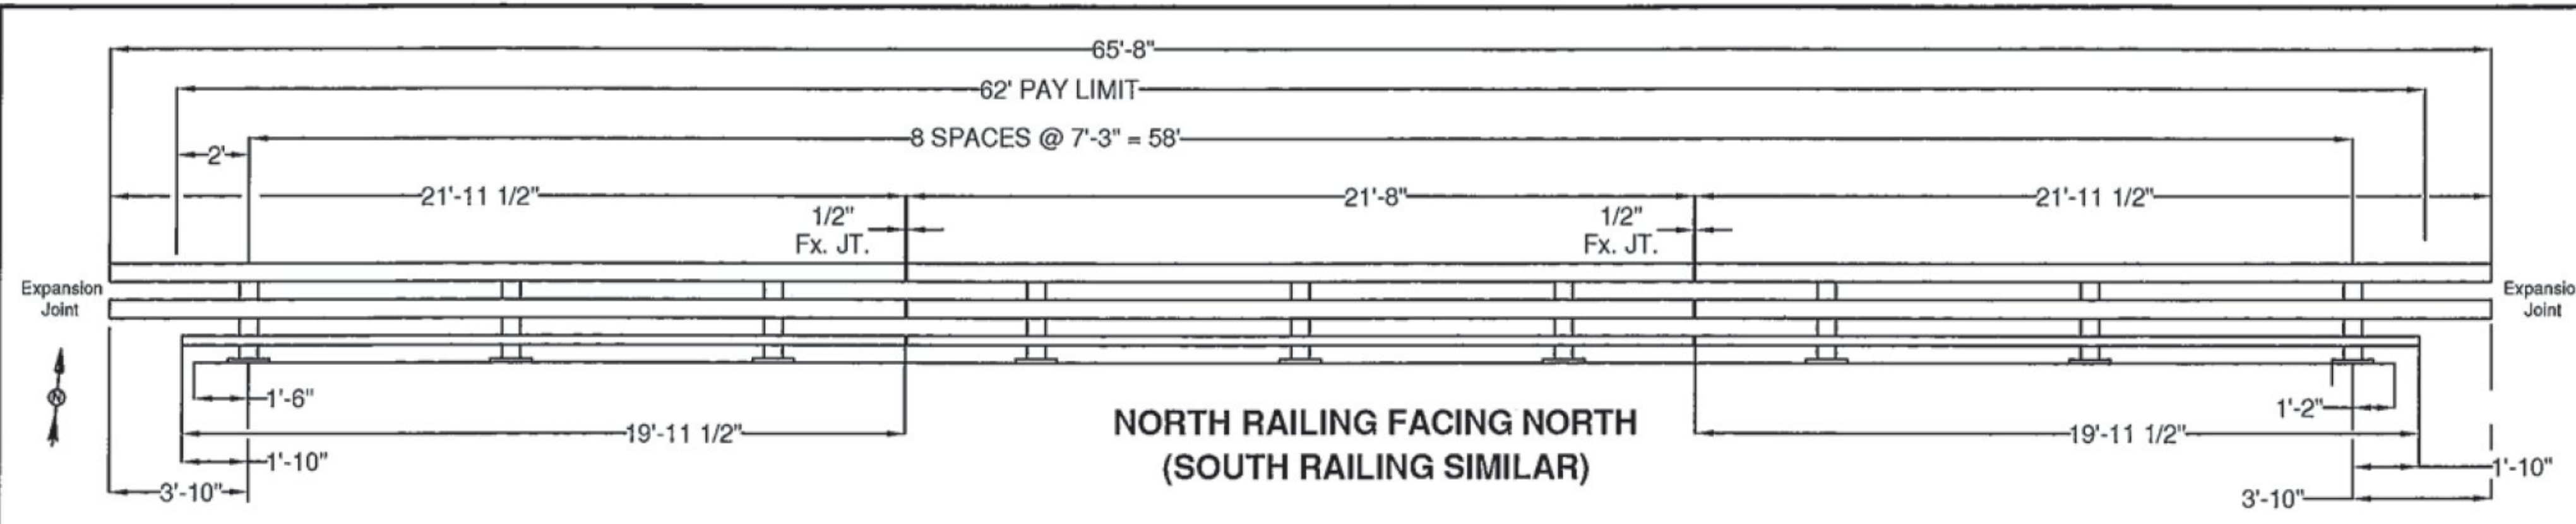


NORTH RAILING FACING NORTH  
(SOUTH RAILING SIMILAR)

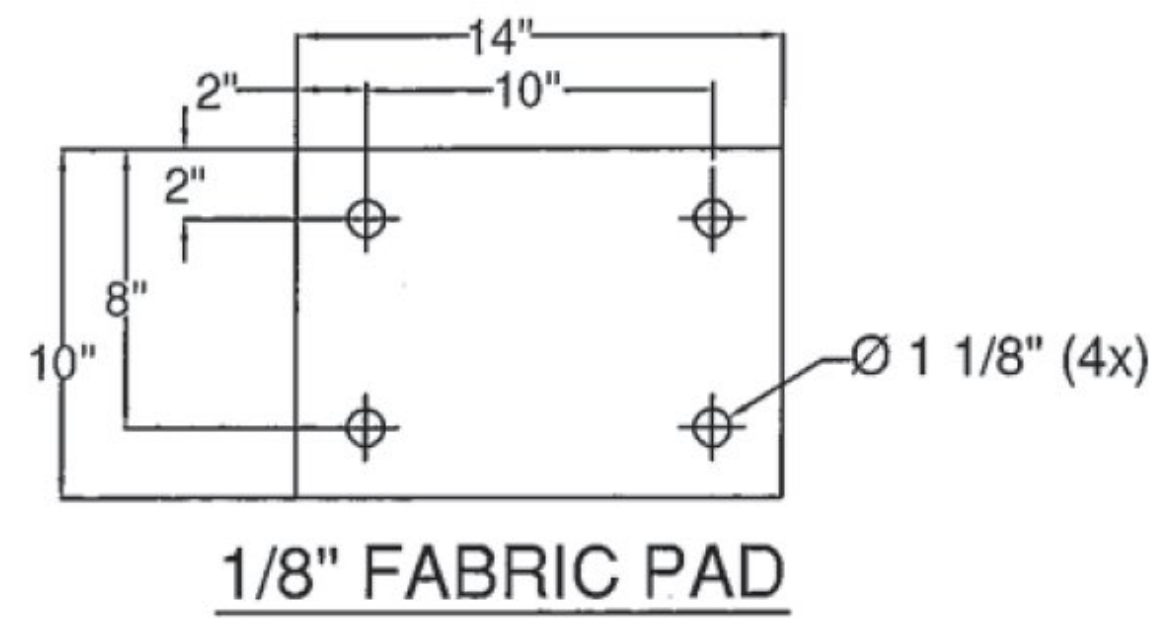


1/8" FABRIC PAD

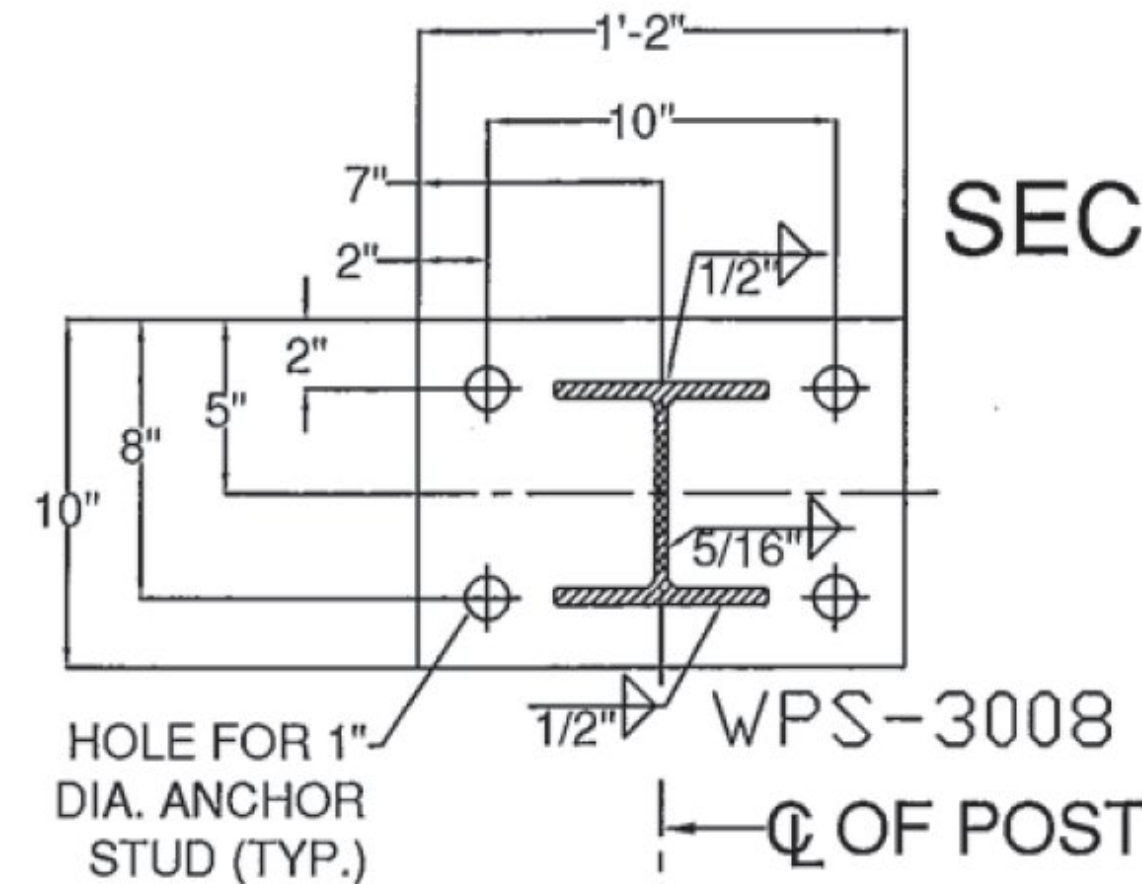

SECTION A-A

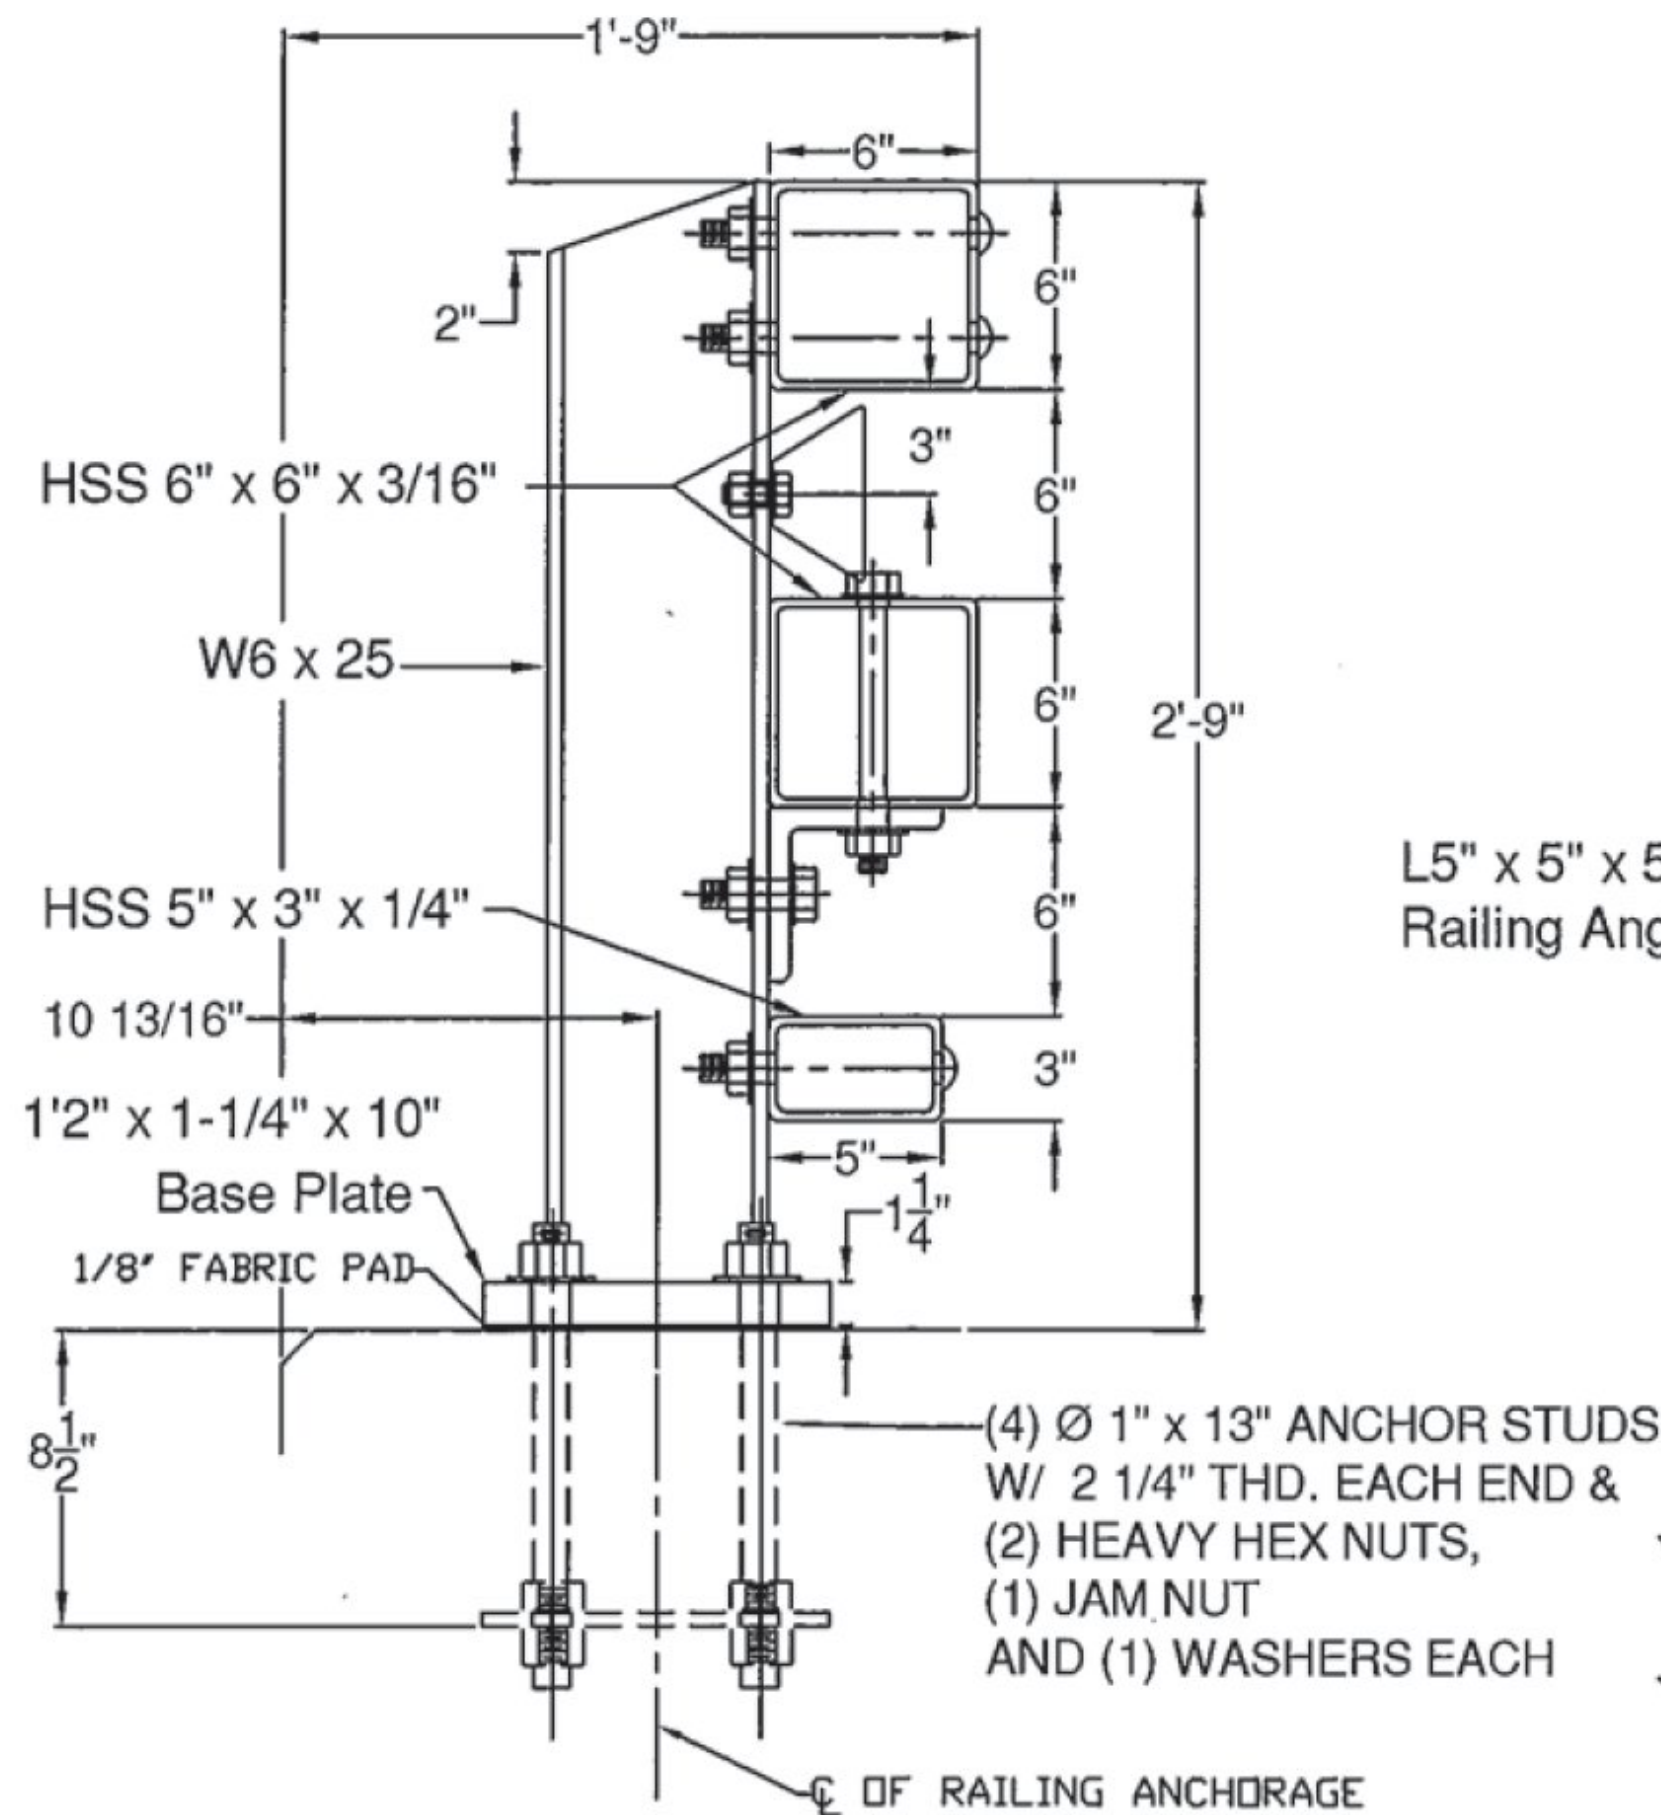

SECTION

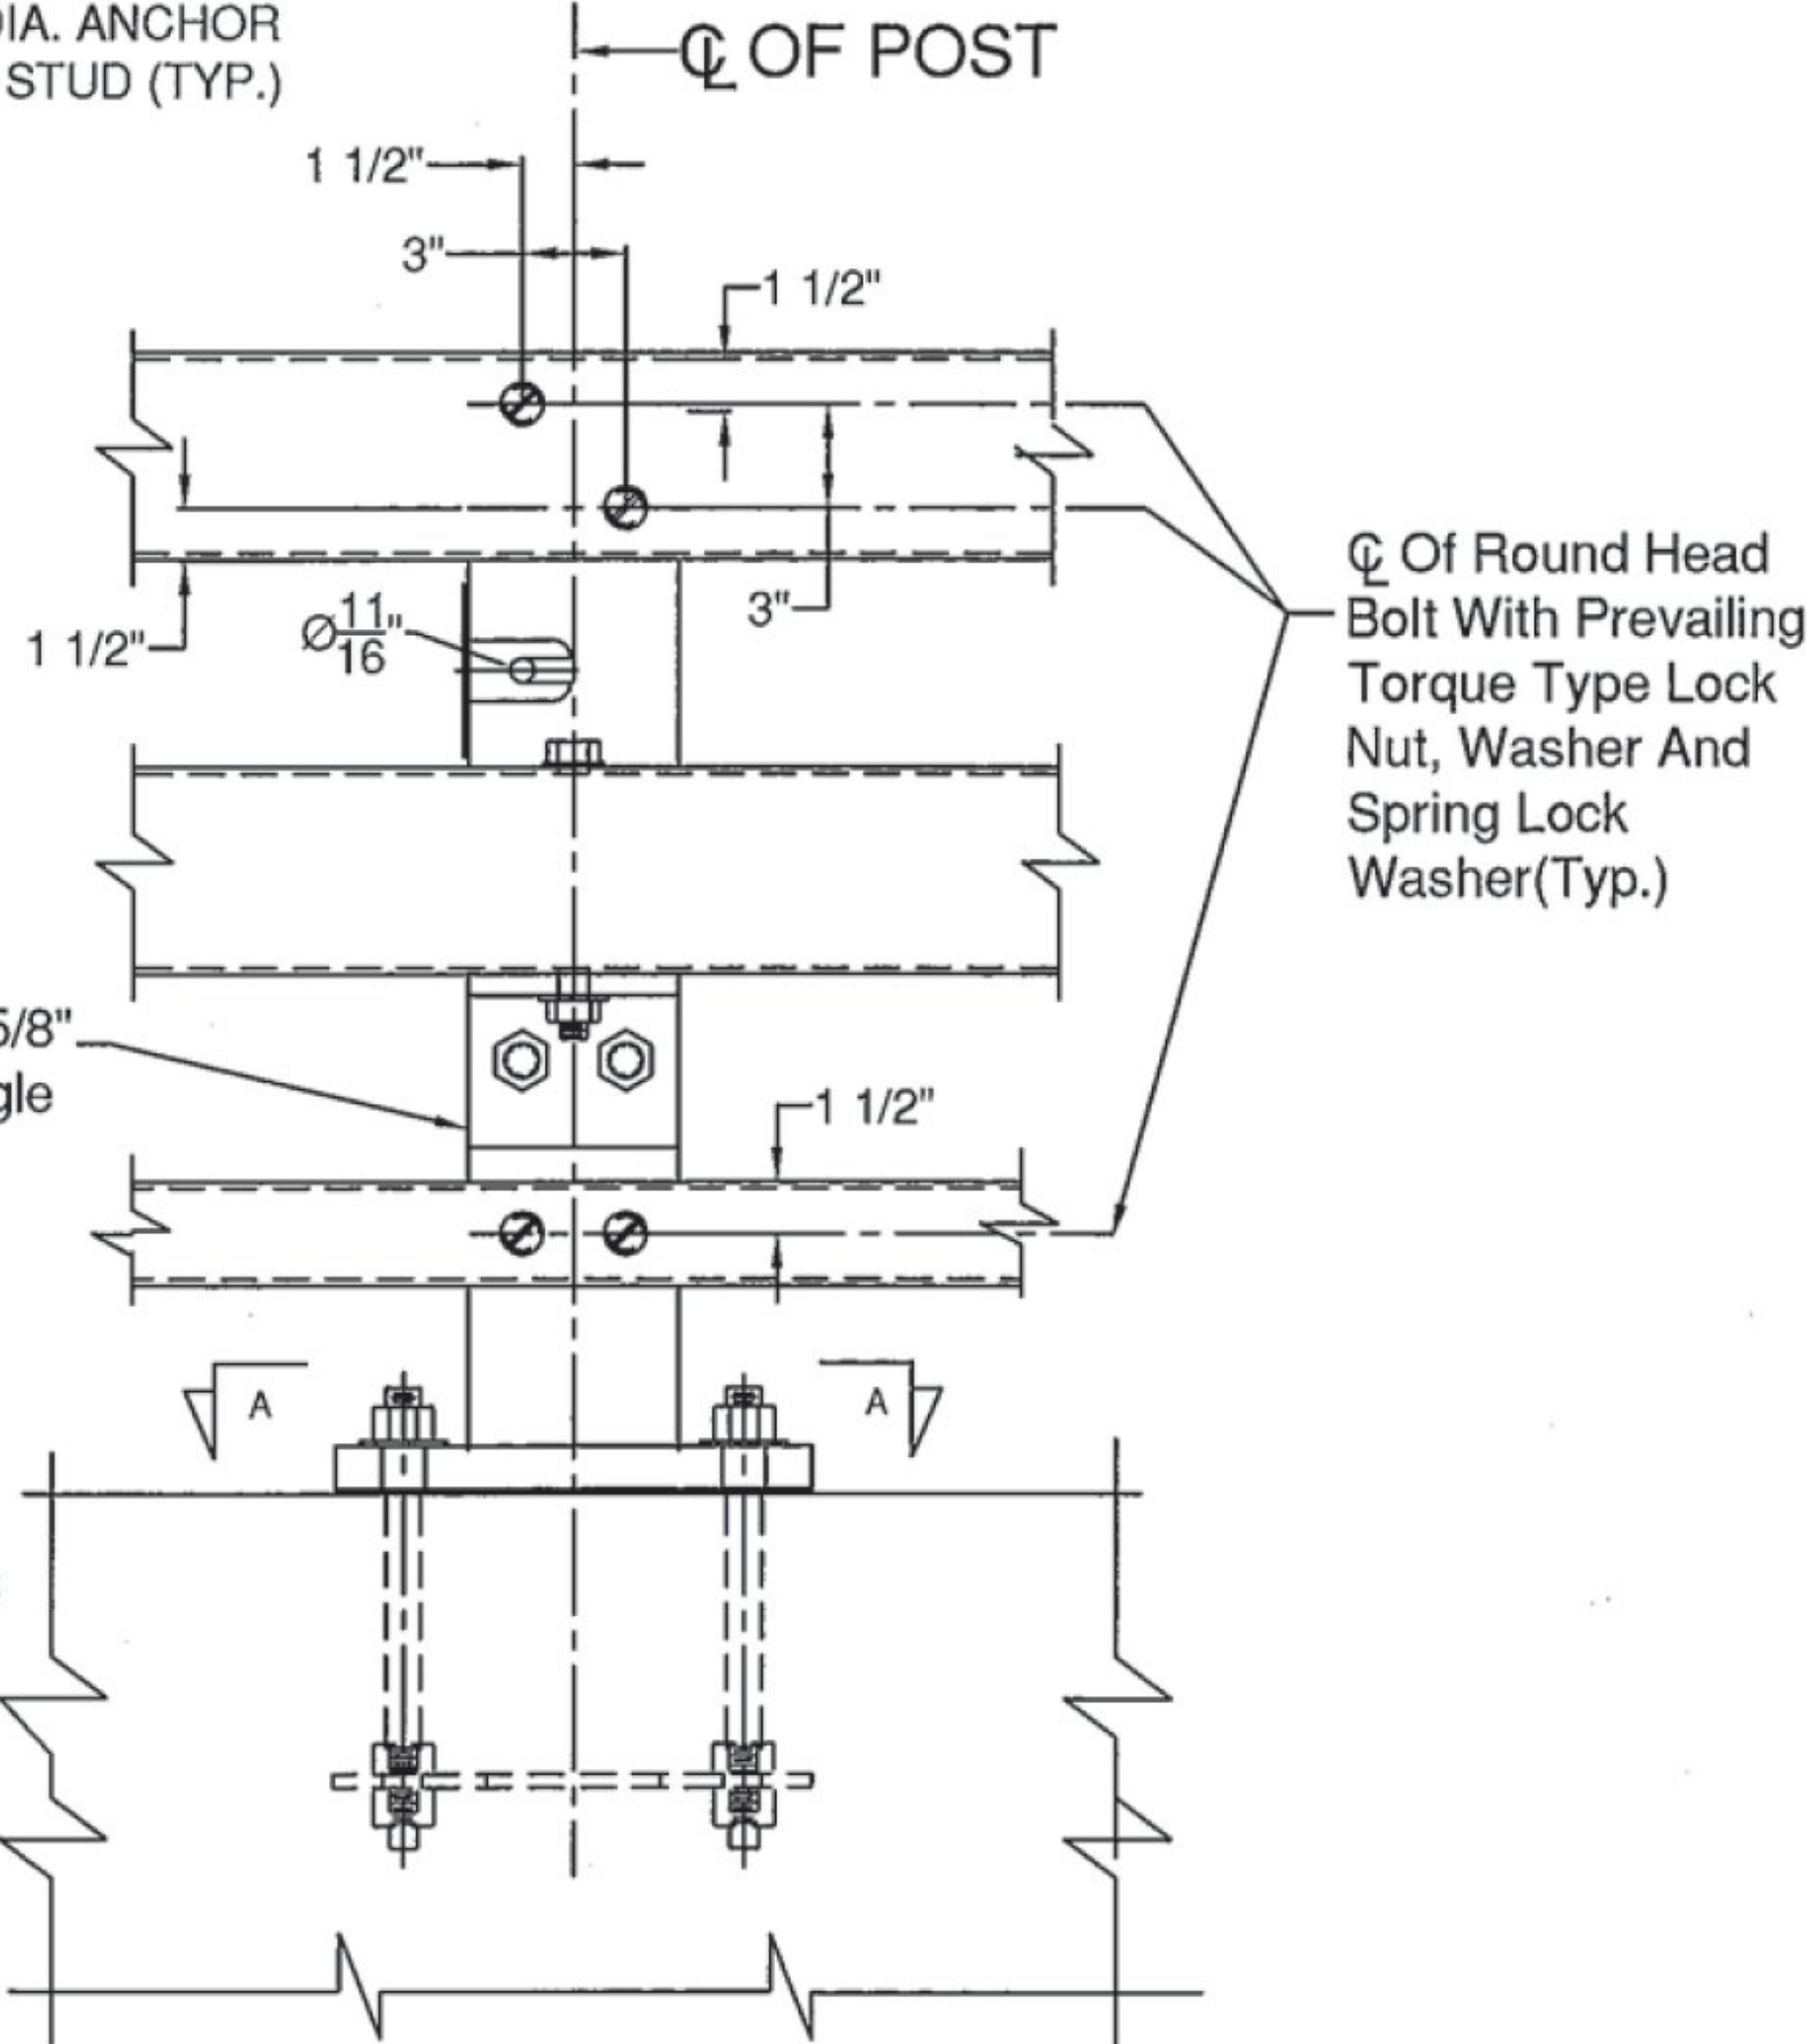

ELEVATION  
STEEL BRIDGE RAILING

BILL OF MATERIAL				
ITEM #	QTY	PART #	DESCRIPTION	ASTM DESIGNATION
1	18	0033.03610	W6x25, THREE RAIL POST @ 2'-9" DA ON 1 1/4x10x1'-2" B.P.	A572 Gr. 50
2	4	0033.91283	HSS 3' X 5' X 1/4' RAIL @ 19'-11 1/2'	A500 Gr. B
3	2	0033.91284	HSS 3' X 5' X 1/4' RAIL @ 21'-8'	A500 Gr. B
5	8	0033.91285	HSS 6' X 6' X 3/16' RAIL @ 21'-11 1/2'	A500 Gr. B
6	4	0033.91286	HSS 6' X 6' X 3/16' RAIL @ 21'-8'	A500 Gr. B
8	4	0033.00840	2-1/8" X 4-1/4" FIX. SPLICE BAR @ 2'-3"	A572 Gr. 50
9	8	0033.00640	HSS 5' X 5' X 5/16' FIX. SPLICE TUBE @ 2'-3"	A500 Gr. B, A572 Gr. 50
10	18	0033.00220	3/8" X 10" X 14" ANCHOR PLATES	A572 Gr. 50
11	18	0033.90050	1/8" X 10" X 14" FABRIC PAD	AASHTO M251
12	74*	0042.21013	Ø 1" X 13" ANCHOR STUDS, W/ 2 1/4" THD. EACH END	A449 TYPE 1
13	146*	0080.18901	Ø 1" HEAVY HEX NUTS	A563 DH
14	72	0080.18911	Ø 1" FLAT WASHERS	F436
15	72	0080.18905	Ø 1" HEX JAM NUTS	A563 DH
16	72	0080.07500	Ø 7/8" X 8" ROUND HEAD BOLT, NUT, SQ. WASHER, L.W.	A449, A563 DH, F436, ASME D18.2
17	18	0080.06400	Ø 3/4" X 8" HEX BOLT, NUT, (2) F.W., & L.W.	A325, A563DH, F436, & ASME D18.2
18	36	0080.06140	Ø 3/4" X 2-3/4" HEX BOLT, NUT, (2) F.W., & L.W.	A325, A563 DH, F436, & ASME D18.2
19	32	0080.06340	Ø 3/4" X 7-1/2" HEX BOLT, NUT, & (2) F.W.	A325, A563 DH, & F436
20	16	0080.06255	Ø 3/4" X 4-1/2" HEX BOLT, NUT, & (2) F.W.	A325, A563 DH, & F436
21	18	0033.00500	L5" X 5" X 5/8" RAILING ANGLE @ 6"	A572 Gr. 50
22	6		DELINEATORS - NOT SHOWN	(SUPPLIED BY CUSTOMER)

*-2 EXTRA FOR VDOT TESTING

GENERAL NOTES:

- 1) ALL RAILING IS TO BE FABRICATED AND ERECTED ACCORDING TO SECTION 525 OF THE STANDARD SPECIFICATIONS.
- 2) PRIOR TO GALVANIZING THE ASSEMBLED POST, GRIND ALL EDGES TO A MINIMUM RADIUS OF 1/16".
- 3) ALL POST SHALL BE SET NORMAL TO GRADE. THE MAXIMUM CENTER TO CENTER SPACING OF BRIDGE RAIL POST IS 8' 3".
- 4) SECTIONS OF RAIL TUBE SHALL BE ATTACHED TO A MINIMUM OF TWO BRIDGE POSTS AND PREFERABLY TO AT LEAST 4 POSTS.
- 5) RAIL TUBE EXPANSION JOINTS SHALL BE PROVIDED IN ANY RAIL BAY SPANNING THE END OF AN INTEGRAL ABUTMENT BRIDGE AND AT ALL SUPER STRUCTURE EXPANSION JOINTS. EXPANSION JOINT WIDTH SHALL BE 4" @ 68°F AND WILL BE ADJUSTED IN THE FIELD BY THE ENGINEER FOR OTHER TEMPERATURES.
- 6) STD. SPLICE HOLES ONLY IN BRIDGE RAIL TUBES. REST TO BE DRILLED BY CUSTOMER. FIELD DRILLED HOLES TO BE COATED WITH AN APPROVED ZINC-RICH PAINT PRIOR TO INSTALLATION.
- 7) BOLTS SHALL BE TORQUED SNUG TIGHT (APPROXIMATELY 100 FT-LB).
- 8) SEE STANDARD DRAWING G-1 FOR DETAILS OF DELINEATORS. A DELINEATOR SHALL BE INSTALLED AT 30 FOOT SPACING OR THE NEAREST POST. WHITE IS TO BE INSTALLED ON THE DRIVER'S RIGHT. FOR ONE WAY BRIDGES, YELLOW IS TO BE INSTALLED ON THE DRIVER'S LEFT. PAYMENT FOR DELINEATORS SHALL BE INCIDENTAL TO OTHER ITEMS.
- 9) ANY BENDING OF RAIL SHALL BE DONE AT THE FABRICATION PLANT ACCORDING TO A PROCEDURE PROVIDED BY THE FABRICATOR.
- 10) THE MINIMUM DISTANCE FROM THE POST TO AN EXPANSION JOINT SHALL BE DETERMINED BY THE MINIMUM EDGE DISTANCE OF 5" FROM ANY ANCHOR STUD TO THE END OF THE SLAB, OR THE EXPANSION JOINT RECESS POUR, IF ONE IS USED.
- 11) PROTRUSIONS CAUSED BY WELDING OR GALVANIZING ARE NOT PERMITTED ON THE ADJOINING SURFACES OF THE BOX BEAM RAILS, SPLICE TUBES AND FILL PLATES.
- 12) THIS RAILING MEETS THE REQUIREMENTS FOR A TL-4 SERVICE LEVEL.

ITEM #: 525.335

SHEET 1 OF 2

STRUCTURAL STEEL TO COMPLY W/ ASTM A6

TOLERANCE UNLESS OTHERWISE NOTED:  
FRACTIONS = ± 1/16"  
ANGLES = ± 1/2"  
DIAMETERS = ± 1/32"

BRIDGE RAIL DETAILS SHEET

TOWN HIGHWAY 46 (IRISH SETTLEMENT ROAD), BRIDGE #28  
TOWN OF CAMBRIDGE, COUNTY OF LAMOILLE, VT.

R NO.	DATE	DESCRIPTION	BY	R NO.	DATE	DESCRIPTION	BY
E 1	1/7/15	Revised Per 12/19/14 Markup	E.P.	E			
V			V				

DRAWN	E.P.	11/21/14
CHECKED	D.L.	11/21/14
APPROVED		
SCALE	SCHEMATIC	
DRAWING NO. F.R. LaFAYETTE-CAMBRIDGE		



ELDERLEE, INC.

OAKS CORNERS, NEW YORK 14578




E-Mail: dlong@elderlee.com, epeek@elderlee.com

Tel: 315-789-6670 Fax: 315-789-6615



CERTIFIED FABRICATOR

**SPLICE BAR - FIXED**



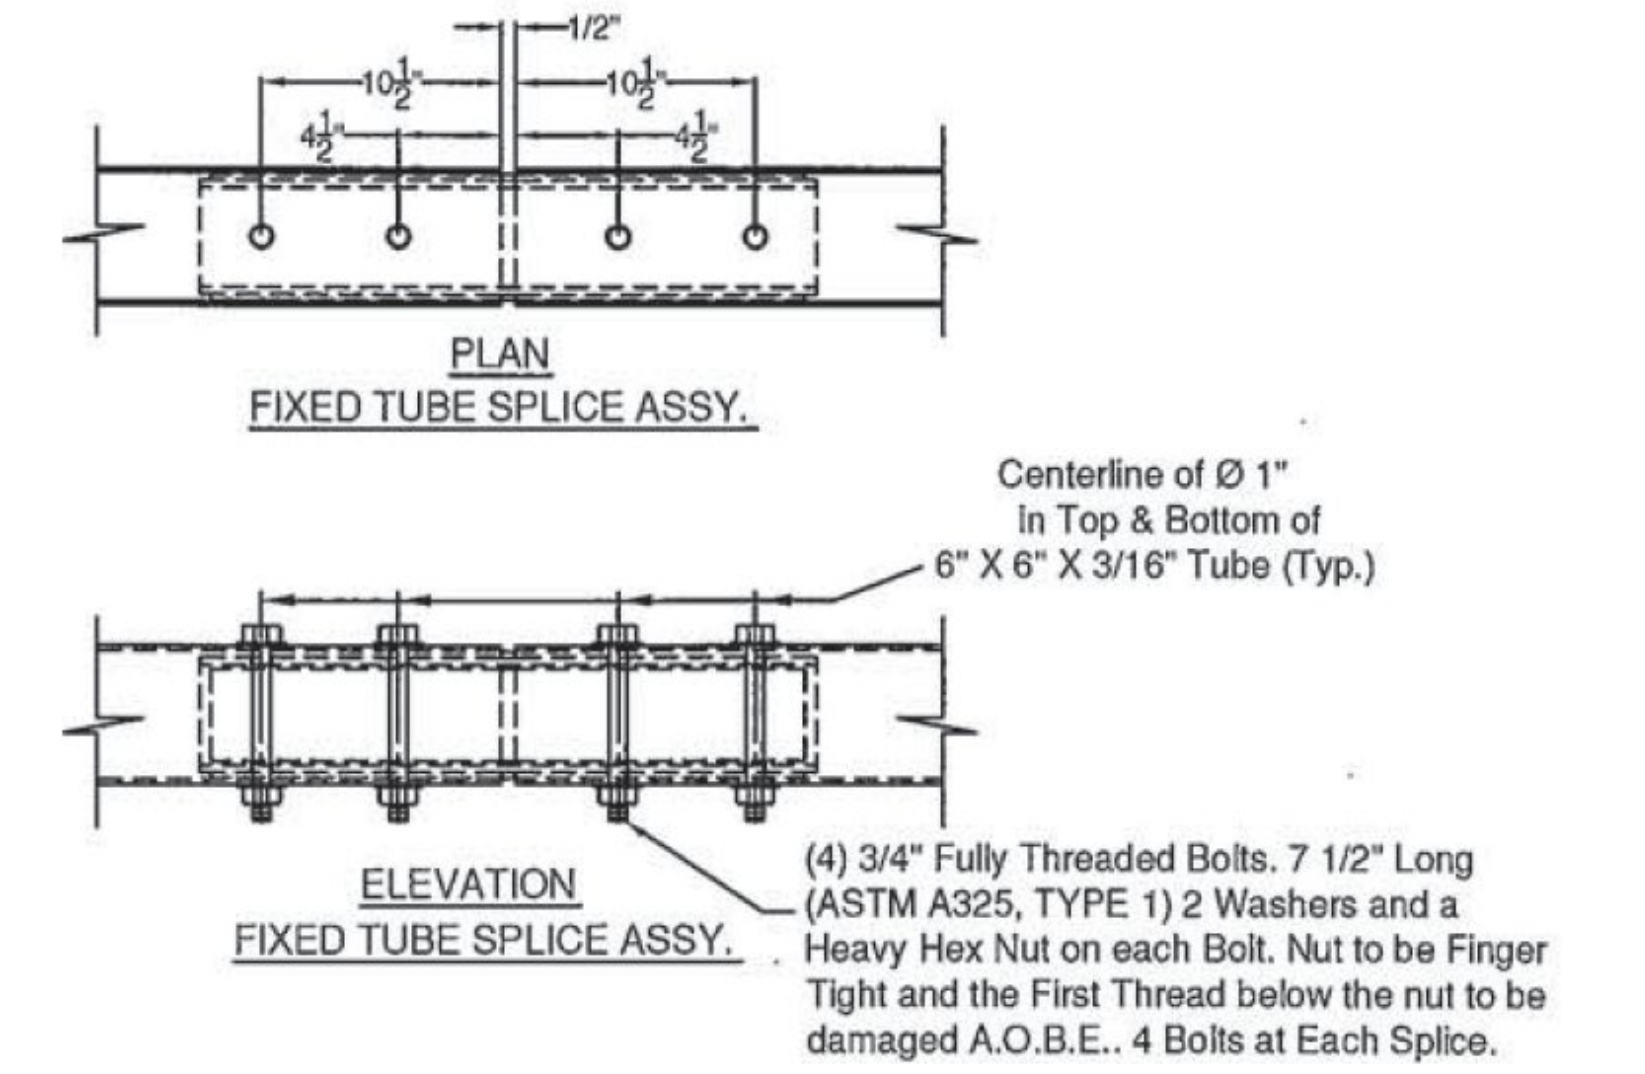
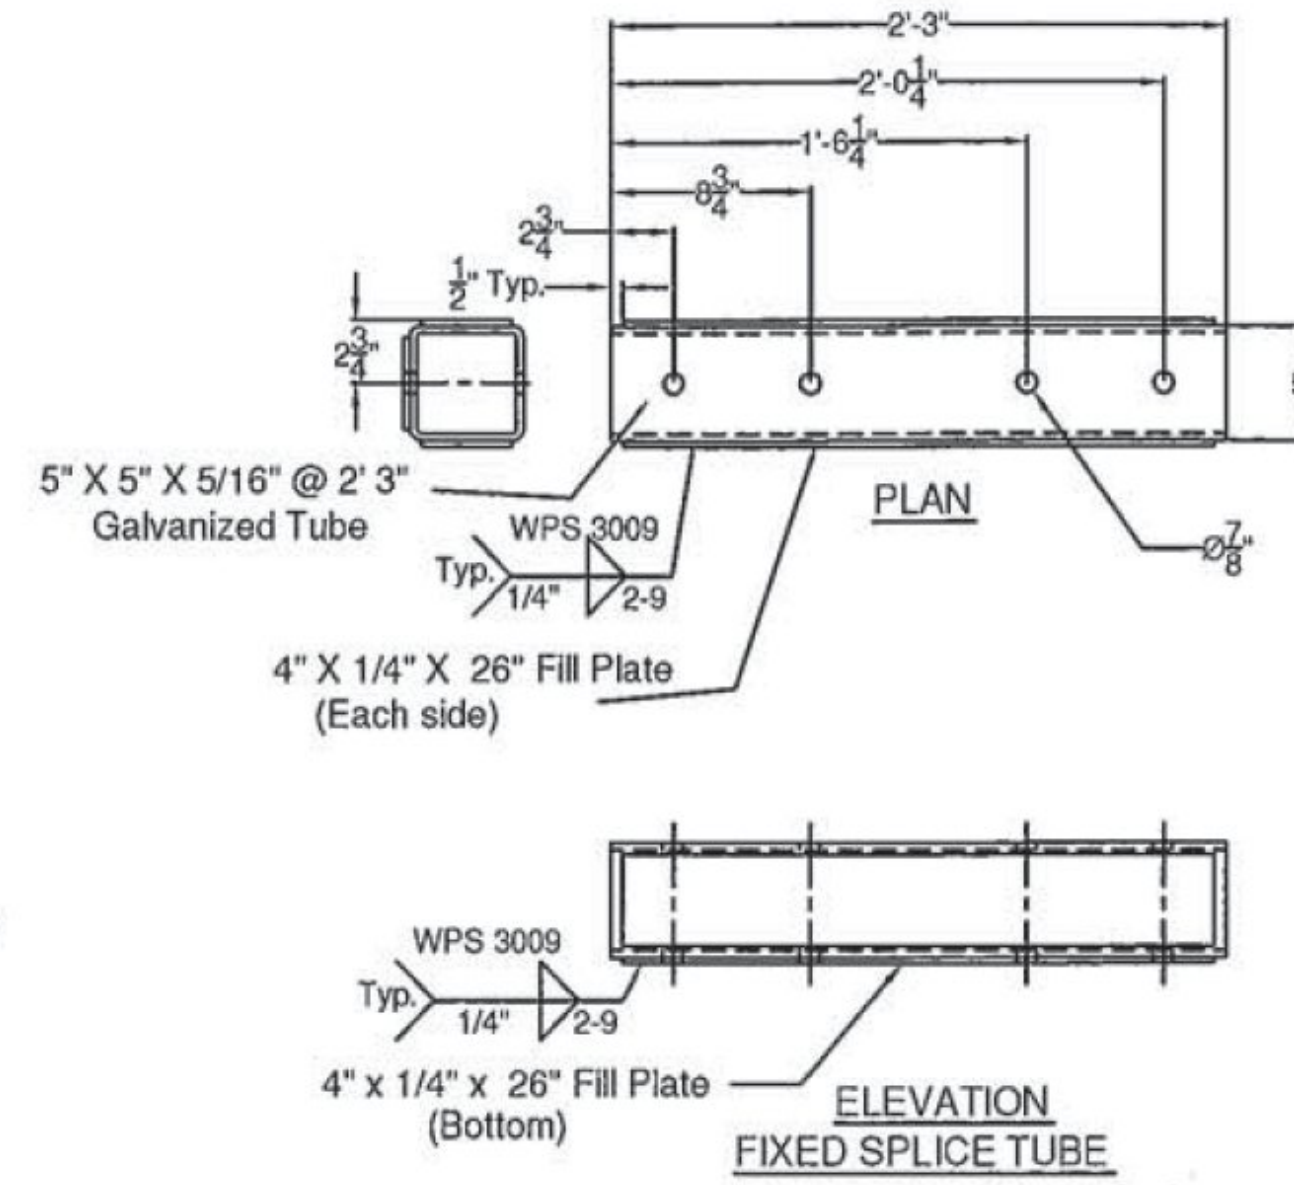
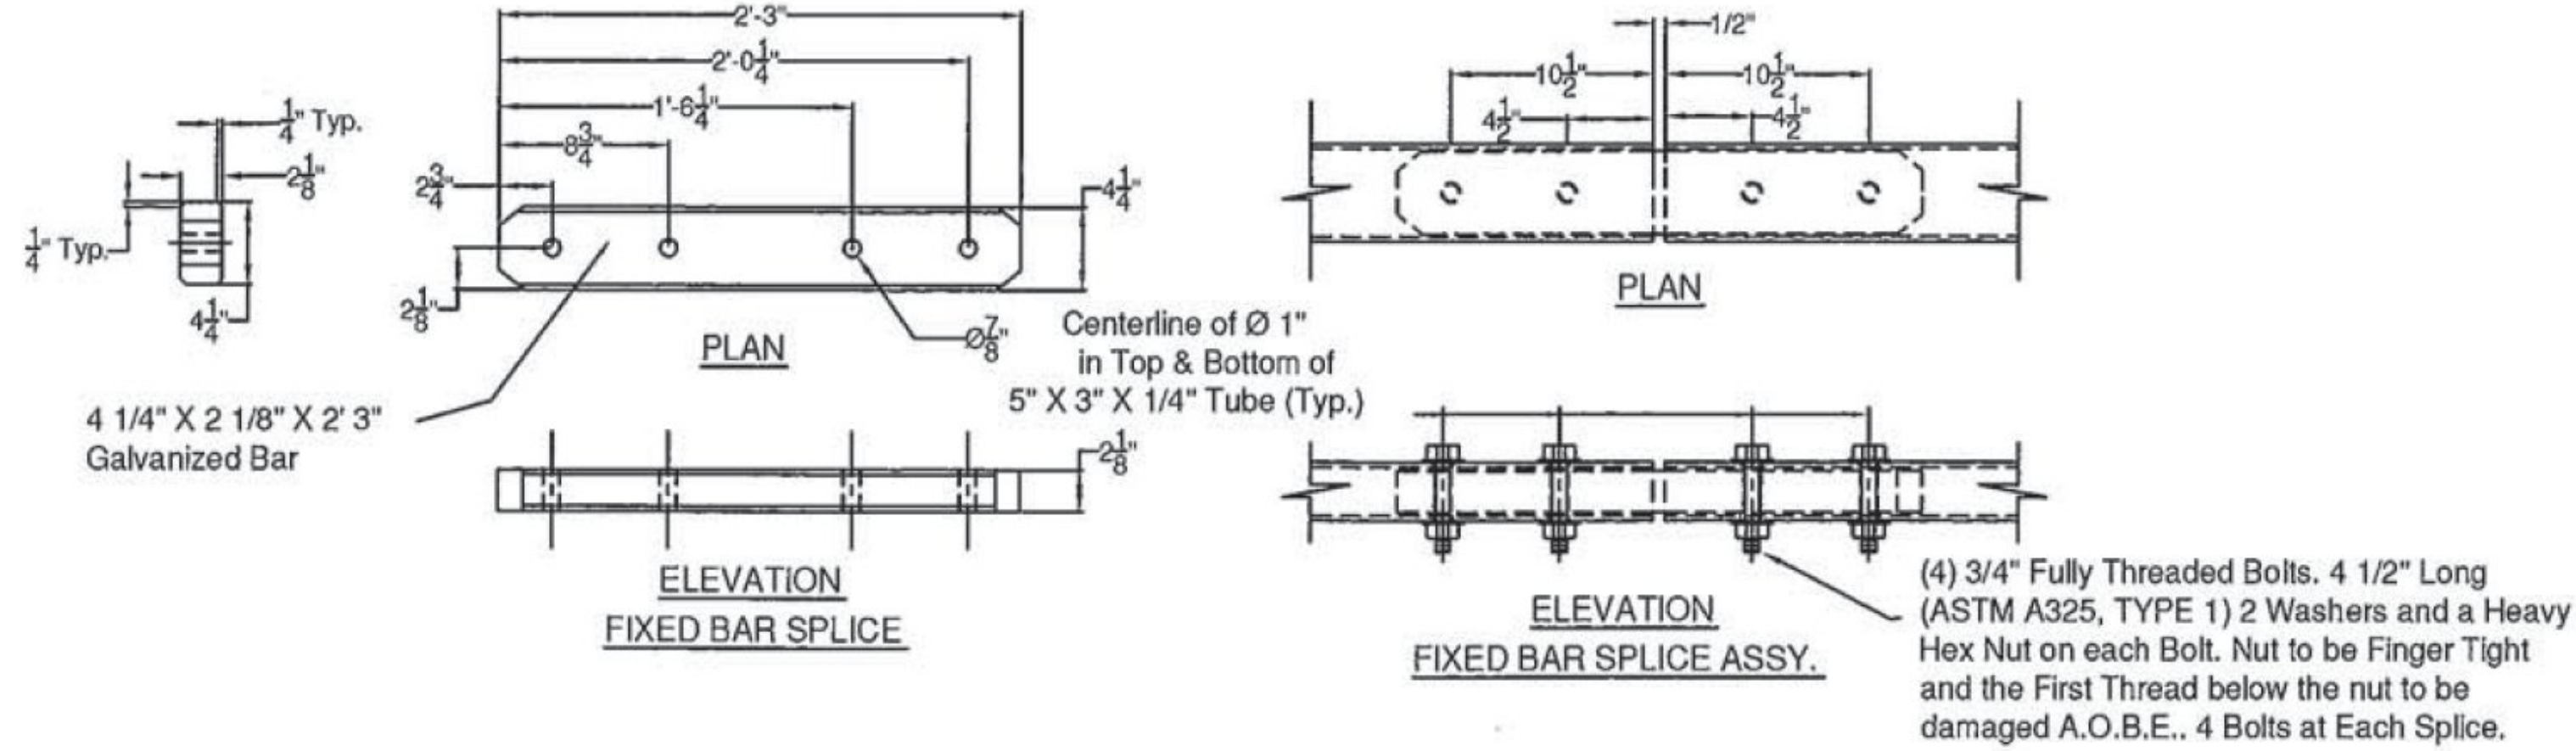


**SPLICE TUBE - FIXED**

Vermont Agency of Transportation  
**RECEIVED**

CK'D BY GL OK'D BY JS  
January 8, 2015  
RESUBMIT NO Approved  
BY KH DATE 1-8-2015

**BRIDGE POST DETAIL**

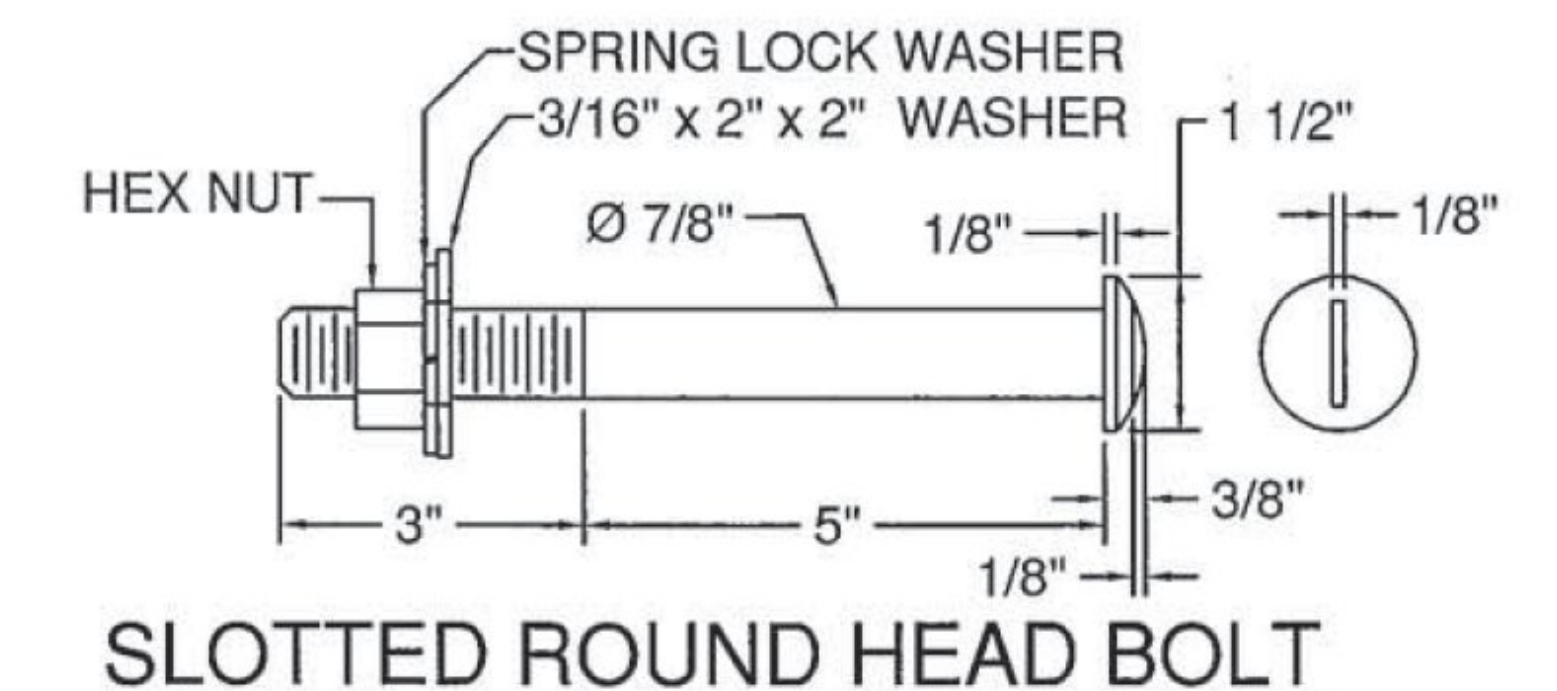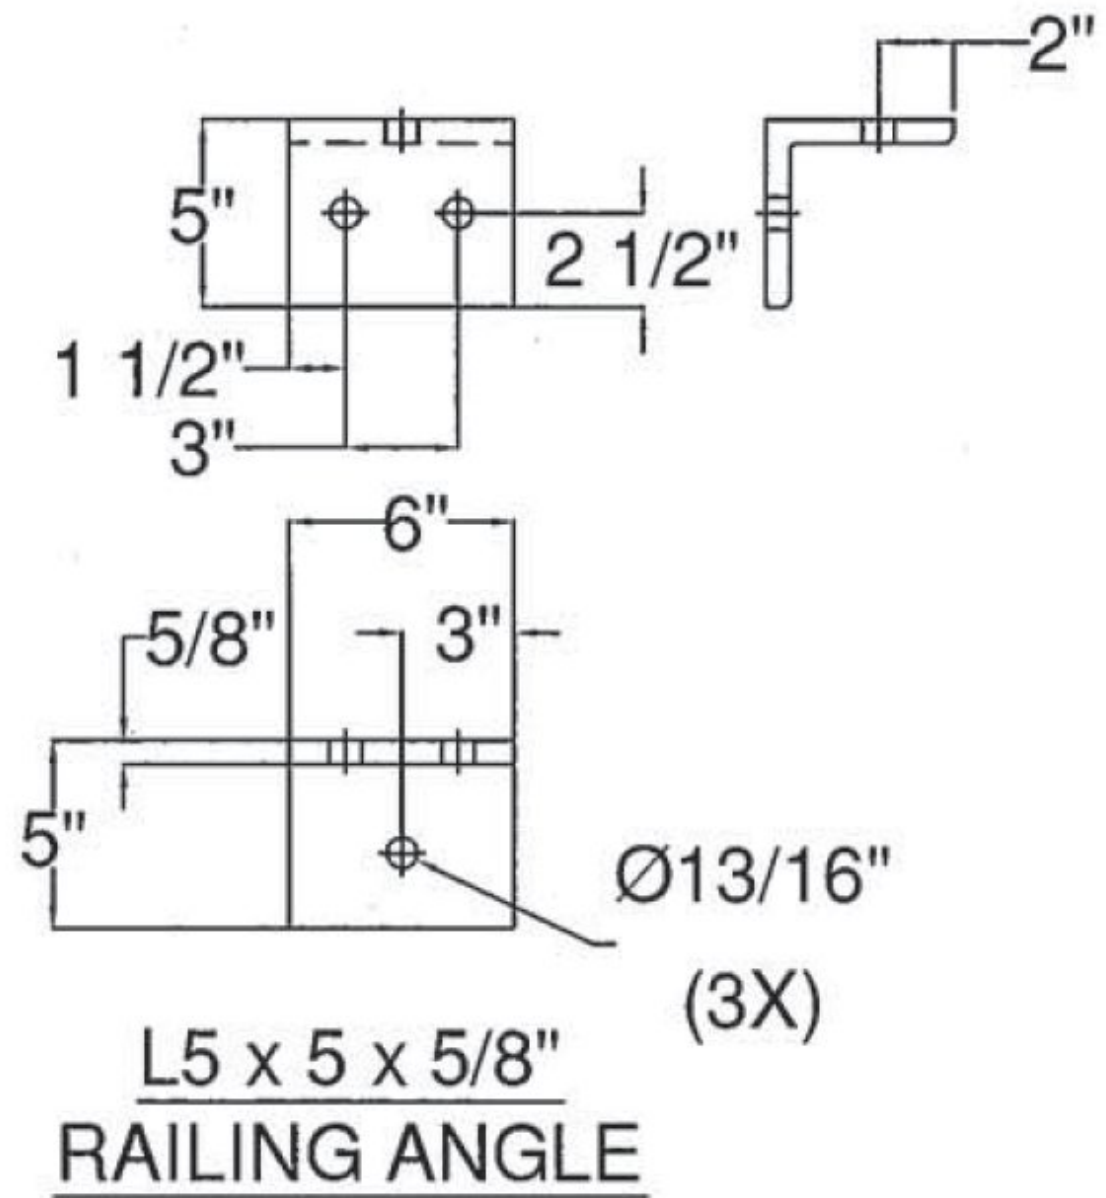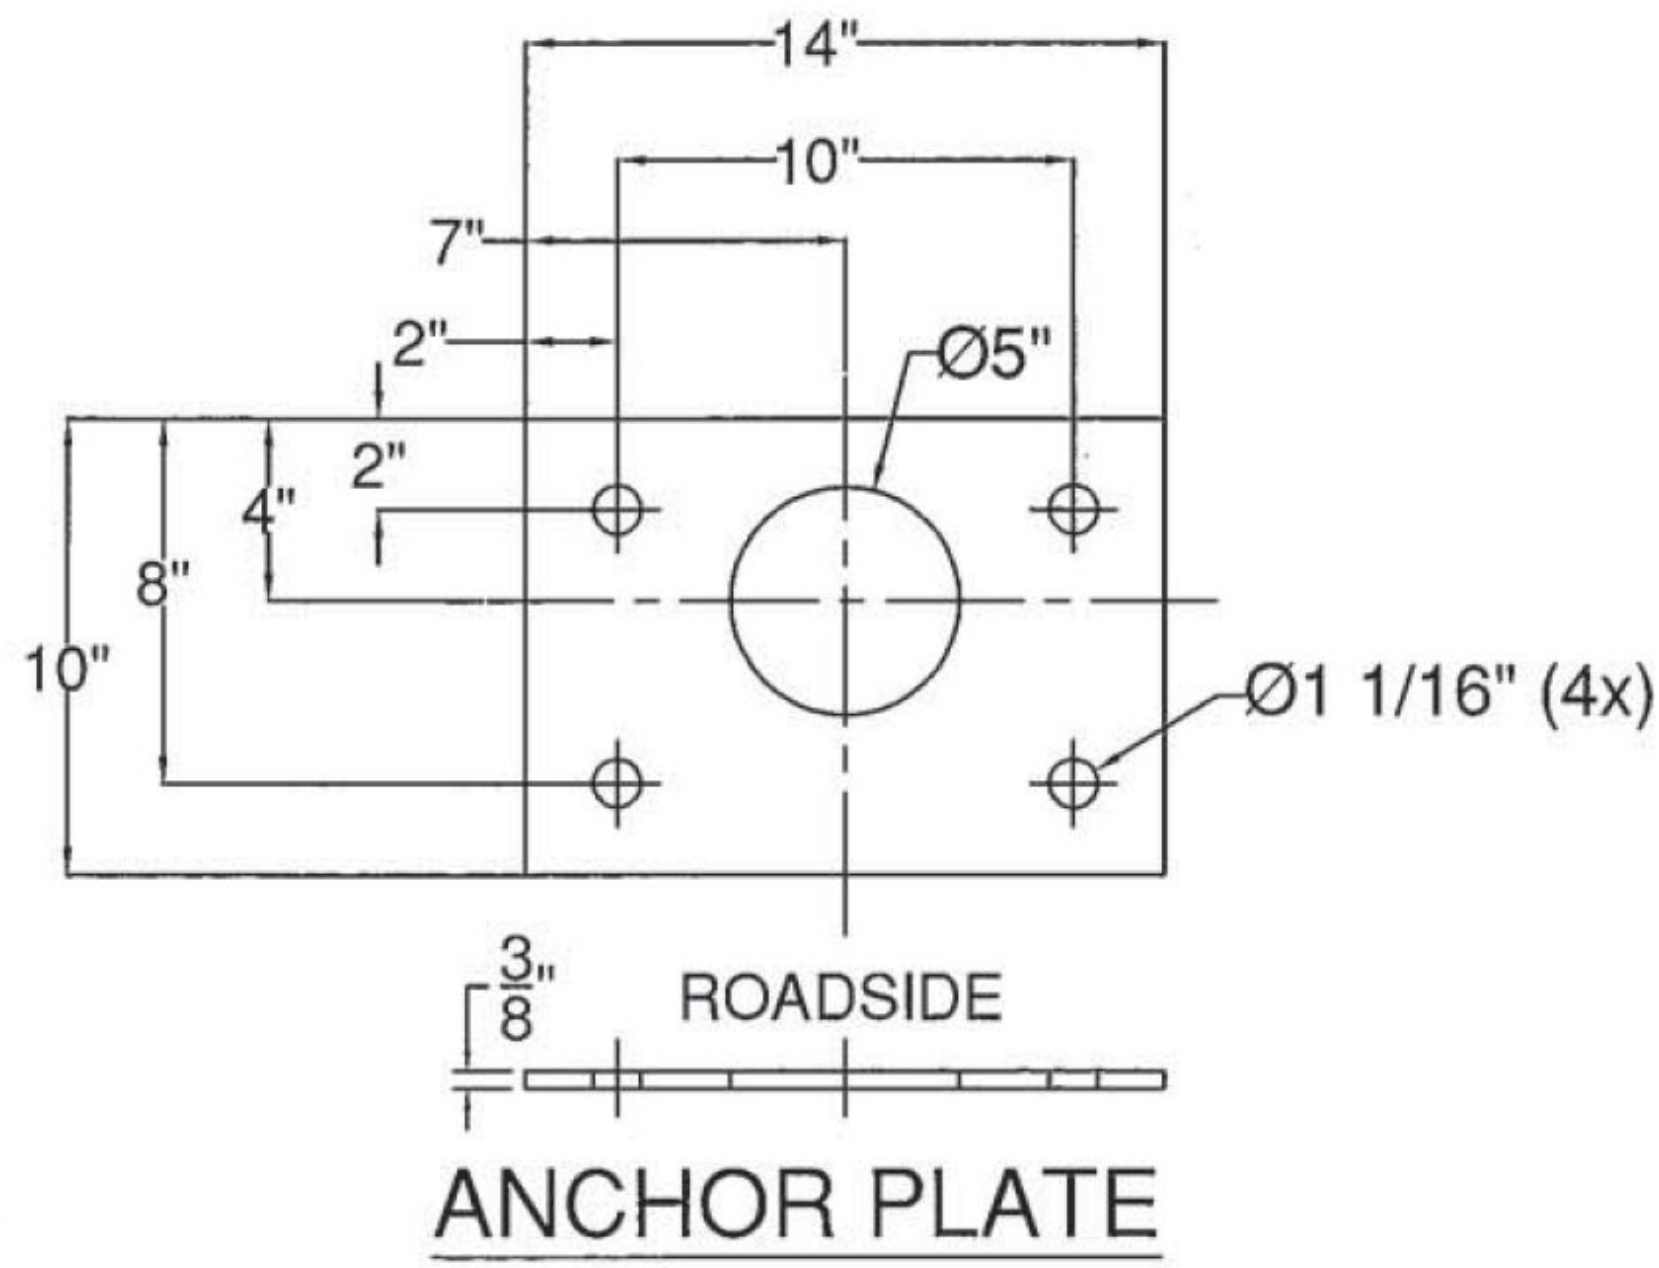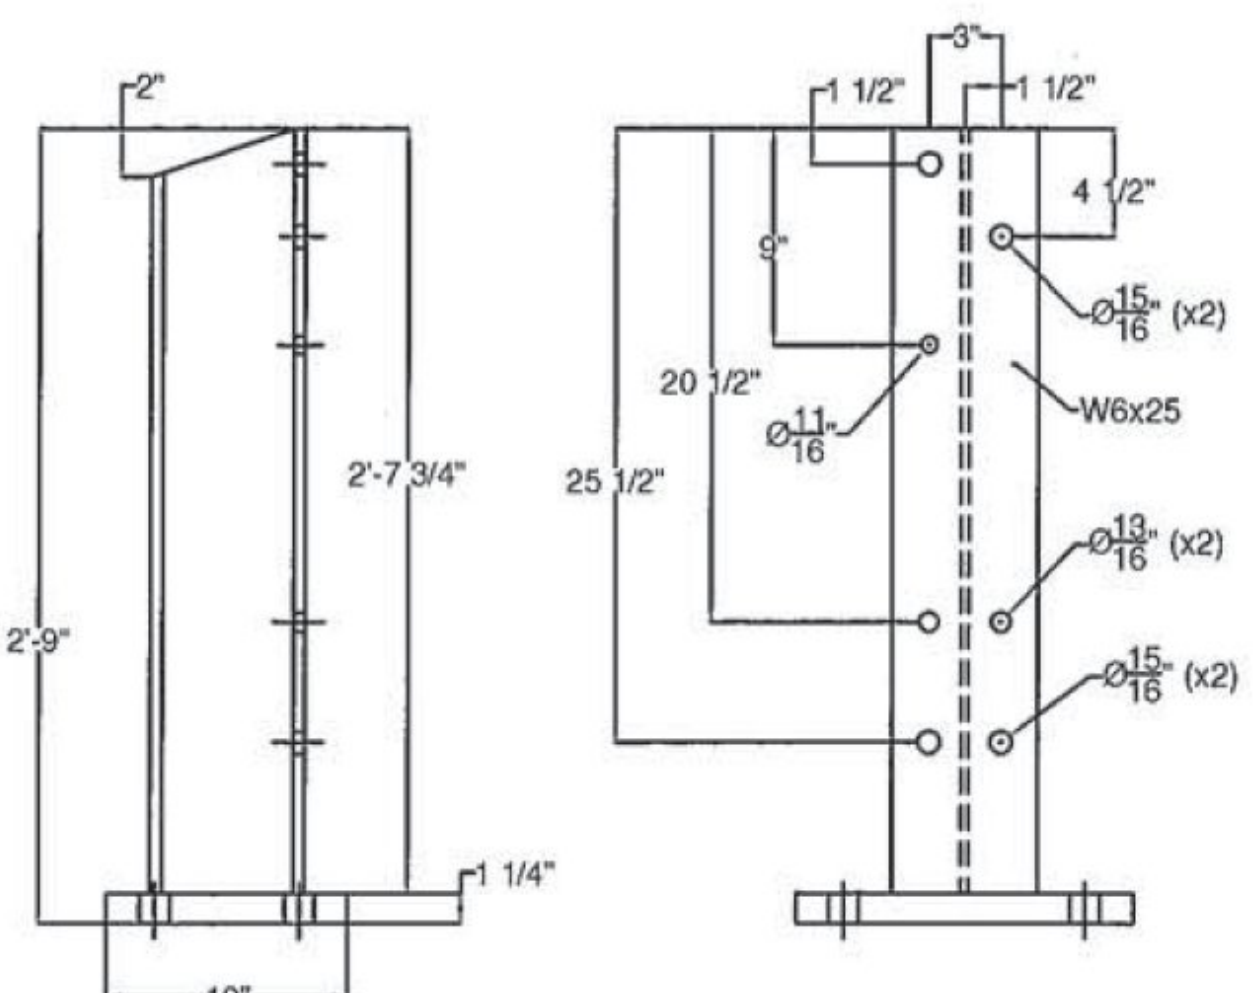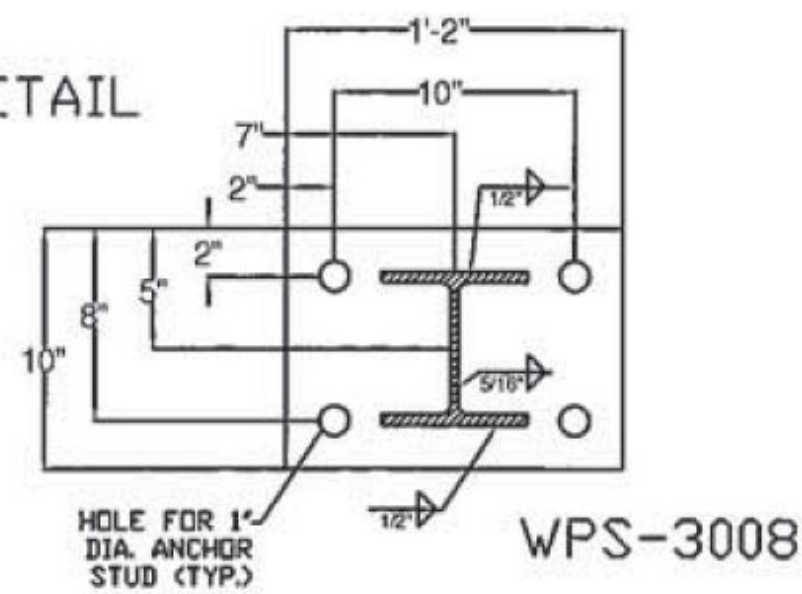

ITEM #: 525.335  
STRUCTURAL STEEL TO COMPLY W/ ASTM A6  
TOLERANCE UNLESS OTHERWISE NOTED:  
FRACTIONS = ± 1/16"  
ANGLES = ± 1/2"  
DIAMETERS = ± 1/32"

<b>BRIDGE RAIL DETAILS SHEET</b>							
TOWN HIGHWAY 46 (IRISH SETTLEMENT ROAD), BRIDGE # 28 TOWN OF CAMBRIDGE, COUNTY OF LAMOILLE, VT.							
R NO.	DATE	DESCRIPTION	BY	R NO.	DATE	DESCRIPTION	BY
E 1	1/7/15	Revised Per 12/19/14 Markup	E.P.	E			
V				V			
DRAWN		E.P.		11/21/14			
CHECKED		D.L.		11/21/14			
APPROVED							
SCALE		SCHEMATIC					
DRAWING NO. F.R. LaFAYETTE-CAMBRIDGE							

**WELDING PROCEDURE SPECIFICATION**

PQR ELDERLEE #3

Material Specification	A709 TO A500 GR B
Welding Process	FCAW-G
Manual or Machine	SEMAUTOMATIC
Position of Welding	FLAT/HORIZONTAL
Filler Metal Specification	A5.29
Filler Metal Classification	E81T1-Ni1C-JH4
Flux	N/A
Shielding Gas	CO 2 Dew Point -40DEG F Flow Rate 50CFH
Single or Multiple Pass	SINGLE
Single or Multiple Arc	SINGLE
Welding Current	DC
Polarity	REVERSE ELECTRODE POSITIVE
Welding Progression	STRINGER
Root Treatment	D1.5
Preheat and Interpass Temperature	D1.5
Postheat Temperature	NONE
Heat Input	Min _____ Max _____

**WELDING PROCEDURE.**

Pass no.	Electrode size	Welding Current		Travel speed	Joint detail
		Amperes	Volts		
1	1/16	310	25	11	
Variable	LIMITS	341	27	12	
		TO 269	TO 23	TO 10	

This procedure may vary due to fabrication sequence, fit-up, pass size, etc., within the limitation of variables given in Section 5.

Procedure No. 3009 Contractor Elderlee, Inc.  
 Revision No. _____ Authorized By RANDY SCOTT  
 Date 3/20/2014

**WELDING PROCEDURE SPECIFICATION**

PQR ELDERLEE#1

Material Specification	A572 GRD. 50 /A992-06a
Welding Process	FCAW
Manual or Machine	SEMAUTOMATIC
Position of Welding	FLAT/HORIZONTAL
Filler Metal Specification	A5.20
Filler Metal Classification	E70 LINCOLN OUTERSHEILD
Flux	N/A
Shielding Gas	CO 2 Dew Point -40DEG F Flow Rate 50 CFM
Single or Multiple Pass	SINGLE (45 TO 63 CFM)
Single or Multiple Arc	N/A
Welding Current	DC
Polarity	DCEP
Welding Progression	STRINGER
Root Treatment	PER D1.5
Preheat and Interpass Temperature	PER D1.5
Postheat Temperature	NONE
Heat Input	Min _____ Max _____

**WELDING PROCEDURE.**

Pass no.	Electrode size	Welding Current		Travel speed	Joint detail
		Amperes	Volts		
1	3/32	390	27	12	
Variable	LIMITS	351	25	11	
		TO 429	TO 29	TO 13	

This procedure may vary due to fabrication sequence, fit-up, pass size, etc., within the limitation of variables given in Section 5.

Procedure No. 3008 Contractor Elderlee, Inc.  
 Revision No. _____ Authorized By RANDY SCOTT  
 Date 5/29/2013


Vermont Agency of Transportation

**RECEIVED**

CK'D BY JC OK'D BY JS


January 8, 2015

RESUBMIT NO Approved _____  
 BY KH DATE 1-8-2015

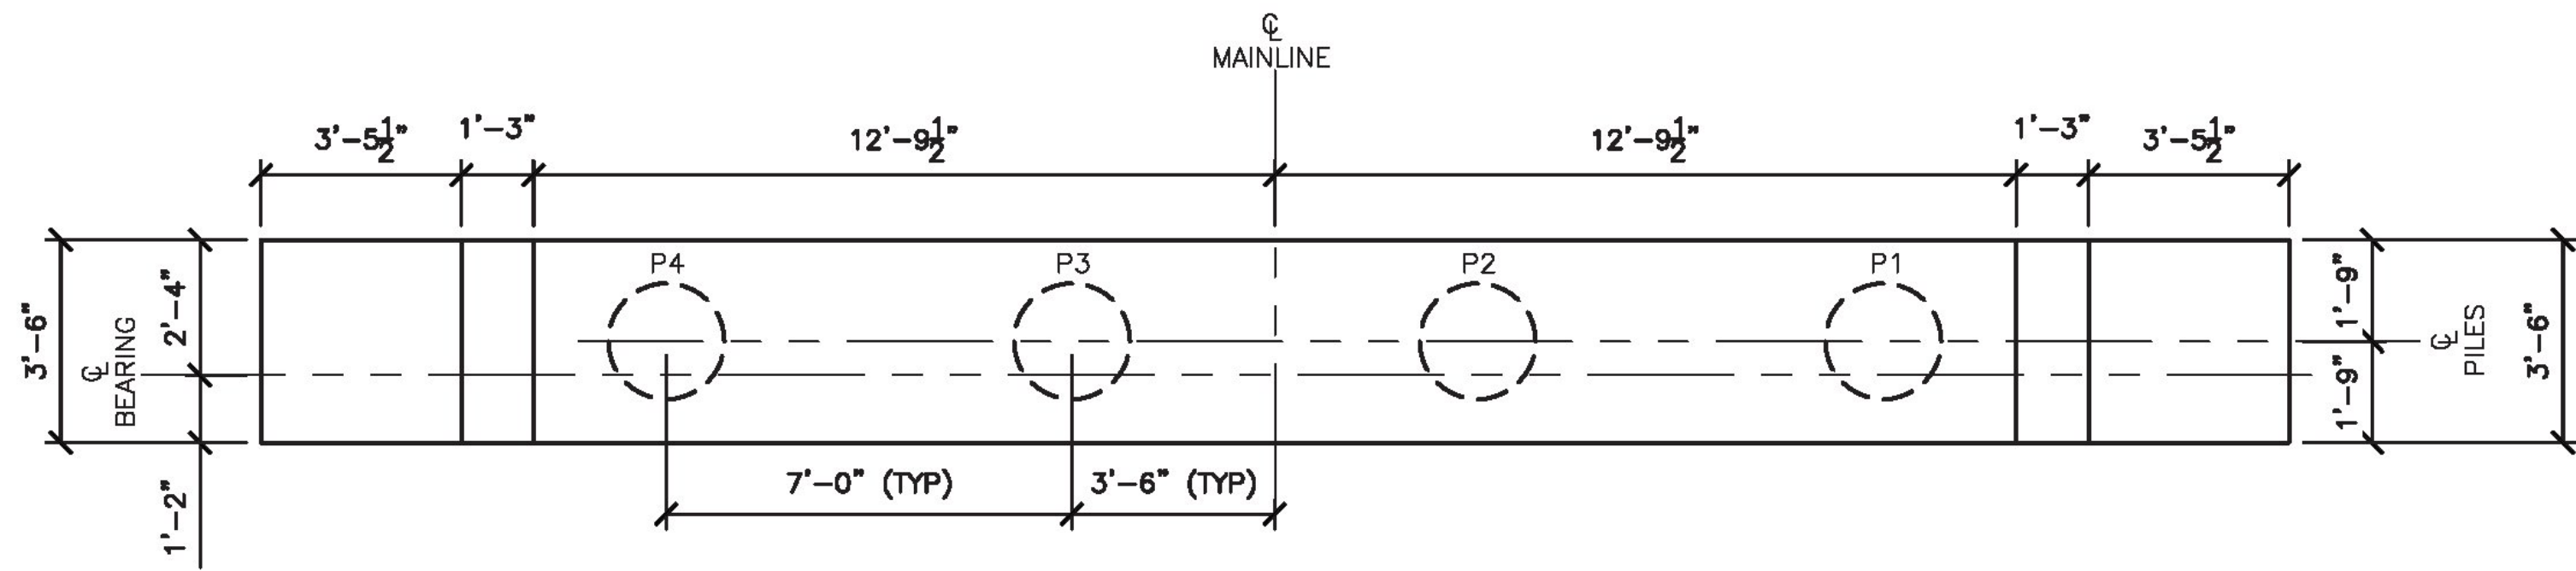

TYPICAL ABUTMENT PLAN

SCALE: 1/4"=1'-0"

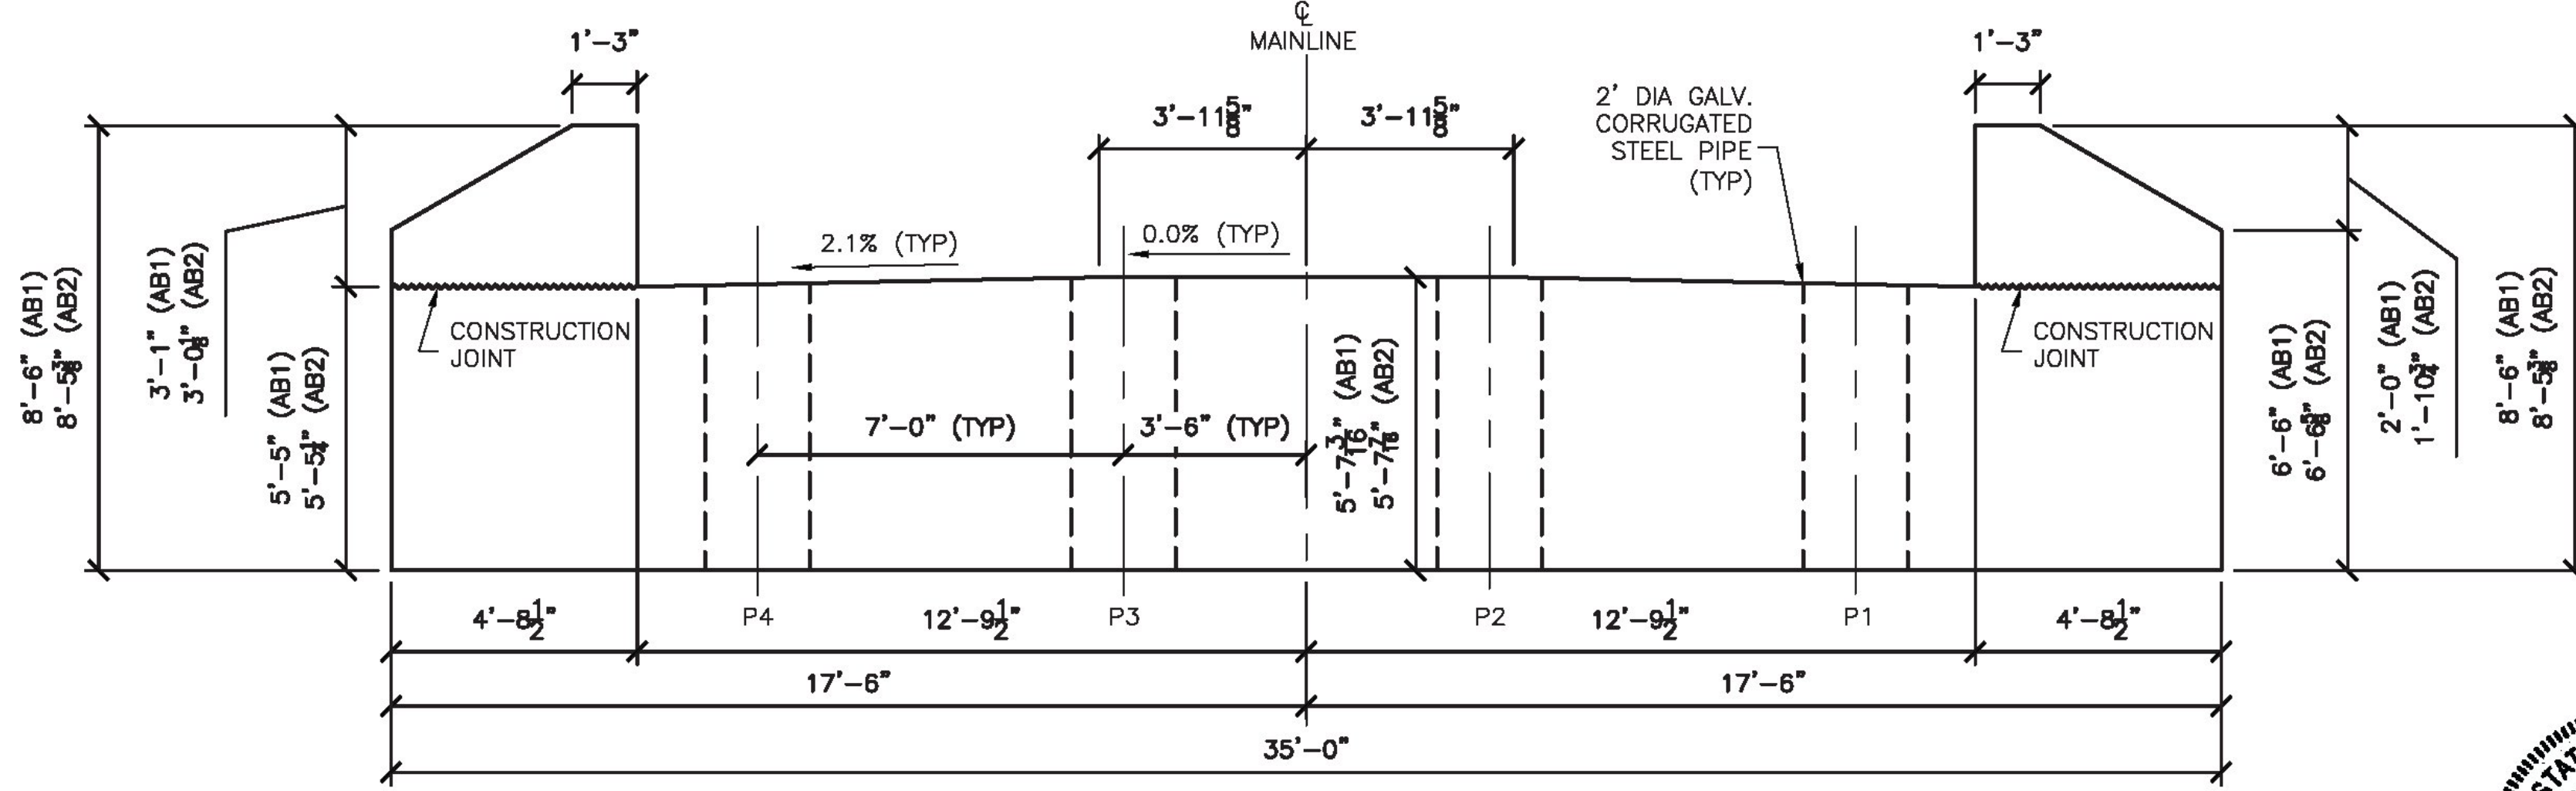


TYPICAL ABUTMENT ELEVATION

SCALE: 1/4"=1'-0"

Vermont Agency of Transportation  
**RECEIVED**

CK'D BY GL OK'D BY JS  
June 19, 2015  
RESUBMIT NO Approved  
BY RY DATE 6-23-2015

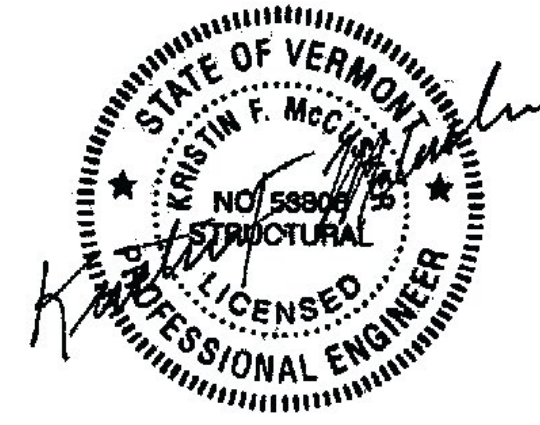

1


PREPARED BY: KFM  
CHECKED BY: TRF  
DATE: 05/20/15

CAMBRIDGE BRO 1448(39)  
Abutments #1 and #2  
Cambridge, VT

T. R. FELLOWS  
NH  
VT ENGINEERING  
CIVIL - STRUCTURAL  
134 COUNTY ROAD  
PO BOX 56  
ROCHESTER, VT 07676  
P.O. BOX 428 03608  
TEL/FAX: 803.758.4811  
trf@myelipoint.net  
kcc@myelipoint.net






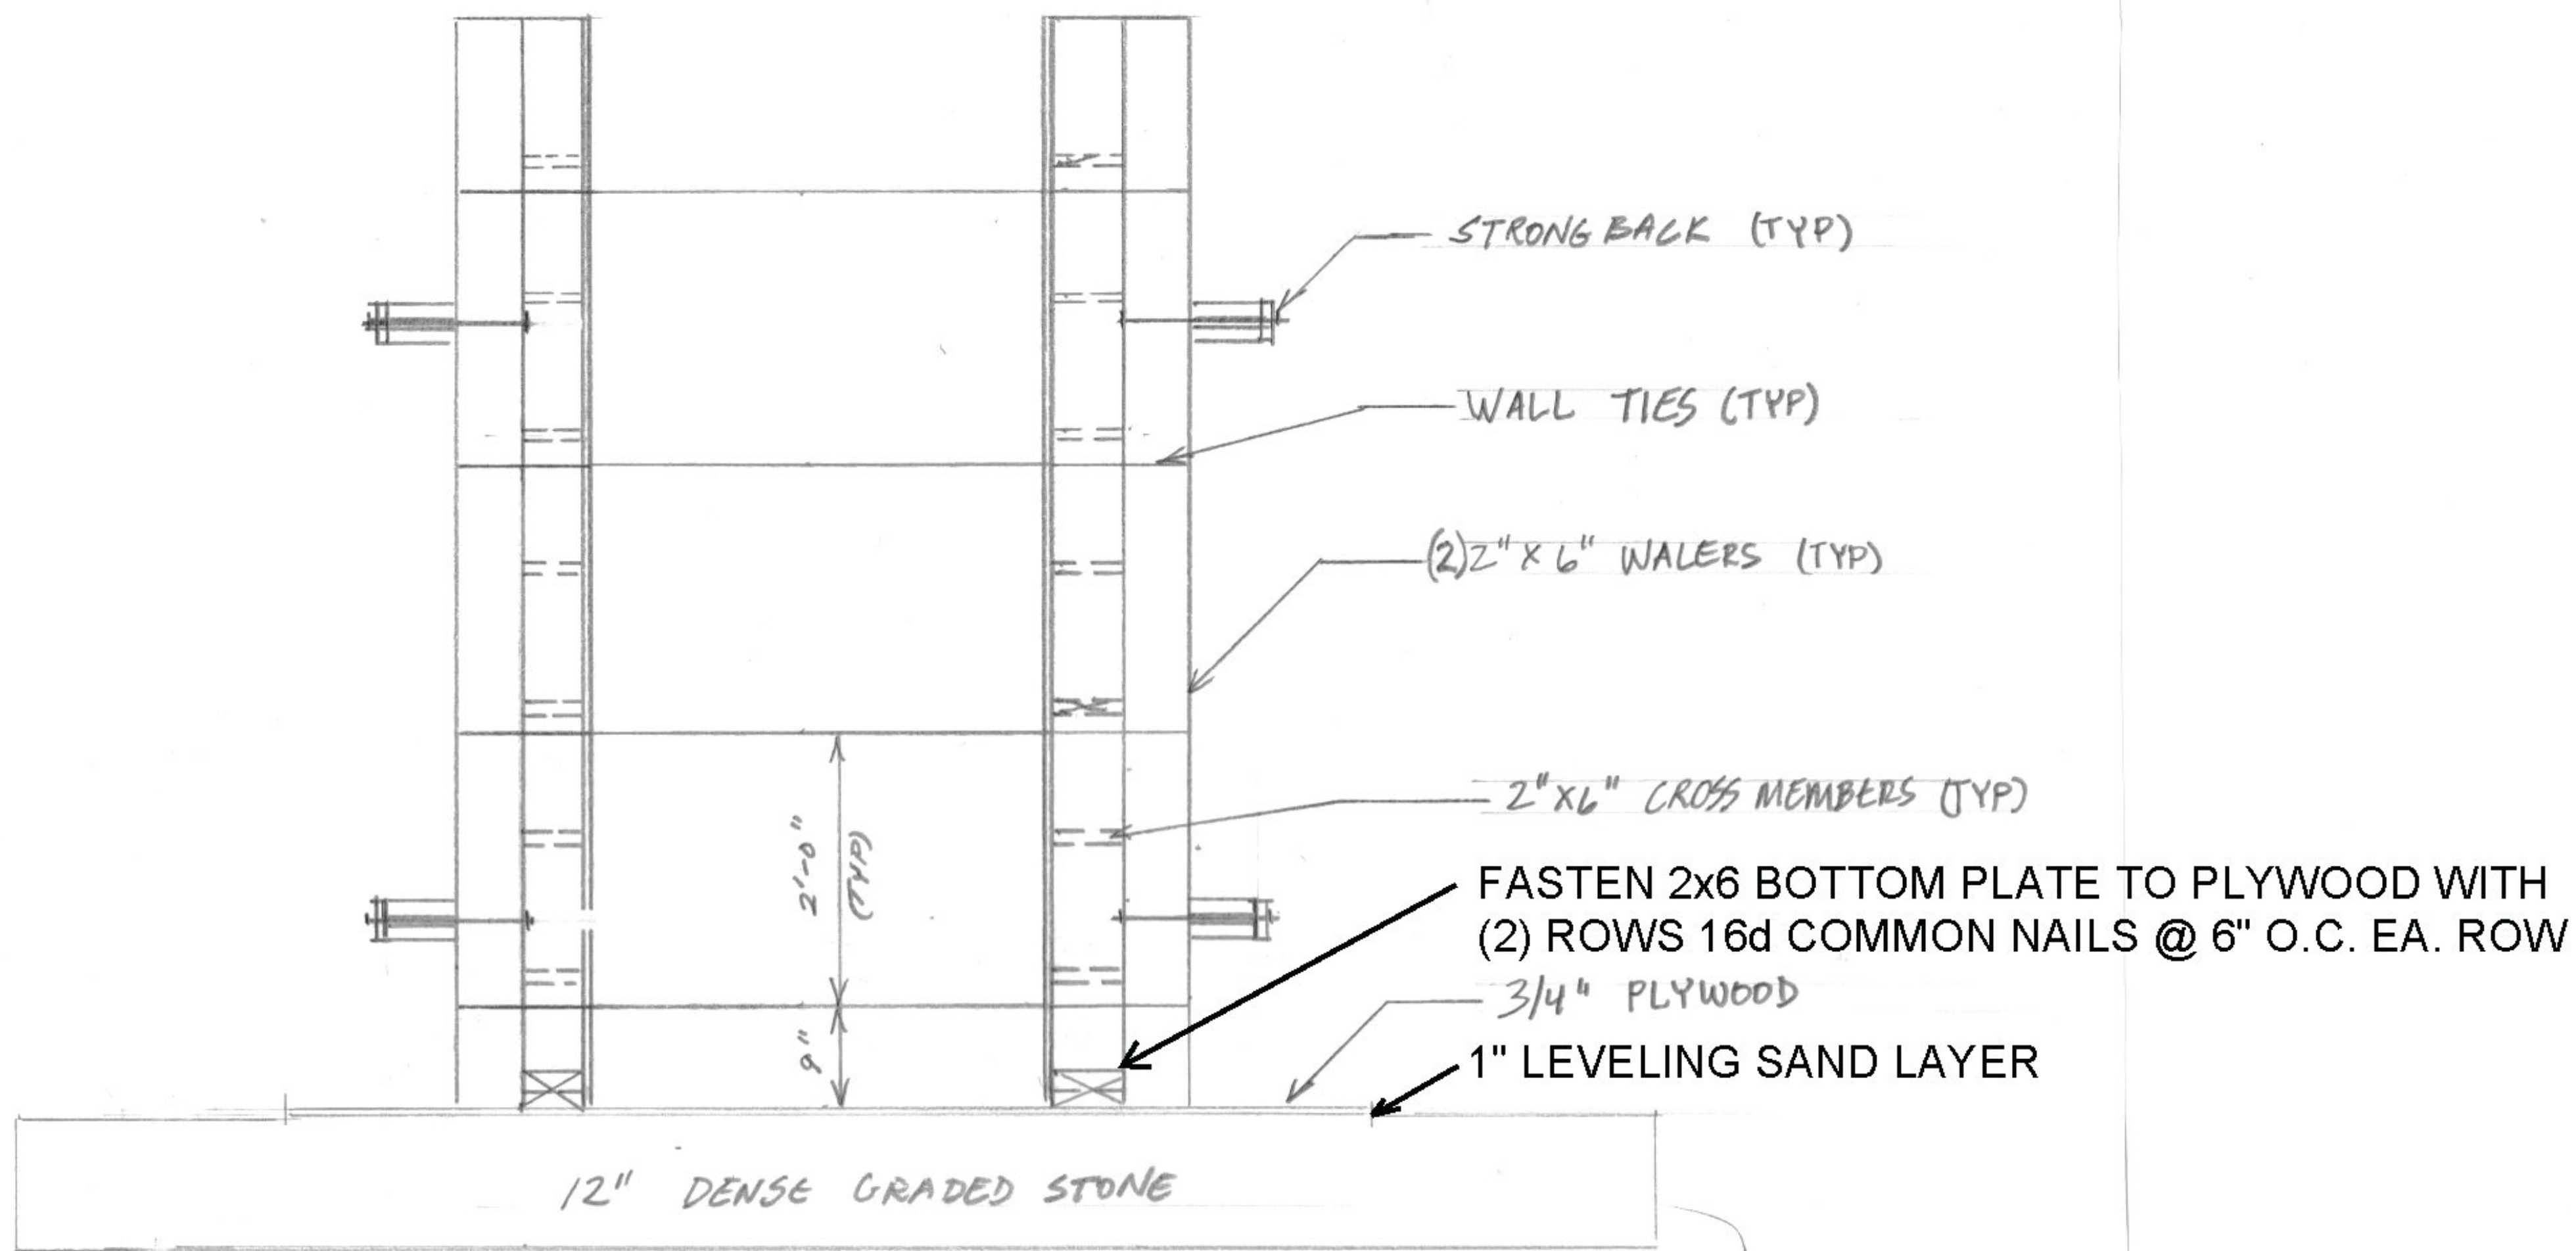

TYPICAL FORM SECTION

1/2" = 1'-0"

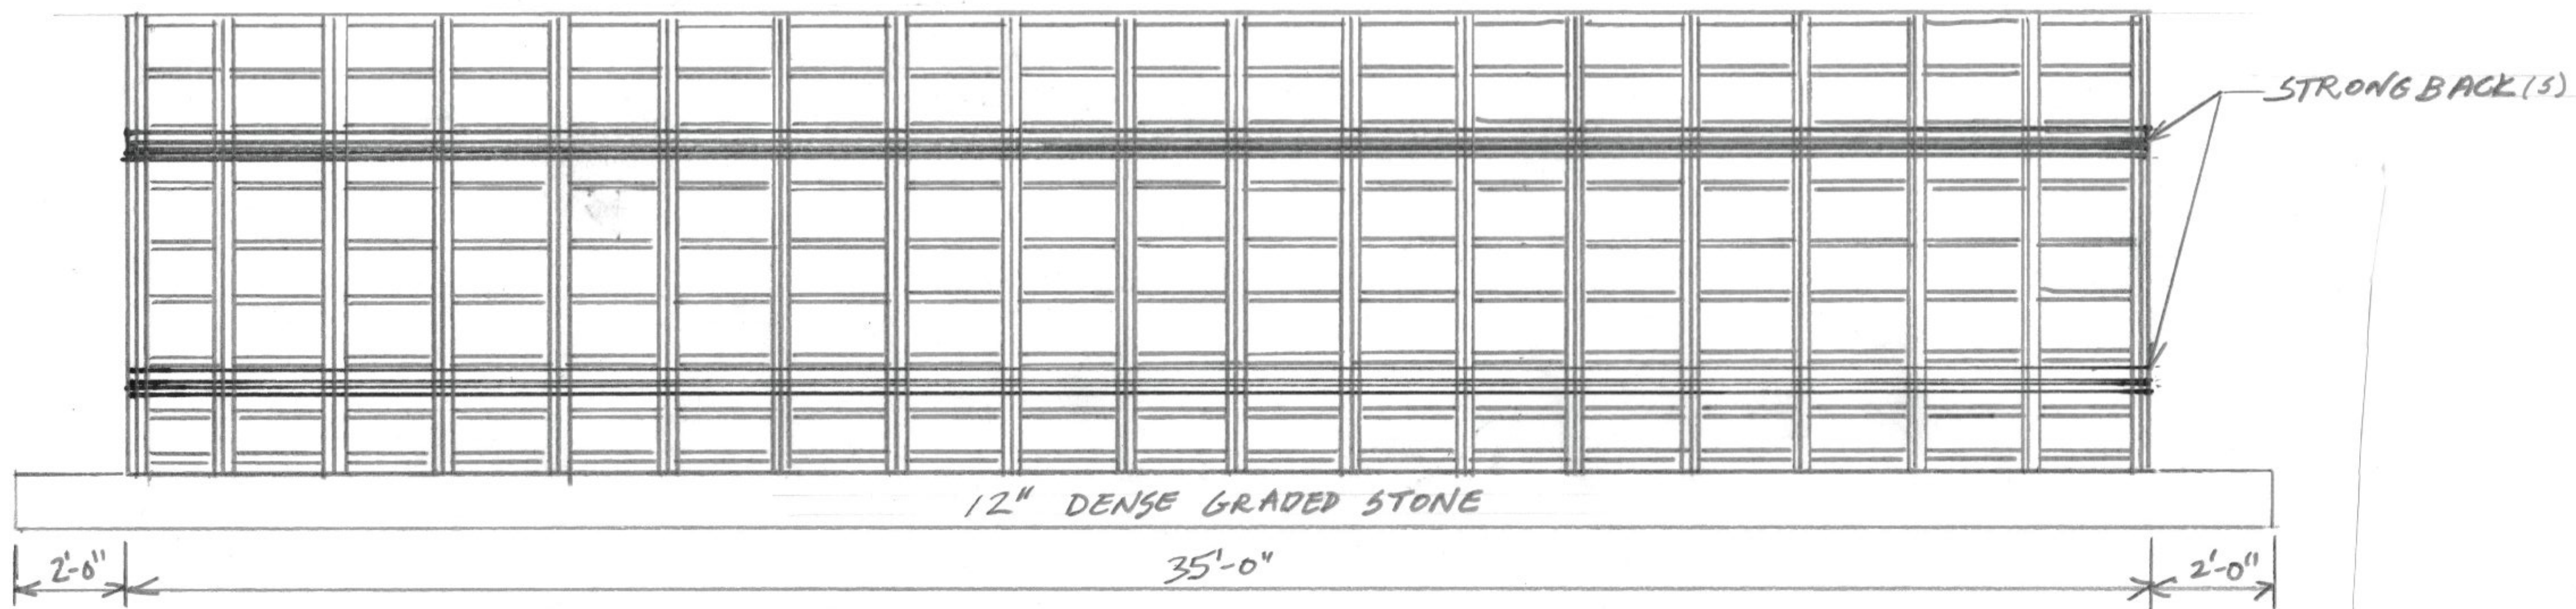

TYPICAL FORM ELEVATION

1/4" = 1'-0"

Vermont Agency of Transportation


**RECEIVED**

CK'D BY GL OK'D BY JS


June 19, 2015

RESUBMIT NO Approved


BY RY DATE 6-23-2015

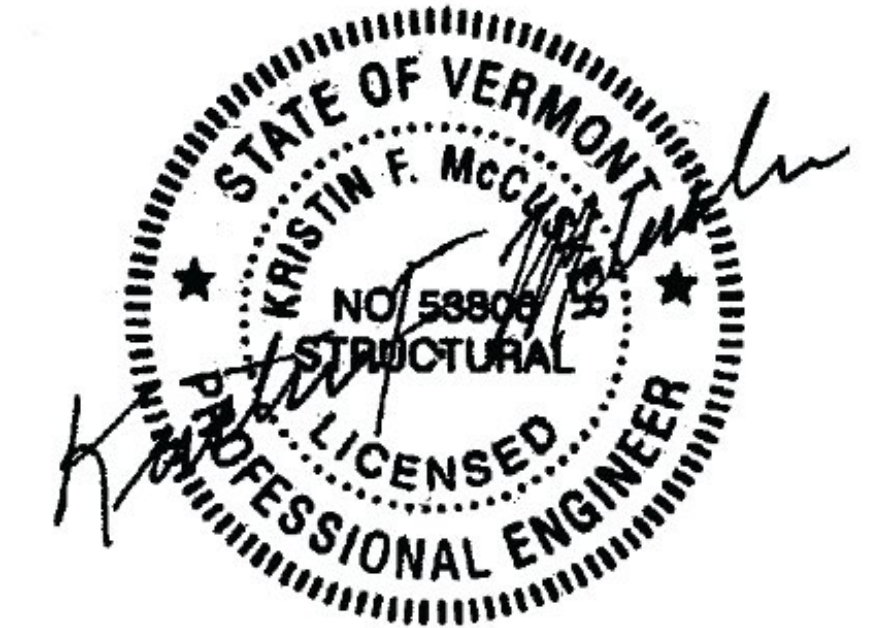


BLOW & COTE, INC.	
CAMBRIDGE BRO 1448(39)	
PRECAST FORM DETAILS	
SCALE: AS SHOWN	Page 8 of 38
	2 FEB 15

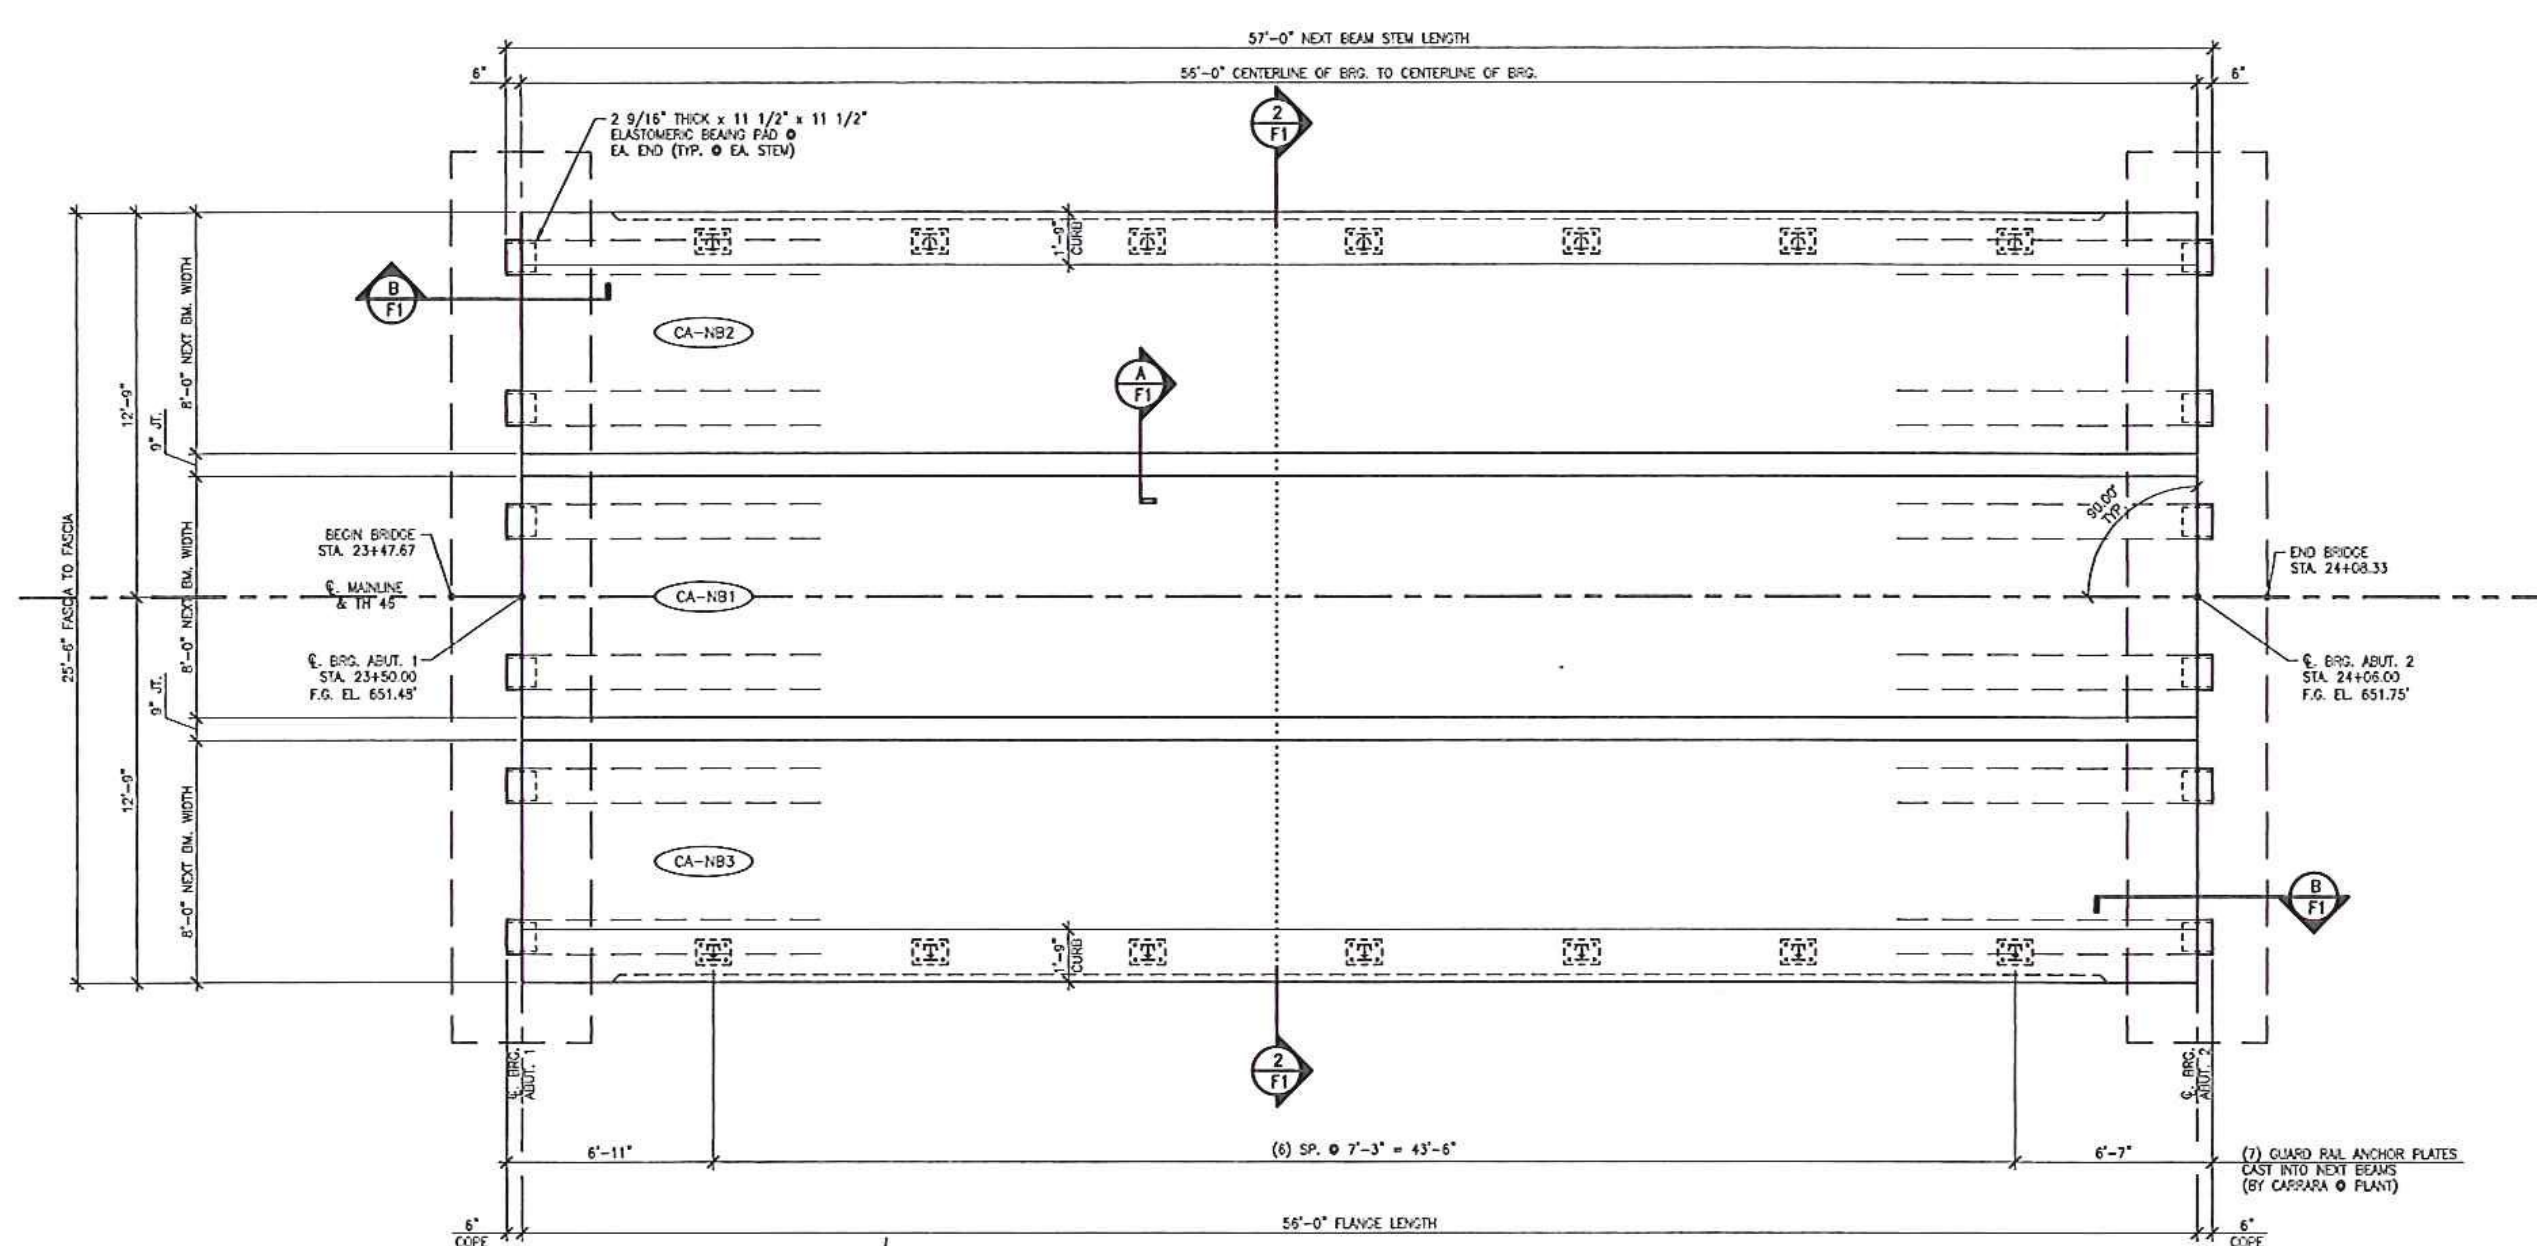


1 NEXT BEAM LAYOUT  
1/4" = 1'-0"

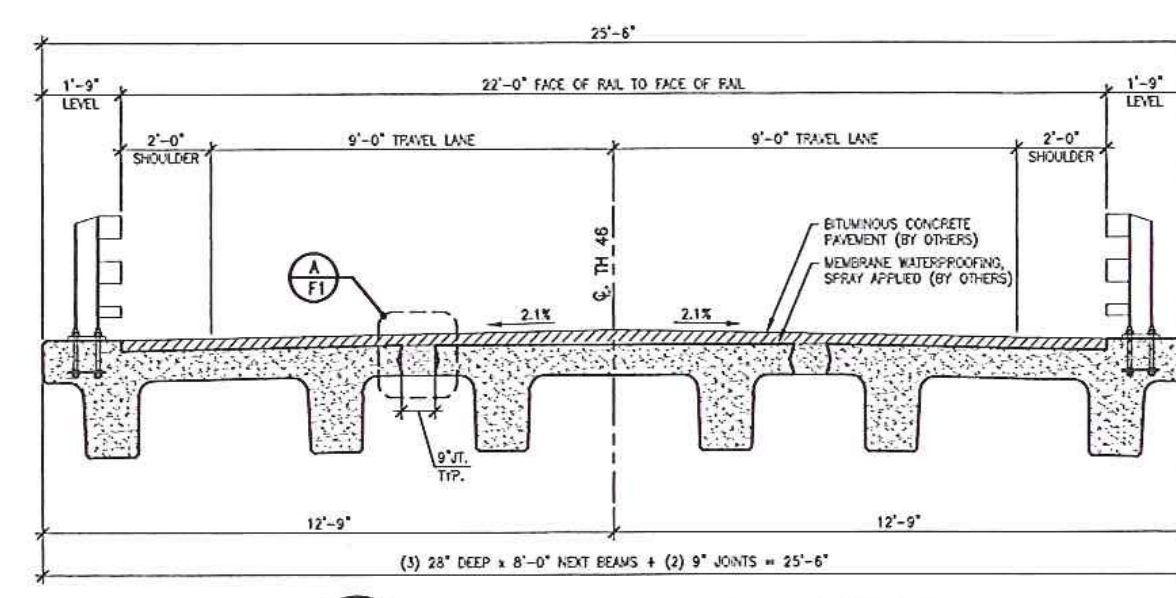

2 TRANSVERSE NEXT BEAM SECTION  
3/8" = 1'-0"

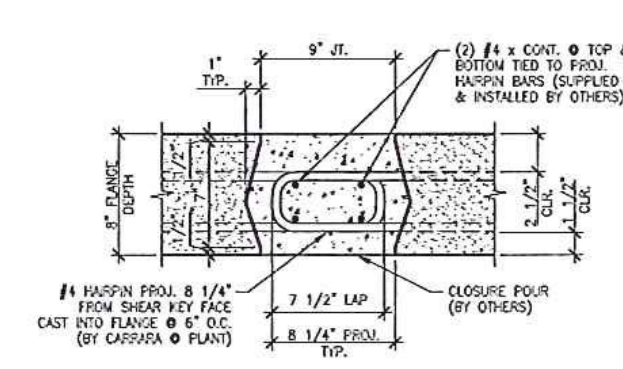

A NEXT BEAM CLOSURE POUR  
1 1/2" = 1'-0"

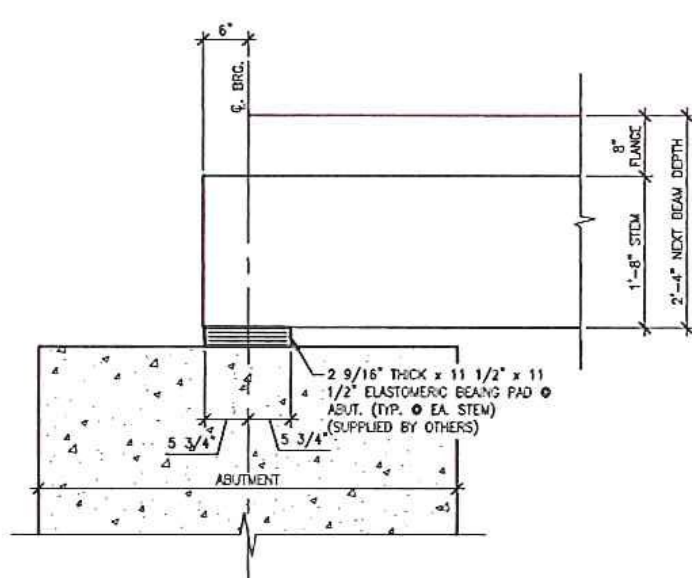

B BEARING DETAIL  
3/4" = 1'-0"

APPROVAL STAMP:  
 05-7-15 REVISED CROWN FROM NEXT BR.  
 01-28-15 REVISED

**Vermont Agency of Transportation**  
**RECEIVED**  
 May 18, 2015  
 Approved  
 DATE 5-19-2015

**J.P. CARRARA & SONS INC.**  
 Precast & Prestress Manufacturer  
 484 DIX ST., WINDHAM, VERMONT 05751 PH: (802) 368-4361 FX: (802) 368-9110

**BLOW & COTE, INC.**  
 CONTRACTOR  
 MORRISVILLE, VERMONT

STATE OF VERMONT AGENCY OF TRANSPORTATION  
 COUNTY OF LAMOILLE


TOWN OF CAMBRIDGE  
 IRISH SETTLEMENT ROAD T.H.46 CLASS 3  
 BRIDGE NO.: 28 PROJECT NO.: BRD 1448(3)

PRESTRESSED NEXT BEAM LAYOUT


DATE: JAN. 28, 2015  
 SCALE: NOTED  
 CHK'D BY: RM DFTM: PSS  
 JOB NO: 23447-014  
 DWG. NO: F1

Submitted  
 5-15-15  
 J. P. CARRARA & SONS, INC.  
 MORRISVILLE, VT 05753




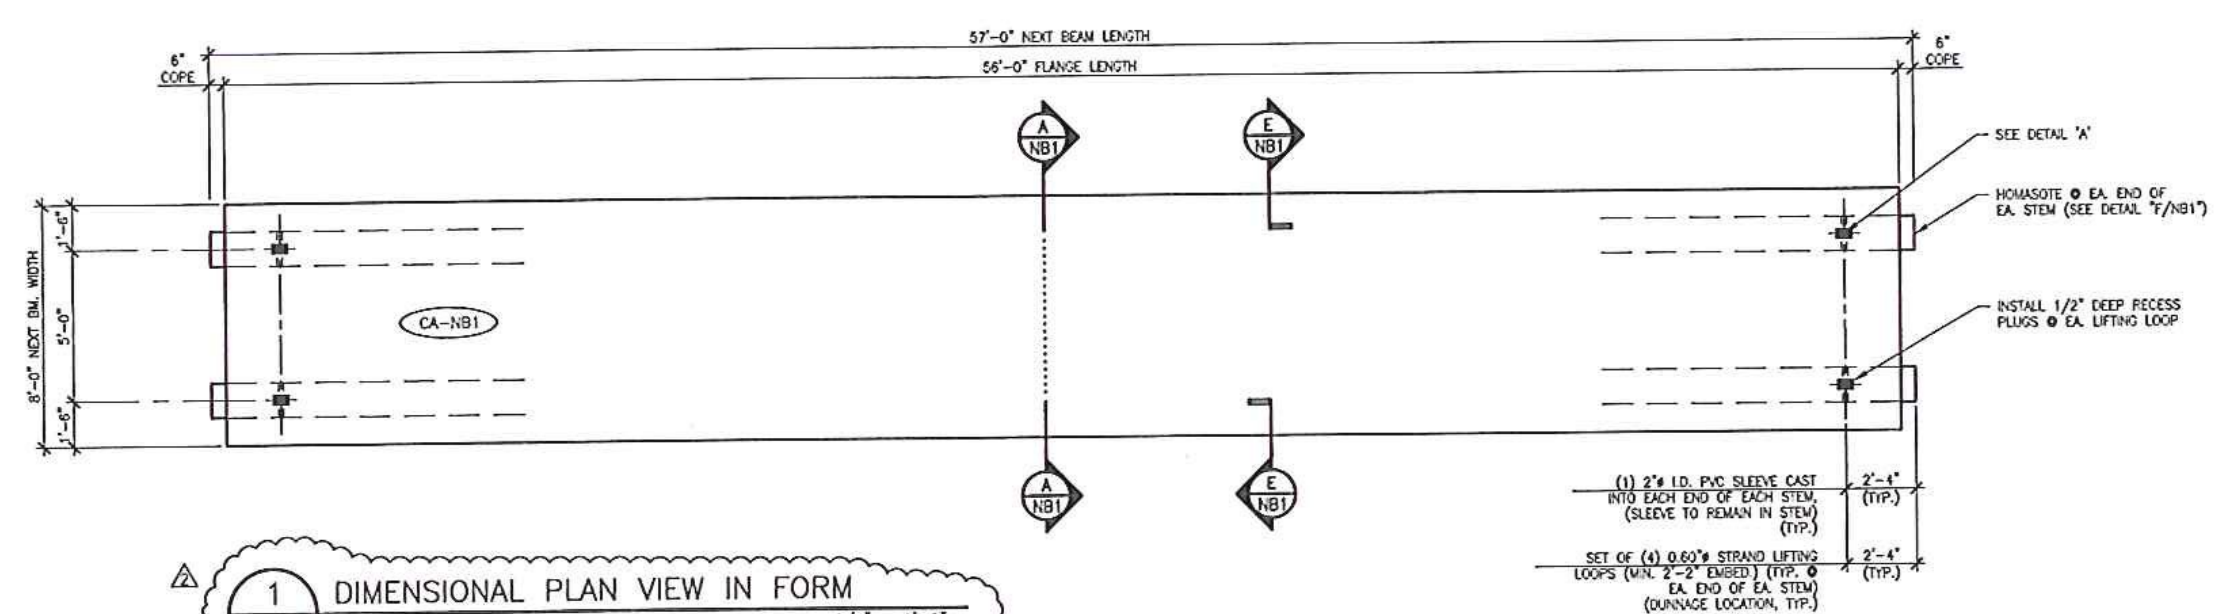

1 DIMENSIONAL PLAN VIEW IN FORM  
1/4" = 1'-0"

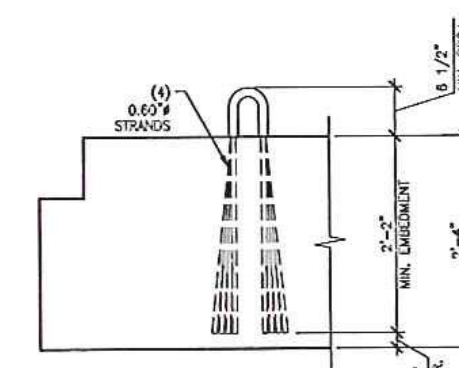

A LIFT LOOP DETAIL  
3/4" = 1'-0"

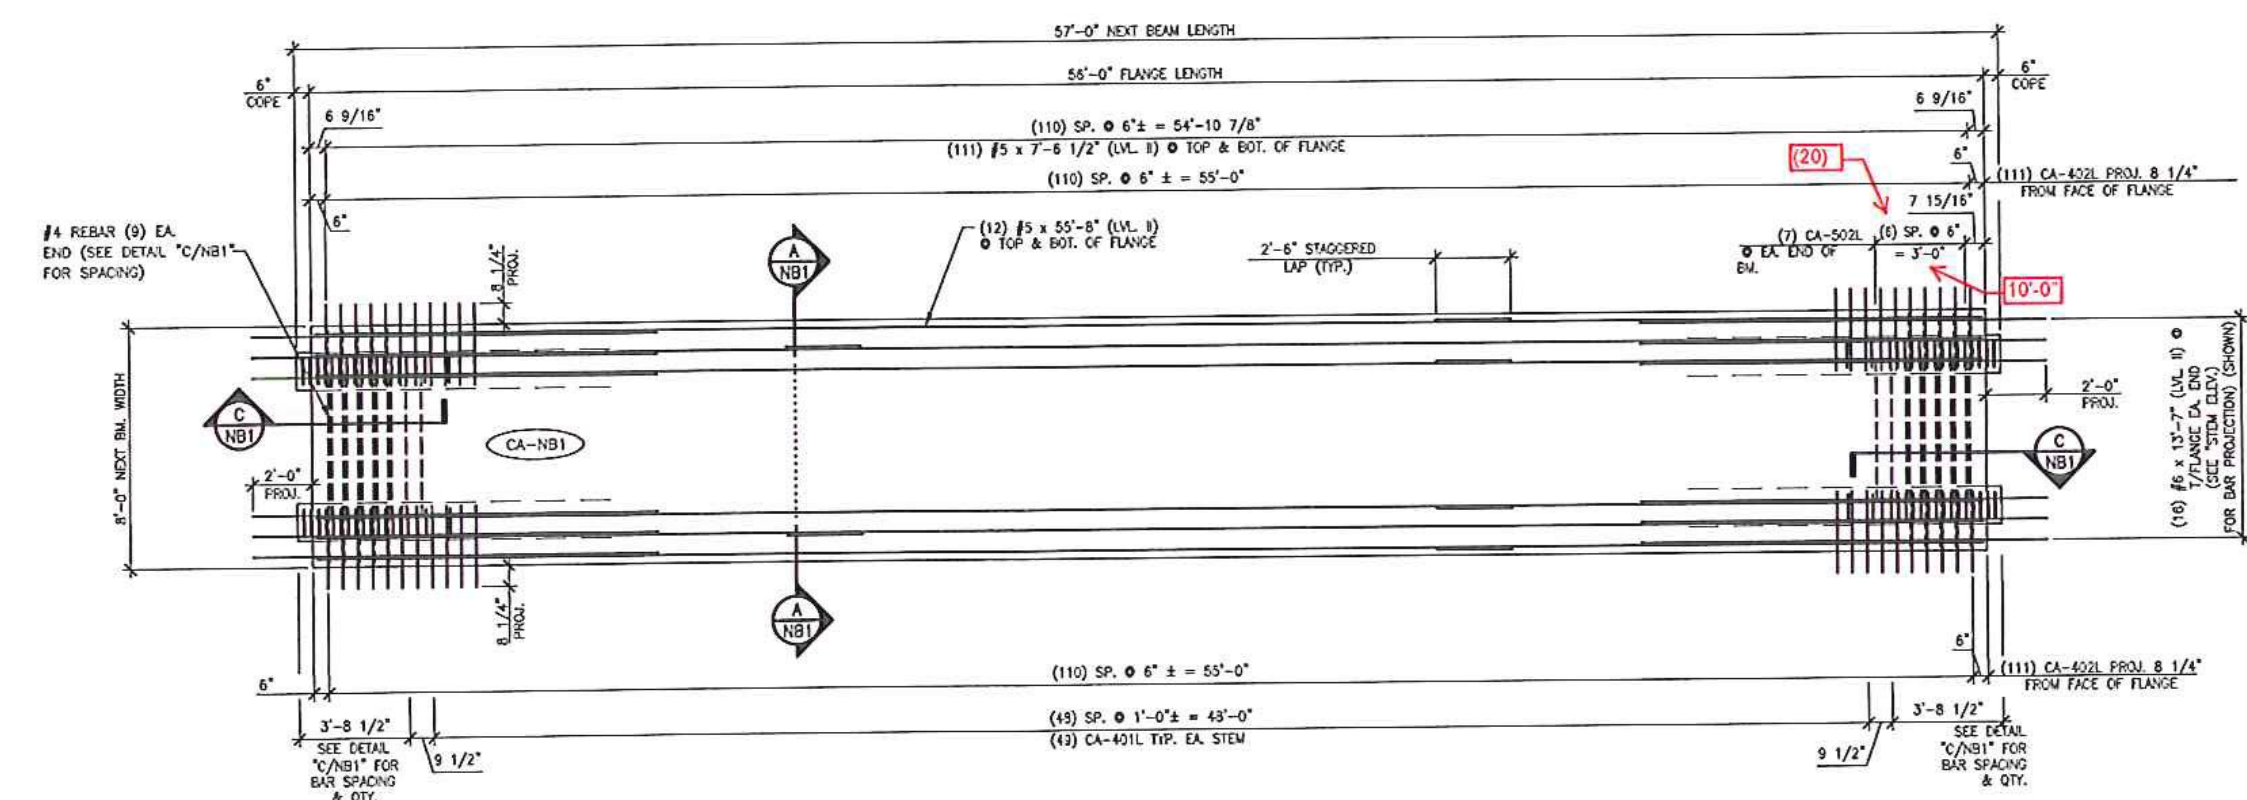

2 REINFORCING PLAN VIEW IN FORM  
1/4" = 1'-0"

MARK: CA-NB1 QTY: 1 WT: 38.61 VOL: 19.06

MATERIAL LIST / NEXT BEAM

ITEM	MARK	DESCRIPTION	QTY.
1	CA-40L	#4 BENT BAR (LEVEL 4, DUAL COATED)	168
2	CA-40L	#4 BENT BAR (LEVEL 4, DUAL COATED)	222
3	CA-40L	#4 BENT BAR (LEVEL 4, DUAL COATED)	16
4	CA-50L	#5 BENT BAR (LEVEL 4, DUAL COATED)	14
5	#4	#4 x 7'-6 1/2" (LEVEL 4, DUAL COATED)	18
6	#4	#4 x 7'-6 1/2" (LEVEL 4, DUAL COATED)	6
7	#5	#5 x 7'-6 1/2" (LEVEL 4, DUAL COATED)	224
8	#5	#5 x 55'-8" (#1) 2'-6" SHOULDER LAP (LEVEL 4, DUAL COATED)	24
9			
10			
11	#5	#5 x 12'-7" (LEVEL 4, DUAL COATED)	32
12			
13	#2 x 10	#2 x 10 PVC SLIDER	4
14	SET OF (4)	SET OF (4) 2x8x8 x 210 X18 STRAND LIFTING LOOPS	4
15			

05-7-15 REMOVED CROWN FROM NEXT BH.  
01-28-15 REVISED

Vermont Agency of Transportation  
**RECEIVED**

CK'D BY GL OK'D BY JS  
May 18, 2015  
RESUBMIT NO Approved AsNoted  
BY KH DATE 05/18/2015

Submitted  
5-15-15  
J.P. CARRARA & SONS, Inc.  
MIDDLEBURY, VT 05753


APPROVAL STAMP:

J.P. CARRARA & SONS, INC. BLOW & COTE, INC.  
Precast & Prestress Manufacturer CONTRACTOR  
444 ONE ST. WASHINGTON, VERMONT 05673 PH: 802-248-4341 FAX: 802-248-9210 MORRISVILLE, VERMONT

STATE OF VERMONT AGENCY OF TRANSPORTATION  
COUNTY OF LAMOILLE DATE: JUN. 28, 2015  
SCALE: NOTED


TOWN OF CAMBRIDGE  
IRISH SETTLEMENT ROAD T.H.46 CLASS 3  
BRIDGE NO.: 28 PROJECT NO.: BRO 1448(39) CHKD: RM DFTM: PSS  
JOB NO: 23447-014

PRESTRESSED NEXT BEAM DETAILS DWG. NO: NB2

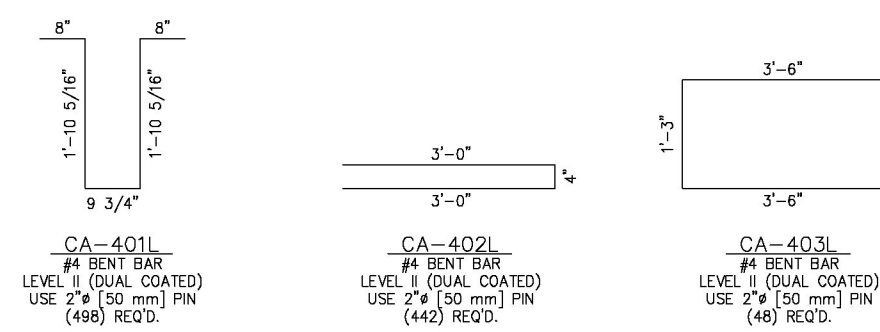

CA-401L  
#6 BENT BAR  
LEVEL II (DUAL COATED)  
USE 2# (50 mm) PIN  
(48) RECD

CA-403L  
#6 BENT BAR  
LEVEL II (DUAL COATED)  
USE 2# (50 mm) PIN  
(48) RECD

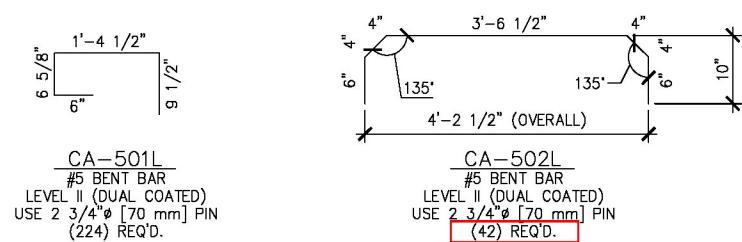


CA-501L  
#6 BENT BAR  
LEVEL II (DUAL COATED)  
USE 2 3/4# (70 mm) PIN  
(24) RECD

CA-502L  
#6 BENT BAR  
LEVEL II (DUAL COATED)  
USE 2 3/4# (70 mm) PIN  
(24) RECD

CHANGE ORDER QUANTITY:  
LENGTH = 50.5' + 10' + 10' = 70.5' = 5.875 FT / BAR  
WEIGHT PER BAR = 5.875 FT * 1.04 LB / FT = 6.11 LB  
# OF BARS = 2 ENDS * 3 BEAMS * 21 BARS @ EA END = 126 BARS  
TOTAL ADDITIONAL WEIGHT = 126 BARS * 6.11 LB / BAR = 769.86 LB = 770 LB

PRESTRESSED NEXT BEAMS

NEXT BEAM MISCELLANEOUS MATERIALS				
ITEM	MARK	QTY.	DESCRIPTION	REMARKS
1		54	#4 x 7'-6 1/2" (LEVEL I, DUAL COATED)	
2				
3		672	#5 x 7'-6 1/2" (LEVEL I, DUAL COATED)	
4		78	#5 x 55'-8" (W/ (1) 2'-8" STAGGERED LAP) (L.V. II, DUAL COATED)	
5				
6		96	#6 x 15'-7" (L.V. I, DUAL COATED)	
7				
8				
9				
10				
11				
12				
13				
14		14	GUARD RAIL ANCHOR PLATE (GALV)	SUPPLIED BY OTHERS. SEE DETAIL THIS SHEET
15		12	SET OF (4) 0.625" x 270 KIB STRAND LIFTING LOOPS	
16		12	2" I.D. PVC SLEEVE	
17				
18				
19				
20				

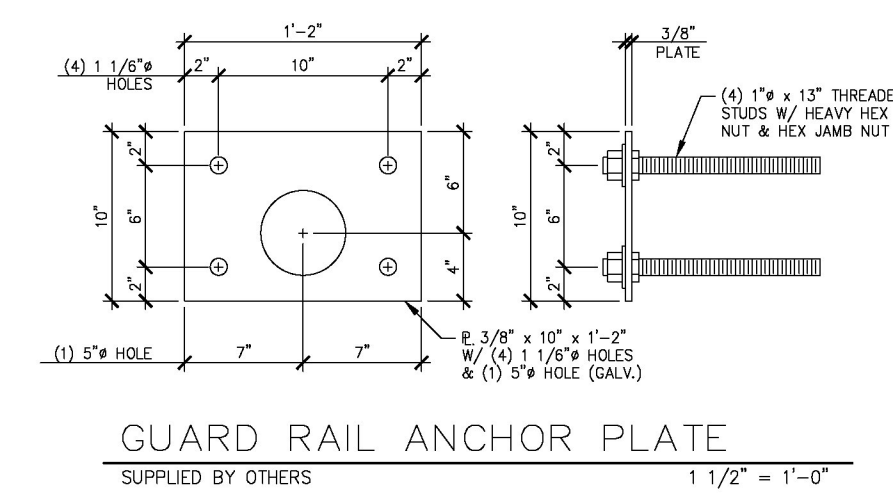

GUARD RAIL ANCHOR PLATE  
SUPPLIED BY OTHERS  
1 1/2" = 1'-0"

01-28-15 REVISED

APPROVAL STAMP:

Vermont Agency of Transportation  
**RECEIVED**  
CK'D BY GL OK'D BY JS  
January 29, 2015  
RESUBMIT NO Approved AsNoted  
BY KH DATE 2-3-2015

J.P. CARRARA & SONS INC.  
Precast & Prestress Manufacturer  
244 ONE ST. WOODBURY, VT 05255 Phone: (802)388-4361 Fax: (802)388-9010


BLOW & COTE, INC.  
CONTRACTOR  
MORRISVILLE, VERMONT

STATE OF VERMONT AGENCY OF TRANSPORTATION  
COUNTY OF LAMOILLE  
TOWN OF CAMBRIDGE  
IRISH SETTLEMENT ROAD T.H.46 CLASS 3  
BRIDGE NO.: 28 PROJECT NO.: BRO 1448(39)

DATE: JAN. 28, 2015  
SCALE: NOTED  
CHKD: RM DFTM: PSS  
JOB NO: 23447-014

MATERIALS LIST

DWG. NO: M1

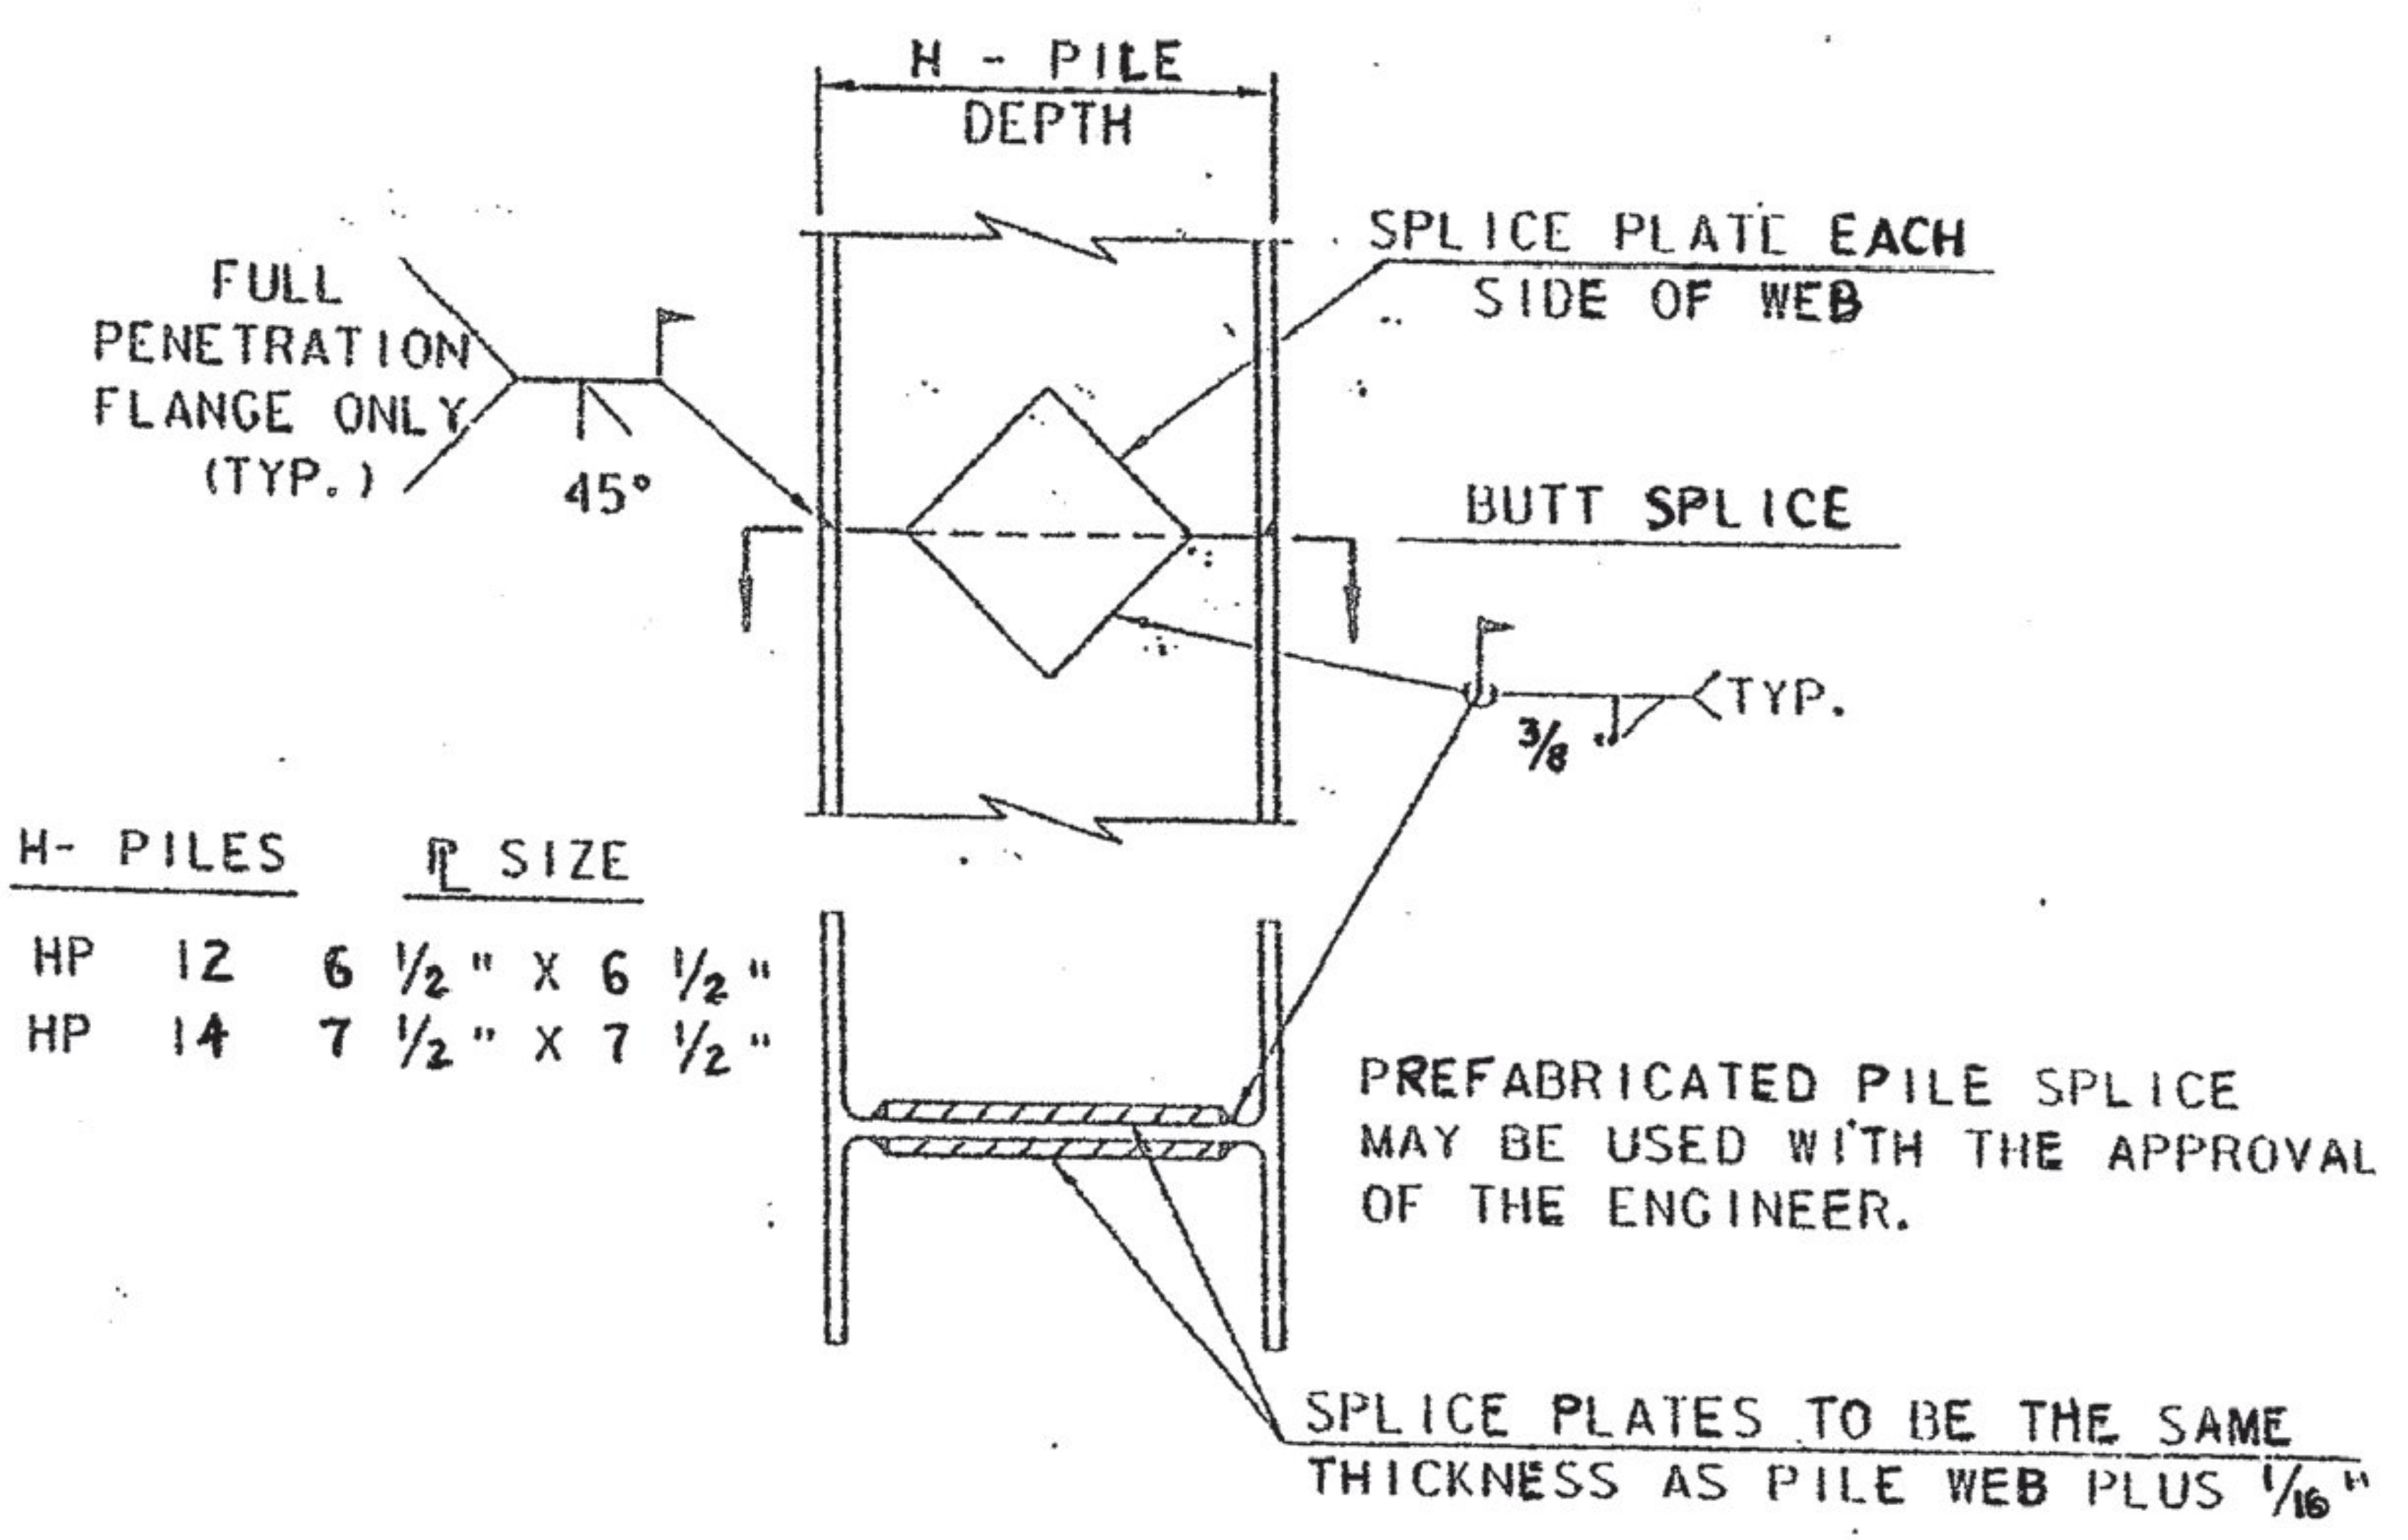

DETAIL OF PILE SPLICE

N.T.S.

CONTRACTOR:  
**BLOW & COTE, INC.**  
 815 VT Route 15 East  
 Morrisville, VT 05601

PROJECT:  
 CAMBRIDGE BRO 1448(39)

Vermont Agency of Transportation  
**RECEIVED**

CK'D BY _____ OK'D BY JC _____  
 February 19, 2015

RESUBMIT NO _____ Approved _____  
 BY KH _____ DATE 3-9-2015

SUBMITTED BY:  
 MARC COTE

**PREQUALIFIED JOINT WELDING PROCEDURE  
PROCEDURE SPECIFICATION**

Material specification Grade 50  
 Welding process SMAW  
 Manual or machine Manual  
 Position of welding all Positions  
 Filler metal specification A5.1  
 Filler metal classification E7018  
 Flux N/A  
 Weld metal grade* —  
 Shielding gas N/A Flow rate —  
 Single or multiple pass Multiple  
 Single or multiple arc Single  
 Welding current DC  
 Polarity Reverse  
 Welding progression Tack 1" 3 locations on flange then stringer head alternating flanges  
 Root treatment Grind and wire brush  
 Preheat and interpass temperature Per AWS D1.5  
 Postheat treatment none

*Applicable only when filler metal has no AWS classification.

**WELDING PROCEDURE**

Pass no.	Electrode size	Welding current		Travel speed	Joint detail
		Amperes	Volts		
A11	5/32	180	30	4"/min	Pile Point welding Detail (see attached)

Vermont Agency of Transportation

**RECEIVED**

CK'D BY _____ OK'D BY JC

February 19, 2015

RESUBMIT NO **Approved**  
 BY KH DATE 3-9-2015

CONTRACTOR:  
 BLOW & COTE, INC.  
 815 VT RTE 15E  
 MORRISVILLE, VT 05661  
 PROJECT: LAMBRIDGE  
BRD 1448 (39)

**RECEIVED**

CK'D BY _____ OK'D BY JC

February 19, 2015


RESUBMIT NO Approved  
BY KH DATE 3-9-2015

815 VT RTE 15E  
MORRISVILLE, VT 05661

PROJECT: CAMBRIDGE  
BRD 1448 (39)

# HARD-BITE POINT


HP 77600-B, HP 77600-B-18#  
HP 77600-B-30#, HP 77600-B-46#

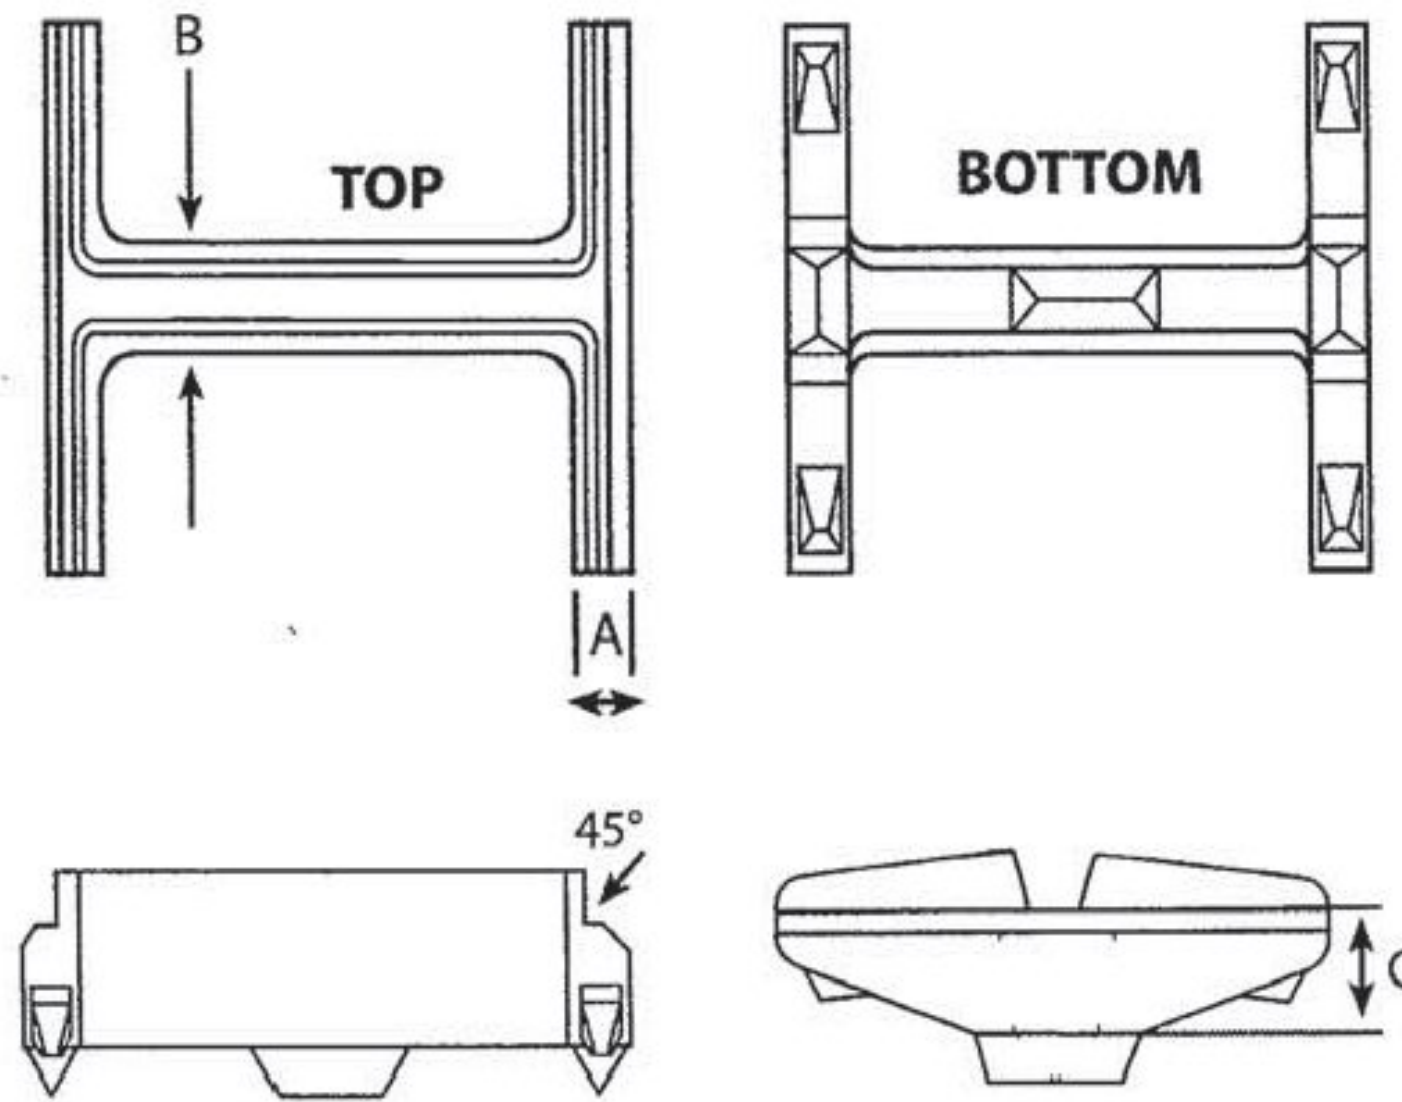

	A	B	C
<b>14" HP</b>			
77600-B	1"	1-1/4"	2-3/4"
77600-B-46#	1-1/2"	1-3/4"	3"
77750-B	1"	1"	4"
<b>12" HP</b>			
77600-B-30#	1"	1-5/16"	3"
77750-B	3/4"	3/4"	3-1/2"
7780-B	3/4"	3/4"	3"
<b>10" HP</b>			
77600-B	1"	1"	2-1/16"
77600-B-18#	1"	1-1/8"	2-3/8"
77750-B	3/4"	3/4"	3"
<b>8" HP</b>			
77600-B	1-1/16"	1"	1-7/16"

## Installation Instructions

- 1.) Fit point onto the end of a square cut pile end.
- 2.) Weld point to the pile in either flat or vertical position using E70XX electrodes.
- 3.) Weld across full width of flange following chart below for minimum size weld.

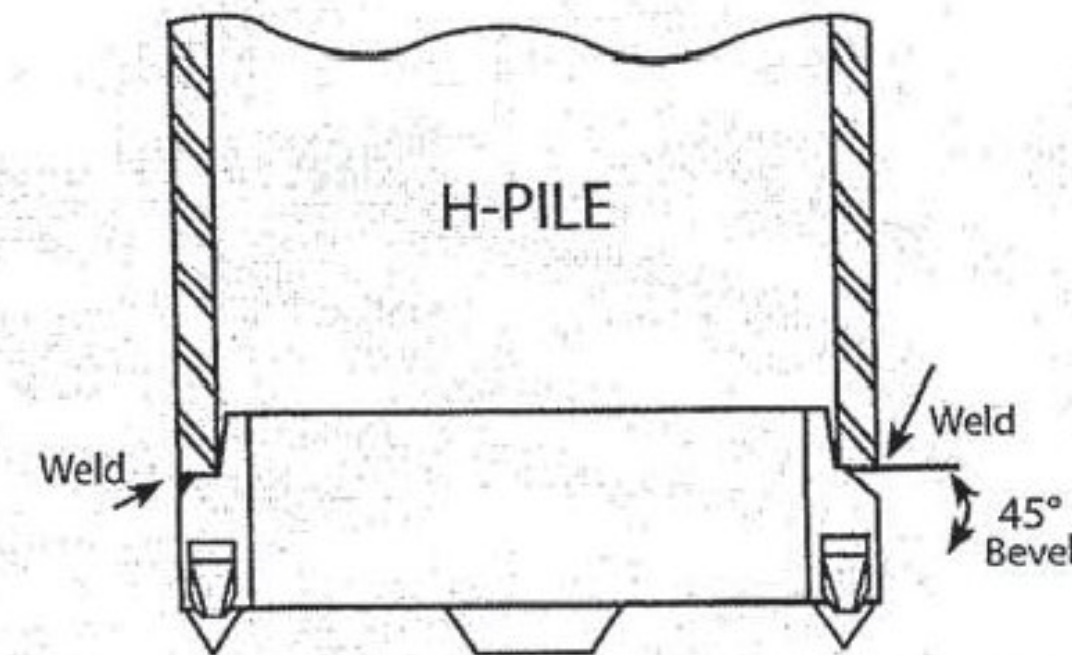

H-PILE SIZE	FLANGE THICKNESS	MINIMUM SIZE GROOVE WELD
HP 14		
x 117	.805	7/16
x 102	.705	3/8
x 89	.615	3/8
x 73	.505	5/16
HP 12		
x 84	.685	3/8
x 74	.610	3/8

H-PILE SIZE	FLANGE THICKNESS	MINIMUM SIZE GROOVE WELD
HP 12		
x 63	.515	5/16
x 53	.435	5/16
HP 10		
x 57	.565	5/16
x 42	.420	5/16
HP 8		
x 36	.445	5/16

**WELDER, WELDING OPERATOR OR TRACK WELDER QUALIFICATION TEST RECORD**

Type of Welder		Identification No.:	AT-001
Name: Adam Thomann		Date:	12/31/2009
Welding Procedure Specification No. AT-001B		Record Actual Values Used in Qualifications	Qualification Range
Variables		SMAW	
Process/Type		Single	
Electrode (single or multiple)		DCEP	
Current/Polarity		3G	Flat/Horizontal/Vertical
Position		Uphill	uphill all passes
Weld Progression		Yes	
Backing (YES or NO)		A36	
Material/Spec.		1"	1/8" - unlimited
Base Material			unlimited
Thickness (Plate)			
Groove			
Fillet			
Thickness: (Pipe/Tube)			
Groove			
Fillet			
Diameter: (Pipe)			
Groove			
Fillet			
Filler Metal		E7018	
Spec. No.		AWS A5.1 / A5.5	AWS A5.1 / A5.5
Class		E7018	E70XX
F-No.		F-4	F-4
Gas/Flux Type			
Other		5/32" Lincoln Rod	

Visual Inspection Acceptable YES or NO  
Guided Bend Test Results

Type	Results	Type	Results
Face		Face	
Root		Root	
Side	Accept	Side	Accept

Fillet Test Results

Appearance	Fillet Size
Fracture Test/Root Penetration	Macro etch
(Describe the location, nature and size of any crack or tearing of specimen.)	

Vermont Agency of Transportation  
**RECEIVED**  
CK'D BY _____ OK'D BY JC  
February 19, 2015  
RESUBMIT NO Approved  
BY KH DATE 3-9-2015

Inspected by: Ed Loprete	Test No.: TA12312009
Organization: VT Nondestructive Testing	Date: 12/31/2009


Radiographic Results

Film Identification Number	Results	Remarks	Film Identification Number	Results	Remarks

Interpreted by:	Test Number:
Organization:	Date:

We, the undersigned, certify that the statements in this record are correct and that the test welds were prepared, welded and tested in accordance with the requirements of Section 5 of AWS D1.5, 2008 Bridge Welding Code

Inspected by: <u>Richard F. Irick</u>	Witnessed by: Ed Loprete
Certification Property of: Adam Thomann	Date: 12/31/2009

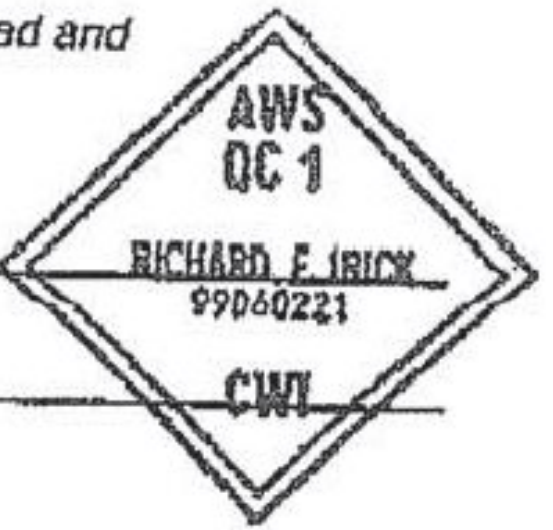

Work Log for Adam Thomann dba Spectrum Welding  
Certified 12/31/2009  
Updated 1/24/2015

Feb 2010

Kubricky Construction  
Bridge Welding requiring certification. SMAW

June – August 2010

St Onge Construction  
Leroy Farr Bridge – Pile Splices. SMAW

August – September 2010

Dartmouth Medical Center - NH moment connections  
CCS – White River Train Bridge

January – December 2011

Kubricky Construction  
2 bridges in Ludlow Vermont requiring welding certification. SMAW, FCAW

January – December 2012 & 2013

Cote Steel Erectors  
Colchester Steel Building requiring welding certification.

November – December 2013, April – May 2014

Blow & Cote, Inc.  
Bristol BRO 1445(32) – Pile Splices. SMAW

August – 2014

The Belden Co.  
Rutland BRF 3000(18) – Pile Splices. SMAW,

November – 2014

ECI Engineers Construction  
Ryegate CULV(10) Pile Splices. SMAW

January 9 – 24 2015

PC Construction Co.  
Middlebury Field House – Handrails, Stairs, Structural welding steel beams. SMAW


Vermont Agency of Transportation

**RECEIVED**

CK'D BY _____ OK'D BY JC _____

February 19, 2015




RESUBMIT NO **Approved**  
BY KH _____ DATE 3-9-2015 _____

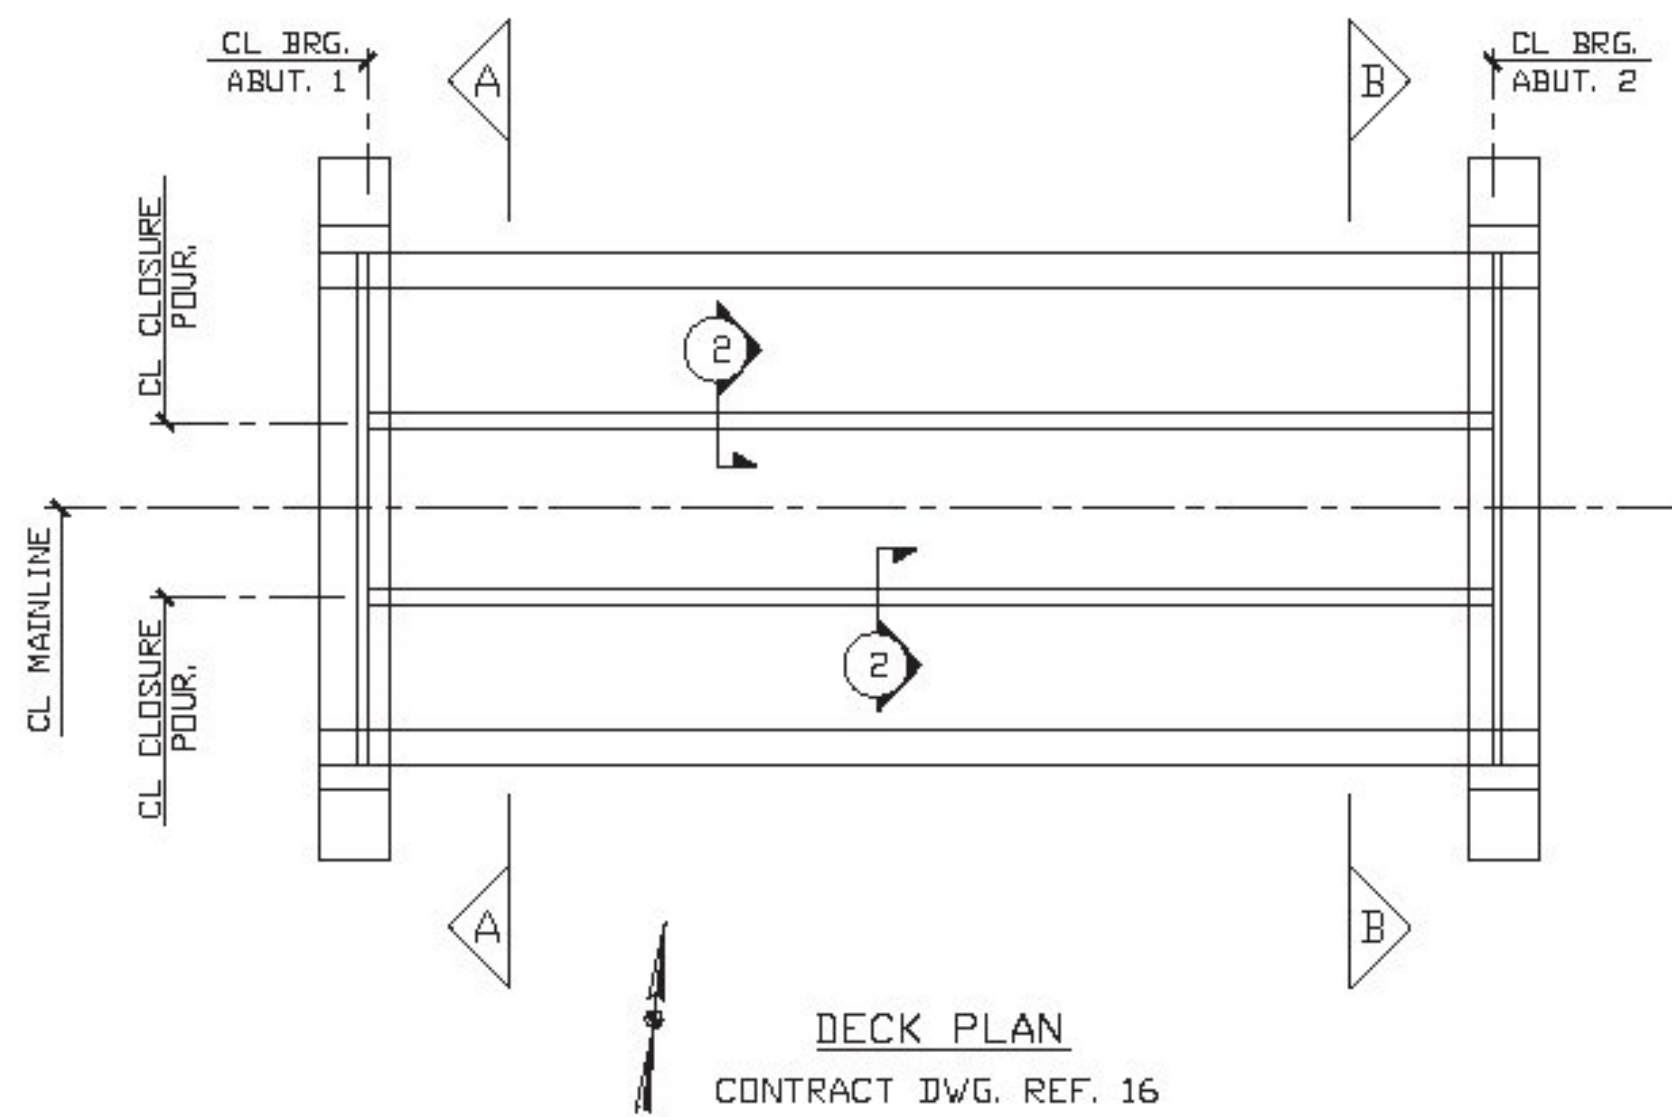


DECK PLAN  
CONTRACT DWG. REF. 16

Release Number: _____

BAR LIST				△												
Bar Mark	Qty	Size	Total Length	Type	'A'	'B'	'C'	'D'	'E'	'F'	'G'	'H'	'J'	'K'	'O'	'R'
5C201	54	#5	6'-2"	T2		1'-7"	3'-0"	1'-7"								
5C202	16	#5	3'-3"	T2		0'-9 1/2"	1'-4 1/2"	0'-7"	0'-6"							
6C201	104	#6	4'-0"	T2		2'-0"	2'-0"									

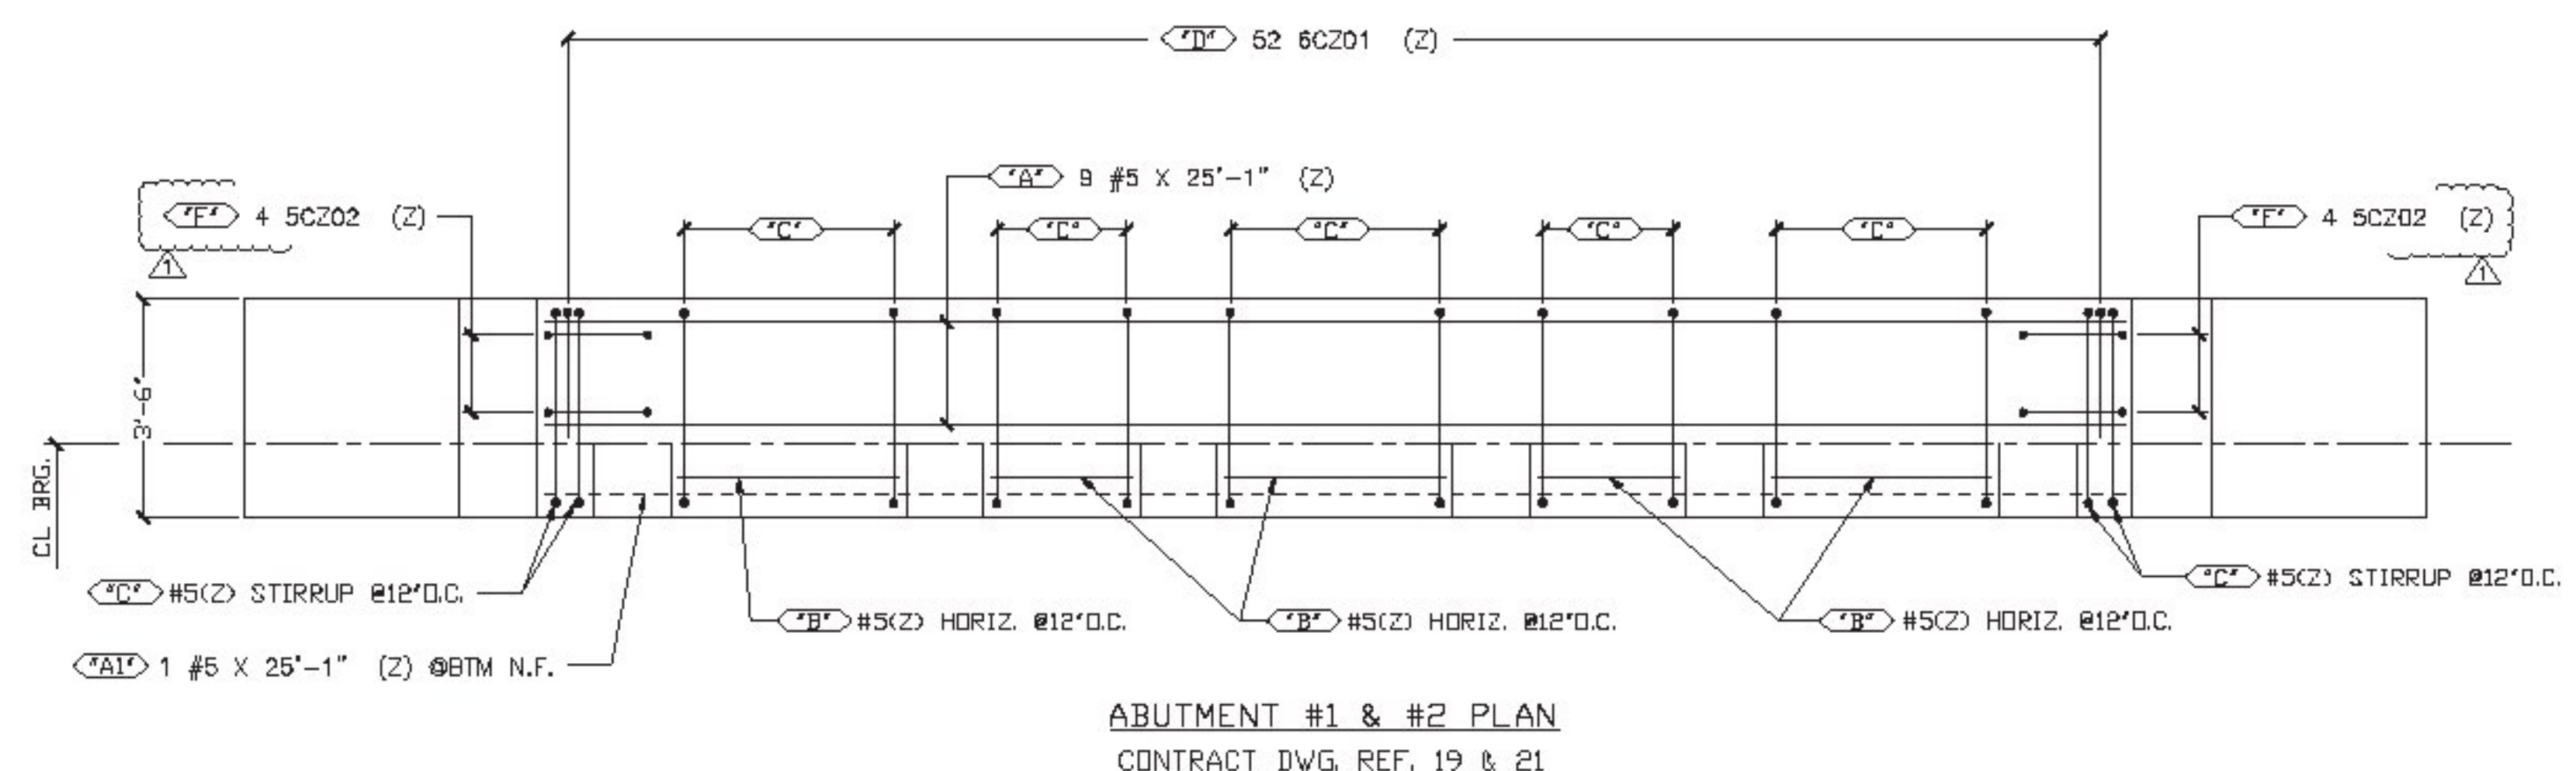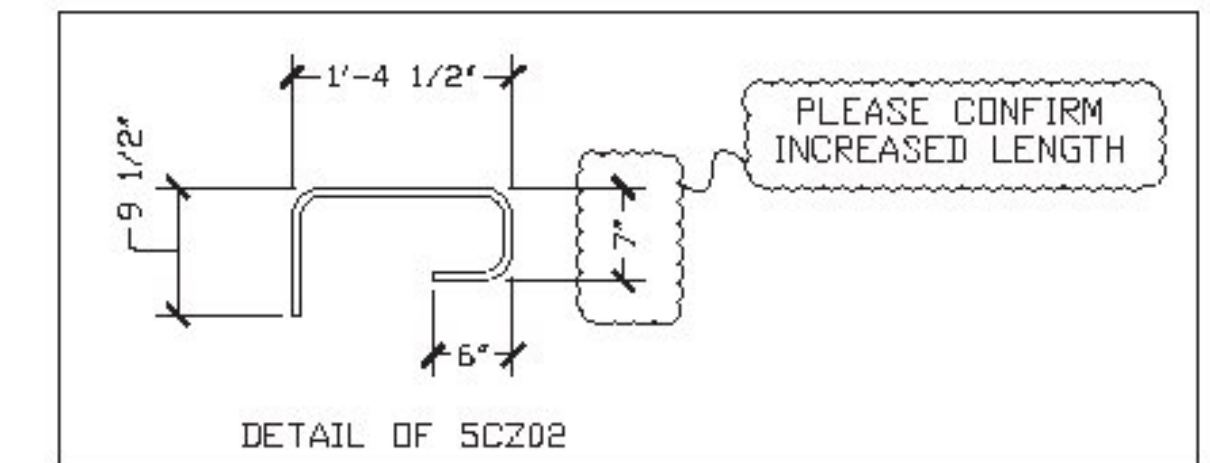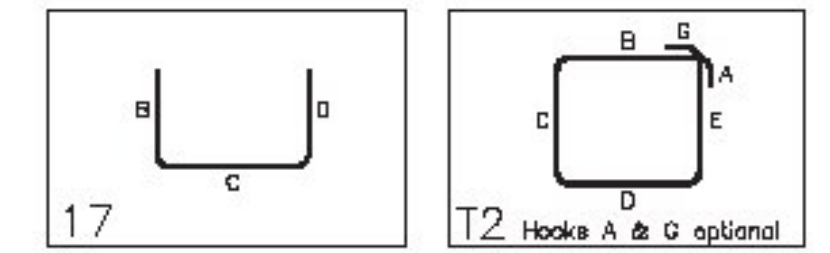

ABUTMENT #1 & #2 PLAN  
CONTRACT DWG. REF. 19 & 21

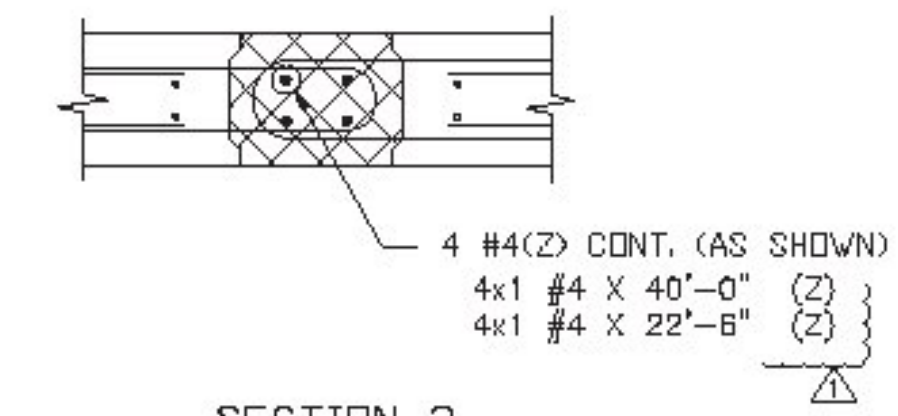

SECTION 2  
(2 THUS)  
CONTRACT DWG. REF. 17

△ BAR MARKS MAY CHANGE, DUE TO REVISIONS

**LEGEND:**  
 CONT.-CONTINUOUS  
 TRANS.-TRANSVERSE  
 DWLS.-DOWELS  
 VERTS.-VERTICAL  
 HORIZ.-HORIZONTAL  
 T&B -TOP & BOTTOM  
 I.F.-INNER FACE  
 O.F.-OUTER FACE  
 E.E.-EACH END  
 E.F.-EACH FACE  
 N.F.-NEAR FACE  
 F.F.-FAR FACE  
 E.W.-EACH WAY  
 O.C.-ON CENTER  
 L.W.-LONG WAY  
 S.W.-SHORT WAY

**FOR APPROVAL**

LAP CHART	
#4	2'-2" (U.N.)
#5	2'-7" (U.N.)
#6	3'-5" (U.N.)


**ALL REINF. BARS  
LEVEL II - DUAL COATED**

ELEVATIONS & DIMENSIONS SHOWN ON THIS DWG. ARE FOR REINF. DETAILING PURPOSES ONLY AND ARE NOT INTENDED FOR DIMENSIONAL CONSTRUCTION.


DUAL COATED REINF. BARS ASTM A615 GRADE 60, MARKED (Z)

VERIFICATION OF UNCLEAR INFORMATION MAY BE REQUESTED ON THIS DRAWING. SHOULD VERIFICATION BE LEFT UN-ADDRESSED IT WILL REMAIN AS SHOWN AND ASSUME TO BE CORRECT.

6			
5			
4			
3			
2	2/27/15	△	REVISED PER APPROVAL
1	1/23/15	-	FOR APPROVAL
DATE	REV.#	SENT FOR	
STRUCTURE	VT/ACT CAMBRIDGE BRO 144B(39)		
LOCATION	CAMBRIDGE, VERMONT		
DESIGNED BY			
OWNER	BLOW & COTE, INC.		
DRAWN BY	DATE	APP.#	
KRIS J	1/23/15	9127	
CHECKED BY	DATE	APPROVED	
CLOSURE POURS			C

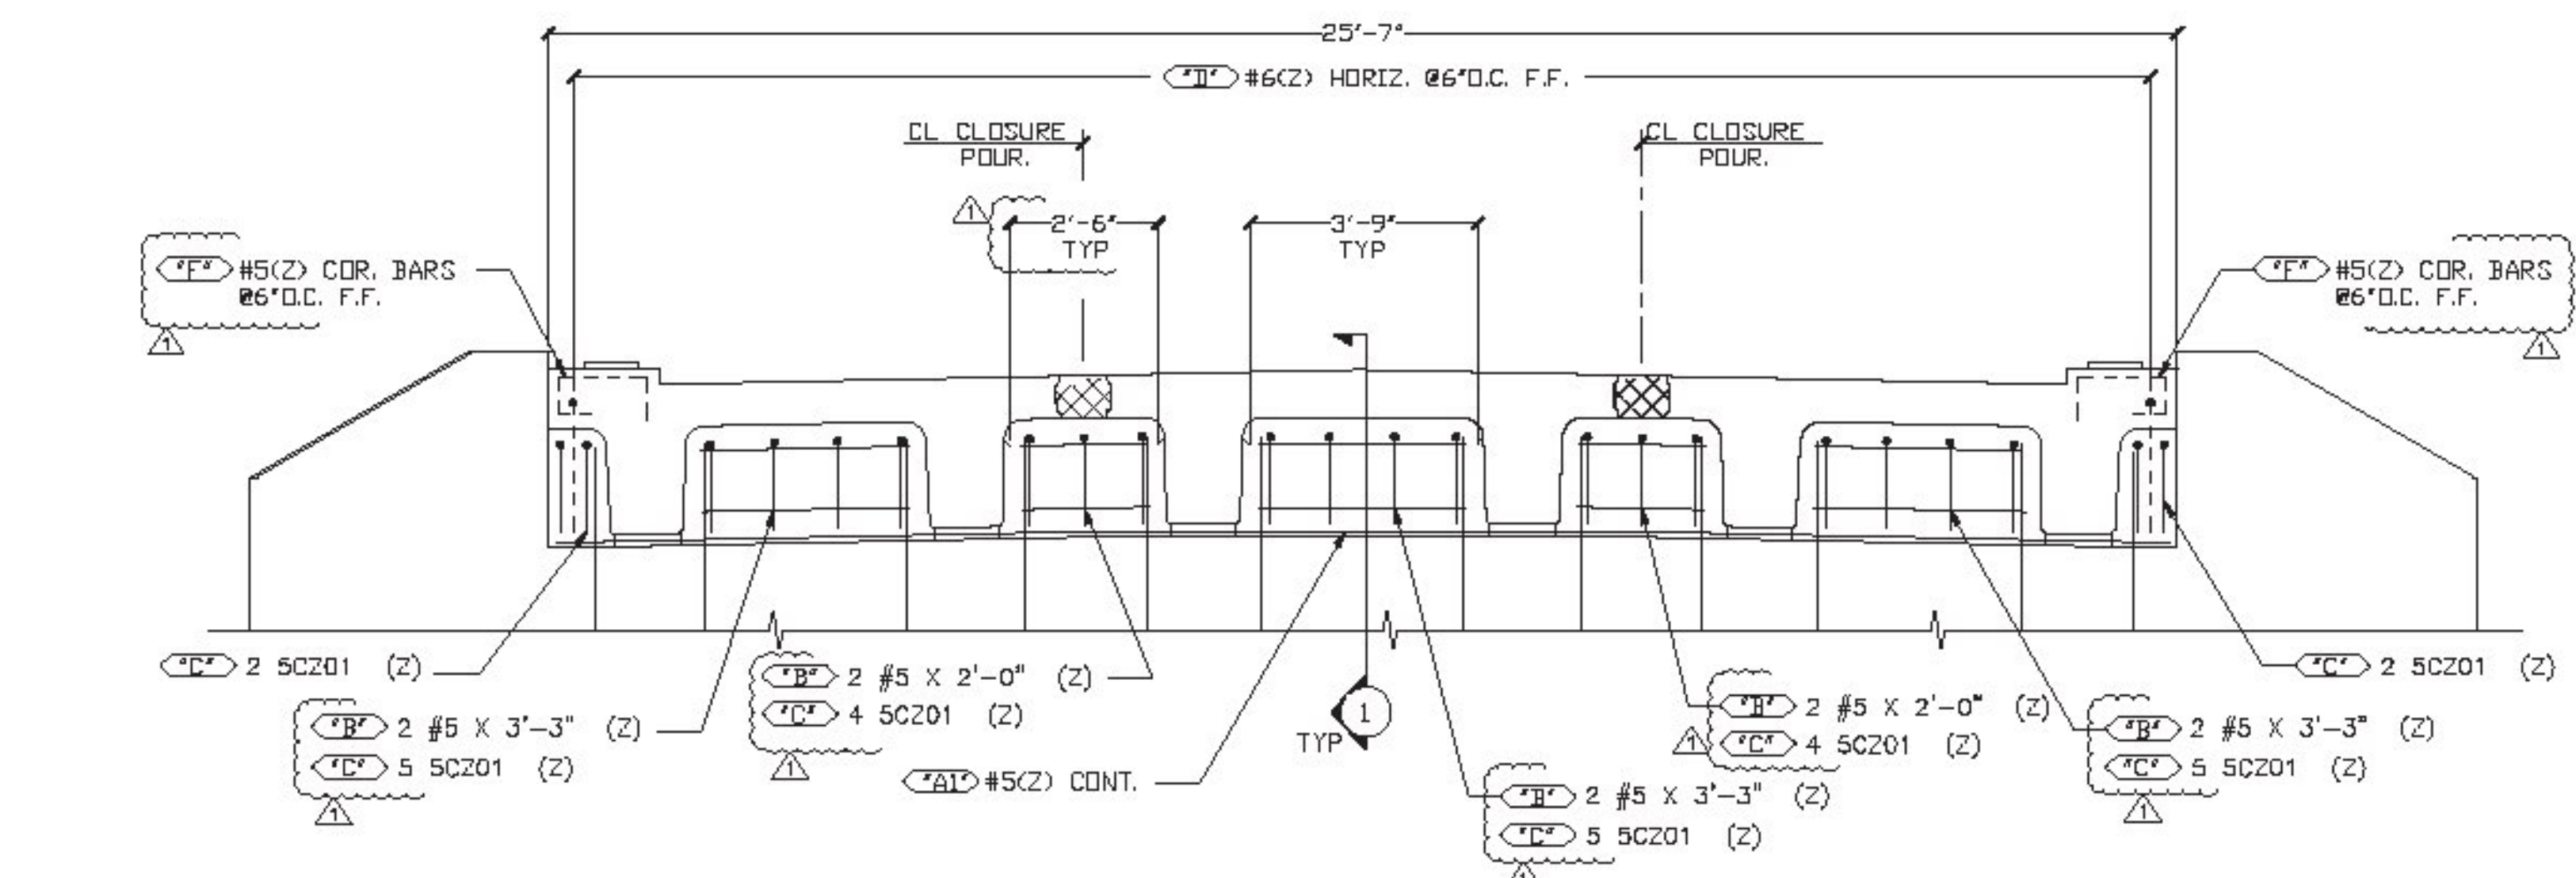

ABUTMENT #1 - ELEVATION A-A  
 ABUTMENT #2 - ELEVATION B-B  
 (PILE CAVITIES NOT SHOWN FOR CLARITY)  
 CONTRACT DWG. REF. 19 & 21

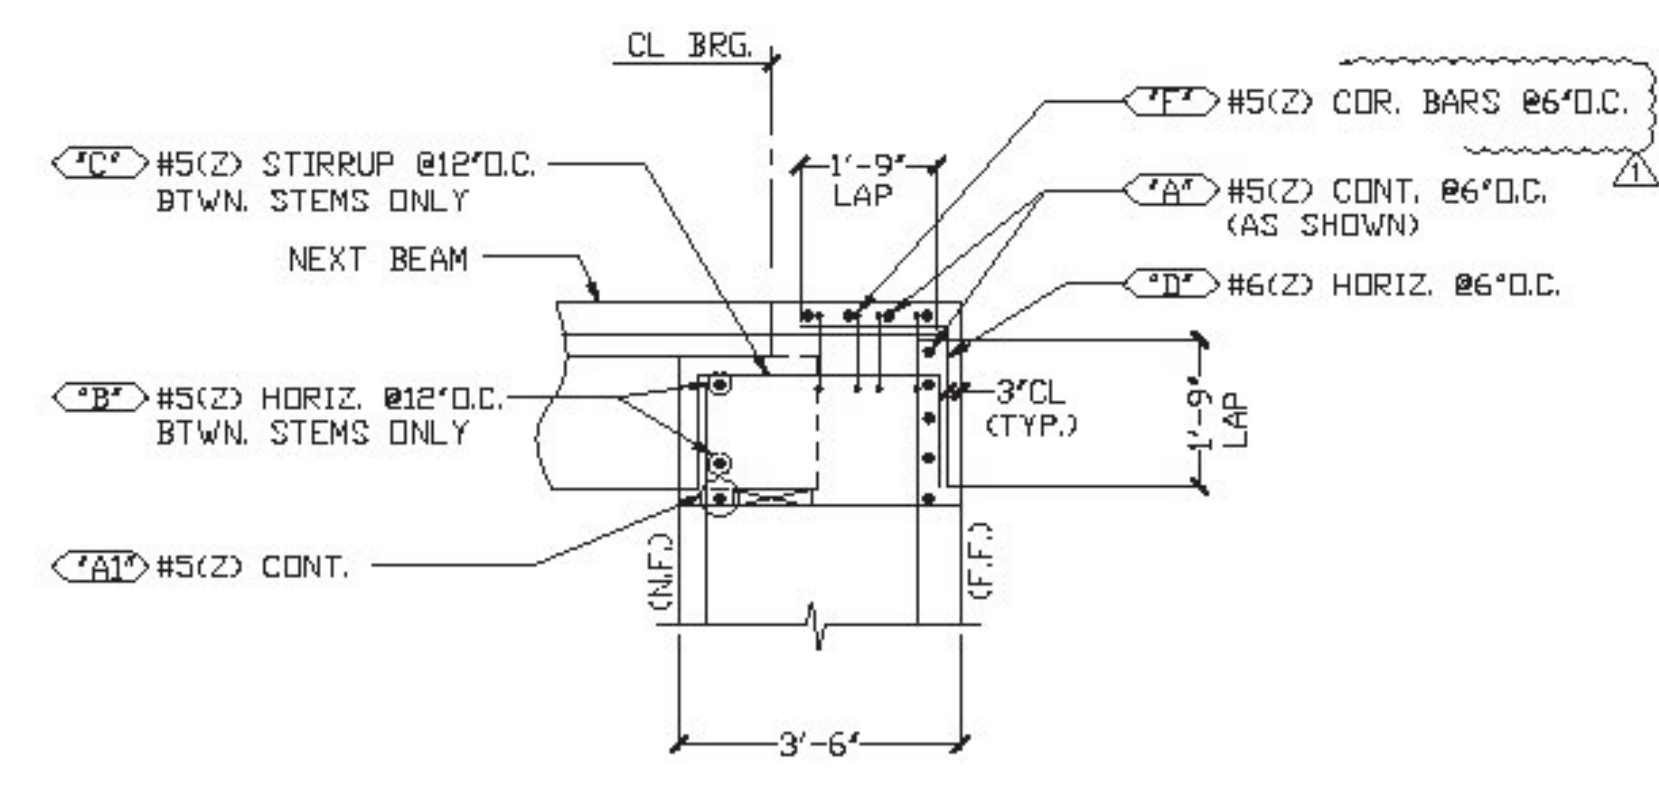

SECTION 1  
CONTRACT DWG. REF. 19 & 21

Vermont Agency of Transportation  
**RECEIVED**  
 CK'D BY JS OK'D BY GL  
 February 27, 2015  
 RESUBMIT NO Approved  
 BY KH DATE 3-2-2015