


TYPICAL ABUTMENT PLAN

SCALE: 1/4"=1'-0"

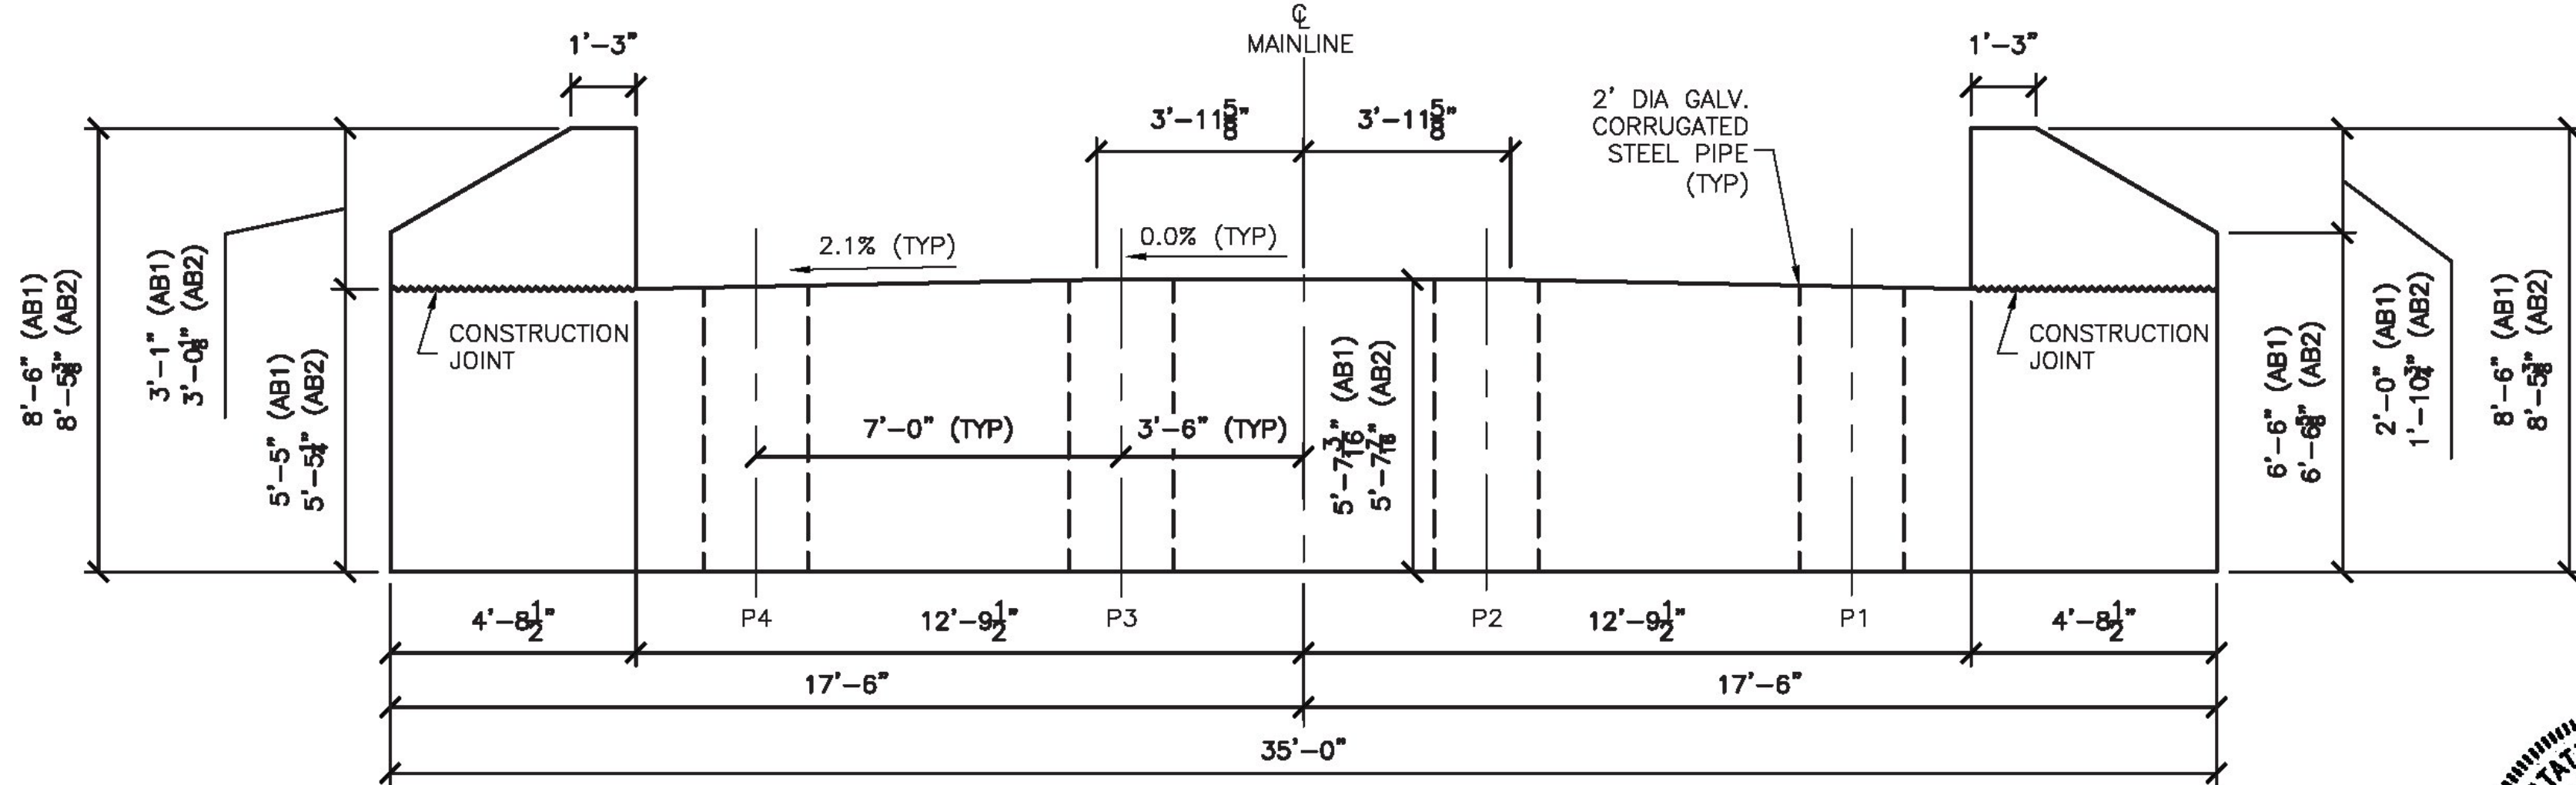

TYPICAL ABUTMENT ELEVATION

SCALE: 1/4"=1'-0"


Vermont Agency of Transportation

RECEIVED

CK'D BY GL OK'D BY JS

June 19, 2015

RESUBMIT NO Approved  
BY RY DATE 6-23-2015

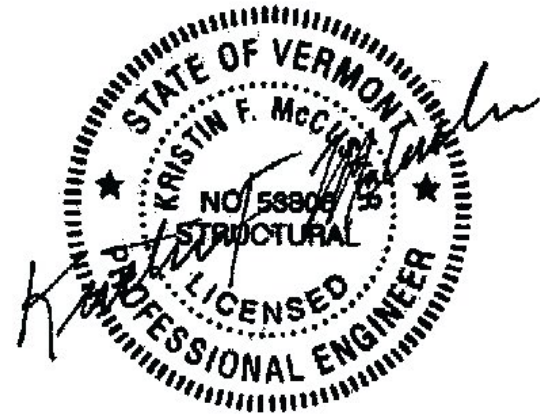

1

PREPARED BY: KFM  
CHECKED BY: TRF  
DATE: 05/20/15

CAMBRIDGE BRO 1448(39)  
Abutments #1 and #2  
Cambridge, VT

T. R. FELLOWS  
NH  
VT ENGINEERING  
CIVIL - STRUCTURAL  
134 COUNTY ROAD  
PO BOX 56  
ROCHESTER, VT 07676  
P.O. BOX 428 03608  
TEL/FAX: 803.758.4811  
trf@myelipoint.net  
trf@myelipoint.net