


TYPICAL FORM SECTION

1/2" = 1'-0"

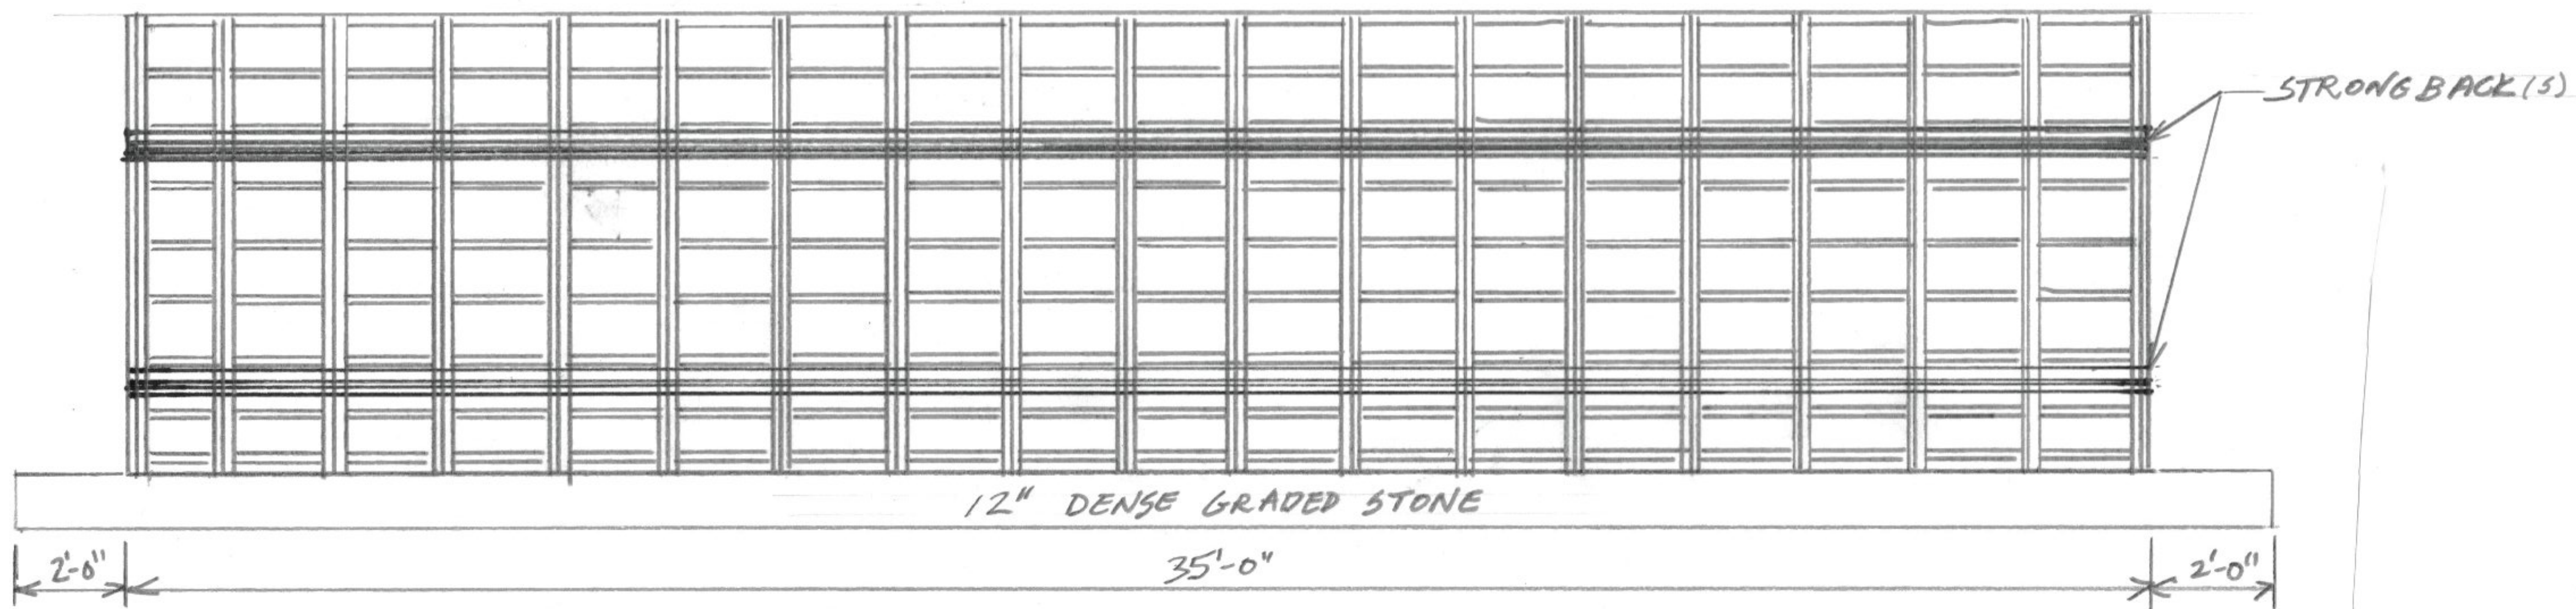

TYPICAL FORM ELEVATION

1/4" = 1'-0"

Vermont Agency of Transportation


RECEIVED

CK'D BY GL OK'D BY JS

June 19, 2015

RESUBMIT NO Approved

BY RY DATE 6-23-2015

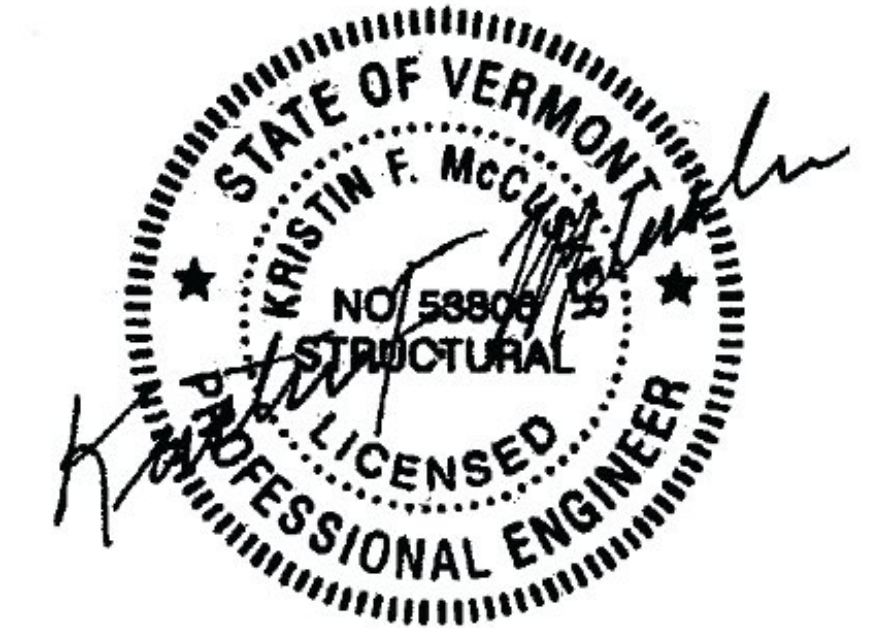

BLOW & COTE, INC.	
CAMBRIDGE BRO 1448(39)	
PRECAST FORM DETAILS	
SCALE: AS SHOWN	Page 8 of 38
	2 FEB 15