


STATE OF VERMONT AGENCY OF TRANSPORTATION



PROPOSED IMPROVEMENT BRIDGE PROJECT TOWN OF ENOSBURG COUNTY OF FRANKLIN BOSTON POST ROAD T.H.2 CLASS 2 BRIDGE NO: 48

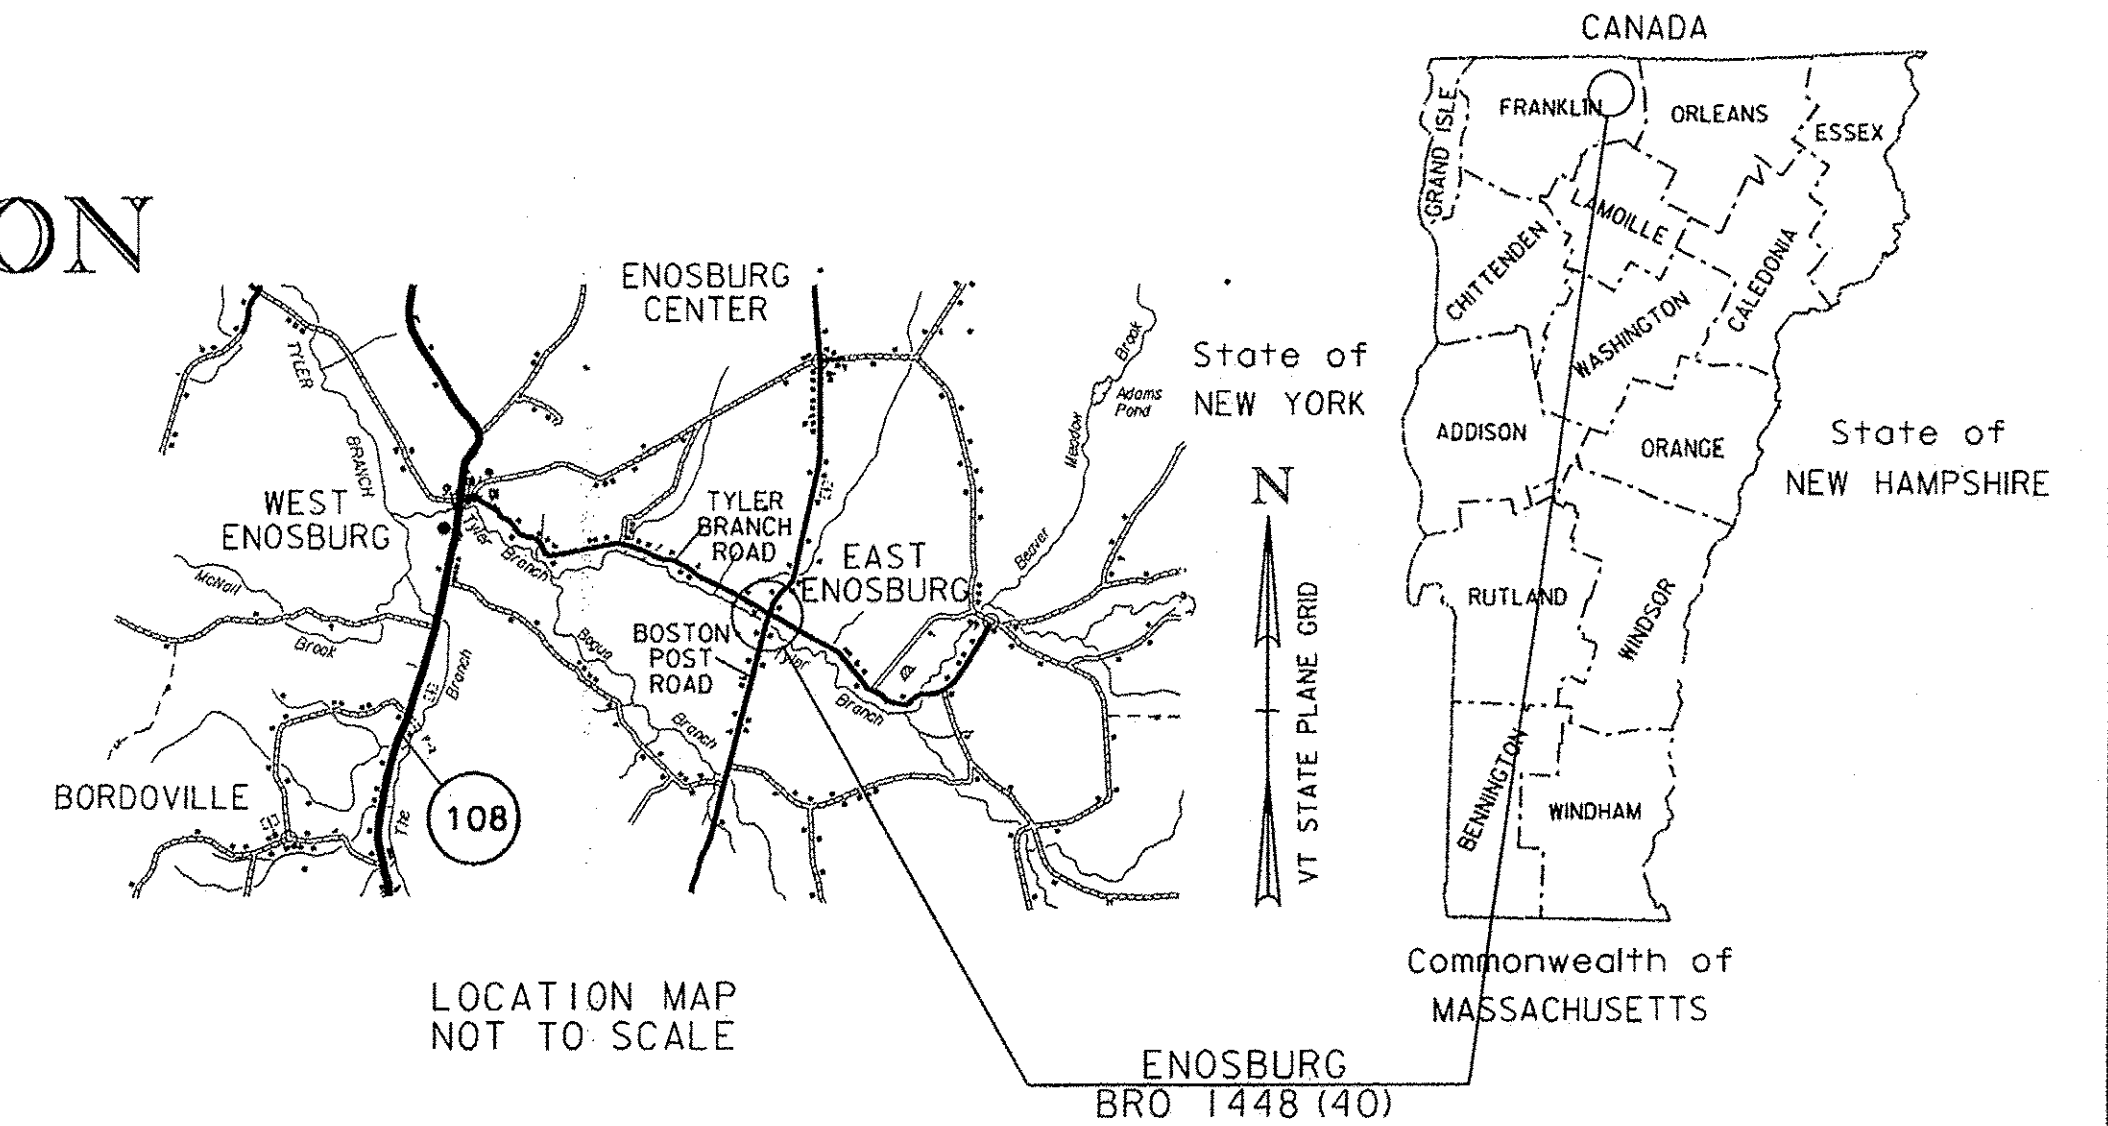


RECORD PLANS	
CONTRACTOR:	A.L. ST. ONGE CONTRACTOR, INC. - MONTGOMERY, VT
RESIDENT ENGINEER:	SCOTT WHEATLEY
CONSTRUCTION BEGAN:	JUNE 12, 2014
CONSTRUCTION COMPLETE:	SEPTEMBER 24, 2014
RECORD PLANS BY:	SCOTT WHEATLEY & JENNA HYDE
I HEREBY CERTIFY THAT ALL THE CONSTRUCTION REQUIRED BY THIS SET OF DRAWINGS HAS BEEN ACCOMPLISHED AS INDICATED HEREIN.	
BY:	<i>Scott Wheatley</i> RESIDENT ENGINEER
DATE:	1-6-2016
NOTE: Any further information concerning final quantities, amounts or other details relative to this project may be found at Central Files in the electronic archives.	


PROJECT LOCATION : ON BOSTON POST ROAD (CLASS II TOWN HIGHWAY (TH #2), LOCAL ROAD) APPROXIMATELY 100' SOUTH OF THE INTERSECTION WITH TYLER BRANCH ROAD (TH #1)

PROJECT DESCRIPTION : THE PROJECT SHALL CONSIST OF THE REPLACEMENT OF THE EXISTING BRIDGE ALONG WITH RELATED CHANNEL AND APPROACH WORK.

LENGTH OF STRUCTURE : 73.50 FEET
LENGTH OF ROADWAY : 62.50 FEET
LENGTH OF PROJECT : 136.00 FEET

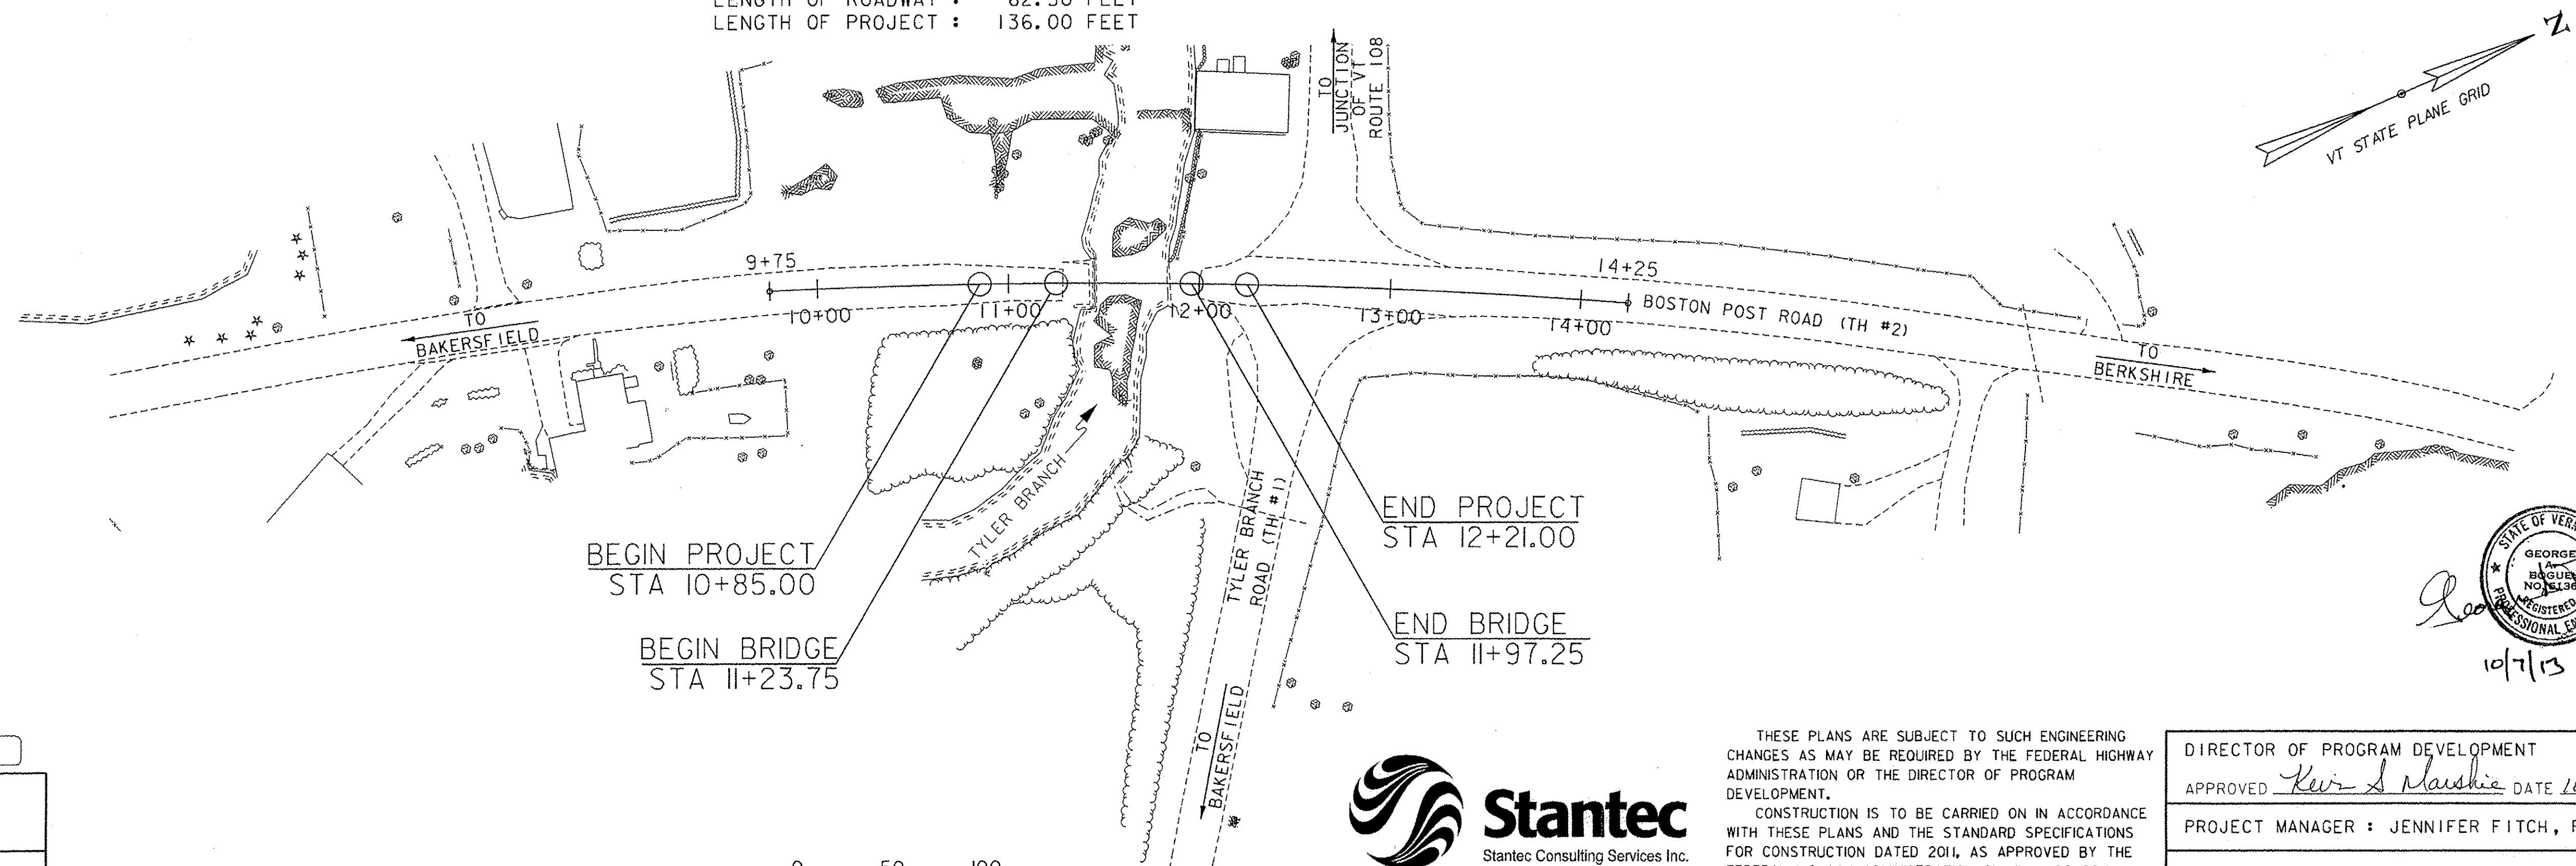

QUALITY ASSURANCE PROGRAM: LEVEL 2	
SURVEYED BY :	VTrans
SURVEYED DATE :	04/12/2012
DATUM	
VERTICAL	NAVD 88
HORIZONTAL	NAD 1983 (2007)

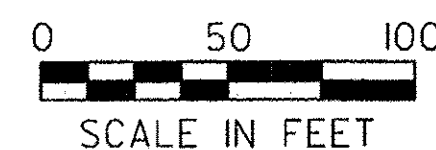

THESE PLANS ARE SUBJECT TO SUCH ENGINEERING CHANGES AS MAY BE REQUIRED BY THE FEDERAL HIGHWAY ADMINISTRATION OR THE DIRECTOR OF PROGRAM DEVELOPMENT.

CONSTRUCTION IS TO BE CARRIED ON IN ACCORDANCE WITH THESE PLANS AND THE STANDARD SPECIFICATIONS FOR CONSTRUCTION DATED 2011, AS APPROVED BY THE FEDERAL HIGHWAY ADMINISTRATION ON JULY 20, 2011 FOR USE ON THIS PROJECT, INCLUDING ALL SUBSEQUENT REVISIONS AND SUCH REVISED SPECIFICATIONS AND SPECIAL PROVISIONS AS ARE INCORPORATED IN THESE PLANS.

DIRECTOR OF PROGRAM DEVELOPMENT	
APPROVED:	<i>Kevin S. Marshie</i> DATE 10/8/13
PROJECT MANAGER : JENNIFER FITCH, PE	
PROJECT NAME : ENOSBURG	
PROJECT NUMBER : BRO 1448 (40)	
SHEET 1 OF 46 SHEETS	

