



10+25

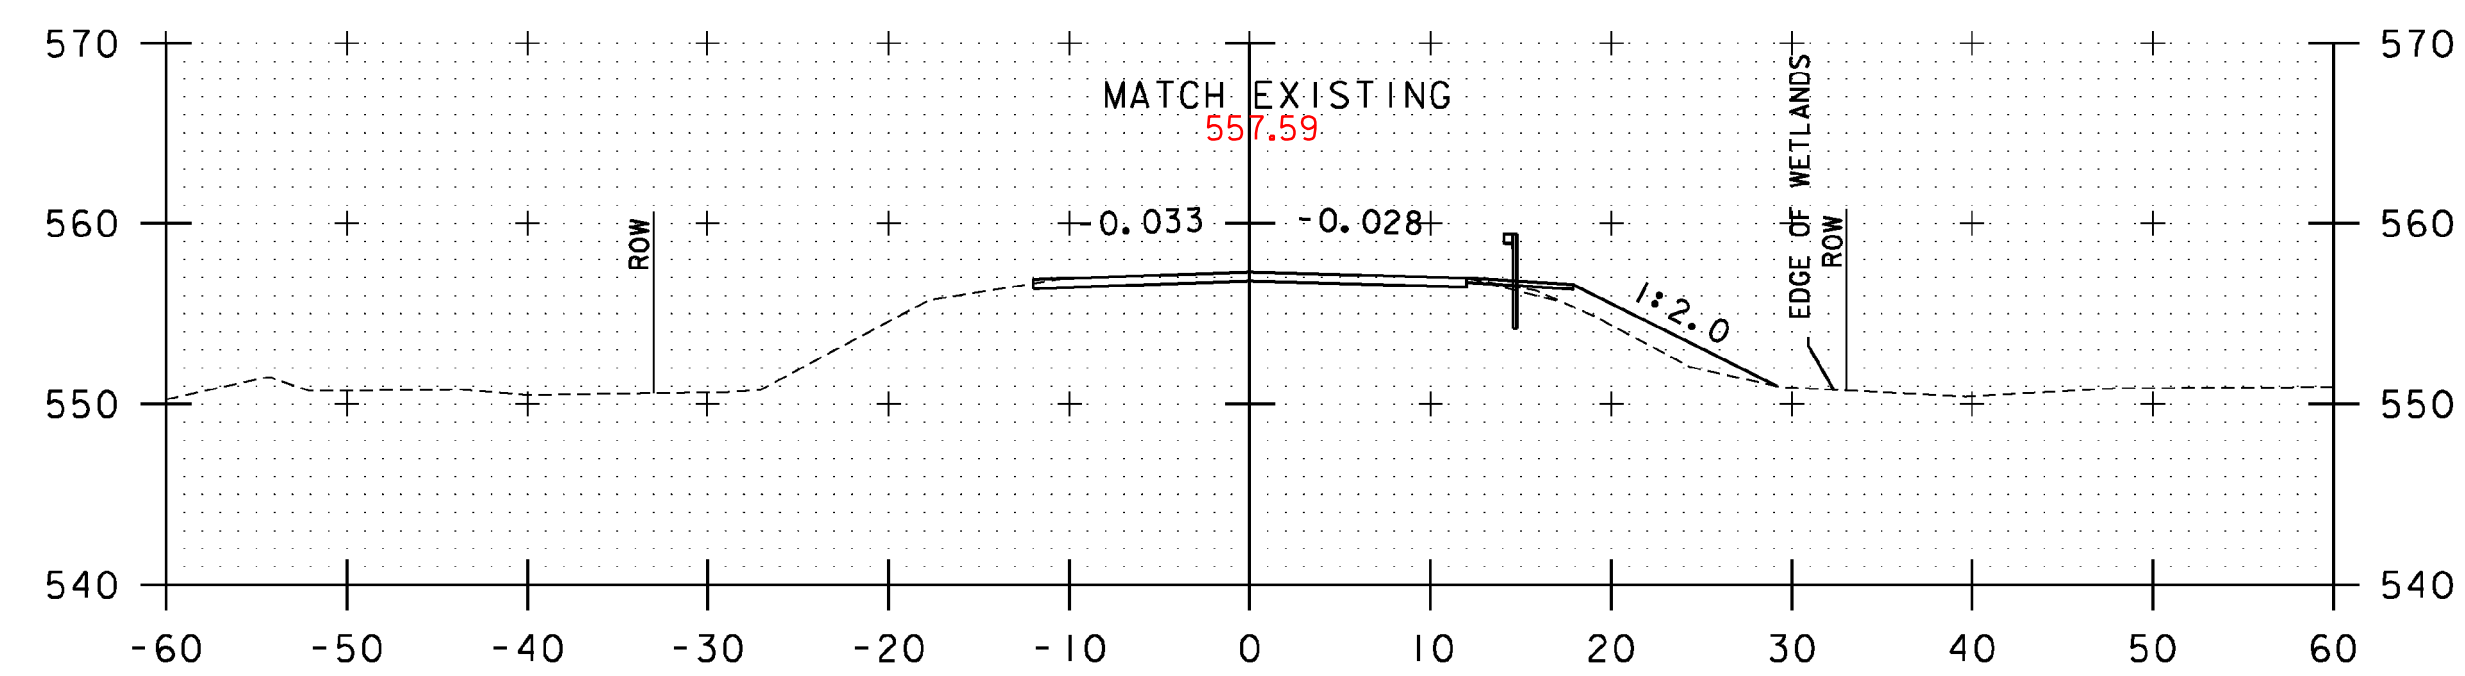


10+00
BEGIN APPROACH

9+75

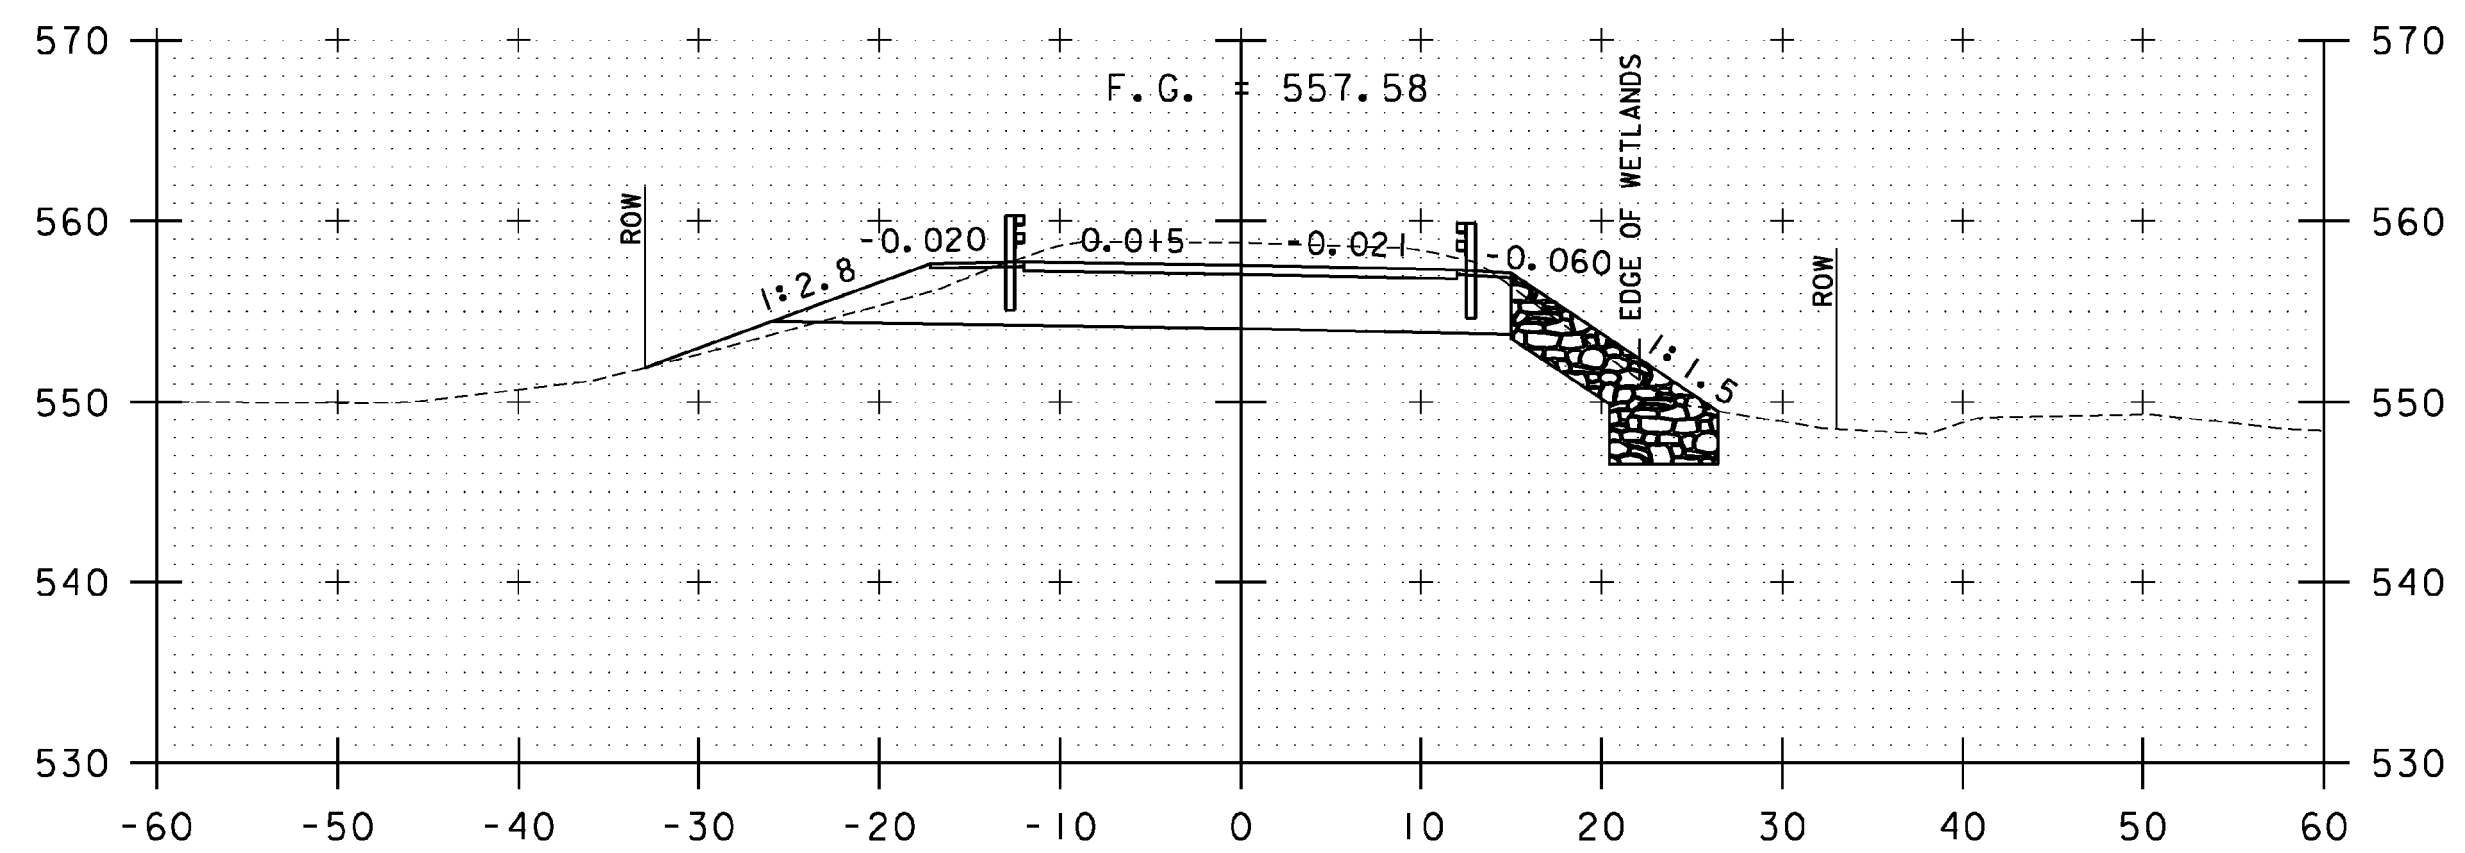


11+00

10+85
END APPROACH
BEGIN PROJECT

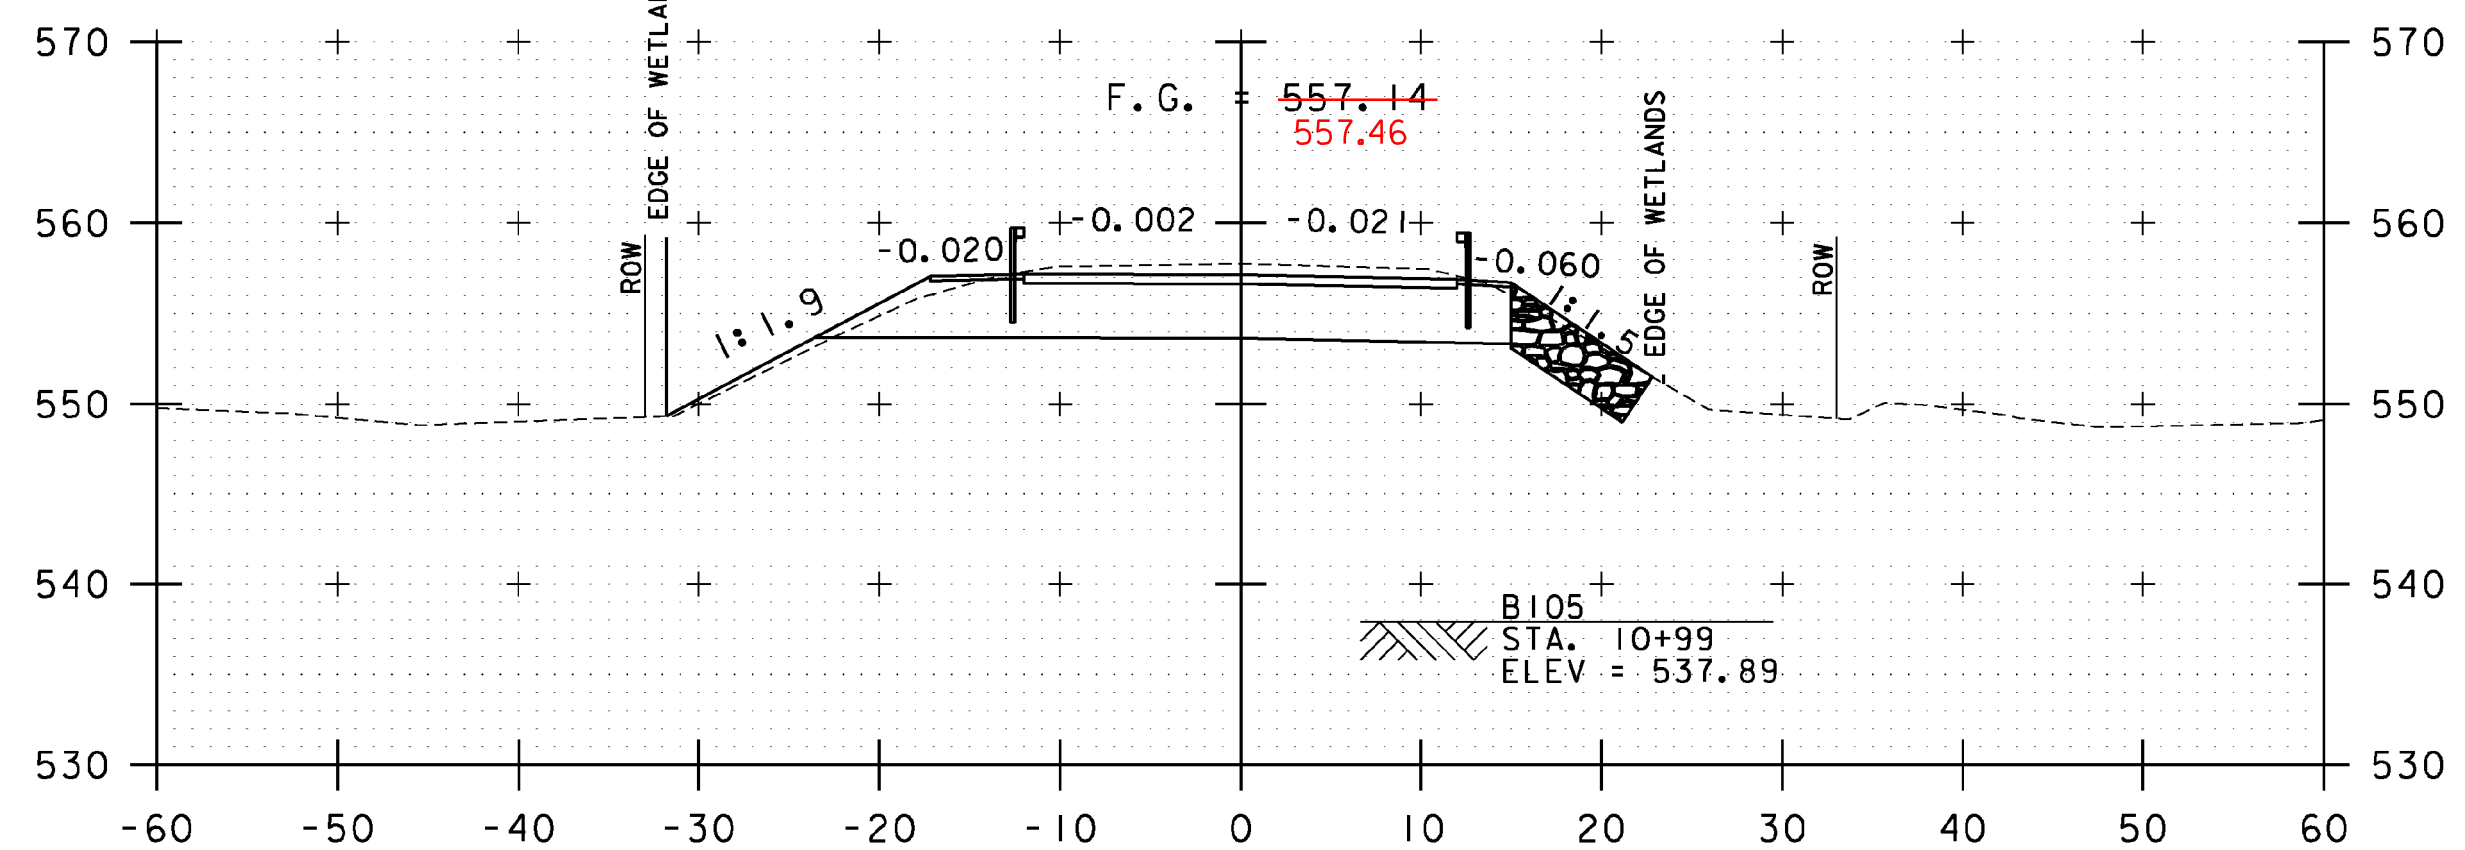


10+75

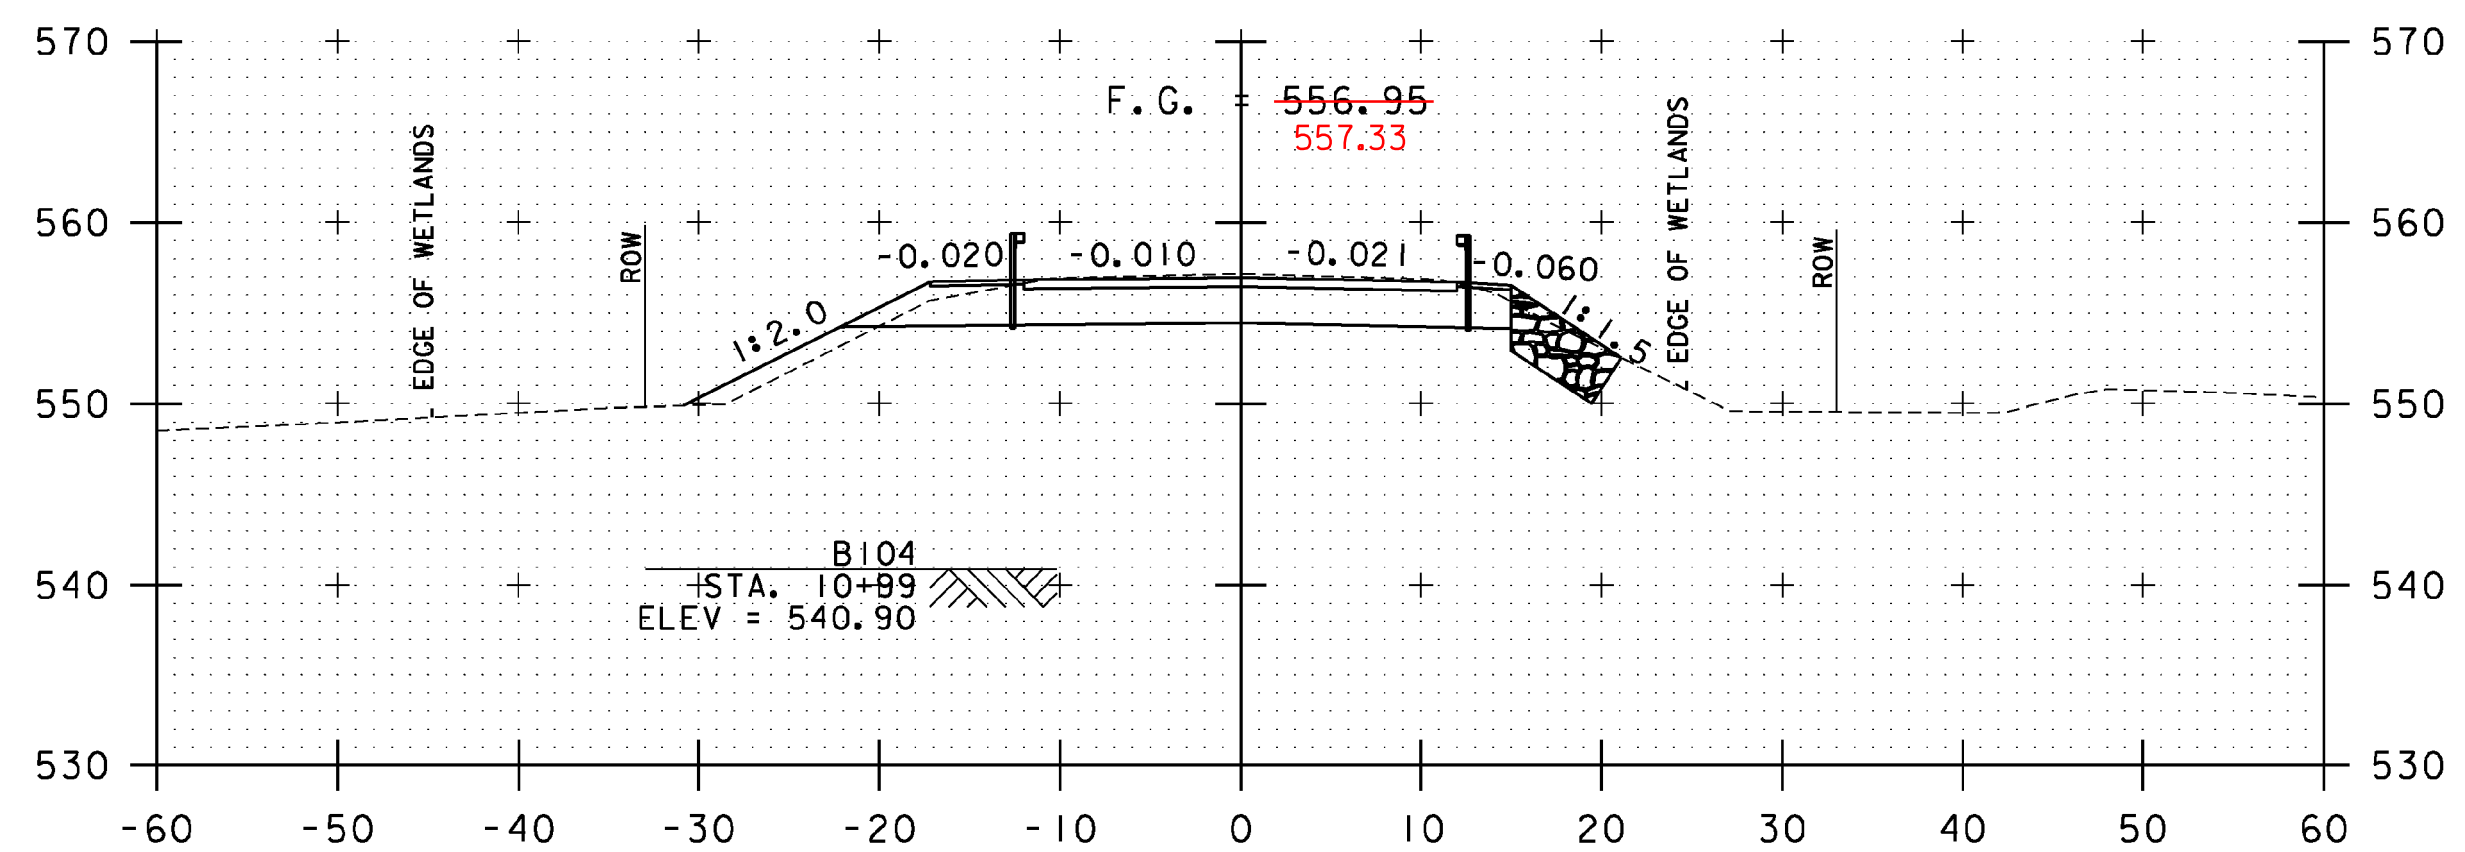

10+50

STA. 9+75 TO STA. 11+00

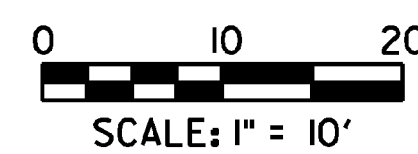

PROJECT NAME:	ENOSBURG	PLOT DATE:	10/4/2013
PROJECT NUMBER:	BRO 1448(40)	DRAWN BY:	E. ALLING
FILE NAME:	...\\12 Cross Sections.dgn	DESIGNED BY:	G. GOYETTE
PROJECT LEADER:	G. BOGUE	CHECKED BY:	G. GOYETTE
ROADWAY CROSS SECTIONS - RXS 1		SHEET 32 OF 46	