



11+96  
END BRIDGE

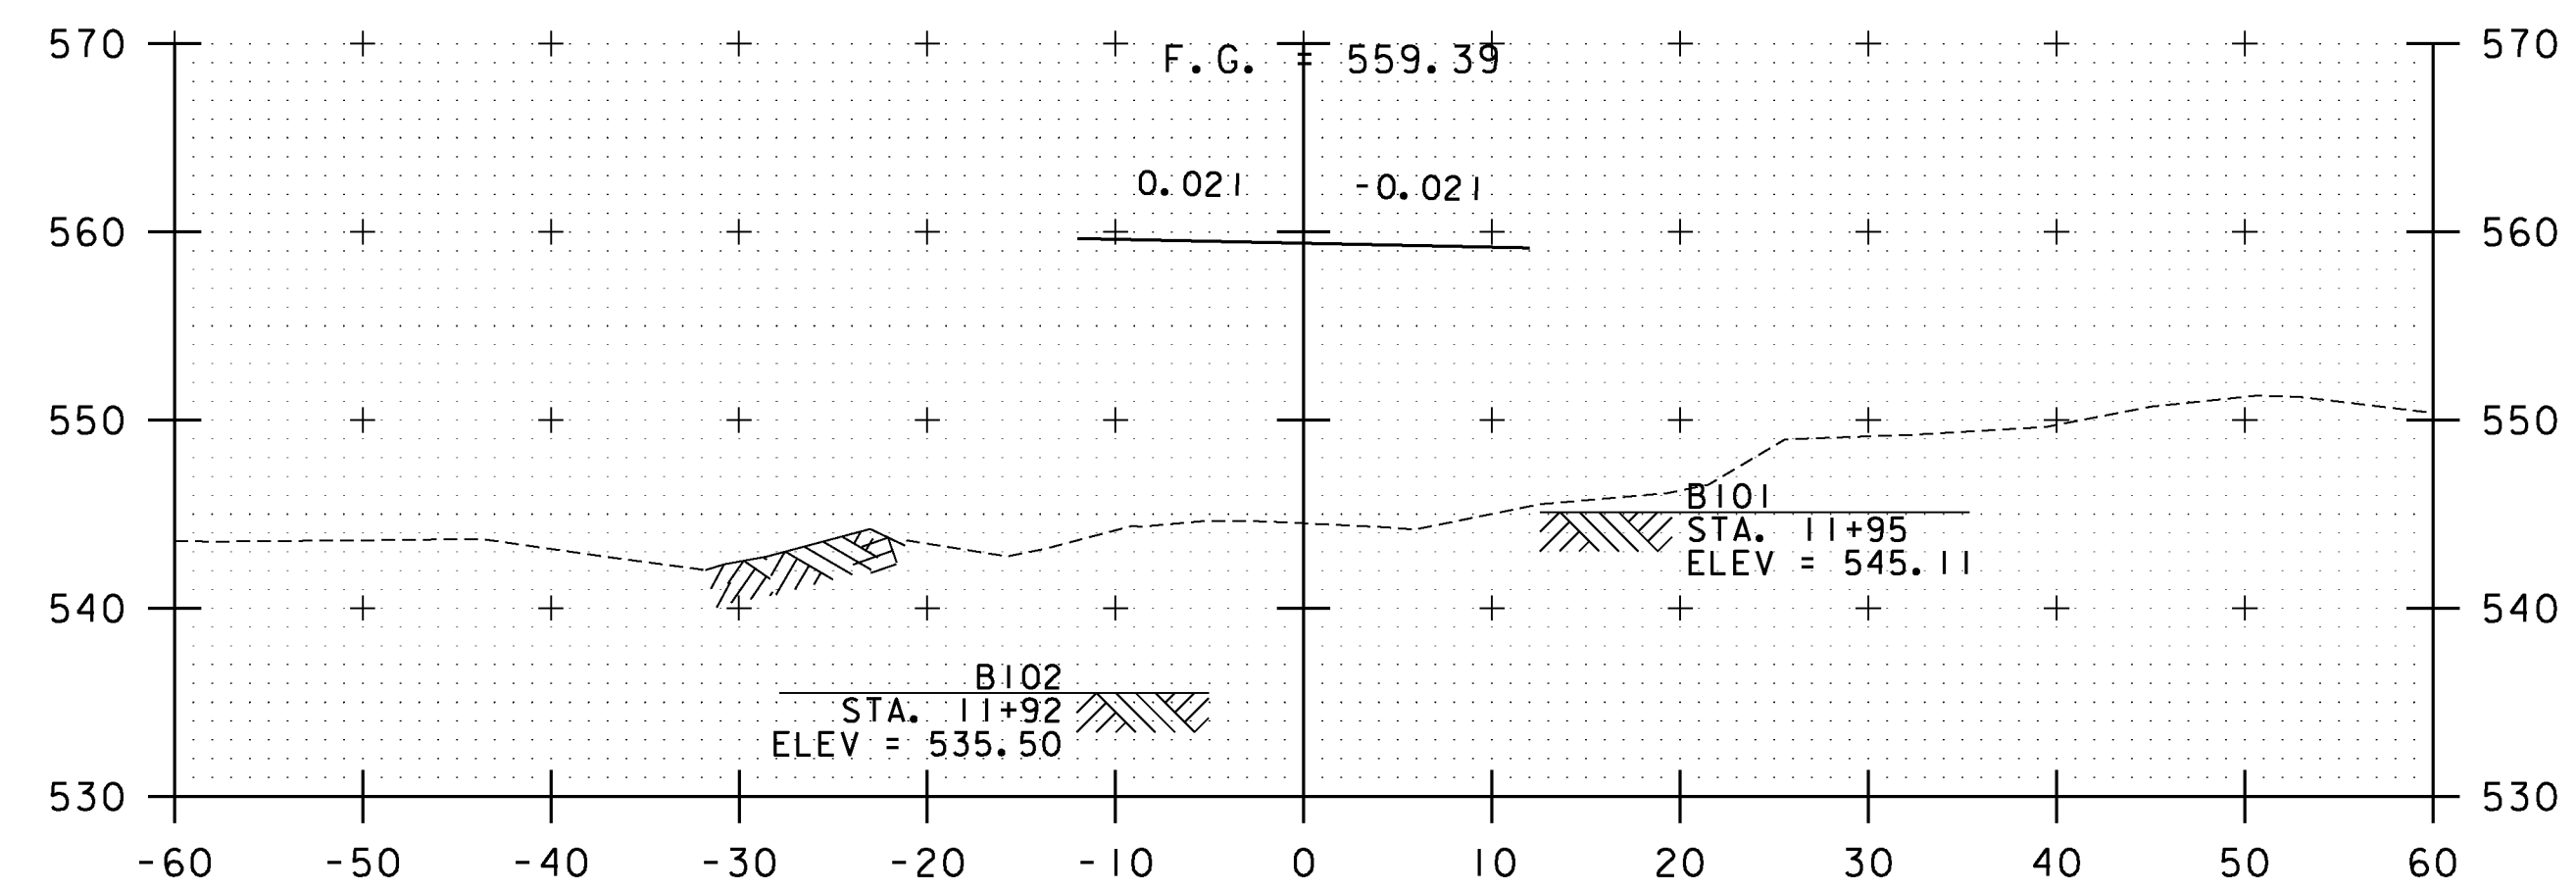


11+75

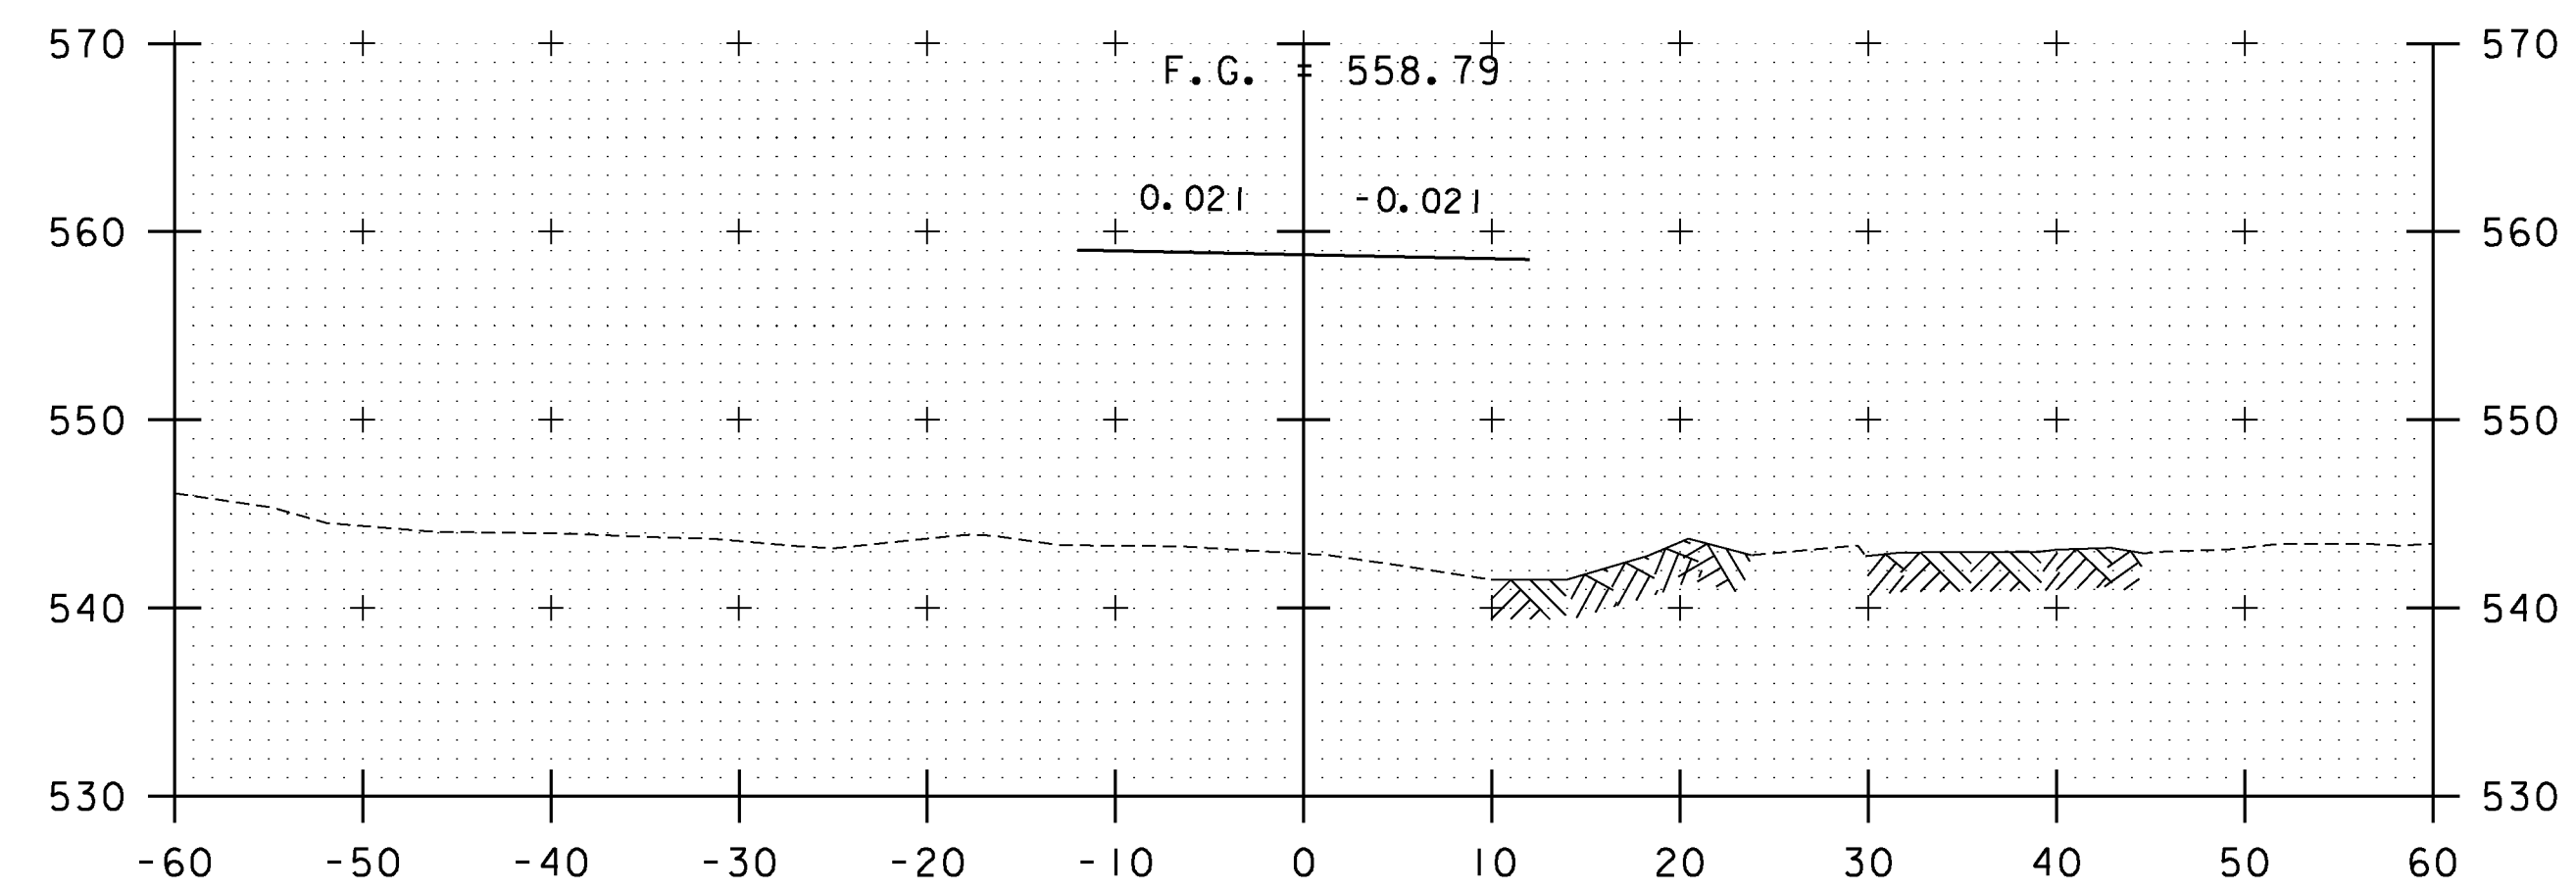


11+50


11+25  
BEGIN BRIDGE

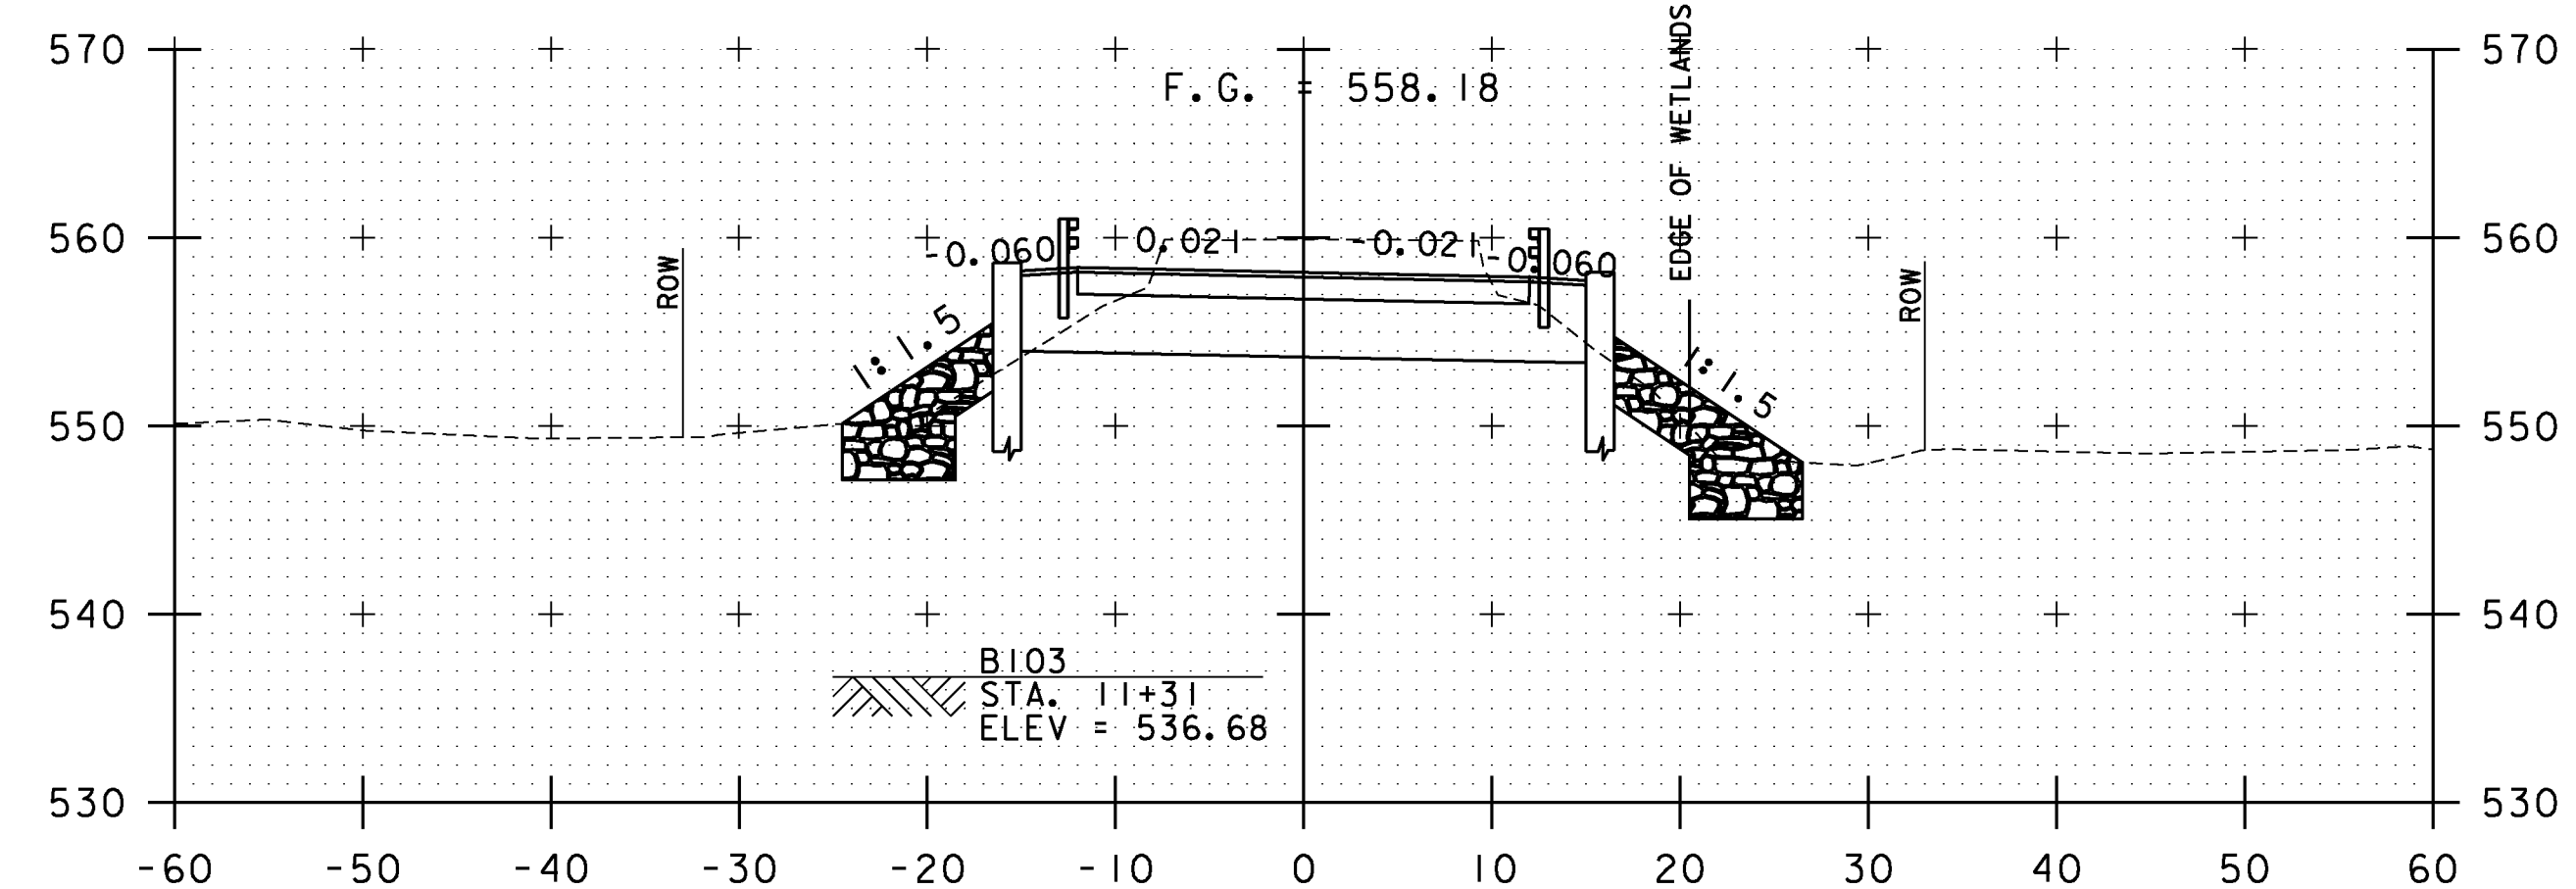

11+25

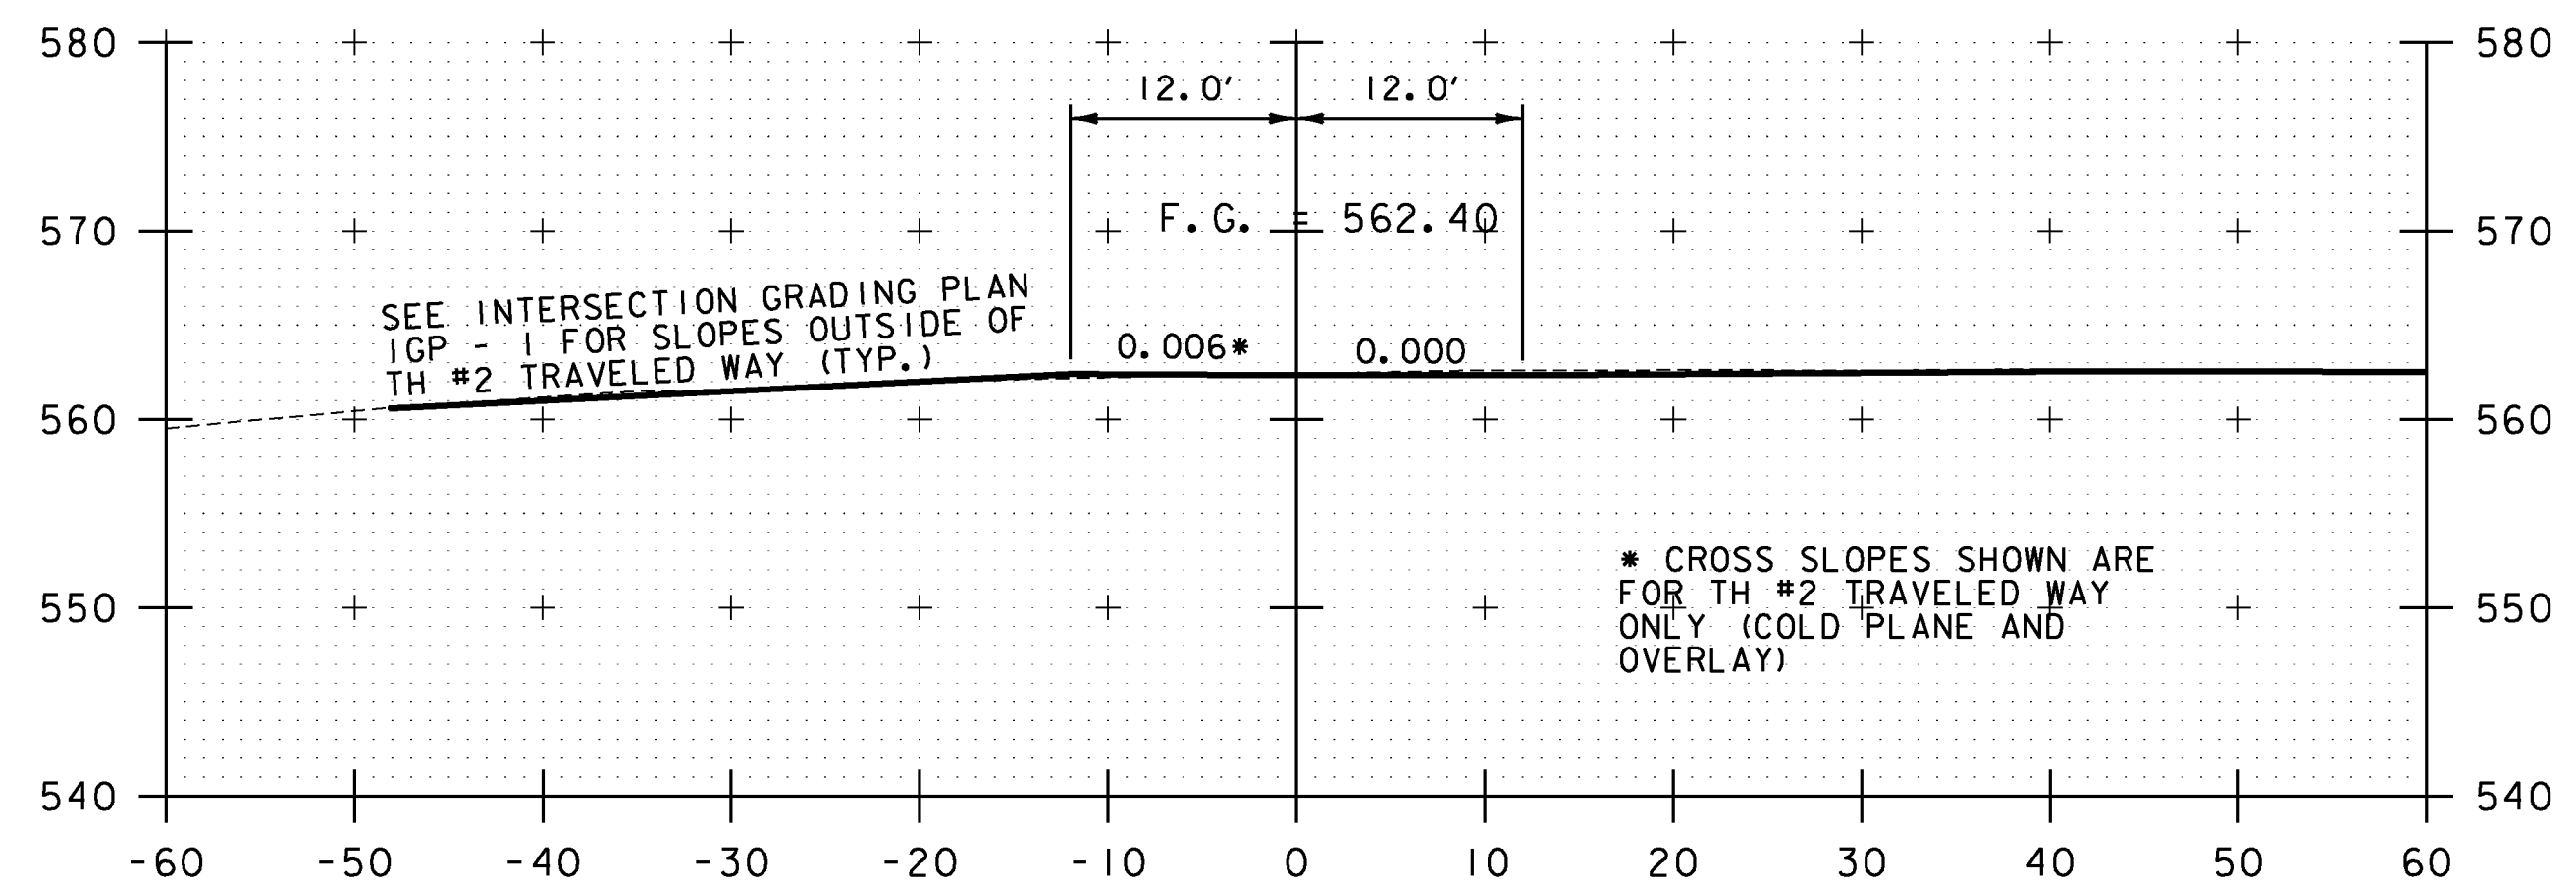


12+50

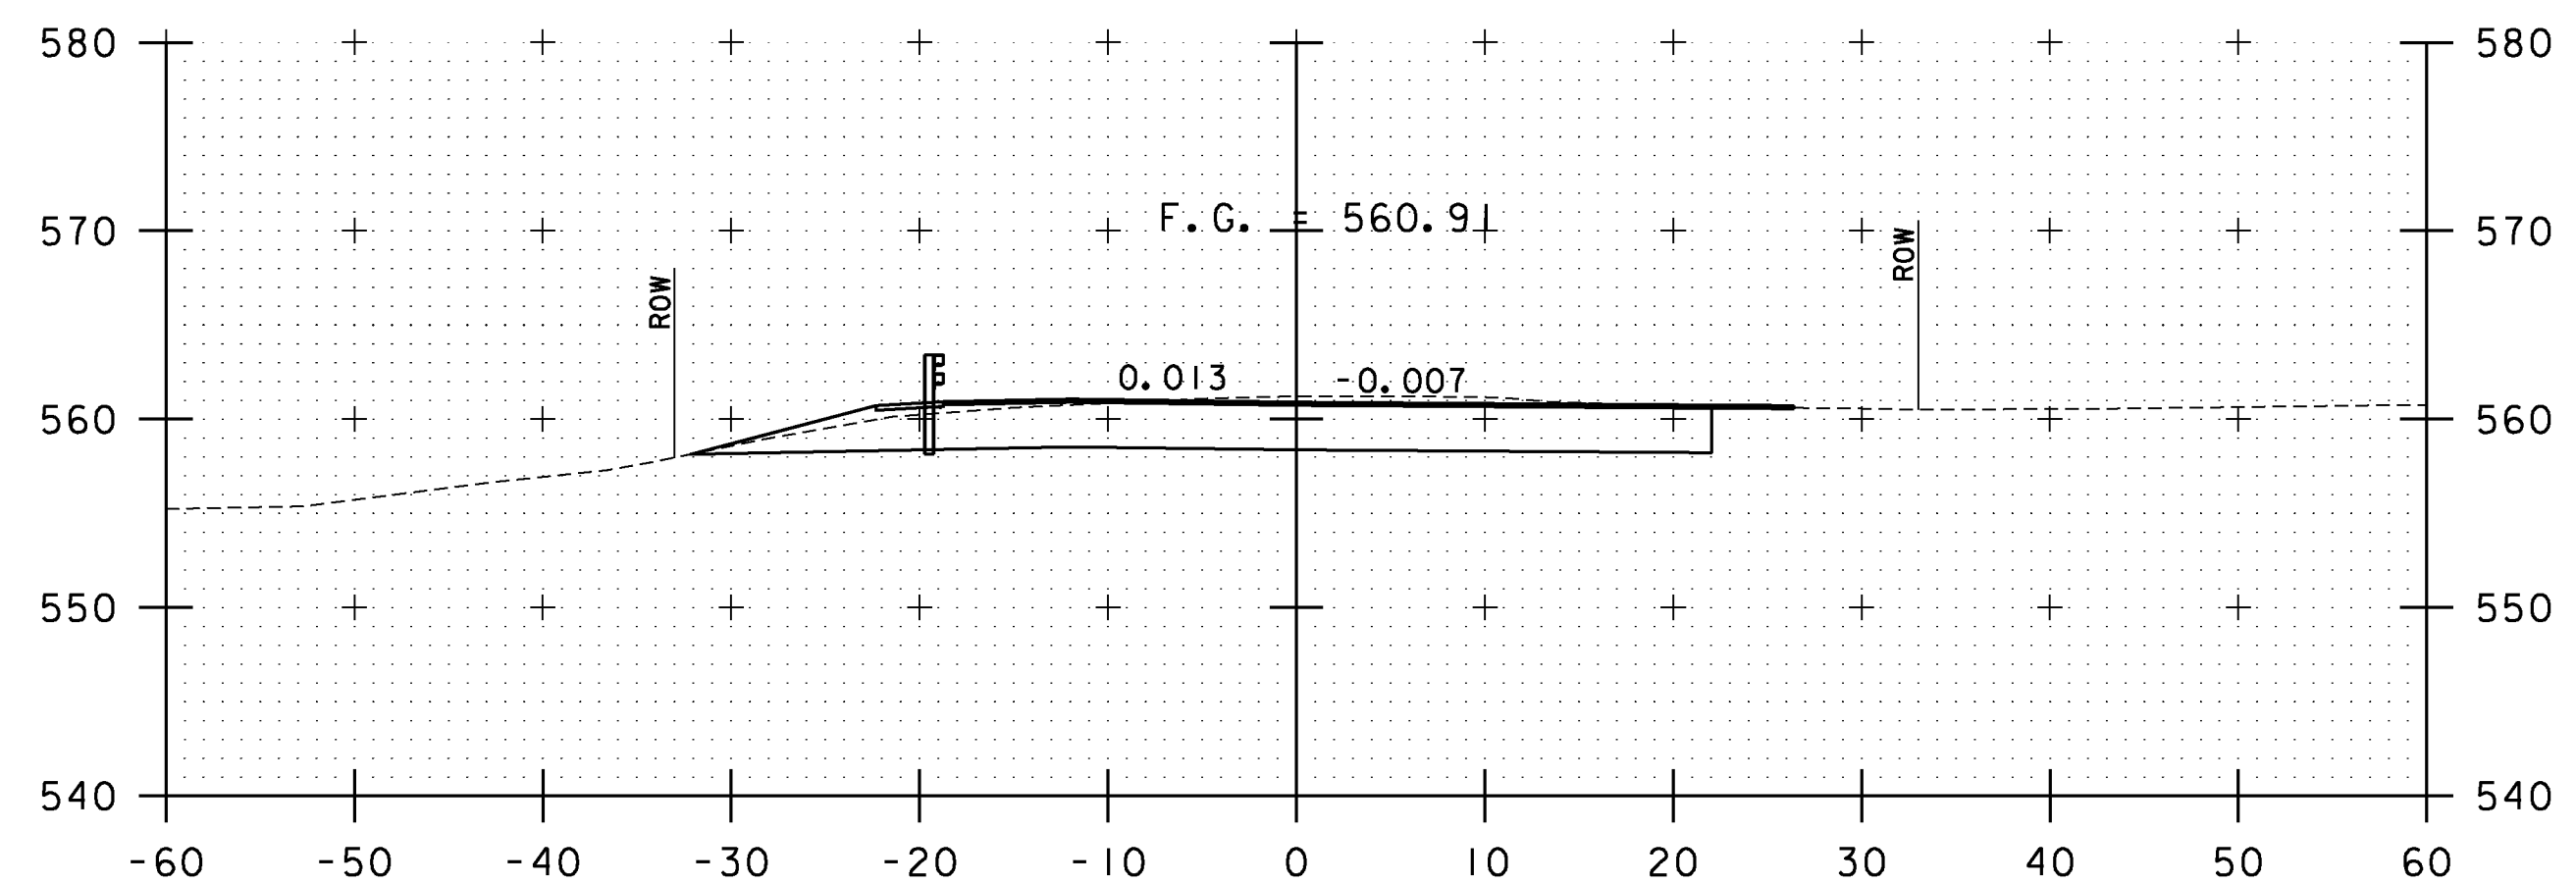


12+25

12+21  
END PROJECT  
BEGIN APPROACH

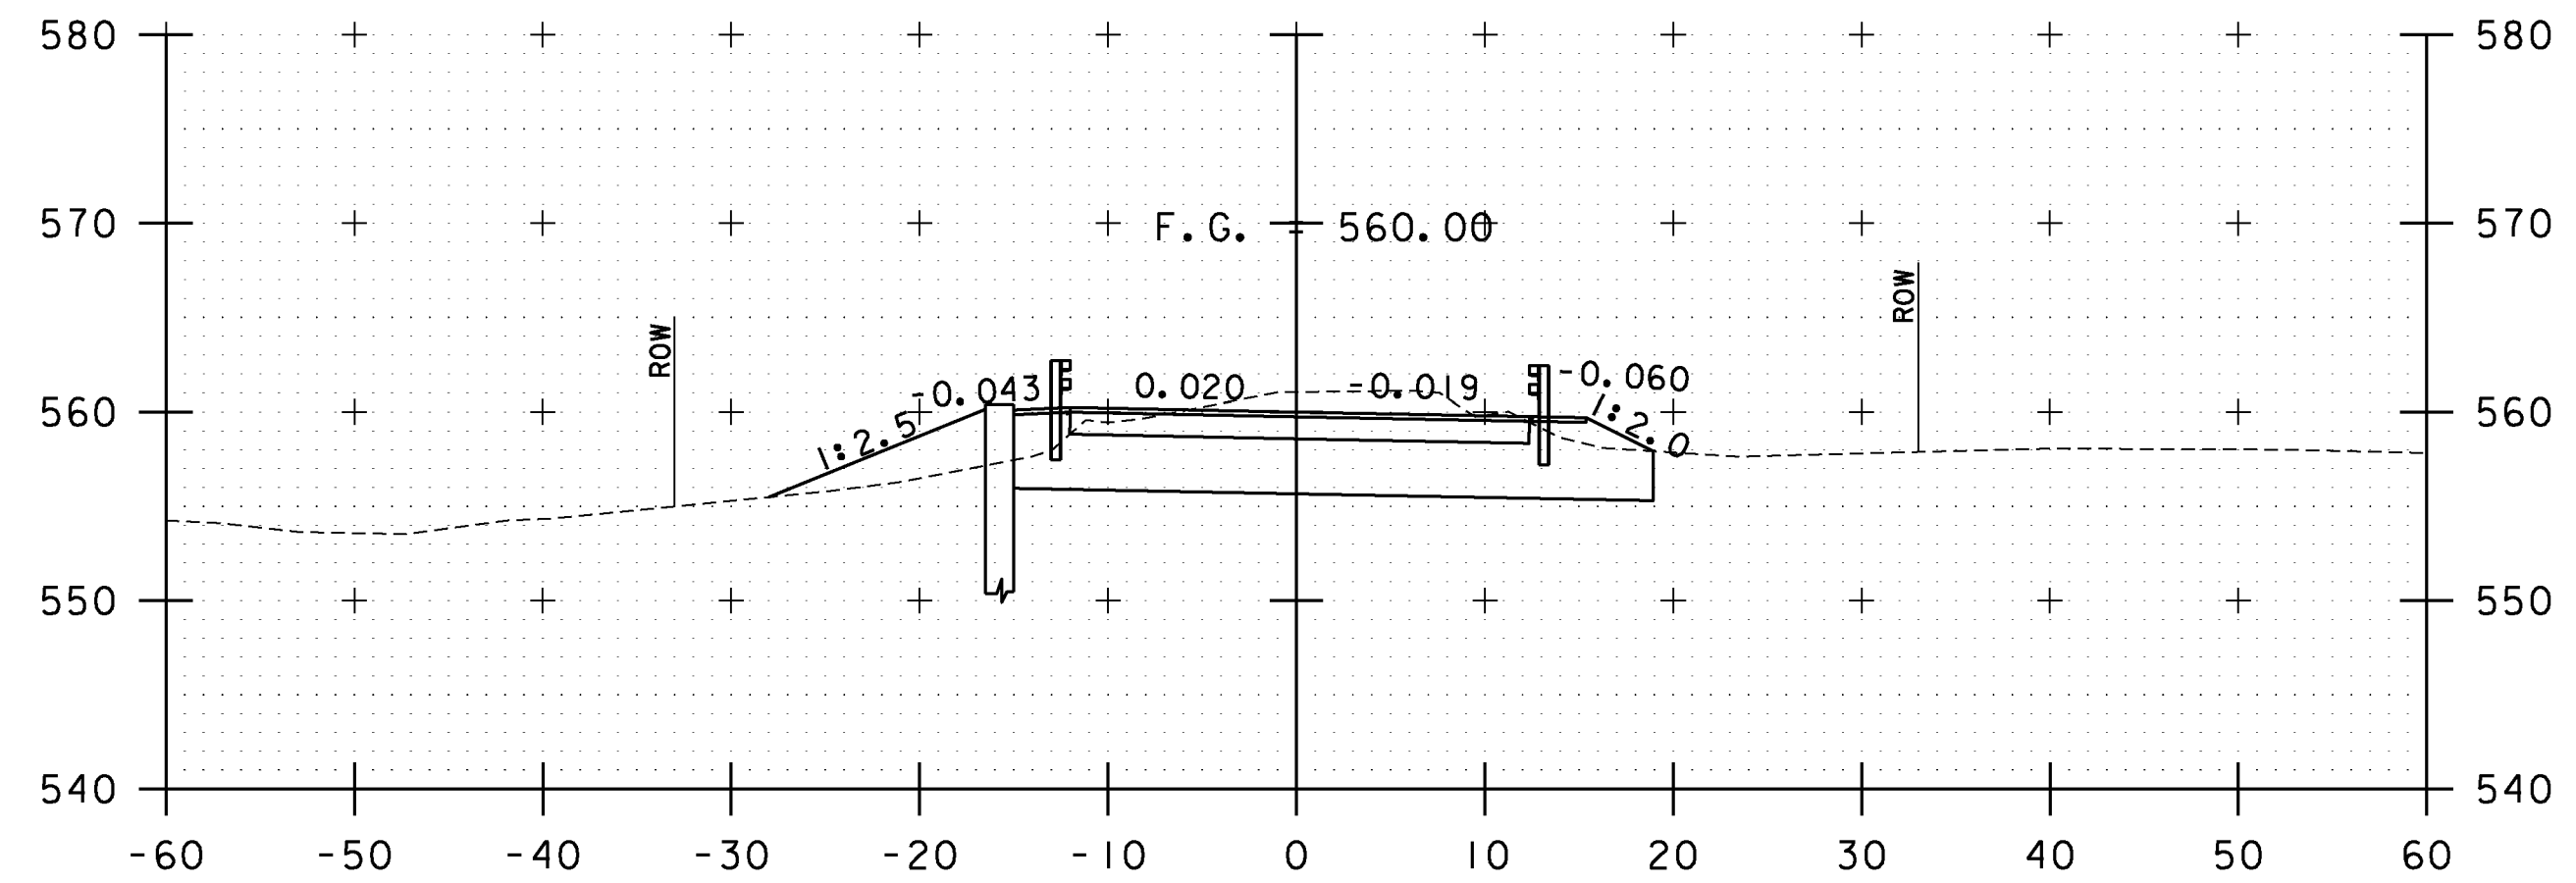

12+00

STA. 11+25 TO STA. 12+50

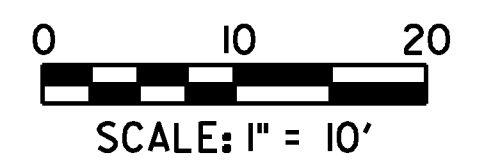

PROJECT NAME: ENOSBURG	PLOT DATE: 10/4/2013
PROJECT NUMBER: BRO 1448(40)	DRAWN BY: E. ALLING
FILE NAME: ...\\12 Cross Sections.dgn	CHECKED BY: G. GOYETTE
PROJECT LEADER: G. BOGUE	SHEET 33 OF 46
DESIGNED BY: G. GOYETTE	
<b>ROADWAY CROSS SECTIONS - RXS 2</b>	