




13+25

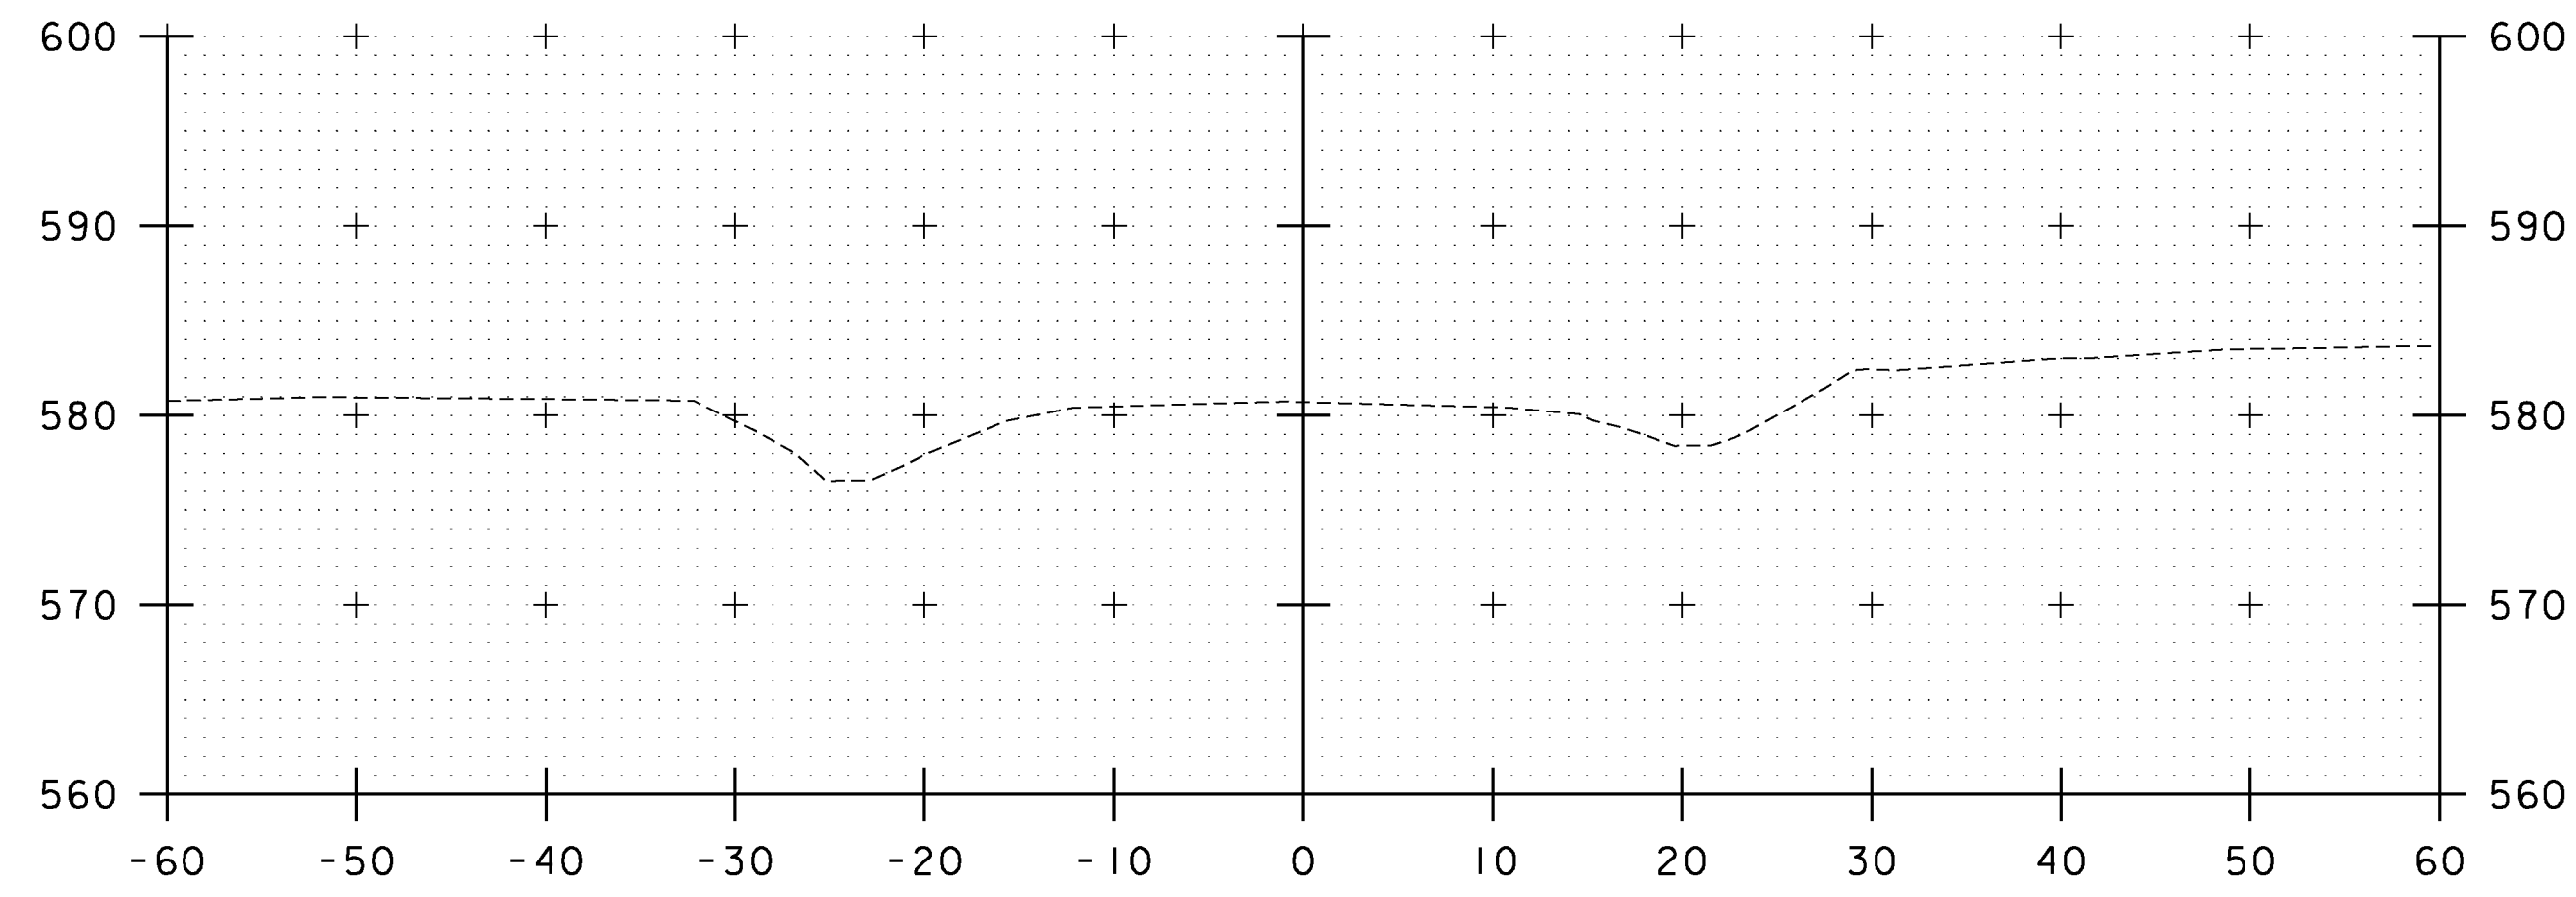


14+00

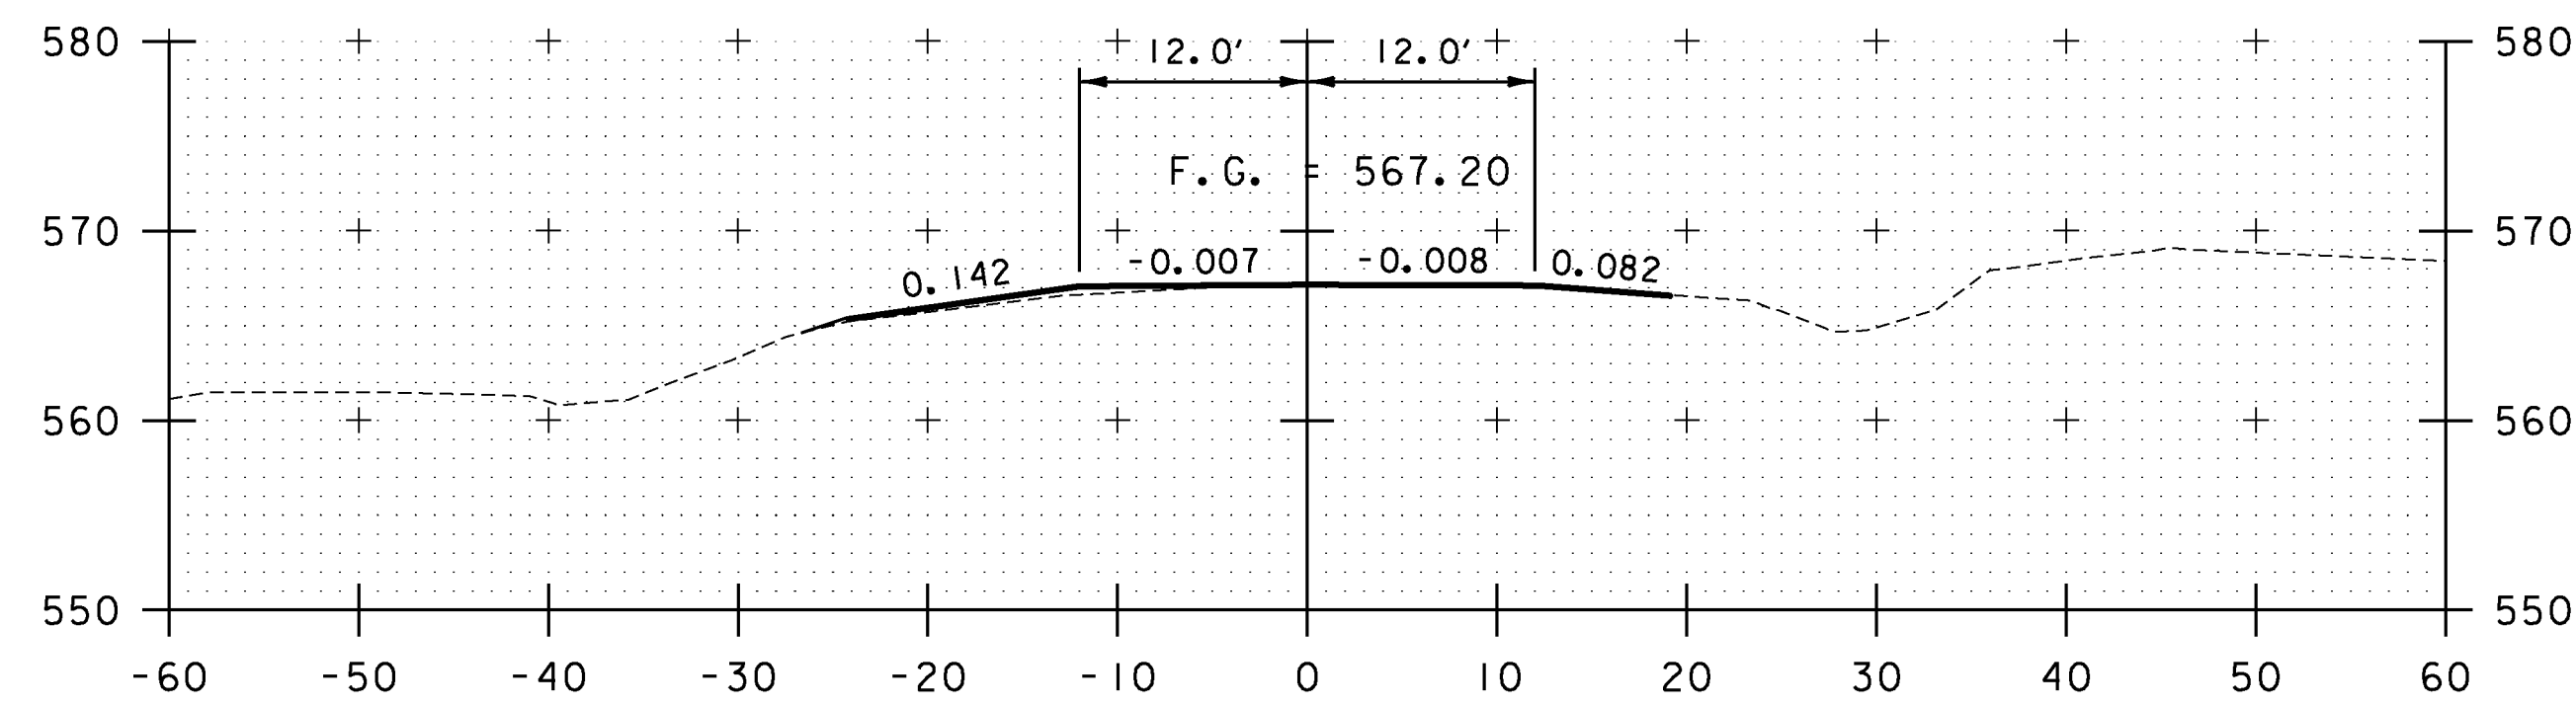


13+00

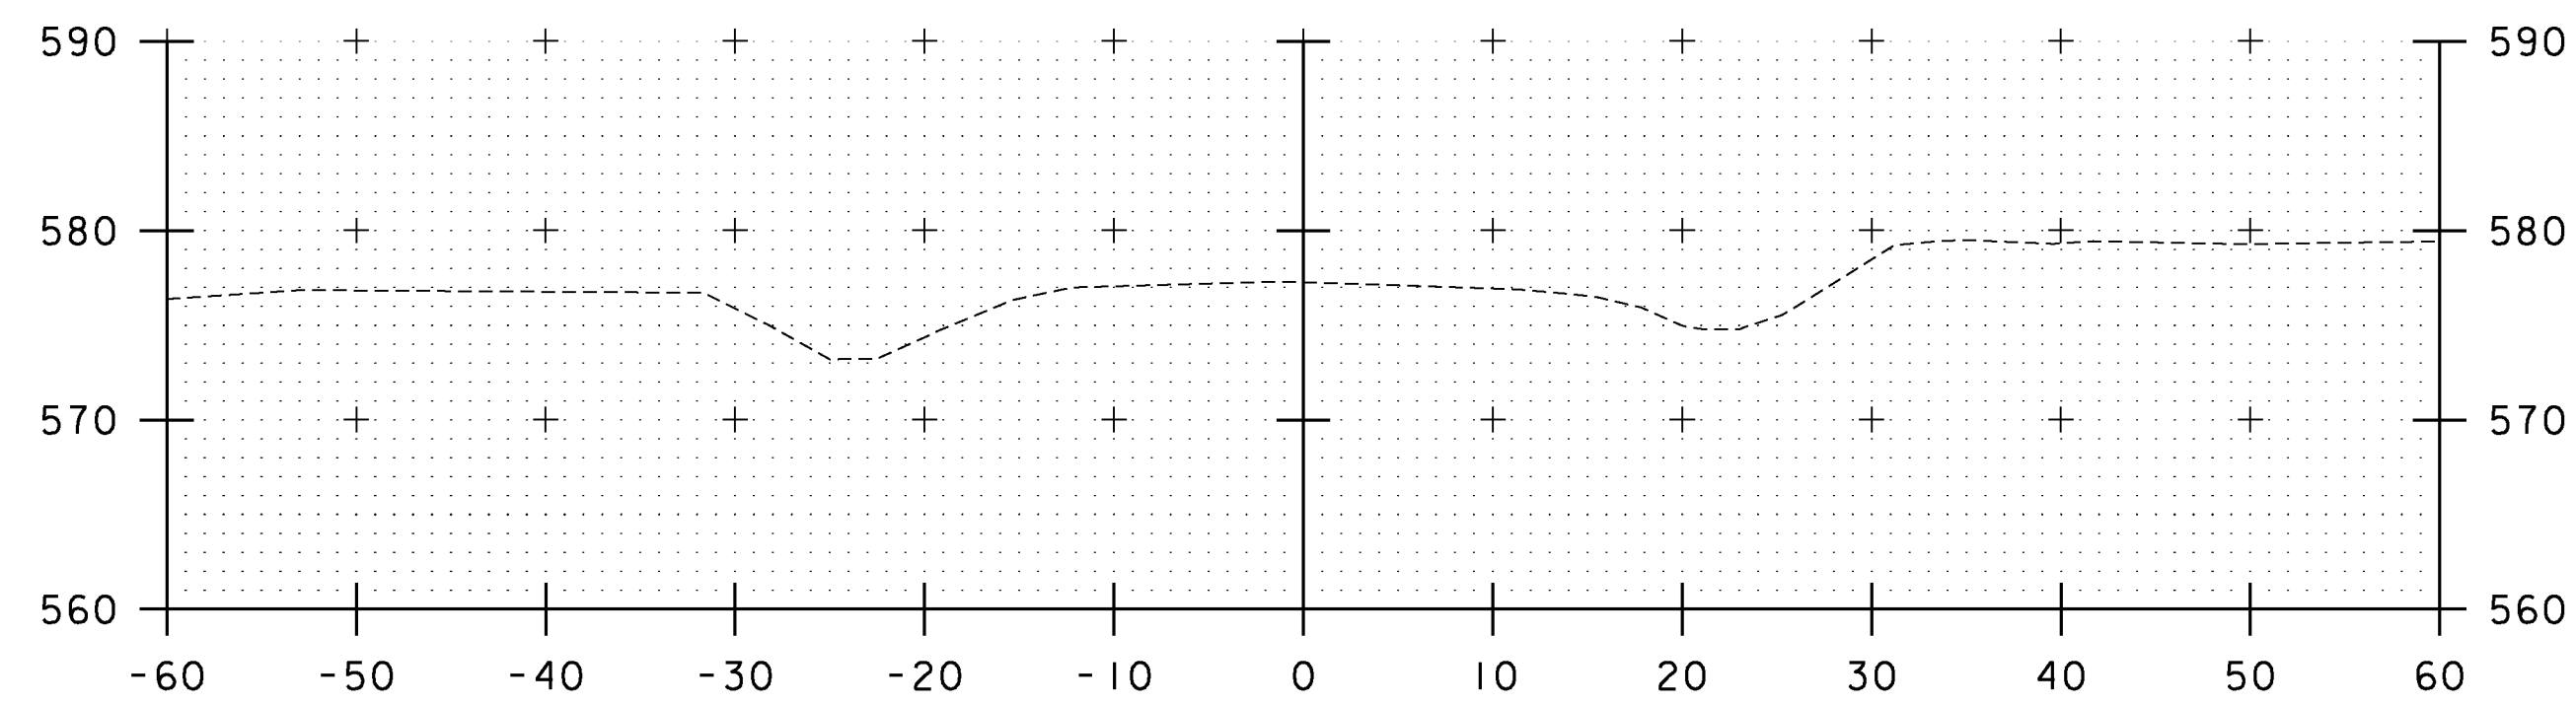

13+75

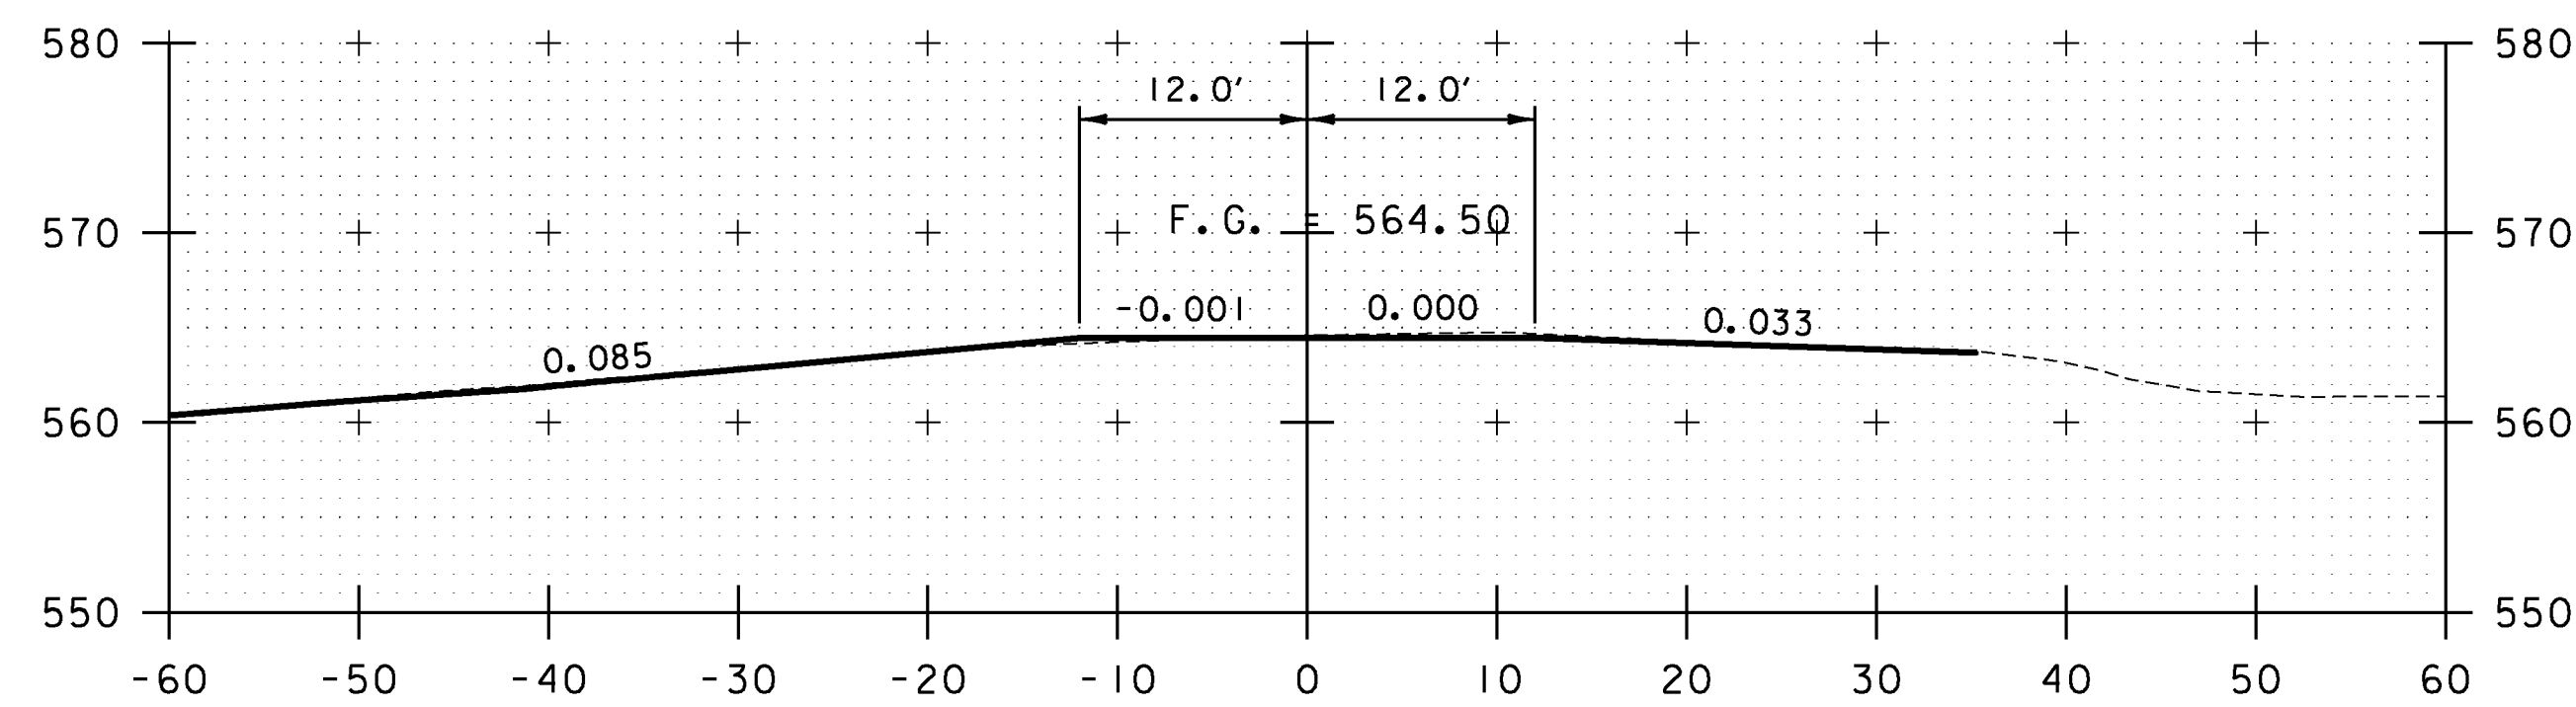


12+75

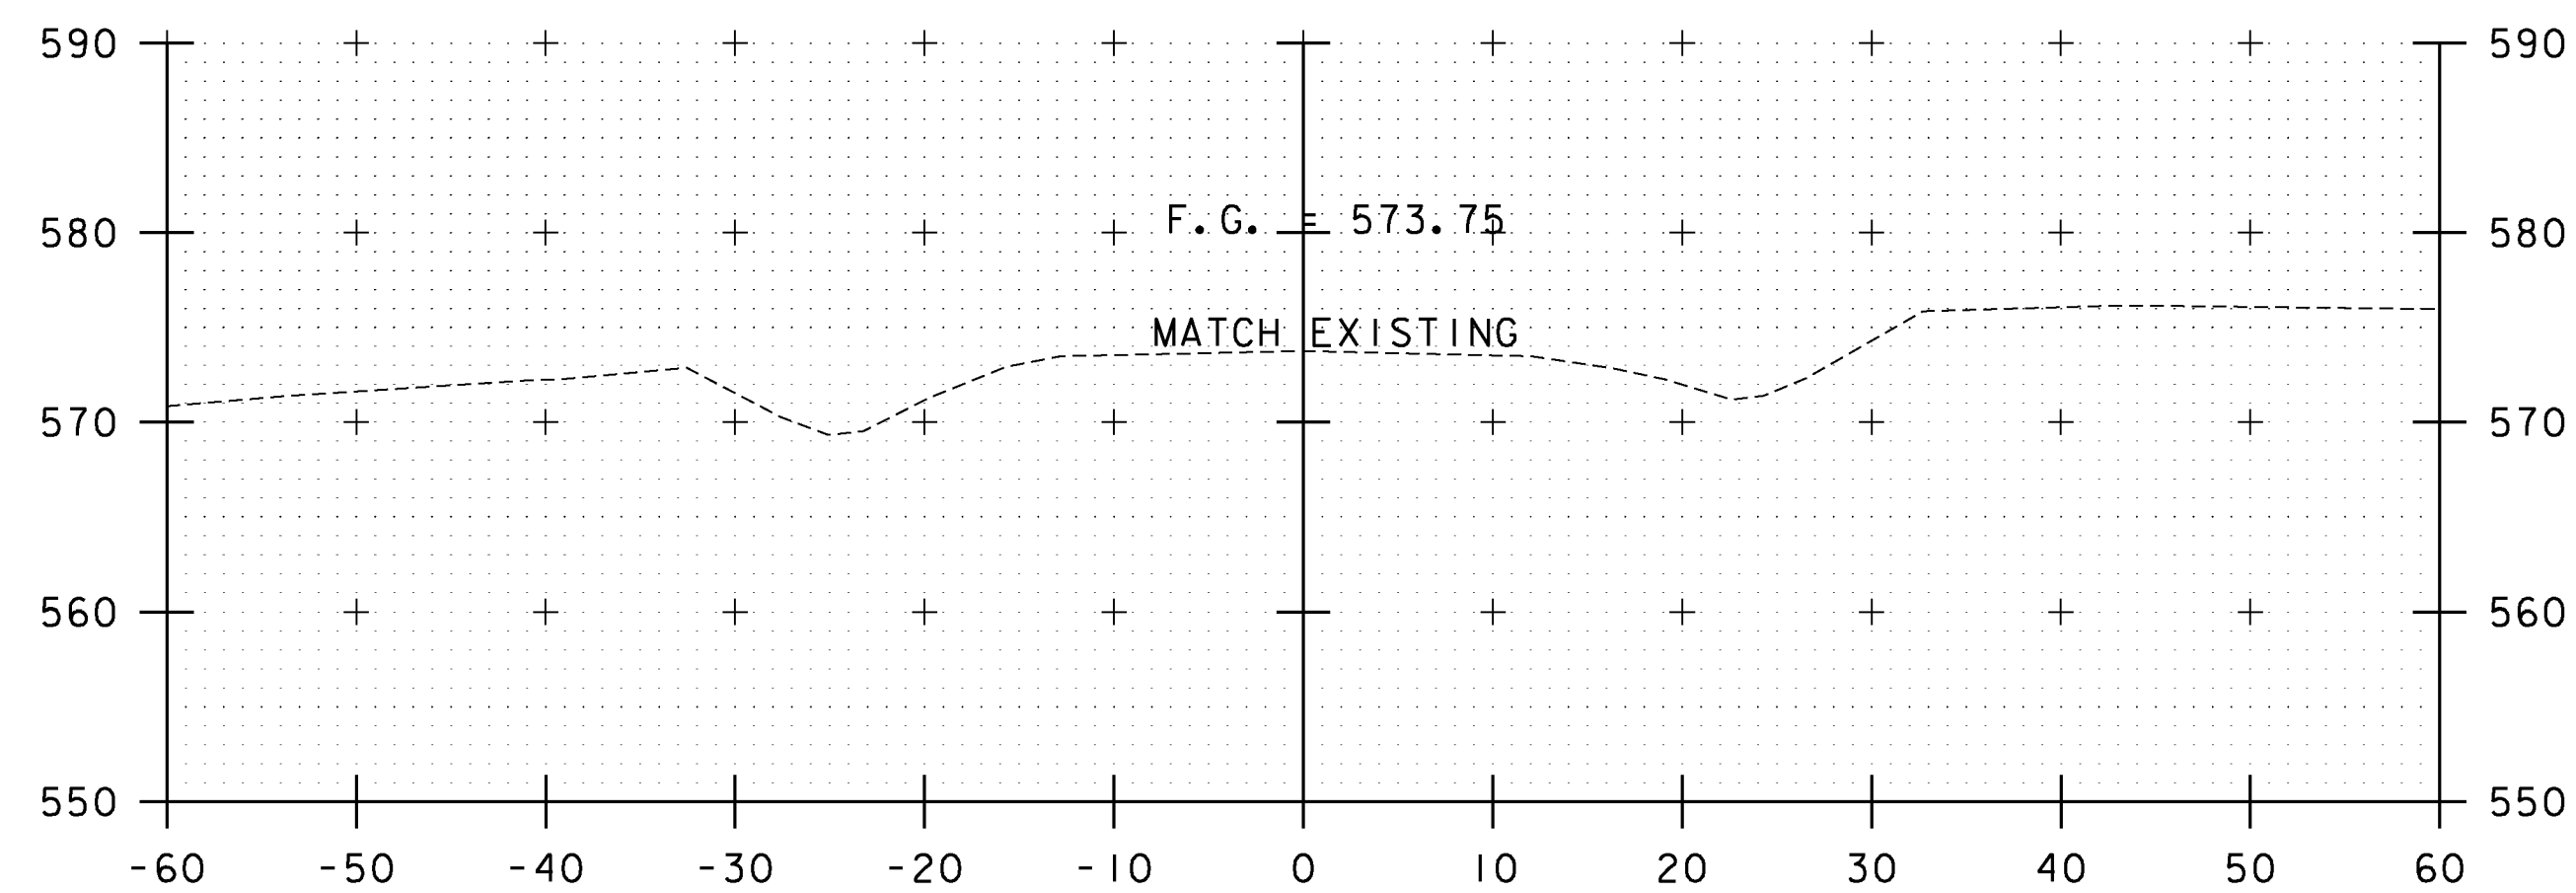

13+50
END APPROACH

STA. 12+75 TO STA. 14+00

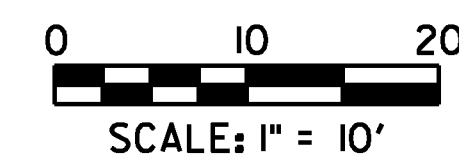

PROJECT NAME: ENOSBURG	PROJECT NUMBER: BRO 1448(40)
FILE NAME: ...12 Cross Sections.dgn	PLOT DATE: 10/4/2013
PROJECT LEADER: G. BOGUE	DRAWN BY: E. ALLING
DESIGNED BY: G. GOYETTE	CHECKED BY: G. GOYETTE
ROADWAY CROSS SECTIONS - RXS 3	SHEET 34 OF 46