



33+50

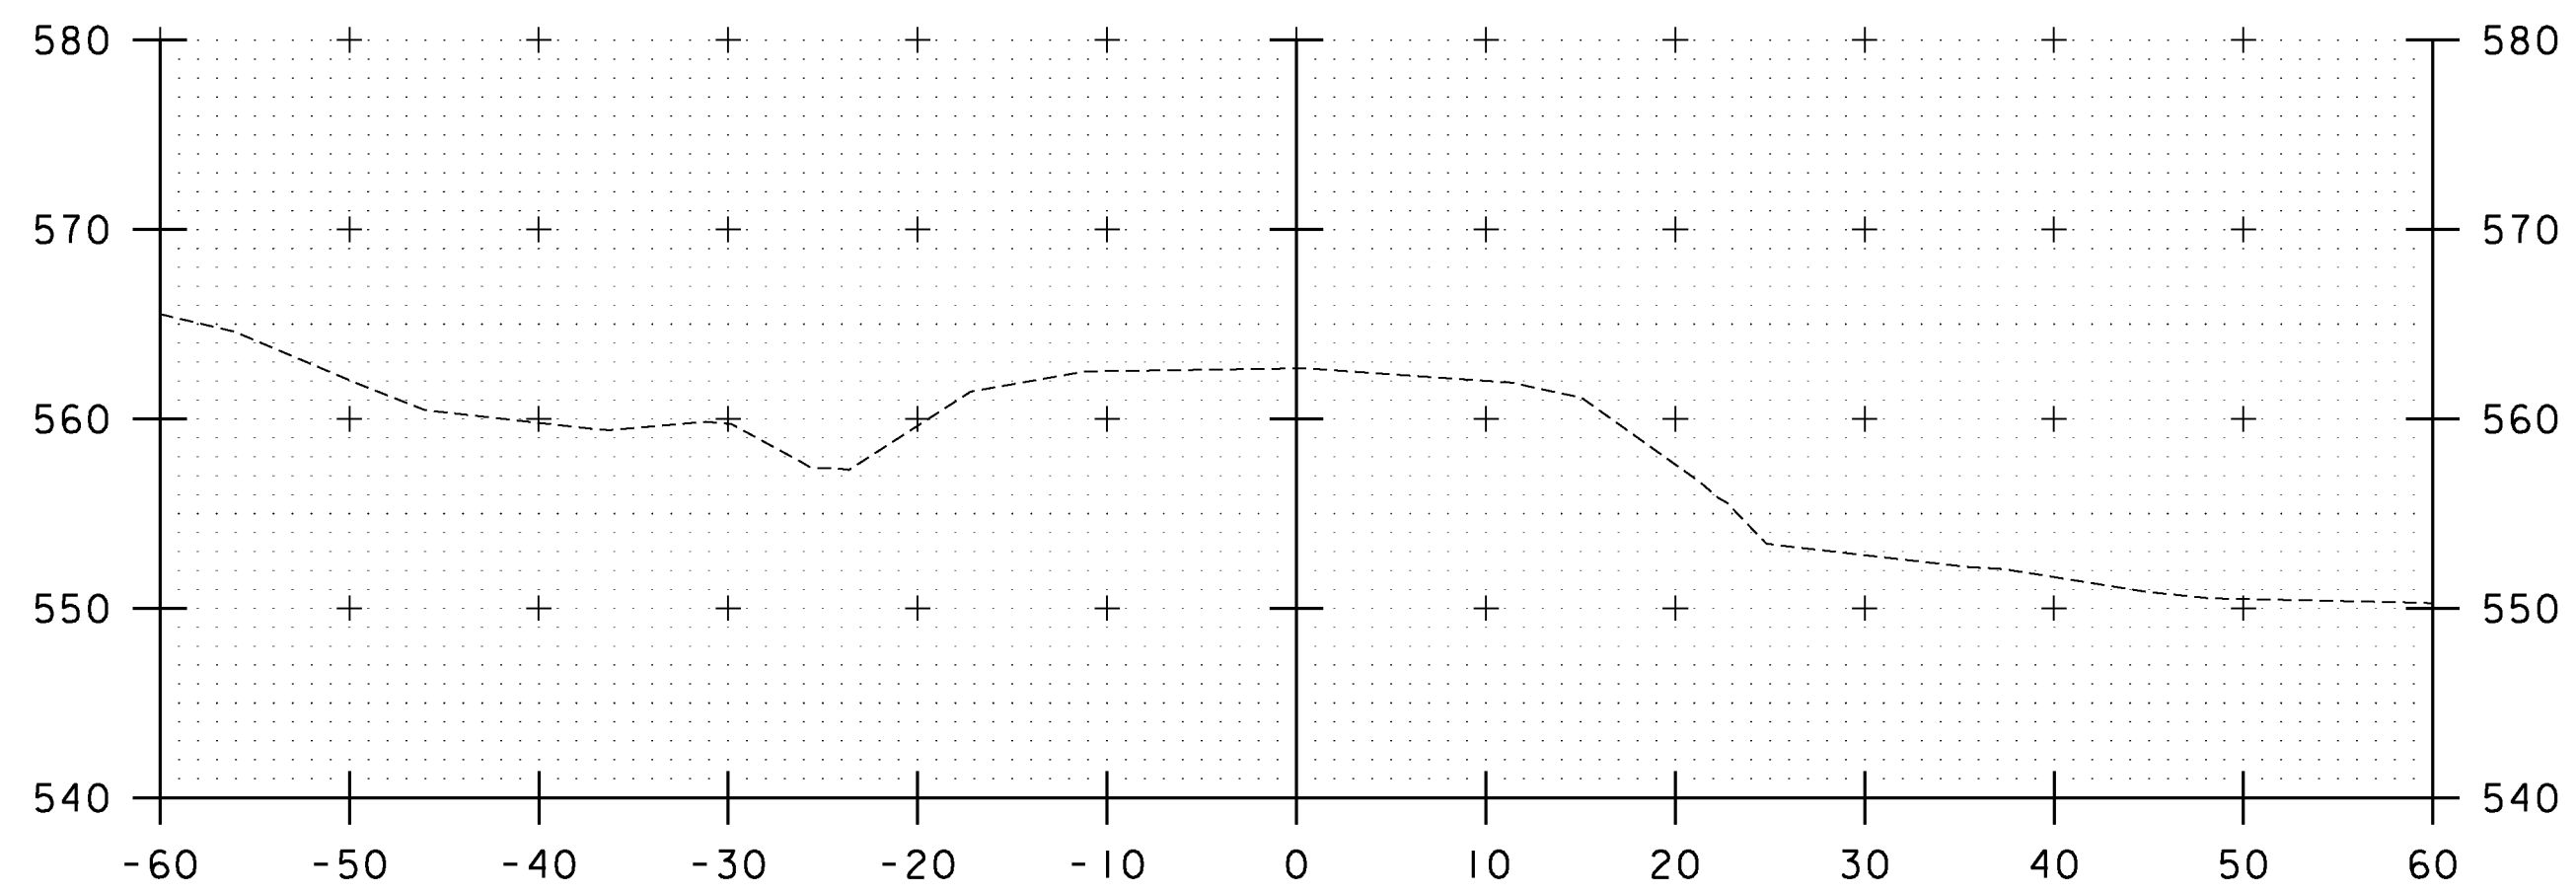


35+00

STA. 34+70  
MATCH EXISTING

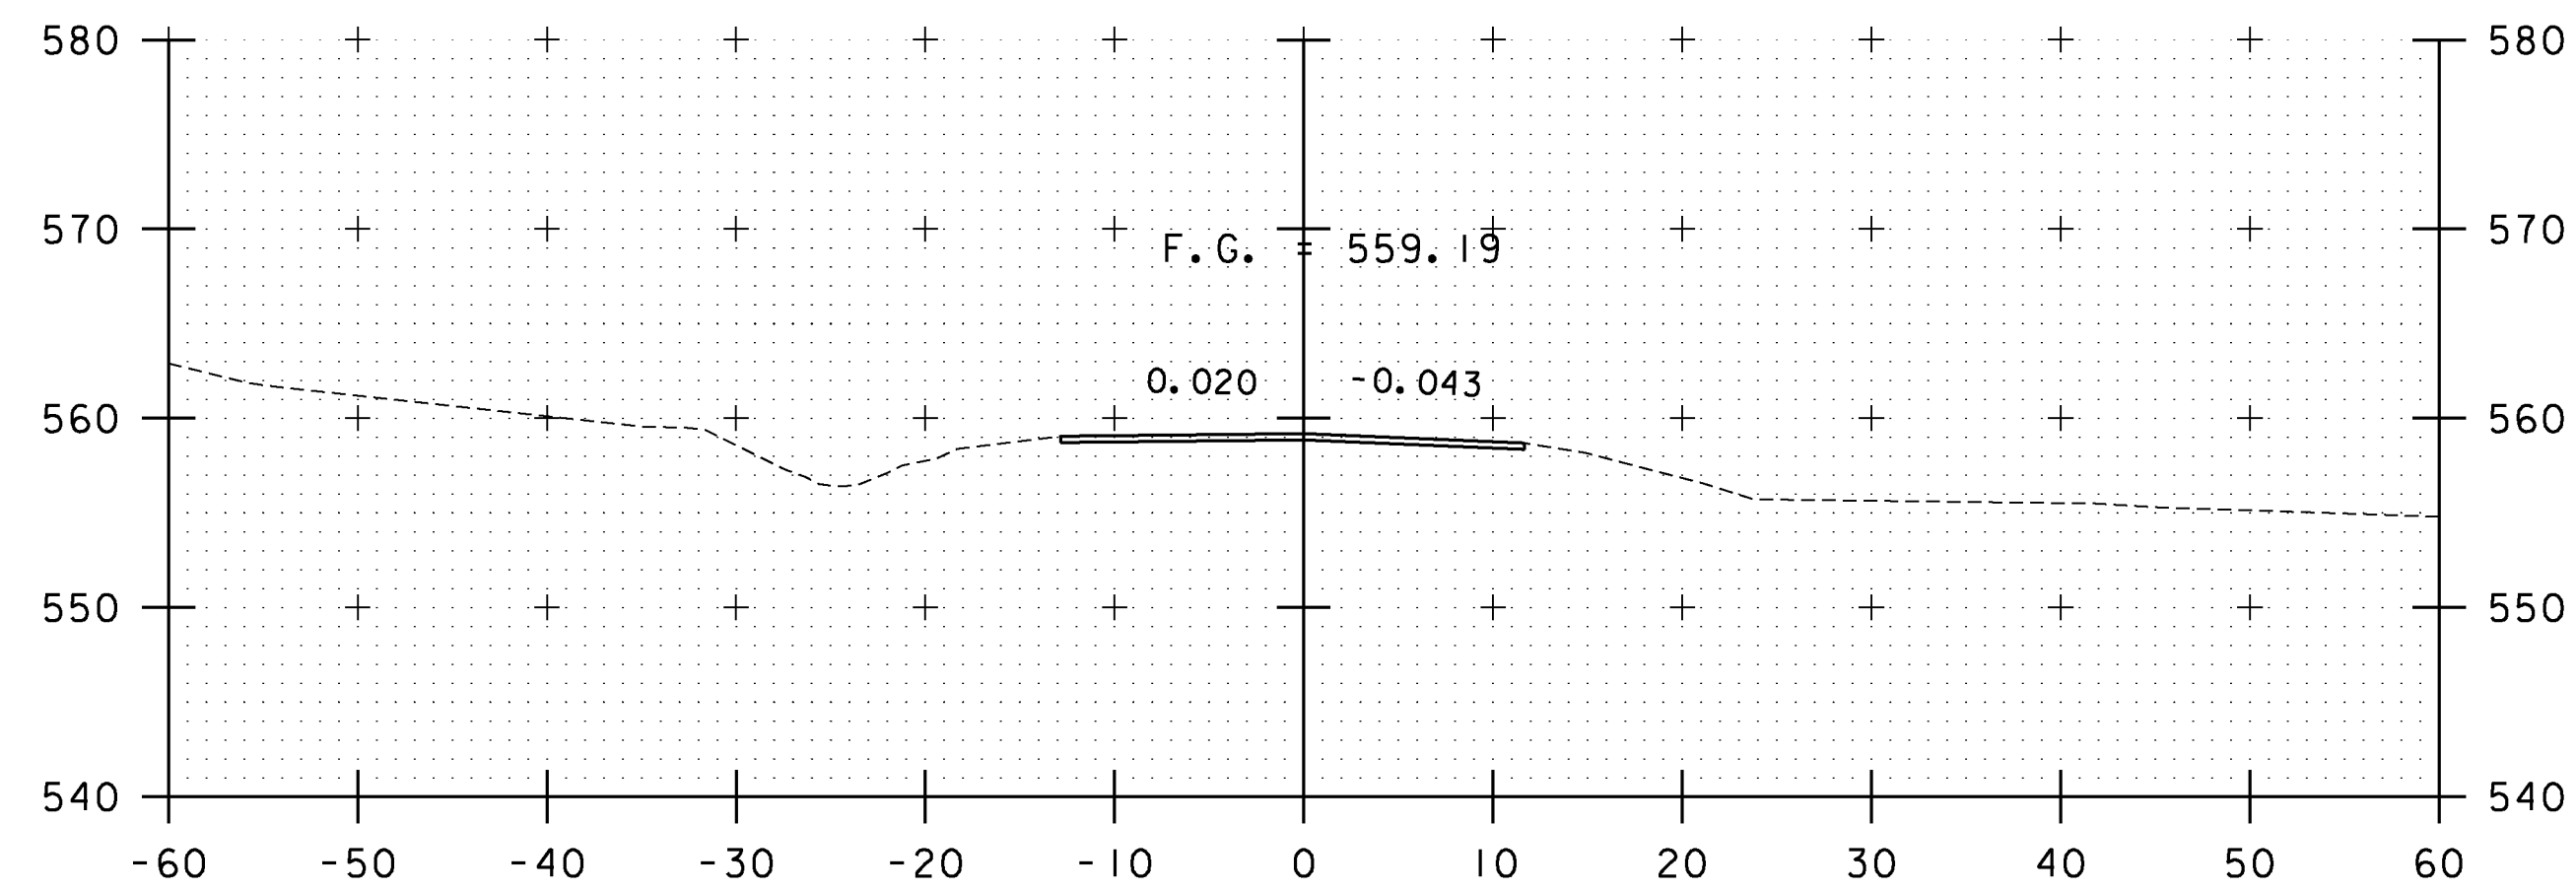


33+00


STA. 32+85  
MATCH EXISTING

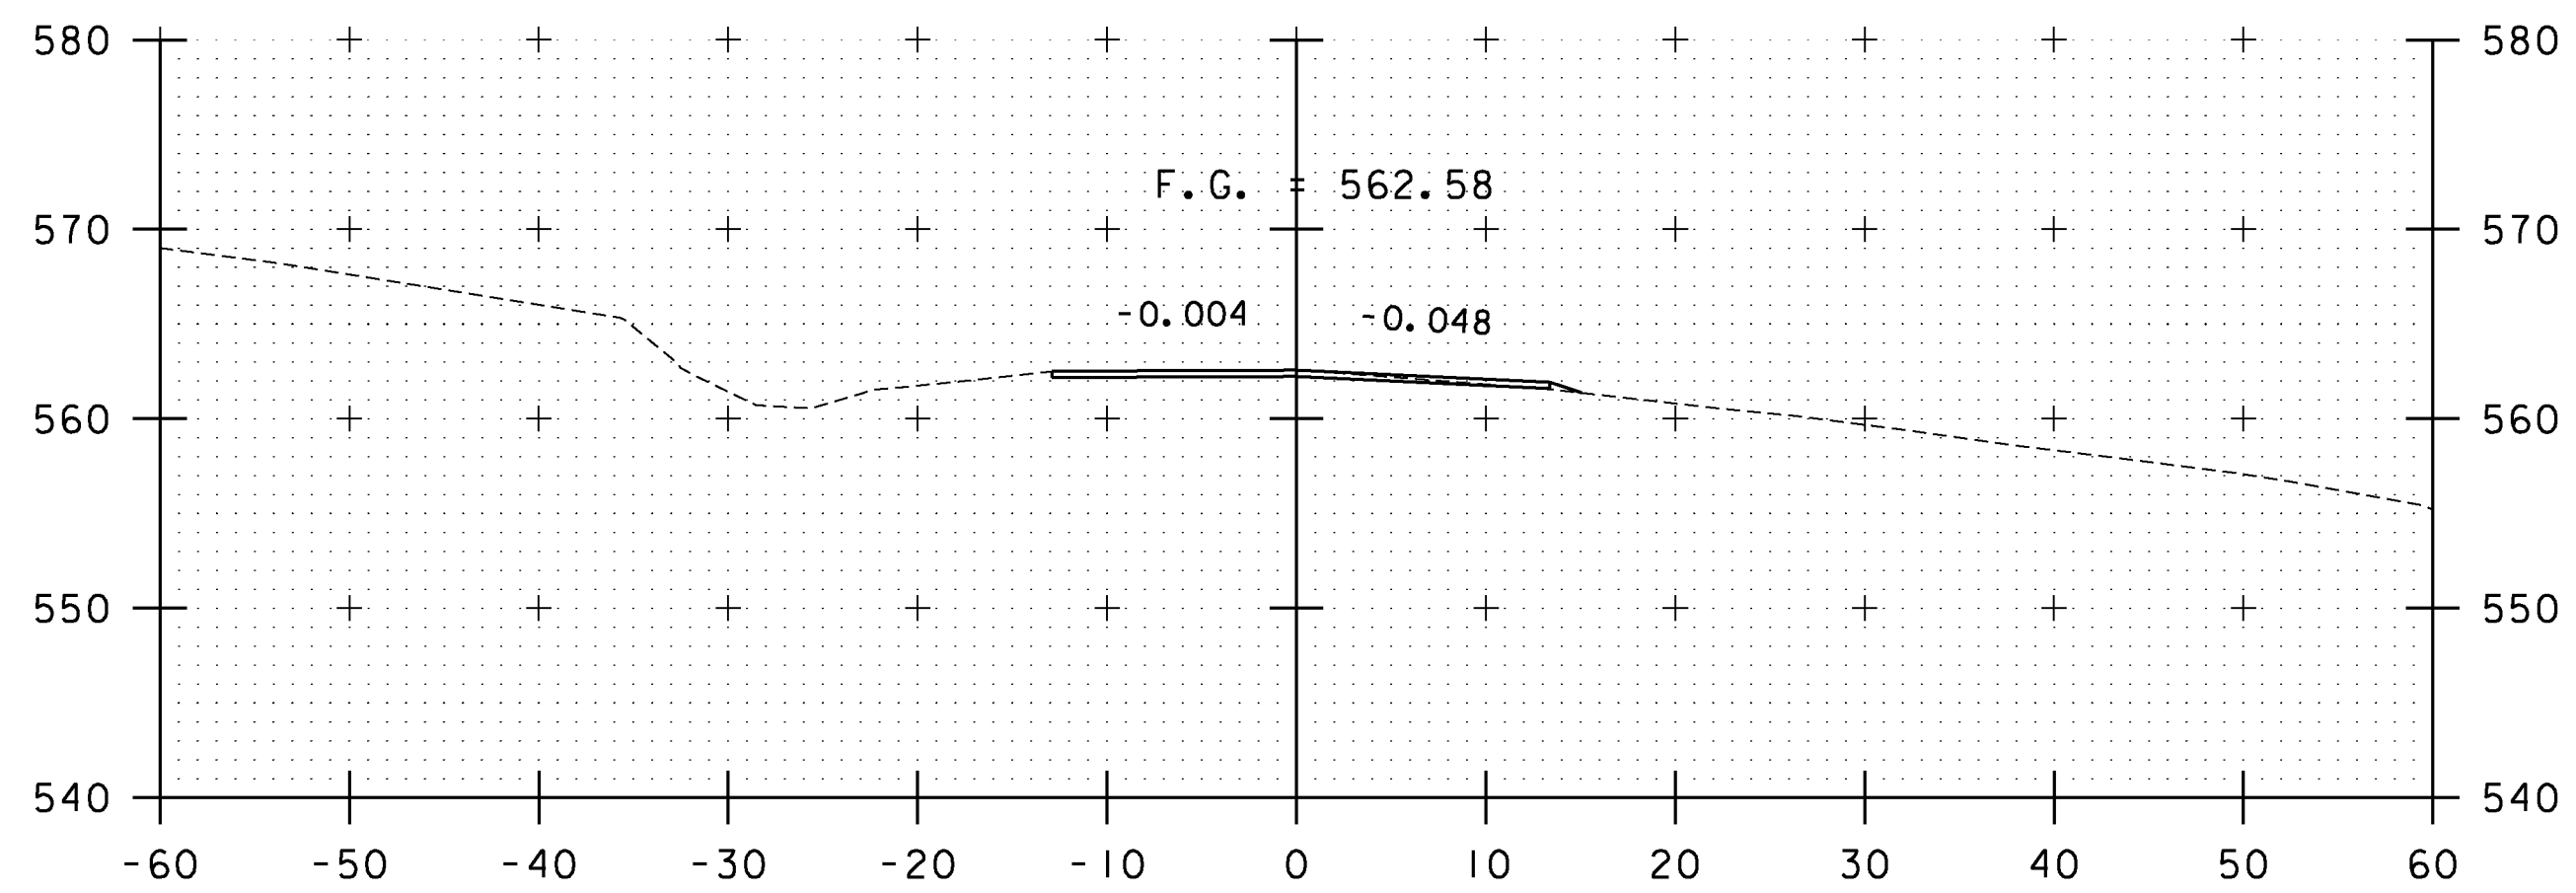

34+50

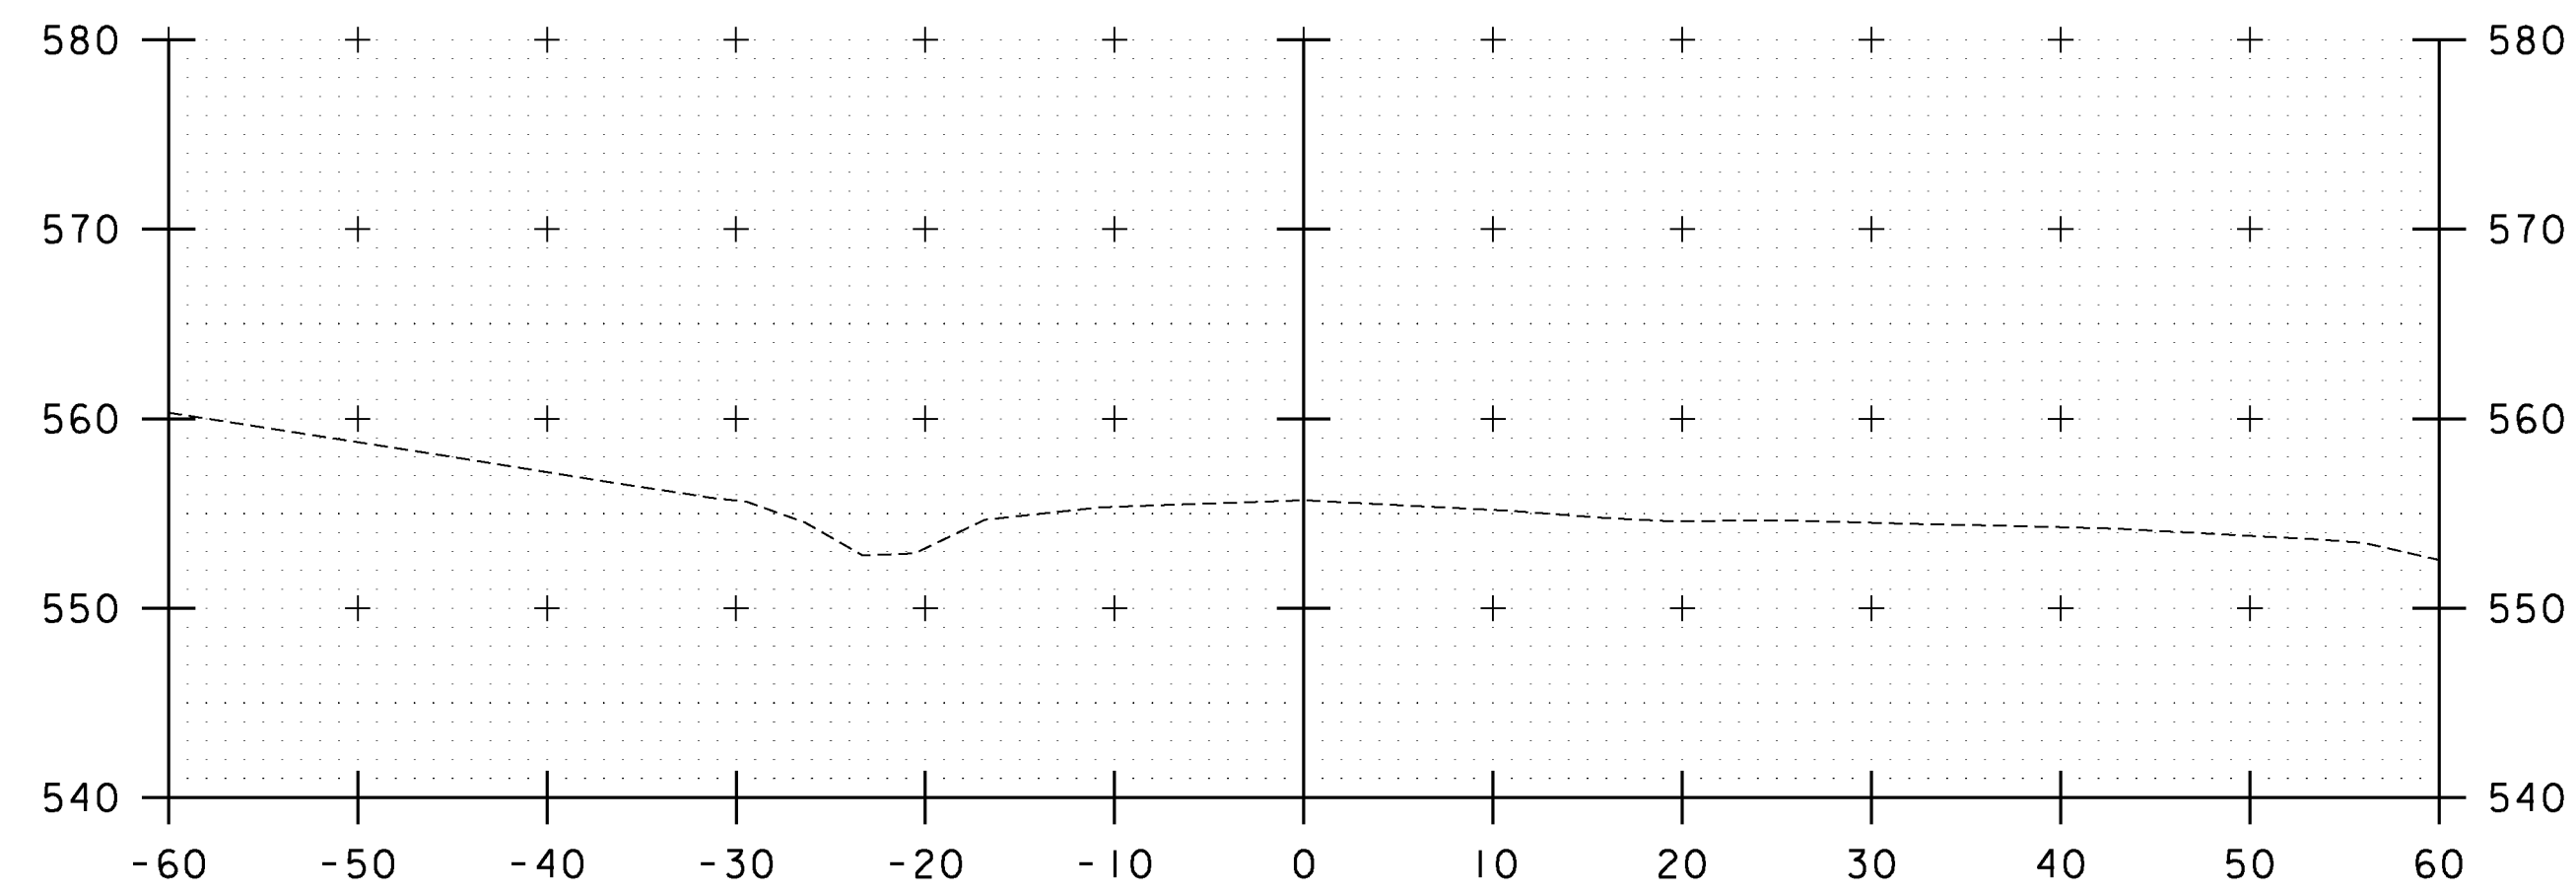


32+50

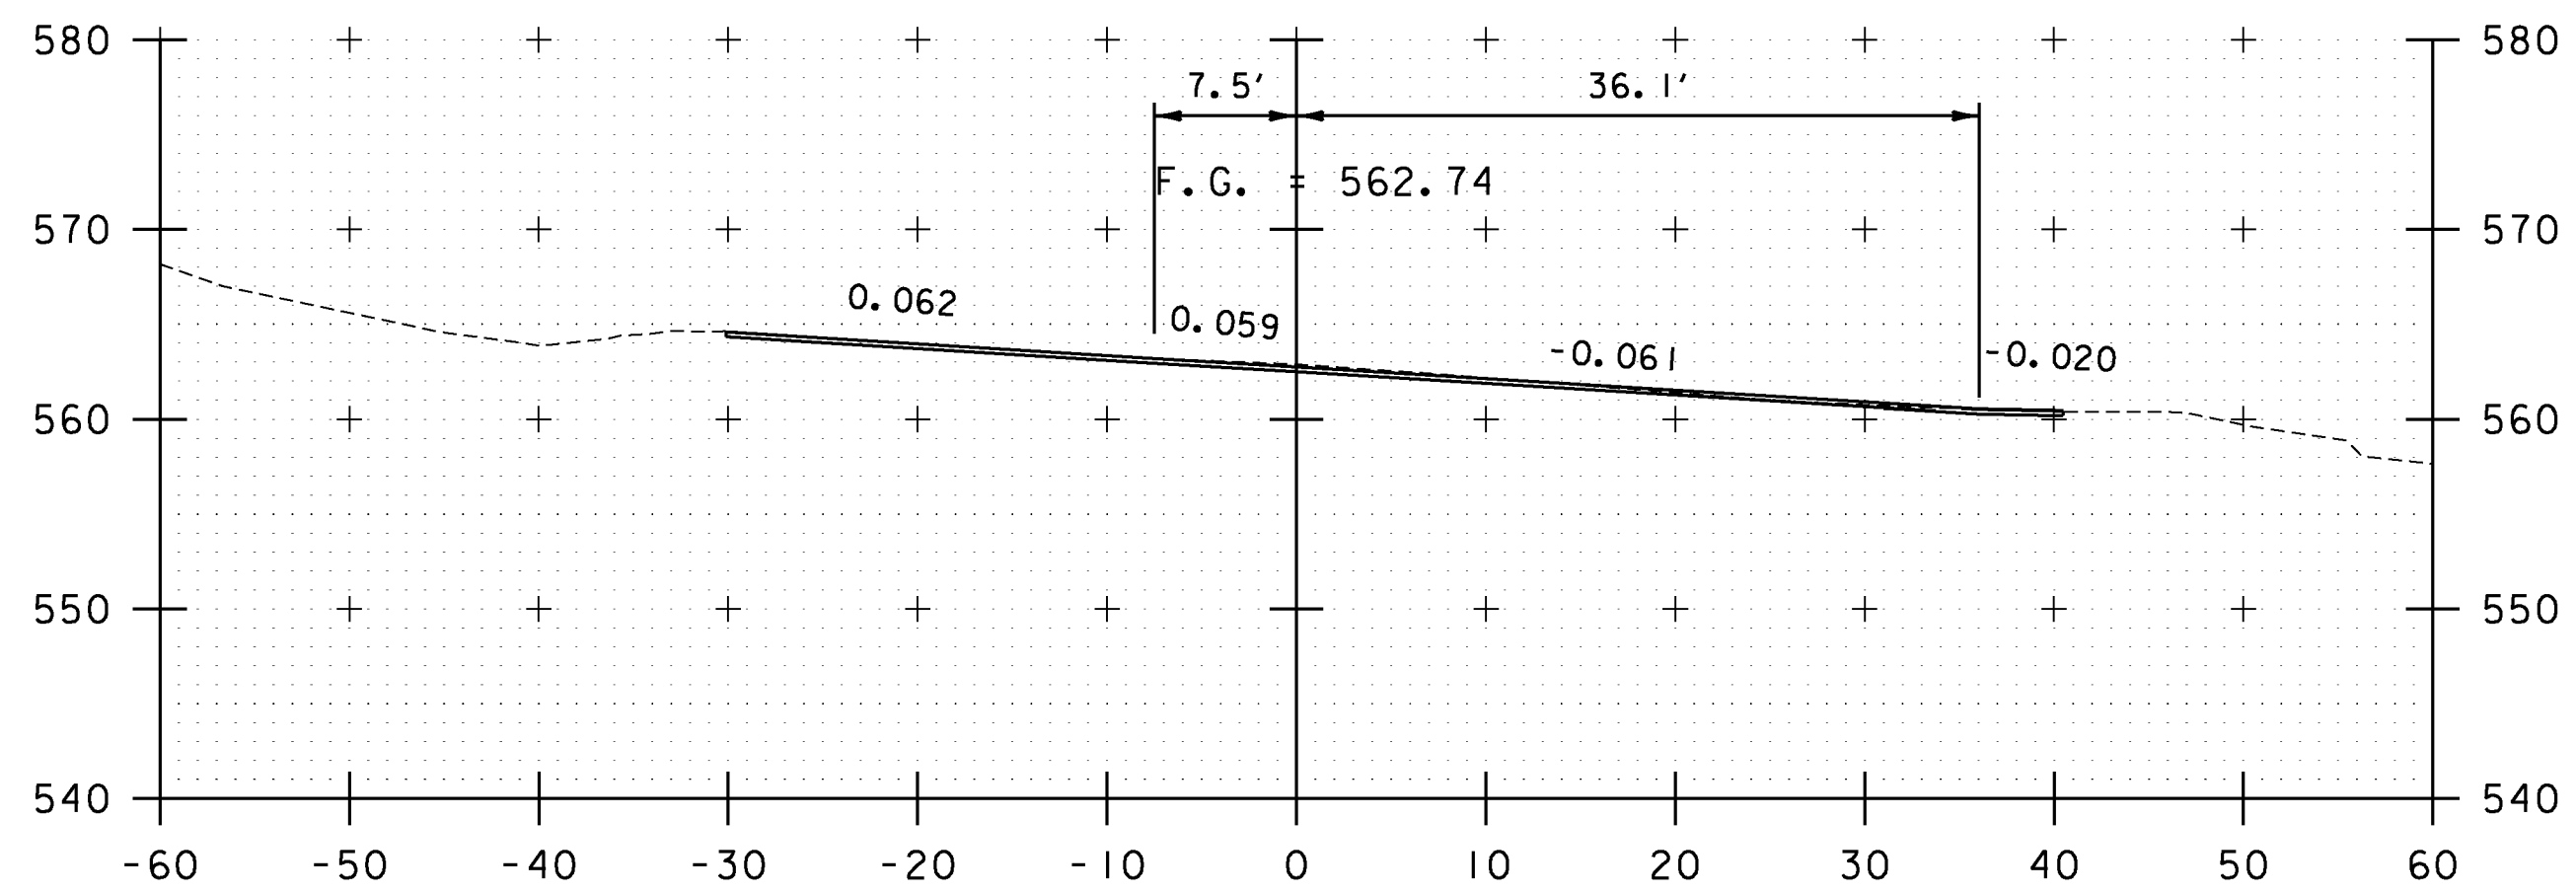

34+00

STA. 32+50 TO STA. 35+00

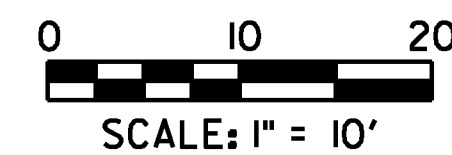

PROJECT NAME: ENOSBURG  
PROJECT NUMBER: BRO 1448(40)

FILE NAME: ...\\12 Cross Sections.dgn  
PROJECT LEADER: G. BOGUE  
DESIGNED BY: G. GOYETTE  
**T.H. 1 CROSS SECTIONS - TXS 1**

PLOT DATE: 10/4/2013  
DRAWN BY: E. ALLING  
CHECKED BY: G. GOYETTE  
SHEET 35 OF 46