



50+25

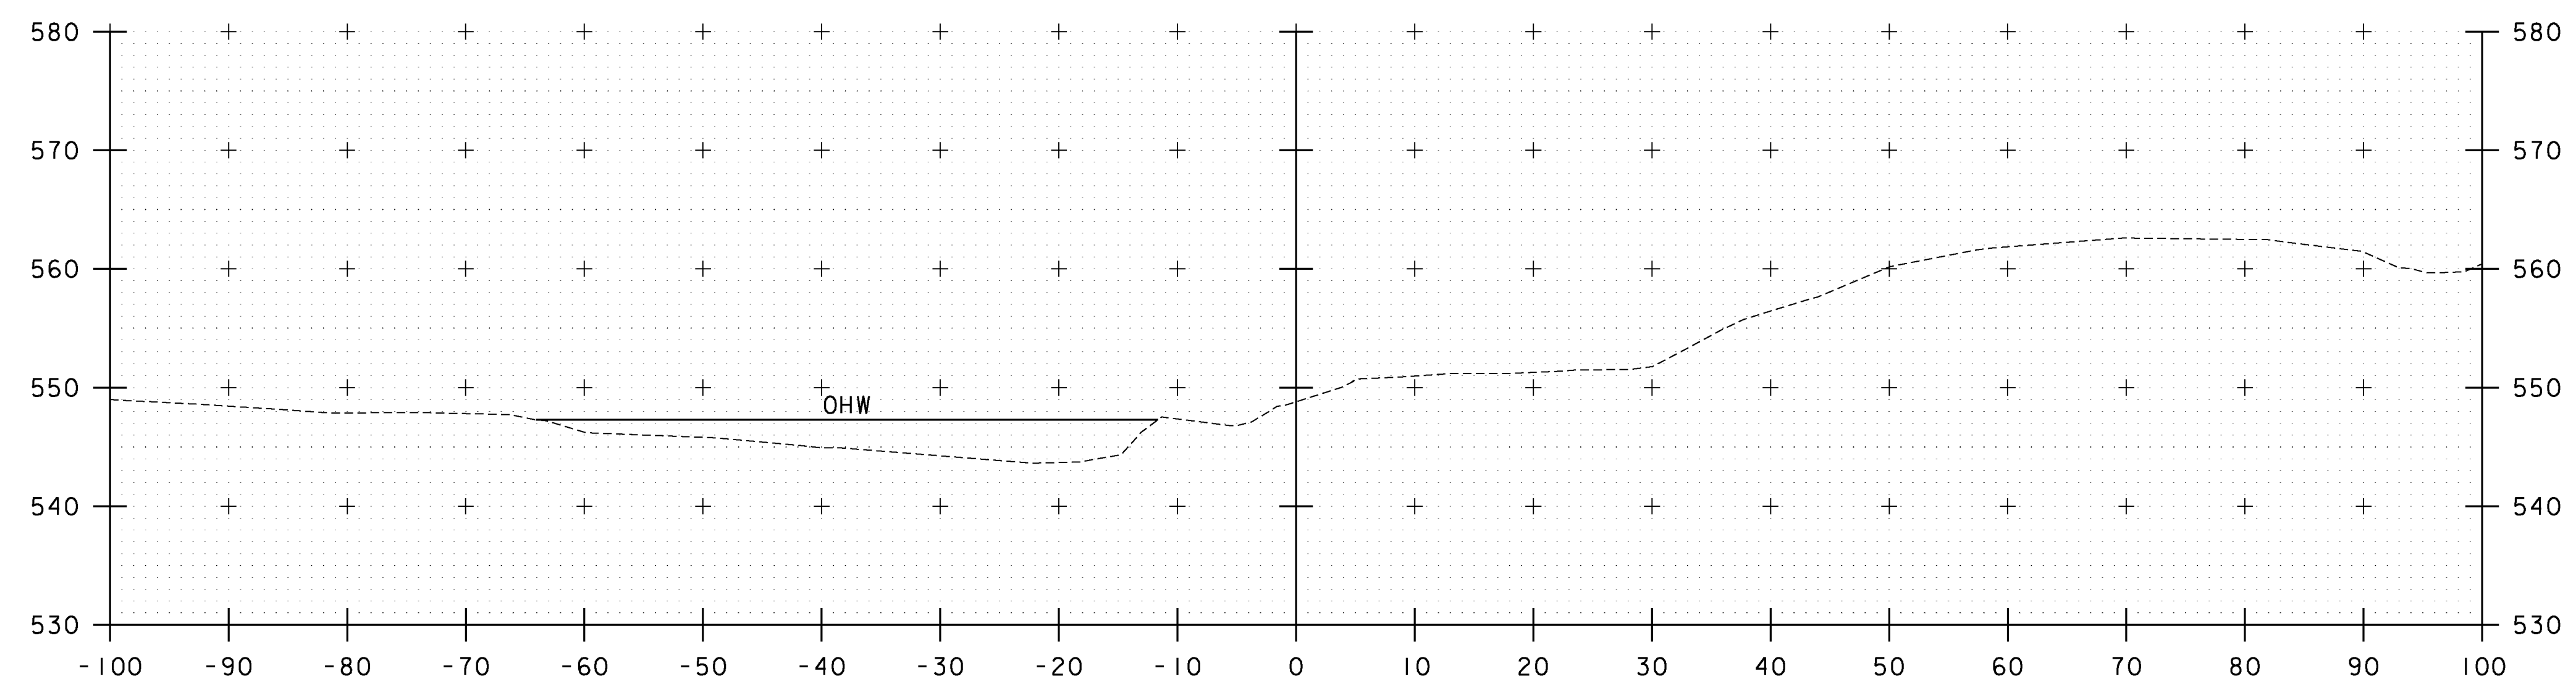

50+00

STA. 50+00 TO STA. 50+25

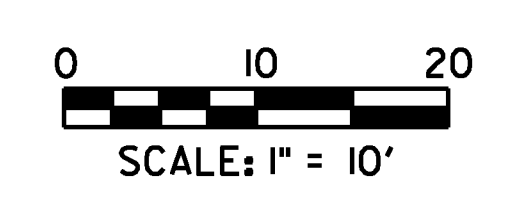

PROJECT NAME:	ENOSBURG
PROJECT NUMBER:	BRO 1448(40)
FILE NAME: ...13 ChannelCross Sections.dwg	LOT DATE: 10/4/2013
PROJECT LEADER: G. BOGUE	DRAWN BY: E. ALLING
DESIGNED BY: G. GOYETTE	CHECKED BY: G. GOYETTE
CHANNEL CROSS SECTIONS - CXS 1	SHEET 36 OF 46