


STA. 51+00 TO STA. 51+14

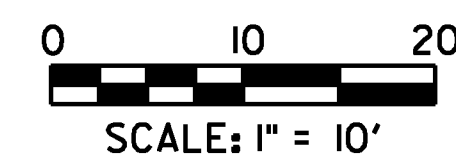

PROJECT NAME:	ENOSBURG
PROJECT NUMBER:	BRO 1448(40)
FILE NAME:	...13 ChannelCross Sections.dwg
LOT DATE:	10/4/2013
PROJECT LEADER:	G. BOGUE
DRAWN BY:	E. ALLING
DESIGNED BY:	G. GOYETTE
CHECKED BY:	G. GOYETTE
CHANNEL CROSS SECTIONS - CXS 4	SHEET 39 OF 46