



Enosburg BRD 1448 (40)
 Structure Excavation, Granular Backfill
 Abutmen 2 ✓
 Drawn By: Alan Therrien
 Checked By: Jon Day

Enosburg BRD 1448 (40)
 ABUT #2
 STRUCTURE Exc.
 GRANULAR BACKFILL

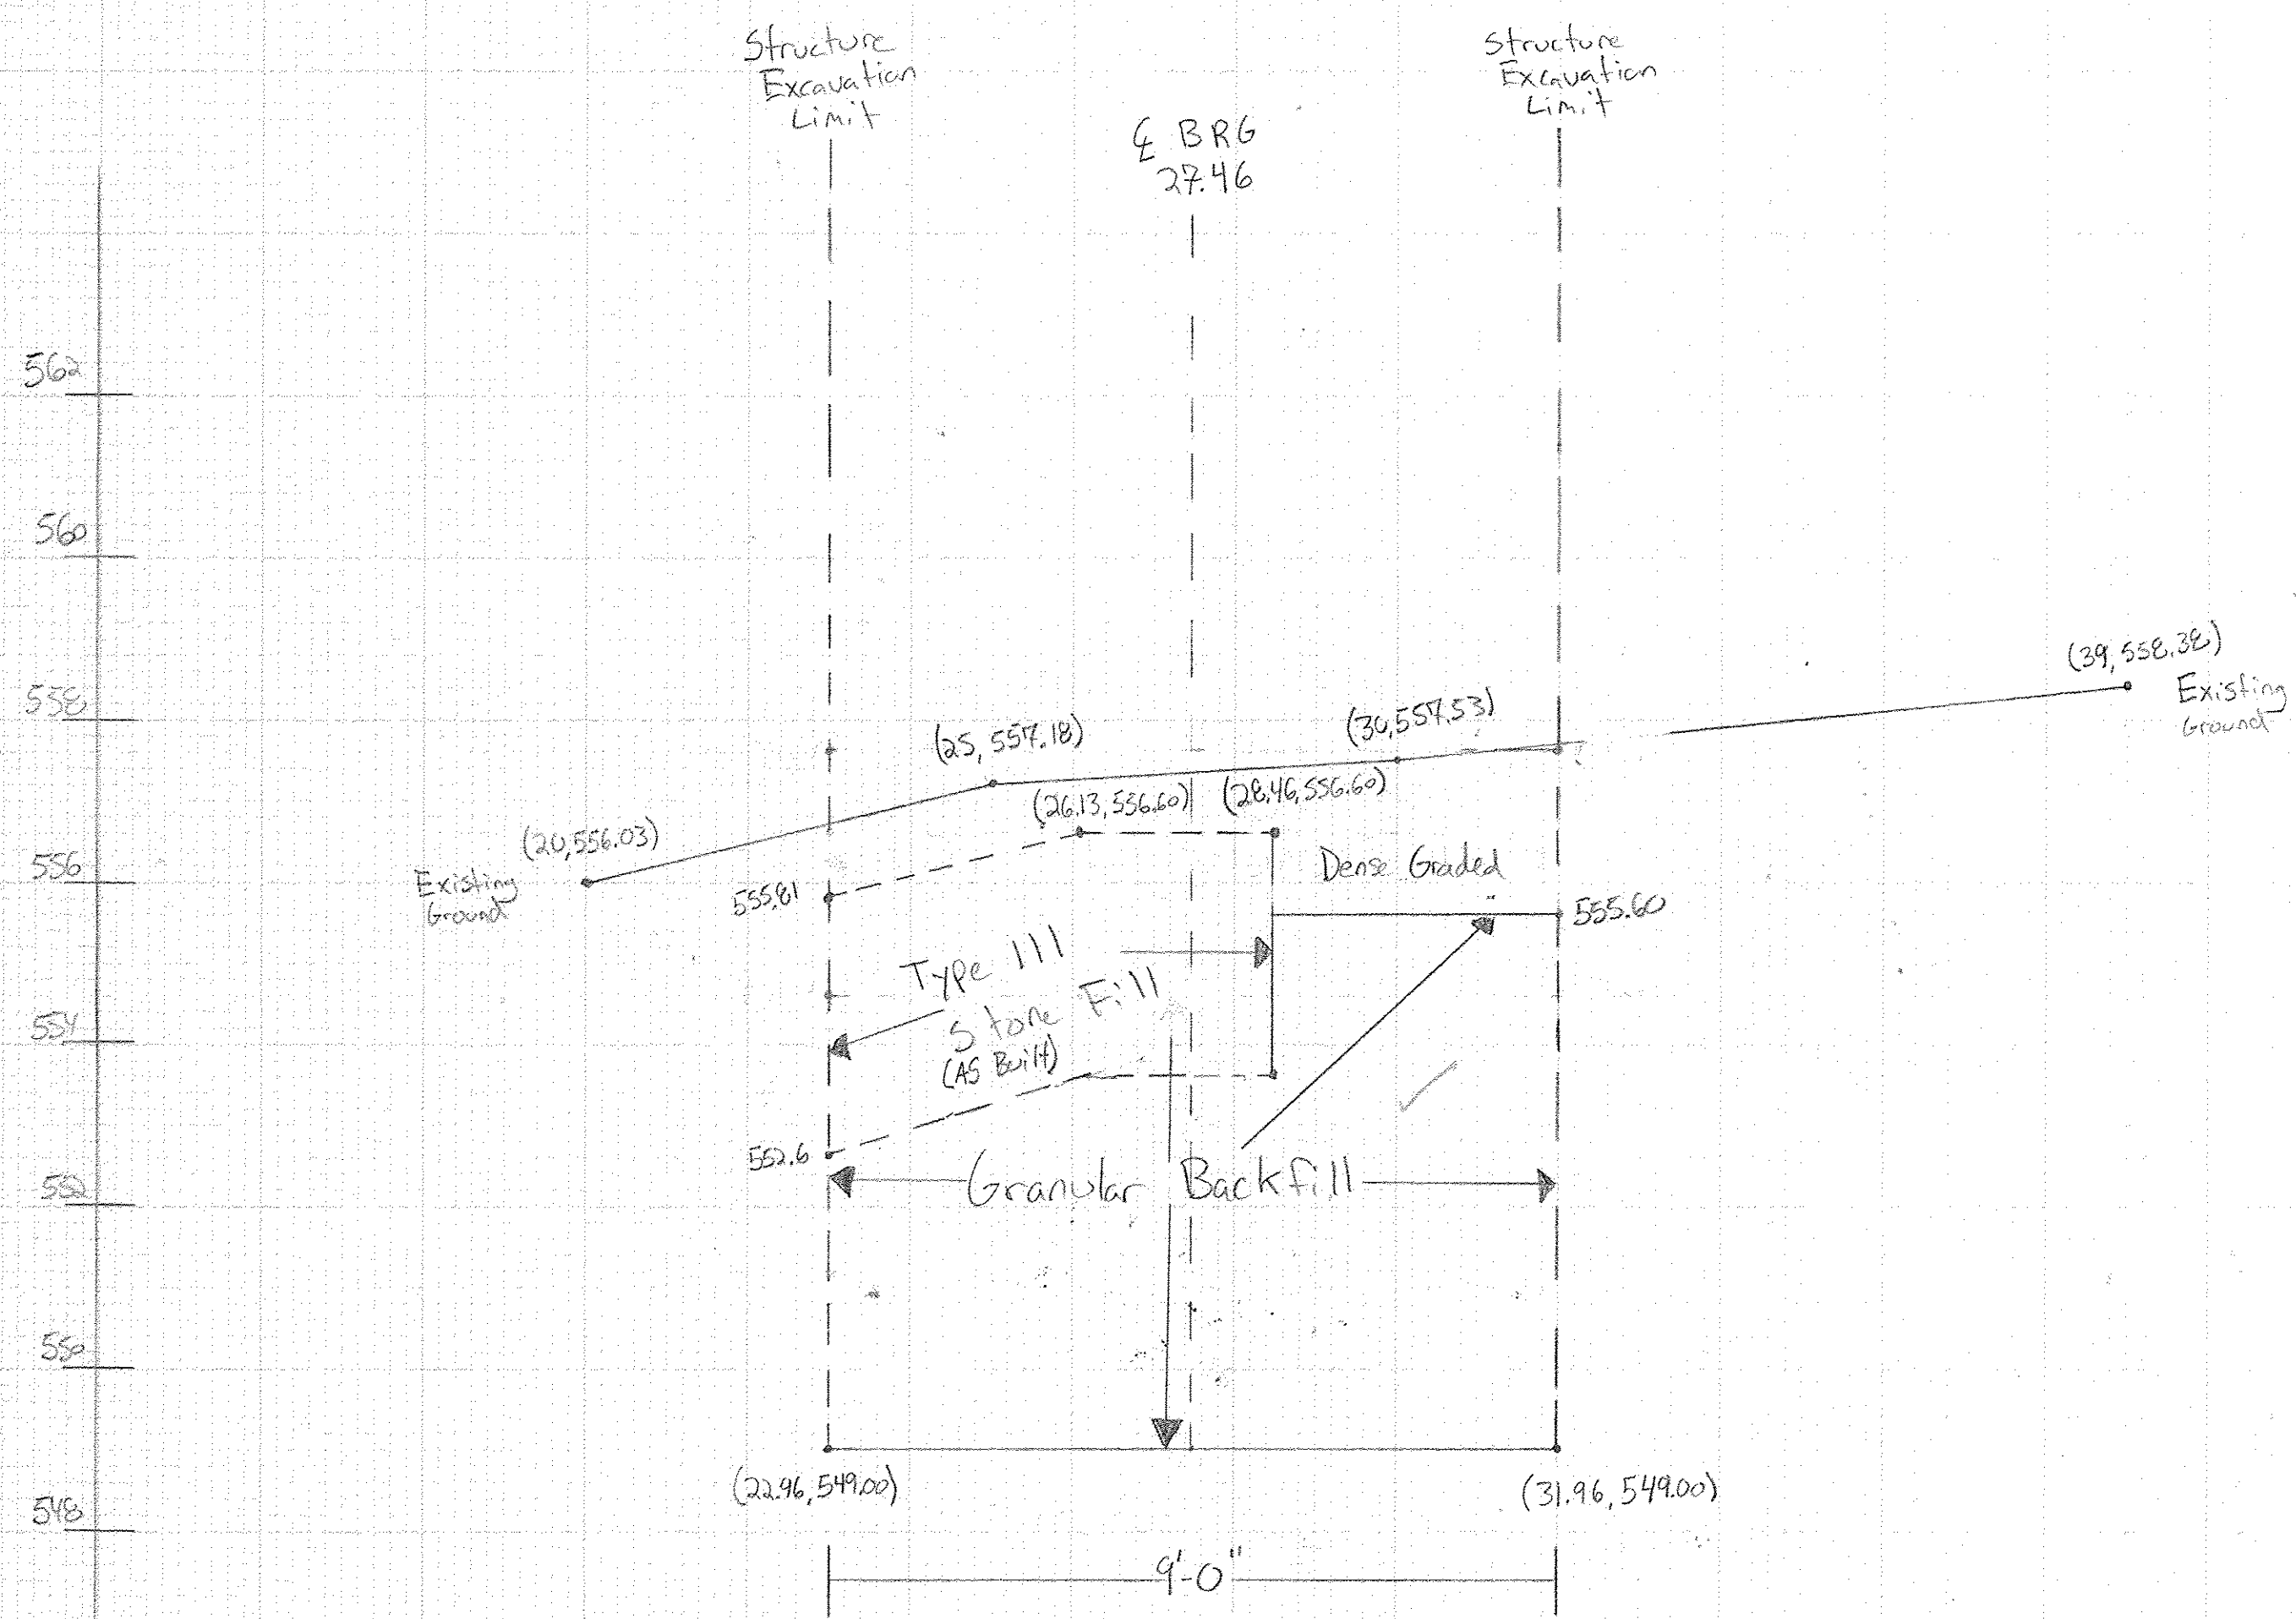

END AREAS:

STRUCTURE Exc.	74.86 SF
GBFS	46.70 SF

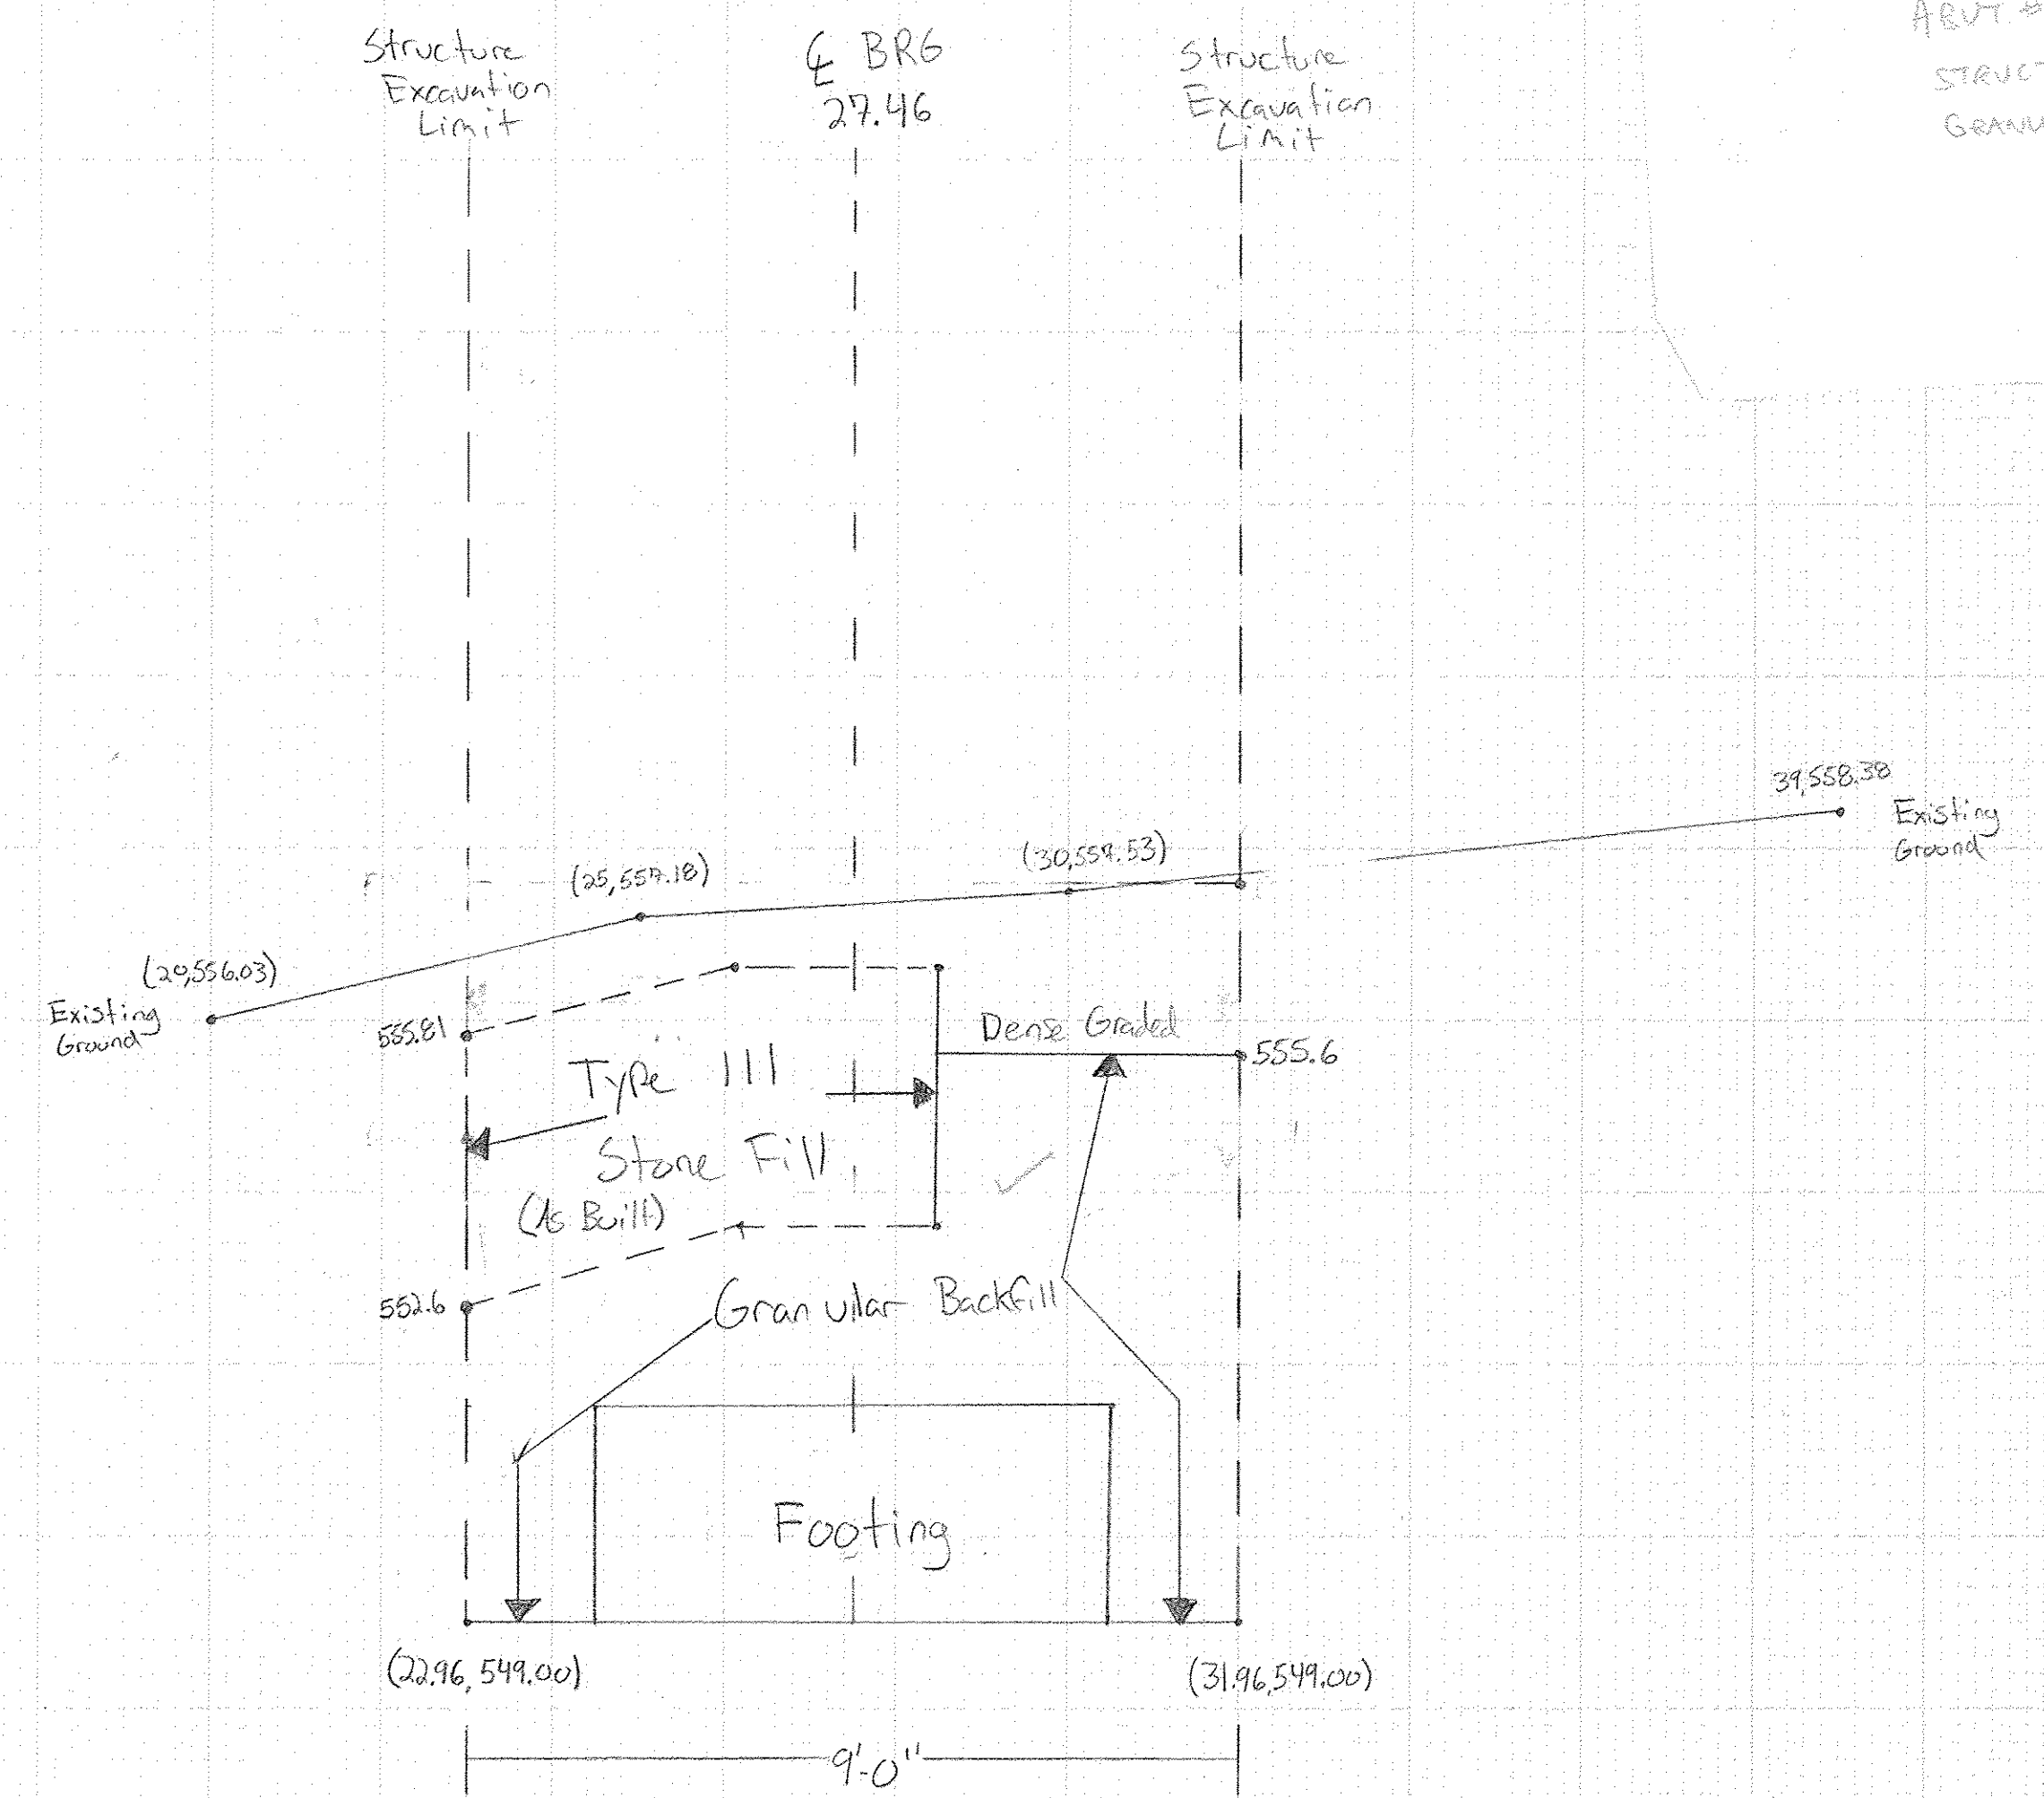

END AREAS:

STRUCTURE Exc.	74.86 SF
GBFS BK	46.70 SF
GBFS AH	31.70 SF

