



Enosburg BRO 1448 (40)
 Structure Excavation, Granular Backfill
 Abutment 2
 Drawn By: Alan Therrien
 Checked By: Jon Day

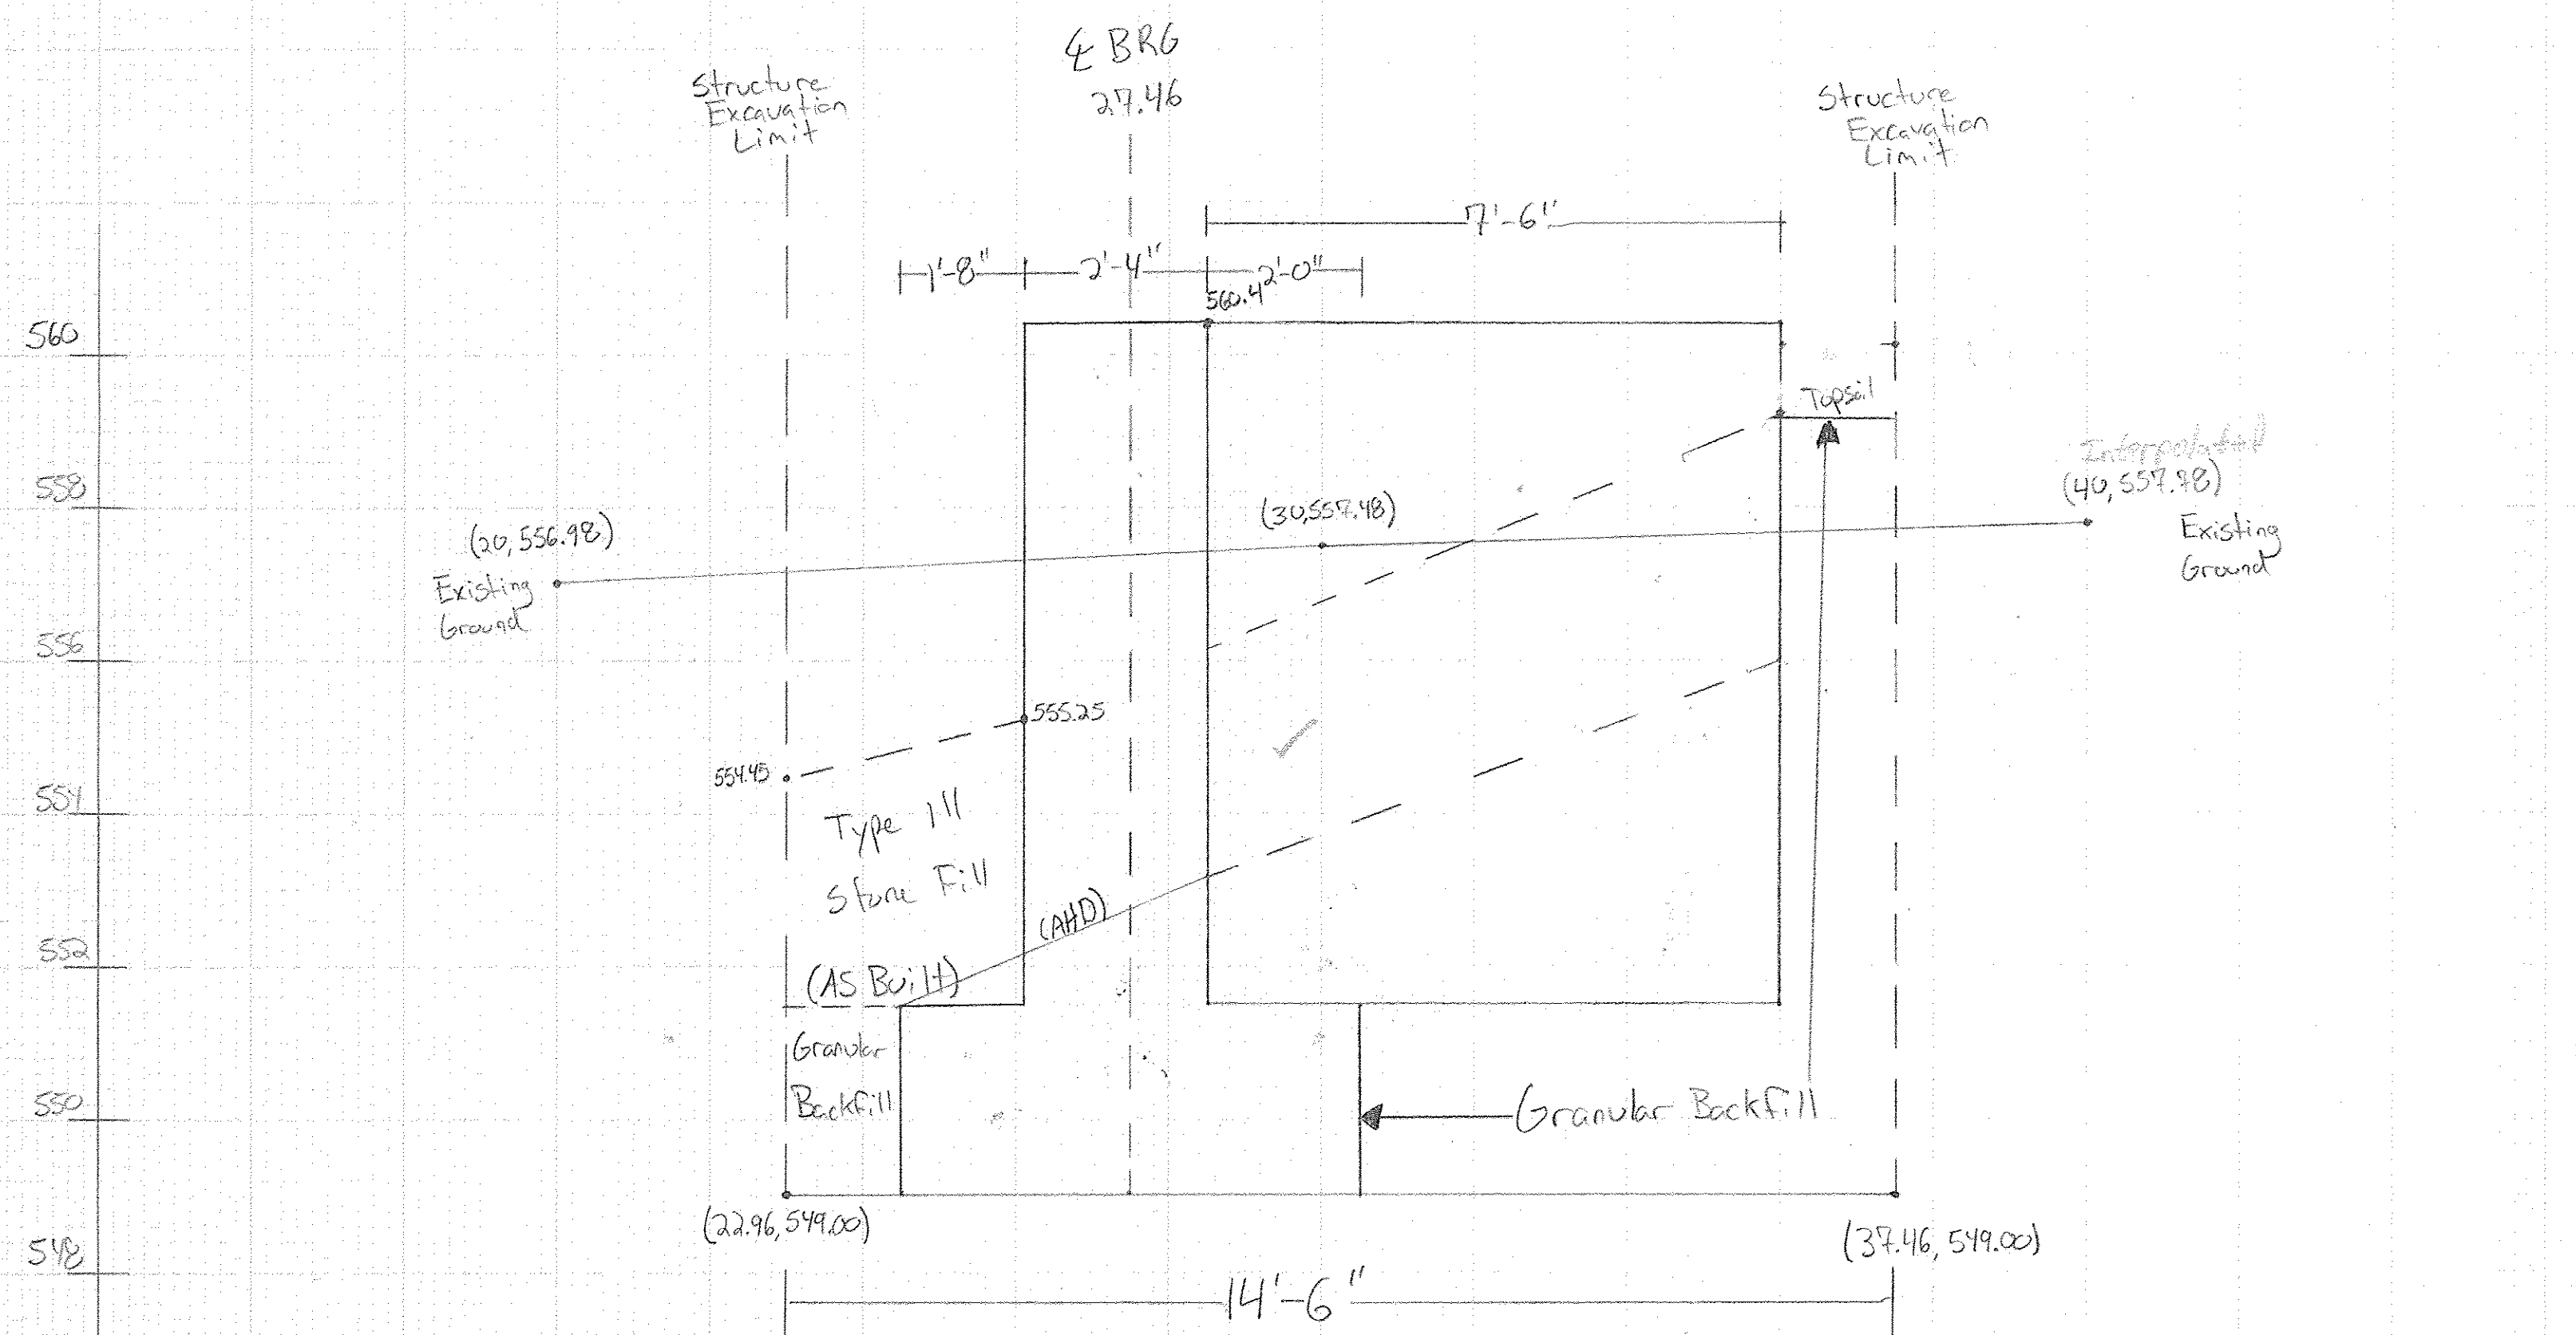

END AREAS:

STRUCTURE EXC.		122.80 SF
GBFS BK		27.97 SF
GBFS AH		73.37 SF

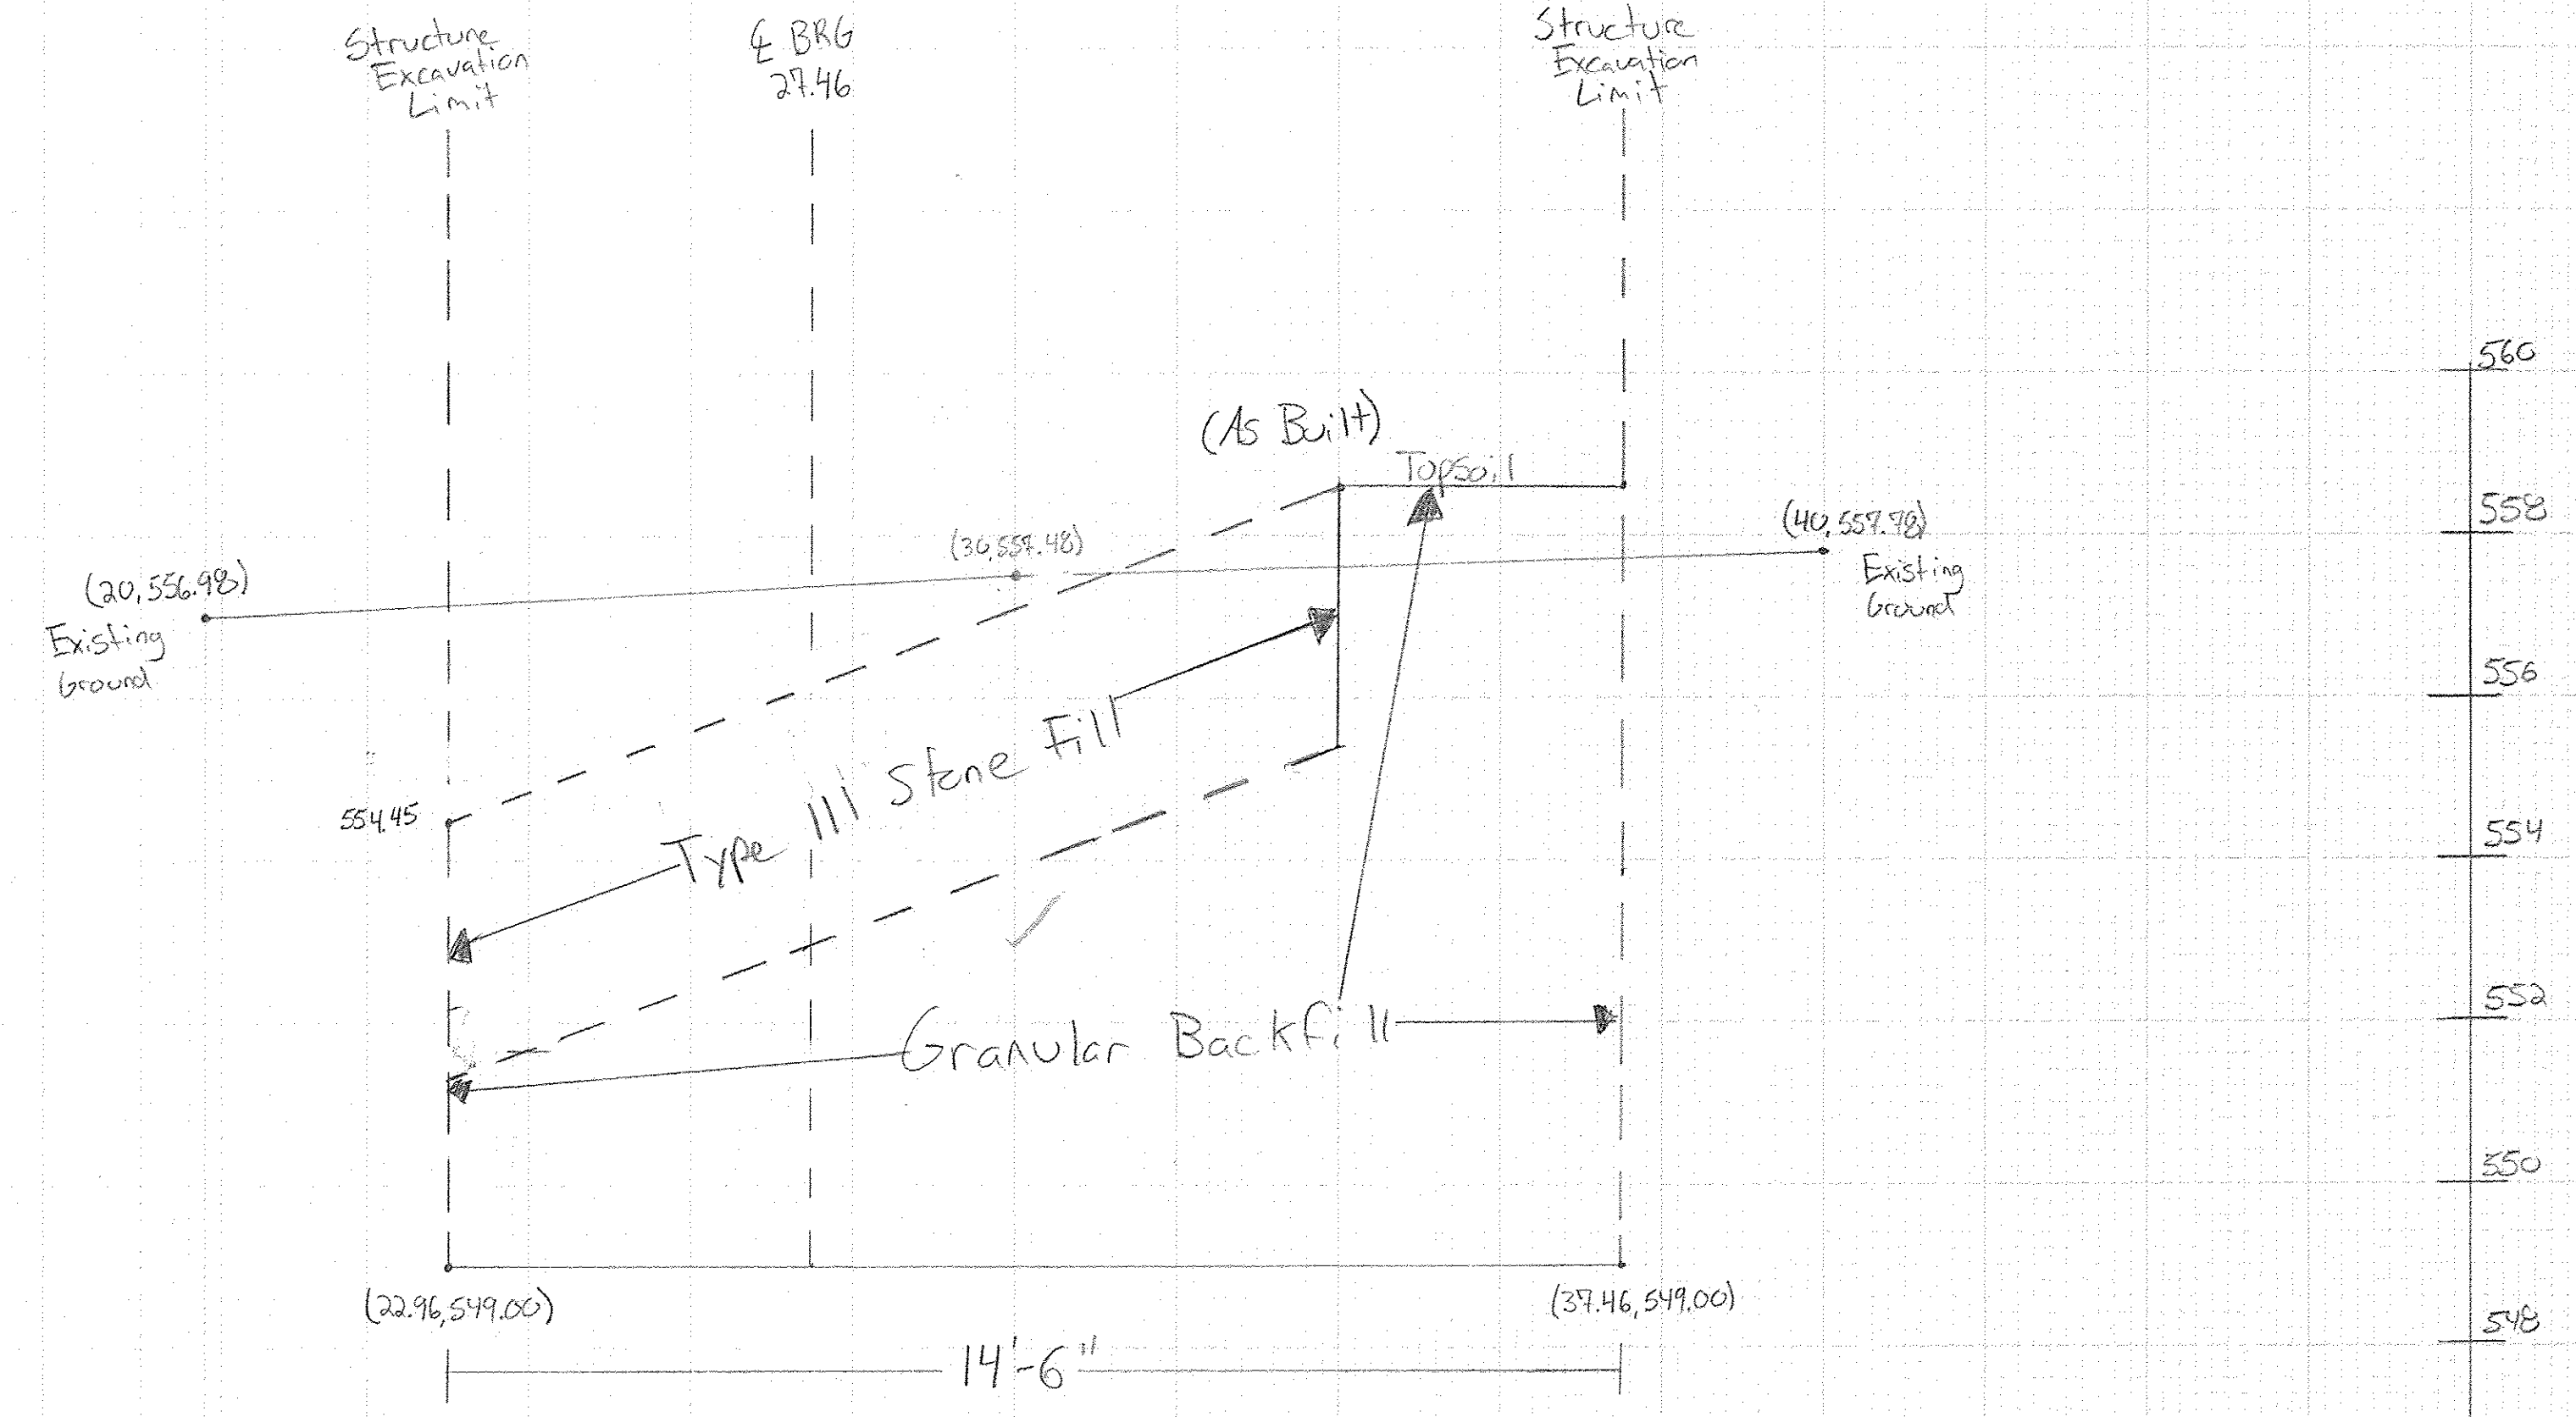

STRUCTURE EXC.		122.80 SF
GBFS BK		81.24 SF

✓ JFD 08-13-14