


FINAL SURVEY  
 BY: [Signature]  
 DATE: [Date]  
 PROJECT: [Project Name]  
 SHEET: [Sheet Number]

ORIGINAL SURVEY  
 BY: [Signature]  
 DATE: [Date]  
 PROJECT: [Project Name]  
 SHEET: [Sheet Number]

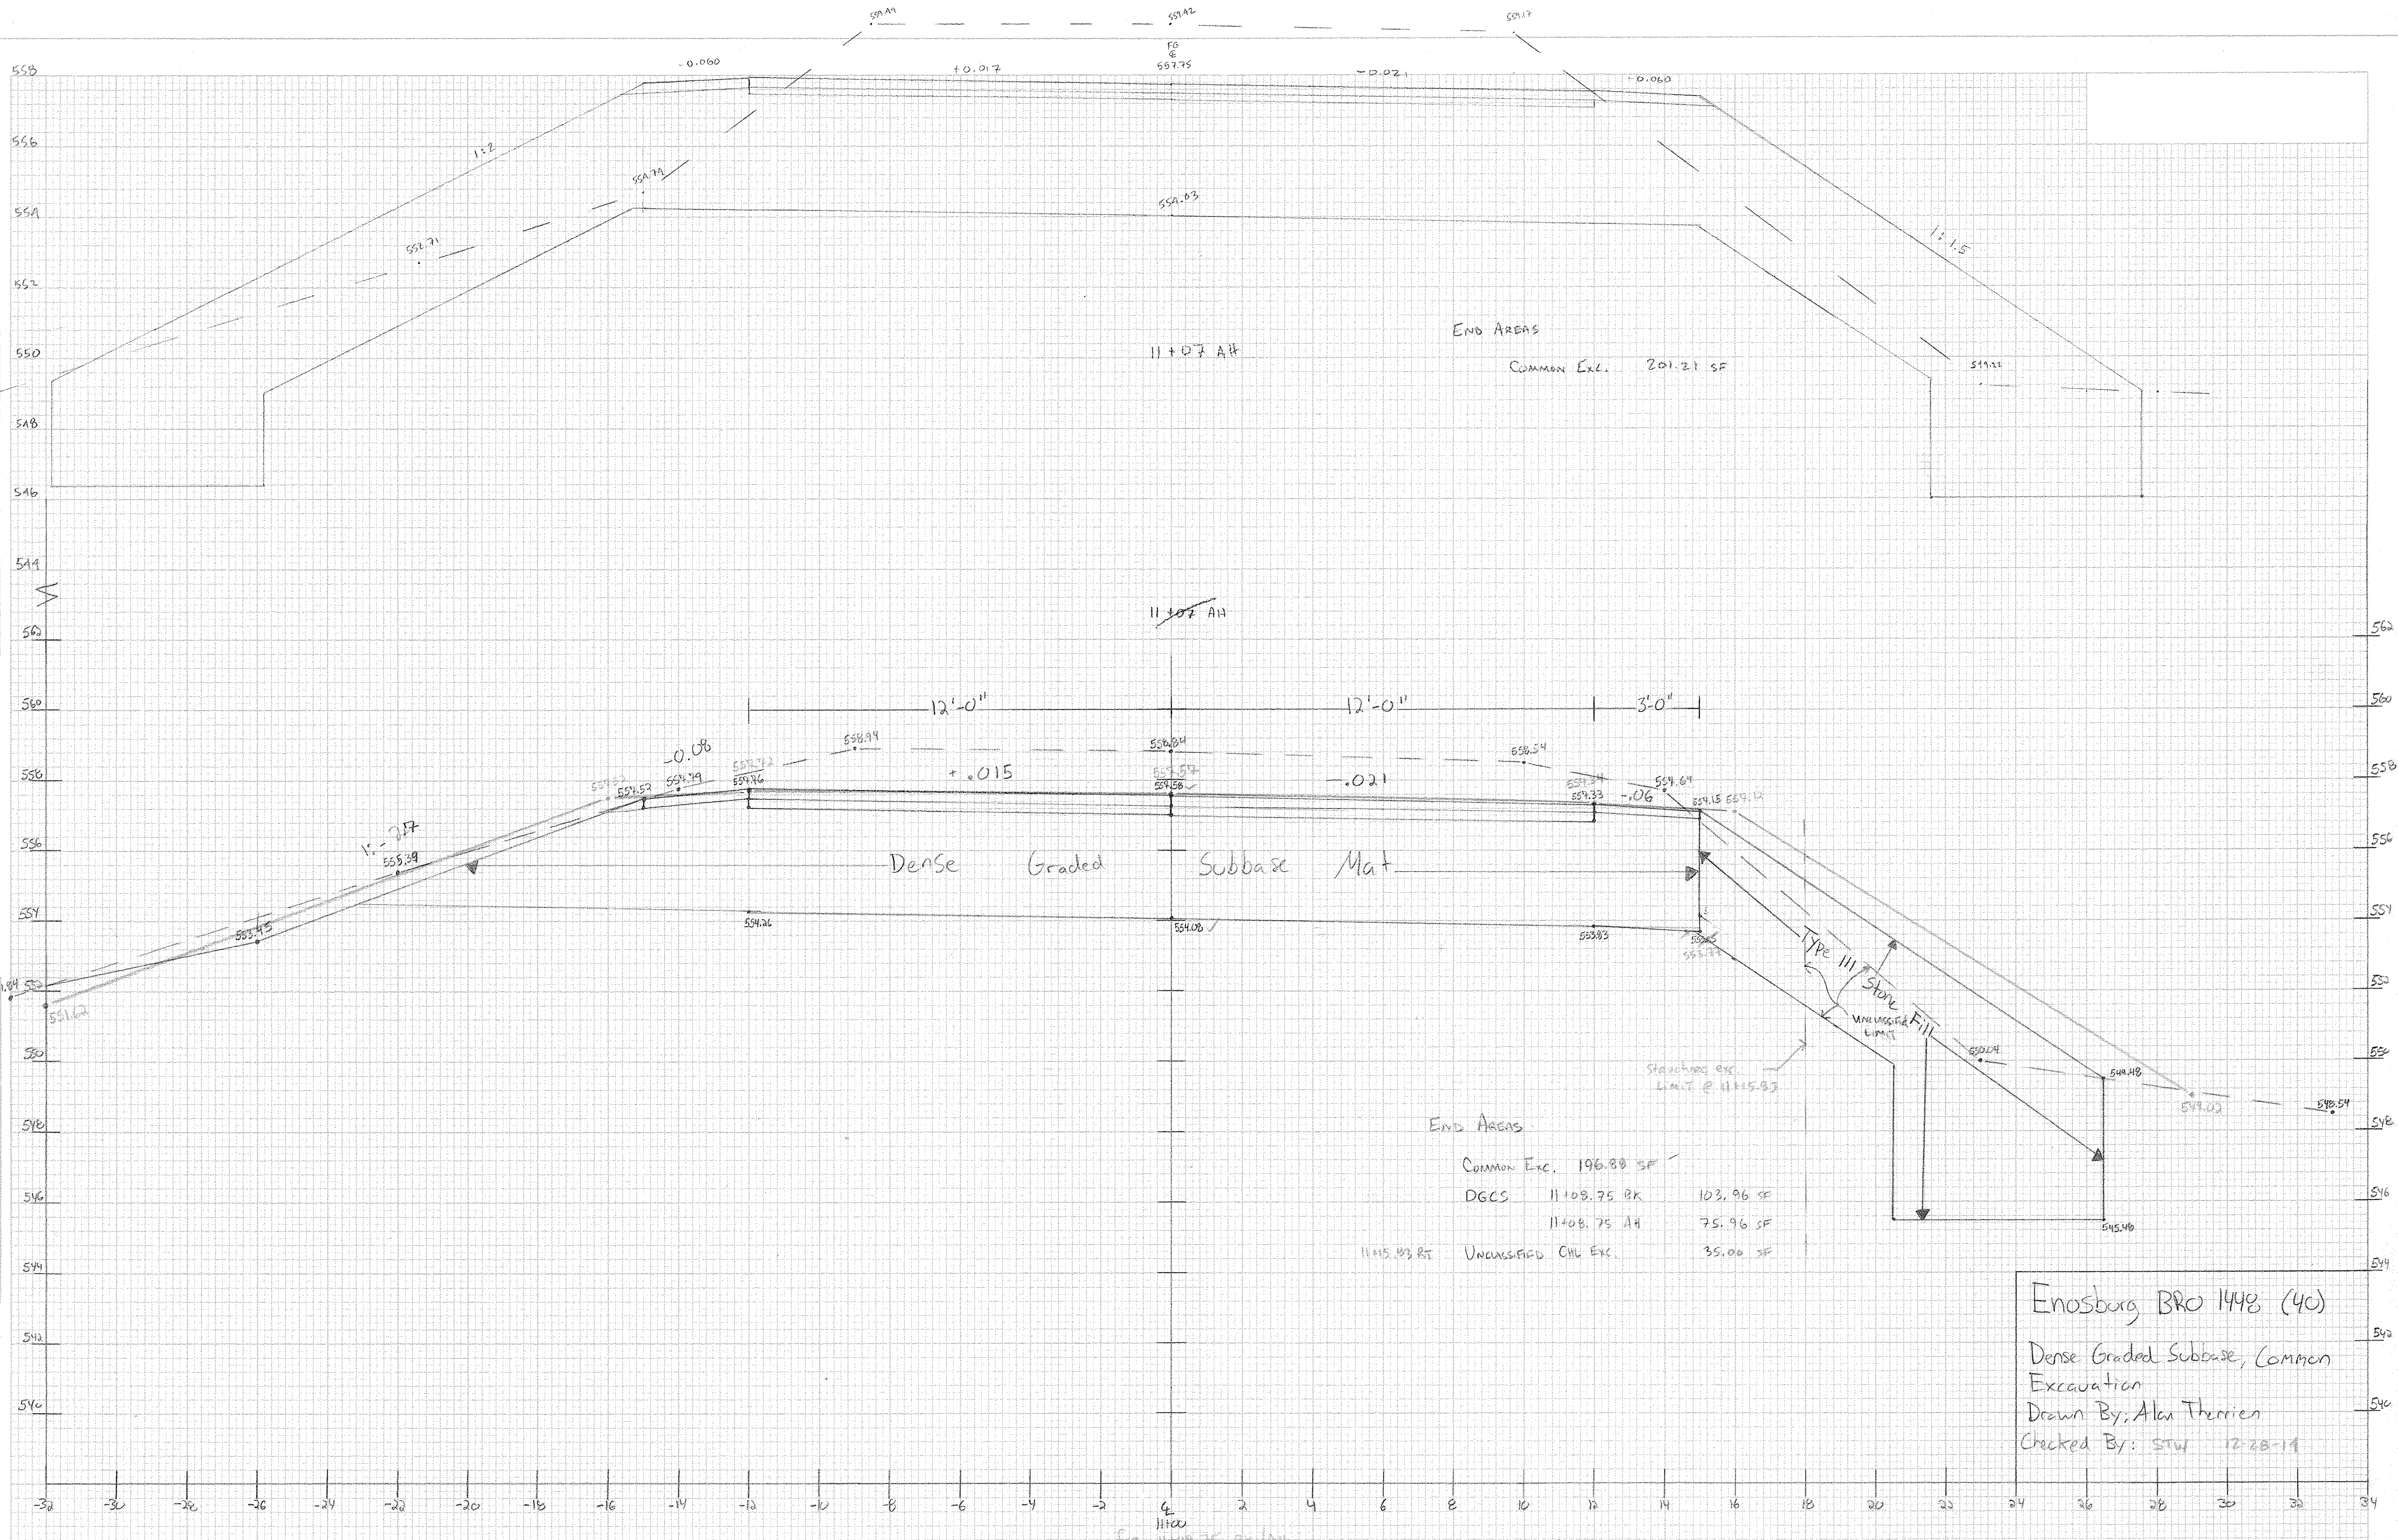

END AREAS

Common Exc.	196.88 SF
DGCS 11+08.75 BK	103.96 SF
11+08.75 AH	75.96 SF
11+15.43 RT UNCLASSIFIED CHL Exc.	35.06 SF

Enosburg BRO 1448 (40)  
 Dense Graded Subbase, Common  
 Excavation  
 Drawn By: Alan Therrien  
 Checked By: STW 12-28-11