


FINAL SURVEY
 DATE: _____
 BY: _____
 PROJECT: _____
 SHEET NO.: _____

ORIGINAL SURVEY
 DATE: _____
 BY: _____
 PROJECT: _____
 SHEET NO.: _____

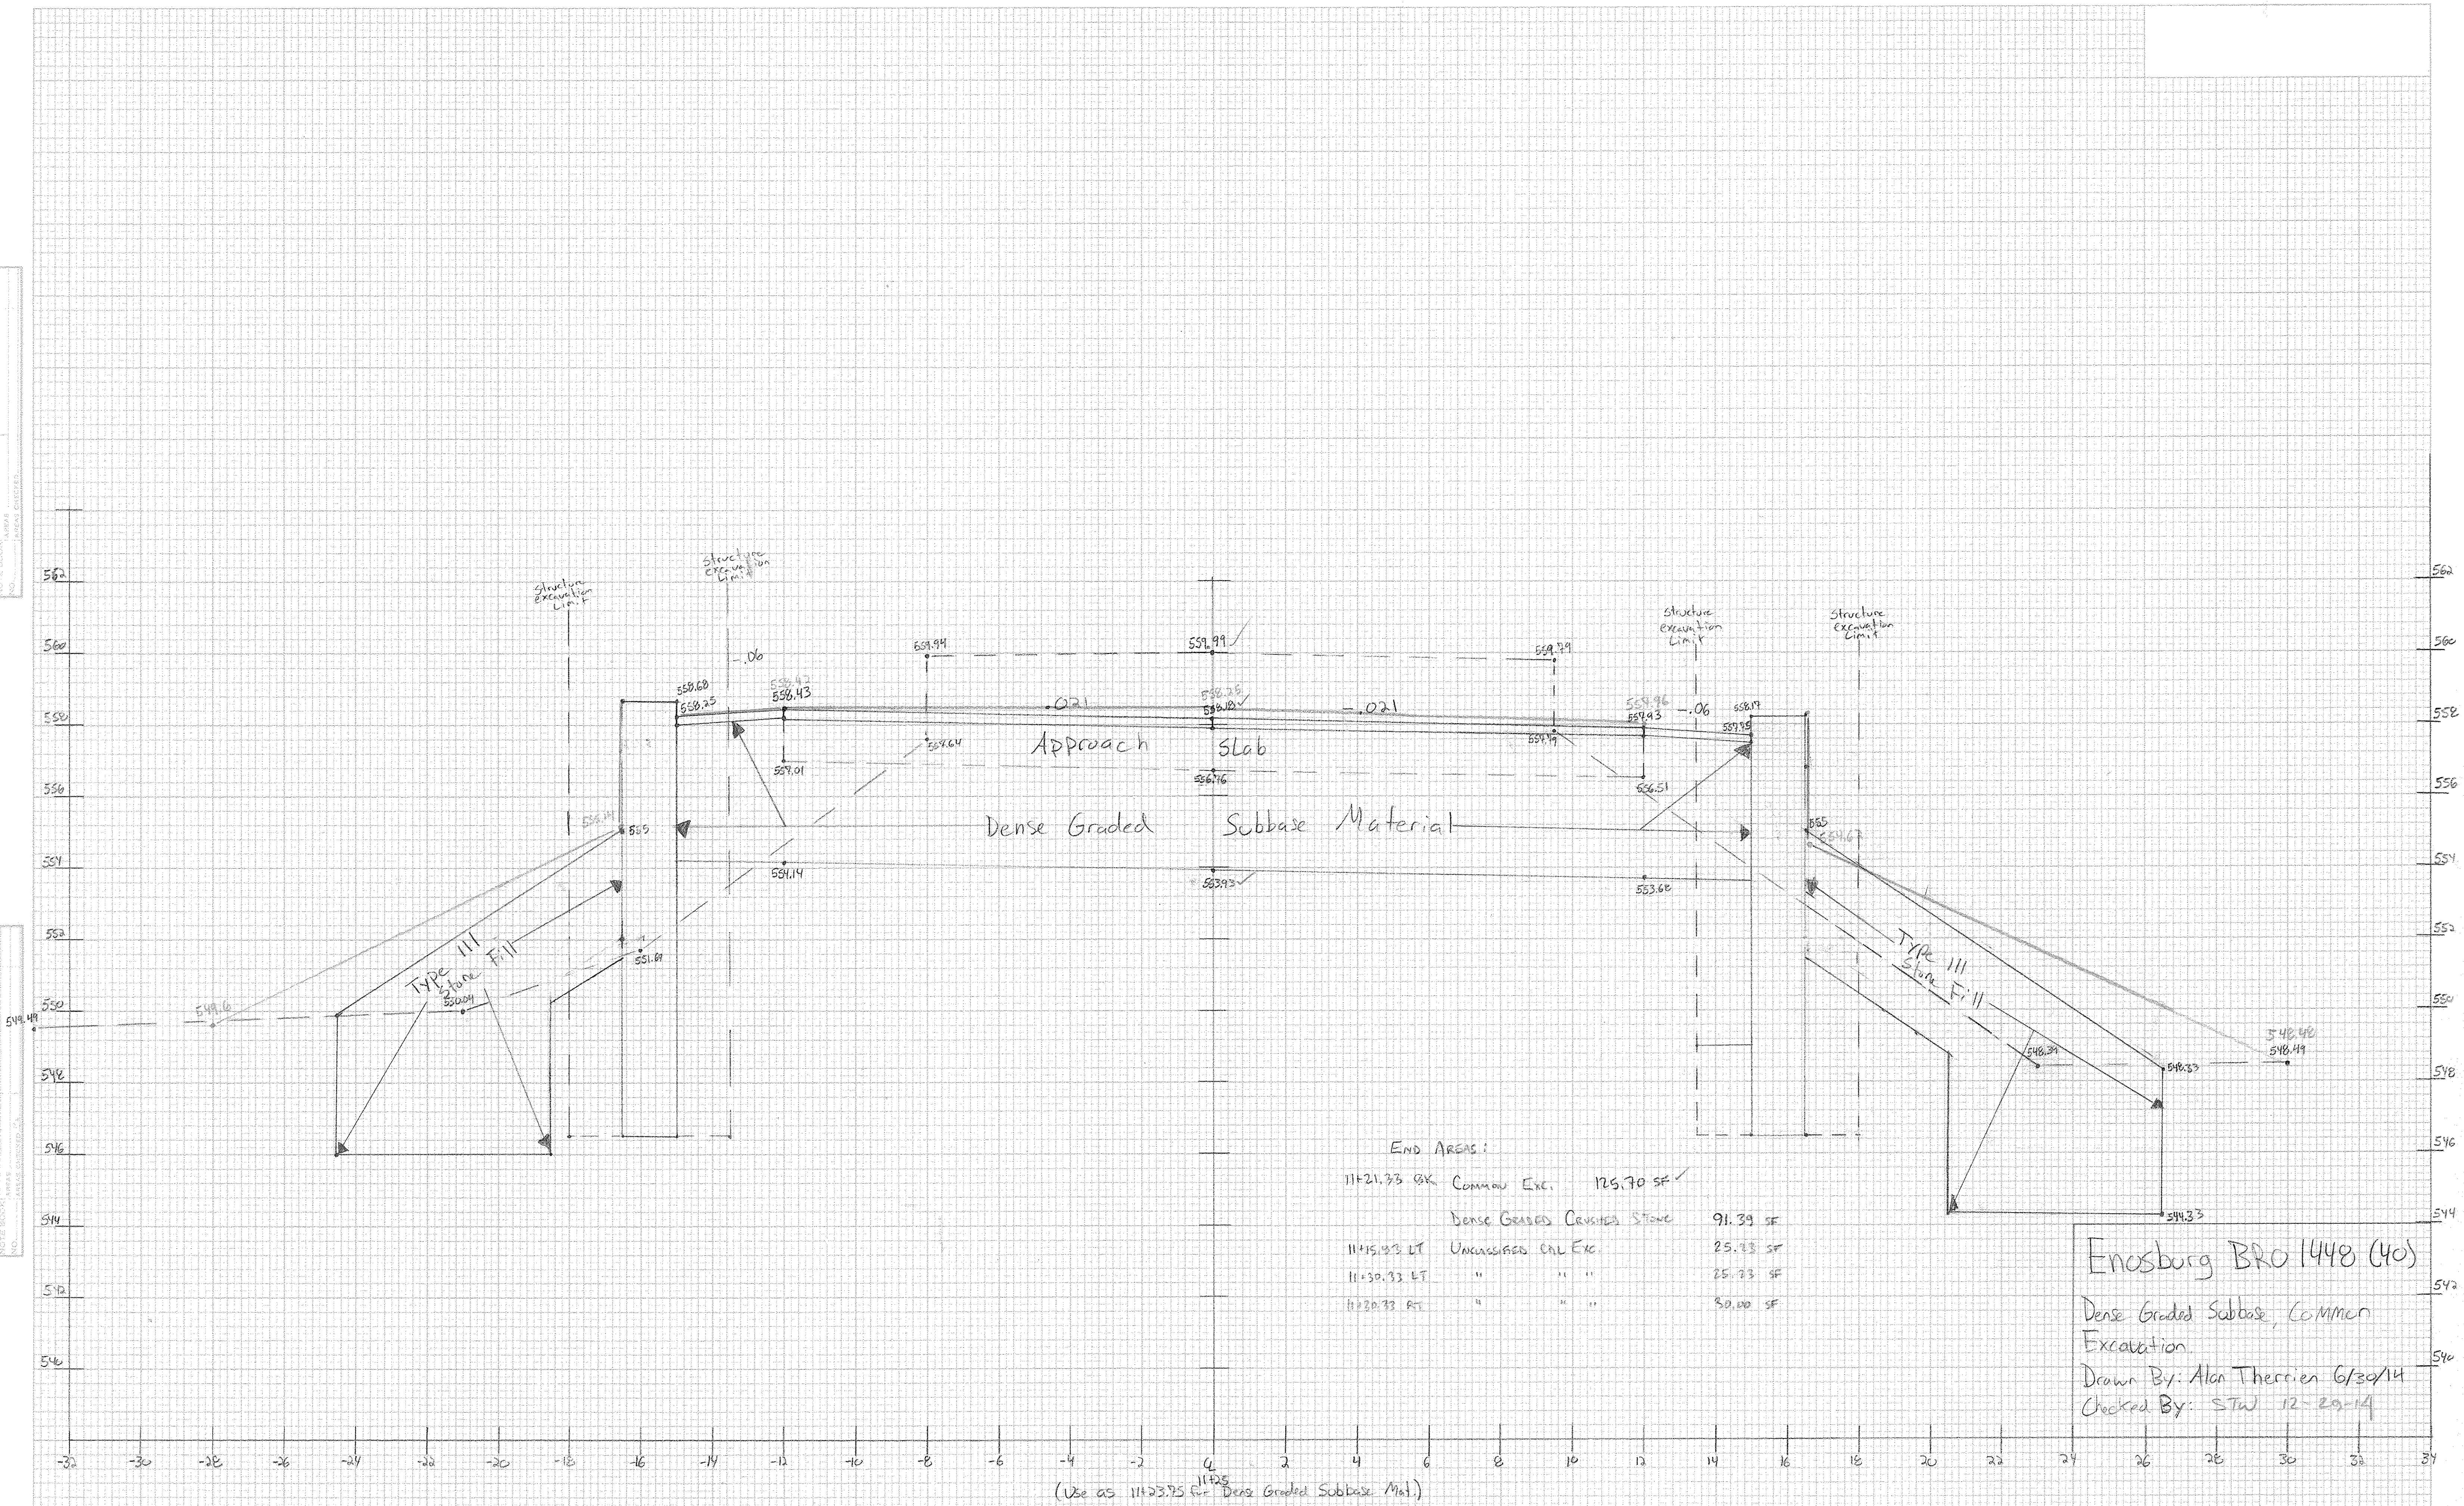

END AREAS:

11+21.33 GR	COMMON EXC.	125.70 SF
11+15.03 LT	UNCLASSIFIED C&G EXC.	25.33 SF
11+30.33 LT	" " "	25.33 SF
11+20.33 RT	" " "	30.00 SF

Enosburg BRO 1448 (40)
 Dense Graded Subbase, Common
 Excavation
 Drawn By: Alan Therrien 6/30/14
 Checked By: STW 12-29-14

(Use as 11+23.75 for Dense Graded Subbase Mat.)