


FINAL SURVEY PLOTTED  
 DATE: 6/30/14  
 NO. 1448

ORIGINAL SURVEY PLOTTED  
 DATE: 6/30/14  
 NO. 1448

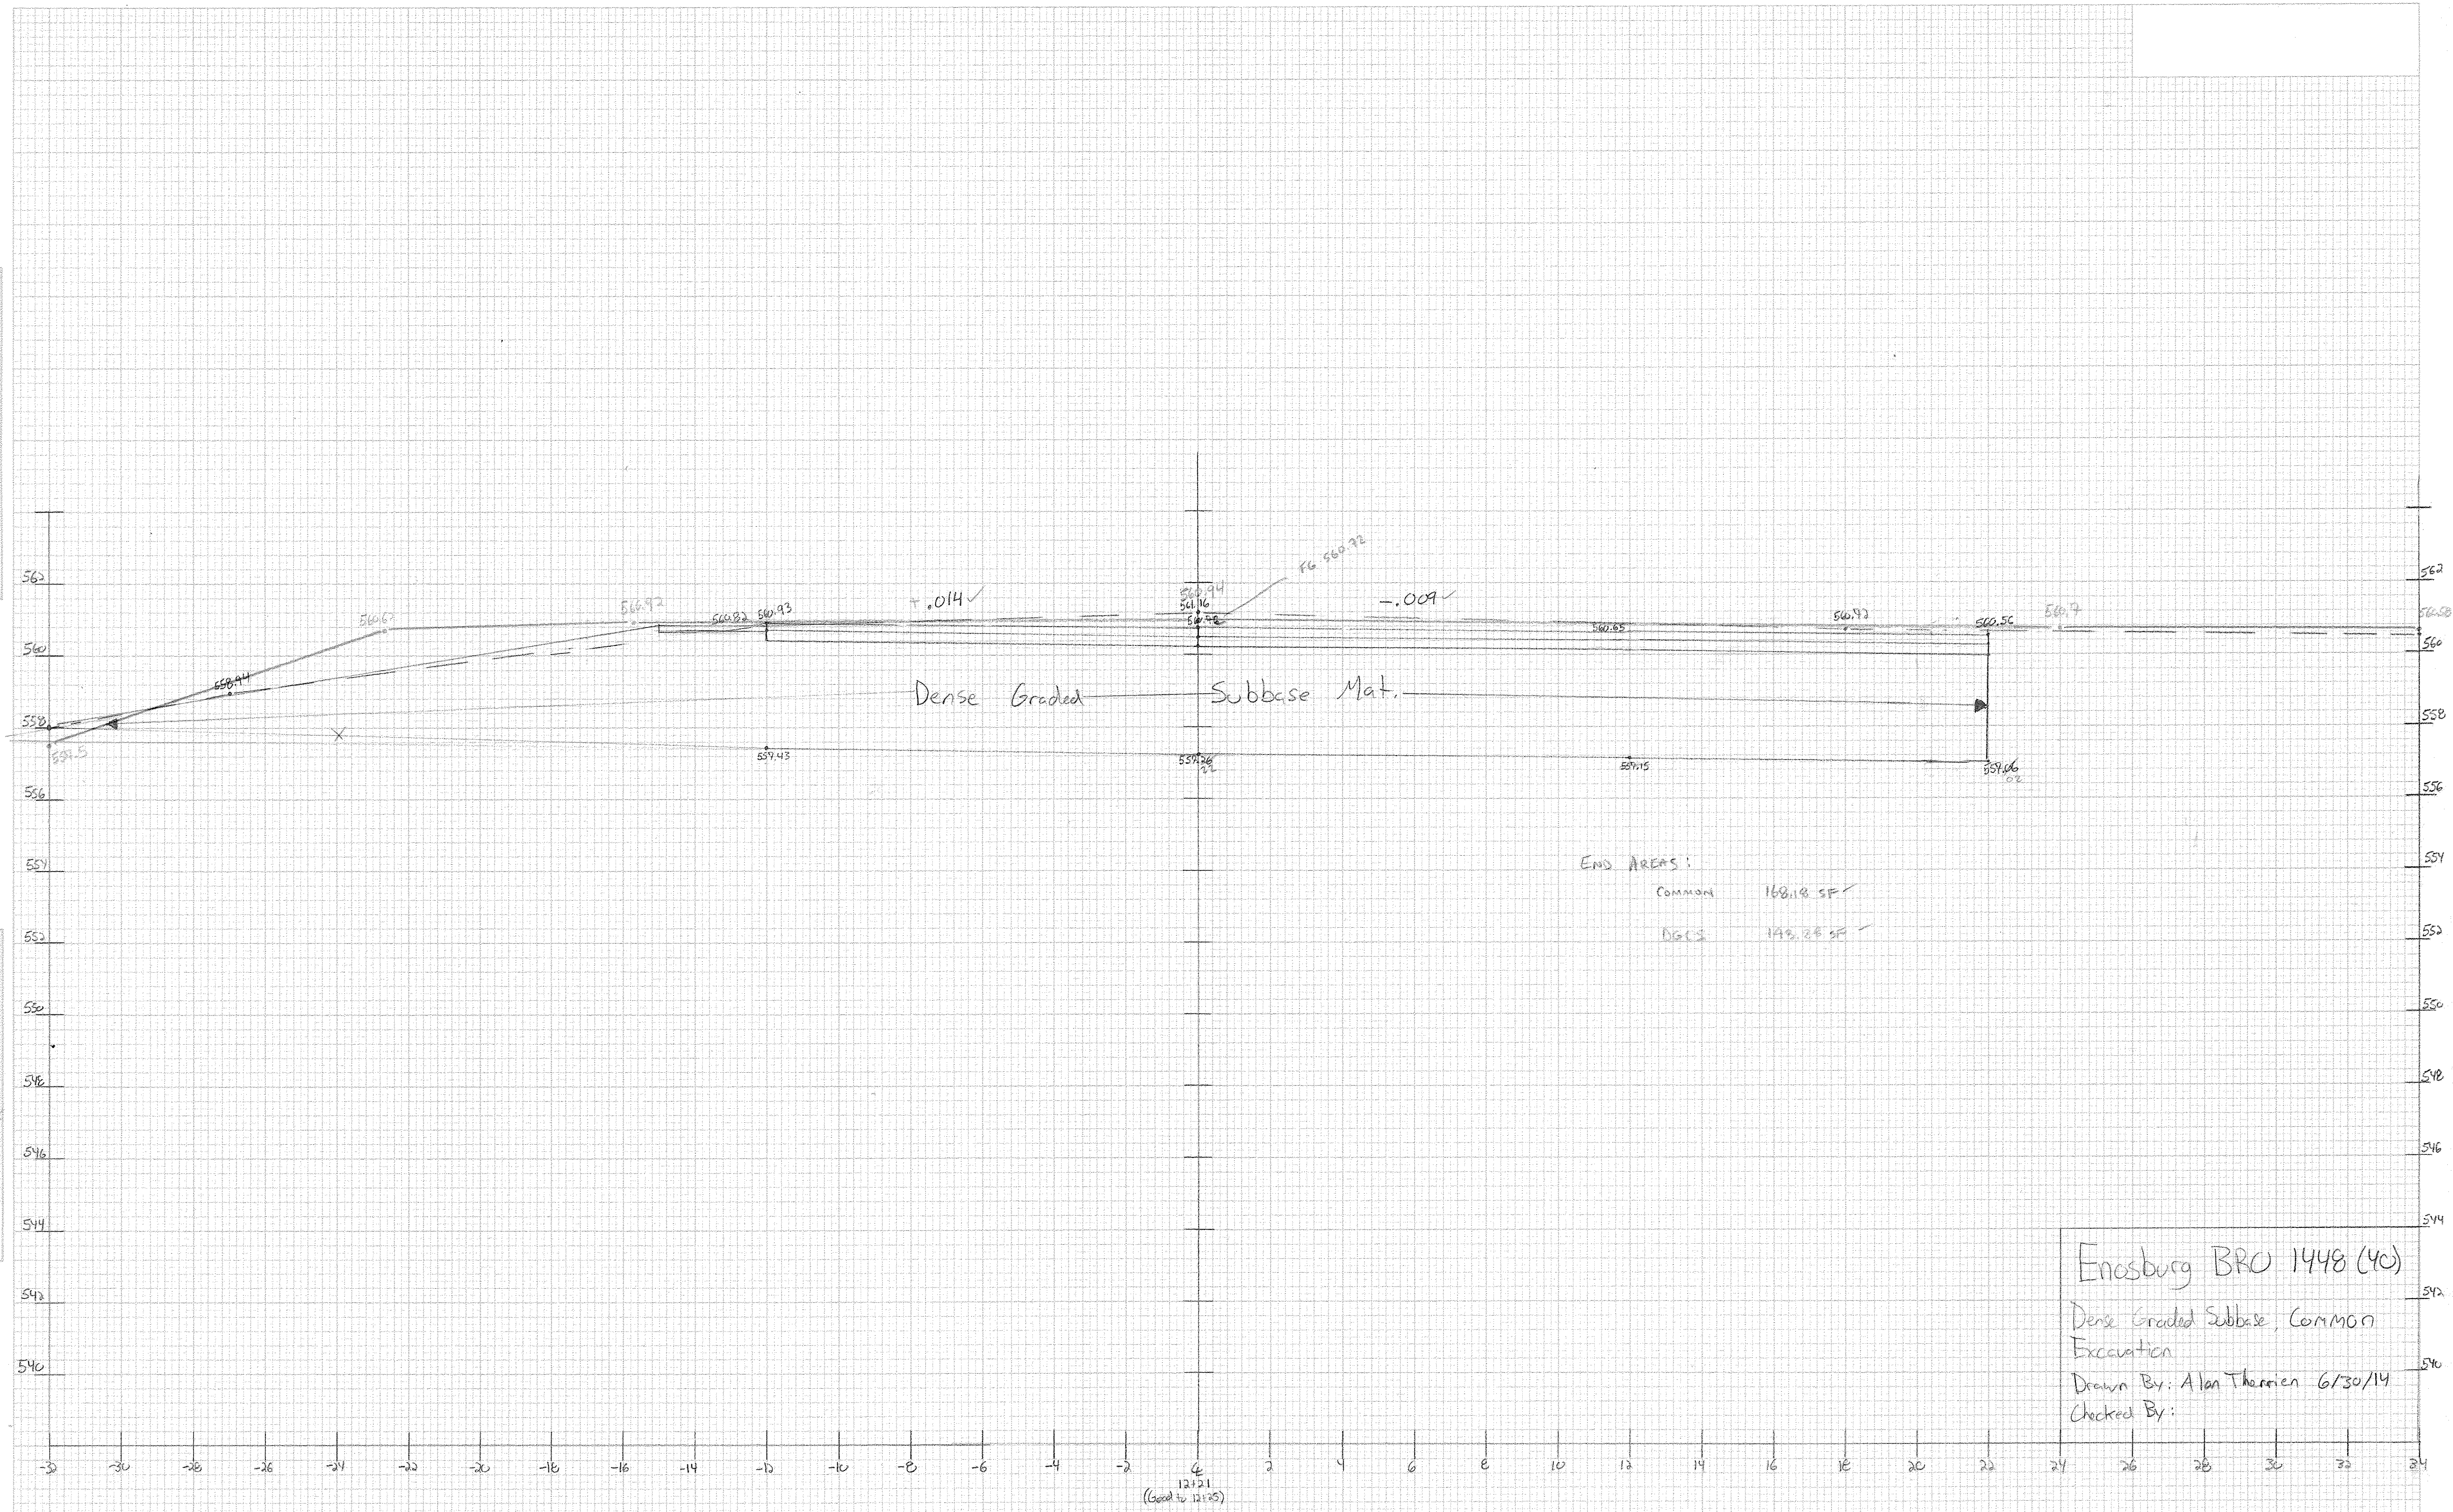

END AREAS:  
 Common 168.18 SF ✓  
 DGCS 143.28 SF ✓

Enosburg BRO 1448 (40)  
 Dense Graded Subbase, Common  
 Excavation  
 Drawn By: Alan Therrien 6/30/14  
 Checked By: