


PLAN VIEW

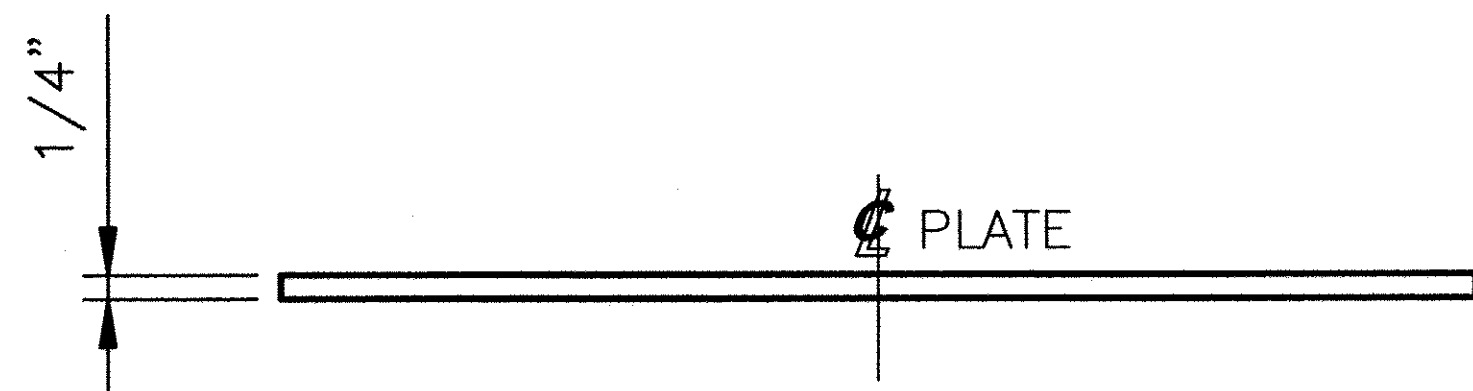

ELEVATION VIEW

EXTERNAL SHIM PLATE  
SHM1

1/4" X 12 1/2" X 12 1/2" SHIM PLATE  
AASHTO M270M/M270 GRADE 36 (GALVANIZED)  
(12) REQUIRED FOR STRUCTURE

Vermont Agency of Transportation

**RECEIVED**

ON: **May 28, 2014**

and Checked for

**CONFORMANCE**

BY: Rob Young DATE: 05/29/2014

APPROVED: Approval of drawings and/or procedures indicates concurrence with the information presented and does not relieve the Contractor or Fabricator of compliance with all specifications and code requirements	✓	
APPROVED AS NOTED		
REVISE AND RESUBMIT		
NOT REVIEWED		
Date: <i>5/29/2014</i>		
By: <i>James Houghton</i>		
<small>This review by Stantec Consulting Services Inc. is for the sole purpose of ascertaining conformance with the general design concept. This review shall not mean that Stantec Consulting Services Inc approves the detail design inherent in the shop drawings, responsibility for which shall remain with the Contractor. Submitting same, and such review shall not relieve the Contractor of his responsibility for errors or omissions in the shop drawing or of his responsibility for meeting all requirements of the Contract Documents. The contractor is responsible for dimensions to be confirmed and correlated at the job site, for information that pertains solely to the fabrication processes or to techniques of construction and installation and for coordination of the work of all subtrades.</small>		

**SEE SHEET GN1 FOR SHOP NOTES**

STATE OF VERMONT AGENCY OF TRANSPORTATION TOWN OF ENOSBURG BOSTON POST ROAD T.H. 2 CLASS 2, BRIDGE NO: 48			
STATE	COUNTY	CONTROL NO.	
VT	FRANKLIN	N/A	
PROJ. NO.: BRO 1448 (40)			
<b>DYNAMIC RUBBER: LAMINATED BEARING PADS</b>			
		1501 ROCKY RIDGE ROAD P.O. BOX 2159 ATHENS, TEXAS 75751	
SCALE: NONE	DRAWN BY: CV DATE: 3/7/14	CHECKED BY: ELS DATE: 3/11/14	
SHEET 3 OF 3		<b>JOB NO.: 12341</b>	
REV.	DESCRIPTION	BY DATE CK'D DATE	
	CUSTOMER: A.L. ST. ONGE CONTRACTOR INC.	DRAWING NUMBER 12341-D3	REV. 0

△					
REV.	DESCRIPTION	BY	DATE	CK'D	DATE