
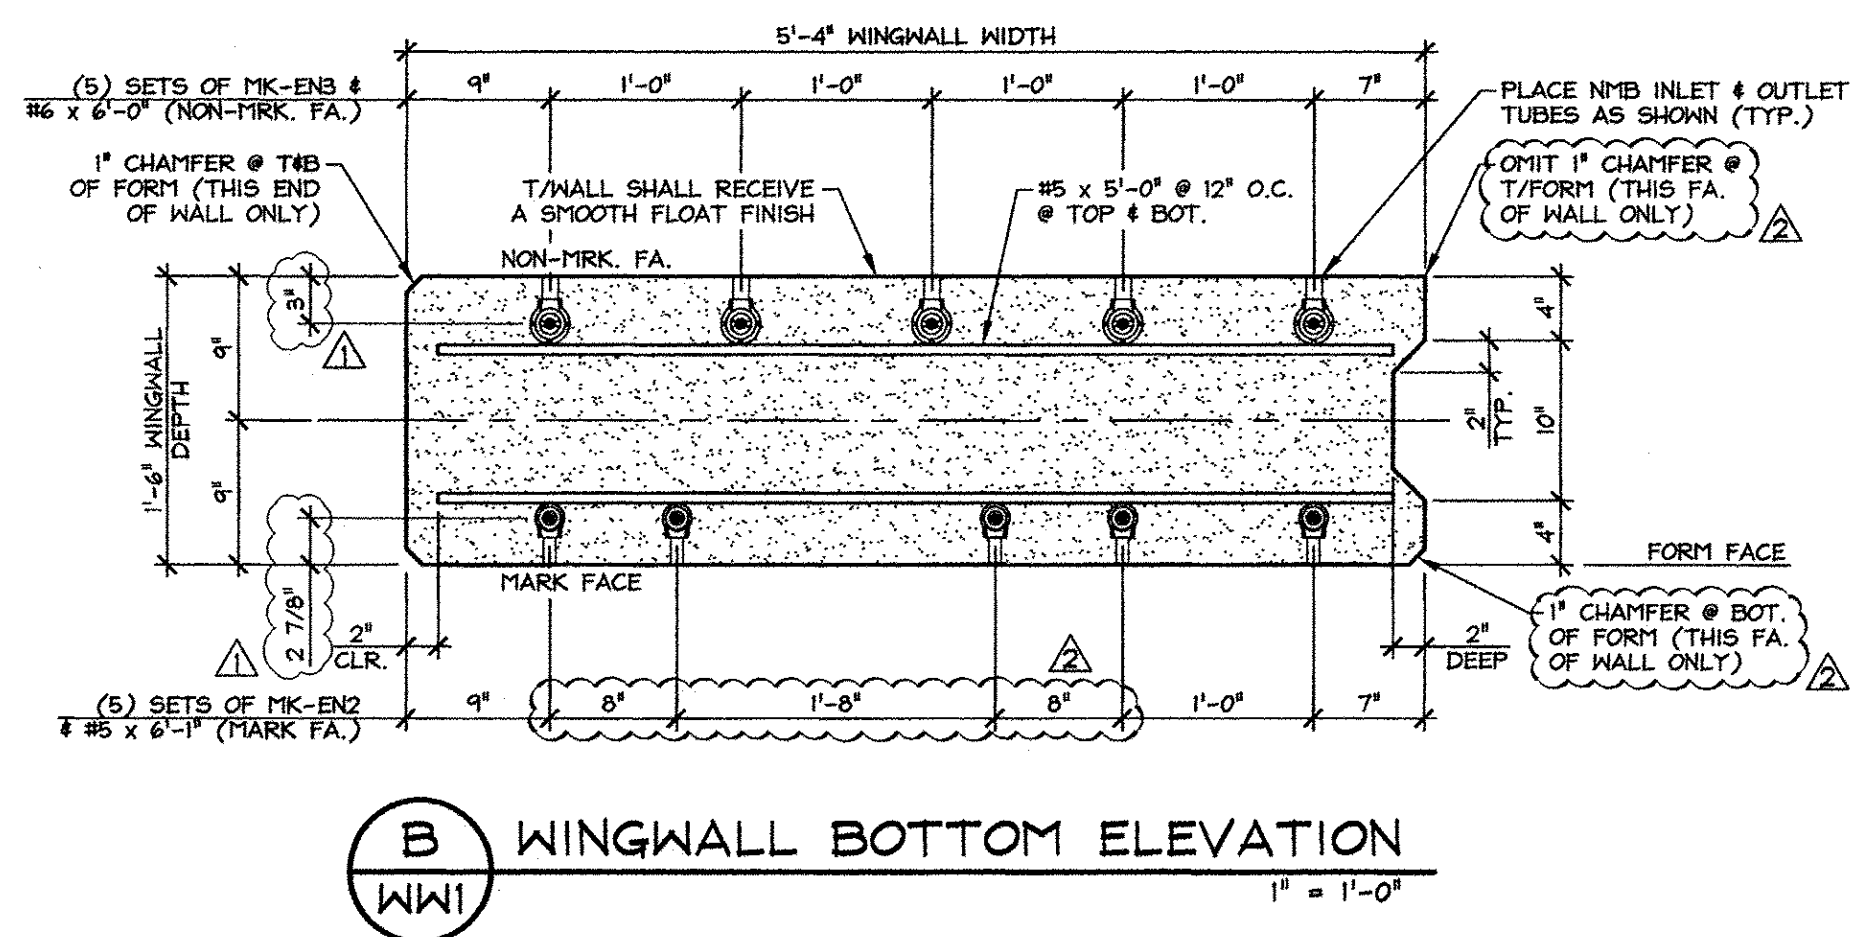
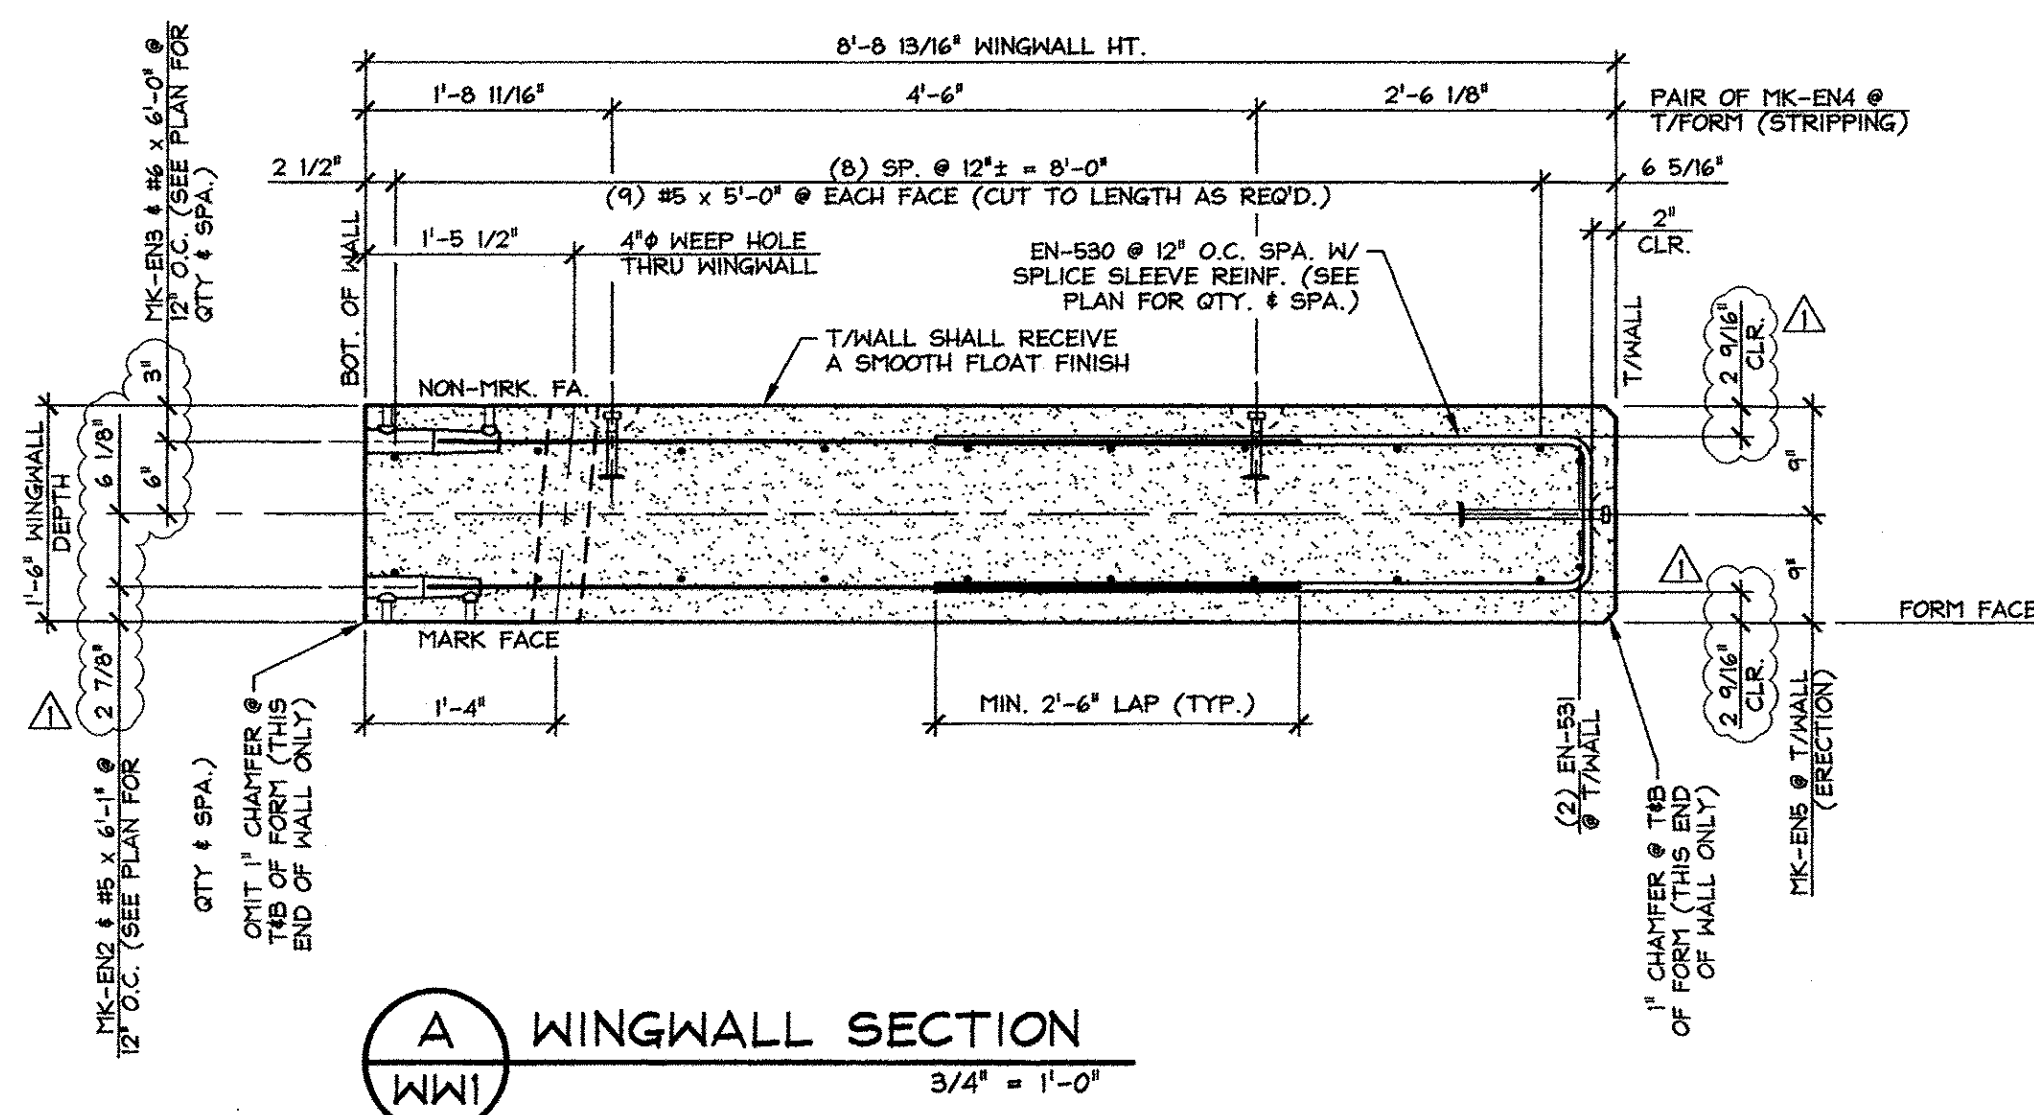


Vermont Agency of Transportation
RECEIVED
 ON: April 28, 2014
 and Checked for
CONFORMANCE
 BY: Rob Young DATE: 05/01/2014

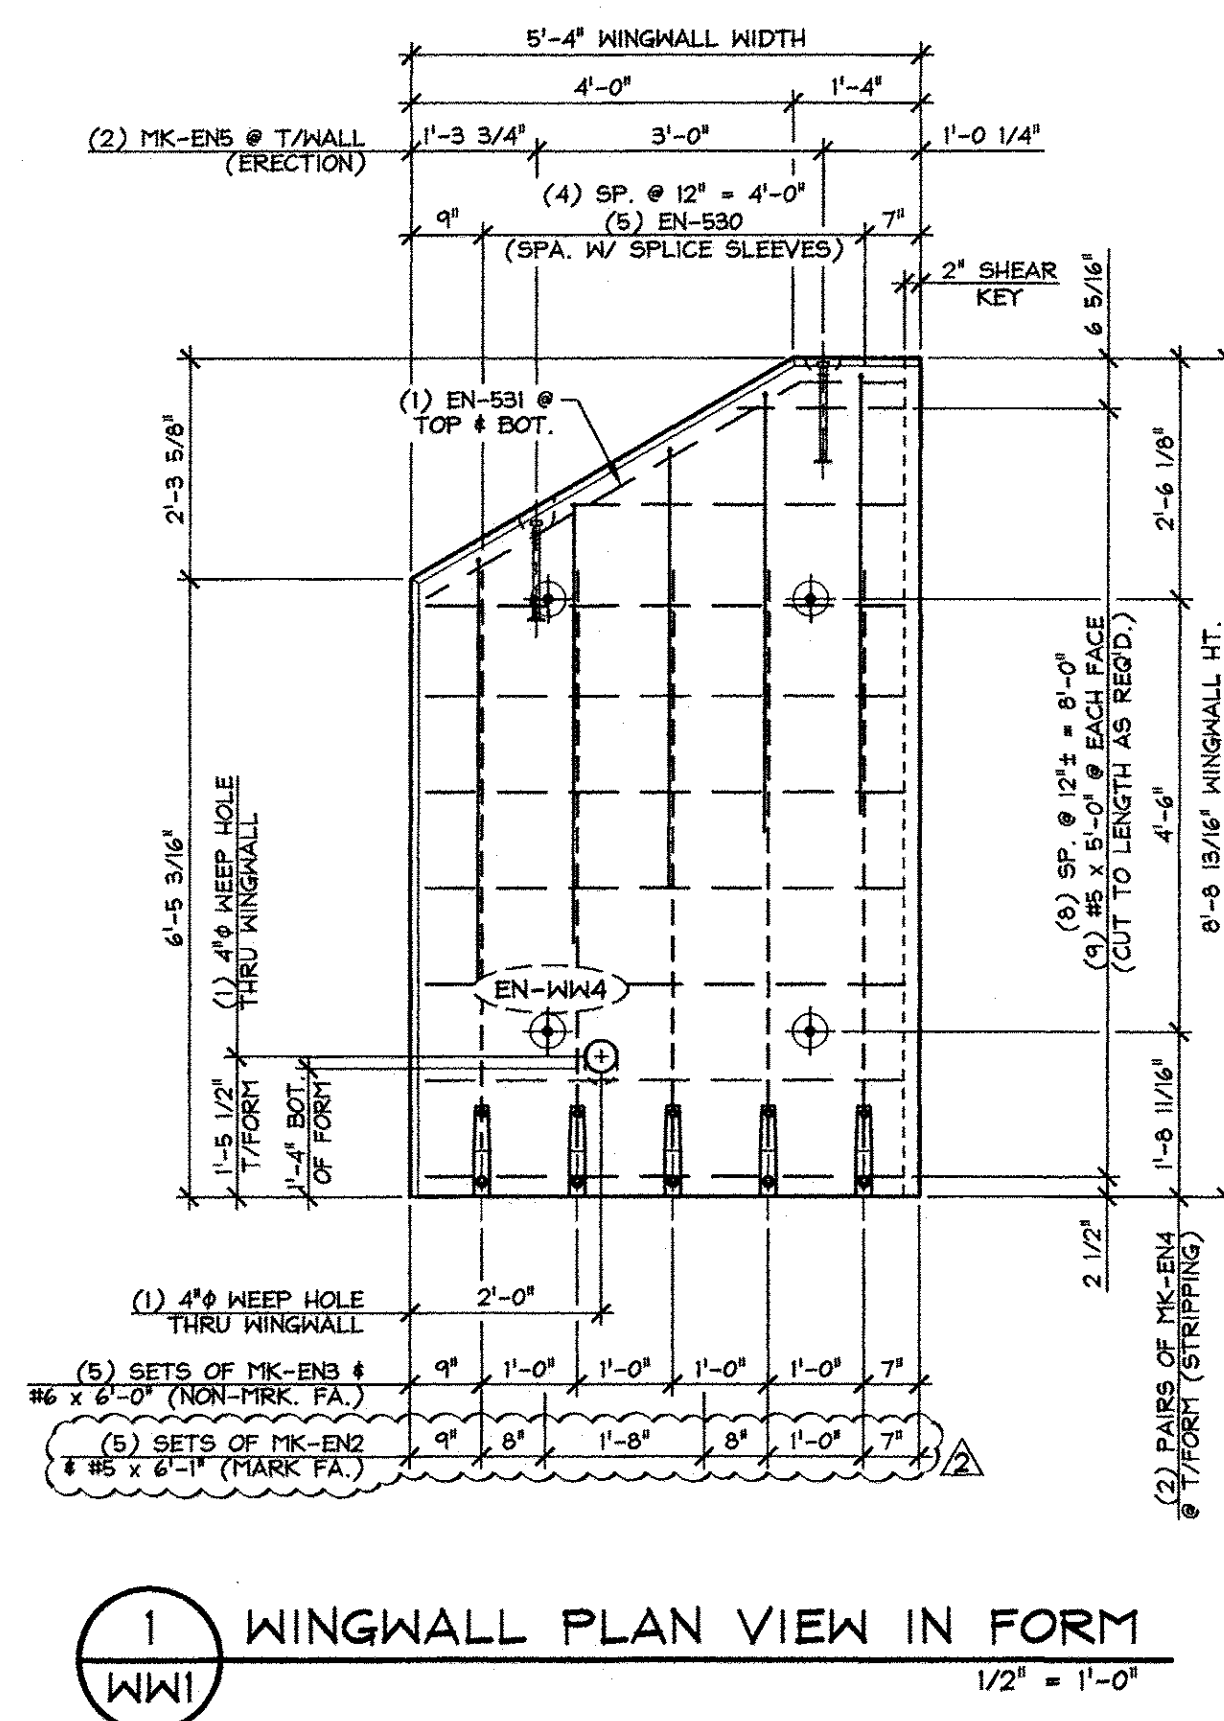

APPROVED: Approval of drawings and/or procedures indicates concurrence with the information presented and does not relieve the Contractor or Fabricator of compliance with all specifications and code requirements

APPROVED AS NOTED

REVISE AND RESUBMIT

NOT REVIEWED

Date: 4-29-2014

By: *James Hynd*

This review by Stantec Consulting Services Inc. is for the sole purpose of ascertaining conformance with the general design concept. This review shall not mean that Stantec Consulting Services Inc approves the detail design inherent in the shop drawings, responsibility for which shall remain with the Contractor. Submitting same, and such review shall not relieve the Contractor of his responsibility for errors or omissions in the shop drawing or of his responsibility for meeting all requirements of the Contract Documents. The contractor is responsible for dimensions to be confirmed and correlated at the job site, for information that pertains solely to the fabrication processes or to techniques of construction and installation and for coordination of the work of all subtrades.



SHOP NOTE:
 ALL EDGES OF WING WALLS, FORM FACE & T/WALL FACE, SHALL RECEIVE A 1" CHAMFER (UNLESS NOTED OTHERWISE)

SHOP NOTE:
 Fc = 5,000 PSI
 Fd = 3,500 PSI
 MIX: #44815CC

SUBMITTED
 APR 28 2014
 J.P. CARRARA & SONS, INC.
 MIDDLEBURY, VT 05753

MARK:	EN-WW4	QTY.:	1	WT.:	4.65 T	VOL.:	2.30 cy
MATERIAL LIST / WINGWALL							
ITEM	MARK	DESCRIPTION	QTY.				
1	EN-530	#5 BENT BAR (LEVEL 1, BLACK STEEL)	5				
2	EN-531	#5 BENT BAR (LEVEL 1, BLACK STEEL)	2				
3		#5 x 6'-1" (LEVEL 1, BLACK STEEL)	5				
4		#5 x 5'-0" (LEVEL 1, BLACK STEEL)	18				
5							
6		#6 x 6'-0" (LEVEL 1, BLACK STEEL)	5				
7							
8							
9	MK-EN2	N#B SPLICE SLEEVE 5U-X(PG) (BLACK STEEL)	5				
10	MK-EN3	N#B SPLICE SLEEVE 6U-X(PG) (BLACK STEEL)	5				
11	MK-EN4	4T x 7 1/8" SWIFT LIFT LIFTER	4				
12	MK-EN5	8T x 13 3/8" SWIFT LIFT LIFTER	2				
13							
14							
15							

△ 4-28-14 REVISED AS NOTED
 △ 4-7-14 REVISED AS NOTED

APPROVAL STAMP:

J.P. CARRARA & SONS INC. A.L. St. ONGE CONTRACTOR, INC.
 Precast & Prestress Manufacturer CONTRACTOR
 244 CARR ST., MIDDLEBURY, VERMONT 05753 Phone: (802)388-6361 Fax: (802)388-8010 MONTGOMERY CENTER, VERMONT

STATE OF VERMONT AGENCY OF TRANSPORTATION COUNTY OF FRANKLIN DATE: JAN. 27, 2014
 SCALE: NOTED

TOWN OF ENOSBURG CHKD: M.W. DFTM: B.L.
 BOSTON POST ROAD T.H.2 CLASS 2 JOB NO: 23418-013
 BRIDGE NO.: 48 PROJECT NO.: BRO 1448(40)

PRECAST WINGWALL DETAILS DWG. NO: WW1