

SUMMARY OF SHEETS
 PROJECT COMPOSITE SHEETS: 1 - 6
 BO 1449 (33) SHEETS: 7 - 54
 BHF 0286 (5) SHEETS: 55 - 110

Record Plans

Contractor: J.P. SICARD, INC.
 Resident Engineer: KEVIN MCCLURE
 Construction Began: APRIL 17, 2017
 Construction Complete: AUGUST 2, 2019
 Record Plans By: KEVIN MCCLURE & JESSE IVES

I hereby certify that all construction required by this set of drawings has been accomplished as indicated herein.

DocuSigned by:

BY: Kevin McClure Resident Engineer
 4D2829C12513433

Date: 7/12/2022


NOTE: Any further information concerning final quantities, amounts or other details relative to this project may be found at Central Files in the electronic archives.

STATE OF VERMONT AGENCY OF TRANSPORTATION



PROPOSED IMPROVEMENT BRIDGE PROJECT

VILLAGE OF BARTON
 COUNTY OF ORLEANS

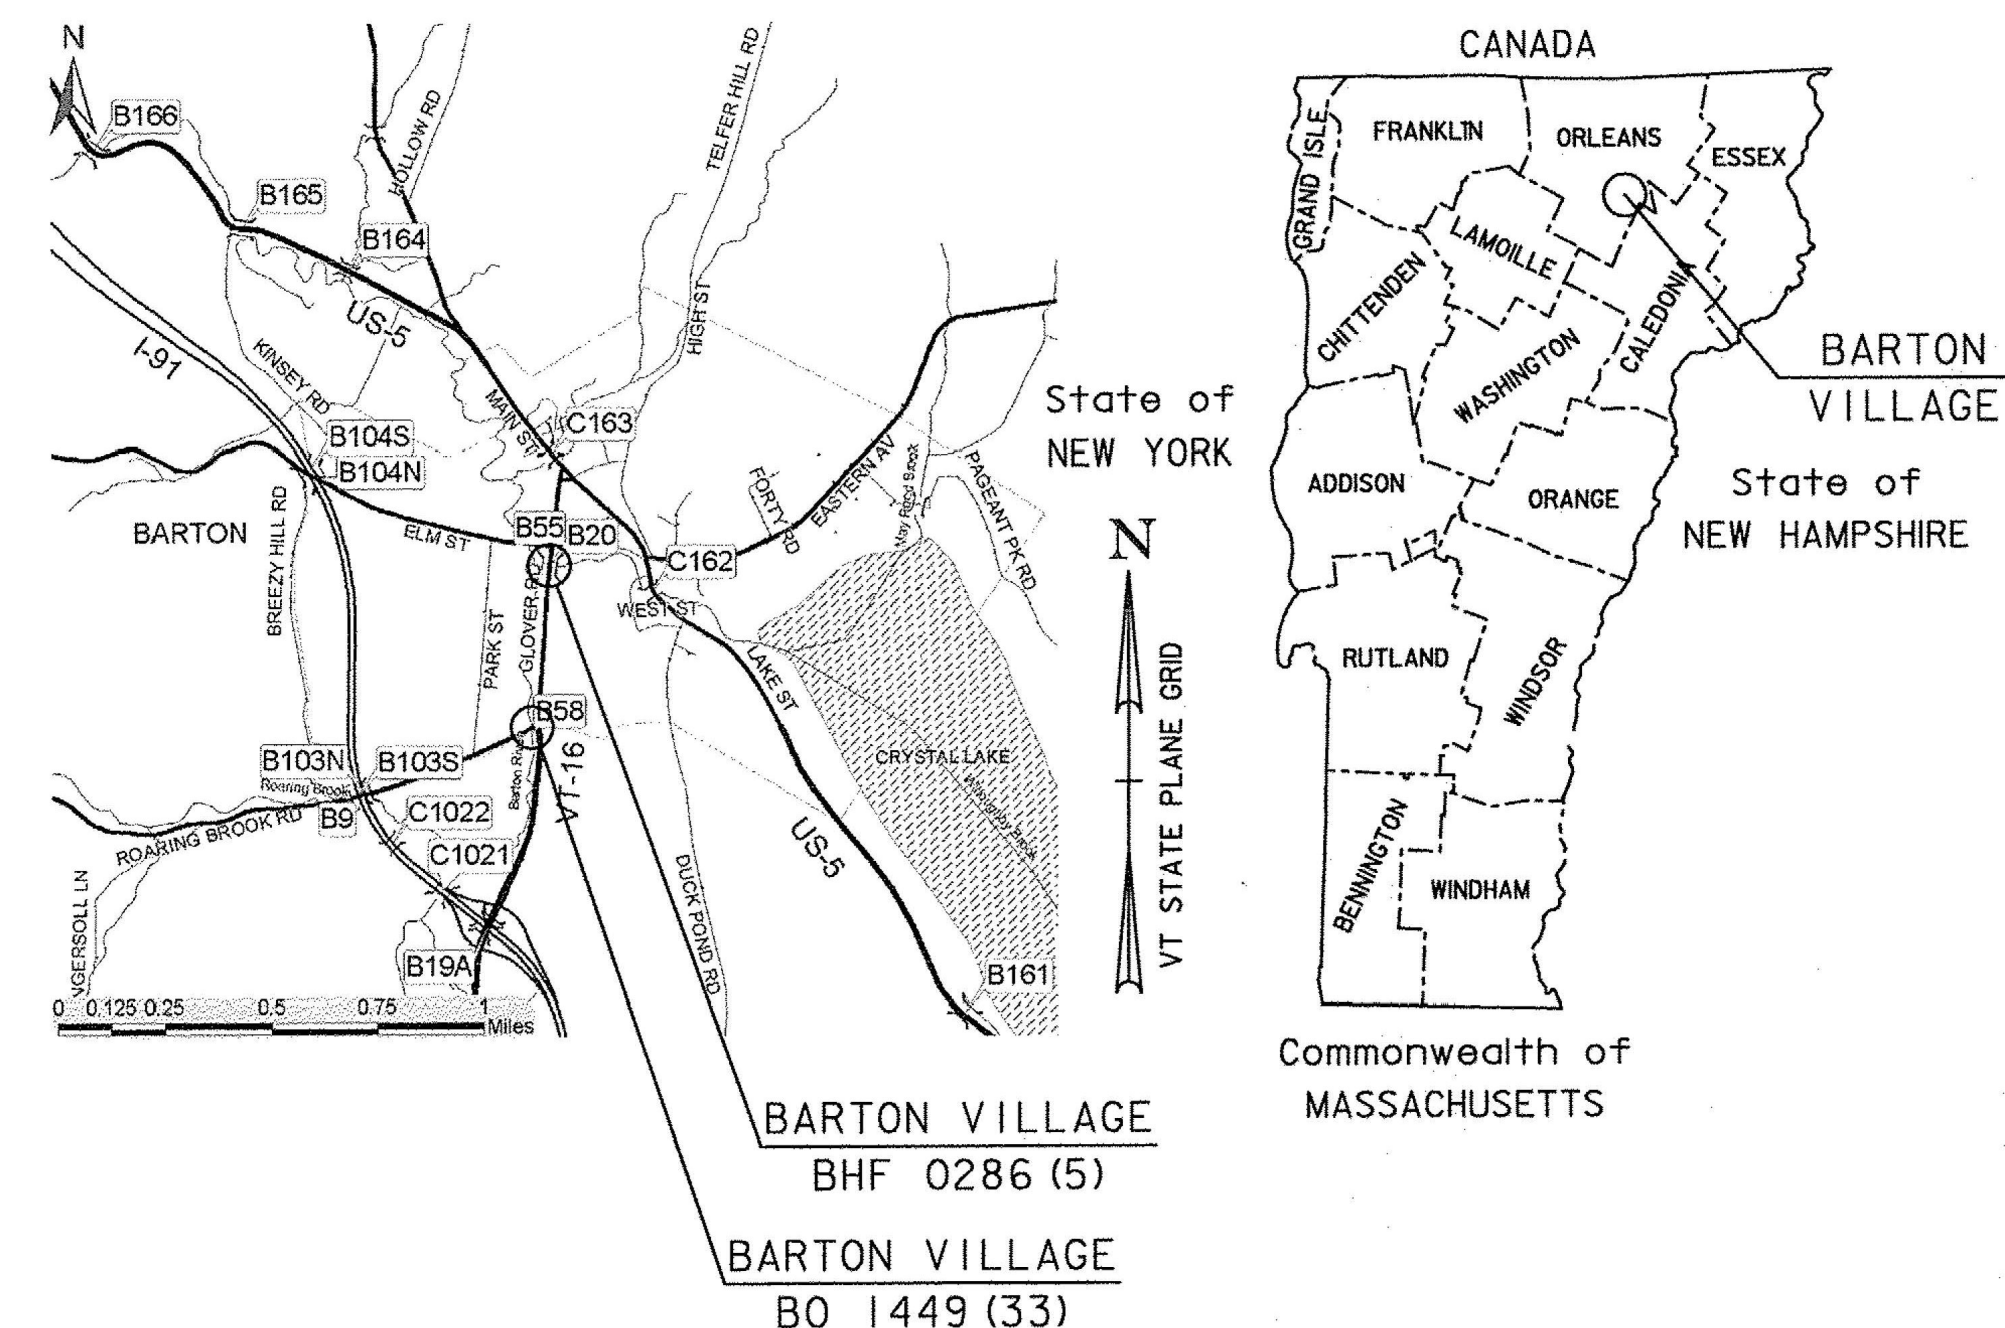

BARTON VILLAGE BO 1449 (33)


ROUTE NO : TH 4 (ROARING BROOK RD), RURAL MINOR COLLECTOR, CLASS 2 TOWN HIGHWAY

BRIDGE NO : 58

PROJECT LOCATION: AT THE INTERSECTION OF TH-4 AND VT ROUTE 16

PROJECT DESCRIPTION: REMOVAL OF EXISTING STRUCTURE AND REPLACEMENT WITH A NEW STRUCTURE.

LENGTH OF STRUCTURE: 68.13 FEET
 LENGTH OF ROADWAY: 221.87 FEET
 LENGTH OF PROJECT: 290.00 FEET

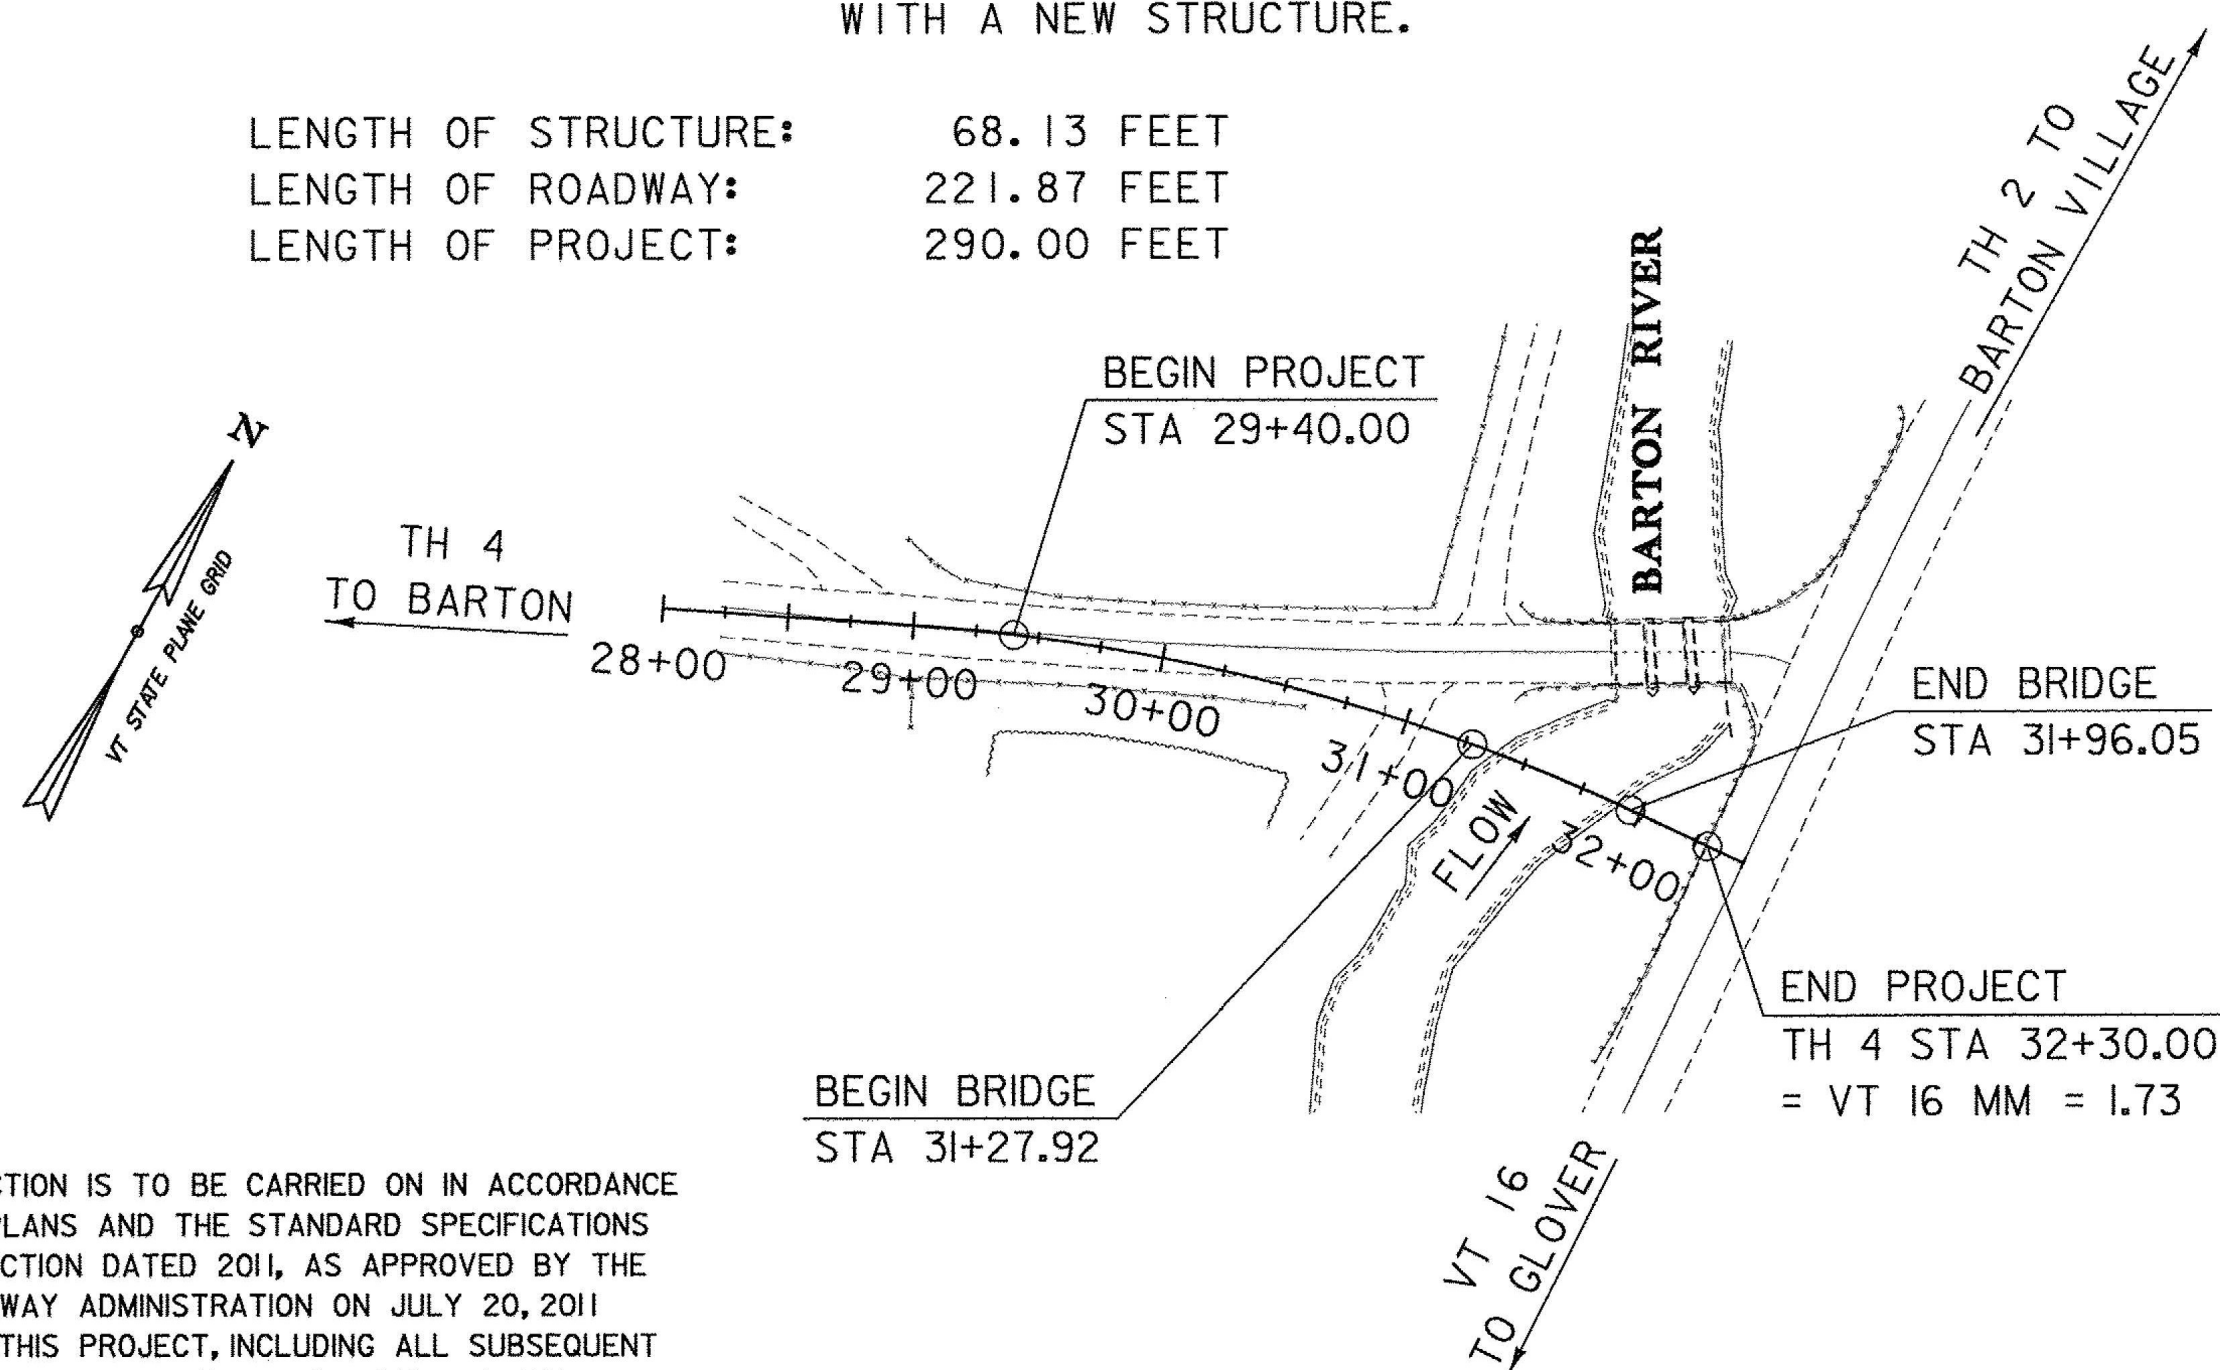

BARTON VILLAGE BHF 0286 (5)


ROUTE NO : TH 2 (GLOVER ROAD), RURAL MAJOR COLLECTOR, CLASS 1 TOWN HIGHWAY

BRIDGE NO : 20

PROJECT LOCATION: 0.2 MILES SOUTH OF JUNCTION WITH US ROUTE 5

PROJECT DESCRIPTION: REMOVAL OF EXISTING STRUCTURE AND REPLACEMENT WITH A NEW STRUCTURE ON EXISTING ALIGNMENT.


LENGTH OF STRUCTURE: 45.00 FEET
 LENGTH OF ROADWAY: 60.00 FEET
 LENGTH OF PROJECT: 105.00 FEET

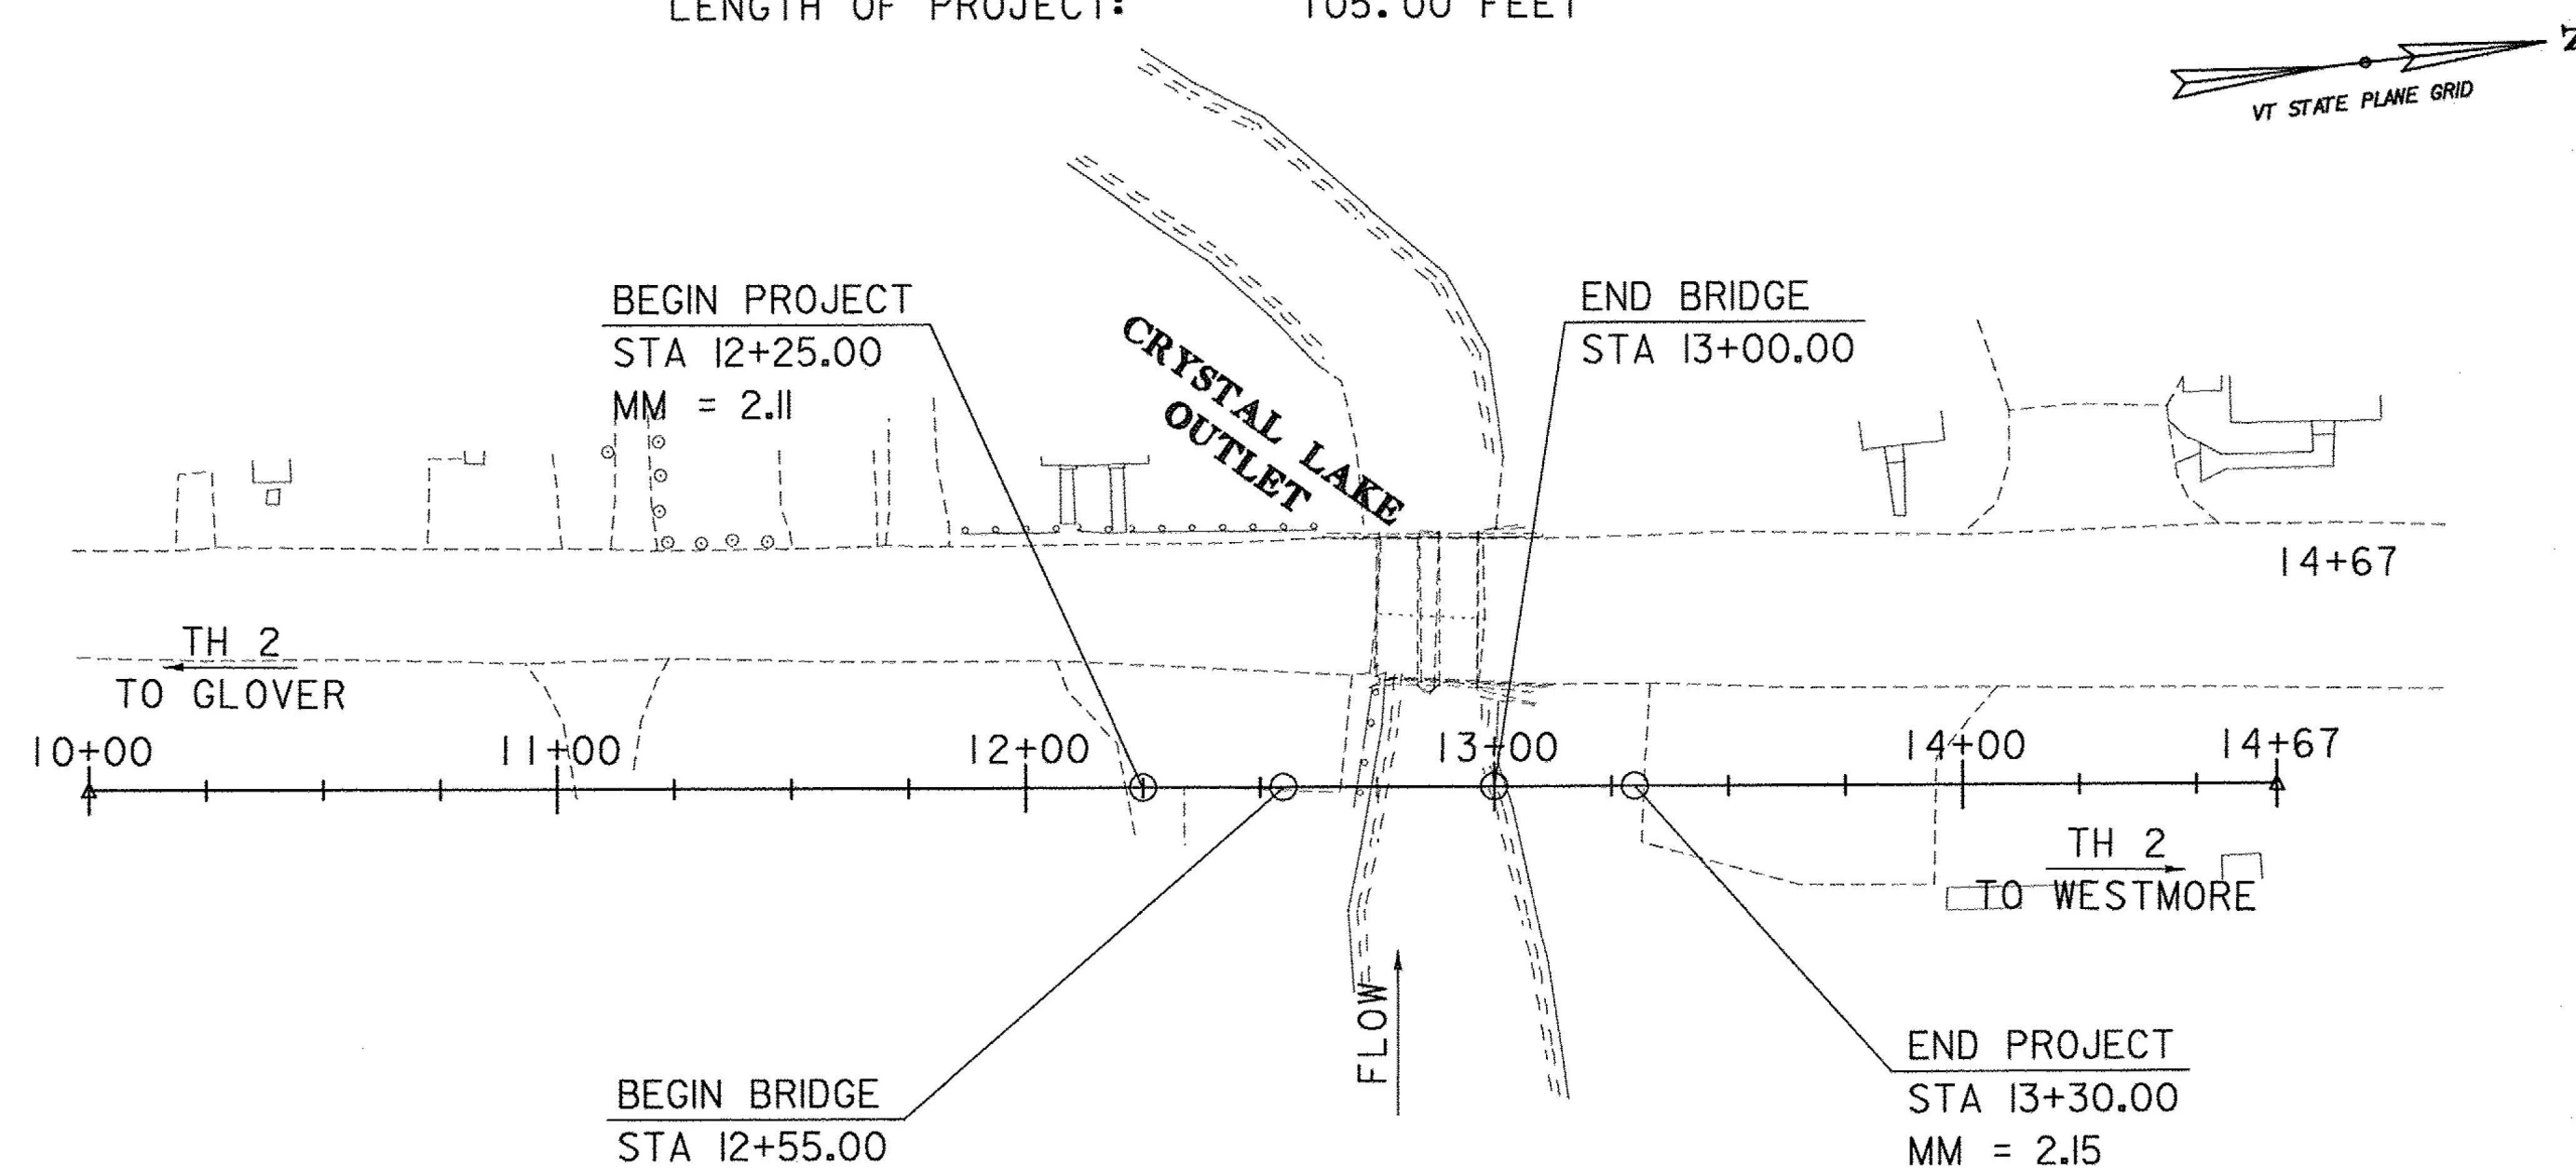

CONSTRUCTION IS TO BE CARRIED ON IN ACCORDANCE WITH THESE PLANS AND THE STANDARD SPECIFICATIONS FOR CONSTRUCTION DATED 2011, AS APPROVED BY THE FEDERAL HIGHWAY ADMINISTRATION ON JULY 20, 2011 FOR USE ON THIS PROJECT, INCLUDING ALL SUBSEQUENT REVISIONS AND SUCH REVISED SPECIFICATIONS AND SPECIAL PROVISIONS AS ARE INCORPORATED IN THESE PLANS.

SCALE 1" = 80'-0"
 80 0 80

QUALITY ASSURANCE PROGRAM : LEVEL 2	
SURVEYED BY : R. GILMAN	
SURVEYED DATE : 06/12; 04/13; 04/14	
DATUM	
VERTICAL	NAVD88
HORIZONTAL	NAD 83 (2011)

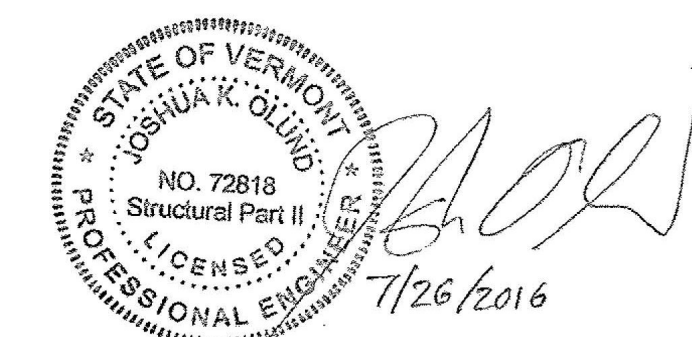

DIRECTOR OF PROJECT DELIVERY	
APPROVED: <u>[Signature]</u>	DATE: <u>8/1/2016</u>
PROJECT MANAGER :	DOUG BONNEAU, P.E.
PROJECT NAME :	BARTON VILLAGE
PROJECT NUMBER :	BO 1449 (33) & BHF 0286 (5)
SHEET 1 OF 110 SHEETS	

TYLIN INTERNATIONAL