


**NOTES:**

1. SEE "ABUTMENT 1 PLAN, ELEVATION, & SECTION" FOR SECTION AND NOTES.

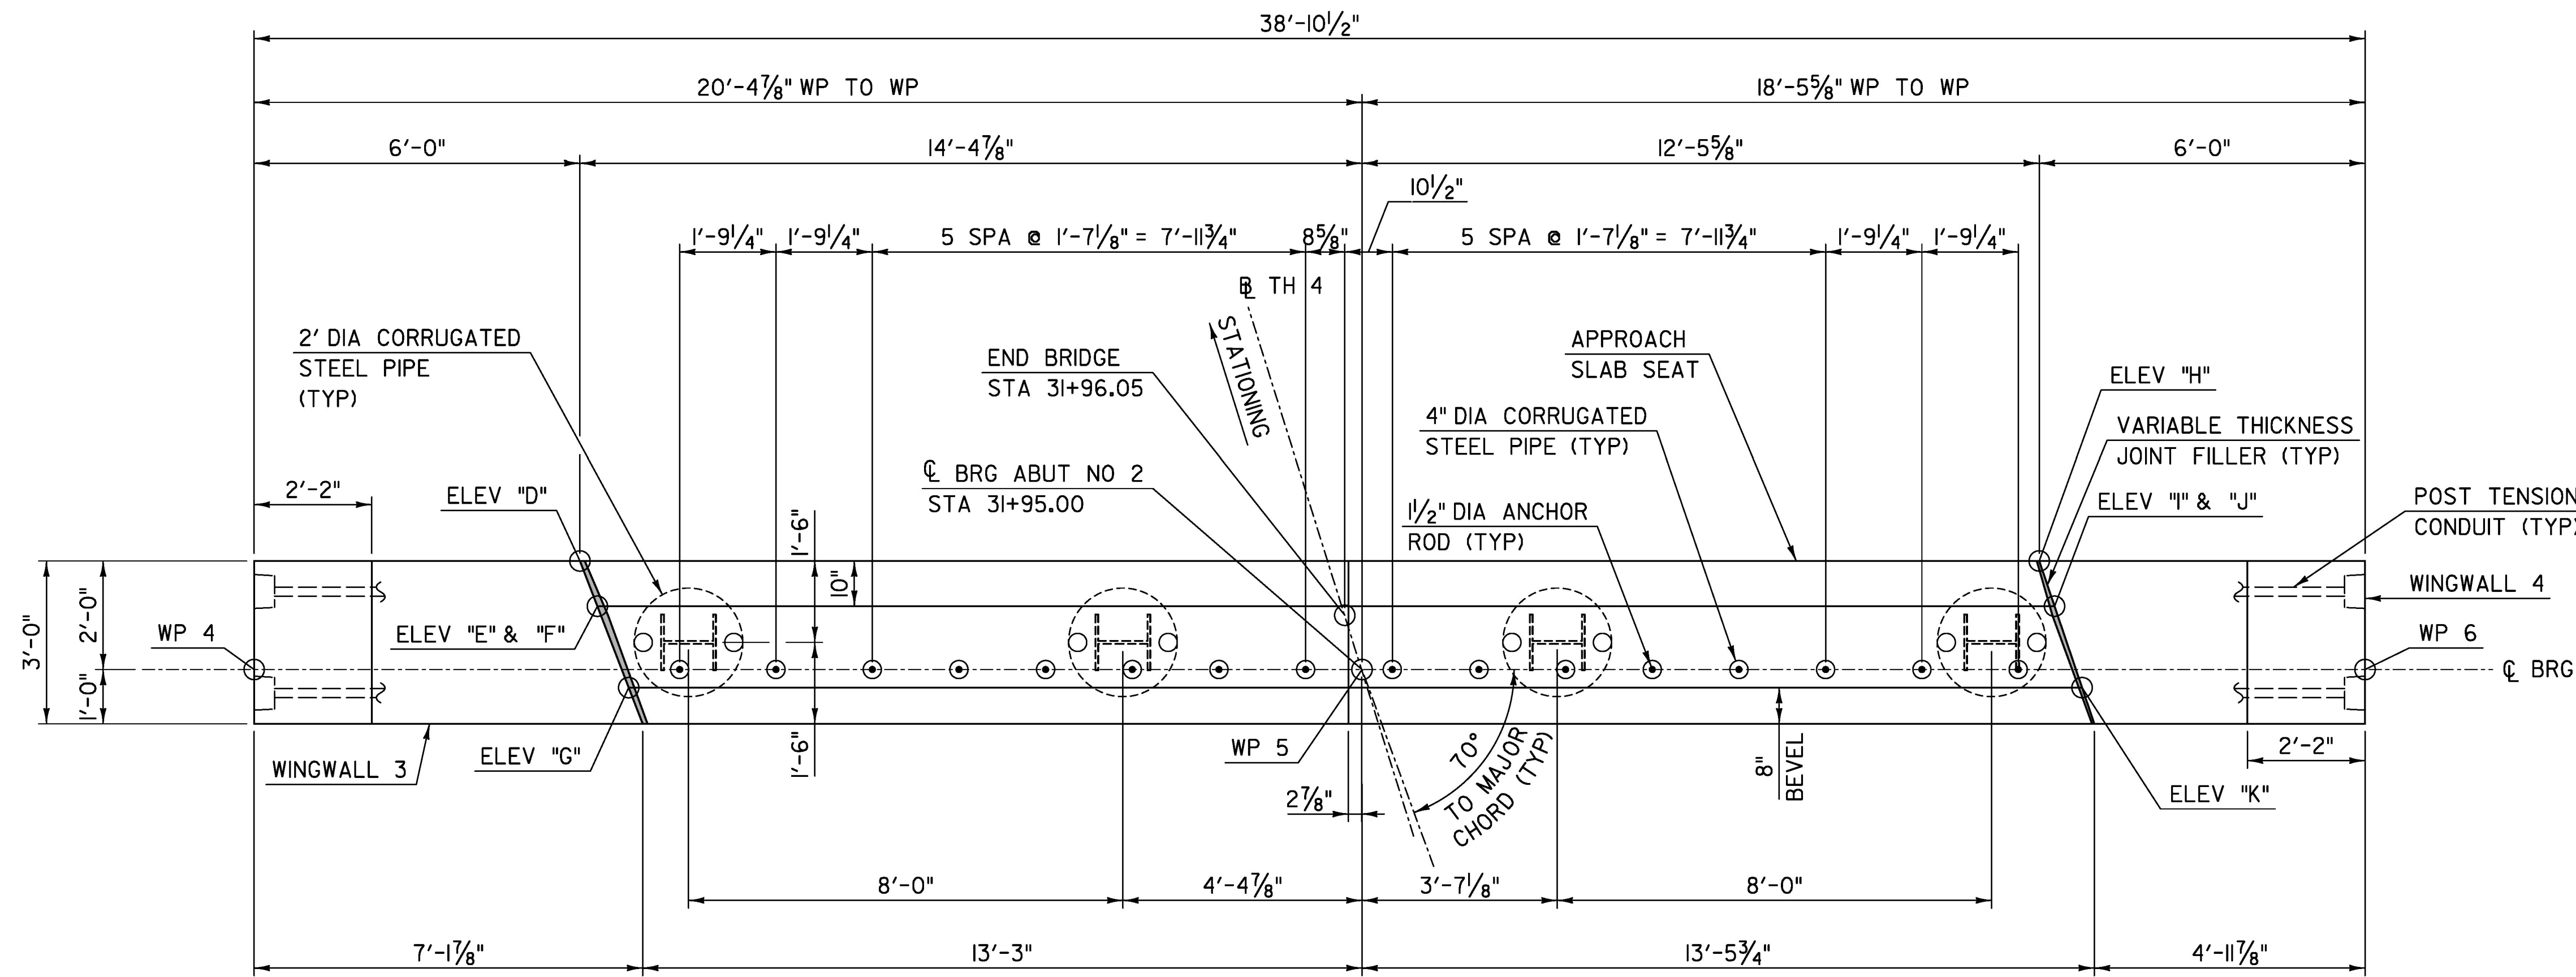


**ABUTMENT NO 2 - PLAN**

SCALE: 1/2" = 1'-0"

**LEGEND:**

ITEM 900.608, "SPECIAL PROVISION (HIGH PERFORMANCE CONCRETE, RAPID SET) (FPQ)"

ABUTMENT ELEVATIONS	
ELEV "A"	857.92
ELEV "B"	856.92
ELEV "C"	848.50
ELEV "D"	856.36
ELEV "E"	856.37
ELEV "F"	855.83
ELEV "G"	855.86
ELEV "H"	855.96
ELEV "I"	855.97
ELEV "J"	855.43
ELEV "K"	855.46
ELEV "L"	857.52
ELEV "M"	856.52

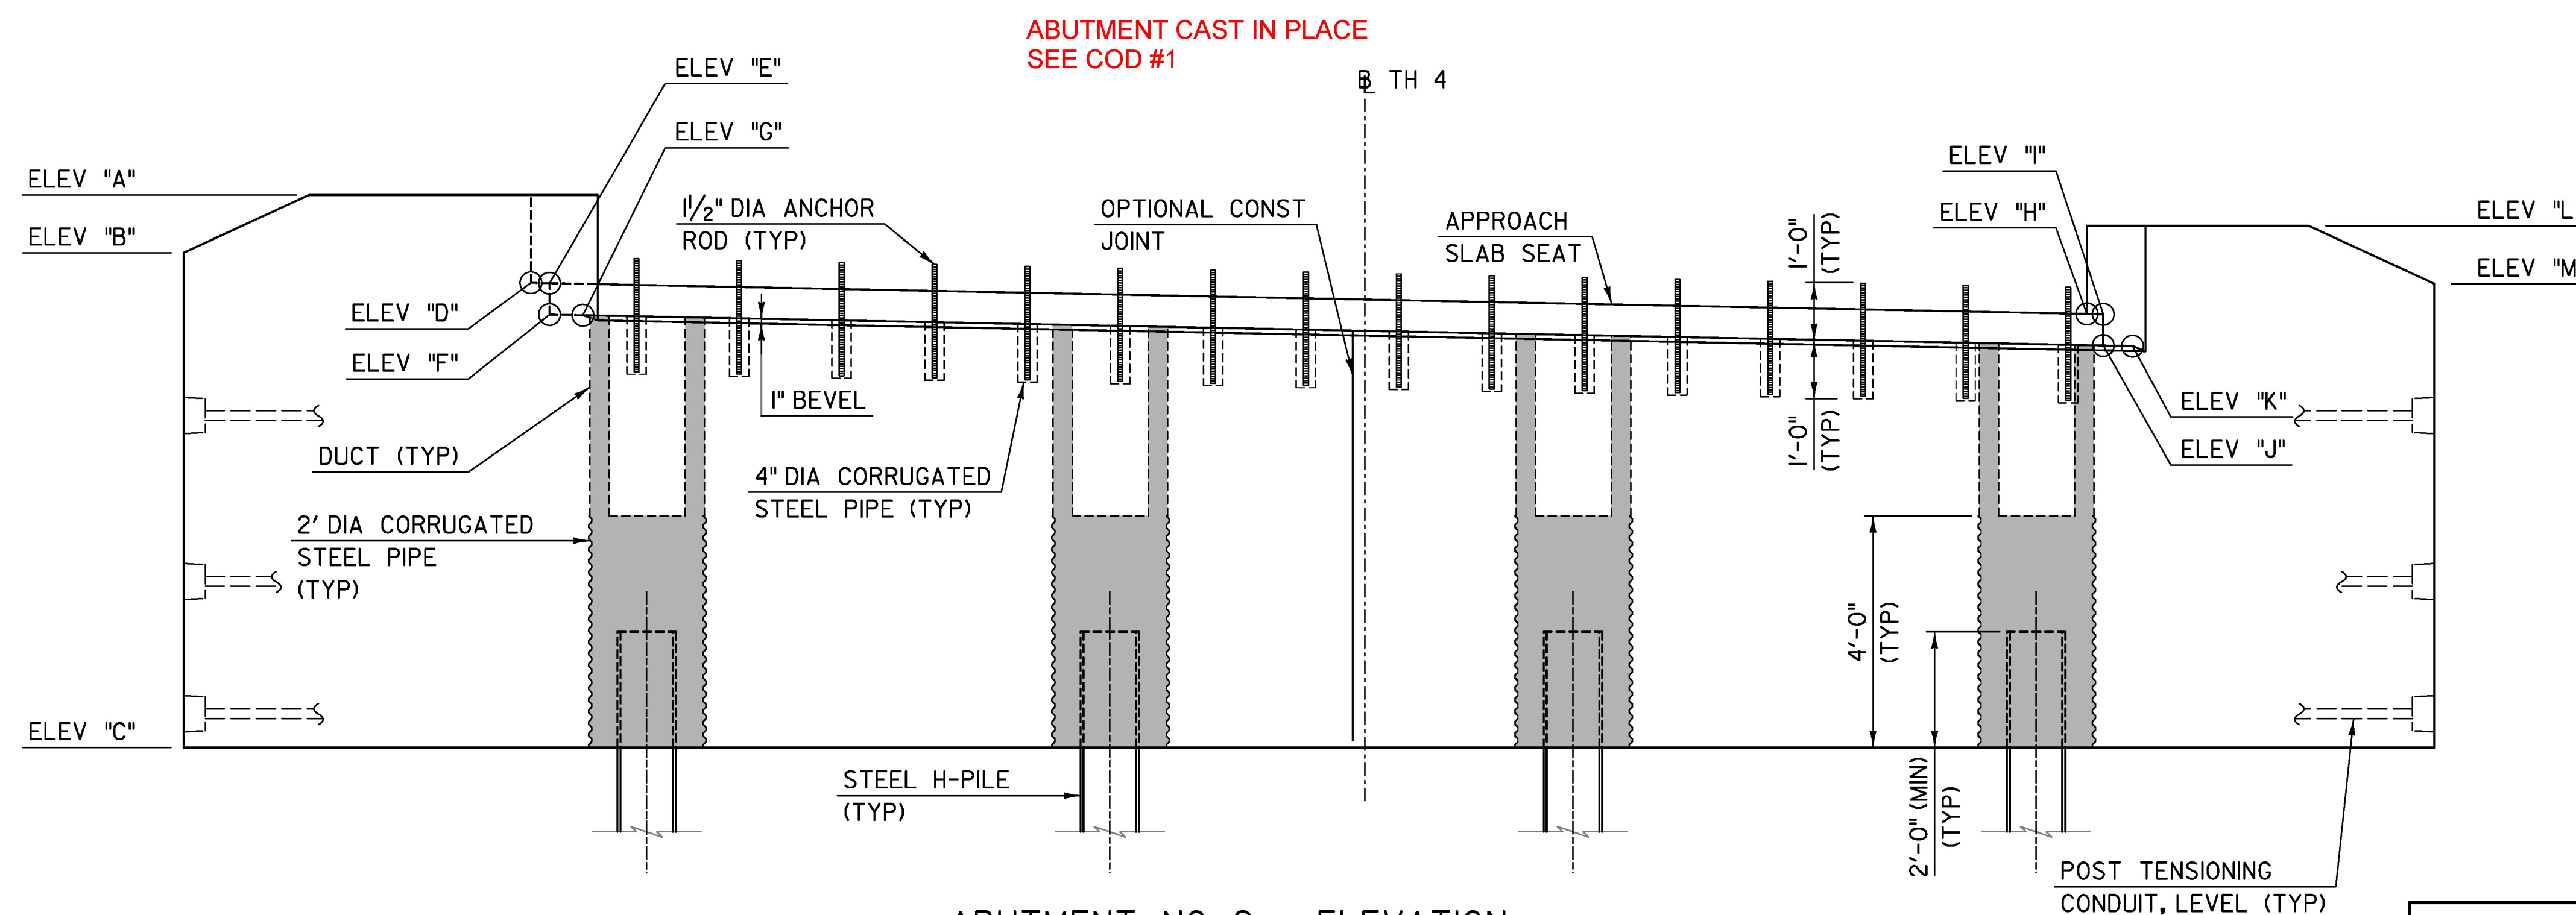

**ABUTMENT NO 2 - ELEVATION**

SCALE: 1/2" = 1'-0"

PROJECT NAME: BARTON VILLAGE  
PROJECT NUMBER: BO 1449(33)

FILE NAME: z13j078sub2.dgn  
PROJECT LEADER: J. OLUND  
DESIGNED BY: D. MYERS  
ABUTMENT 2 PLAN AND ELEVATION

PLOT DATE: 7/26/2016  
DRAWN BY: S. MORGAN  
CHECKED BY: C. TAYLOR  
SHEET 36 OF 110

**TYLIN**INTERNATIONAL