



63+00
LIMIT OF WORK STA 62+98.40

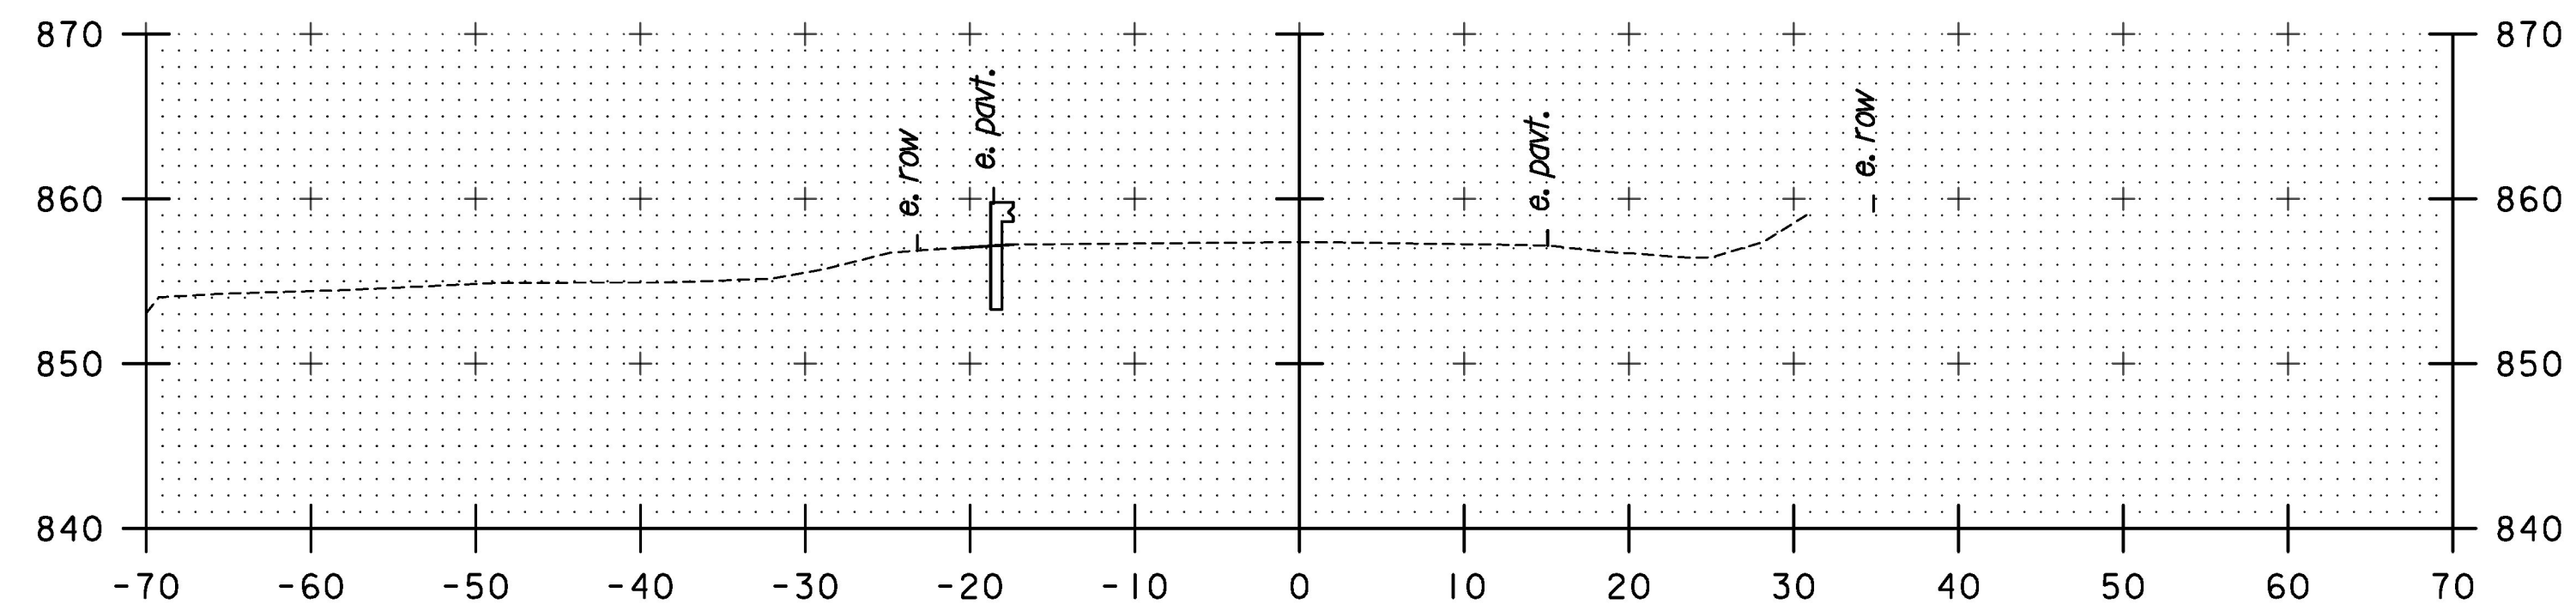

62+75

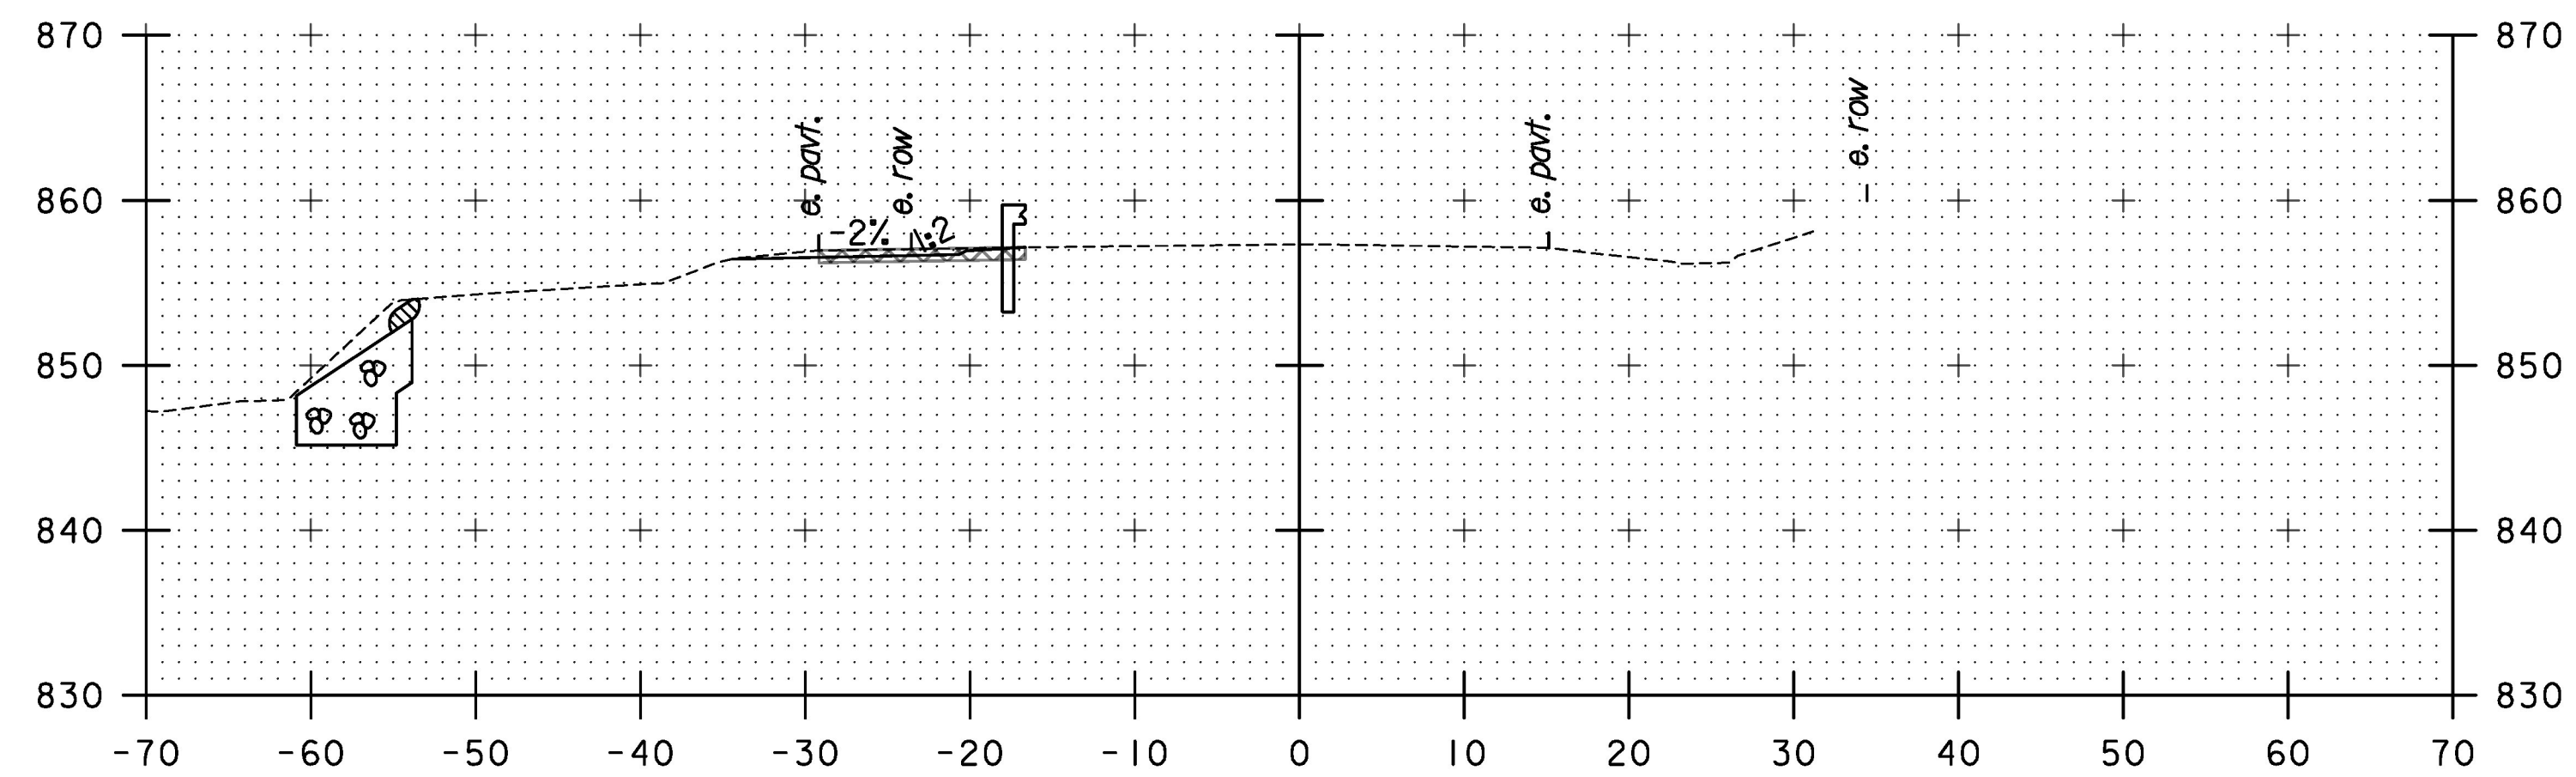

62+50

STA. 62+50 TO STA. 63+00

NOTES: WATER AND SEWER LINES BELOW
VT 16 RIGHT DITCH NOT SHOWN.

TYLIN INTERNATIONAL

PROJECT NAME: BARTON VILLAGE
PROJECT NUMBER: BO 1449(33)

FILE NAME: z13j078xs2.dgn
PROJECT LEADER: J. OLUND
DESIGNED BY: B. TOOTHAKER
VT16 CROSS SECTIONS 2

PLOT DATE: 7/26/2016
DRAWN BY: B. TOOTHAKER
CHECKED BY: J. HOWE
SHEET 43 OF 110