

MATERIAL TOLERANCES (IF USED ON PROJECT)	
SURFACE	
- PAVEMENT (TOTAL THICKNESS)	+/- 1/4"
- AGGREGATE SURFACE COURSE	+/- 1/2"
SUBBASE	
SAND BORROW	+/- 1"


SUBBASE TAPER - SOUTH APPROACH

NOT TO SCALE
(ALONG BASELINE)

SUBBASE TAPER - NORTH APPROACH

NOT TO SCALE
(ALONG BASELINE)


NOTE: EMULSIFIED ASPHALT SHALL BE APPLIED TO ALL COLD PLANED BITUMINOUS CONCRETE PAVEMENT SURFACES AND BETWEEN ALL LIFTS OF PAVEMENT AT THE RATE OF 0.04 GAL/SY OR AS DIRECTED BY THE ENGINEER. THE COST WILL BE PAID UNDER ITEM 404.65, "EMULSIFIED ASPHALT".

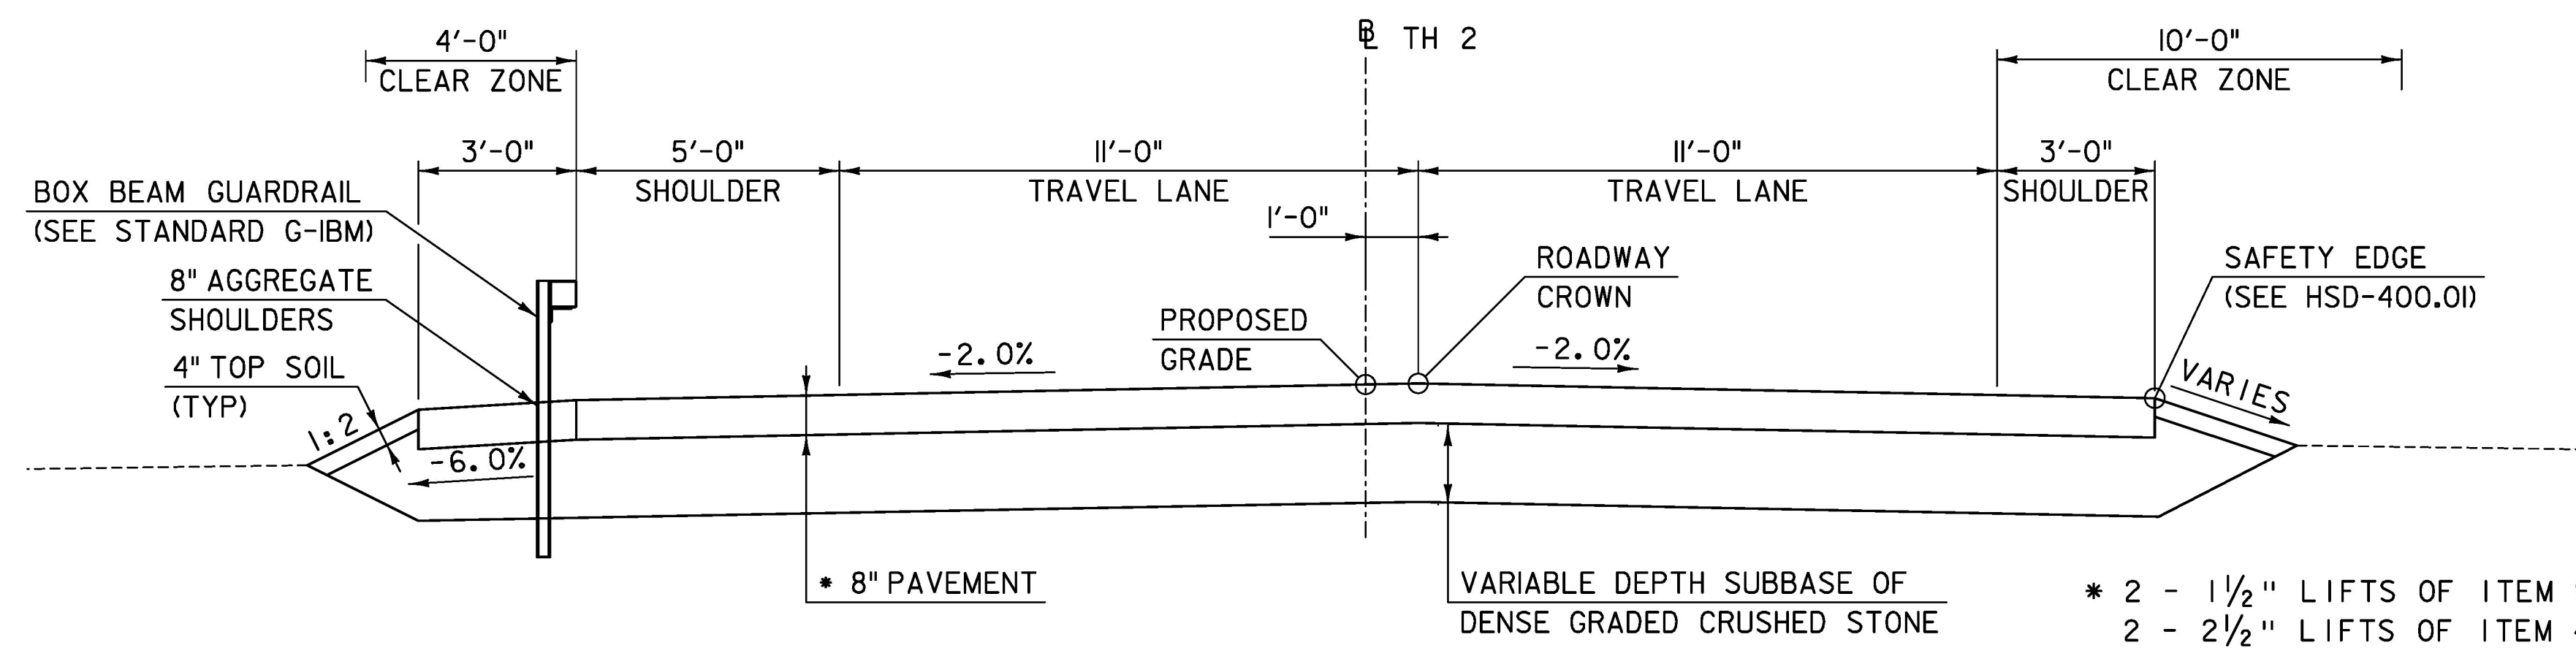

ROADWAY TYPICAL SECTION

SCALE: 3/8" = 1'-0"

* 2 - 1 1/2" LIFTS OF ITEM 900.680, "SPECIAL PROVISION (BITUMINOUS CONCRETE PAVEMENT, TYPE IVB)" OVER
2 - 2 1/2" LIFTS OF ITEM 490.30, "SUPERPAVE BITUMINOUS CONCRETE PAVEMENT", TYPE IIS

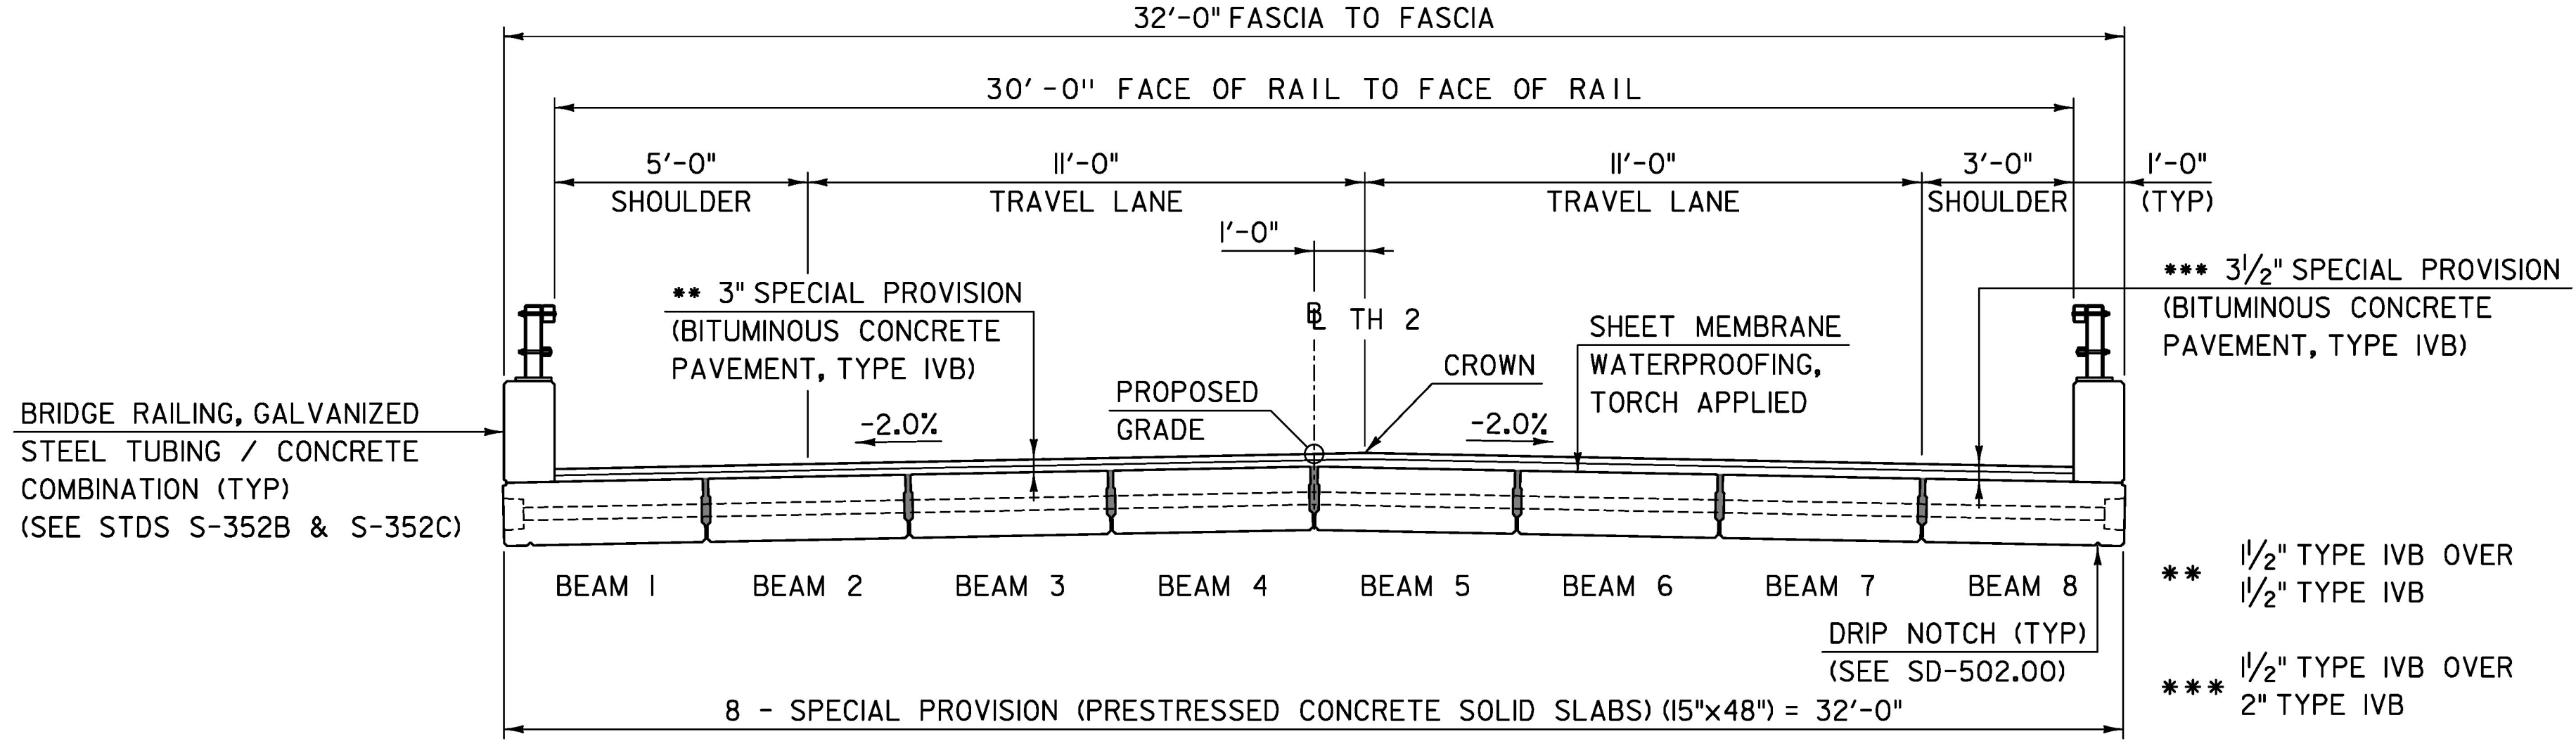

BRIDGE TYPICAL SECTION

SCALE: 3/8" = 1'-0"

** 1 1/2" TYPE IVB OVER 1 1/2" TYPE IVB
*** 1 1/2" TYPE IVB OVER 2" TYPE IVB

PROJECT NAME:	BARTON VILLAGE
PROJECT NUMBER:	BHF 0286(5)
FILE NAME:	z12j172+yp1.dgn
PROJECT LEADER:	J. OLUND
DESIGNED BY:	B. TOOTHAKER
TYPICAL SECTIONS AND DETAILS 1	
PLOT DATE:	8/15/2016
DRAWN BY:	B. TOOTHAKER
CHECKED BY:	J. HOWE
SHEET	57 OF 110

TYLIN INTERNATIONAL